

JOHNSON CONTROLS

Creating a better climate for business.

- Environmental Control System
- Facility Management System
- Air and Water System Balancing
- Fire Management System
- Security System
- Lighting Services
- Instrumentation System Installation
- Building Operations Management
- Energy Conservation Control
- Training Programs
- Performance Contracting
- Planned Service Agreements

Air Conditioning
 Heating
 Diagnostic Services
 Coil Cleaning
 Refrigeration
 Automatic Temperature Controls
 Facility Management Systems
 Fire Management
 Security Management
 Building Operations and Management
 Water Treatment
 Electrical Equipment
 Emergency Generator / Lighting Equipment
 Industrial Controls / Recording / Indication Equipment

PROJECT TITLE

**DANE COUNTY COURTHOUSE
 215 SOUTH HAMILTON ST.
 MADISON, WI 53703**

ARCHITECT	ENGINEER
THE DURRANT GROUP, INC.	THE DURRANT GROUP, INC.
MECHANICAL CONTRACTOR	ELECTRICAL CONTRACTOR
H & H INDUSTRIES, INC.	

1	RECORD DRAWINGS	03/30/08	WCS
REFERENCE DRAWING	NO	REVISION-LOCATION	ECH DATE BY

JOHNSON CONTROLS
 Systems & Services Division

Branch Information
 Madison Branch
 2400 Kilgust Road
 Madison
 WI 53713
 Phone: 608-222-9100
 Fax: 608-222-9490

SALES ENGINEER	PROJECT MANAGER	APPLICATION ENGINEER	DATE	CONTRACT NUMBER
GLA	SEL	RJM	12/23/2003	0 3109-0044

PS-4	POINT SCHEDULE
6.8-6.9	POINT SCHEDULE DETAILS
7.1	AHU-4 FLOW
7.2	AHU-4 FIELD POINTS
7.3	AHU-4 PANEL
7.4	AHU-4 PANEL WIRING
7.5-7.6	SEQUENCE
PS-5	POINT SCHEDULE
7.8	POINT SCHEDULE DETAILS
8.1	AHU-5 FLOW
8.2	AHU-5 FIELD POINTS
8.3	AHU-5 PANEL
8.4	AHU-5 PANEL WIRING
8.5-8.6	SEQUENCE
PS-6	POINT SCHEDULE
8.8	POINT SCHEDULE DETAILS
9.1	AHU-6 FLOW
9.2	AHU-6 FIELD POINTS
9.3	AHU-6 PANEL
9.4	AHU-6 PANEL WIRING
9.5-9.6	SEQUENCE
PS-7	POINT SCHEDULE
9.8-9.9	POINT SCHEDULE DETAILS
10.1	AHU-7 FLOW
10.2	AHU-7 FIELD POINTS
10.3	AHU-7 PANEL
10.4	AHU-7 PANEL WIRING
10.5-10.6	SEQUENCE
PS-8	POINT SCHEDULE
10.8	POINT SCHEDULE DETAILS
11.1	AHU-8 FLOW
11.2	AHU-8 FIELD POINTS
11.3	AHU-8 PANEL
11.4	AHU-8 PANEL WIRING
11.5-11.6	SEQUENCE
PS-8	POINT SCHEDULE
11.8-11.9	POINT SCHEDULE DETAILS
12.1-12.3	FAN DETAILS
13.1-13.16	ROOM SCHEDULE DETAILS
13.1	DETAIL A - VAV TERMINAL WITH HOT WATER REHEAT
13.2-13.3	POINT SCHEDULE
13.4	DETAIL B - VAV TERMINAL WITH HOT WATER REHEAT AND RADIATION
13.5-13.6	POINT SCHEDULE
13.7	DETAIL C - VAV TERMINAL WITH HOT WATER REHEAT (TEMP SENSOR IN EXHAUST DUCT)
13.8	POINT SCHEDULE
13.9	DETAIL D - VAV TERMINAL WITH HOT WATER REHEAT AND RADIATION (ONE ZONE SENSOR SERVING TWO VAV BOXES)
13.10-13.11	POINT SCHEDULE
13.12	DETAIL E - UNIT HEATER / CABINET UNIT HEATER ELECTRIC CONTROL - HOT WATER

REV	DRAWING NUMBER	DRAWING TITLE
	10.1	AHU-7 FLOW
	10.2	AHU-7 FIELD POINTS
	10.3	AHU-7 PANEL
	10.4	AHU-7 PANEL WIRING
	10.5-10.6	SEQUENCE
	PS-8	POINT SCHEDULE
	10.8	POINT SCHEDULE DETAILS
	11.1	AHU-8 FLOW
	11.2	AHU-8 FIELD POINTS
	11.3	AHU-8 PANEL
	11.4	AHU-8 PANEL WIRING
	11.5-11.6	SEQUENCE
	PS-9	POINT SCHEDULE
	11.8-11.9	POINT SCHEDULE DETAILS
	12.1-12.3	FAN DETAILS
	13.1-13.16	ROOM SCHEDULE DETAILS
	13.1	DETAIL A - VAV TERMINAL WITH HOT WATER REHEAT
	13.2-13.3	POINT SCHEDULE
	13.4	DETAIL B - VAV TERMINAL WITH HOT WATER REHEAT AND RADIATION
	13.5-13.6	POINT SCHEDULE
	13.7	DETAIL C - VAV TERMINAL WITH HOT WATER REHEAT (TEMP SENSOR IN EXHAUST DUCT)
	13.8	POINT SCHEDULE
	13.9	DETAIL D - VAV TERMINAL WITH HOT WATER REHEAT AND RADIATION (ONE ZONE SENSOR SERVING TWO VAV BOXES)
	13.10-13.11	POINT SCHEDULE
	13.12	DETAIL E - UNIT HEATER / CABINET UNIT HEATER ELECTRIC CONTROL - HOT WATER
	13.13	DETAIL G - GENERATOR ROOM EXHAUST FAN EF-9 CONTROL
	13.14	DETAIL H - ELECTRICAL EQUIPMENT ROOM EXHAUST FAN CONTROL
	13.14	DETAIL I - KITCHEN ROOM EXHAUST FAN (TEMPERATURE CONTROL)
	13.14	DETAIL J - PARKING EXHAUST FAN
	13.15	DETAIL K - FIN RADIATION - HOT WATER
	13.15	DETAIL L - SELF CONTAINED AIR CONDITIONING UNIT
	13.16	DETAIL M - FAN COIL UNIT
	13.16	DETAIL N - FAN COIL UNIT
	14.1-14.37	MISCELLANEOUS DETAILS
	14.1	DETAIL A - EXHAUST FANS CONTROL PANEL
	14.2	DETAIL A (CONT.) - EXHAUST FANS CONTROL PANEL WIRING
	14.3	DETAIL A (CONT.) - FIELD POINTS
	PS-3	POINT SCHEDULE
	14.5	POINT SCHEDULE
	14.6	DETAIL B - LOWER LEVEL 2 VMA TRANSFORMER PANEL

REVISION INFORMATION	IN CONSIDERATION OF THE RECEIPT OF THIS DOCUMENT, THE RECIPIENT AGREES NOT TO REPRODUCE, COPY, USE OR TRANSMIT THIS DOCUMENT AND/OR THE INFORMATION THEREIN CONTAINED, IN WHOLE OR IN PART, OR TO SUFFER SUCH ACTION BY OTHERS, FOR ANY PURPOSE, EXCEPT WITH THE WRITTEN PERMISSION OF JOHNSON CONTROLS, INC. AND FURTHER AGREES TO SURRENDER SAME TO JOHNSON CONTROLS, INC. UPON DEMAND.
NUMBER	
DATE	
TIME	
FILE NAME	COPYRIGHT JOHNSON CONTROLS, INC. 2001

REV	DRAWING NUMBER	DRAWING TITLE
	14.1-14.37	MISCELLANEOUS DETAILS
	14.1	DETAIL A - EXHAUST FANS CONTROL PANEL
	14.2	DETAIL A (CONT.) - EXHAUST FANS CONTROL PANEL WIRING
	14.3	DETAIL A (CONT.) - FIELD POINTS
	14.4-14.5	POINT SCHEDULE
	14.6	DETAIL B - LOWER LEVEL 2 VMA TRANSFORMER PANEL
	14.7	DETAIL B (CONT.) - LOWER LEVEL 2 VMA TRANSFORMER PANEL WIRING
	14.8	DETAIL C - LOWER LEVEL 1 VMA TRANSFORMER PANEL
	14.9	DETAIL C (CONT.) - LOWER LEVEL 1 VMA TRANSFORMER PANEL WIRING
	14.10	DETAIL D - 1ST FLOOR VMA TRANSFORMER PANEL
	14.11	DETAIL D (CONT.) - 1ST FLOOR VMA TRANSFORMER PANEL WIRING
	14.12	DETAIL E - 2ND FLOOR VMA TRANSFORMER PANEL
	14.13-14.14	DETAIL E (CONT.) - 2ND FLOOR VMA TRANSFORMER PANEL WIRING
	14.15	DETAIL F - 3RD FLOOR VMA TRANSFORMER PANEL
	14.16-14.17	DETAIL F (CONT.) - 3RD FLOOR VMA TRANSFORMER PANEL WIRING
	14.18	DETAIL G - 4TH FLOOR VMA TRANSFORMER PANEL
	14.19-14.20	DETAIL G (CONT.) - 4TH FLOOR VMA TRANSFORMER PANEL WIRING
	14.21	DETAIL H - 5TH FLOOR VMA TRANSFORMER PANEL
	14.22-14.23	DETAIL H (CONT.) - 5TH FLOOR VMA TRANSFORMER PANEL WIRING
	14.24	DETAIL I - 6TH FLOOR VMA TRANSFORMER PANEL
	14.25-14.26	DETAIL I (CONT.) - 6TH FLOOR VMA TRANSFORMER PANEL WIRING
	14.27	DETAIL J - 7TH FLOOR VMA TRANSFORMER PANEL
	14.28-14.29	DETAIL J (CONT.) - 7TH FLOOR VMA TRANSFORMER PANEL WIRING
	14.30	DETAIL K - 8TH FLOOR VMA TRANSFORMER PANEL
	14.31-14.32	DETAIL K (CONT.) - 8TH FLOOR VMA TRANSFORMER PANEL WIRING
	14.33	DETAIL L - MISCELLANEOUS UNT CONTROLLERS
		DETAIL M - FIRE / SMOKE DAMPERS CONTROL RELAYS
	14.34-14.35	POINT SCHEDULE
	14.36	DETAIL N - FIREMAN'S CONTROL PANEL
	14.37	DETAIL O - SNOWMELT SYSTEM
	PAGE 1	DAMPER SCHEDULE
	D1	DAMPER SCHEDULE DETAILS
	PAGE 1	FLOW STATION SCHEDULE
	PAGE 1-5	ROOM SCHEDULE
	PAGE 1	VALVE SCHEDULE
	D2	VALVE SCHEDULE DETAILS
	PAGE 1	WELL/TAP/METER SCHEDULE
	D3-D4	WELL/TAP/METER SCHEDULE DETAILS

JOHNSON CONTROLS

Creating a better climate for business.


- Environmental Control System
- Facility Management System
- Air and Water System Balancing
- Fire Management System
- Security System
- Lighting Services
- Instrumentation System Installation
- Building Operations Management
- Energy Conservation Control
- Training Programs
- Performance Contracting
- Planned Service Agreements

Air Conditioning
 Heating
 Diagnostic Services
 Coil Cleaning
 Refrigeration
 Automatic Temperature Controls
 Facility Management Systems
 Fire Management
 Security Management
 Building Operations and Management
 Water Treatment
 Electrical Equipment
 Emergency Generator / Lighting Equipment
 Industrial Controls / Recording / Indication Equipment

PROJECT TITLE
DANE COUNTY COURTHOUSE
215 SOUTH HAMILTON ST.
MADISON, WI 53703

ARCHITECT	ENGINEER
THE DURRANT GROUP, INC.	THE DURRANT GROUP, INC.
MECHANICAL CONTRACTOR	ELECTRICAL CONTRACTOR
H & H INDUSTRIES, INC.	

1	RECORD DRAWINGS	03/30/08	WCS
REFERENCE DRAWING	NO.	REVISION-LOCATION	ECN
			DATE
			BY

 Systems & Services Division		Branch Information		
		Madison Branch 2400 Kilgust Road Madison WI 53713 Phone: 608-222-9100 Fax: 608-222-9490		
SALES ENGINEER	PROJECT MANAGER	APPLICATION ENGINEER	DATE	CONTRACT NUMBER
GLA	SEL	RJM	12/23/2003	0 3109-0044

REVISION INFORMATION	IN CONSIDERATION OF THE RECEIPT OF THIS DOCUMENT, THE RECIPIENT AGREES NOT TO REPRODUCE, COPY, USE OR TRANSMIT THIS DOCUMENT AND/OR THE INFORMATION THEREIN CONTAINED, IN WHOLE OR IN PART, OR TO SUFFER SUCH ACTION BY OTHERS, FOR ANY PURPOSE, EXCEPT WITH THE WRITTEN PERMISSION OF JOHNSON CONTROLS, INC. AND FURTHER AGREES TO SURRENDER SAME TO JOHNSON CONTROLS, INC. UPON DEMAND.
NUMBER	
DATE	
TIME	
FILE NAME	COPYRIGHT JOHNSON CONTROLS, INC. 2001
Title2.vsd	

BILL OF MATERIALS

Designation	Qty	Part Number	Description
Field Devices:			
CAP-1	1	PD-101-10	CAPACITOR, 560PF
FILTER-1	1	81F4523	CORCOM 3VB1 LINE FILTER - NEWARK
MOV-1	1	AS-MOVKIT-0	KIT, TRANSIENT NOISE SUPPRESSOR, PK OF 12

TABLE 2	DRAIN CABLE		
	TERMINALS	I/O GROUNDING	
ENCLOSURE		NO ENCLOSURE	
VO	HARD GROUND @ EACH PANEL. TAPE BACK @ EACH DEVICE	TAPE BACK @ EACH END	SEE FIGURE A
BO (NOISY INDUCTIVE LOADS)	TAPE BACK @ EACH END	TAPE BACK @ EACH END	ADD MOV-1 @ CONTROLLER TERMINALS
BO (GAS IGNITION)	TAPE BACK @ EACH END	TAPE BACK @ EACH END	ADD FILTER-1 @ CONTROLLER TERMINALS. HARD GROUND CASE.

TABLE 3	DRAIN CABLE		
	TERMINALS	N2 GROUNDING	
ENCLOSURE		NO ENCLOSURE	
SUPERVISORY CONTROLLER	HARD GROUND TO BACK PLANE	NA	
ASC	STRAIGHT THROUGH TO NEXT DEVICE	STRAIGHT THROUGH TO NEXT DEVICE	SEE FIGURE B
ASC (EOL)	TAPE BACK @ ASC	TAPE BACK @ ASC	
ASC (NOISY)	SOFT GROUND ONCE PER ENCLOSURE	TAPE BACK @ ASC	ADD CAP-1 @ ENCLOSURE

FIGURE A


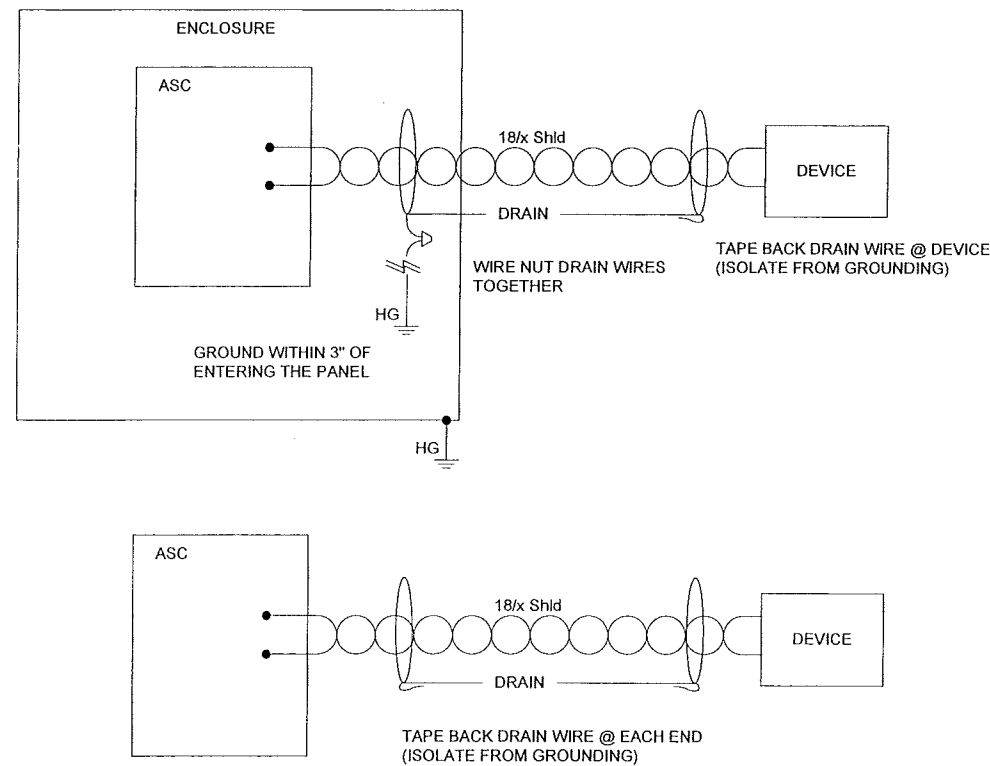


FIGURE B

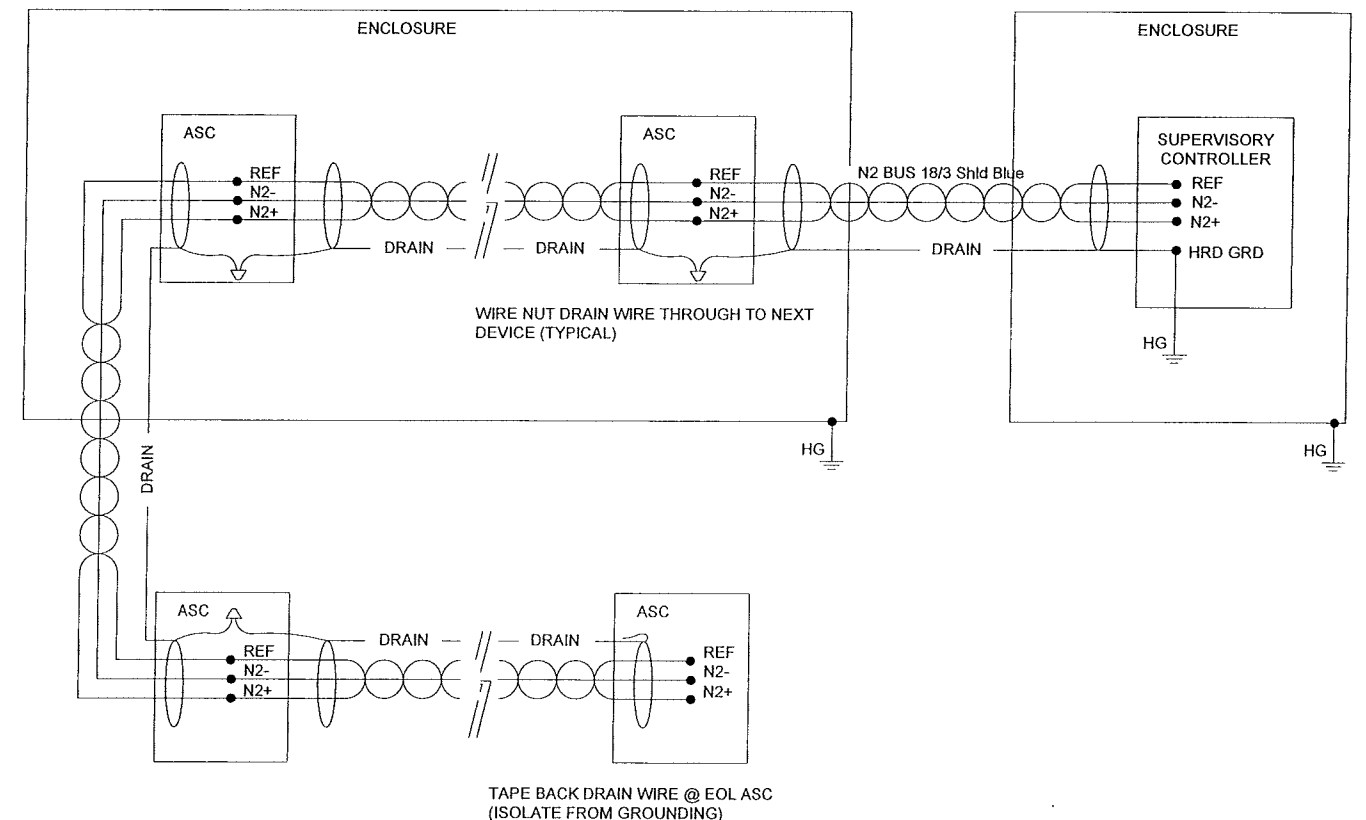


SYMBOL LEGEND ○ PNEUMATIC TUBING □ LOW VOLTAGE ○ CABLE ◊ HIGH VOLTAGE	REVISION INFORMATION NUMBER DATE 04/17/08 TIME 09:49 AM FILE NAME Legend-b.vsd	Drawing Title LEGEND Project Title DANE COUNTY COURTHOUSE 215 SOUTH HAMILTON ST. MADISON, WI 53703	NO. 1 REFERENCE DRAWING Sales Engineer: GLA Project Manager: SEL Application Engineer: RJM DRAWN BY: [] APPROVED BY: [] DATE: []	REVISION-LOCATION ECN: [] DATE: [] BY: []	CONTRACT NUMBER 0 3109-0044 DRAWING NUMBER 1.2
	JOHNSON CONTROLS Systems & Services Division		Branch Information Madison Branch 2400 Kilgust Road Madison WI 53713 Phone: 608-222-9100 Fax: 608-222-9490		
	DATE: 03/30/08 BY: WCS		DATE: [] BY: []		
	DATE: [] BY: []		DATE: [] BY: []		

BILL OF MATERIALS

Designation	Qty	Part Number	Description
Panel Devices:			
HUB-1	1	464163	NETGEAR-5 PORT 10/100 SWITCHING HUB-ITAS
NIE01	2	064321	3' RJ45 PATCH CABLE-ITAS
	1	EN-EWC35-0	TRIPLE ENCLOSURE WITH 100VA POWER
	1	MS-NIE5510-0	NIE FOR EXIST NCM, 24VAC, 50VA


CITY/COUNTY BUILDING

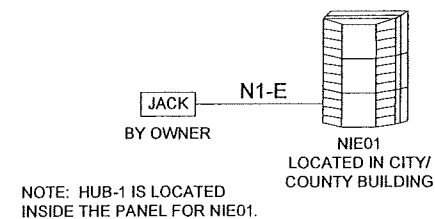

ETHERNET ADDRESSES		
REV	TYPE	ADDRESS
	SUBNET MASK	255.255.255.0
	DEFAULT GATEWAY	134.48.250.101

TRUNK SCHEMATIC LEGEND

<u>N1-A</u>	N1 ARCNET BUS	<u>R</u>	RS232 CABLE
<u>N1-E</u>	N1 ETHERNET BUS	<u>M</u>	MODEM CABLE - RS232
<u>N1-F</u>	N1 FIBER BUS	<u>P</u>	PARALLEL PRINTER CABLE
<u>BAC</u>	BACNET (N30) BUS	<u>XT</u>	XT BUS
<u>N2</u>	N2 BUS	*	N2 BUS END OF LINE
<u>NT</u>	NT BUS	#	LON BUS END OF LINE
<u>N2/NT</u>	N2 AND NT BUS	+	N1 BUS END OF LINE
<u>LON</u>	LON BUS		

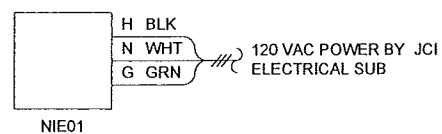


NOTE: N2 TRUNK IS SCHEMATIC ONLY. ACTUAL RUN WILL VARY.

REVISION INFORMATION		Drawing Title									
NUMBER		COMMUNICATIONS BUS		1		RECORD DRAWINGS		03/30/08		WCS	
DATE		04/17/08		REFERENCE DRAWING		NO.		REVISION-LOCATION		ECH DATE BY	
TIME		09:49 AM		Sales Engineer		Project Manager		Application Engineer		DRAWN APPROVED	
FILE NAME		Trunka.vsd		GLA		SEL		RJM		BY DATE	
Project Title		DANE COUNTY COURTHOUSE 215 SOUTH HAMILTON ST. MADISON, WI 53703		Branch Information		Madison Branch 2400 Kilgust Road Madison WI 53713 Phone: 608-222-9100 Fax: 608-222-9490		CONTRACT NUMBER		0 3109-0044	
				JOHNSON CONTROLS		Systems & Services Division		DRAWING NUMBER		2.1	


BILL OF MATERIALS

Designation	Qty	Part Number	Description
Field Devices:			
NAE01	2	NU-EOL202-0	END OF LINE MOD. FTT10
PP-1	1	634118	PALM-HOTS SYNC CABLE-ITAS
	1	821089	BLACK BOX-NULL MODEM ADAPTER DBP M/M-ITAS
	1	AS-CVTPRO100-1	CONVERTER, N-AMERICAN W/ CABLES & CASE
	1	D48608	PALM-TUNGSTEN W, COLOR, RECHARGEABLE-ITAS
RPTR-x	2	4683-TTM-1	REPEATER,RS-485>RS-485,115VAC
Panel Devices:			
HUB-1	1	464163	NETGEAR-5 PORT 10/100 SWITCHING HUB-ITAS
NAE01	2	064321	3' RJ45 PATCH CABLE-ITAS
	1	EN-EWC35-0	TRIPLE ENCLOSURE WITH 100VA POWER
	1	MS-NAE5520-0	NAE WIN2 BUS, LON CARD, 24VAC, 50VA
	1	MS-SCTSWO-0	SYSTEM CONFIGURATION TOOL S/W, NEW
	1	MW-MCLTOL064-0	MCL TOOL 5.1 64 NODES


2ND FLOOR

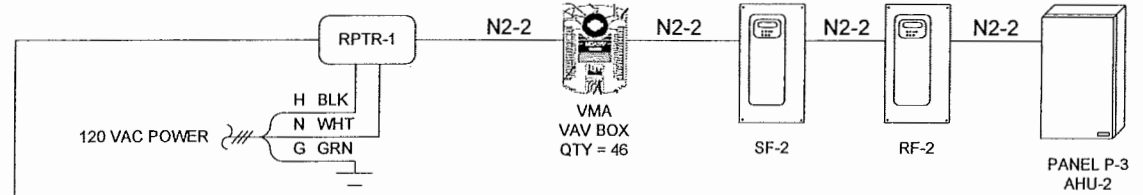

1ST FLOOR

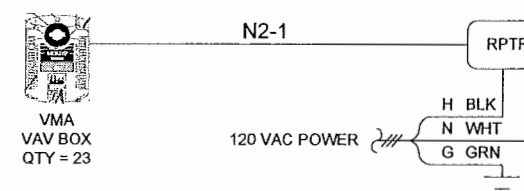

LOWER LEVEL 1


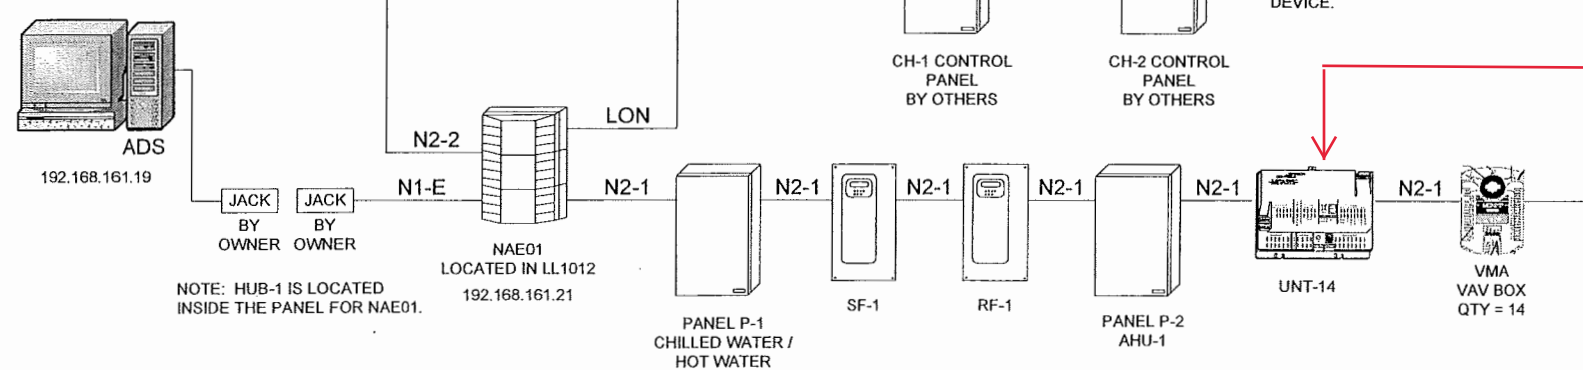


ETHERNET ADDRESSES		
REV	TYPE	ADDRESS
	SUBNET MASK	255.255.255.0
	DEFAULT GATEWAY	134.48.250.101

TRUNK SCHEMATIC LEGEND

N1-A	N1 ARCNET BUS	R	RS232 CABLE
N1-E	N1 ETHERNET BUS	M	MODEM CABLE - RS232
N1-F	N1 FIBER BUS	P	PARALLEL PRINTER CABLE
BAC	BACNET (N30) BUS	XT	XT BUS
N2	N2 BUS	*	N2 BUS END OF LINE
NT	NT BUS	#	LON BUS END OF LINE
N2/NT	N2 AND NT BUS	+	N1 BUS END OF LINE
LON	LON BUS		

LOWER LEVEL 2

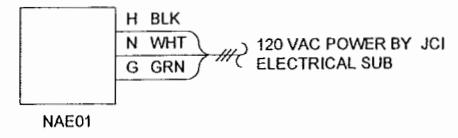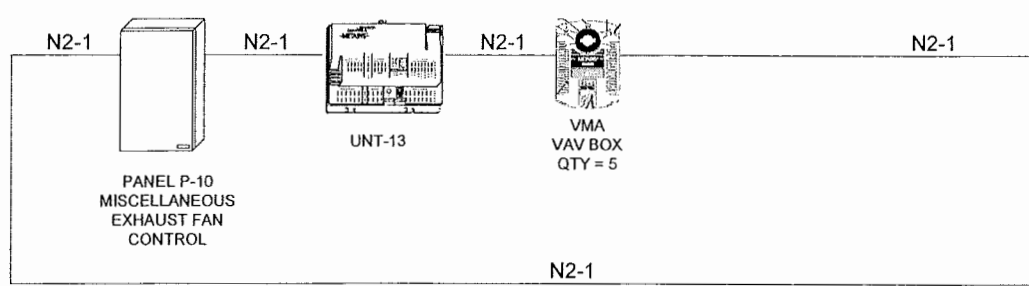

PP-1

NOTE: N2 TRUNK IS SCHEMATIC ONLY. ACTUAL RUN WILL VARY.

REVISION INFORMATION	Drawing Title							
	COMMUNICATIONS BUS							
NUMBER			1		RECORD DRAWINGS		03/30/08 WCS	
DATE	04/17/08		REFERENCE DRAWING NO.		REVISION-LOCATION		ECN DATE BY	
TIME	08:30 AM		Sales Engineer GLA		Project Manager SEL		Application Engineer RJM	
FILE NAME	Trunkb.vsd		Project Title		Branch Information		CONTRACT NUMBER	
			DANE COUNTY COURTHOUSE 215 SOUTH HAMILTON ST. MADISON, WI 53703		Madison Branch 2400 Kilgust Road Madison WI 53713 Phone: 608-222-9100 Fax: 608-222-9490		0 3109-0044	
			JOHNSON CONTROLS Systems & Services Division				DRAWING NUMBER 2.2	

2ND FLOOR

1ST FLOOR

LOWER LEVEL 1

LOWER LEVEL 2

NAE01 N2-2

NAE01 N2-1

NOTES:


INSTALL REPEATERS EVERY 50 N2 DEVICES.

REVISION INFORMATION	Drawing Title								
NUMBER	COMMUNICATIONS BUS								
DATE	04/17/08								
TIME	09:48 AM								
FILE NAME	Vavrisra.vsd								
	Project Title	DANE COUNTY COURTHOUSE 215 SOUTH HAMILTON ST. MADISON, WI 53703		JOHNSON CONTROLS Systems & Services Division		Branch Information Madison Branch 2400 Kilgust Road Madison WI 53713 Phone: 608-222-9100 Fax: 608-222-9490		CONTRACT NUMBER 0 3109-0044 DRAWING NUMBER 2.3	
	REFERENCE DRAWING	NO.	REVISION-LOCATION		ECH	DATE	BY		
	Sales Engineer	Project Manager	Application Engineer	DRAWN		APPROVED			
	GLA	SEL	RJM	BY	DATE	BY	DATE		


BILL OF MATERIALS

Designation	Qty	Part Number	Description
Field Devices:			
RPTR-x	2	4683-TTM-1	REPEATER,RS-485>RS-485,115VAC
Panel Devices:			
HUB-1	1	464163	NETGEAR-5 PORT 10/100 SWITCHING HUB-ITAS
NAE02	2	064321	3' RJ45 PATCH CABLE-ITAS
	1	EN-EWC35-0	TRIPLE ENCLOSURE WITH 100VA POWER
	1	MS-NAE5510-0	NAE WIN2 BUS, 24VAC, 50VA


5TH FLOOR

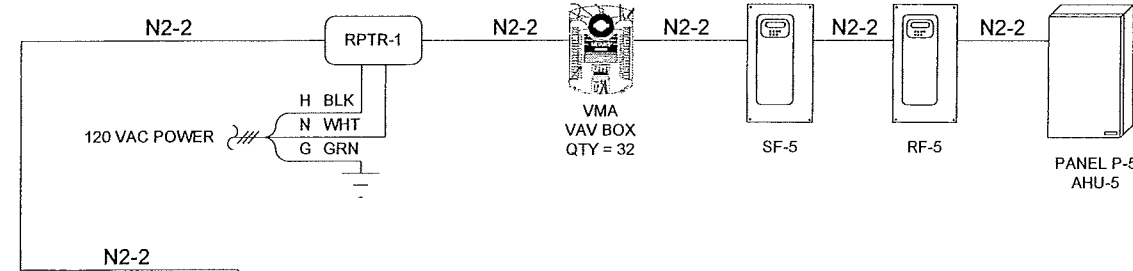

4TH FLOOR

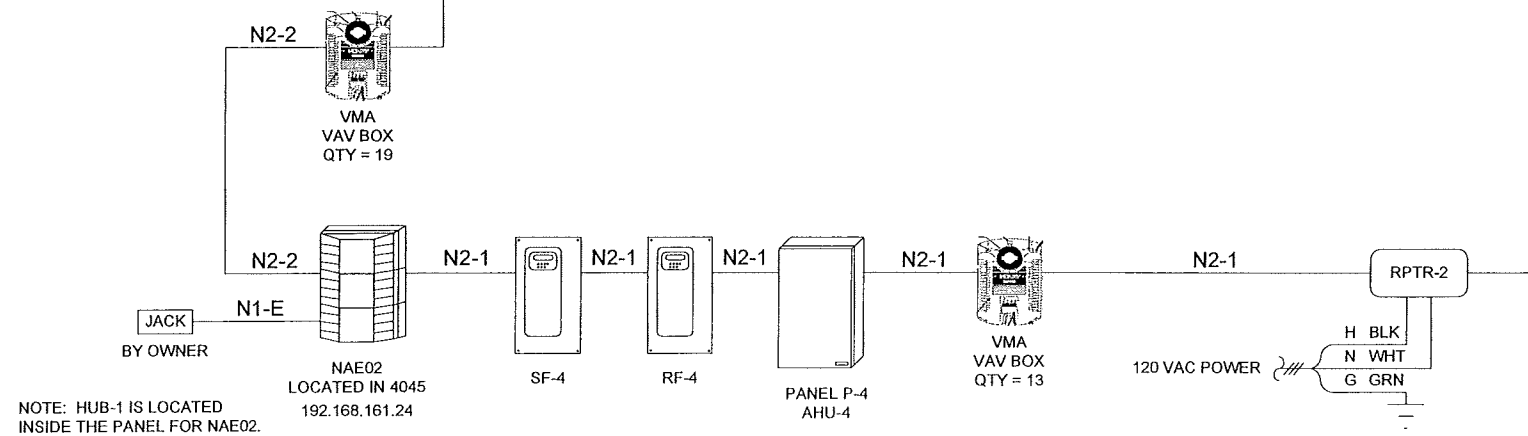


3RD FLOOR

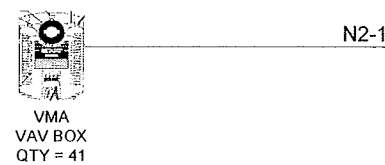

ETHERNET ADDRESSES		
REV	TYPE	ADDRESS
	SUBNET MASK	255.255.255.0
	DEFAULT GATEWAY	134.48.250.101

TRUNK SCHEMATIC LEGEND

<u>N1-A</u>	N1 ARCNET BUS	<u>R</u>	RS232 CABLE
<u>N1-E</u>	N1 ETHERNET BUS	<u>M</u>	MODEM CABLE - RS232
<u>N1-F</u>	N1 FIBER BUS	<u>P</u>	PARALLEL PRINTER CABLE
<u>BAC</u>	BACNET (N30) BUS	<u>XT</u>	XT BUS
<u>N2</u>	N2 BUS	*	N2 BUS END OF LINE
<u>NT</u>	NT BUS	#	LON BUS END OF LINE
<u>N2/NT</u>	N2 AND NT BUS	+	N1 BUS END OF LINE
<u>LON</u>	LON BUS		

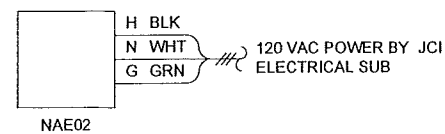

NOTE: N2 TRUNK IS SCHEMATIC ONLY. ACTUAL RUN WILL VARY.

REVISION INFORMATION		Drawing Title							
NUMBER		COMMUNICATIONS BUS		1		RECORD DRAWINGS		03/30/08 WCS	
DATE	04/17/08								
TIME	08:30 AM								
FILE NAME	Trunkc.vsd	Project Title		DANE COUNTY COURTHOUSE 215 SOUTH HAMILTON ST. MADISON, WI 53703		Branch Information		CONTRACT NUMBER	
				JOHNSON CONTROLS Systems & Services Division		Madison Branch 2400 Kilgust Road Madison WI 53713 Phone: 608-222-9100 Fax: 608-222-9490		0 3109-0044	
								DRAWING NUMBER	
								2.4	

5TH FLOOR

4TH FLOOR

NAE02 N2-2

NAE02 N2-1

3RD FLOOR

NOTES:


INSTALL REPEATERS EVERY 50 N2 DEVICES.

REVISION INFORMATION	Drawing Title								
NUMBER	COMMUNICATIONS BUS								
DATE	04/17/08		1	RECORD DRAWINGS		03/30/08	WCS		
TIME	08:30 AM	Project Title	REFERENCE DRAWING	NO.	REVISION LOCATION	ECN	DATE	BY	
FILE NAME	Vavrisrb.vsd	DANE COUNTY COURTHOUSE 215 SOUTH HAMILTON ST. MADISON, WI 53703	Sales Engineer	Project Manager	Application Engineer				
			GLA	SEL	RJM				
			BY	DATE	BY	DATE	BY	DATE	
			Branch Information		CONTRACT NUMBER		0 3109-0044		
			JOHNSON CONTROLS Systems & Services Division		Madison Branch 2400 Kilgust Road Madison WI 53713 Phone: 608-222-9100 Fax: 608-222-9490		DRAWING NUMBER 2.5		


BILL OF MATERIALS

Designation	Qty	Part Number	Description
Field Devices:			
RPTR-x	2	4683-TTM-1	REPEATER,RS-485>RS-485,115VAC
Panel Devices:			
HUB-1	1	464163	NETGEAR-5 PORT 10/100 SWITCHING HUB-ITAS
NAE03	2	064321	3' RJ45 PATCH CABLE-ITAS
	1	EN-EWC35-0	TRIPLE ENCLOSURE WITH 100VA POWER
	1	MS-NAE5510-0	NAE WN2 BUS, 24VAC, 50VA


8th FLOOR

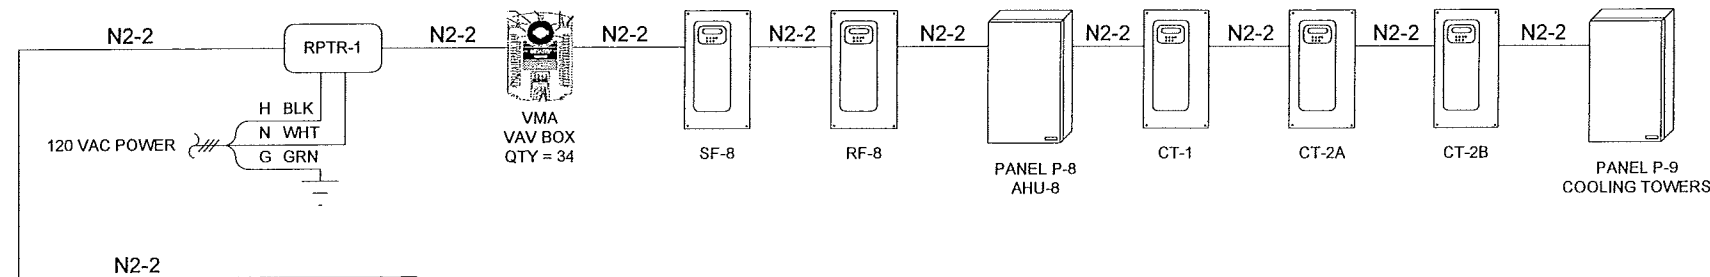

7th FLOOR

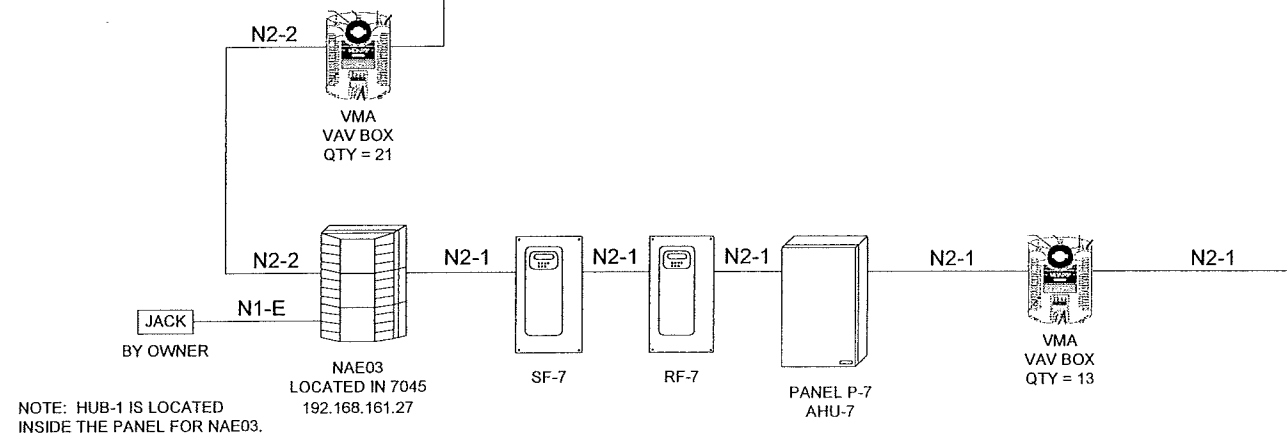


6th FLOOR

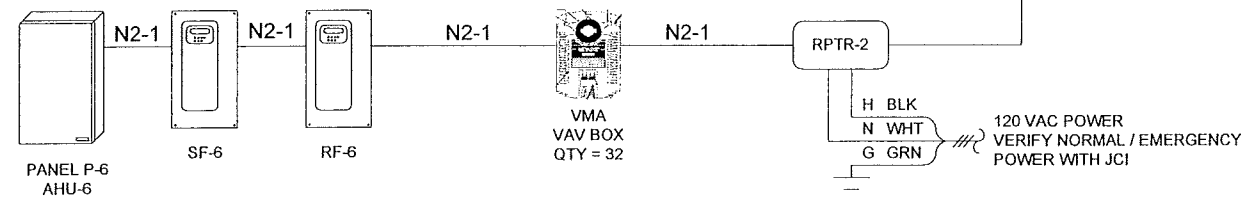

ETHERNET ADDRESSES		
REV	TYPE	ADDRESS
	SUBNET MASK	255.255.255.0
	DEFAULT GATEWAY	134.48.250.101

TRUNK SCHEMATIC LEGEND

N1-A	N1 ARCNET BUS	R	RS232 CABLE
N1-E	N1 ETHERNET BUS	M	MODEM CABLE - RS232
N1-F	N1 FIBER BUS	P	PARALLEL PRINTER CABLE
BAC	BACNET (N30) BUS	XT	XT BUS
N2	N2 BUS	*	N2 BUS END OF LINE
NT	NT BUS	#	LON BUS END OF LINE
N2/NT	N2 AND NT BUS	+	N1 BUS END OF LINE
LON	LON BUS		

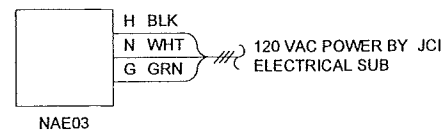

NOTE: N2 TRUNK IS SCHEMATIC ONLY. ACTUAL RUN WILL VARY.

REVISION INFORMATION		Drawing Title							
NUMBER	04/17/08	COMMUNICATIONS BUS		1	RECORD DRAWINGS	03/30/08	WCS		
DATE	04/17/08	REFERENCE DRAWING	NO.	REVISION-LOCATION	ECN	DATE	BY		
TIME	08:30 AM	GLA	SEL	Application Engineer	RJM	DATE	BY	DATE	APPROVED
FILE NAME	Trunkd.vsd	Project Title		Branch Information		CONTRACT NUMBER		DRAWING NUMBER	
		DANE COUNTY COURTHOUSE 215 SOUTH HAMILTON ST. MADISON, WI 53703		 Madison Branch 2400 Kilgust Road Madison WI 53713 Phone: 608-222-9100 Fax: 608-222-9490		0 3109-0044		2.6	

8TH FLOOR

7TH FLOOR

NAE03 N2-2

NAE03 N2-1

6TH FLOOR


NOTES:

INSTALL REPEATERS EVERY 50 N2 DEVICES.


REVISION INFORMATION	Drawing Title								
NUMBER	COMMUNICATIONS BUS								
DATE	04/17/08								
TIME	08:29 AM								
FILE NAME	Vavriscr.vsd								
Project Title	DANE COUNTY COURTHOUSE 215 SOUTH HAMILTON ST. MADISON, WI 53703		REFERENCE DRAWING NO. 1 REVISION-LOCATION RECORD DRAWINGS ECH DATE BY 03/30/08 WCS		SALES ENGINEER PROJECT MANAGER APPLICATION ENGINEER GLA SEL RJM		DRAWN BY DATE APPROVED BY DATE		CONTRACT NUMBER 0 3109-0044
Branch Information			JOHNSON CONTROLS Systems & Services Division		Madison Branch 2400 Kilgust Road Madison WI 53713 Phone: 608-222-9100 Fax: 608-222-9490		DRAWING NUMBER 2.7		

BILL OF MATERIALS

Designation	Qty	Part Number	Description
Field Devices:			
1/3-VLV, 2/3-VLV	0	VALVE	SEE VALVE SCHEDULE
HWS-T	1	TE-631AP-1	SENSOR,T-NI,0.1%,FWZ1000-5 WELL
	1	WZ-1000-5	WELL,BRASS,2-3/8IN,1/2IN NPT+COMPOUND
OA-T	1	TE-6313P-1	SENSOR,T-NI,0.1%,3IN OAT
P6-C, P6-S, P8-C, P8-S	2	H738	SENS,CURR,1A @30VAC/DC,1/3HP,CMND RELAY

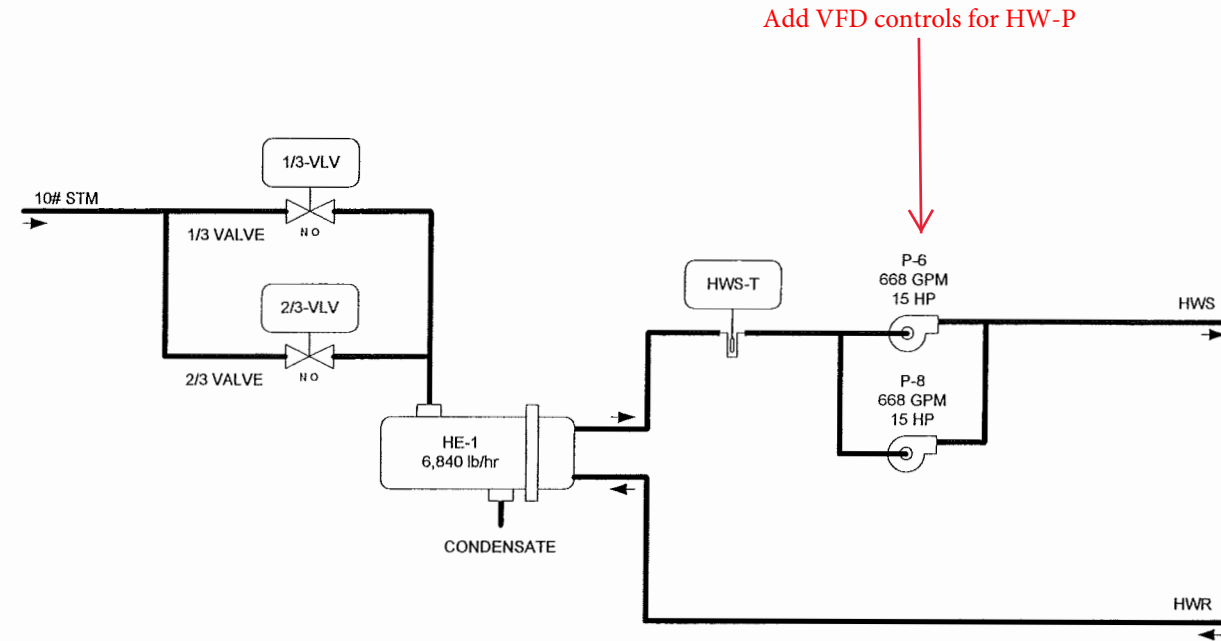


Add VFD controls for HW-P

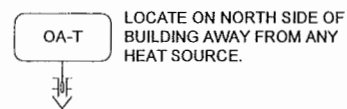


NOTE: ALL ASSOCIATED POINTS ARE WIRED TO PANEL P-1.

PUMP P-6 STARTER WIRING

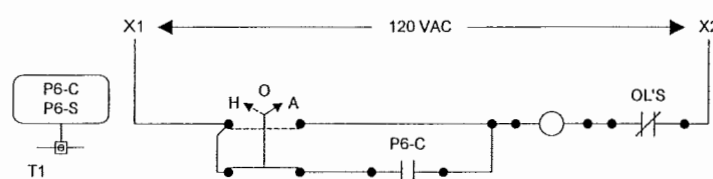


PUMP P-8 STARTER WIRING

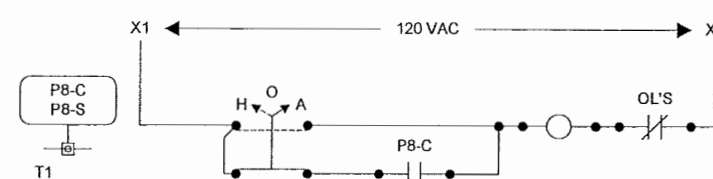

REVISION INFORMATION	Drawing Title								
NUMBER	HOT WATER SYSTEM FLOW								
DATE	04/17/08			1		RECORD DRAWINGS		03/30/08	WCS
TIME	09:48 AM								
FILE NAME	Hwsf.vsd								
Project Title		DANE COUNTY COURTHOUSE 215 SOUTH HAMILTON ST. MADISON, WI 53703		Branch Information		Madison Branch 2400 Kilgust Road Madison WI 53713 Phone: 608-222-9100 Fax: 608-222-9490		CONTRACT NUMBER 0 3109-0044	
		JOHNSON CONTROLS Systems & Services Division		BY		DATE		DRAWING NUMBER 3.1	

BILL OF MATERIALS

Designation	Qty	Part Number	Description
Field Devices:			
C1CW-VLV, C2CW-VLV	0	VALVE	SEE VALVE SCHEDULE
V			
CH-FLOW, FLOW-DIR	1	F-STD-INSTL1	INSTALL KIT, STD, WELDED
	1	FB-1211	FLOW METER, BI-DIR ISO-ANALOG OUT
CT2XS-T, CT2ABR-T, CT1X-T, CWS-T, CHX-T	8	TE-631AP-1	SENSOR, T-NI, 0.1%, F/WZ1000-5 WELL
	8	WZ-1000-5	WELL, BRASS, 2-3/8IN, 1/2IN NPT+COMPOUND

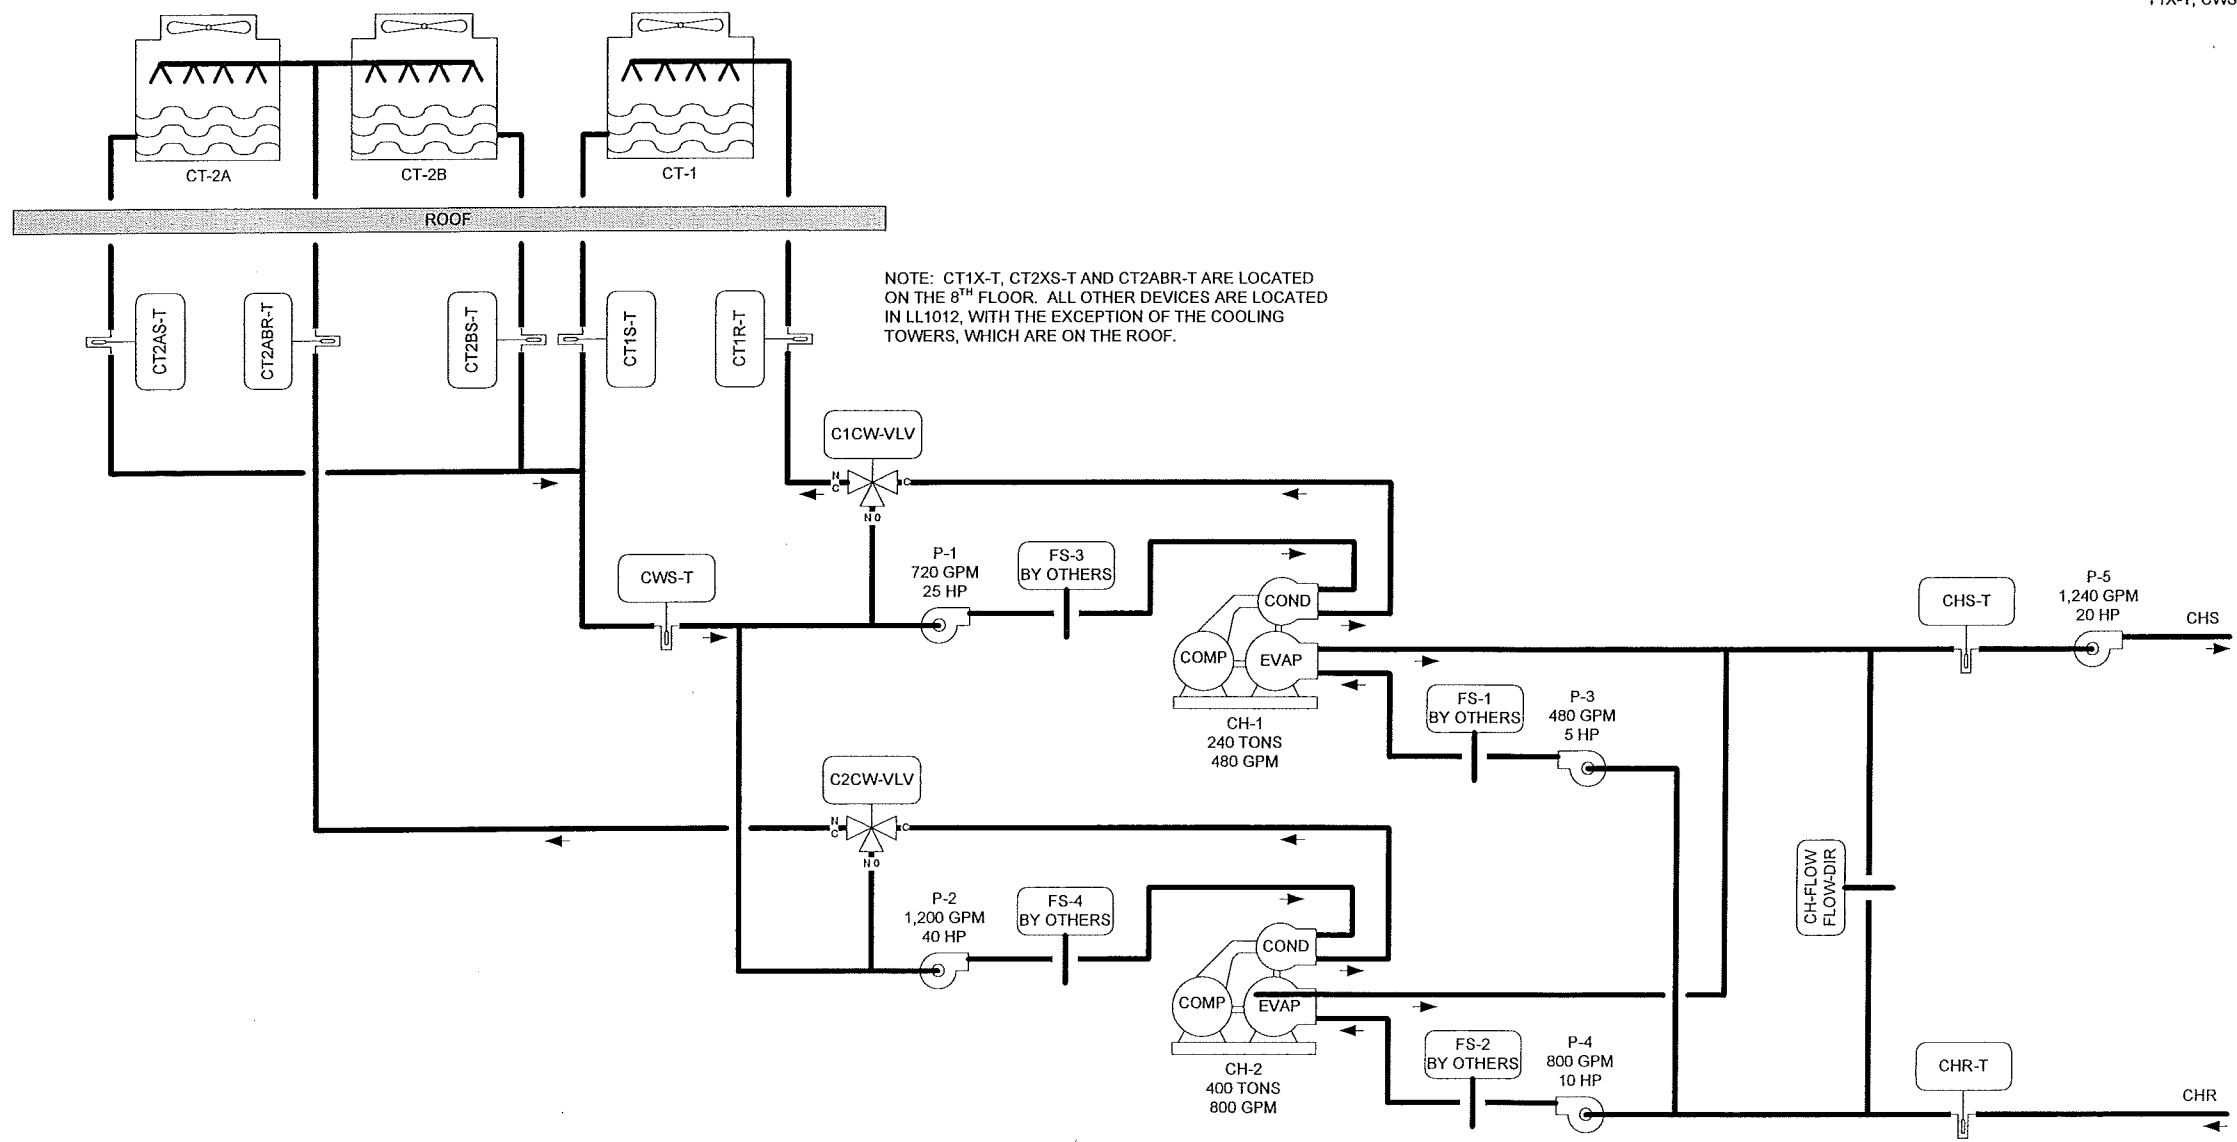

REVISION INFORMATION	Drawing Title				
NUMBER	CHILLED WATER SYSTEM FLOW	1		RECORD DRAWINGS	03/30/08 WCS
DATE	04/17/08	REFERENCE DRAWING	NO.	REVISION-LOCATION	ECN
TIME	09:47 AM	SALES ENGINEER	PROJECT MANAGER	APPLICATION ENGINEER	DATE
FILE NAME	chsf.vsd	GLA	SEL	RJM	DATE
Project Title		Branch Information		CONTRACT NUMBER	
DANE COUNTY COURTHOUSE 215 SOUTH HAMILTON ST. MADISON, WI 53703		 Systems & Services Division		Madison Branch 2400 Kilgust Road Madison WI 53713 Phone: 608-222-9100 Fax: 608-222-9490	
				0 3109-0044	
				DRAWING NUMBER	
				4.1	

EF6-S \ DI-1 (1-2A-DI-1) 2/18 ORG	OA-T \ AI-1 (1-1-AI-1) 2/18 YEL	FROM LAST N2 DEVICE (N2) 3/18
KEF1-S \ DI-2 (1-2A-DI-2) 2/18 ORG	HWS-T \ AI-2 (1-1-AI-2) 2/18 YEL	TO NEXT N2 DEVICE (N2) 3/18
REF-ALM \ DI-3 (1-2A-DI-3) 2/18 ORG	CH-FLOW \ AI-3 (1-1-AI-3) 2/18 YEL	P6-C \ DO-3 (1-1-DO-3) 2/18 VIO
SNWMLT-S \ DI-4 (1-2A-DI-4) 2/18 ORG	CHS-T \ AI-4 (1-1-AI-4) 2/18 YEL	P8-C \ DO-4 (1-1-DO-4) 2/18 VIO
P2-C \ DO-5 (1-2A-DO-5) 2/18 VIO	CHR-T \ AI-5 (1-1-AI-5) 2/18 YEL	P3-C \ DO-5 (1-1-DO-5) 2/18 VIO
CH1-E \ DO-6 (1-2A-DO-6) 2/18 VIO	CWS-T \ AI-6 (1-1-AI-6) 2/18 YEL	P4-C \ DO-6 (1-1-DO-6) 2/18 VIO
CH2-E \ DO-7 (1-2A-DO-7) 2/18 VIO	MECH-T \ AI-7 (1-1-AI-7) 2/18 YEL	P5-C \ DO-7 (1-1-DO-7) 2/18 VIO
EF6-C \ DO-8 (1-2A-DO-8) 2/18 VIO	KITCH-T \ AI-8 (1-1-AI-8) 2/18 YEL	P1-C \ DO-8 (1-1-DO-8) 2/18 VIO
KEF1-C \ DO-5 (1-2B-DO-5) 2/18 VIO	1/3-VLV \ AO-1 (1-1-AO-1) 2/18 TAN / 18GRAY	P6-S \ DI-1 (1-1-DI-1) 2/18 ORG
SNWMLT-E \ DO-6 (1-2B-DO-6) 2/18 VIO	2/3-VLV \ AO-2 (1-1-AO-2) 2/18 TAN / 18GRAY	P8-S \ DI-2 (1-1-DI-2) 2/18 ORG
	C1CW-VLV \ AO-9 (1-1-AO-9) 2/18 TAN / 18GRAY	P3-S \ DI-3 (1-1-DI-3) 2/18 ORG
	C2CW-VLV \ AO-10 (1-1-AO-10) 2/18 TAN	P4-S \ DI-4 (1-1-DI-4) 2/18 ORG
	EF6-DPR \ AO-11 (1-1-AO-11) 2/18 TAN / 18GRAY	P5-S \ DI-5 (1-1-DI-5) 2/18 ORG
		P1-S \ DI-6 (1-1-DI-6) 2/18 ORG
		P2-S \ DI-7 (1-1-DI-7) 2/18 ORG
		FLOW-DIR \ DI-8 (1-1-DI-8) 2/18 ORG



REVISION INFORMATION	Drawing Title					
NUMBER	CHILLED WATER SYSTEM FIELD POINTS		1	RECORD DRAWINGS	03/30/08	WCS
DATE	04/17/08	REFERENCE DRAWING	NO.	REVISION-LOCATION	ECH	DATE
TIME	09:47 AM	GLA	SEL	RJM	BY	DATE
FILE NAME	chsfp1.vsd	Project Title	DANE COUNTY COURTHOUSE 215 SOUTH HAMILTON ST. MADISON, WI 53703		Branch Information Madison Branch 2400 Kilgust Road Madison WI 53713 Phone: 608-222-9100 Fax: 608-222-9490	
		JOHNSON CONTROLS Systems & Services Division		CONTRACT NUMBER 0 3109-0044		DRAWING NUMBER 4.3

FROM LAST N2 DEVICE (N2) 3/18
 TO NEXT N2 DEVICE (N2) 3/18
 CT1S-T\AI-1 (9-14-AI-1)-2/18 YEL
 CT1R-T\AI-2 (9-14-AI-2)-2/18 YEL
 CT2AS-T\AI-3 (9-14-AI-3)-2/18 YEL
 CT2BS-T\AI-4 (9-14-AI-4)-2/18 YEL
 CT2ABR-T\AI-5 (9-14-AI-5)-2/18 YEL
 CT1-O\AO-1 (9-14-AO-1)-2/18 TAN
 CT2A-O\AO-2 (9-14-AO-2)-2/18 TAN
 CT2B-O\AO-3 (9-14-AO-3)-2/18 TAN
 SCF2-DPR\AO-4 (9-14-AO-4)-2/18TAN / 18GRAY
 CT1-C\BO-1 (9-14-BO-1)-2/18 VIO
 CT2A-C\BO-2 (9-14-BO-2)-2/18 VIO
 CT2B-C\BO-3 (9-14-BO-3)-2/18 VIO

REVISION INFORMATION	Drawing Title								
NUMBER	CHILLED WATER SYSTEM FIELD POINTS		1	RECORD DRAWINGS		03/30/08	WCS		
DATE	04/17/08	REFERENCE DRAWING	NO.	REVISION-LOCATION	ECH	DATE	BY	APPROVED	
TIME	09:46 AM	GLA	SEL	RJM	BY	DATE	BY	DATE	
FILE NAME	chsfp2.vsd	Project Title		DANE COUNTY COURTHOUSE 215 SOUTH HAMILTON ST. MADISON, WI 53703		Branch Information		JOHNSON CONTROLS Systems & Services Division Madison Branch 2400 Kilgust Road Madison WI 53713 Phone: 608-222-9100 Fax: 608-222-9490	
						CONTRACT NUMBER		0 3109-0044	
						DRAWING NUMBER		4.4	

BILL OF MATERIALS


Designation	Qty	Part Number	Description
Panel Devices:			
DX-1	1	AS-LCPKEY-0	CNTRLR,LCP SERVICE KEY
	1	DX-9100-8454	CNTRLR,DIG,DX,8AI,8AO,6BO,8BI
	1	DX-9100-8990	CNTRLR,DIG,DX,MTG BASE,F/ DX-9170-8454
	1	DX-9100-8991	KIT,CNTRLR,DIG,DX,WIRING PROTECTION
P-1	1	PAN-ENC2436WDP	PANEL, HOFFMAN 24X36X9 PERF-SUB W/ DOOR
RC-1	1	PD-117-02	RECEPTACLE DUPLEX IVORY
	1	PD-121-01	BOX COVER RECPT,EAGLE 2510
	1	PD-121-14	HANDY BOX, 2-1/8IN DEEP
TAG-1	1	NAMETAG-CUSTOM	1"X3" TAG, 3-LINES MAX, CUSTOM PNL FACE
TB-1	2	PD-113-44	END CLAMP, WIELAND Z5.522.8553.0
	10	PD-113-52	TERM BLK,6-SQ-MM WIRE SLOT,WIELAND
	1	PD-113-53	END PLATE F/113-52 TERM BLK,WIELAND
TB-PWR	1	PD-112-09	CIRCUIT BREAKER,10A,SQ-D QOU-110
	2	PD-113-44	END CLAMP, WIELAND Z5.522.8553.0
	2	PD-113-52	TERM BLK,6-SQ-MM WIRE SLOT,WIELAND
	1	PD-113-53	END PLATE F/113-52 TERM BLK,WIELAND
TX-x	2	PD-114-02	XFMR,120/24VAC,96VA
XP-x	2	XP-9104-8304	CNTRLR,DIG,DX EXPN MOD,4BI,4BO,2/XT
XT-2	1	XT-9100-8304	CNTRLR,DIG,DX EXTENSION MODULE,8/DX

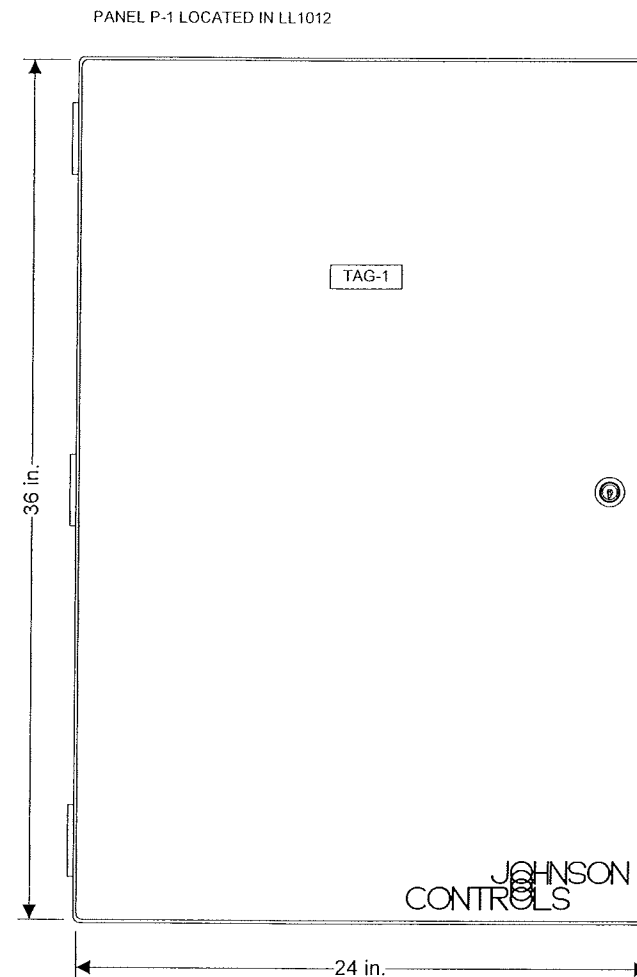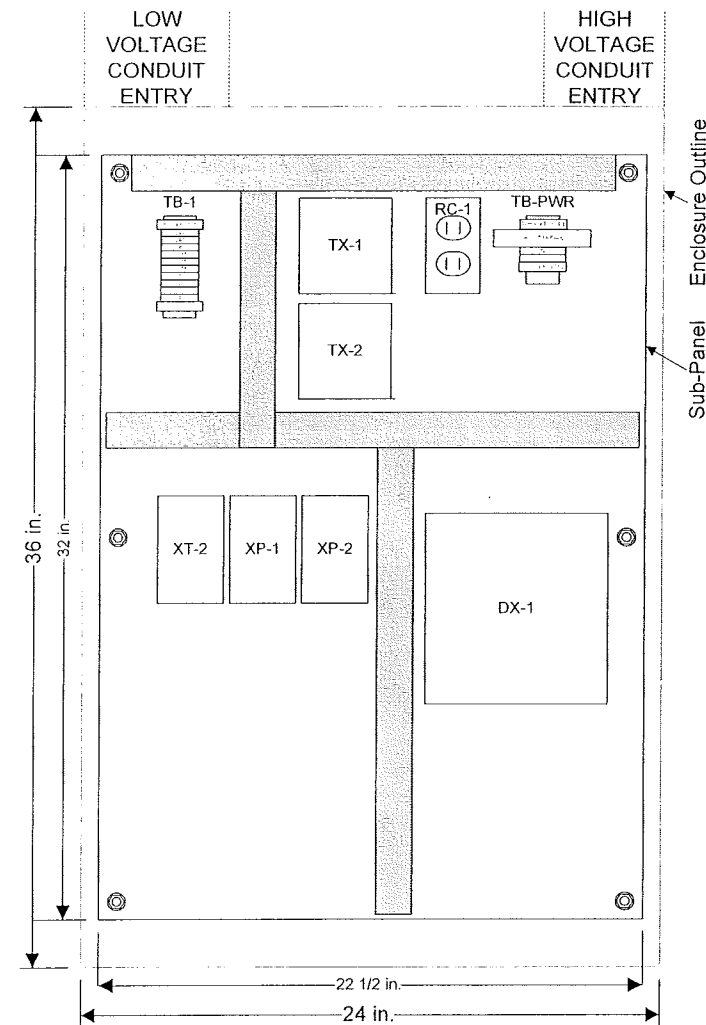


PANEL FACE TAGS:
 TAG-1: PANEL P-1 HWS & CHS
 JCI 0 3109-0044

REVISION INFORMATION	Drawing Title							
NUMBER	CHILLED WATER SYSTEM PANEL 1 LOCATED IN LL1012		1		RECORD DRAWINGS		03/30/08 CSW	
DATE	04/18/08		REFERENCE DRAWING	NO.	REVISION-LOCATION		ECH	DATE
TIME	04:17 PM		SALES ENGINEER	PROJECT MANAGER	APPLICATION ENGINEER		BY	DATE
FILE NAME	chsp1.vsd		GLA	SEL	RJM		BY	DATE
Project Title			Branch Information			CONTRACT NUMBER		
DANE COUNTY COURTHOUSE 215 SOUTH HAMILTON ST. MADISON, WI 53703			 Madison Branch 2400 Kilgust Road Madison WI 53713 Phone: 608-222-9100 Fax: 608-222-9490			0 3109-0044		
			Systems & Services Division			DRAWING NUMBER		
						4.5		

LINE VOLTAGE WIRING DIAGRAM

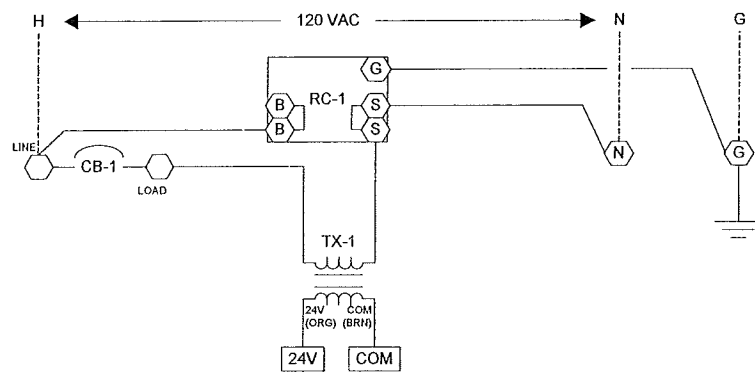

LOW VOLTAGE WIRING DIAGRAM

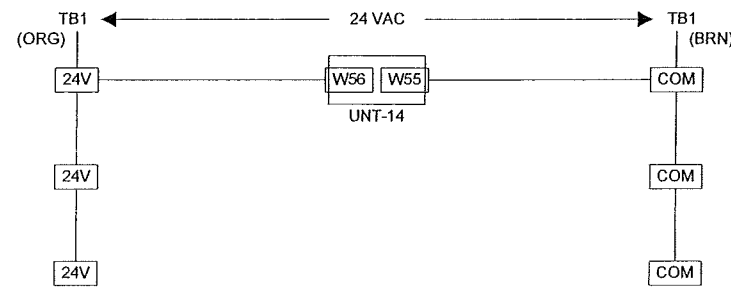

Wiring Legend

- Pneumatic Tubing
- Low Voltage Terminal
- ▭ Cable
- ⬡ Line Voltage Terminal
- Panel Wiring by JCI
- - - Field Wiring by Others
- ⚡ VAC Power

REVISION INFORMATION		Drawing Title			
NUMBER		CHILLED WATER SYSTEM PANEL P-9 WIRING			
DATE		04/17/08			
TIME		09:45 AM			
FILE NAME		chspw2.vsd			
REFERENCE DRAWING		NO. 1 REVISION-LOCATION RECORD DRAWINGS			
DATE		03/30/08 WCS			
SALES ENGINEER		PROJECT MANAGER		APPLICATION ENGINEER	
GLA		SEL		RJM	
DRAWN		BY		DATE	
DATE		DATE		DATE	
BRANCH INFORMATION		CONTRACT NUMBER			
JOHNSON CONTROLS Systems & Services Division		0 3109-0044			
Madison Branch 2400 Kilgust Road Madison WI 53713 Phone: 608-222-9100 Fax: 608-222-9490		DRAWING NUMBER			
		4.8			

WATER COOLED CHILLERS (2):

General:

Control electronically with stand-alone HVAC Node (HN).

The chillers will be connected to the JCI system via the LON bus. LON bus communications will provide monitoring of all data available at the drives via the FMS. Install Communications Interfaces furnished by the chiller manufacturer. Provide all necessary wiring between communications interfaces and FMS.

The FMS will monitor the common chilled water and condenser water supply and return temperatures.

System Off:

Chillers and associated chilled water and condenser water pumps will be off.

Cooling towers fan off.

Cooling tower bypass valve closed to tower.

System Start:

The FMS will monitor the position of all control valves. When there is a call for cooling in the building (any cooling coil valve open) the lead chiller (operator selectable) will be indexed to operate: Associated chilled water and condenser water pumps will start. Chiller will be enabled to start when proof of flow has been established. The lead chiller will operate for a minimum of 15 minutes (adj.).

System Run:

The FMS will monitor the direction and amount of flow in the chilled water bypass line.

Lag Chiller Operation:

Lag chiller will be prevented from operating until 30 minutes (adj.) after initial system start-up.

Lag chiller will be indexed to operate when the flow in the bypass line from return to supply is equal to or greater than 80% of the chiller % of load of the lag chiller for 15 minutes (adj.).

Lag chiller will be de-energized when the flow in the bypass line from supply to return is less than 80% of the chiller % of load of the lag chiller for 15 minutes (adj.).

The lead chiller will continue to operate to meet the building cooling load.

System Stop:

When there is no call for cooling and/or all air handling units are de-energized:

Lead chiller will be disabled.

Associated chilled water and condenser water pumps will continue to run for 2 minutes (adj.) after chiller shutdown and then be stopped.

The chilled water pumps are stopped.

Chiller system will remain off for a minimum of 15 minutes (adj.).

Safeties and Alarms:

The chiller microprocessors will annunciate discrete alarm conditions.

When a chiller alarm is initiated, the discrete alarm condition causing the alarm will be annunciated at the operator workstation.

Annunciate off-normal alarm whenever chiller status does not equal command.

Refer also to the Point List.

Failure and Modes:

Chiller Failure: If a chiller fails to operate, the chiller will be disabled and alarm will be annunciated at the operator workstation. Associated pumps will be stopped. The other chiller will be started as described above.

Pump Failure: If a pump fails to operate, its associated chiller will shut down and alarm will be annunciated at the operator workstation. Pumps will be disabled.

Sensor Failure: Upon the failure of an internal analog sensor, the chiller operating controls will shutdown the chiller. Upon the failure of an FMS analog sensor, an alarm will be annunciated at the operator workstation.

COOLING TOWERS (3):

General:

Control electronically with stand-alone HVAC Node (HN).

Totalize runtime of the tower fans and condenser water pumps.

The drives will be connected to the JCI system via the N2 bus. N2 bus communications will provide monitoring of all data available at the drives via the FMS. Install Communications Interfaces furnished by the VFD manufacturer. Provide all necessary wiring between communications interfaces and FMS.

The FMS will monitor the common condenser water supply and return temperatures.

System Off:

Chillers and associated chilled water and condenser water pumps, and the tower fans will be off.

Cooling tower bypass valve closed to towers.

System Start:

When there is a call for cooling in the building, and a chiller is enabled to operate:

The condenser water pump will start.

The cooling tower bypass valve will be controlled by the chiller to maintain the optimum condenser water supply temperature set point by modulating from full closed to the tower to full open to the tower.

When the condenser water supply temperature rises to the maximum condenser water set point (85 degrees F, adj.), the cooling tower fan will be modulated to maintain the set point.

System Run:

The FMS will monitor the chilled water supply temperature.

The tower will continue to operate to maintain the condenser water supply temperature set point.

When the lead tower fan has been modulated to its minimum speed for 15 minutes (adj.) and the condenser water temperature drops to the minimum condenser water supply temperature, the VFD will be de-energized. The cooling tower bypass valve will be modulated to maintain the set point.

System Stop:

When there is no call for cooling and/or all air handling units are de-energized:

Lead chiller will be disabled.

Associated chilled water and condenser water pumps will continue to run for 2 minutes (adj.) after chiller shutdown and then be stopped.

The cooling tower fan will be de-energized.

The cooling tower bypass valve will close to the towers.

Safeties and Alarms:

The VFD microprocessors will annunciate discrete alarm conditions.

Annunciate off-normal alarm whenever VFD status does not equal command.

Refer also to the Point List.

Failure Modes:

Tower Fan Failure: If a tower fan fails to operate an alarm will be annunciated at the operator workstation.

Condenser Water Pump Failure: If an operating pump fails, an alarm will be annunciated at the operator workstation.

Sensor Failure: Upon the failure of an FMS analog sensor, an alarm will be annunciated at the operator workstation.

PRIMARY LOOP CHILLED WATER CONSTANT FLOW - 1 PUMP:

General:

Totalize runtime of the chilled water pump.

System Off:

The chilled water pumps will be off.

System Start:

When the outdoor air temperature rises above the cooling system enable set point (55 degrees F, adj.) and there is a call for mechanical cooling, the chilled water pump P-5 will start.

A pump will operate for a minimum of 30 minutes (adj.).

System Run:

The chilled water pump will run continuously when there is a call for chilled water.

System Stop:

When the outdoor air temperature falls below the cooling system enable set point (55 degrees F, adj.), the chilled water pump will stop.


Safeties and Alarms:

Annunciate off-normal alarm whenever pump status does not equal command.

Refer also to Point List.


Failure Mode:

Pump Failure: If a pump fails to operate, an alarm will be annunciated.


REVISION INFORMATION	Drawing Title								
NUMBER	SEQUENCE		1	RECORD DRAWINGS		03/30/08	WCS		
DATE	04/17/08	REFERENCE DRAWING	NO.	REVISION-LOCATION	ECN	DATE	BY		
TIME	08:24 AM	SALES ENGINEER	PROJECT MANAGER	APPLICATION ENGINEER	BY	DATE	BY	DATE	
FILE NAME	chss.vsd	GLA	SEL	RJM					
	Project Title				Branch Information Madison Branch 2400 Kilgust Road Madison WI 53713 Phone: 608-222-9100 Fax: 608-222-9490		CONTRACT NUMBER 0 3109-0044		
	DANE COUNTY COURTHOUSE 215 SOUTH HAMILTON ST. MADISON, WI 53703	Systems & Services Division					DRAWING NUMBER 4.9		

Electrician/Fitter		Point Information			Controller Information					Panel Information				Intermedi		Field Device					
Tag	Point Type	System Name	Object Name	Expanded ID	Controller Type	Trunk Nbr	Trunk Addr.	Cable Destination Bay/Terminal	Module Type	Termination Out	Panel	Panel Location	Slot Number	Reference Drawing	Cable Number	Wiring /Tubing	Termination In	Device	Location	Ref Detail Shape	Comment
					UNT1100						P-9	8045									Power to Controller N2 Trunk
AI-1	CHS	CT1S-T	Clg Twr 1 CW Sup Temp		UNT1100	2	14		AI1,AICM	P-9	8045	0									UC131
AI-2	CHS	CT1R-T	Clg Twr 1 CW Ret Temp		UNT1100	2	14	AI-2	AI2,AICM	P-9	8045	0		9-14-AI-1	2/18 YEL	2-Wire	TE				UC131
AI-3	CHS	CT2AS-T	Clg Twr 2A CW Sup Temp		UNT1100	2	14	AI-3	AI3,AICM	P-9	8045	0		9-14-AI-2	2/18 YEL	2-Wire	TE				UC131
AI-4	CHS	CT2BS-T	Clg Twr 2B CW Sup Temp		UNT1100	2	14	AI-4	AI4,AICM	P-9	8045	0		9-14-AI-3	2/18 YEL	2-Wire	TE				UC131
AI-5	CHS	CT2ABR-T	Clg Twr 2A-B CW Ret Tem		UNT1100	2	14	AI-5	AI5,AICM	P-9	8045	0		9-14-AI-4	2/18 YEL	2-Wire	TE				UC131
AI-6					UNT1100	2	14	AI-6		P-9	8045	0		9-14-AI-5	2/18 YEL	2-Wire	TE				
BI-1					UNT1100	2	14	BI-1		P-9	8045	0		9-14-BI-1							
BI-2					UNT1100	2	14	BI-2		P-9	8045	0		9-14-BI-2							
BI-3					UNT1100	2	14	BI-3		P-9	8045	0		9-14-BI-3							
BI-4	CHS	TR1-FILL			UNT1100	2	14	BI-4		P-9	8045	0		9-14-BI-4							
BI-6	CHS	TR2-FILL			UNT1100	2	14	BI-6		P-9	8045	0		9-14-BI-6							
BI-7					UNT1100	2	14	BI-7		P-9	8045	0		9-14-BI-7							
AO-1	CHS	CT1-O	Clg Tower 1 VSD Cmd		UNT1100	2	14	AO-1	AO1,AOCM	P-9	8045	0		9-14-AO-1	2/18 TAN	See wiring detail	Output (Voltage)				UC201
AO-2	CHS	CT2A-O	Clg Tower 2A VSD Cmd		UNT1100	2	14	AO-2	AO2,AOCM	P-9	8045	0		9-14-AO-2	2/18 TAN	See wiring detail	Output (Voltage)				UC201
AO-3	CHS	CT2B-O	Clg Tower 2B VSD Cmd		UNT1100	2	14	AO-3	AO3,AOCM	P-9	8045	0		9-14-AO-3	2/18 TAN	See wiring detail	Output (Voltage)				UC201
AO-4	CHS	SCF2-DPR	SCF-2 Inlet Damper Cmd		UNT1100	2	14	AO-4	AO4,AOCM / 24VAC	P-9	8045	0		9-14-AO-4	2/18TAN / 2/185, 1/1, 2	See wiring detail	M-9216 (Ext Source)				UC264
BO-1	CHS	CT1-C	Cooling Tower 1 Cntl		UNT1100	2	14	BO-1	BO1(NO),24V Com	P-9	8045	0		9-14-BO-1	2/18 VIO	See wiring detail	24VAC OUT				UC504
BO-2	CHS	CT2A-C	Cooling Tower 2A Cntl		UNT1100	2	14	BO-2	BO2(NO),24V Com	P-9	8045	0		9-14-BO-2	2/18 VIO	See wiring detail	24VAC OUT				UC504
BO-3	CHS	CT2B-C	Cooling Tower 2B Cntl		UNT1100	2	14	BO-3	BO3(NO),24V Com	P-9	8045	0		9-14-BO-3	2/18 VIO	See wiring detail	24VAC OUT				UC504
BO-4					UNT1100	2	14	BO-4		P-9	8045	0		9-14-BO-4							


DETAIL UC131 TEMPERATURE SENSOR INPUT

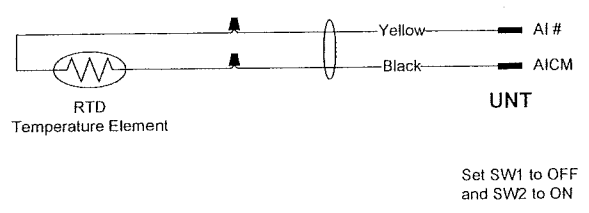


DETAIL UC201 ANALOG OUTPUT (VOLTAGE)

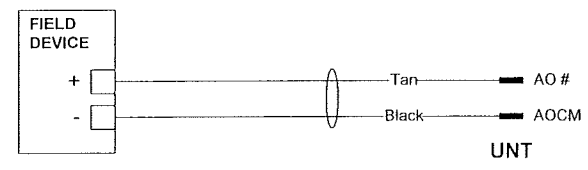

DETAIL UC264 0-10VDC OUTPUT to M-9216

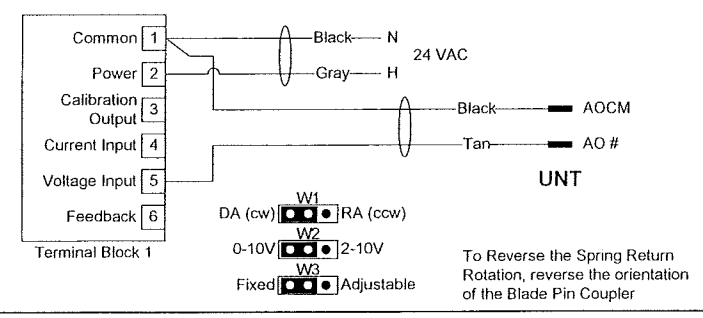


DETAIL UC504 24 VAC BINARY OUTPUT

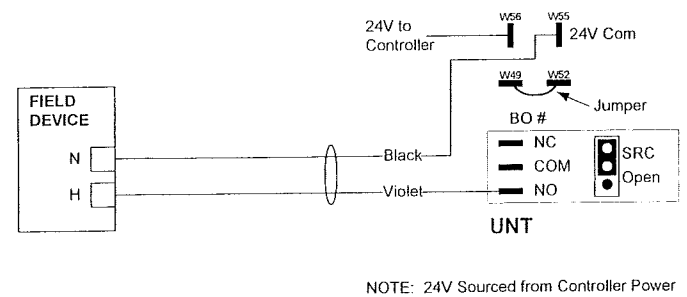



REVISION INFORMATION	Drawing Title									
NUMBER	POINT SCHEDULE									
DATE	04/18/08		REFERENCE DRAWING		NO.		REVISION-LOCATION		ECN DATE BY	
TIME	04:19 PM		Sales Engineer		Project Manager		Application Engineer		DRAWN APPROVED	
FILE NAME	chsp3.vsd		GLA		SEL		RJM		BY DATE BY DATE	
	Project Title		Appleton Branch		2140 American Drive		Neenah		CONTRACT NUMBER	
	DANE COUNTY COURTHOUSE		WI 54956		Phone: 920-739-2461		Fax: 920-739-4782		0 3109-0044	
	MADISON, WI		Systems & Services Division						DRAWING NUMBER	
									4.12	

BILL OF MATERIALS

Designation	Qty	Part Number	Description
Field Devices:			
CLG-VLV, HTG-O	0	VALVE	SEE VALVE SCHEDULE
DA-H, DA-T	1	HE-67N3-0N00P	SENSOR,3%RH & 1K NI TEMP,DUCT-PROBE
FILTER-S	1	P32AC-2C	PRESS SW,DP,SPDT,5IN WC,U-BRKT
HUM-O	1	HL-87N5-8N00P	HI-LIMIT,5%RH & 1K NI TMP,WHT,DUCT-PROBE
MA-DPR, HTG-O	0	DAMPER	SEE DAMPER SCHEDULE
MA-T	1	TE-6316P-1	SENSOR,T-NI,0.1%,17FT AVG
MA-T, TS-x	10	TE-6001-8	CLIP F/AVG ELEMENT,10-PACK
PS-x	2	AFS-460	AIR FLOW SW,SPST,NC RESET 0.05-12IN
R-x	2	RIBU1C	10AMP SPDT 10-30VAC/DC/120VAC
RA-CO2, OA-CO2, DA-CO2	3	CD-P00-00-0	SENSOR,CO2, 0-2000PPM,DUCT MOUNT
RA-T	1	TE-6311P-1	SENSOR,T-NI,0.1%,8IN DUCT
RA-V	1	STA104-F	EBTRON-FAN INLET AIR FLOW MEASURING STN-JMB ASSOC.
SA-V	1	STA104-F	EBTRON-FAN INLET AIR FLOW MEASURING STN-JMB ASSOC.
SF-C, CS-1, RF-C, RF-S	2	H738	SENS,CURR,1A @30VAC/DC,1/3HP,CMND RELAY
ST-1, ST-2, ST-4	3	FTG18A-600R	SENSING TUBE KIT, F/P32
ST-3	1	A-302	DWYER-STATIC PRESSURE TIP, 1/4" BARB-KELE
	1	A-345	DWYER-FLANGE MOUNTING KIT FOR A-302-KELE
TS-4	1	A19ABB-2C	STAT,CROP DRY,SPST,-30/50F,BULB,OPEN LO
TS-x	3	A70BA-18C	STAT,LL,20FT ELEMENT,MANUAL,15/55F

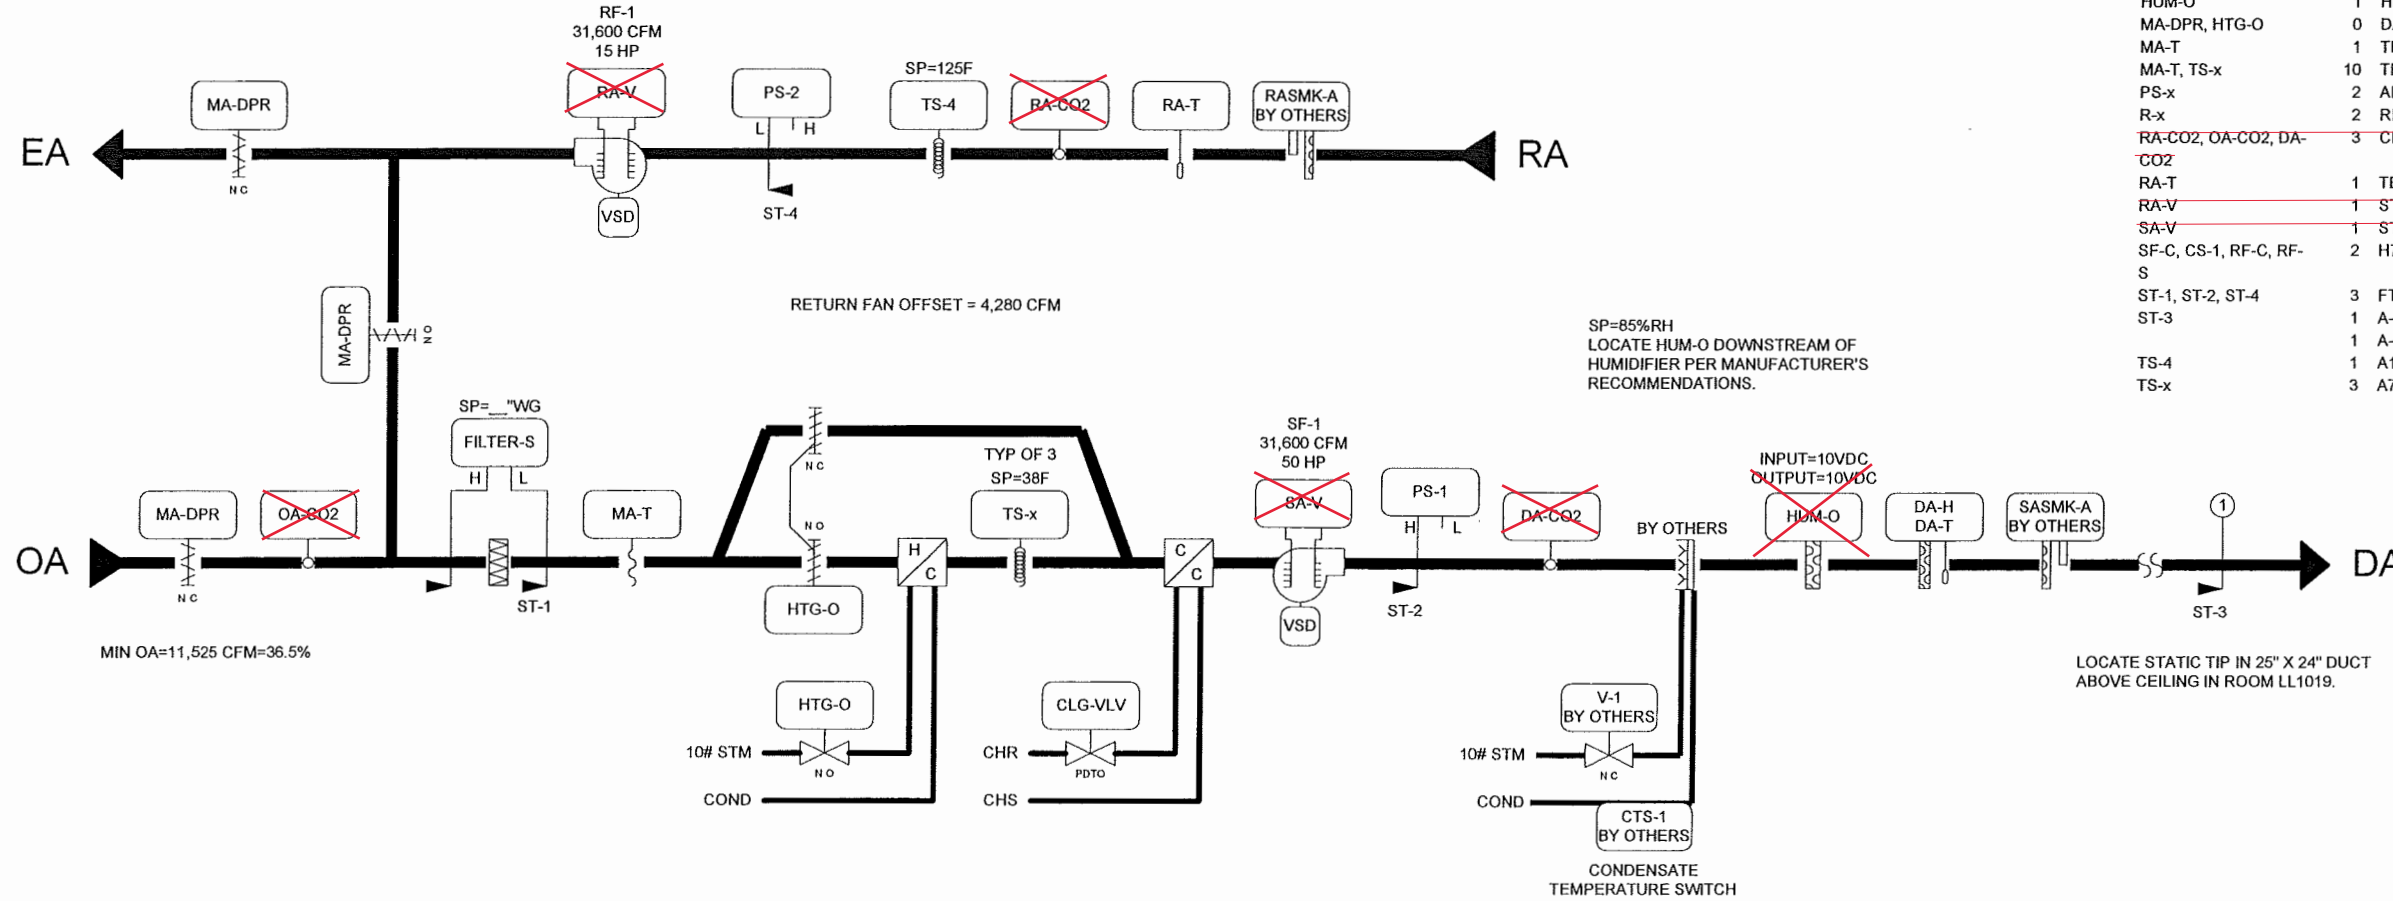



Note: "X" items are no longer in the control sequence.

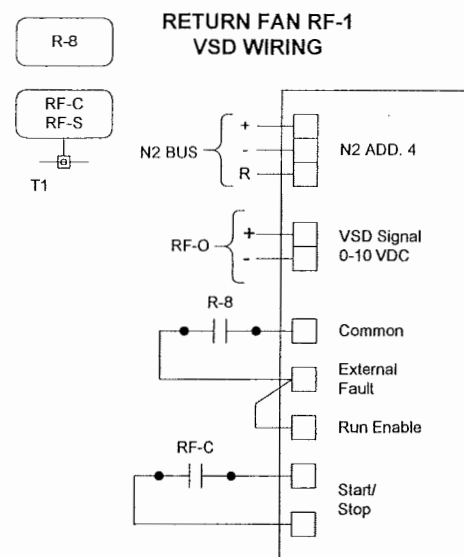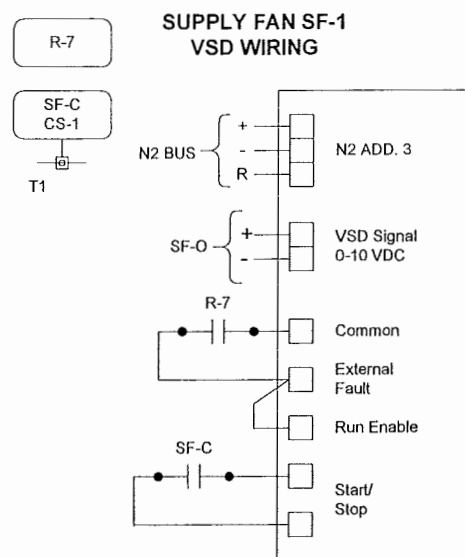

REVISION INFORMATION	Drawing Title				
NUMBER	AHU-1 FLOW				
DATE	04/17/08				
TIME	08:24 AM				
FILE NAME	ahu1f.vsd				
Project Title		DANE COUNTY COURTHOUSE 215 SOUTH HAMILTON ST. MADISON, WI 53703		CONTRACT NUMBER	
		JOHNSON CONTROLS Systems & Services Division		0 3109-0044	
		Madison Branch 2400 Kilgust Road Madison WI 53713 Phone: 608-222-9100 Fax: 608-222-9490		DRAWING NUMBER	
				5.1	

BILL OF MATERIALS


Designation	Qty	Part Number	Description
Panel Devices:			
DA-SP	1	DPT2640-2R5B	XMTR,DIFF PR,AIR,-2.5/2.5"WC,0-5VDC,0.5%
DX-5	1	AS-LCPKEY-0	CNTRLR,LCP SERVICE KEY
	1	DX-9100-8454	CNTRLR,DIG,DX,8AI,8AO,6BO,8BI
	1	DX-9100-8990	CNTRLR,DIG,DX,MTG BASE,F/ DX-9170-8454
	1	DX-9100-8991	KIT,CNTRLR,DIG,DX,WIRING PROTECTION
P-2	1	PAN-ENC2436WDP	PANEL, HOFFMAN 24X36X9 PERF-SUB W/ DOOR
R-x, HTG-SO, HUM-E, SF-OFF, RF-OFF	10	PD-101-27	BASE F/109-38.73,74/IDEC #SH3B-05
	10	PD-109-74	RLY,3PDT,10A,24VAC,LED/IDEC RH3B-ULAC24V
RASMK-1, SASMK-A			
	2	PAM-1	MULTI-V RELAY MODULE,FORM C,10A,AIR PROD.
RC-1	1	PD-117-02	RECEPTACLE DUPLEX IVORY
	1	PD-121-01	BOX COVER RECPT,EAGLE 2510
	1	PD-121-14	HANDY BOX, 2-1/8IN DEEP
SAFETY-OV	1	RIB2401D	10A PILOT CONTROL RELAY,DPDT,FUNC.DEVICES
TAG-1	1	NAMETAG-CUSTOM	1"X3" TAG, 3-LINES MAX, CUSTOM PNL FACE
TB-1	2	PD-113-44	END CLAMP, WIELAND Z5.522.8553.0
	36	PD-113-52	TERM BLK,6-SQ-MM WIRE SLOT,WIELAND
	1	PD-113-53	END PLATE F/113-52 TERM BLK,WIELAND
TB-PWR	1	PD-112-09	CIRCUIT BREAKER,10A,SQ-D QOU-110
	2	PD-113-44	END CLAMP, WIELAND Z5.522.8553.0
	2	PD-113-52	TERM BLK,6-SQ-MM WIRE SLOT,WIELAND
	1	PD-113-53	END PLATE F/113-52 TERM BLK,WIELAND
	3	PD-114-02	XFMR,120/24VAC,96VA
TX-x	3	PD-114-02	XFMR,120/24VAC,96VA
XP-1	1	XP-9102-8304	CNTRLR,DIG,DX EXPN MOD,6AI,2AO,2/DX,1/XT
XP-2	1	XP-9104-8304	CNTRLR,DIG,DX EXPN MOD,4BI,4BO,2/XT
XT-6	1	XT-9100-8304	CNTRLR,DIG,DX EXTENSION MODULE,8/DX

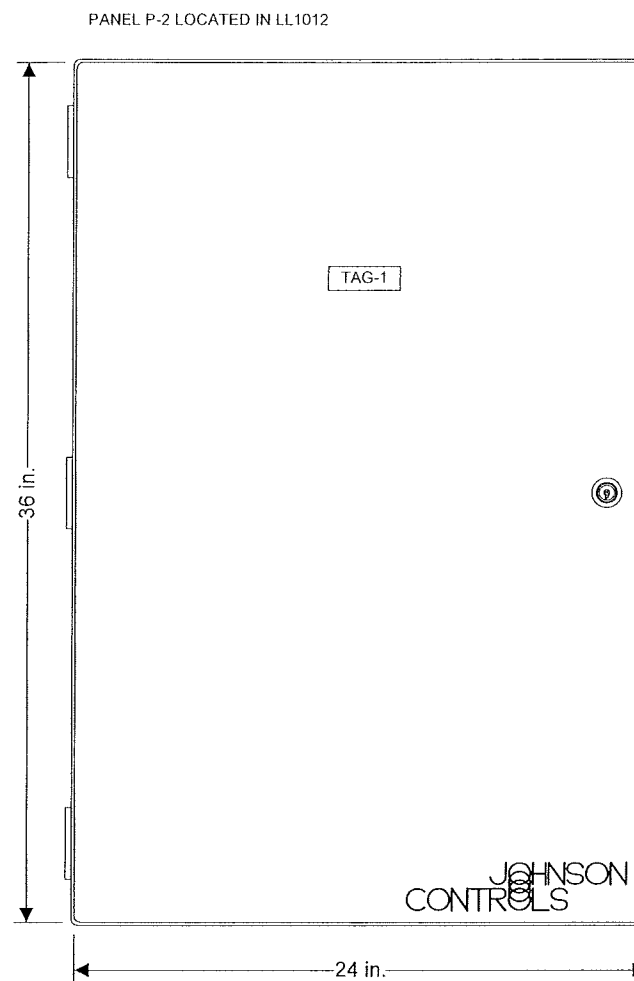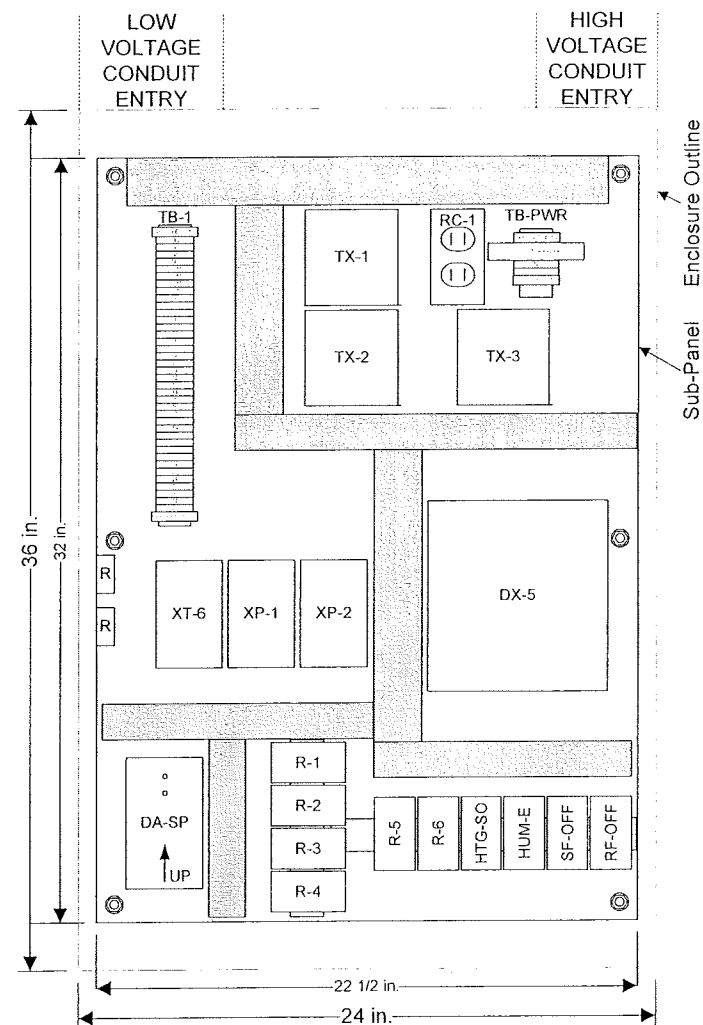


PANEL FACE TAGS:
 TAG-1: PANEL P-2
 AHU-1 SERVING LL2, LL1 & 1ST FLOORS
 JCI 0 3109-0044

REVISION INFORMATION	Drawing Title								
NUMBER	AHU-1 PANEL LOCATED IN LL1012			1		RECORD DRAWINGS		03/30/08	WCS
DATE	04/16/08	SALES ENGINEER	PROJECT MANAGER	APPLICATION ENGINEER	DRAWN		APPROVED		
TIME	01:11 PM	GLA	SEL	RJM	BY	DATE	BY	DATE	
FILE NAME	ahu1p.vsd	Project Title		Branch Information		CONTRACT NUMBER			
		DANE COUNTY COURTHOUSE 215 SOUTH HAMILTON ST. MADISON, WI 53703		Madison Branch 2400 Kilgust Road Madison WI 53713 Phone: 608-222-9100 Fax: 608-222-9490		0 3109-0044		DRAWING NUMBER 5.3	





LINE VOLTAGE WIRING DIAGRAM

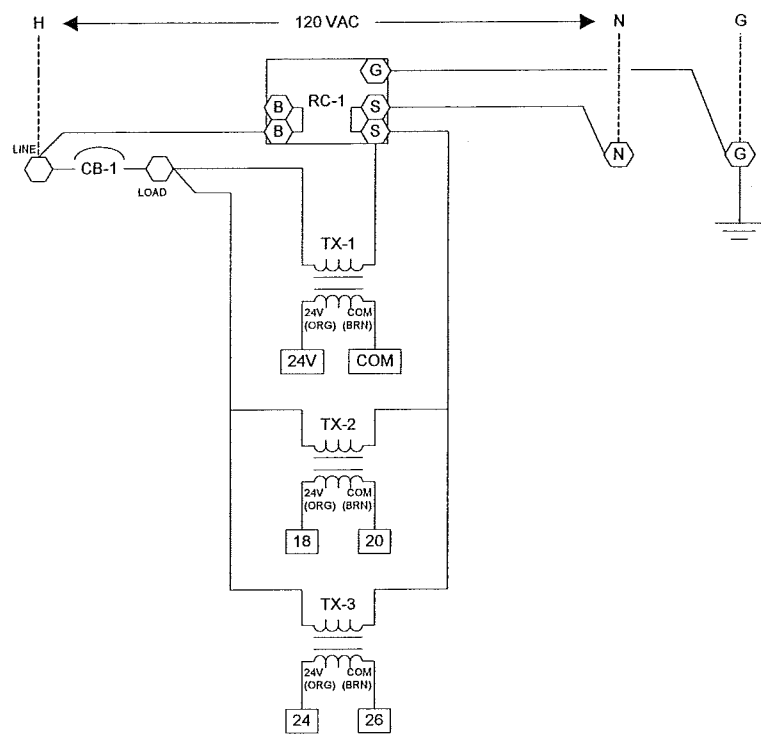

LOW VOLTAGE WIRING DIAGRAM

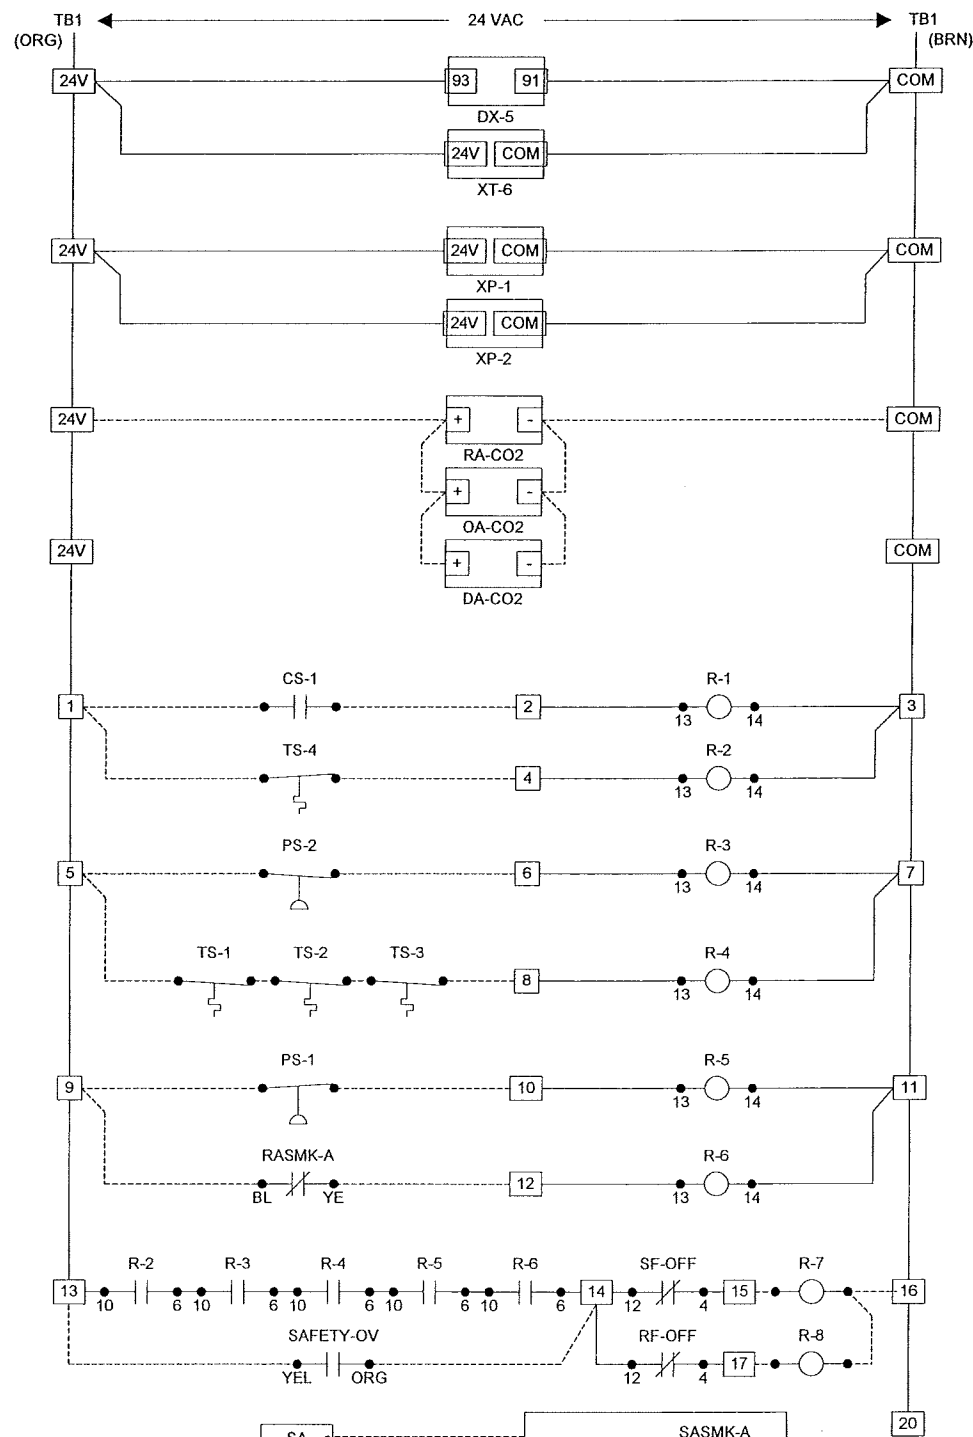

LOW VOLTAGE WIRING DIAGRAM

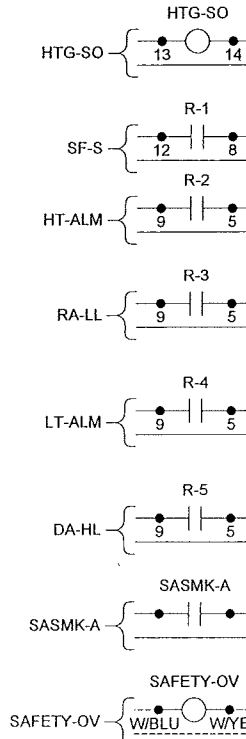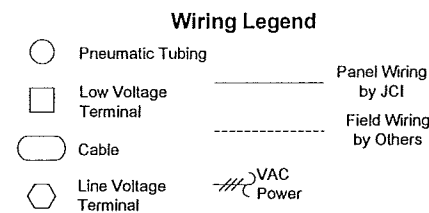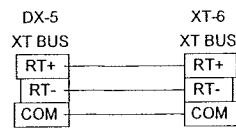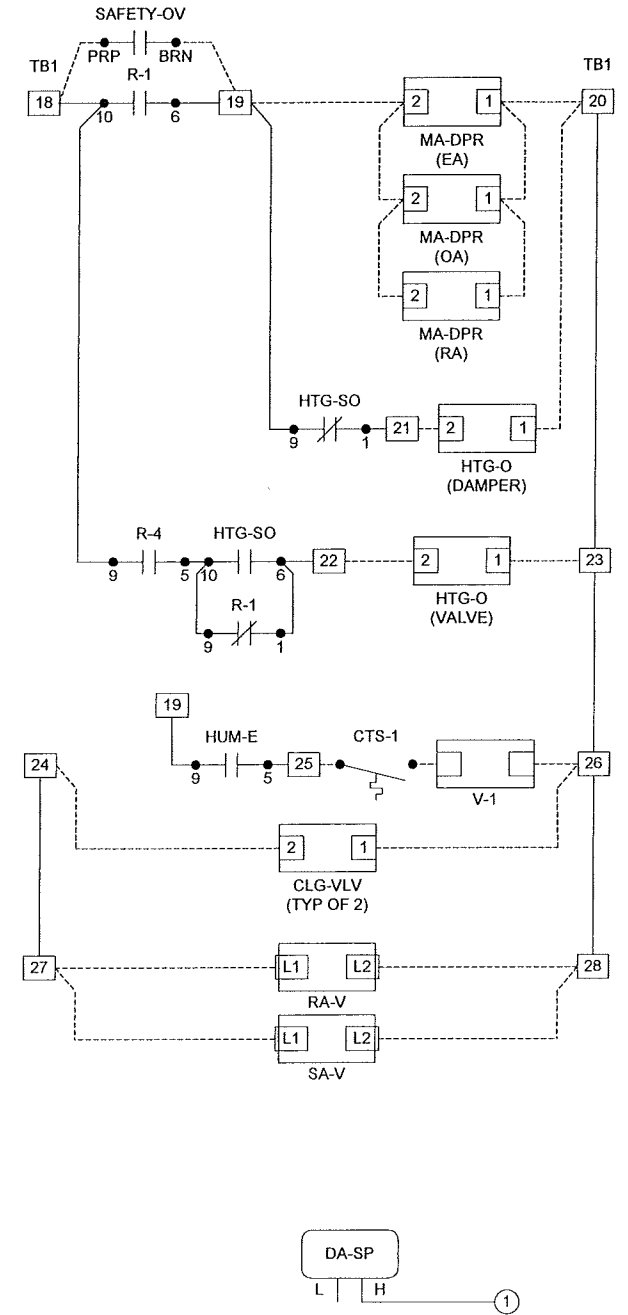

REVISION INFORMATION		Drawing Title							
NUMBER		AHU-1 PANEL WIRING		1		RECORD DRAWINGS		03/30/08 WCS	
DATE		04/16/08		NO.		REVISION LOCATION		ECN	
TIME		01:11 PM		SALES ENGINEER		PROJECT MANAGER		APPLICATION ENGINEER	
FILE NAME		ahu1pw.vsd		GLA		SEL		RJM	
Project Title		DANE COUNTY COURTHOUSE 215 SOUTH HAMILTON ST. MADISON, WI 53703		DRAWN		BY		DATE	
Branch Information		Madison Branch 2400 Kilgust Road Madison WI 53713 Phone: 608-222-9100 Fax: 608-222-9490		CONTRACT NUMBER		0 3109-0044		DRAWING NUMBER	
Systems & Services Division		JOHNSON CONTROLS						5.4	

INDOOR AIR HANDLING UNIT VARIABLE VOLUME:

General:

Control electronically with stand-alone HVAC Node (HN).

The system will operate on a timed-programmed basis as determined by the system operator (initially set to start at 7:30 AM and stop at 6:30 PM, Monday-Friday).

System Off:

The supply and return fans will be off.

The outside air damper will be closed.

The return air damper will be open.

The steam heating will be off.

The cooling coil valve will be closed.

System Start:

When the air-handling unit is indexed to operate, the return fan will start first. Following a 5-second (adj.) delay, the supply fan will start. **NOTE:** The mixed air dampers and the supply/return fans speed drives will be ramped to their respective operating values over a time period (adj., initially set to 5 minutes)

Upon proof of supply and return fan operation, dampers, cooling coil valve, and steam valve will be indexed to their "System Run" conditions.

The air handler will be commanded on during the unoccupied mode when any of the associated zones is outside the setback set point temperatures.

System On:

Unoccupied Heating Mode:

Supply and Return Fans: Supply and return fans will cycle to maintain the lowest space temperature at the unoccupied heating set point (adj.). The supply fan speed will be controlled to maintain duct static pressure at set point (adj., initially set to 1.5" water column) and the return fan speed will volume match the supply fan.

Economizer Dampers: Outside air damper is fully closed and return air damper is fully open.

Interlock supply fan with return fan. General exhaust fans will be off. Interlock (via software) supply and return fan with smoke detector in supply and return duct.

Heating Coil Valve and Face & Bypass Dampers: operate when the supply and return fans are on.

Below 40 degrees F (adj.) mixed air temperature, fully open steam heating valve and modulate the face & bypass dampers.

Above 40 degrees F (adj.) mixed air temperature, modulate the steam heating valve and opens the face and bypass dampers to maintain supply air temperature.

Cooling Coil Valve: Fully closed.

Unoccupied Cooling Mode:

Supply and Return Fans: Supply and return fans will cycle to maintain the highest space temperature at the unoccupied cooling set point (adj.). The supply fan will be controlled to maintain duct static pressure at set point (adj., initially set to 1.5" water column) and the return fan speed will volume match the supply fan.

Economizer Dampers: Economizer dampers will be enabled to provide free cooling when the outside air temperature is below the dry bulb economizer set point.

Economizer Available: Outside air and exhaust dampers are modulated open and return air damper is modulated closed to control mixed air temperature at 55°F when the supply fan is on.

Economizer Not Available: Outside air and exhaust dampers are fully closed and return air damper is fully open.

Cooling Coil Valve: Modulating when fans are on to maintain unoccupied temperature set point.

Occupied Mode:

Supply and Return Fans: Supply and return fans will run continuously. The supply fan speed will be controlled to maintain duct static pressure and the return fan speed will be controlled to maintain a volume differential (4,280 CFM) between the supply and exhaust (adj.). **Add setpoint for manual offset for return fan speed.**

Economizer Dampers: Economizer dampers will be enabled to provide free cooling when the outside air temperature is below the dry bulb economizer set point.

Economizer Available: Economizer dampers will modulate subject to a mixed air low limit of 55 degrees F (adj.).

Economizer Not Available: The economizer dampers will maintain a minimum outside air damper position (adj.).

Steam Heating and Face & Bypass Dampers: Modulate steam heating and valve in sequence with the economizer dampers to maintain the discharge air temperature at set point as reset by space temperature

Below 40 degrees F (adj.) mixed air temperature, fully open steam heating valve and modulate the face & bypass dampers.

Above 40 degrees F (adj.) mixed air temperature, modulate steam heating valve and open the face and bypass dampers to maintain supply air temperature.

Cooling Coil Valve: Modulate in sequence with the economizer dampers to maintain discharge air temperature set point.

Match existing sequence.

~~Indoor Air Quality: Provide monitoring of outside air, return air and supply air CO2 concentration, calculate and maintain fresh air requirements. Adjust outdoor air intake to ensure return air CO2 high level limit is not exceeded.~~

STEAM HUMIDIFIER:

General:

~~Control electronically with HVAC Node (HN).~~

~~Humidity monitored by duct discharge humidity sensor and controlled by a modulating control valve.~~

System Off:

The steam valve will remain closed.

System Run:

Upon proof of airflow, system will be enabled to operate.

When the duct return humidity falls below 30% relative humidity (adj.) control valve will modulate open.

Safeties and Alarms:

Humidity valve will be prevented from operating until positive proof of airflow.


Humidity High Limit: Sensor located downstream from humidifier will modulate control valve closed upon exceeding high humidity limit.

System Stop:

When the air-handling unit is indexed to shut down, the supply and return fans will stop.

Dampers and control valve will be indexed to their "System Off" conditions.

Steam Heat will shut down.

REVISION INFORMATION	Drawing Title								
NUMBER	SEQUENCE		1	RECORD DRAWINGS		03/30/08	WCS		
DATE	04/17/08	REFERENCE DRAWING	NO.	REVISION LOCATION	ECH	DATE	BY		
TIME	08:15 AM	Sales Engineer	Project Manager	Application Engineer	BY	DATE	BY	DATE	
FILE NAME	Ahu1s1.vsd	GLA	SEL	RJM	Branch Information		CONTRACT NUMBER		
	Project Title	DANE COUNTY COURTHOUSE 215 SOUTH HAMILTON ST. MADISON, WI 53703					Madison Branch 2400 Kilgust Road Madison WI 53713 Phone: 608-222-9100 Fax: 608-222-9490		0 3109-0044
					Systems & Services Division		DRAWING NUMBER		5.5

Safeties and Alarms:

Filter Condition: Monitor differential pressure across filter and annunciate alarm when differential pressure set point is exceeded.

Low limit: Manual reset low limit thermostat will stop the supply and return fans, close the outdoor air dampers, open steam heating valve on and annunciate alarm should the coil discharge air temperature fall below 38 degrees F.

High Limit: Manual reset high limit thermostat located in the return air will stop the supply and return fans and annunciate alarm should the return air temperature rise above 125 degrees F. Dampers will be indexed to their "System Off" conditions.

Static High Limit: The static high limit sensor located in the discharge of the supply fan will shut down the unit and annunciate alarm if discharge static exceeds 3" w.g. (adj.).

Failure Modes:

Fan Failure: If the supply or return fan fails to operate, both fans will shut down and alarm will be annunciated. Dampers and control valves will be indexed to their "System Off" conditions.


Sensor Failure: Upon the failure of an analog sensor, associated dampers and control valve will remain at their last position and alarm will be annunciated.












Power Failure:

Fans: Upon restoration of power, the supply and return fans will start after an adjustable delay to provide a staggered start of all building loads.

Dampers: Economizer dampers will be provided with spring return actuators to fail to their "System Off" positions.

Valves: Heating valve will be provided with spring return actuator to fail open to the coil.


REVISION INFORMATION	Drawing Title								
NUMBER	SEQUENCE		1	RECORD DRAWINGS		03/30/08	WCS		
DATE	04/17/08	REFERENCE DRAWING	NO.	REVISION-LOCATION	ECN	DATE	BY		
TIME	08:14 AM	GLA	SEL	RJM	BY	DATE	BY	DATE	
FILE NAME	Ahu1s2.vsd	Project Title		Branch Information		CONTRACT NUMBER			
		DANE COUNTY COURTHOUSE 215 SOUTH HAMILTON ST. MADISON, WI 53703		 Madison Branch 2400 Kilgust Road Madison WI 53713 Phone: 608-222-9100 Fax: 608-222-9490		0 3109-0044			
				Systems & Services Division		DRAWING NUMBER		5.6	

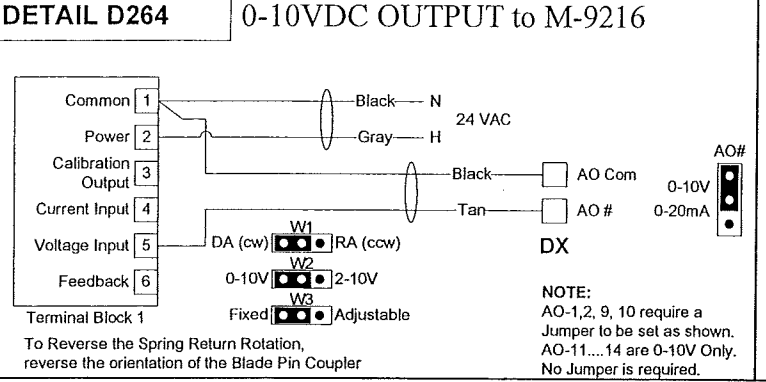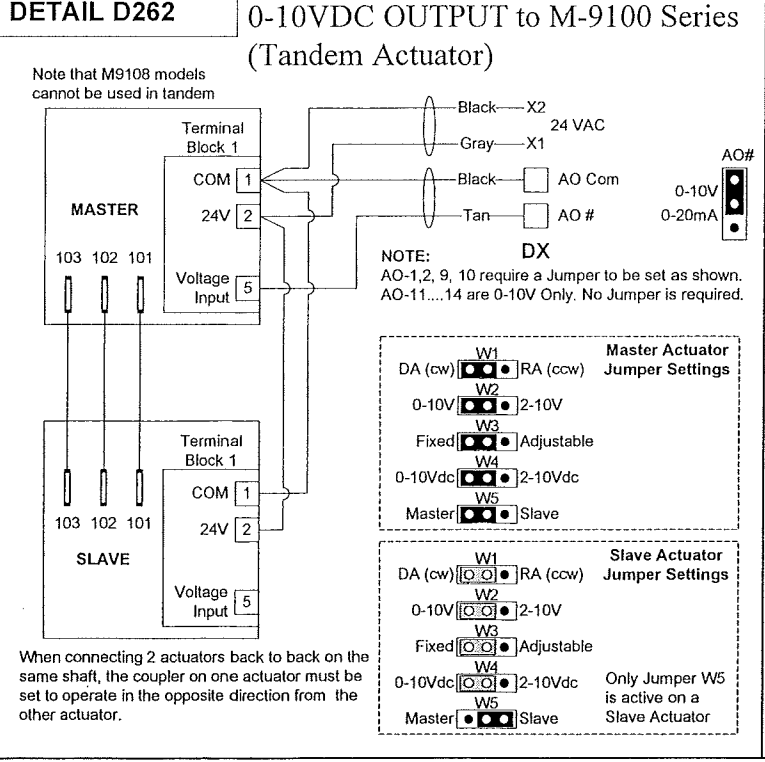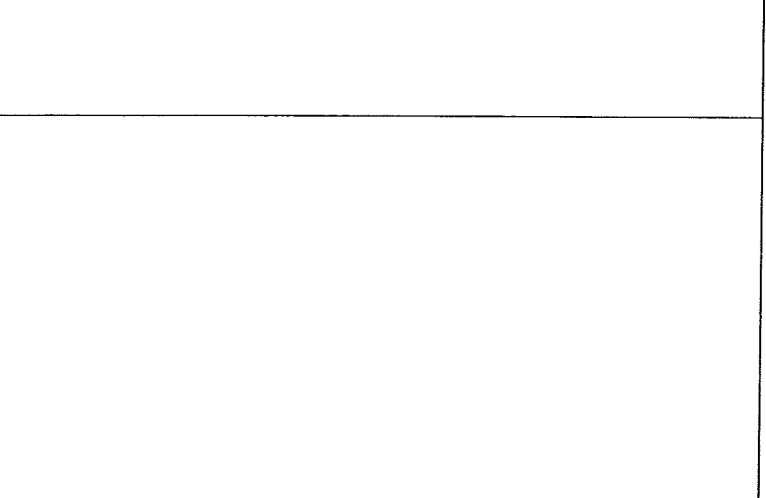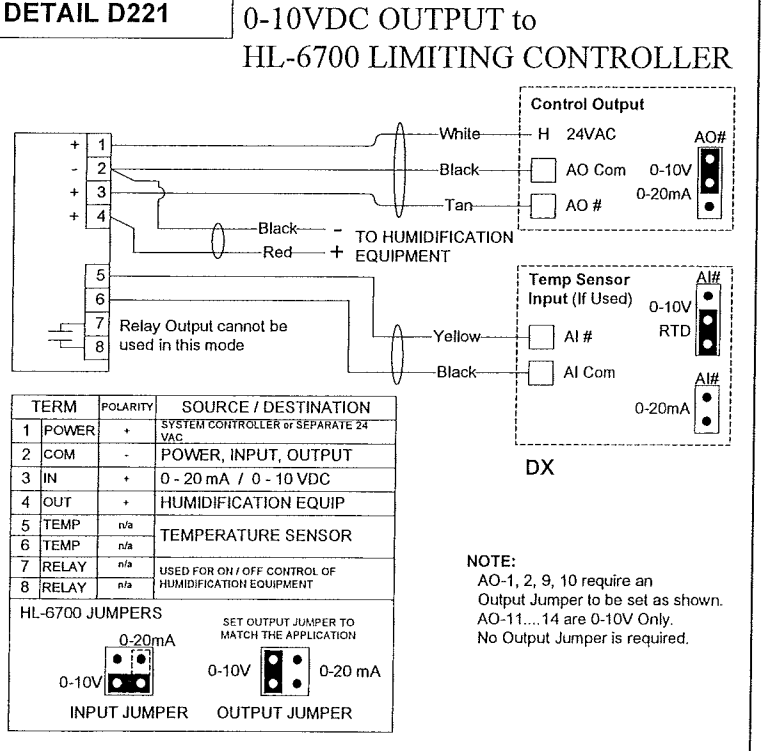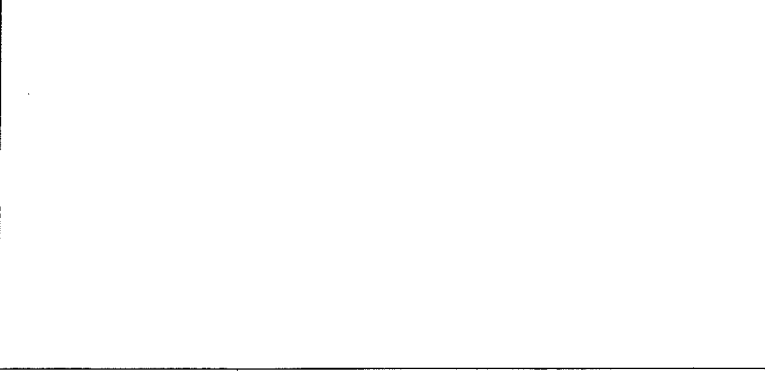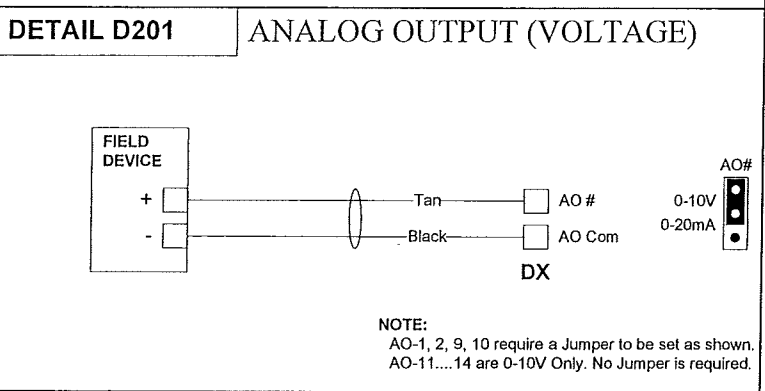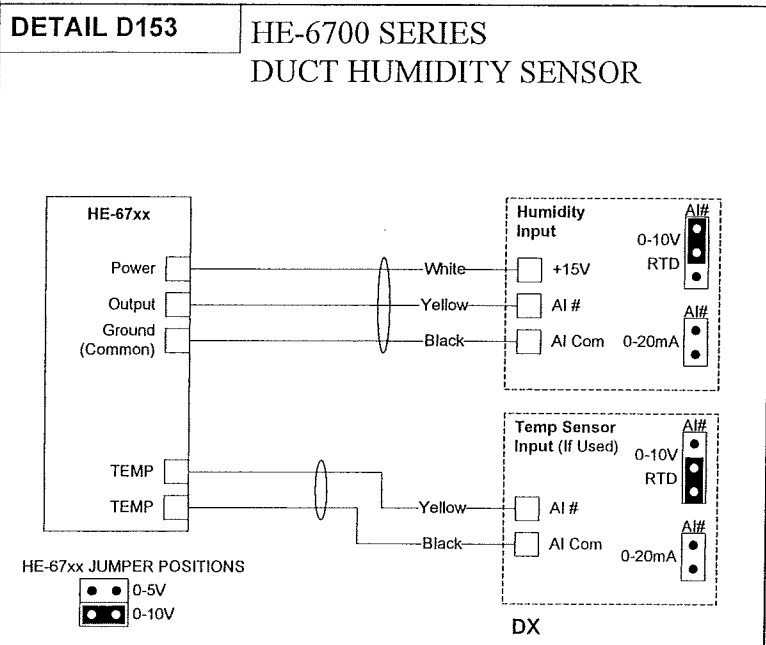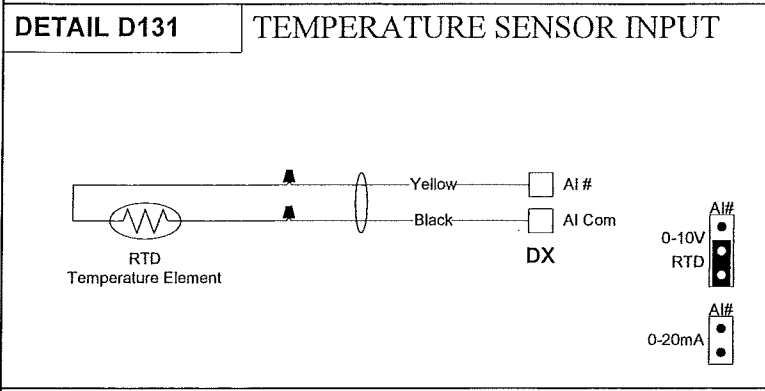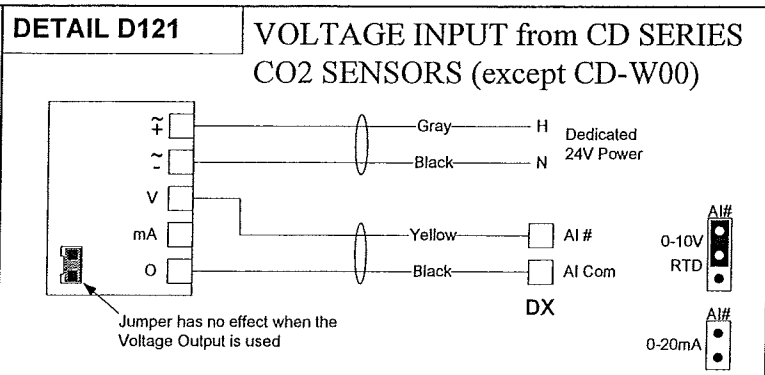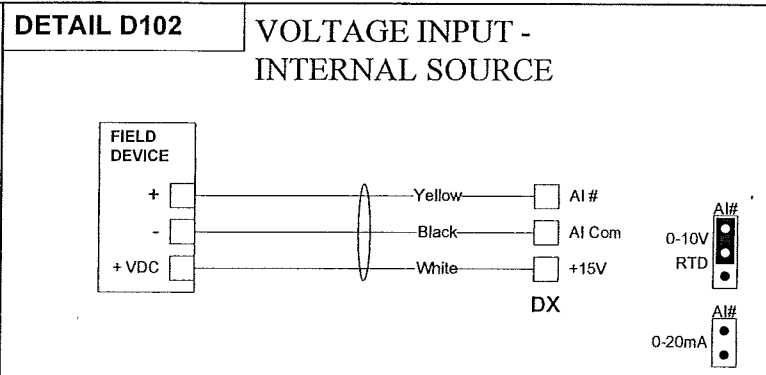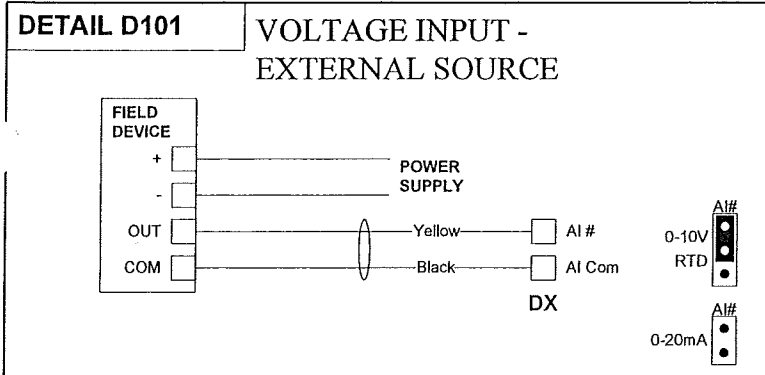

REVISION INFORMATION		Drawing Title									
NUMBER		POINT SCHEDULE		1		RECORD DRAWINGS		03/30/08		WCS	
DATE		04/17/08		SALES ENGINEER		PROJECT MANAGER		APPLICATION ENGINEER		DRAWN	
TIME		09:17 AM		GLA		SEL		RJM		APPROVED	
FILE NAME		ahu1ps2.vsc		Project Title		DANE COUNTY COURTHOUSE		215 SOUTH HAMILTON ST.		MADISON, WI 53703	
				Branch Information		Madison Branch		2400 Kilgust Road		Madison WI 53713	
				Systems & Services Division		Phone: 608-222-9100		Fax: 608-222-9490		CONTRACT NUMBER	
										0 3109-0044	
										DRAWING NUMBER	
										5.8	



BILL OF MATERIALS

Designation	Qty	Part Number	Description
Field Devices:			
CLG-VLV, HTG-O	0	VALVE	SEE VALVE SCHEDULE
FILTER-S	1	P32AC-2C	PRESS SW.DP.SPDT.5IN WC.U-BRKT
HUM-O	1	HL-67N5-8N00P	HI-LIMIT,5%RH & 1K NI TMP.WHT.DUCT-PROBE
MA-DPR, HTG-O	0	DAMPER	SEE DAMPER SCHEDULE
MA-T	1	TE-6316P-1	SENSOR.T-NI,0.1%,17FT AVG
MA-T, TS-x	10	TE-6001-8	CLIP F/AVG ELEMENT.10-PACK
PS-x	2	AFS-460	AIR FLOW SW.SPST.NC RESET 0.05-12IN
R-x	2	RIBU1C	10AMP SPDT 10-30VAC/DC/120VAC
RA-CO2, OA-CO2, DA-	3	CD-P00-00-0	SENSOR.CO2,0-2000PPM,DUCT MOUNT
-CO2			
RA-H, RA-T, DA-H, DA-	2	HE-67N3-0N00P	SENSOR,3%RH & 1K NI TEMP,DUCT-PROBE
T			
RA-V	1	STA104-F	EBTRON-FAN INLET AIR FLOW MEASURING STN-JMB ASSOC
SA-V	1	STA104-F	EBTRON-FAN INLET AIR FLOW MEASURING STN-JMB ASSOC
SF-C, CS-1, RF-C, RF-	2	H738	SENS,CURR,1A @30VAC/DC,1/3HP,CMND RELAY
S			
ST-1, ST-2, ST-4	3	FTG18A-600R	SENSING TUBE KIT, F/P32
ST-3	1	A-302	DWYER-STATIC PRESSURE TIP, 1/4" BARB-KELE
	1	A-345	DWYER-FLANGE MOUNTING KIT FOR A-302-KELE
TS-4	1	A19ABB-2C	STAT,CROP DRY,SPST,-30/50F,BULB,OPEN LO
TS-x	3	A70BA-18C	STAT,LL,20FT ELEMENT,MANUAL,15/55F

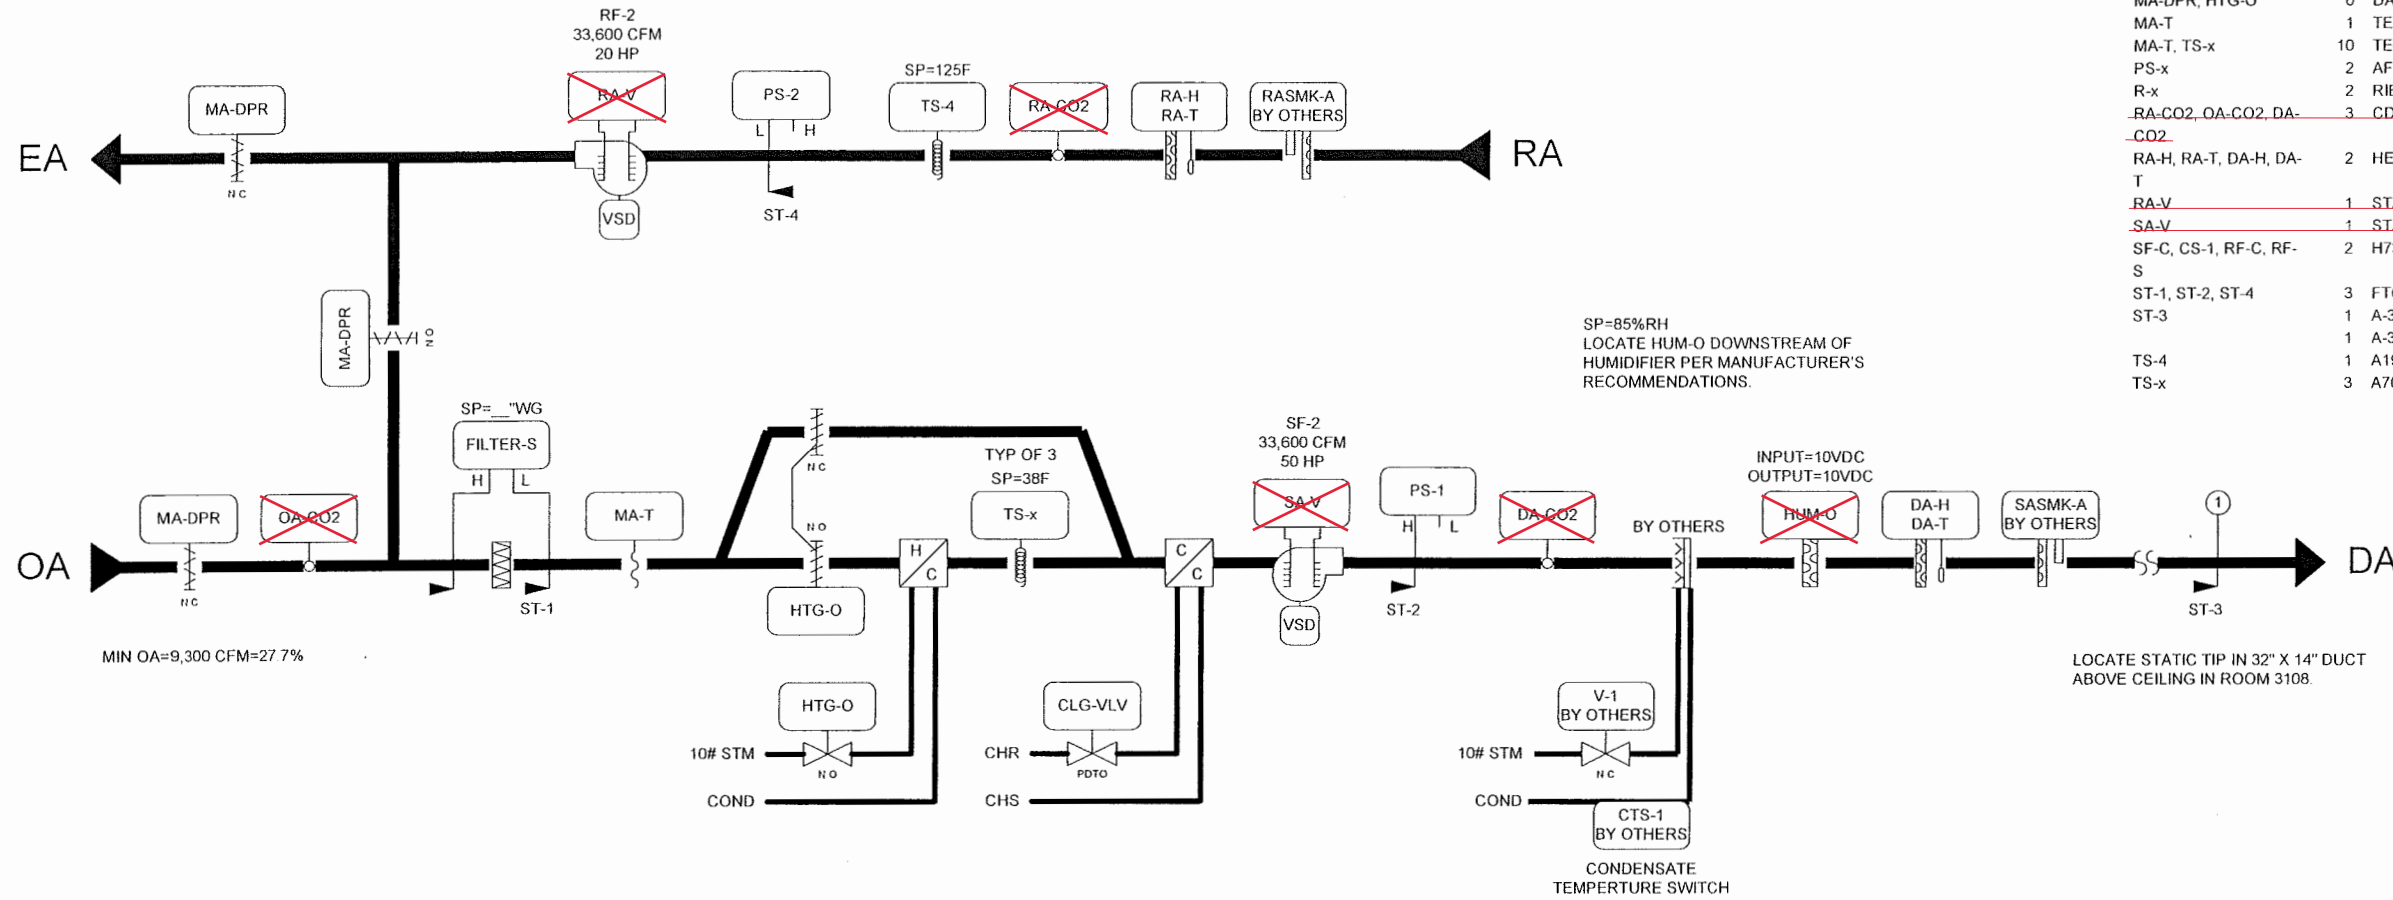

SP=85%RH
LOCATE HUM-O DOWNSTREAM OF HUMIDIFIER PER MANUFACTURER'S RECOMMENDATIONS.

LOCATE STATIC TIP IN 32" X 14" DUCT ABOVE CEILING IN ROOM 3108.

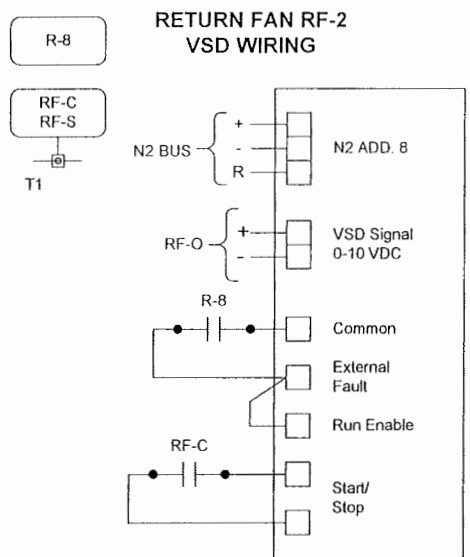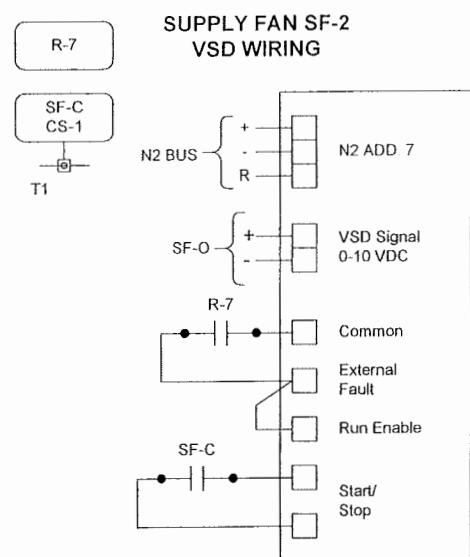




FACM BY OTHERS
FIRE ALARM CONTROL MODULE

Note: "X" items are no longer in the control sequence.

REVISION INFORMATION	Drawing Title				
NUMBER	AHU-2 FLOW				
DATE	04/16/08	1	RECORD DRAWINGS	03/30/08	WCS
TIME	01:24 PM	Project Title	DANE COUNTY COURTHOUSE 215 SOUTH HAMILTON ST. MADISON, WI 53703		
FILE NAME	ahu2f.vsd	JOHNSON CONTROLS Systems & Services Division		Branch Information Madison Branch 2400 Kilgust Road Madison WI 53713 Phone: 608-222-9100 Fax: 608-222-9490	
		CONTRACT NUMBER		0 3109-0044	
		DRAWING NUMBER		6.1	

BILL OF MATERIALS

Designation	Qty	Part Number	Description
Panel Devices:			
DA-SP	1	DPT2640-2R5B	XMTR,DIFF PR,AIR,-2.5/2.5"WC,0-5VDC,0.5%
DX-9	1	AS-LCPKEY-0	CNTRLR,LCP SERVICE KEY
	1	DX-9100-8454	CNTRLR,DIG,DX,8AI,8AO,6BO,8BI
	1	DX-9100-8990	CNTRLR,DIG,DX,MTG BASE,F/ DX-9170-8454
	1	DX-9100-8991	KIT,CNTRLR,DIG,DX,WIRING PROTECTION
P-3	1	PAN-ENC2436WDP	PANEL, HOFFMAN 24X36X9 PERF-SUB W/ DOOR
R-x, HTG-SO, HUM-E, SF-OFF, RF-OFF	10	PD-101-27	BASE F/109-38,73,74/IDEC #SH3B-05
	10	PD-109-74	RLY,3PDT,10A,24VAC,LED/IDEC RH3B-ULAC24V
RC-1	1	PD-117-02	RECEPTACLE DUPLEX IVORY
	1	PD-121-01	BOX COVER RECPT,EAGLE 2510
	1	PD-121-14	HANDY BOX, 2-1/8IN DEEP
SAFETY-OV	1	RIB2401D	10A PILOT CONTROL RELAY,DPDT,FUNC.DEVICES
TAG-1	1	NAMETAG-CUSTOM	1"X3" TAG, 3-LINES MAX, CUSTOM PNL FACE
TB-1	2	PD-113-44	END CLAMP, WIELAND Z5.522.8553.0
	36	PD-113-52	TERM BLK,6-SQ-MM WIRE SLOT,WIELAND
	1	PD-113-53	END PLATE F/113-52 TERM BLK,WIELAND
TB-PWR	1	PD-112-09	CIRCUIT BREAKER,10A,SQ-D QOU-110
	2	PD-113-44	END CLAMP, WIELAND Z5.522.8553.0
	2	PD-113-52	TERM BLK,6-SQ-MM WIRE SLOT,WIELAND
	1	PD-113-53	END PLATE F/113-52 TERM BLK,WIELAND
	3	PD-114-02	XFMR,120/24VAC,96VA
TX-x	1	XP-9102-8304	CNTRLR,DIG,DX EXPN MOD,6AI,2AO,2/DX,1/XT
XP-1	1	XP-9104-8304	CNTRLR,DIG,DX EXPN MOD,4BI,4BO,2/XT
XP-2	1	XP-9104-8304	CNTRLR,DIG,DX EXPN MOD,4BI,4BO,2/XT
XT-10	1	XT-9100-8304	CNTRLR,DIG,DX EXTENSION MODULE,8/DX

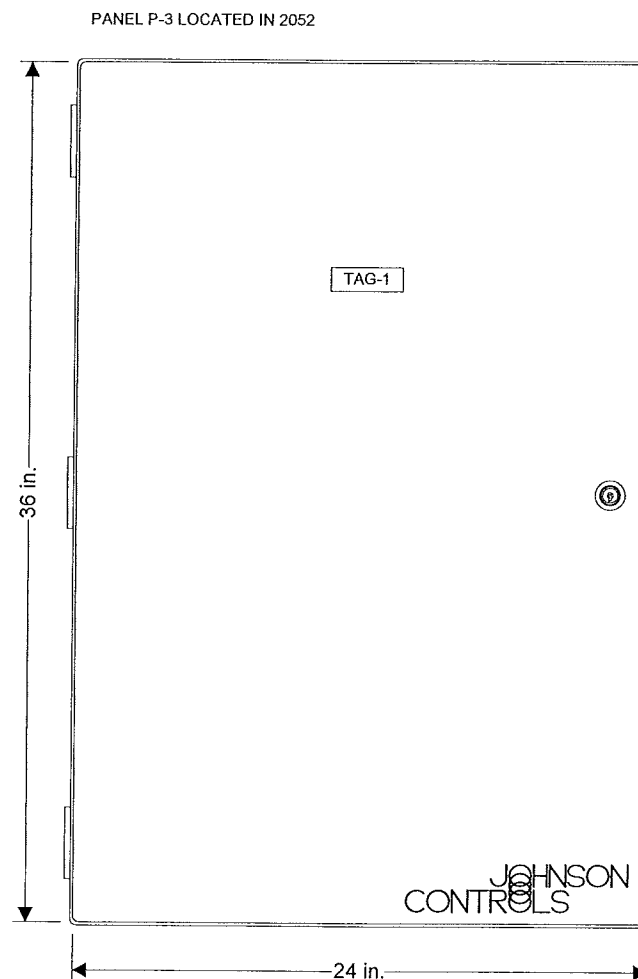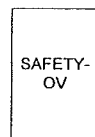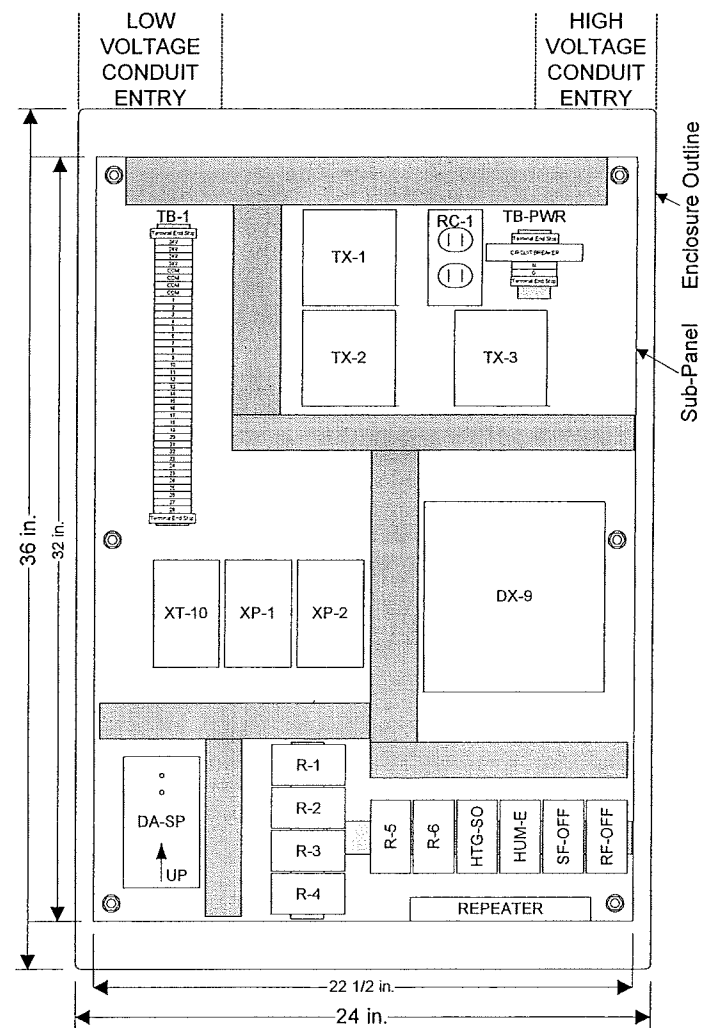

PANEL FACE TAGS:
 TAG-1: PANEL P-3
 AHU-2 SERVING 2nd & 3rd FLOORS
 JCI 0 3109-0044

REVISION INFORMATION	Drawing Title				
NUMBER	AHU-2 PANEL LOCATED IN 2052				
DATE	04/16/08	NO.	1	RECORD DRAWINGS	03/30/08 WCS
TIME	01:10 PM	REFERENCE DRAWING			
FILE NAME	ahu2p.vsd	NO.			
		REVISION-LOCATION			
		SALES ENGINEER	PROJECT MANAGER	APPLICATION ENGINEER	CONTRACT NUMBER
		GLA	SEL	RJM	0 3109-0044
		DRAWN		APPROVED	
		BY	DATE	BY	DATE
		Branch Information		DRAWING NUMBER	
		JOHNSON CONTROLS Systems & Services Division		6.3	
		Madison Branch 2400 Kilgust Road Madison WI 53713 Phone: 608-222-9100 Fax: 608-222-9490			

INDOOR AIR HANDLING UNIT VARIABLE VOLUME:

General:

Control electronically with stand-alone HVAC Node (HN).

The system will operate on a timed-programmed basis as determined by the system operator (initially set to start at 7:30 AM and stop at 6:30 PM, Monday-Friday).

System Off:

The supply and return fans will be off.

The outside air damper will be closed.

The return air damper will be open.

The steam heating will be off.

The cooling coil valve will be closed.

System Start:

When the air-handling unit is indexed to operate, the return fan will start first. Following a 5-second (adj.) delay, the supply fan will start. NOTE: The mixed air dampers and the supply/return fans speed drives will be ramped to their respective operating values over a time period (adj., initially set to 5 minutes)

Upon proof of supply and return fan operation, dampers, cooling coil valve, and steam valve will be indexed to their "System Run" conditions.

The air handler will be commanded on during the unoccupied mode when any of the associated zones is outside the setback set point temperatures.

System On:

Unoccupied Heating Mode:

Supply and Return Fans: Supply and return fans will cycle to maintain the lowest space temperature at the unoccupied heating set point (adj.). The supply fan speed will be controlled to maintain duct static pressure at set point (adj., initially set to 1.5" water column) and the return fan speed will volume match the supply fan.

Economizer Dampers: Outside air damper is fully closed and return air damper is fully open.

Interlock supply fan with return fan. General exhaust fans will be off. Interlock (via software) supply and return fan with smoke detector in supply and return duct.

Heating Coil Valve and Face & Bypass Dampers: operate when the supply and return fans are on.

Below 40 degrees F (adj.) mixed air temperature, fully open steam heating valve and modulate the face & bypass dampers.

Above 40 degrees F (adj.) mixed air temperature, modulate the steam heating valve and opens the face and bypass dampers to maintain supply air temperature.

Cooling Coil Valve: Fully closed.

Unoccupied Cooling Mode:

Supply and Return Fans: Supply and return fans will cycle to maintain the highest space temperature at the unoccupied cooling set point (adj.). The supply fan will be controlled to maintain duct static pressure at set point (adj., initially set to 1.5" water column) and the return fan speed will volume match the supply fan.

Economizer Dampers: Economizer dampers will be enabled to provide free cooling when the outside air temperature is below the dry bulb economizer set point.

Economizer Available: Outside air and exhaust dampers are modulated open and return air damper is modulated closed to control mixed air temperature at 55°F when the supply fan is on.

Economizer Not Available: Outside air and exhaust dampers are fully closed and return air damper is fully open.

Cooling Coil Valve: Modulating when fans are on to maintain unoccupied temperature set point.

Occupied Mode:

Supply and Return Fans: Supply and return fans will run continuously. The supply fan speed will be controlled to maintain duct static pressure and the return fan speed will be controlled to maintain a volume differential between the supply and exhaust (adj.). ~~Add setpoint for manual offset for return fan speed.~~

Economizer Dampers: Economizer dampers will be enabled to provide free cooling when the outside air temperature is below the dry bulb economizer set point.

Economizer Available: Economizer dampers will modulate subject to a mixed air low limit of 55 degrees F (adj.).

Economizer Not Available: The economizer dampers will maintain a minimum outside air damper position (adj.).

Steam Heating and Face & Bypass Dampers: Modulate steam heating and valve in sequence with the economizer dampers to maintain the discharge air temperature at set point as reset by space temperature

Below 40 degrees F (adj.) mixed air temperature, fully open steam heating valve and modulate the face & bypass dampers.

Above 40 degrees F (adj.) mixed air temperature, modulate steam heating valve and open the face and bypass dampers to maintain supply air temperature.

Cooling Coil Valve: Modulate in sequence with the economizer dampers to maintain discharge air temperature set point.

Match existing sequence.

~~Indoor Air Quality: Provide monitoring of outside air, return air and supply air CO2 concentration, calculate and maintain fresh air requirements. Adjust outdoor air intake to ensure return air CO2 high level limit is not exceeded.~~

STEAM HUMIDIFIER:

General:

~~Control electronically with HVAC Node (HN).~~

~~Humidity monitored by duct discharge humidity sensor and controlled by a modulating control valve.~~

System Off:

The steam valve will remain closed.

System Run:

Upon proof of airflow, system will be enabled to operate.

When the duct return humidity falls below 30% relative humidity (adj.) control valve will modulate open.

Safeties and Alarms:

Humidity valve will be prevented from operating until positive proof of airflow.

Humidity High Limit: Sensor located downstream from humidifier will modulate control valve closed upon exceeding high humidity limit.











System Stop:

When the air-handling unit is indexed to shut down, the supply and return fans will stop.

Dampers and control valve will be indexed to their "System Off" conditions.

Steam Heat will shut down.

REVISION INFORMATION		Drawing Title									
NUMBER		SEQUENCE		1		RECORD DRAWINGS		03/30/08		WCS	
DATE		04/17/08		NO.		REVISION-LOCATION		ECN		DATE	
TIME		08:14 AM		Sales Engineer		Project Manager		Application Engineer		DRAWN	
FILE NAME		Ahu2s1.vsd		GLA		SEL		RJM		BY	
Project Title		DANE COUNTY COURTHOUSE 215 SOUTH HAMILTON ST. MADISON, WI 53703		Branch Information		Madison Branch 2400 Kilgust Road Madison WI 53713 Phone: 608-222-9100 Fax: 608-222-9490		CONTRACT NUMBER		0 3109-0044	
				JOHNSON CONTROLS Systems & Services Division				DRAWING NUMBER		6.5	

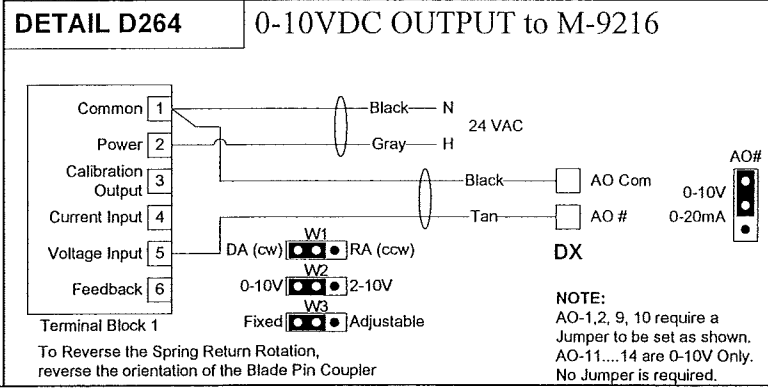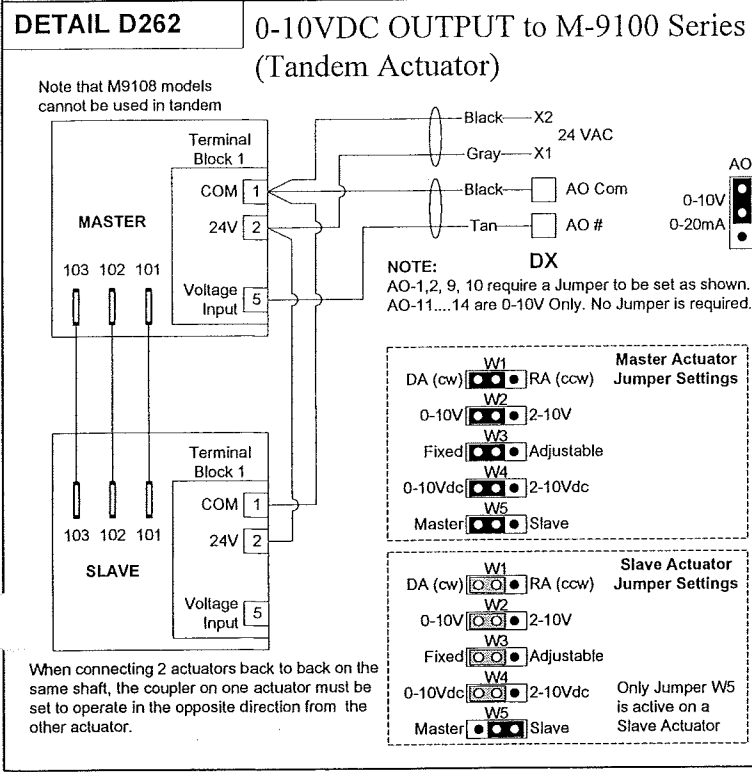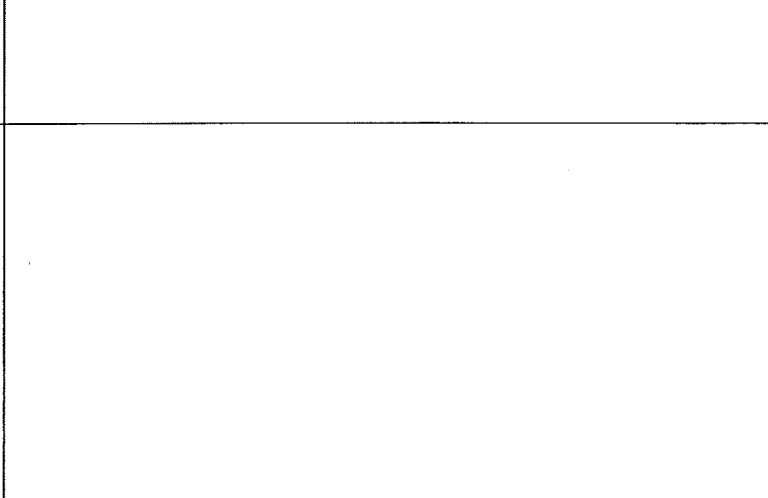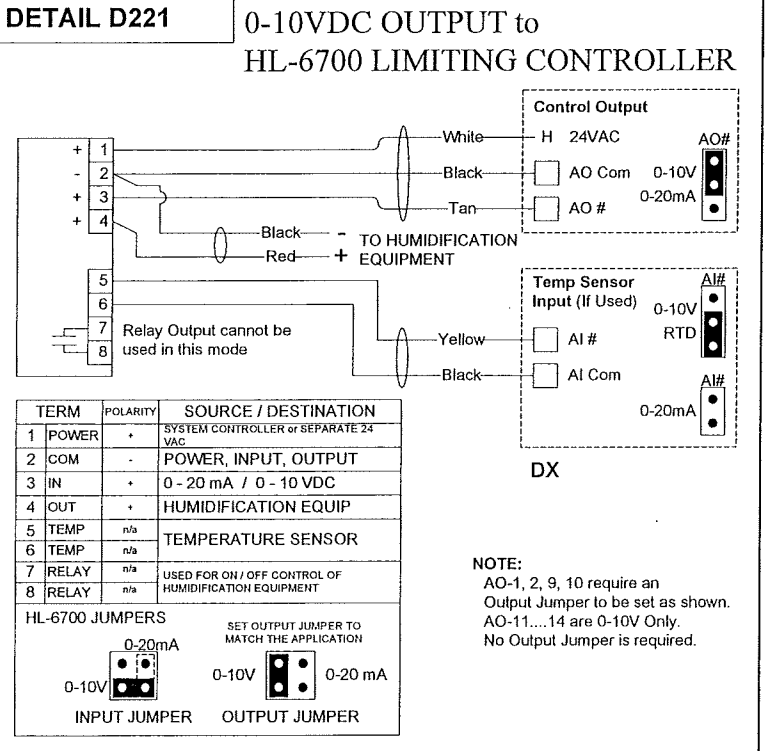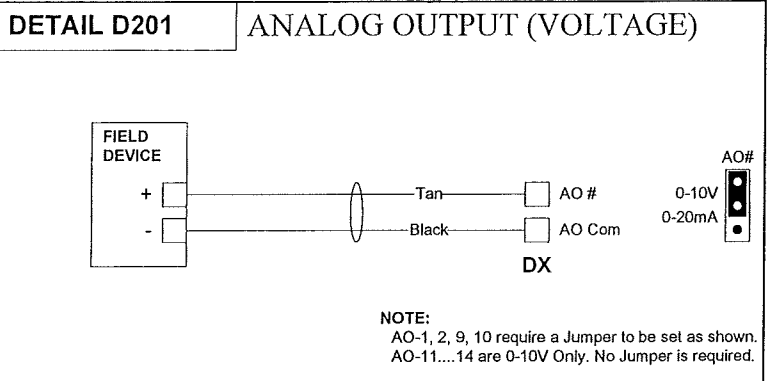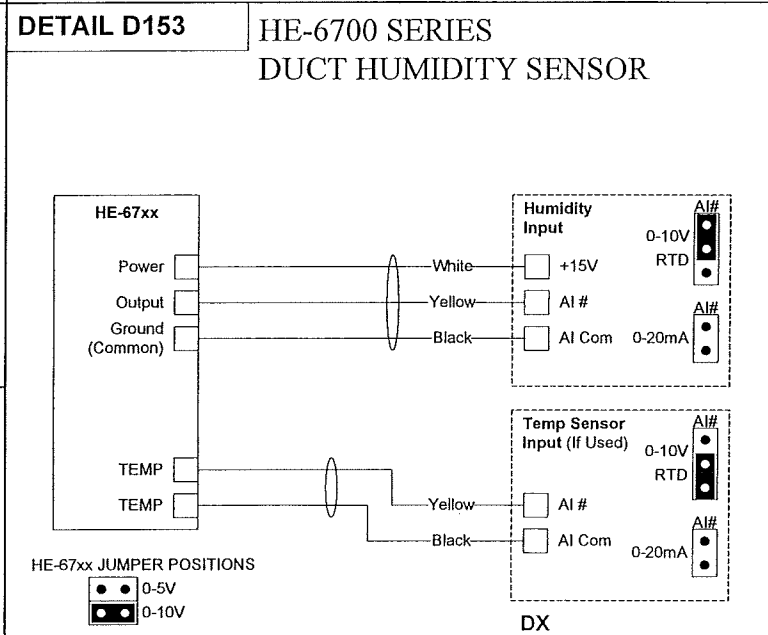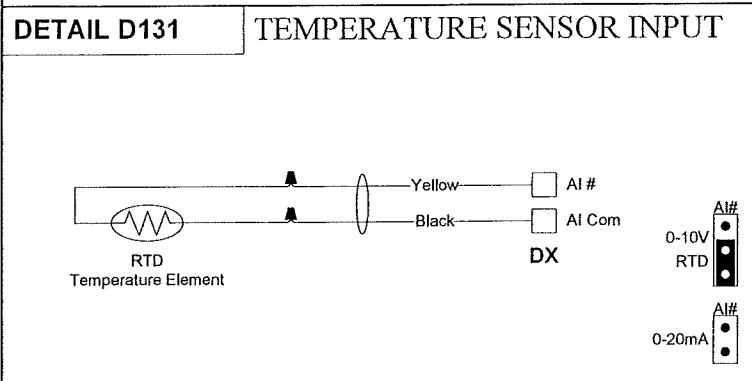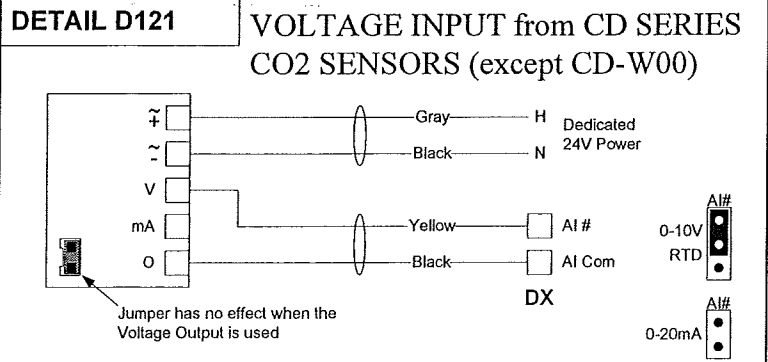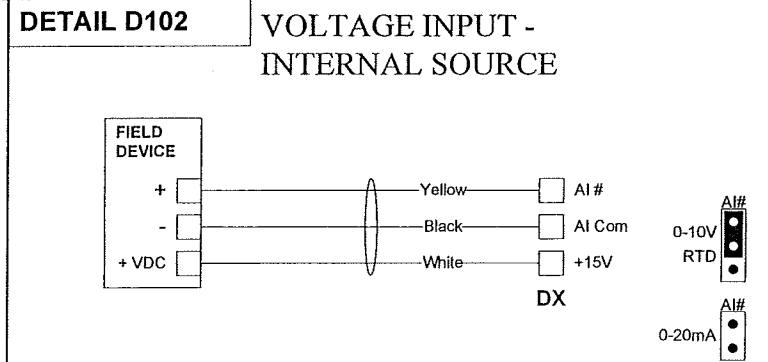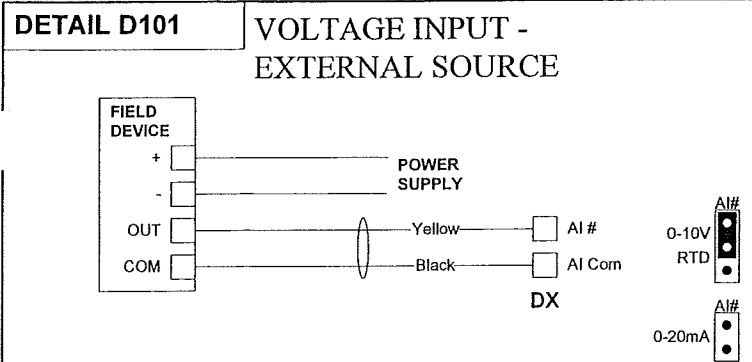

DETAIL D221 0-10VDC OUTPUT to HL-6700 LIMITING CONTROLLER

TERM	POLARITY	SOURCE / DESTINATION
1	POWER +	SYSTEM CONTROLLER or SEPARATE 24 VAC
2	COM -	POWER, INPUT, OUTPUT
3	IN +	0 - 20 mA / 0 - 10 VDC
4	OUT +	HUMIDIFICATION EQUIP
5	TEMP n/a	TEMPERATURE SENSOR
6	TEMP n/a	TEMPERATURE SENSOR
7	RELAY n/a	USED FOR ON / OFF CONTROL OF HUMIDIFICATION EQUIPMENT
8	RELAY n/a	USED FOR ON / OFF CONTROL OF HUMIDIFICATION EQUIPMENT

HL-6700 JUMPERS
0-20mA
0-10V
INPUT JUMPER
OUTPUT JUMPER

SET OUTPUT JUMPER TO MATCH THE APPLICATION




NOTE:
AO-1, 2, 9, 10 require an Output Jumper to be set as shown.
AO-11...14 are 0-10V Only.
No Output Jumper is required.

DX

REVISION INFORMATION	Drawing Title				
NUMBER	POINT SCHEDULE	1		RECORD DRAWINGS	
DATE	04/17/08	03/30/08		WCS	
TIME	09:17 AM	DATE		BY	
FILE NAME	ahu2ps2.vsd	DATE		BY	
Project Title		Branch Information		CONTRACT NUMBER	
DANE COUNTY COURTHOUSE 215 SOUTH HAMILTON ST. MADISON, WI 53703		Madison Branch 2400 Kilgust Road Madison WI 53713 Phone: 608-222-9100 Fax: 608-222-9490		0 3109-0044	
		JOHNSON CONTROLS Systems & Services Division		DRAWING NUMBER 6.8	

BILL OF MATERIALS

Designation	Qty	Part Number	Description
Field Devices:			
CLG-VLV, HTG-O	0	VALVE	SEE VALVE SCHEDULE
DA-H, DA-T	1	HE-67N3-0N00P	SENSOR,3%RH & 1K NI TEMP,DUCT-PROBE
FILTER-S	1	P32AC-2C	PRESS SW,DP,SPDT,5IN WC,U-BRKT
HUM-O	1	HL-67N5-8N00P	HI-LIMIT,5%RH & 1K NI TMP,WHT,DUCT-PROBE
MA-DPR, HTG-O	0	DAMPER	SEE DAMPER SCHEDULE
MA-T	1	TE-6316P-1	SENSOR,T-NI,0.1%,17FT AVG
MA-T, TS-x	8	TE-6001-8	CLIP F/AVG ELEMENT,10-PACK
PS-x	2	AFS-460	AIR FLOW SW,SPST,NC RESET 0.05-12IN
R-x	2	RIBU1C	10AMP SPDT 10-30VAC/DC/120VAC
RA-CO2, OA-CO2, DA-	3	CD-P00-00-0	SENSOR,G02, 0-2000PPM,DUCT MOUNT
CO2-			
RA-T	1	TE-6311P-1	SENSOR,T-NI,0.1%,8IN DUCT
RA-V	1	STA104-F	EBTRON-FAN INLET AIR FLOW-MEASURING-STN-JMB-ASSOC.
SA-V	1	STA104-F	EBTRON-FAN INLET AIR FLOW-MEASURING-STN-JMB-ASSOC.
SF-C, CS-1, RF-C, RF-S	2	H738	SENS,CURR,1A @30VAC/DC,1/3HP,CMND RELAY
ST-1, ST-2, ST-4	3	FTG18A-600R	SENSING TUBE KIT, F/P32
ST-3	1	A-302	DWYER-STATIC PRESSURE TIP, 1/4" BARB-KELE
	1	A-345	DWYER-FLANGE MOUNTING KIT FOR A-302-KELE
TS-3	1	A19ABB-2C	STAT,CROP DRY,SPST,-30/50F,BULB,OPEN LO
TS-x	2	A70BA-18C	STAT,LL,20FT ELEMENT,MANUAL,15/55F

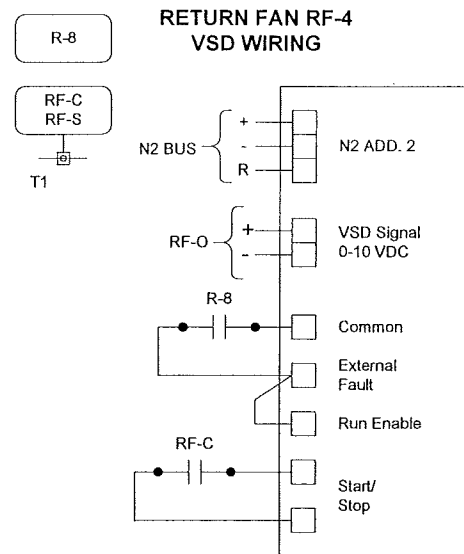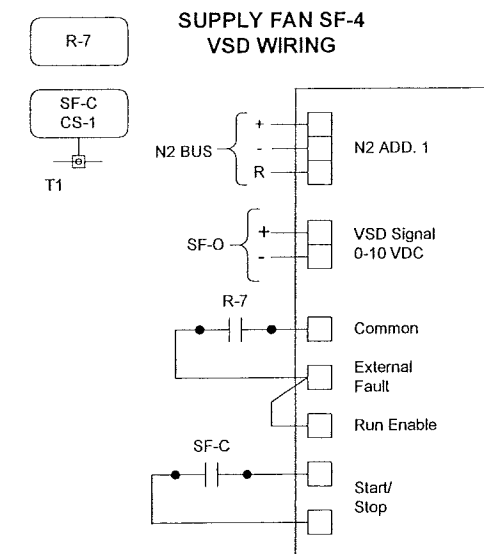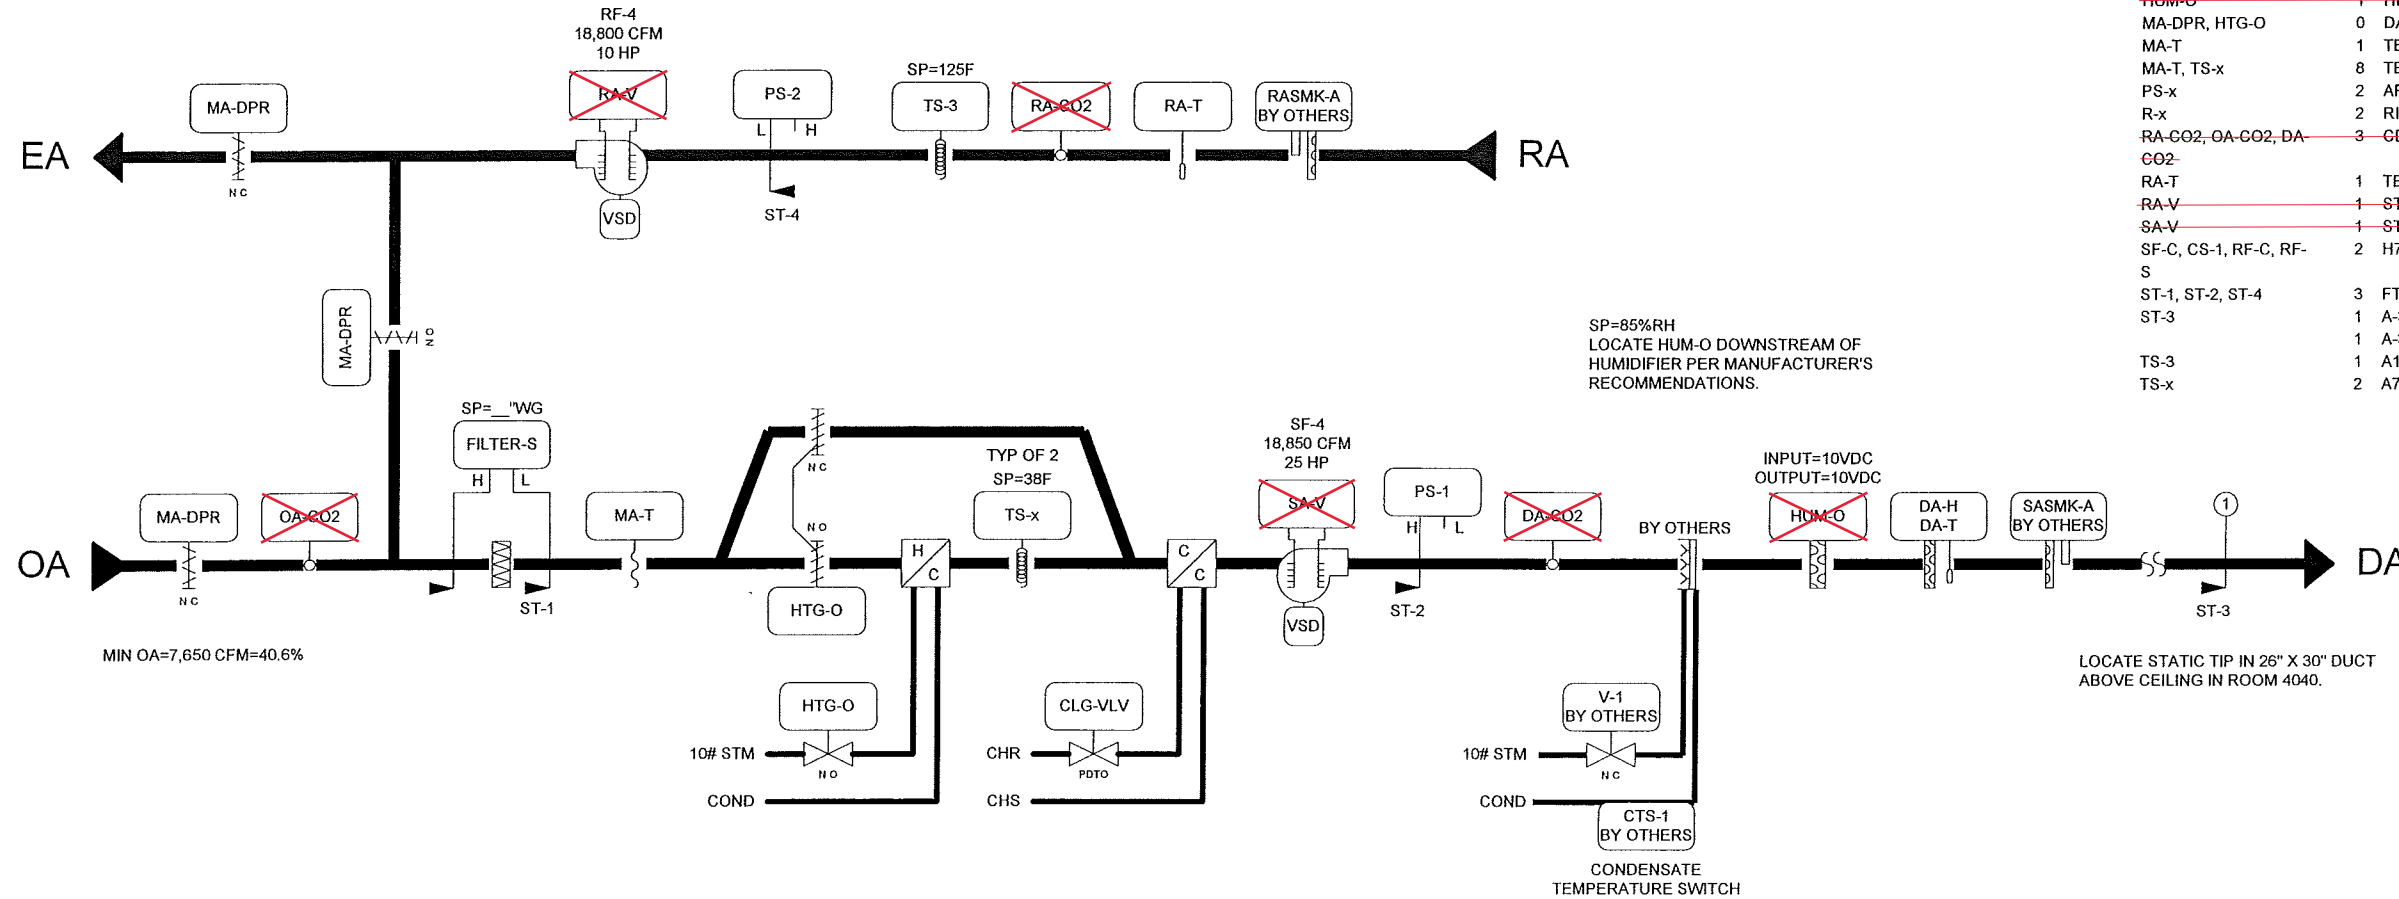

FACM
BY OTHERS
FIRE ALARM
CONTROL MODULE

Note: "X" items are no longer in the control sequence.



REVISION INFORMATION	Drawing Title				
NUMBER	AHU-4 FLOW				
DATE	04/17/08	1	RECORD DRAWINGS	03/30/08	WCS
TIME	09:16 AM				
FILE NAME	ahu4f.vsd				
Project Title		Branch Information		CONTRACT NUMBER	
DANE COUNTY COURTHOUSE 215 SOUTH HAMILTON ST. MADISON, WI 53703		Johnson CONTROLS Systems & Services Division Madison Branch 2400 Kilgust Road Madison WI 53713 Phone: 608-222-9100 Fax: 608-222-9490		0 3109-0044 DRAWING NUMBER 7.1	

DA-T \ AI-7 (4-3-AI-7) 2/18 YEL	FROM LAST N2 DEVICE (N2) 3/18
SF-O \ AO-1 (4-3-AO-1) 2/18 TAN	TO NEXT N2 DEVICE (N2) 3/18
RF-O \ AO-2 (4-3-AO-2) 2/18 TAN	SF-C \ DO-3 (4-3-DO-3) 2/18 VIO
MA-DPR \ AO-9 (4-3-AO-9) 18TAN / 2/18 TAN / 18GRAY	RF-C \ DO-4 (4-3-DO-4) 2/18 VIO
HTG-O \ AO-10 (4-3-AO-10) 2/18TAN / 18GRAY	RF-S \ DI-2 (4-3-DI-2) 2/18 ORG
CLG-VLV \ AO-11 (4-3-AO-11) 2/18TAN / 18GRAY	RASMK-A \ DI-3 (4-3-DI-3) 2/18 ORG
HUM-O \ AO-12 (4-3-AO-12) 2/18 TAN	SASMK-A \ DI-4 (4-3-DI-4) 2/18 ORG
OA-CO2 \ AI-1 (4-4A-AI-1) 18YEL / 2/18 YEL / 18GRAY	RA-CO2 \ AI-1 (4-3-AI-1) 18YEL / 2/18 YEL / 18GRAY
DA-CO2 \ AI-2 (4-4A-AI-2) 18YEL / 2/18 YEL / 18GRAY	RA-V \ AI-2 (4-3-AI-2) 2/18 YEL
FILTER-S \ DI-1 (4-4B-DI-1) 2/18 ORG	RA-T \ AI-3 (4-3-AI-3) 2/18 YEL
	SA-V \ AI-4 (4-3-AI-4) 2/18 YEL
	DA-H \ AI-5 (4-3-AI-5) 3/18 YEL
	MA-T \ AI-6 (4-3-AI-6) 2/18 YEL

REVISION INFORMATION	Drawing Title									
NUMBER	AHU-4 FIELD POINTS		1		RECORD DRAWINGS		03/30/08		WCS	
DATE	04/17/08		NO.		REVISION-LOCATION		ECN		DATE	
TIME	09:16 AM		Sales Engineer		Project Manager		Application Engineer		DRAWN	
FILE NAME	ahufp.vsd		GLA		SEL		RJM		DATE	
	Project Title		BY		DATE		BY		DATE	
	DANE COUNTY COURTHOUSE 215 SOUTH HAMILTON ST. MADISON, WI 53703		Branch Information		CONTRACT NUMBER		APPROVED			
			JOHNSON CONTROLS		Madison Branch 2400 Kilgust Road Madison WI 53713 Phone: 608-222-9100 Fax: 608-222-9490		0 3109-0044			
			Systems & Services Division		DRAWING NUMBER		7.2			

BILL OF MATERIALS

Designation	Qty	Part Number	Description
Panel Devices:			
DA-SP	1	DPT2640-2R5B	XMTR,DIFF PR,AIR,-2.5/2.5"WC,0-5VDC,0.5%
DX-3	1	AS-LCPKEY-0	CNTRLR,LCP SERVICE KEY
	1	DX-9100-8454	CNTRLR,DIG,DX,8AI,8AO,8BO,8BI
	1	DX-9100-8990	CNTRLR,DIG,DX,MTG BASE,F/ DX-9170-8454
	1	DX-9100-8991	KIT,CNTRLR,DIG,DX,WIRING PROTECTION
P-4	1	PAN-ENC2436WDP	PANEL, HOFFMAN 24X36X9 PERF-SUB W/ DOOR
R-x, HTG-SO, HUM-E, SF-OFF, RF-OFF	10	PD-101-27	BASE F/109-38,73,74/IDEC #SH3B-05
	10	PD-109-74	RLY,3PDT,10A,24VAC,LED/IDEC RH3B-ULAC24V
RC-1	1	PD-117-02	RECEPTACLE DUPLEX IVORY
	1	PD-121-01	BOX COVER RECPT,EAGLE 2510
	1	PD-121-14	HANDY BOX, 2-1/8IN DEEP
SAFETY-OV	1	RIB2401D	10A PILOT CONTROL RELAY,DPDT,FUNC.DEVICES
TAG-1	1	NAMETAG-CUSTOM	1"X3" TAG, 3-LINES MAX, CUSTOM PNL FACE
TB-1	2	PD-113-44	END CLAMP, WIELAND Z5.522.8553.0
	36	PD-113-52	TERM BLK,6-SQ-MM WIRE SLOT,WIELAND
	1	PD-113-53	END PLATE F/113-52 TERM BLK,WIELAND
TB-PWR	1	PD-112-09	CIRCUIT BREAKER,10A,SQ-D QOU-110
	2	PD-113-44	END CLAMP, WIELAND Z5.522.8553.0
	2	PD-113-52	TERM BLK,6-SQ-MM WIRE SLOT,WIELAND
	1	PD-113-53	END PLATE F/113-52 TERM BLK,WIELAND
	3	PD-114-02	XFMR,120/24VAC,96VA
TX-x	1	XP-9102-8304	CNTRLR,DIG,DX EXPN MOD,6AI,2AO,2DX,1XT
XP-1	1	XP-9104-8304	CNTRLR,DIG,DX EXPN MOD,4BI,4BO,2XT
XP-2	1	XP-9104-8304	CNTRLR,DIG,DX EXPN MOD,4BI,4BO,2XT
XT-4	1	XT-9100-8304	CNTRLR,DIG,DX EXTENSION MODULE,B/DX

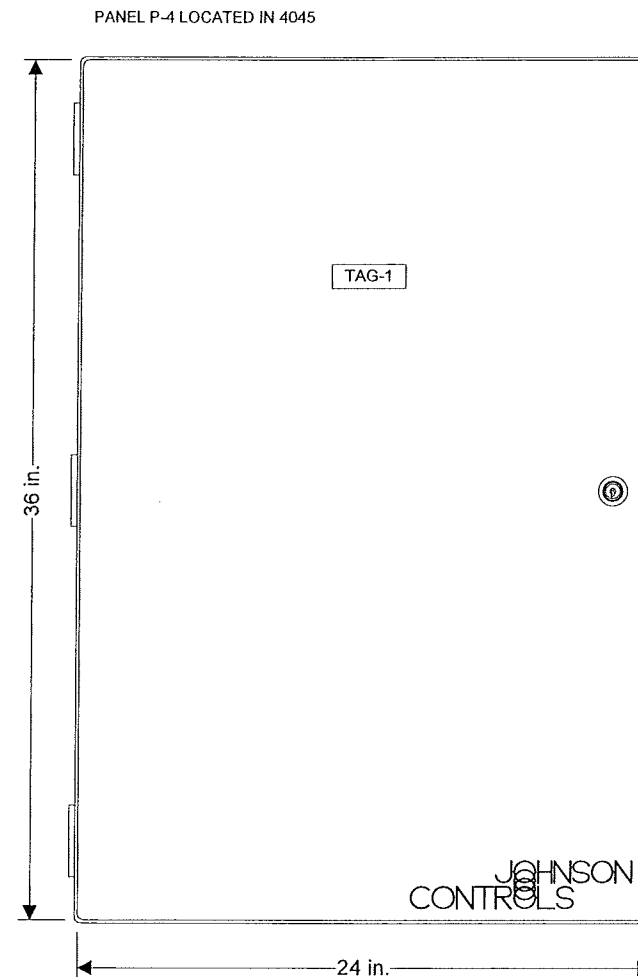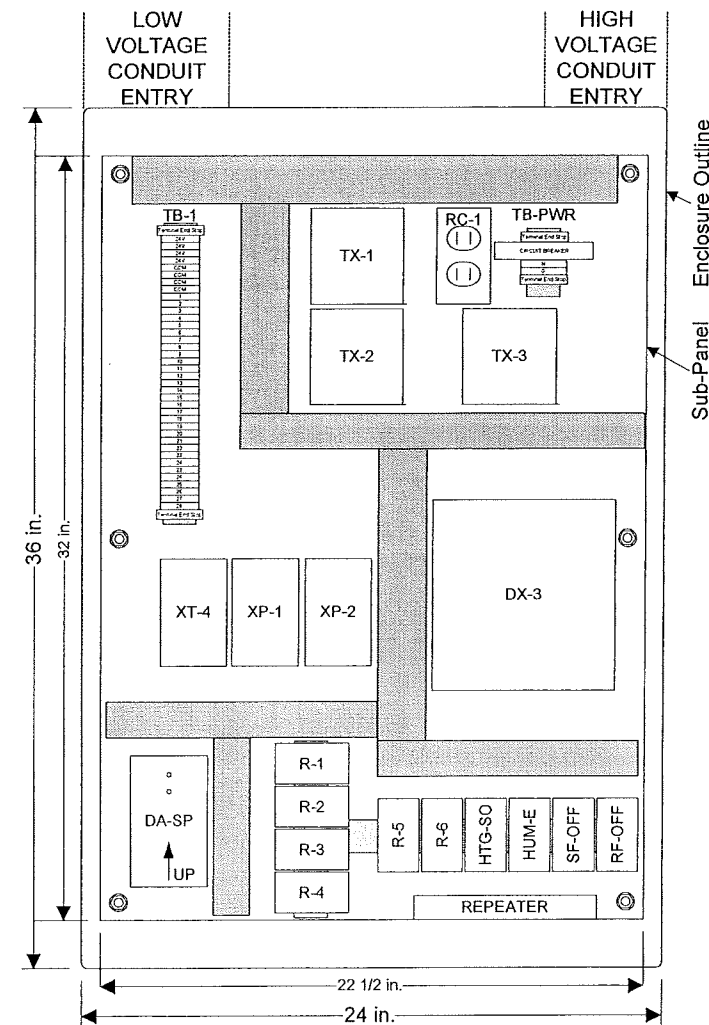


SAFETY-OV



PANEL FACE TAGS:
TAG-1: PANEL P-4
AHU-4 SERVING 4TH FLOOR
JCI 0 3109-0044

REVISION INFORMATION	Drawing Title									
NUMBER	AHU-4 PANEL LOCATED IN 4045		1		RECORD DRAWINGS		03/30/08		WCS	
DATE	04/16/08		REFERENCE DRAWING	NO.	REVISION-LOCATION		ECN	DATE	BY	
TIME	01:10 PM		Sales Engineer	Project Manager	Application Engineer		DRAWN		APPROVED	
FILE NAME	ahu4p.vsd		GLA	SEL	RJM		BY	DATE	BY	DATE
	Project Title		Branch Information		CONTRACT NUMBER					
	DANE COUNTY COURTHOUSE 215 SOUTH HAMILTON ST. MADISON, WI 53703		Madison Branch 2400 Kilgust Road Madison WI 53713 Phone: 608-222-9100 Fax: 608-222-9490		0 3109-0044					
			JOHNSON CONTROLS Systems & Services Division		DRAWING NUMBER		7.3			



LINE VOLTAGE WIRING DIAGRAM

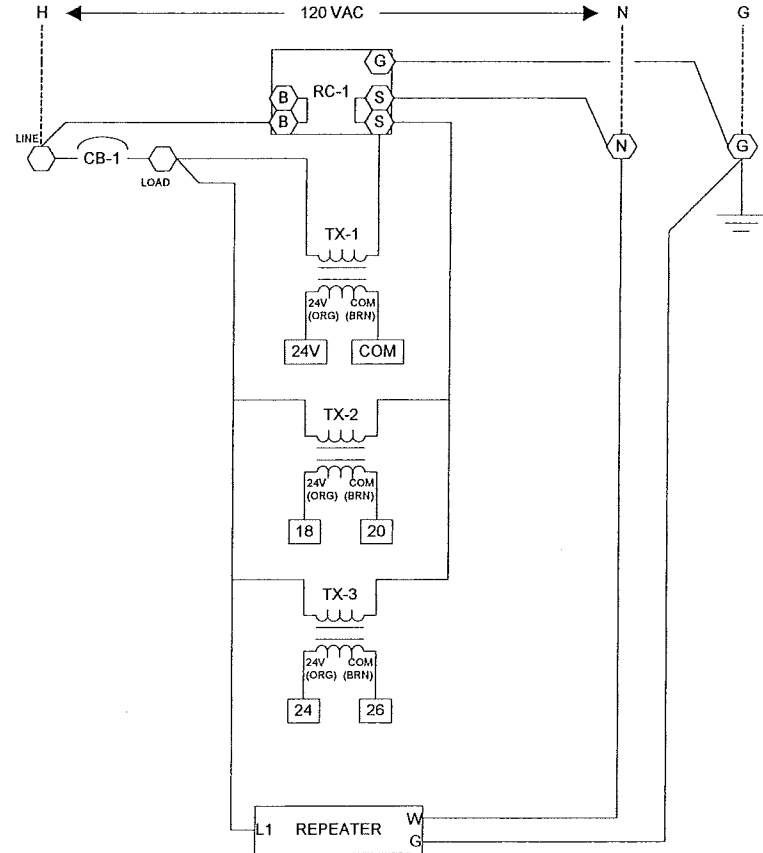


LOW VOLTAGE WIRING DIAGRAM

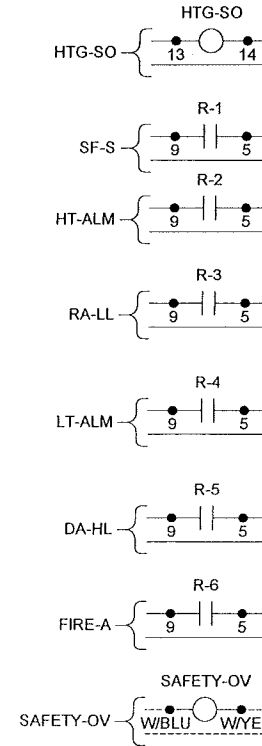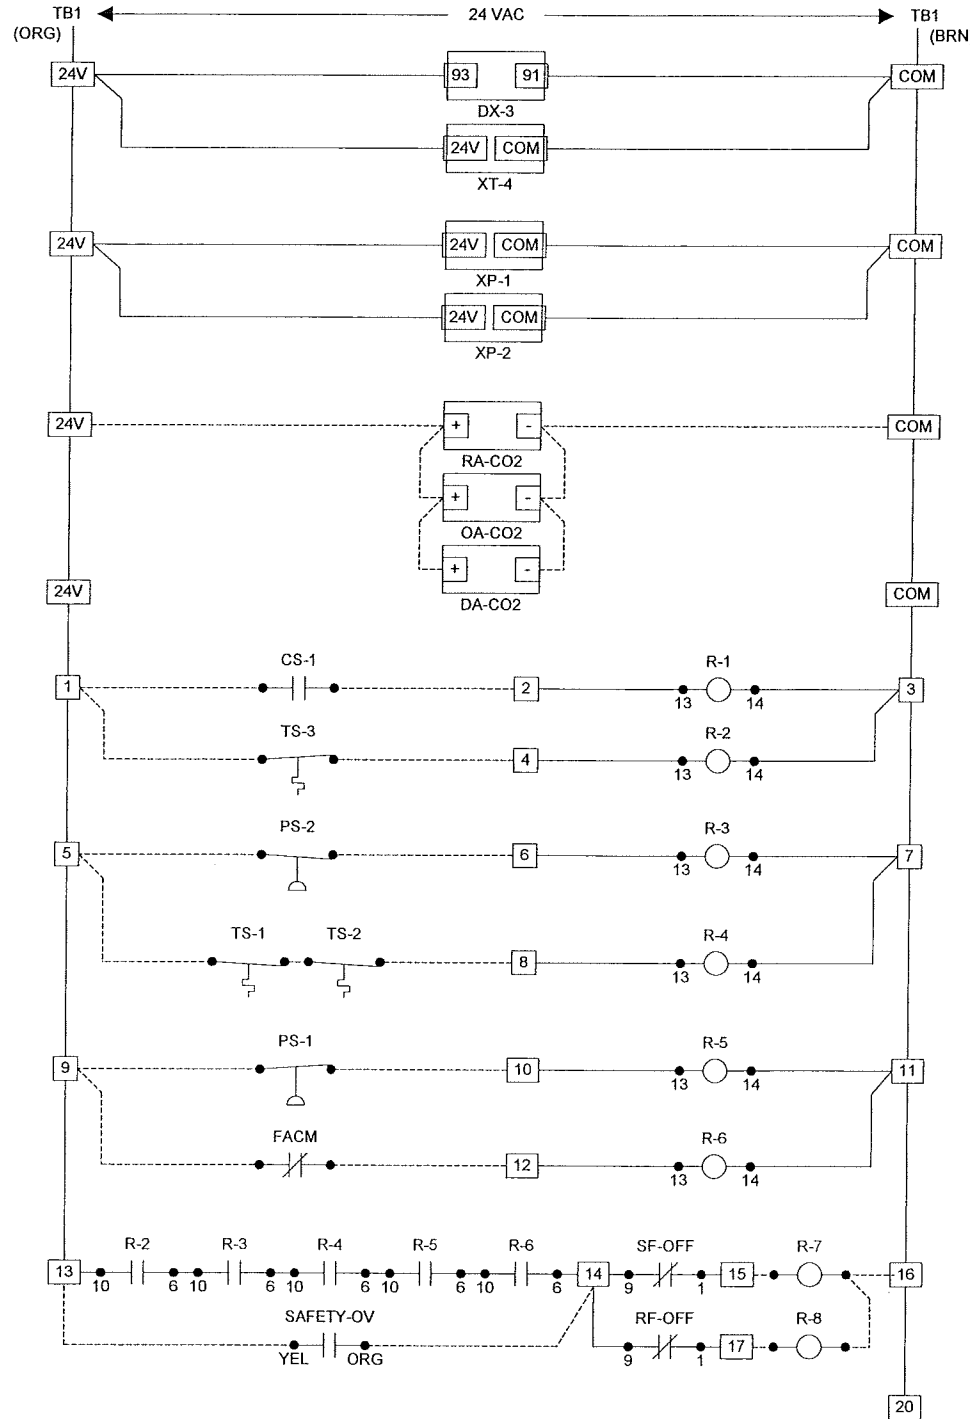

LOW VOLTAGE WIRING DIAGRAM

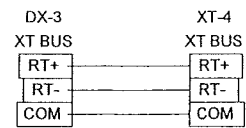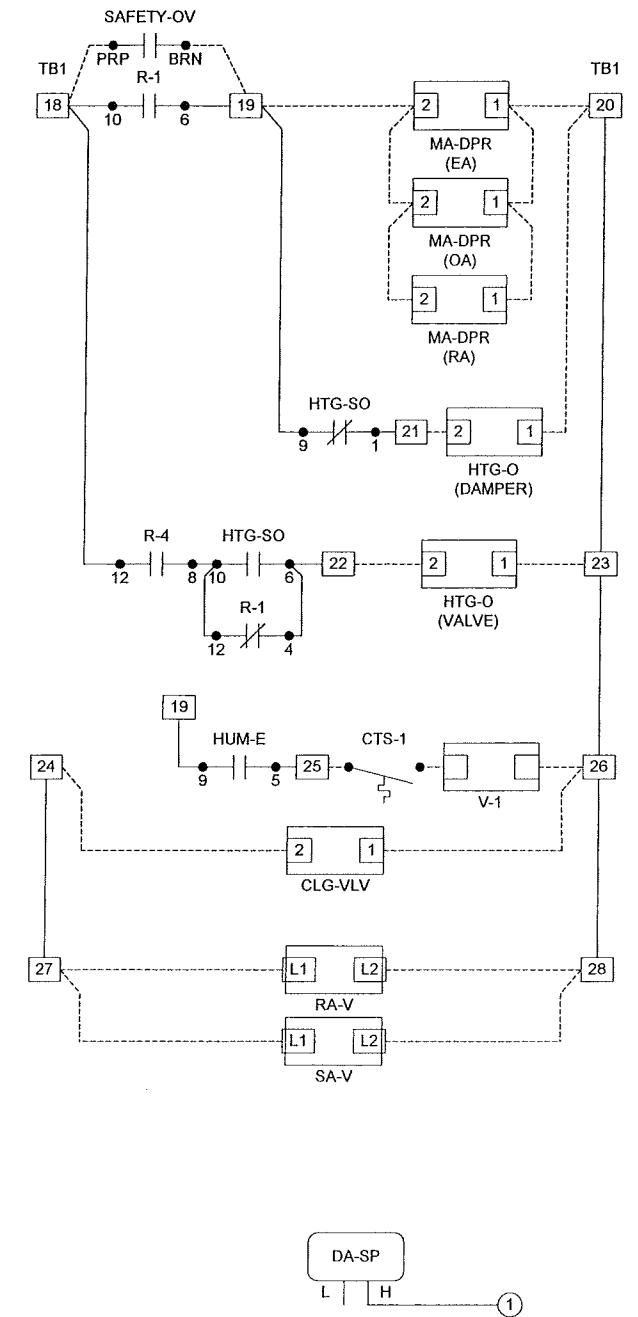

Wiring Legend

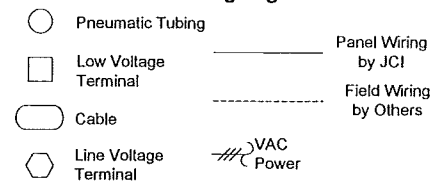

REVISION INFORMATION		Drawing Title									
NUMBER		AHU-4 PANEL WIRING		1		RECORD DRAWINGS		03/30/08		WCS	
DATE		04/16/08		NO.		REVISION-LOCATION		ECH		DATE	
TIME		01:09 PM		SALES ENGINEER		PROJECT MANAGER		APPLICATION ENGINEER		DRAWN	
FILE NAME		ah4pw.vsd		GLA		SEL		RJM		BY	
Project Title		DANE COUNTY COURTHOUSE 215 SOUTH HAMILTON ST. MADISON, WI 53703		Branch Information		CONTRACT NUMBER		DRAWING NUMBER			
JOHNSON CONTROLS Systems & Services Division		Madison Branch 2400 Kilgust Road Madison WI 53713 Phone: 608-222-9100 Fax: 608-222-9490		0 3109-0044		7.4					

INDOOR AIR HANDLING UNIT VARIABLE VOLUME:

General:
Control electronically with stand-alone HVAC Node (HN).

The system will operate on a timed-programmed basis as determined by the system operator (initially set to start at 7:30 AM and stop at 6:30 PM, Monday-Friday).

System Off:
The supply and return fans will be off.

The outside air damper will be closed.

The return air damper will be open.

The steam heating will be off.

The cooling coil valve will be closed.

System Start:
When the air-handling unit is indexed to operate, the return fan will start first. Following a 5-second (adj.) delay, the supply fan will start. **NOTE:** The mixed air dampers and the supply/return fans speed drives will be ramped to their respective operating values over a time period (adj., initially set to 5 minutes)

Upon proof of supply and return fan operation, dampers, cooling coil valve, and steam valve will be indexed to their "System Run" conditions.

The air handler will be commanded on during the unoccupied mode when any of the associated zones is outside the setback set point temperatures.

System On:
Unoccupied Heating Mode:
Supply and Return Fans: Supply and return fans will cycle to maintain the lowest space temperature at the unoccupied heating set point (adj.). The supply fan speed will be controlled to maintain duct static pressure at set point (adj., initially set to 1.5" water column) and the return fan speed will volume match the supply fan.
Economizer Dampers: Outside air damper is fully closed and return air damper is fully open.

Interlock supply fan with return fan. General exhaust fans will be off. Interlock (via software) supply and return fan with smoke detector in supply and return duct.

Heating Coil Valve and Face & Bypass Dampers: operate when the supply and return fans are on.
Below 40 degrees F (adj.) mixed air temperature, fully open steam heating valve and modulate the face & bypass dampers.
Above 40 degrees F (adj.) mixed air temperature, modulate the steam heating valve and opens the face and bypass dampers to maintain supply air temperature.
Cooling Coil Valve: Fully closed.

Unoccupied Cooling Mode:
Supply and Return Fans: Supply and return fans will cycle to maintain the highest space temperature at the unoccupied cooling set point (adj.). The supply fan will be controlled to maintain duct static pressure at set point (adj., initially set to 1.5" water column) and the return fan speed will volume match the supply fan.
Economizer Dampers: Economizer dampers will be enabled to provide free cooling when the outside air temperature is below the dry bulb economizer set point.
Economizer Available: Outside air and exhaust dampers are modulated open and return air damper is modulated closed to control mixed air temperature at 55°F when the supply fan is on.
Economizer Not Available: Outside air and exhaust dampers are fully closed and return air damper is fully open.
Cooling Coil Valve: Modulating when fans are on to maintain unoccupied temperature set point.

Occupied Mode:
Supply and Return Fans: Supply and return fans will run continuously. The supply fan speed will be controlled to maintain duct static pressure and the return fan speed will be controlled to maintain a volume differential between the supply and exhaust (adj.). ~~Add setpoint for manual offset for return fan speed~~
Economizer Dampers: Economizer dampers will be enabled to provide free cooling when the outside air temperature is below the dry bulb economizer set point.
Economizer Available: Economizer dampers will modulate subject to a mixed air low limit of 55 degrees F (adj.).
Economizer Not Available: The economizer dampers will maintain a minimum outside air damper position (adj.).
Steam Heating and Face & Bypass Dampers: Modulate steam heating and valve in sequence with the economizer dampers to maintain the discharge air temperature at set point as reset by space temperature
Below 40 degrees F (adj.) mixed air temperature, fully open steam heating valve and modulate the face & bypass dampers.
Above 40 degrees F (adj.) mixed air temperature, modulate steam heating valve and open the face and bypass dampers to maintain supply air temperature.
Cooling Coil Valve: Modulate in sequence with the economizer dampers to maintain discharge air temperature set point.

Match existing sequence.

~~Indoor Air Quality: Provide monitoring of outside air, return air and supply air CO2 concentration, calculate and maintain fresh air requirements. Adjust outdoor air intake to ensure return air CO2 high level limit is not exceeded.~~

STEAM HUMIDIFIER:
General:
Control electronically with HVAC Node (HN).

~~Humidity monitored by duct discharge humidity sensor and controlled by a modulating control valve.~~

System Off:
The steam valve will remain closed.

System Run:
Upon proof of airflow, system will be enabled to operate.

When the duct return humidity falls below 30% relative humidity (adj.) control valve will modulate open.

Safeties and Alarms:
Humidity valve will be prevented from operating until positive proof of airflow.













Humidity High Limit: Sensor located downstream from humidifier will modulate control valve closed upon exceeding high humidity limit.

System Stop:
When the air-handling unit is indexed to shut down, the supply and return fans will stop.

Dampers and control valve will be indexed to their "System Off" conditions.

Steam Heat will shut down.




REVISION INFORMATION	Drawing Title								
NUMBER	SEQUENCE		1	RECORD DRAWINGS		03/30/08	WCS		
DATE	04/17/08	REFERENCE DRAWING	NO.	REVISION LOCATION	ECN	DATE	BY	APPROVED	
TIME	08:14 AM	Sales Engineer	Project Manager	Application Engineer	BY	DATE	BY	DATE	CONTRACT NUMBER
FILE NAME	Ahu4s1.vsd	GLA	SEL	RJM					
	Project Title	JOHNSON CONTROLS Systems & Services Division			Branch Information		CONTRACT NUMBER		
	DANE COUNTY COURTHOUSE 215 SOUTH HAMILTON ST. MADISON, WI 53703				Madison Branch 2400 Kilgust Road Madison WI 53713 Phone: 608-222-9100 Fax: 608-222-9490		0 3109-0044		
							DRAWING NUMBER		
							7.5		

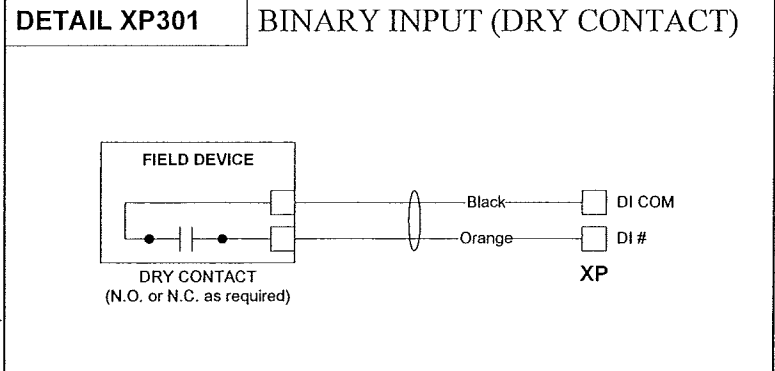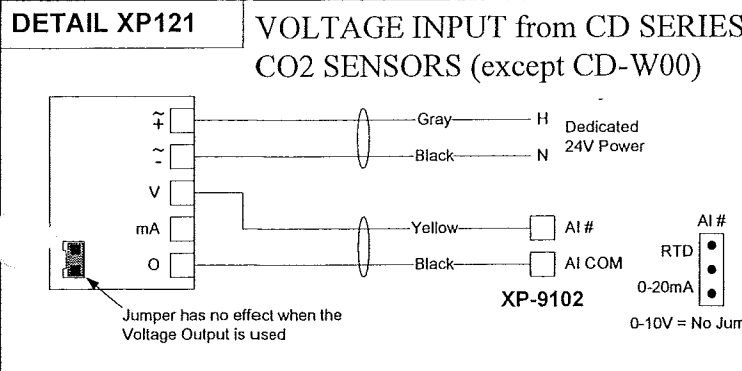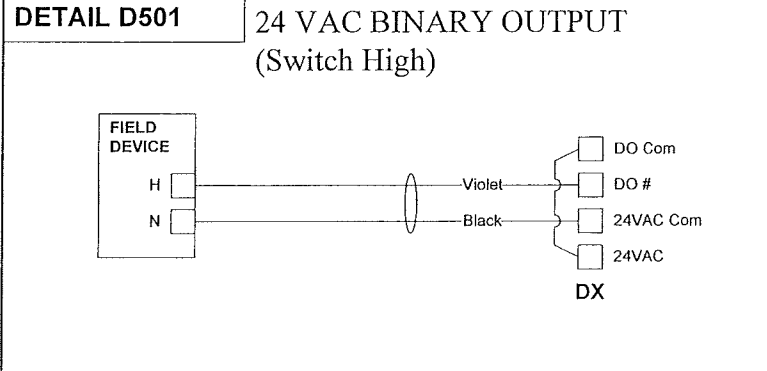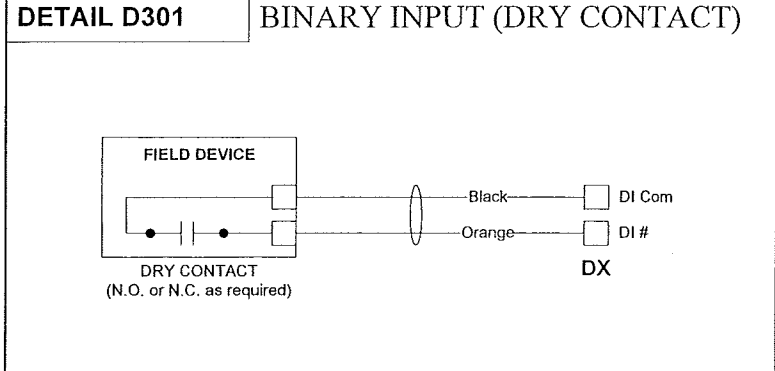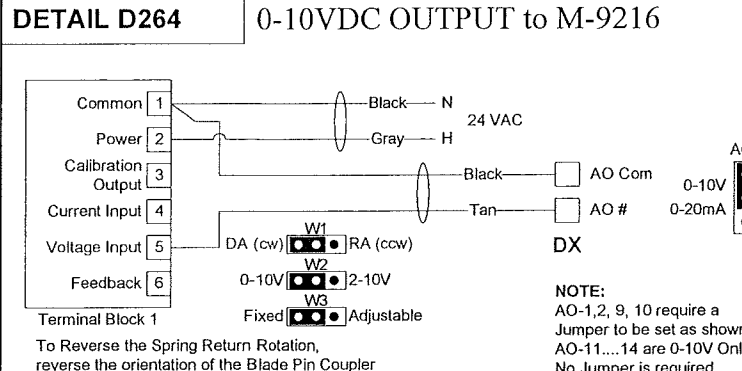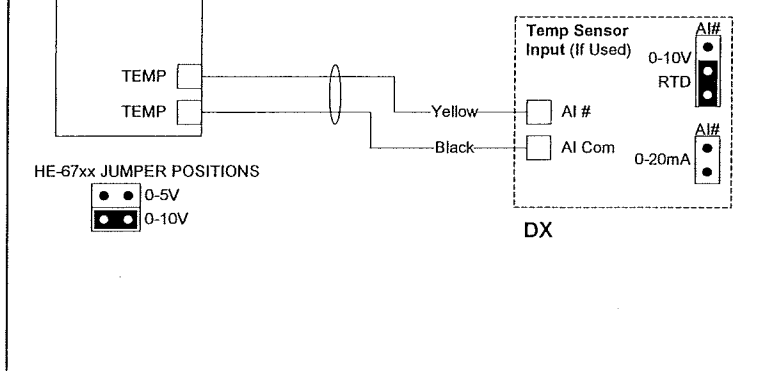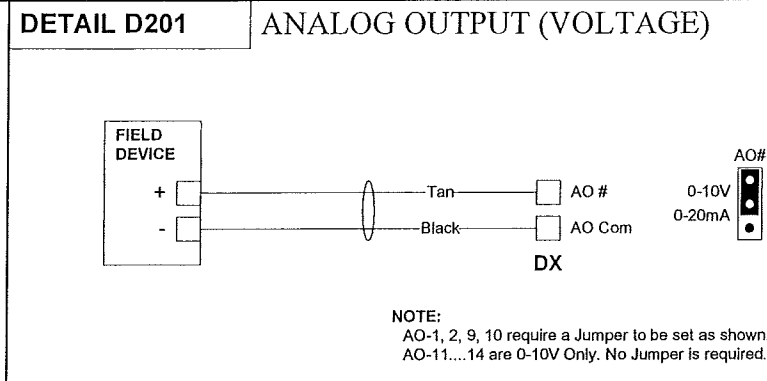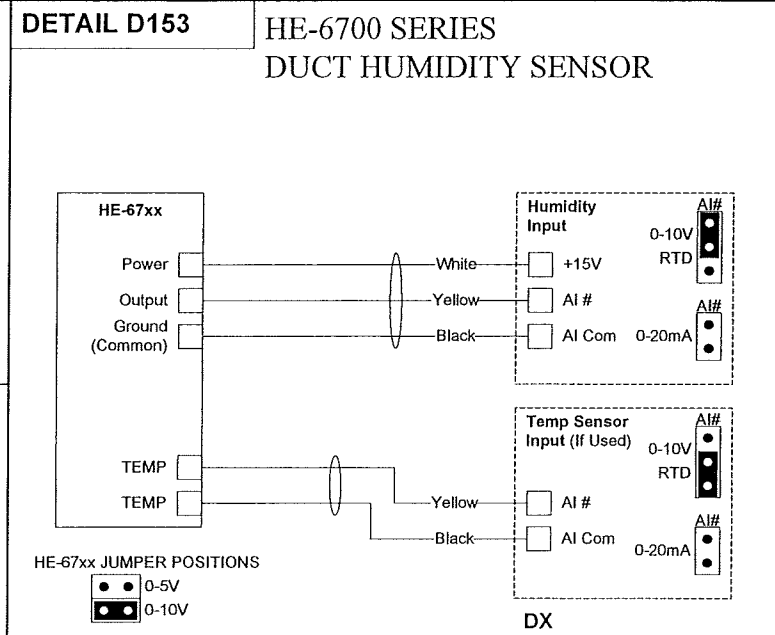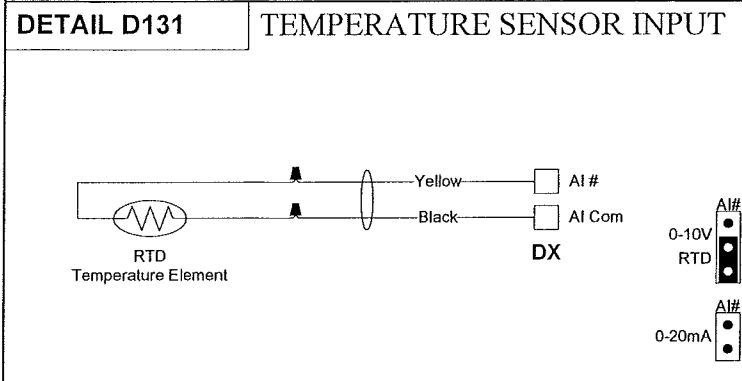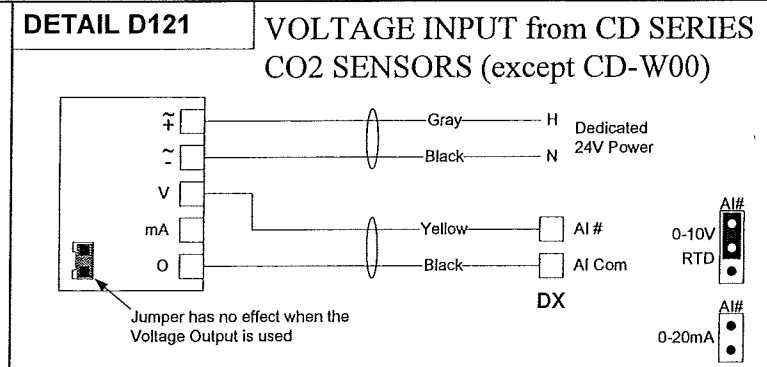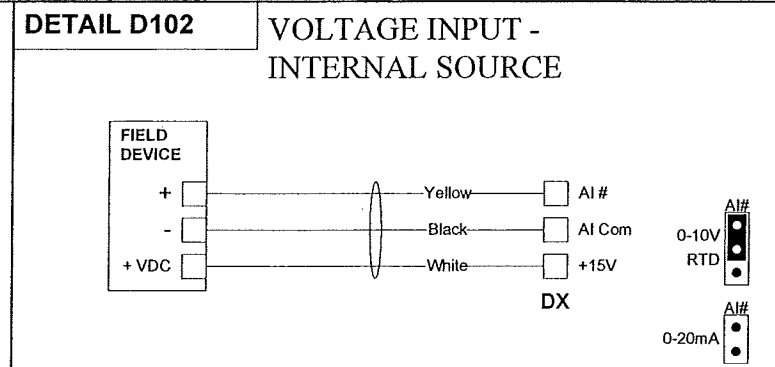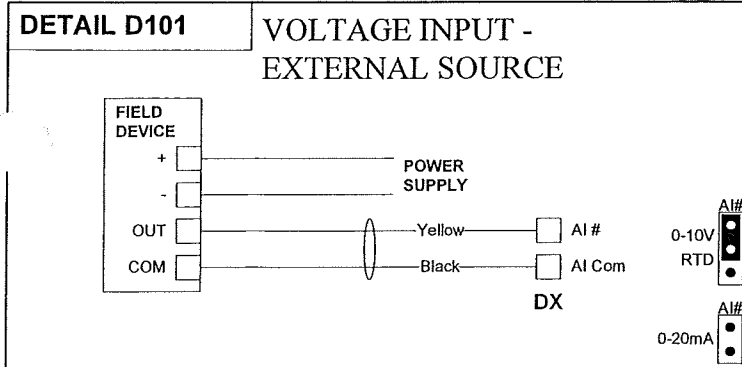

REVISION INFORMATION	Drawing Title				
NUMBER	POINT SCHEDULE				
DATE	04/17/08	1	RECORD DRAWINGS	03/30/08	WCS
TIME	08:13 AM				
FILE NAME	ahu4ps2.vsc				
Project Title		Branch Information		CONTRACT NUMBER	
DANE COUNTY COURTHOUSE 215 SOUTH HAMILTON ST. MADISON, WI 53703		Johnson Controls Systems & Services Division Madison Branch 2400 Kilgust Road Madison WI 53713 Phone: 608-222-9100 Fax: 608-222-9490		0 3109-0044	
				DRAWING NUMBER	
				7.8	

BILL OF MATERIALS

Designation	Qty	Part Number	Description
Field Devices:			
CLG-VLV, HTG-O	0	VALVE	SEE VALVE SCHEDULE
DA-H, DA-T	1	HE-67N3-0N00P	SENSOR,3%RH & 1K NI TEMP,DUCT-PROBE
FILTER-S	1	P32AC-2C	PRESS SW,DP,SPDT,5IN WC,U-BRKT
HUM-O	1	HL-67N5-8N00P	HI-LIMIT,5%RH & 1K NI TMP,WHT,DUCT-PROBE
MA-DPR, HTG-O	0	DAMPER	SEE DAMPER SCHEDULE
MA-T	1	TE-6316P-1	SENSOR,T-NI,0.1%,17FT AVG
MA-T, TS-x	8	TE-6001-8	CLIP F/AVG ELEMENT,10-PACK
PS-x	2	AFS-460	AIR FLOW SW,SPST,NC RESET 0.05-12IN
R-x	2	RIBU1C	10AMP SPDT 10-30VAC/DC/120VAC
RA-CO2, OA-CO2, DA-	3	CD-P00-00-0	SENSOR,CO2, 0-2000PPM,DUCT MOUNT
CO2			
RA-T	1	TE-6311P-1	SENSOR,T-NI,0.1%,8IN DUCT
RA-V	1	STA104-F	EBTRON-FAN-INLET-AIR-FLOW-MEASURING-STN-JMB-ASSOC.
SA-V	1	STA104-F	EBTRON-FAN-INLET-AIR-FLOW-MEASURING-STN-JMB-ASSOC.
SF-C, CS-1, RF-C, RF-S	2	H738	SENS,CURR,1A @30VAC/DC,1/3HP,CMND RELAY
ST-1, ST-2, ST-4	3	FTG18A-600R	SENSING TUBE KIT, F/P32
ST-3	1	A-302	DWYER-STATIC PRESSURE TIP, 1/4" BARB-KELE
	1	A-345	DWYER-FLANGE MOUNTING KIT FOR A-302-KELE
TS-3	1	A19ABB-2C	STAT,CROP DRY,SPST,-30/50F,BULB,OPEN LO
TS-x	2	A70BA-18C	STAT,LL,20FT ELEMENT,MANUAL,15/55F

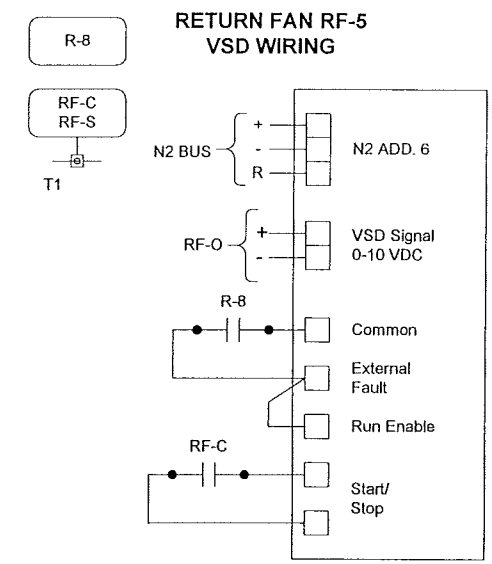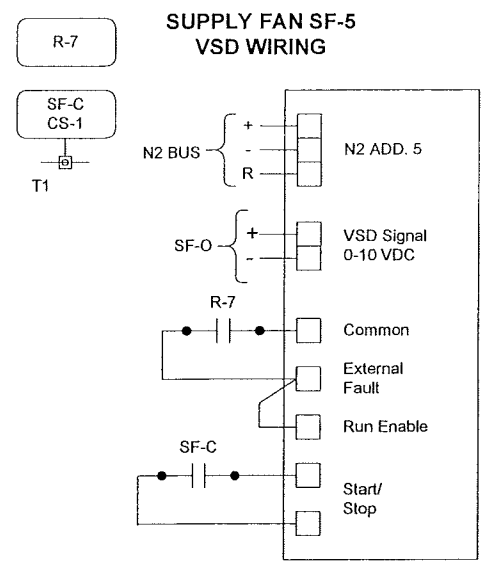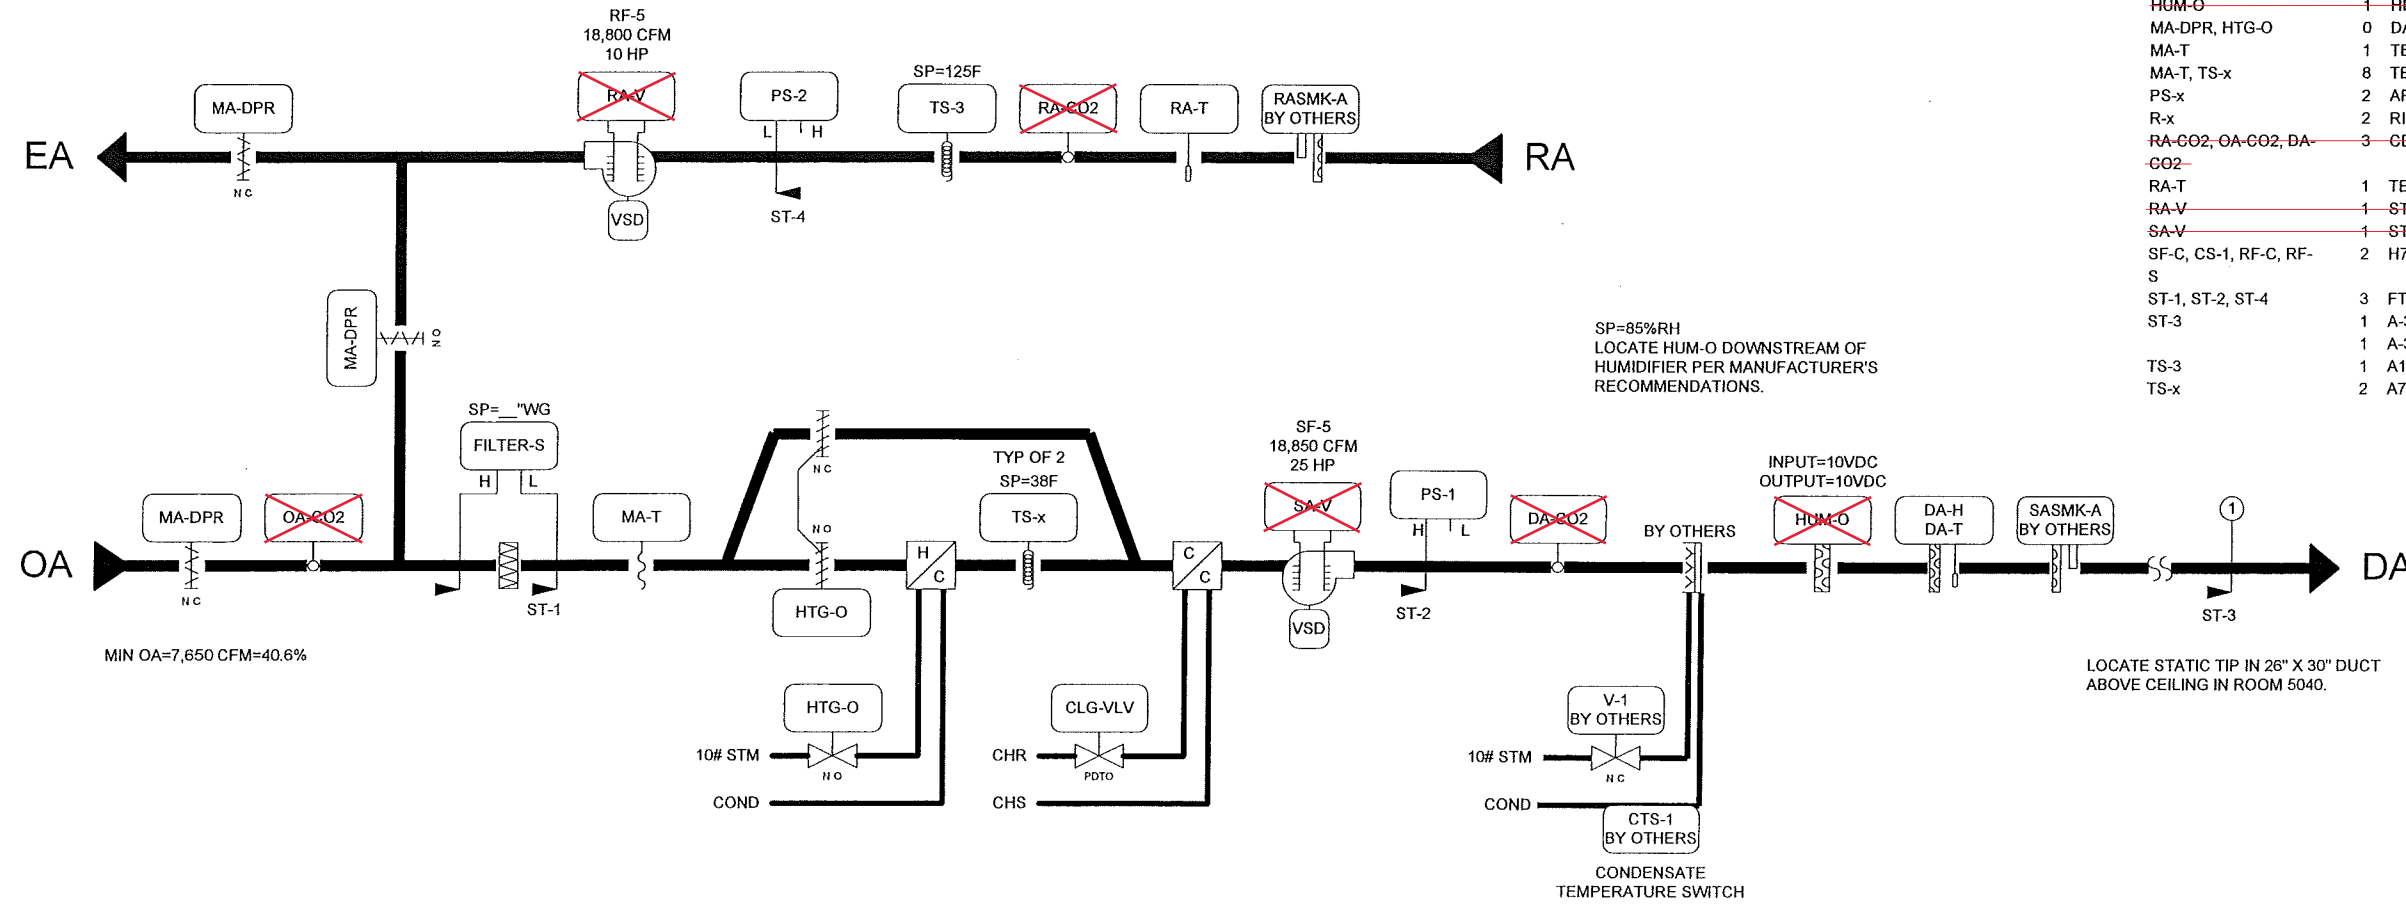

FACM BY OTHERS
FIRE ALARM CONTROL MODULE

Note: "X" items are no longer in the control sequence.



REVISION INFORMATION	Drawing Title				
NUMBER	AHU-5 FLOW				
DATE	04/17/08	1	RECORD DRAWINGS	03/30/08	WCS
TIME	09:16 AM				
FILE NAME	ahu5f.vsd				
Project Title		REFERENCE DRAWING		REVISION-LOCATION	
DANE COUNTY COURTHOUSE 215 SOUTH HAMILTON ST. MADISON, WI 53703		NO.	NO.	ECN	DATE
MADISON, WI 53703		GLA	SEL	RJM	
JOHNSON CONTROLS Systems & Services Division		DRAWN		APPROVED	
Madison Branch 2400 Kilgust Road Madison WI 53713 Phone: 608-222-9100 Fax: 608-222-9490		BY		BY	
CONTRACT NUMBER		0 3109-0044			
DRAWING NUMBER		8.1			

DA-T \ AI-7 (5-7-AI-7) 2/18 YEL	FROM LAST N2 DEVICE (N2) 3/18
SF-O \ AO-1 (5-7-AO-1) 2/18 TAN	TO NEXT N2 DEVICE (N2) 3/18
RF-O \ AO-2 (5-7-AO-2) 2/18 TAN	SF-C \ DO-3 (5-7-DO-3) 2/18 VIO
MA-DPR \ AO-9 (5-7-AO-9) 18TAN / 2/18 18GRAY	RF-C \ DO-4 (5-7-DO-4) 2/18 VIO
HTG-O \ AO-10 (5-7-AO-10) 2/18TAN / 18GRAY	RF-S \ DI-2 (5-7-DI-2) 2/18 ORG
CLG-VLV \ AO-11 (5-7-AO-11) 2/18TAN / 18GRAY	RASMK-A \ DI-3 (5-7-DI-3) 2/18 ORG
HUM-O \ AO-12 (5-7-AO-12) 2/18 TAN	SASMK-A \ DI-4 (5-7-DI-4) 2/18 ORG
OA-CO2 \ AI-1 (5-8A-AI-1) 18YEL / 2/18 18GRAY	RA-CO2 \ AI-1 (5-7-AI-1) 18YEL / 2/18 18GRAY
DA-CO2 \ AI-2 (5-8A-AI-2) 18YEL / 2/18 18GRAY	RA-V \ AI-2 (5-7-AI-2) 2/18 YEL
FILTER-S \ DI-1 (5-8B-DI-1) 2/18 ORG	RA-T \ AI-3 (5-7-AI-3) 2/18 YEL
	SA-V \ AI-4 (5-7-AI-4) 2/18 YEL
	DA-H \ AI-5 (5-7-AI-5) 3/18 YEL
	MA-T \ AI-6 (5-7-AI-6) 2/18 YEL

REVISION INFORMATION	Drawing Title								
NUMBER	AHU-5 FIELD POINTS								
DATE	04/17/08	1	RECORD DRAWINGS	03/30/08	WCS				
TIME	09:14 AM	NO.	REVISION-LOCATION	ECN	DATE	BY			
FILE NAME	ahu5fp.vsd	Sales Engineer	Project Manager	Application Engineer	DRAWN		APPROVED		
		GLA	SEL	RJM	BY	DATE	BY	DATE	
	Project Title	Branch Information		CONTRACT NUMBER					
	DANE COUNTY COURTHOUSE 215 SOUTH HAMILTON ST. MADISON, WI 53703	JOHNSON CONTROLS Systems & Services Division		Madison Branch 2400 Kilgust Road Madison WI 53713 Phone: 608-222-9100 Fax: 608-222-9490		0 3109-0044 DRAWING NUMBER 8.2			

BILL OF MATERIALS

Designation	Qty	Part Number	Description
Panel Devices:			
DA-SP	1	DPT2640-2R5B	XMTR,DIFF PR,AIR,-2.5/2.5"WC,0-5VDC,0.5%
DX-7	1	AS-LCPKEY-0	CNTRLR,LCP SERVICE KEY
	1	DX-9100-8454	CNTRLR,DIG,DX,8AI,8AO,6BO,8BI
	1	DX-9100-8990	CNTRLR,DIG,DX,MTG BASE,F/ DX-9170-8454
	1	DX-9100-8991	KIT,CNTRLR,DIG,DX,WIRING PROTECTION
P-5	1	PAN-ENC2436WDP	PANEL, HOFFMAN 24X36X9 PERF-SUB W/ DOOR
R-x, HTG-SO, HUM-E, SF-OFF, RF-OFF	10	PD-101-27	BASE F/109-38,73,74/IDEC #SH3B-05
	10	PD-109-74	RLY,3PDT,10A,24VAC,LED/IDEC RH3B-ULAC24V
RC-1	1	PD-117-02	RECEPTACLE DUPLEX IVORY
	1	PD-121-01	BOX COVER RECPT,EAGLE 2510
	1	PD-121-14	HANDY BOX, 2-1/8IN DEEP
SAFETY-OV	1	RIB2401D	10A PILOT CONTROL RELAY,DPDT,FUNC.DEVICES
TAG-1	1	NAMETAG-CUSTOM	1"X3" TAG, 3-LINES MAX, CUSTOM PNL FACE
TB-1	2	PD-113-44	END CLAMP, WIELAND Z5.522.8553.0
	36	PD-113-52	TERM BLK,6-SQ-MM WIRE SLOT,WIELAND
	1	PD-113-53	END PLATE F/113-52 TERM BLK,WIELAND
TB-PWR	1	PD-112-09	CIRCUIT BREAKER,10A,SQ-D QOU-110
	2	PD-113-44	END CLAMP, WIELAND Z5.522.8553.0
	2	PD-113-52	TERM BLK,6-SQ-MM WIRE SLOT,WIELAND
	1	PD-113-53	END PLATE F/113-52 TERM BLK,WIELAND
	3	PD-114-02	XFMR,120/24VAC,96VA
TX-x	1	XP-9102-8304	CNTRLR,DIG,DX EXPN MOD,6AI,2AO,2/DX,1/XT
XP-1	1	XP-9104-8304	CNTRLR,DIG,DX EXPN MOD,4BI,4BO,2/XT
XP-2	1	XP-9104-8304	CNTRLR,DIG,DX EXPN MOD,4BI,4BO,2/XT
XT-8	1	XT-9100-8304	CNTRLR,DIG,DX EXTENSION MODULE,8/DX

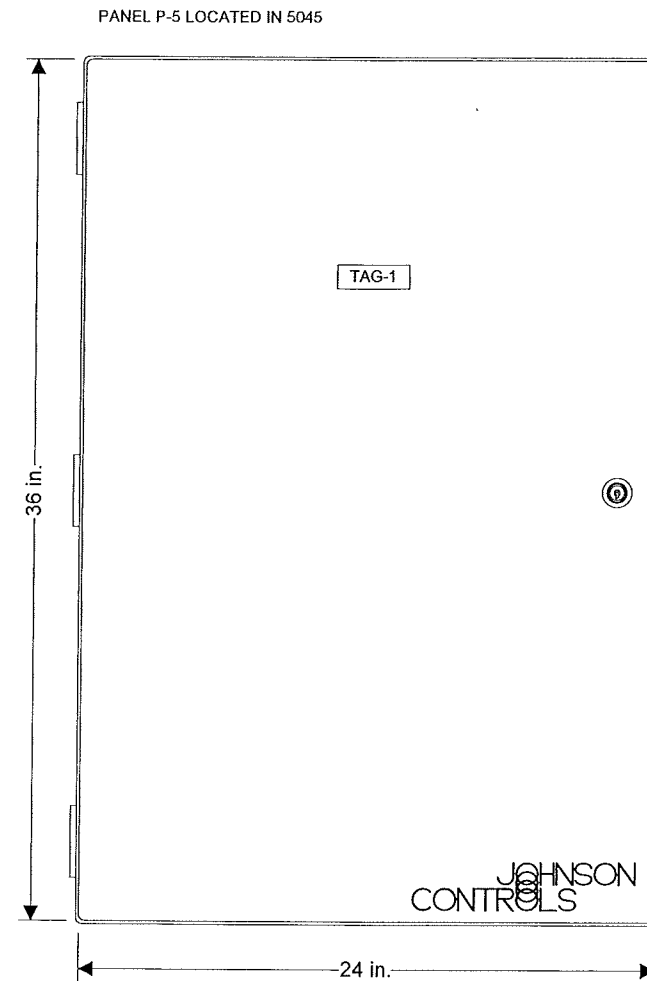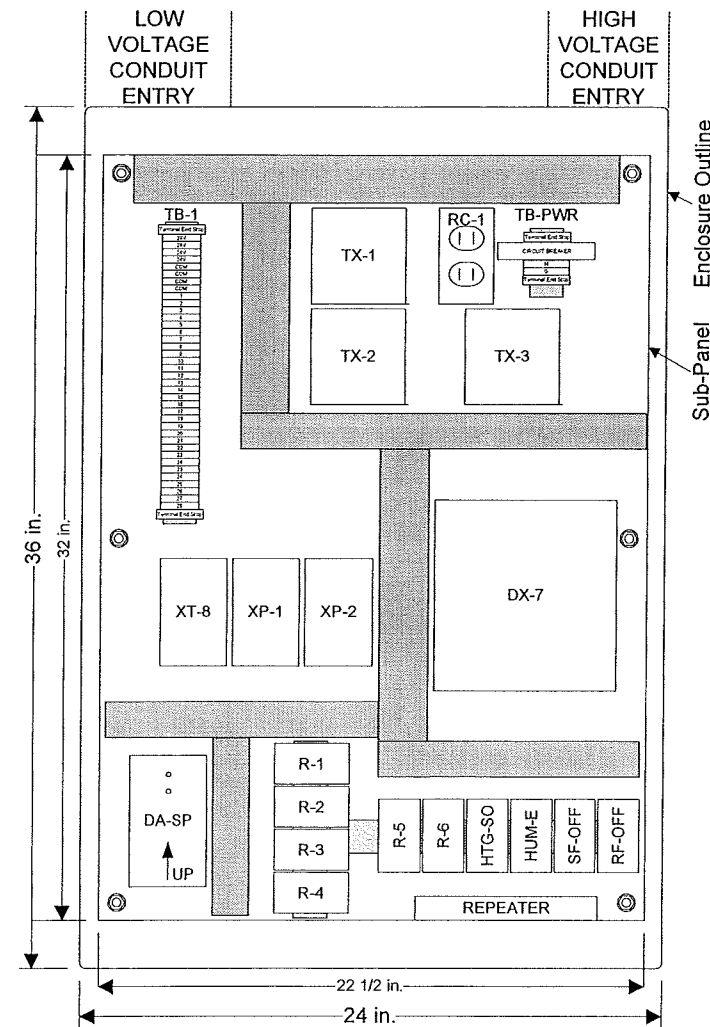


SAFETY-OV



PANEL FACE TAGS:
TAG-1: PANEL P-5
AHU-5 SERVING 5TH FLOOR
JCI 0 3109-0044

REVISION INFORMATION	Drawing Title				
NUMBER	AHU-5 PANEL LOCATED IN 5045				
DATE	04/16/08	1	RECORD DRAWINGS	03/30/08	WCS
TIME	01:08 PM	GLA	SEL	RJM	
FILE NAME	ahu5p.vsd	Project Title		Branch Information	
		DANE COUNTY COURTHOUSE 215 SOUTH HAMILTON ST. MADISON, WI 53703		Madison Branch 2400 Kilgust Road Madison WI 53713 Phone: 608-222-9100 Fax: 608-222-9490	
		JOHNSON CONTROLS Systems & Services Division		CONTRACT NUMBER 0 3109-0044 DRAWING NUMBER 8.3	



LINE VOLTAGE WIRING DIAGRAM

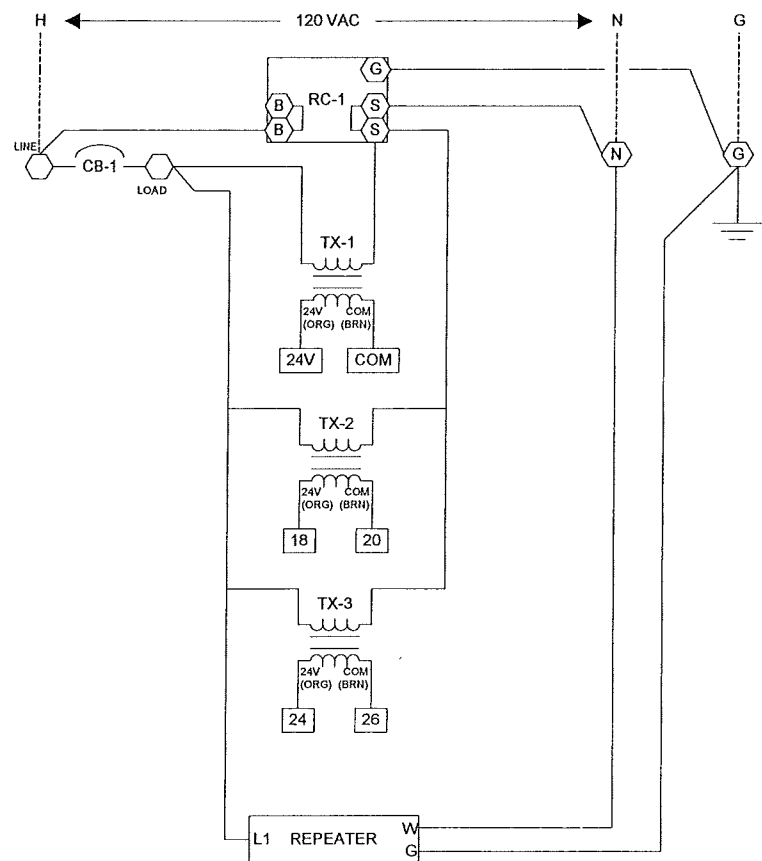

LOW VOLTAGE WIRING DIAGRAM

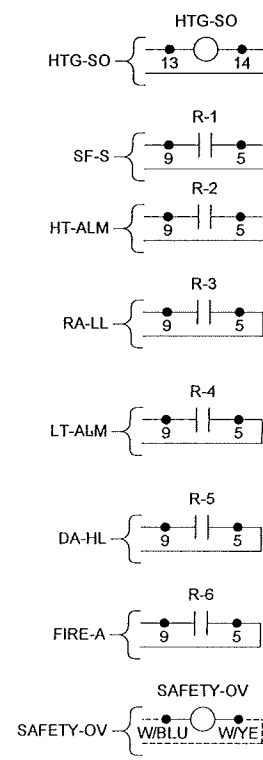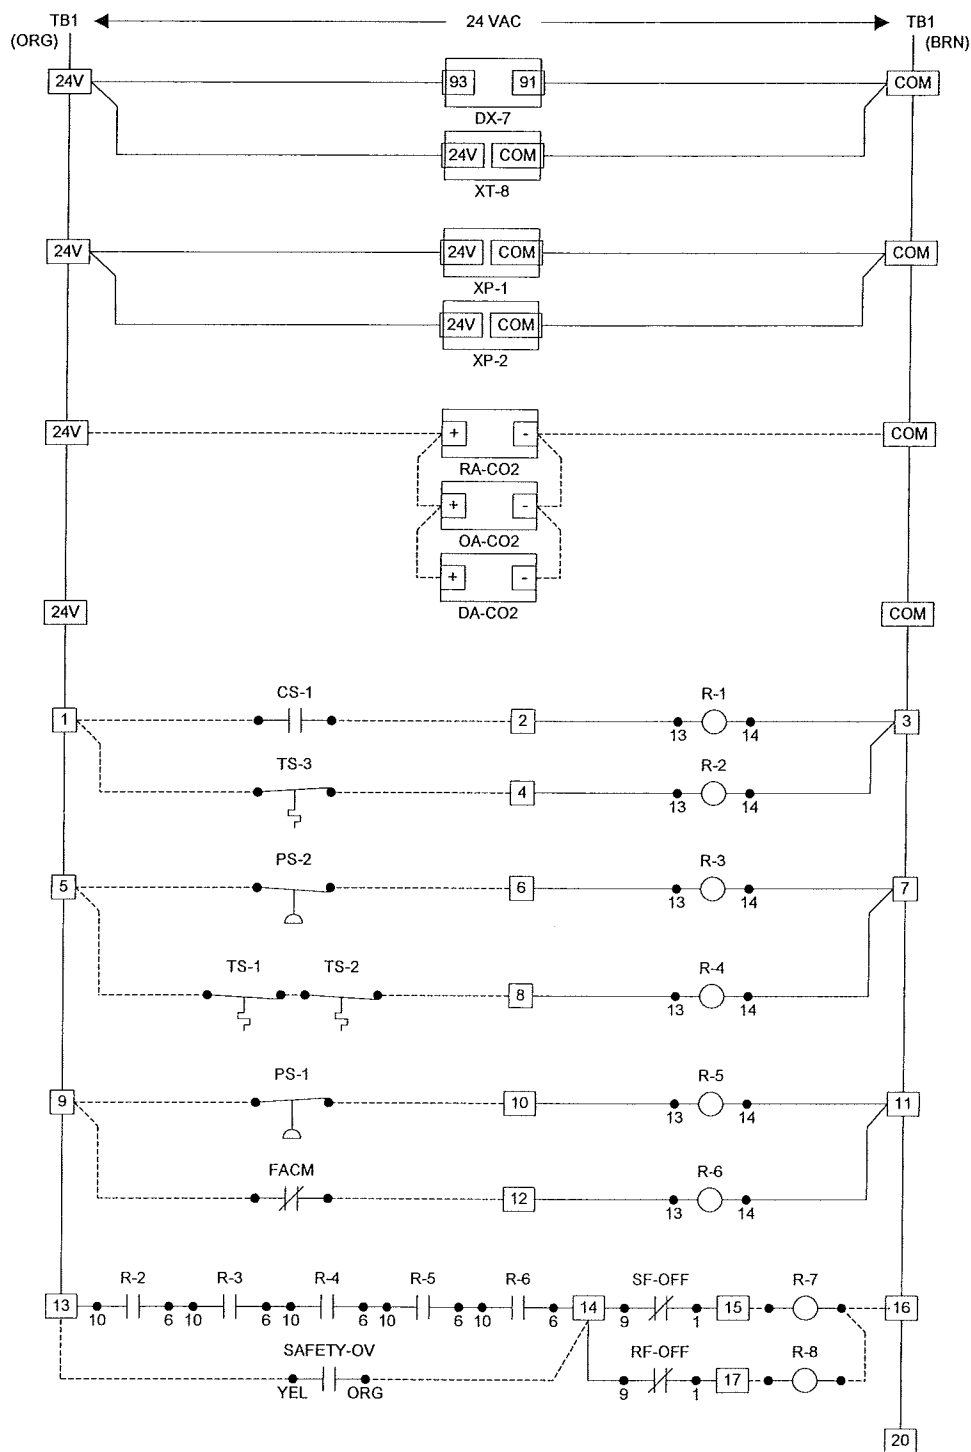

LOW VOLTAGE WIRING DIAGRAM

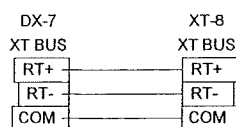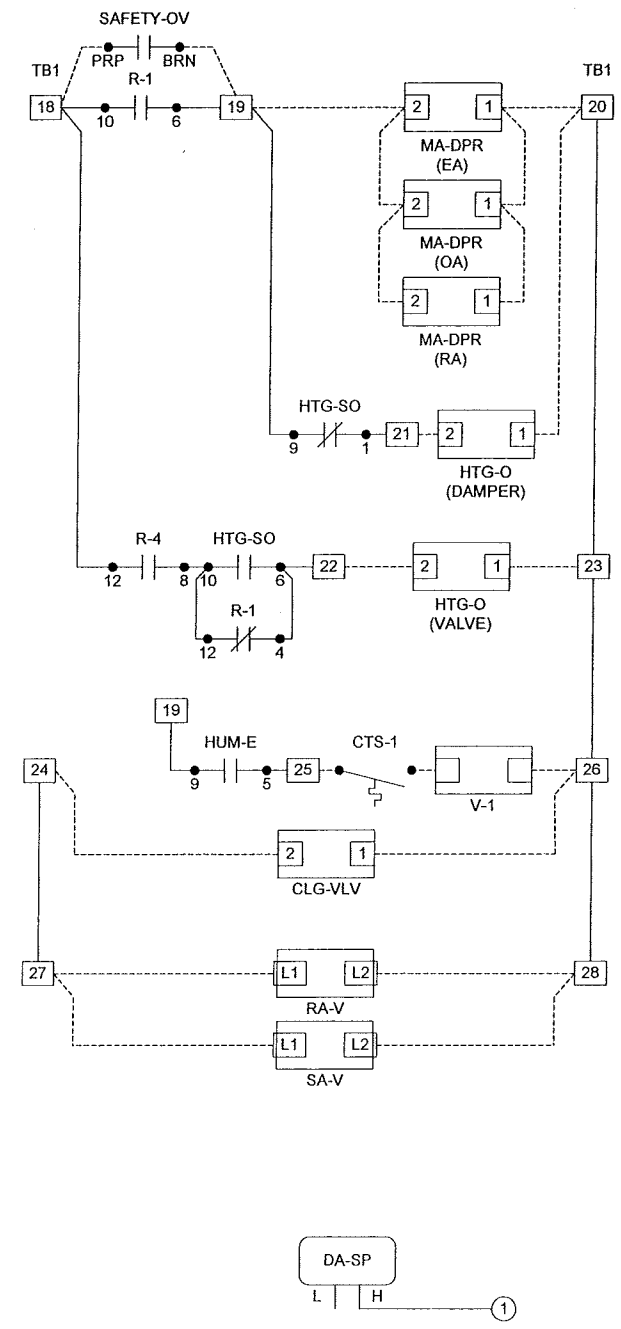

Wiring Legend

- Pneumatic Tubing
- Low Voltage Terminal
- Cable
- Line Voltage Terminal
- Panel Wiring by JCI
- Field Wiring by Others
- VAC Power

REVISION INFORMATION		Drawing Title			
NUMBER		AHU-5 PANEL WIRING			
DATE		04/16/08		1	
TIME		01:09 PM		RECORD DRAWINGS	
FILE NAME		ahu5pw.vsd		03/30/08 WCS	
Project Title		DANE COUNTY COURTHOUSE 215 SOUTH HAMILTON ST. MADISON, WI 53703			
Sales Engineer		Project Manager		Application Engineer	
GLA		SEL		RJM	
Branch Information		Madison Branch 2400 Kilgust Road Madison WI 53713 Phone: 608-222-9100 Fax: 608-222-9490			
CONTRACT NUMBER		0 3109-0044			
DRAWING NUMBER		8.4			



INDOOR AIR HANDLING UNIT VARIABLE VOLUME:

General:

Control electronically with stand-alone HVAC Node (HN).

The system will operate on a timed-programmed basis as determined by the system operator (initially set to start at 7:30 AM and stop at 6:30 PM, Monday-Friday).

System Off:

The supply and return fans will be off.

The outside air damper will be closed.

The return air damper will be open.

The steam heating will be off.

The cooling coil valve will be closed.

System Start:

When the air-handling unit is indexed to operate, the return fan will start first. Following a 5-second (adj.) delay, the supply fan will start. **NOTE:** The mixed air dampers and the supply/return fans speed drives will be ramped to their respective operating values over a time period (adj., initially set to 5 minutes)

Upon proof of supply and return fan operation, dampers, cooling coil valve, and steam valve will be indexed to their "System Run" conditions.

The air handler will be commanded on during the unoccupied mode when any of the associated zones is outside the setback set point temperatures.

System On:

Unoccupied Heating Mode:

Supply and Return Fans: Supply and return fans will cycle to maintain the lowest space temperature at the unoccupied heating set point (adj.). The supply fan speed will be controlled to maintain duct static pressure at set point (adj., initially set to 1.5" water column) and the return fan speed will volume match the supply fan.

Economizer Dampers: Outside air damper is fully closed and return air damper is fully open.

Interlock supply fan with return fan. General exhaust fans will be off. Interlock (via software) supply and return fan with smoke detector in supply and return duct.

Heating Coil Valve and Face & Bypass Dampers: operate when the supply and return fans are on.

Below 40 degrees F (adj.) mixed air temperature, fully open steam heating valve and modulate the face & bypass dampers.

Above 40 degrees F (adj.) mixed air temperature, modulate the steam heating valve and opens the face and bypass dampers to maintain supply air temperature.

Cooling Coil Valve: Fully closed.

Unoccupied Cooling Mode:

Supply and Return Fans: Supply and return fans will cycle to maintain the highest space temperature at the unoccupied cooling set point (adj.). The supply fan will be controlled to maintain duct static pressure at set point (adj., initially set to 1.5" water column) and the return fan speed will volume match the supply fan.

Economizer Dampers: Economizer dampers will be enabled to provide free cooling when the outside air temperature is below the dry bulb economizer set point.

Economizer Available: Outside air and exhaust dampers are modulated open and return air damper is modulated closed to control mixed air temperature at 55°F when the supply fan is on.

Economizer Not Available: Outside air and exhaust dampers are fully closed and return air damper is fully open.

Cooling Coil Valve: Modulating when fans are on to maintain unoccupied temperature set point.

Occupied Mode:

Supply and Return Fans: Supply and return fans will run continuously. The supply fan speed will be controlled to maintain duct static pressure and the return fan speed will be controlled to maintain a volume differential between the supply and exhaust (adj.). **Add setpoint for manual offset for return fan speed.**

Economizer Dampers: Economizer dampers will be enabled to provide free cooling when the outside air temperature is below the dry bulb economizer set point.

Economizer Available: Economizer dampers will modulate subject to a mixed air low limit of 55 degrees F (adj.).

Economizer Not Available: The economizer dampers will maintain a minimum outside air damper position (adj.).

Steam Heating and Face & Bypass Dampers: Modulate steam heating and valve in sequence with the economizer dampers to maintain the discharge air temperature at set point as reset by space temperature

Below 40 degrees F (adj.) mixed air temperature, fully open steam heating valve and modulate the face & bypass dampers.

Above 40 degrees F (adj.) mixed air temperature, modulate steam heating valve and open the face and bypass dampers to maintain supply air temperature.

Cooling Coil Valve: Modulate in sequence with the economizer dampers to maintain discharge air temperature set point.

Match existing sequence.

~~Indoor Air Quality: Provide monitoring of outside air, return air and supply air CO2 concentration, calculate and maintain fresh air requirements. Adjust outdoor air intake to ensure return air CO2 high level limit is not exceeded.~~

STEAM HUMIDIFIER:

General:

~~Control electronically with HVAC Node (HN).~~

~~Humidity monitored by duct discharge humidity sensor and controlled by a modulating control valve.~~

System Off:

The steam valve will remain closed.

System Run:

Upon proof of airflow, system will be enabled to operate.

When the duct return humidity falls below 30% relative humidity (adj.) control valve will modulate open.

Safeties and Alarms:

Humidity valve will be prevented from operating until positive proof of airflow.

Humidity High Limit: Sensor located downstream from humidifier will modulate control valve closed upon exceeding high humidity limit.

System Stop:

When the air-handling unit is indexed to shut down, the supply and return fans will stop.

Dampers and control valve will be indexed to their "System Off" conditions.

Steam Heat will shut down.

REVISION INFORMATION	Drawing Title								
NUMBER	SEQUENCE		1	RECORD DRAWINGS		03/30/08	WCS		
DATE	04/17/08	REFERENCE DRAWING	NO.	REVISION LOCATION	ECN	DATE	BY		
TIME	08:13 AM	GLA	SEL	RJM	BY	DATE	APPROVED		
FILE NAME	Ahu5s1.vsd	Project Title		Branch Information		CONTRACT NUMBER			
	DANE COUNTY COURTHOUSE 215 SOUTH HAMILTON ST. MADISON, WI 53703	JOHNSON CONTROLS Systems & Services Division		Madison Branch 2400 Kilgust Road Madison WI 53713 Phone: 608-222-9100 Fax: 608-2229490		0 3109-0044		DRAWING NUMBER 8.5	

Safeties and Alarms:

Filter Condition: Monitor differential pressure across filter and annunciate alarm when differential pressure set point is exceeded.

Low limit: Manual reset low limit thermostat will stop the supply and return fans, close the outdoor air dampers, open steam heating valve on and annunciate alarm should the coil discharge air temperature fall below 38 degrees F.

High Limit: Manual reset high limit thermostat located in the return air will stop the supply and return fans and annunciate alarm should the return air temperature rise above 125 degrees F. Dampers will be indexed to their "System Off" conditions.

Static High Limit: The static high limit sensor located in the discharge of the supply fan will shut down the unit and annunciate alarm if discharge static exceeds 3" w.g. (adj.).

Failure Modes:

Fan Failure: If the supply or return fan fails to operate, both fans will shut down and alarm will be annunciated. Dampers and control valves will be indexed to their "System Off" conditions.


Sensor Failure: Upon the failure of an analog sensor, associated dampers and control valve will remain at their last position and alarm will be annunciated.

Power Failure:

Fans: Upon restoration of power, the supply and return fans will start after an adjustable delay to provide a staggered start of all building loads.


Dampers: Economizer dampers will be provided with spring return actuators to fail to their "System Off" positions.

Valves: Heating valve will be provided with spring return actuator to fail open to the coil.

REVISION INFORMATION	Drawing Title									
NUMBER	SEQUENCE									
DATE	04/17/08	REFERENCE DRAWING NO.	1	REVISION-LOCATION	RECORD DRAWINGS	ECH	03/30/08	DATE	WCS	BY
TIME	09:14 AM	Sales Engineer	GLA	Project Manager	SEL	Application Engineer	RJM	DATE		
FILE NAME	Ahu5s2.vsd	Project Title		DANE COUNTY COURTHOUSE 215 SOUTH HAMILTON ST. MADISON, WI 53703		 Systems & Services Division		Branch Information Madison Branch 2400 Kilgust Road Madison WI 53713 Phone: 608-222-9100 Fax: 608-222-9490		CONTRACT NUMBER 0 3109-0044 DRAWING NUMBER 8.6



BILL OF MATERIALS

Designation	Qty	Part Number	Description
Field Devices:			
CLG-VLV, HTG-O	0	VALVE	SEE VALVE SCHEDULE
FILTER-S	1	P32AC-2C	PRESS SW,DP,SPDT,5IN WC,U-BRKT
HUM-O	1	HL-67N5-8N00P	HI-LIMIT,5%RH & 1K NI TMP,WHT,DUCT-PROBE
MA-DPR, HTG-O	0	DAMPER	SEE DAMPER SCHEDULE
MA-T	1	TE-6316P-1	SENSOR,T-NI,0.1%,17FT AVG
MA-T, TS-x	8	TE-6001-8	CLIP F/AVG ELEMENT,10-PACK
PS-x	2	AFS-460	AIR FLOW SW,SPST,NC RESET 0.05-12IN
R-x	2	RIBU1C	10AMP SPDT 10-30VAC/DC/120VAC
RA-CO2, OA-CO2, DA-	3	CD-P00-00-0	SENSOR,CO2, 0-2000PPM,DUCT MOUNT
CO2			
RA-H, RA-T, DA-H, DA-T	2	HE-67N3-0N00P	SENSOR,3%RH & 1K NI TEMP,DUCT-PROBE
RA-V	1	STA104-F	EBTRON-FAN INLET AIR FLOW MEASURING STN-JMB ASSOC.
SA-V	1	STA104-F	EBTRON-FAN INLET AIR FLOW MEASURING STN-JMB ASSOC.
SF-C, CS-1, RF-C, RF-S	2	H738	SENS,CURR,1A @30VAC/DC,1/3HP,CMND RELAY
ST-1, ST-2, ST-4	3	FTG18A-600R	SENSING TUBE KIT, F/P32
ST-3	1	A-302	DWYER-STATIC PRESSURE TIP, 1/4" BARB-KELE
	1	A-345	DWYER-FLANGE MOUNTING KIT FOR A-302-KELE
TS-3	1	A19ABB-2C	STAT,CROP DRY,SPST,-30/50F,BULB,OPEN LO
TS-x	2	A70BA-18C	STAT,LL,20FT ELEMENT,MANUAL,15/55F

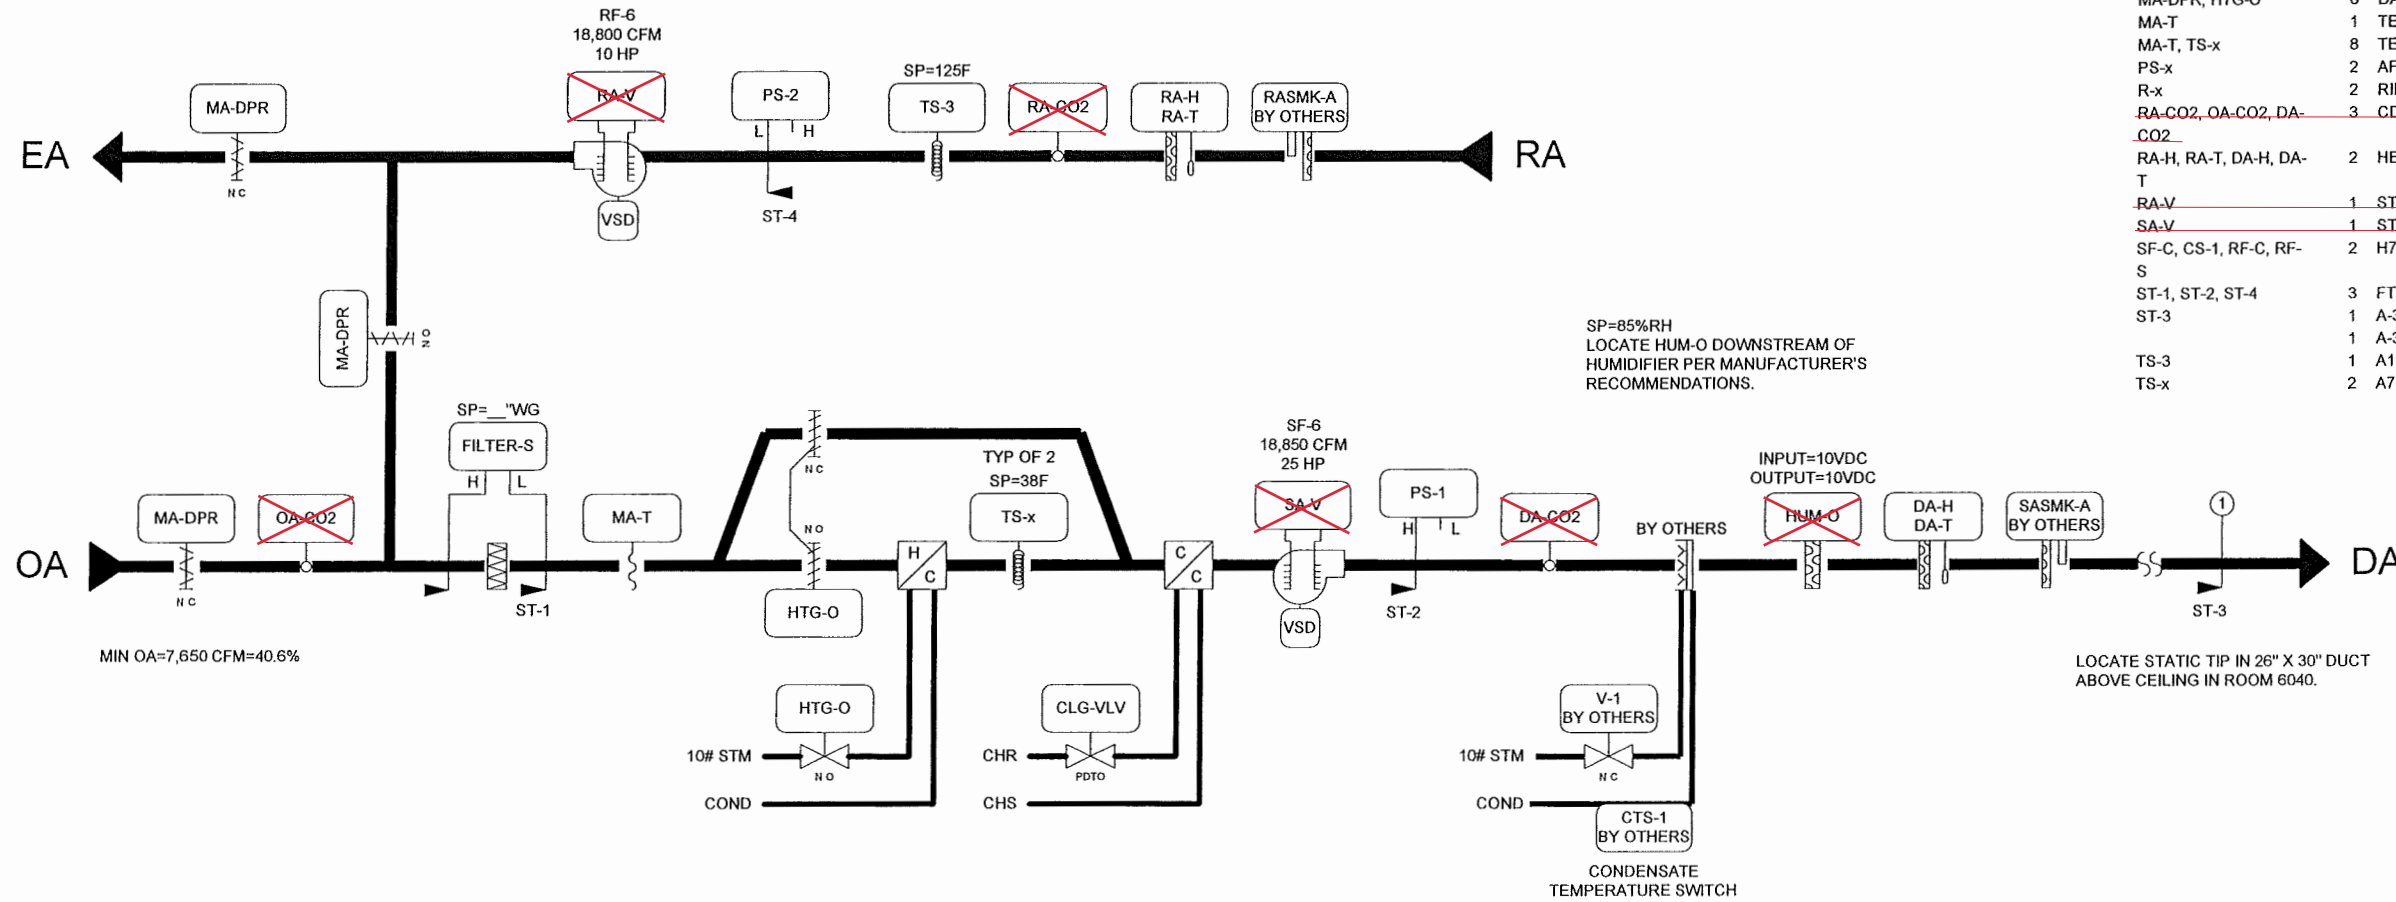

SP=85%RH
LOCATE HUM-O DOWNSTREAM OF HUMIDIFIER PER MANUFACTURER'S RECOMMENDATIONS.

LOCATE STATIC TIP IN 26" X 30" DUCT ABOVE CEILING IN ROOM 6040.

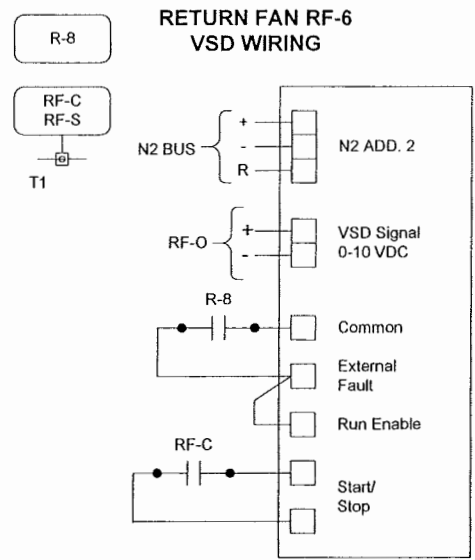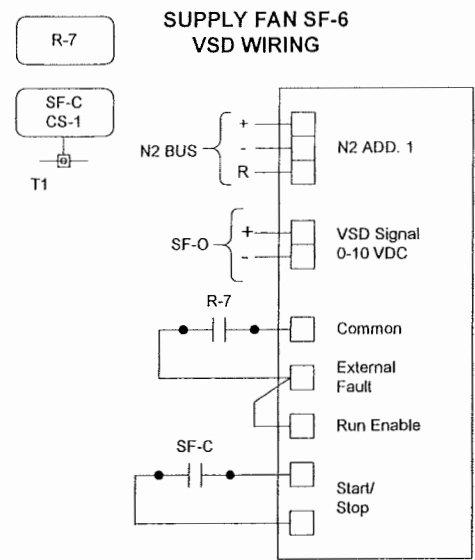

FACM BY OTHERS
FIRE ALARM CONTROL MODULE

Note: "X" items are no longer in the control sequence.



REVISION INFORMATION	Drawing Title	NO.	REVISION LOCATION	ECH	DATE	BY
NUMBER	AHU-6 FLOW	1	RECORD DRAWINGS		03/30/08	WCS
DATE	04/17/08					
TIME	08:31 AM					
FILE NAME	ahu6f.vsd					
Project Title		Branch Information		CONTRACT NUMBER		
DANE COUNTY COURTHOUSE 215 SOUTH HAMILTON ST. MADISON, WI 53703		Madison Branch 2400 Kilgust Road Madison WI 53713 Phone: 608-222-9100 Fax: 608-222-9490		0 3109-0044		
		JOHNSON CONTROLS Systems & Services Division		DRAWING NUMBER 9.1		

DA-T\AI-7 (6-3-AI-7) 2/18 YEL	FROM LAST N2 DEVICE (N2) 3/18
SF-O\AO-1 (6-3-AO-1) 2/18 TAN	TO NEXT N2 DEVICE (N2) 3/18
RF-O\AO-2 (6-3-AO-2) 2/18 TAN	SF-C\DO-3 (6-3-DO-3) 2/18 VIO
MA-DPR\AO-9 (6-3-AO-9) 18TAN / 2/18TAN /	RF-C\DO-4 (6-3-DO-4) 2/18 VIO
HTG-O\AO-10 (6-3-AO-10) 18GRAY / 2/18TAN /	RF-S\DI-2 (6-3-DI-2) 2/18 ORG
CLG-VLV\AO-11 (6-3-AO-11) 2/18TAN / 18GRAY	RASMK-A\DI-3 (6-3-DI-3) 2/18 ORG
HUM-O\AO-12 (6-3-AO-12) 2/18 TAN	SASMK-A\DI-4 (6-3-DI-4) 2/18 ORG
OA-CO2\AI-1 (6-4-AI-1) 18YEL / 2/18GRAY	RA-CO2\AI-1 (6-3-AI-1) 18YEL / 2/18GRAY
DA-CO2\AI-2 (6-4-AI-2) 18YEL / 2/18GRAY	RA-V\AI-2 (6-3-AI-2) 2/18 YEL
RA-H\AI-3 (6-4-AI-3) 3/18 YEL	RA-T\AI-3 (6-3-AI-3) 2/18 YEL
FILTER-S\DI-1 (6-4B-DI-1) 2/18 ORG	SA-V\AI-4 (6-3-AI-4) 2/18 YEL
	DA-H\AI-5 (6-3-AI-5) 3/18 YEL
	MA-T\AI-6 (6-3-AI-6) 2/18 YEL

REVISION INFORMATION	Drawing Title							
NUMBER	AHU-6 FIELD POINTS		1	RECORD DRAWINGS		03/30/08	WCS	
DATE	04/17/08	REFERENCE DRAWING	NO.	REVISION-LOCATION	ECN	DATE	BY	
TIME	08:31 AM	Sales Engineer	Project Manager	Application Engineer	DRAWN			APPROVED
FILE NAME	ahu6fp.vsd	GLA	SEL	RJM	BY	DATE	BY	DATE
	Project Title	DANE COUNTY COURTHOUSE 215 SOUTH HAMILTON ST. MADISON, WI 53703			Branch Information		CONTRACT NUMBER	
		JOHNSON CONTROLS Systems & Services Division			Madison Branch 2400 Kilgust Road Madison WI 53713 Phone: 608-222-9100 Fax: 608-222-9490		0 3109-0044	
							DRAWING NUMBER	
							9.2	

BILL OF MATERIALS

Designation	Qty	Part Number	Description
Panel Devices:			
DA-SP	1	DPT2640-2R5B	XMTR,DIFF PR,AIR,-2.5/2.5"WC,0-5VDC,0.5%
DX-3	1	AS-LCPKEY-0	CNTRLR,LCP SERVICE KEY
	1	DX-9100-8454	CNTRLR,DIG,DX,8AI,8AO,6BO,8BI
	1	DX-9100-8990	CNTRLR,DIG,DX,MTG BASE,F/ DX-9170-8454
	1	DX-9100-8991	KIT,CNTRLR,DIG,DX,WIRING PROTECTION
P-6	1	PAN-ENC2436WDP	PANEL, HOFFMAN 24X36X9 PERF-SUB W/ DOOR
R-x, HTG-SO, HUM-E, SF-OFF, RF-OFF	10	PD-101-27	BASE F/109-38,73,74/IDEC #SH3B-05
	10	PD-109-74	RLY,3PDT,10A,24VAC,LED/IDEC RH3B-ULAC24V
RC-1	1	PD-117-02	RECEPTACLE DUPLEX IVORY
	1	PD-121-01	BOX COVER RECPT,EAGLE 2510
	1	PD-121-14	HANDY BOX, 2-1/8IN DEEP
SAFETY-OV	1	RIB2401D	10A PILOT CONTROL RELAY,DPDT,FUNC.DEVICES
TAG-1	1	NAMETAG-CUSTOM	1"X3" TAG, 3-LINES MAX, CUSTOM PNL FACE
TB-1	2	PD-113-44	END CLAMP, WIELAND Z5.522.8553.0
	36	PD-113-52	TERM BLK,6-SQ-MM WIRE SLOT,WIELAND
	1	PD-113-53	END PLATE F/113-52 TERM BLK,WIELAND
TB-PWR	1	PD-112-09	CIRCUIT BREAKER,10A,SQ-D QOU-110
	2	PD-113-44	END CLAMP, WIELAND Z5.522.8553.0
	2	PD-113-52	TERM BLK,6-SQ-MM WIRE SLOT,WIELAND
	1	PD-113-53	END PLATE F/113-52 TERM BLK,WIELAND
	3	PD-114-02	XFMR,120/24VAC,96VA
TX-x	1	XP-9102-8304	CNTRLR,DIG,DX EXPN MOD,6AI,2AO,2/DX,1/XT
XP-1	1	XP-9104-8304	CNTRLR,DIG,DX EXPN MOD,4BI,4BO,2/XT
XP-2	1	XT-9100-8304	CNTRLR,DIG,DX EXTENSION MODULE,8/DX
XT-4	1		

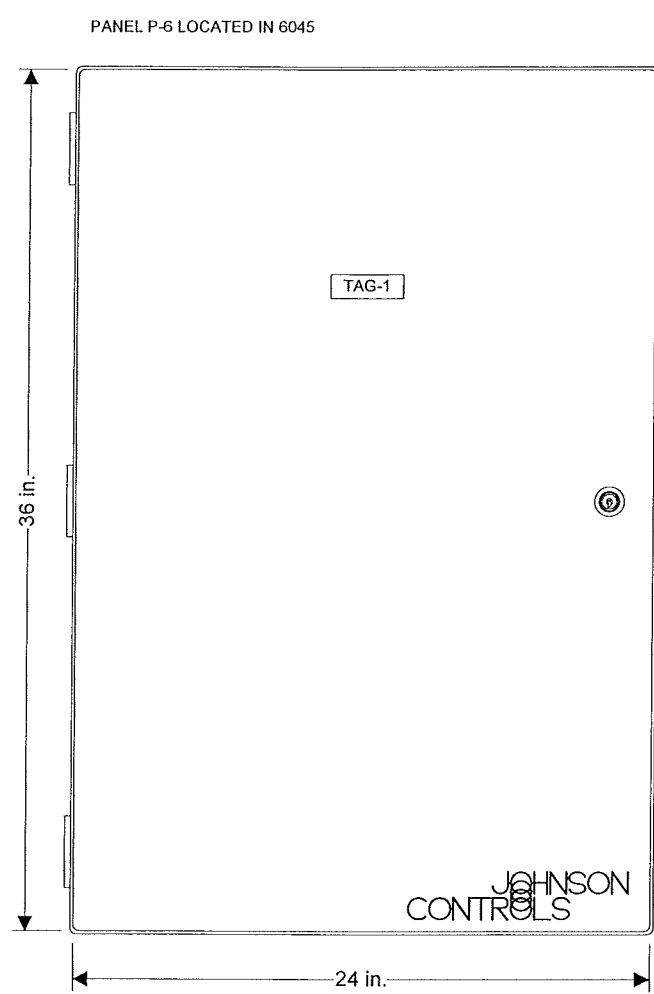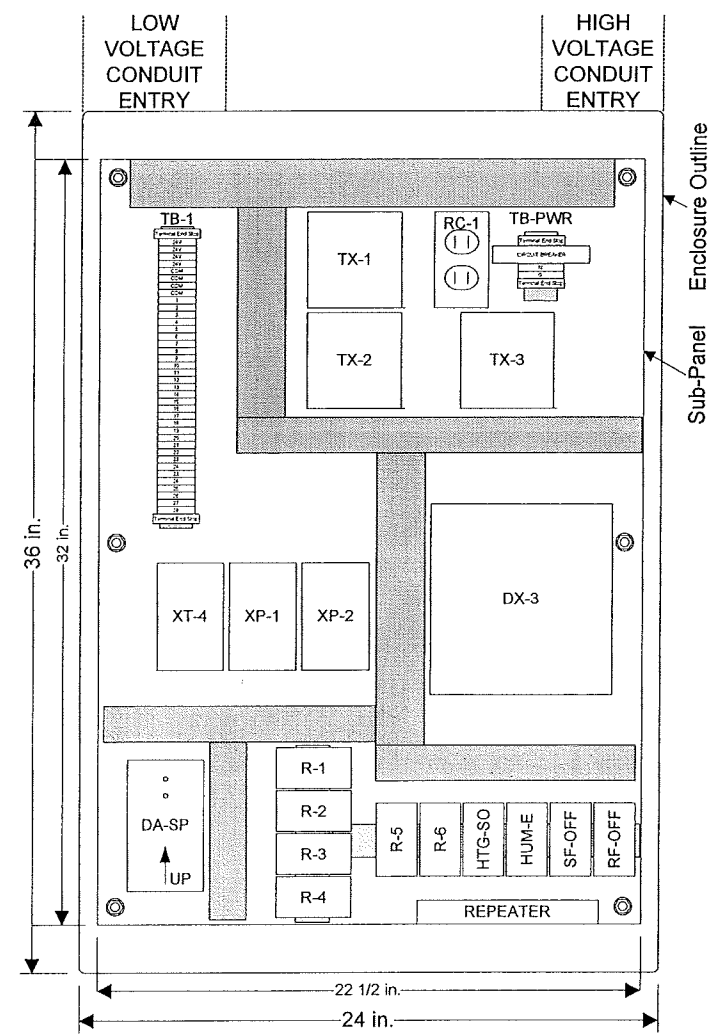


SAFETY-OV


PANEL FACE TAGS:
TAG-1: PANEL P-6
AHU-6 SERVING 6TH FLOOR
JCI 0 3109-0044

REVISION INFORMATION	Drawing Title					
NUMBER	AHU-6 PANEL LOCATED IN 6045	1	RECORD DRAWINGS	03/30/08	WCS	
DATE	04/16/08	REFERENCE DRAWING	NO.	REVISION-LOCATION	ECN DATE BY	
TIME	01:08 PM	SALES ENGINEER	PROJECT MANAGER	APPLICATION ENGINEER	DRAWN	APPROVED
FILE NAME	Project Title	GLA	SEL	RJM	BY DATE	BY DATE
	DANE COUNTY COURTHOUSE 215 SOUTH HAMILTON ST. MADISON, WI 53703	JOHNSON CONTROLS Systems & Services Division		Branch Information Madison Branch 2400 Kilgust Road Madison WI 53713 Phone: 608-222-9100 Fax: 608-222-9490	CONTRACT NUMBER 0 3109-0044 DRAWING NUMBER 9.3	




LINE VOLTAGE WIRING DIAGRAM

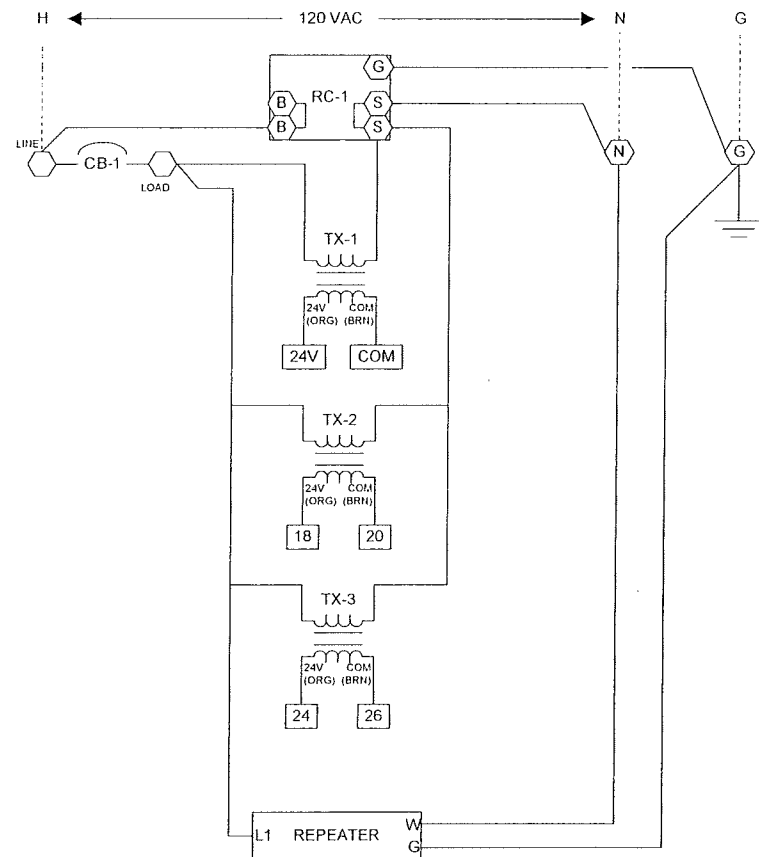

LOW VOLTAGE WIRING DIAGRAM

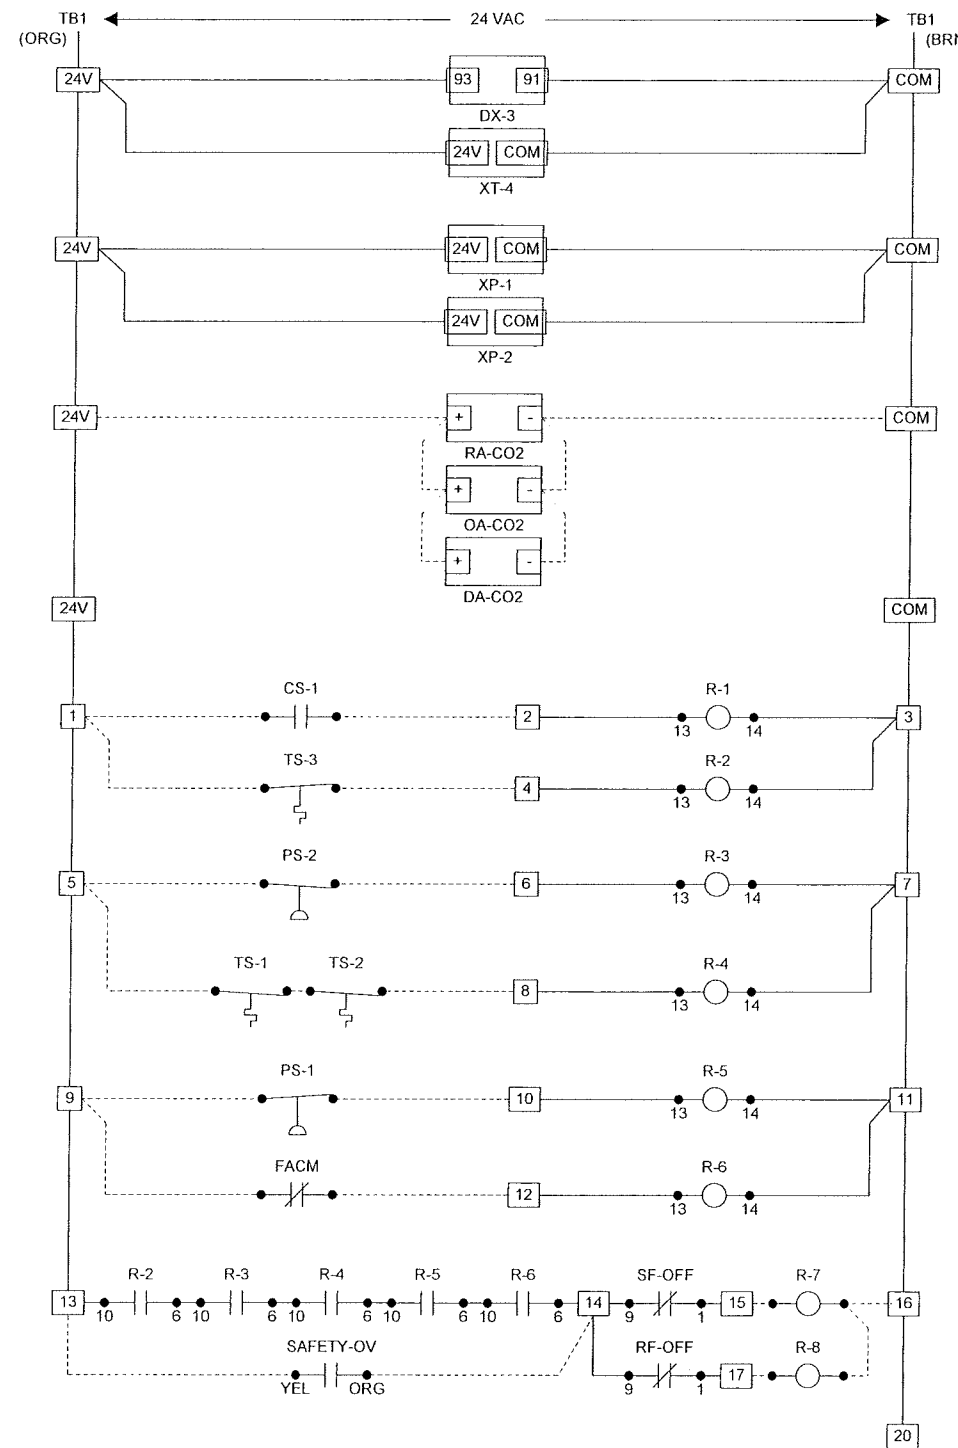

LOW VOLTAGE WIRING DIAGRAM

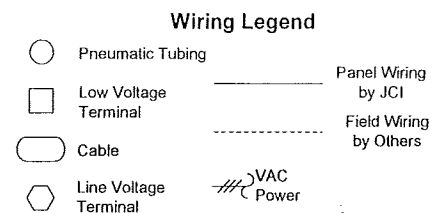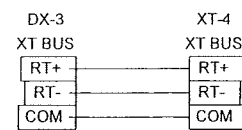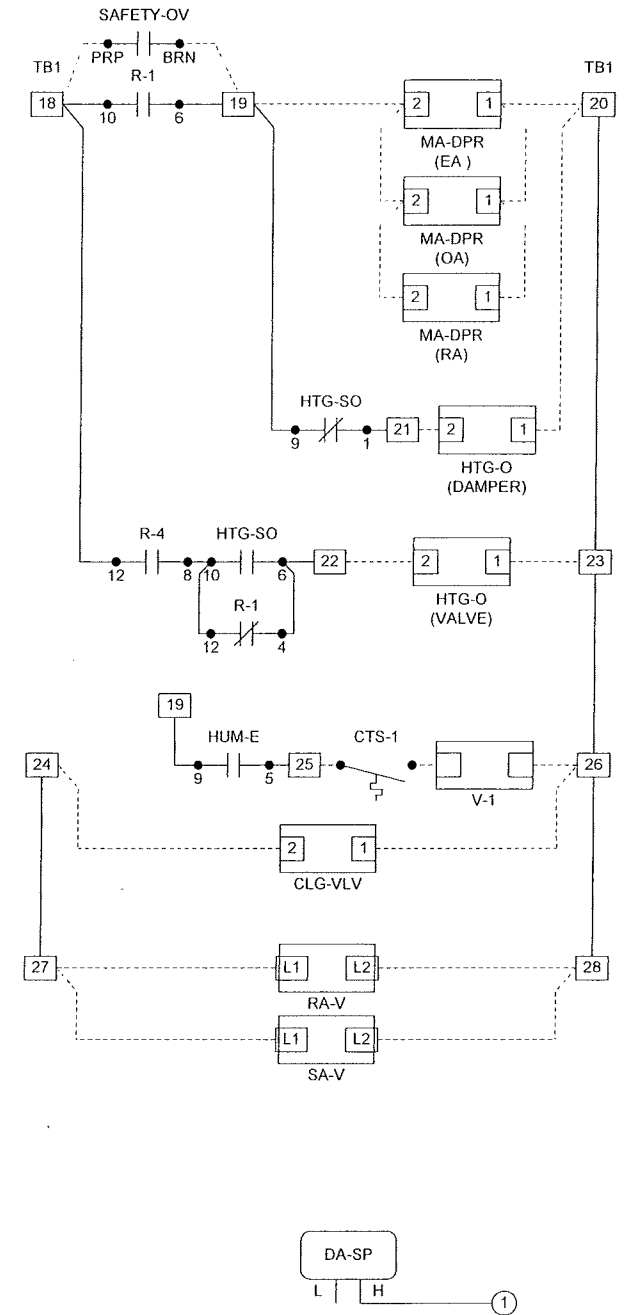

REVISION INFORMATION		Drawing Title									
NUMBER		AHU-6 PANEL WIRING									
DATE		04/16/08				1		RECORD DRAWINGS		03/30/08 WCS	
TIME		01:07 PM				Sales Engineer		Project Manager		Application Engineer	
FILE NAME		ahu6pw.vsd				GLA		SEL		RJM	
Project Title		DANE COUNTY COURTHOUSE 215 SOUTH HAMILTON ST. MADISON, WI 53703				BY		DATE		APPROVED	
Branch Information		Madison Branch 2400 Kilgust Road Madison WI 53713 Phone: 608-222-9100 Fax: 608-222-9490				DAWN				CONTRACT NUMBER	
Systems & Services Division		JOHNSON CONTROLS				BY		DATE		0 3109-0044	
						BY		DATE		DRAWING NUMBER	
										9.4	

INDOOR AIR HANDLING UNIT VARIABLE VOLUME:

General:

Control electronically with stand-alone HVAC Node (HN).

The system will operate on a timed-programmed basis as determined by the system operator (initially set to start at 7:30 AM and stop at 6:30 PM, Monday-Friday).

System Off:

The supply and return fans will be off.

The outside air damper will be closed.

The return air damper will be open.

The steam heating will be off.

The cooling coil valve will be closed.

System Start:

When the air-handling unit is indexed to operate, the return fan will start first. Following a 5-second (adj.) delay, the supply fan will start. **NOTE:** The mixed air dampers and the supply/return fans speed drives will be ramped to their respective operating values over a time period (adj., initially set to 5 minutes)

Upon proof of supply and return fan operation, dampers, cooling coil valve, and steam valve will be indexed to their "System Run" conditions.

The air handler will be commanded on during the unoccupied mode when any of the associated zones is outside the setback set point temperatures.

System On:

Unoccupied Heating Mode:

Supply and Return Fans: Supply and return fans will cycle to maintain the lowest space temperature at the unoccupied heating set point (adj.). The supply fan speed will be controlled to maintain duct static pressure at set point (adj., initially set to 1.5" water column) and the return fan speed will volume match the supply fan.

Economizer Dampers: Outside air damper is fully closed and return air damper is fully open.

Interlock supply fan with return fan. General exhaust fans will be off. Interlock (via software) supply and return fan with smoke detector in supply and return duct.

Heating Coil Valve and Face & Bypass Dampers: operate when the supply and return fans are on.

Below 40 degrees F (adj.) mixed air temperature, fully open steam heating valve and modulate the face & bypass dampers.

Above 40 degrees F (adj.) mixed air temperature, modulate the steam heating valve and opens the face and bypass dampers to maintain supply air temperature.

Cooling Coil Valve: Fully closed.

Unoccupied Cooling Mode:

Supply and Return Fans: Supply and return fans will cycle to maintain the highest space temperature at the unoccupied cooling set point (adj.). The supply fan will be controlled to maintain duct static pressure at set point (adj., initially set to 1.5" water column) and the return fan speed will volume match the supply fan.

Economizer Dampers: Economizer dampers will be enabled to provide free cooling when the outside air temperature is below the dry bulb economizer set point.

Economizer Available: Outside air and exhaust dampers are modulated open and return air damper is modulated closed to control mixed air temperature at 55°F when the supply fan is on.

Economizer Not Available: Outside air and exhaust dampers are fully closed and return air damper is fully open.

Cooling Coil Valve: Modulating when fans are on to maintain unoccupied temperature set point.

Occupied Mode:

Supply and Return Fans: Supply and return fans will run continuously. The supply fan speed will be controlled to maintain duct static pressure and the return fan speed will be controlled to maintain a volume differential between the supply and exhaust (adj.). **Add setpoint for manual offset for return fan speed.**

Economizer Dampers: Economizer dampers will be enabled to provide free cooling when the outside air temperature is below the dry bulb economizer set point.

Economizer Available: Economizer dampers will modulate subject to a mixed air low limit of 55 degrees F (adj.).

Economizer Not Available: The economizer dampers will maintain a minimum outside air damper position (adj.).

Steam Heating and Face & Bypass Dampers: Modulate steam heating and valve in sequence with the economizer dampers to maintain the discharge air temperature at set point as reset by space temperature

Below 40 degrees F (adj.) mixed air temperature, fully open steam heating valve and modulate the face & bypass dampers.

Above 40 degrees F (adj.) mixed air temperature, modulate steam heating valve and open the face and bypass dampers to maintain supply air temperature.

Cooling Coil Valve: Modulate in sequence with the economizer dampers to maintain discharge air temperature set point.

Match existing sequence.

~~Indoor Air Quality: Provide monitoring of outside air, return air and supply air CO2 concentration, calculate and maintain fresh air requirements. Adjust outdoor air intake to ensure return air CO2 high level limit is not exceeded.~~

STEAM HUMIDIFIER:

General:

~~Control electronically with HVAC Node (HN).~~

~~Humidity monitored by duct discharge humidity sensor and controlled by a modulating control valve.~~

System Off:

The steam valve will remain closed.

System Run:

Upon proof of airflow, system will be enabled to operate.

When the duct return humidity falls below 30% relative humidity (adj.) control valve will modulate open.

Safeties and Alarms:

Humidity valve will be prevented from operating until positive proof of airflow.


Humidity High Limit: Sensor located downstream from humidifier will modulate control valve closed upon exceeding high humidity limit.













System Stop:

When the air-handling unit is indexed to shut down, the supply and return fans will stop.

Dampers and control valve will be indexed to their "System Off" conditions.


Steam Heat will shut down.

REVISION INFORMATION	Drawing Title								
NUMBER	SEQUENCE		1	RECORD DRAWINGS		03/30/08	WCS		
DATE	04/17/08	REFERENCE DRAWING	NO.	REVISION-LOCATION	ECN	DATE	BY		
TIME	08:13 AM	Sales Engineer	Project Manager	Application Engineer	BY	DATE	APPROVED		
FILE NAME	Ahu6s1.vsd	GLA	SEL	RJM					
	Project Title	DANE COUNTY COURTHOUSE 215 SOUTH HAMILTON ST. MADISON, WI 53703				Branch Information Madison Branch 2400 Kilgust Road Madison WI 53713 Phone: 608222-9100 Fax: 608222-9490		CONTRACT NUMBER 0 3109-0044 DRAWING NUMBER 9.5	

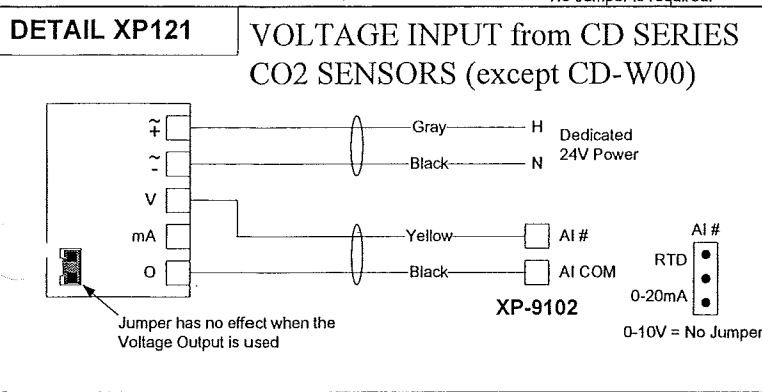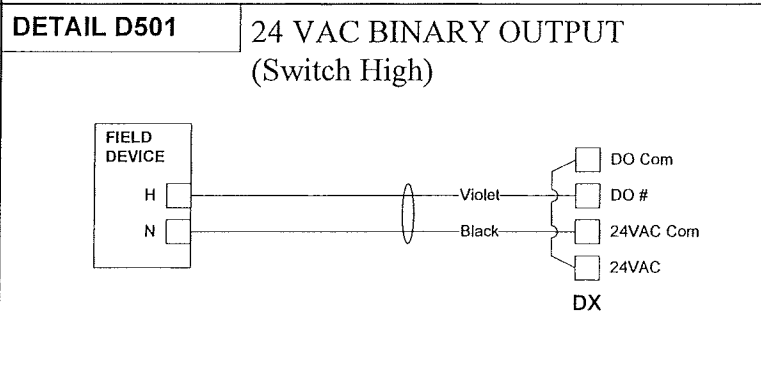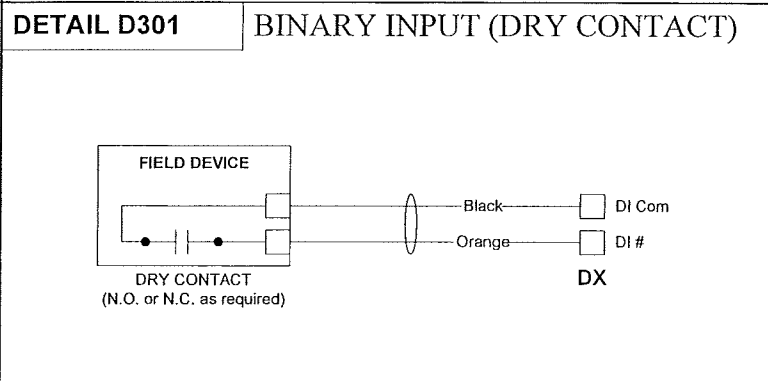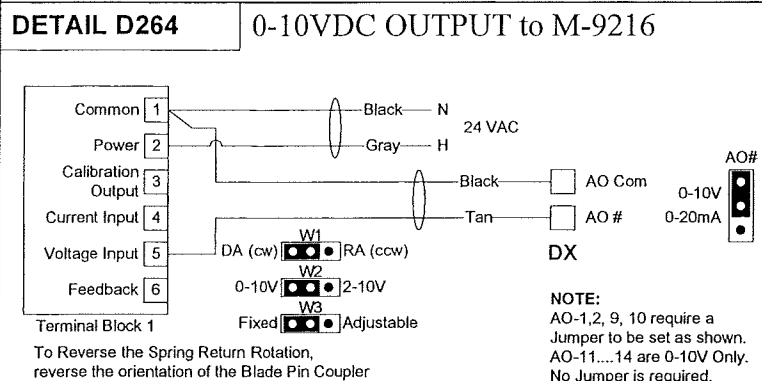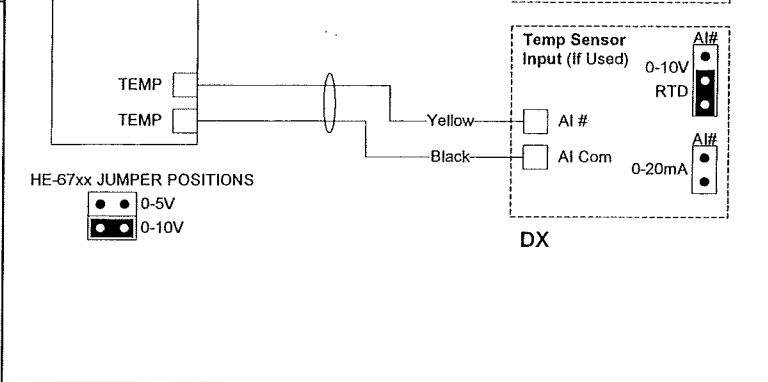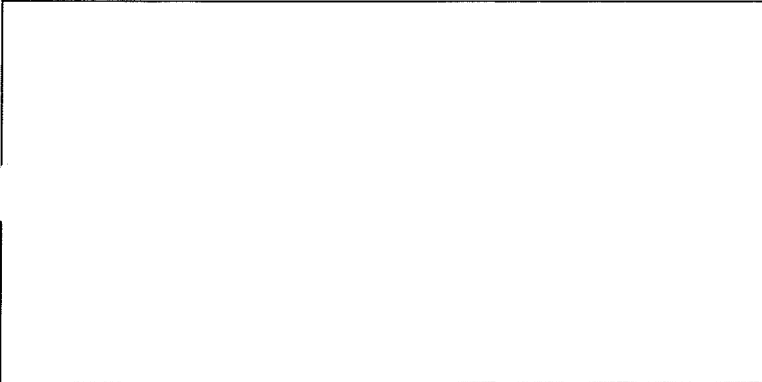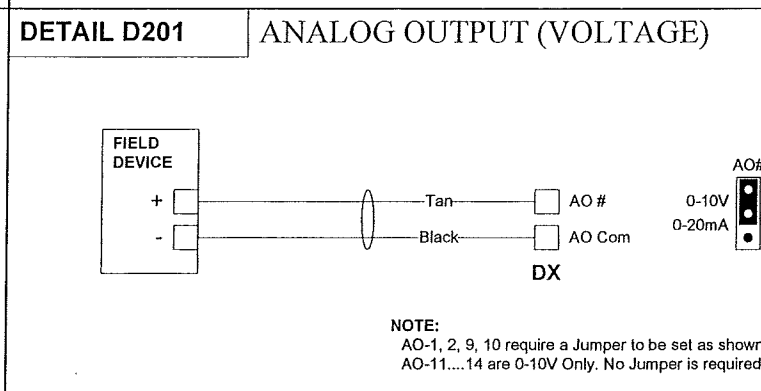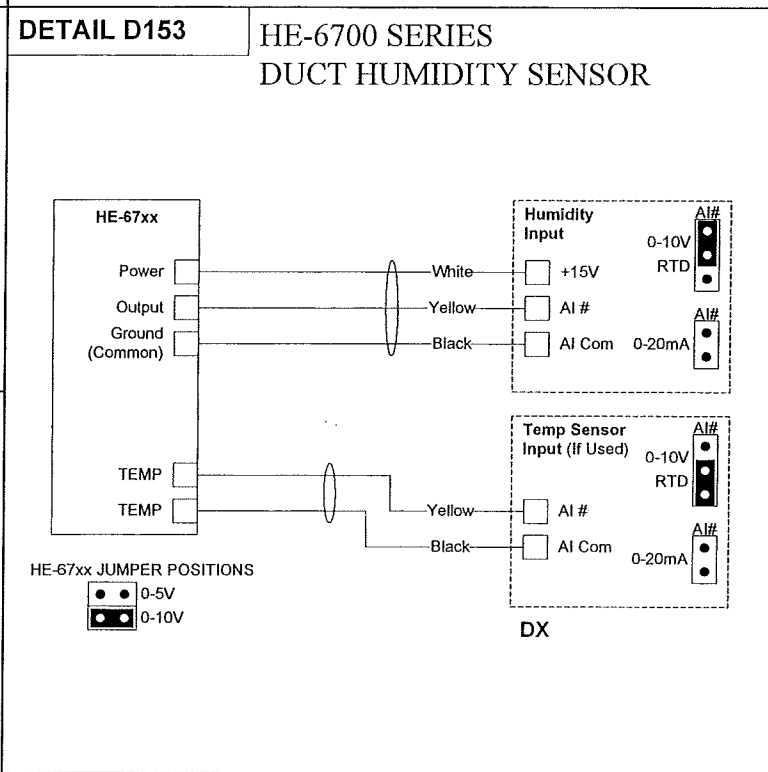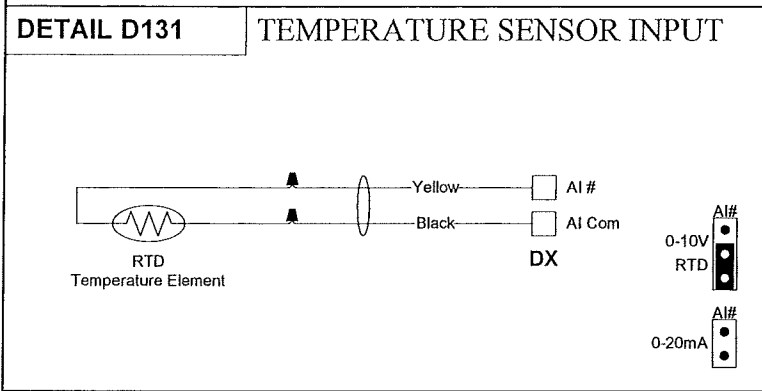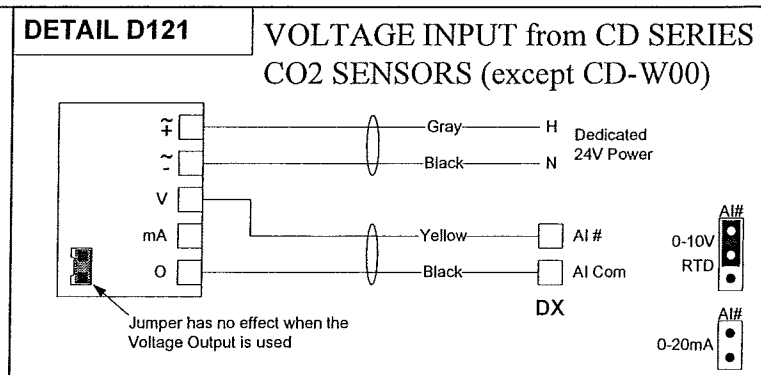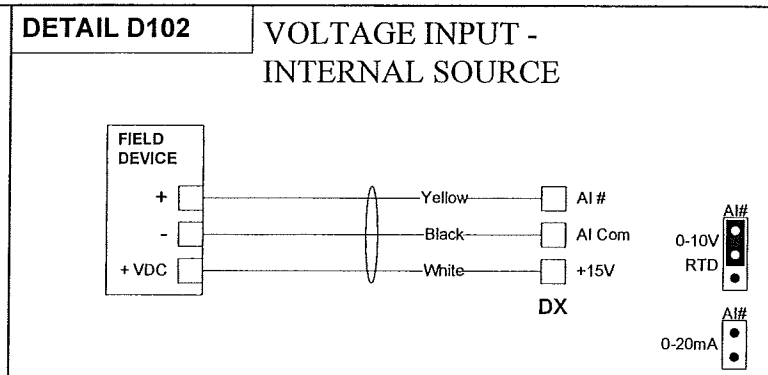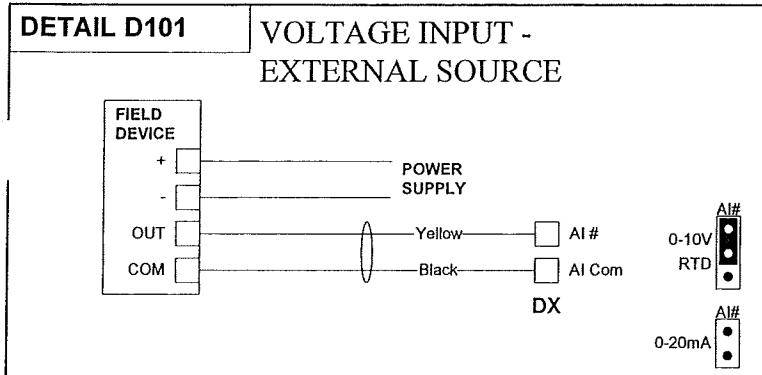


REVISION INFORMATION		Drawing Title									
NUMBER		POINT SCHEDULE		1		RECORD DRAWINGS		03/30/08		WCS	
DATE		04/17/08		REFERENCE DRAWING		NO.		REVISION-LOCATION		ECN	
TIME		08:13 AM		Sales Engineer		Project Manager		Application Engineer		APPROVED	
FILE NAME		ahu6ps2.vsc		GLA		SEL		RJM		DATE	
		Project Title		BY		DATE		BY		DATE	
		DANE COUNTY COURTHOUSE 215 SOUTH HAMILTON ST. MADISON, WI 53703		Branch Information		CONTRACT NUMBER					
				JOHNSON CONTROLS Systems & Services Division		0 3109-0044					
				Madison Branch 2400 Kilgust Road Madison WI 53713 Phone: 608-222-9100 Fax: 608-222-9490		DRAWING NUMBER				9.8	

DETAIL XP153 HE-6700 SERIES
DUCT HUMIDITY SENSOR

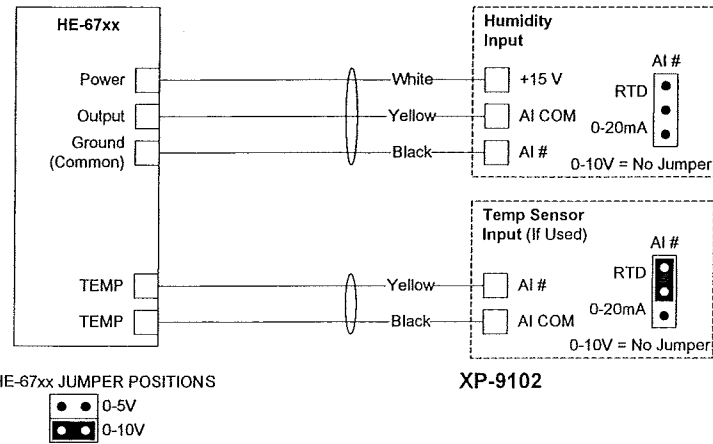


DETAIL XP301 BINARY INPUT (DRY CONTACT)

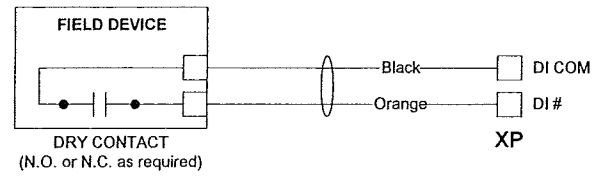



REVISION INFORMATION	Drawing Title								
NUMBER	POINT SCHEDULE								
DATE	04/17/08								
TIME	08:12 AM								
FILE NAME	ahu6ps3.vsc								
		1	RECORD DRAWINGS			03/30/08	WCS		
		NO.	REVISION-LOCATION	ECH	DATE	BY			
		SALES ENGINEER	PROJECT MANAGER	APPLICATION ENGINEER	DATE	BY	DATE		
		GLA	SEL	RJM					
	Project Title	Branch Information		CONTRACT NUMBER					
	DANE COUNTY COURTHOUSE 215 SOUTH HAMILTON ST. MADISON, WI 53703	Madison Branch 2400 Kilgust Road Madison WI 53713 Phone: 608-222-9100 Fax: 608-222-9490		0 3109-0044					
		JOHNSON CONTROLS Systems & Services Division		DRAWING NUMBER					
				9.9					

BILL OF MATERIALS

Designation	Qty	Part Number	Description
Field Devices:			
CLG-VLV, HTG-O	0	VALVE	SEE VALVE SCHEDULE
DA-H, DA-T	1	HE-67N3-0N00P	SENSOR,3%RH & 1K NI TEMP,DUCT-PROBE
FILTER-S	1	P32AC-2C	PRESS SW,DP,SPDT,5IN WC,U-BRKT
HUM-O	1	HL-67N5-0N00P	HI-LIMIT,5%RH & 1K NI-TMP,WHT,DUCT-PROBE
MA-DPR, HTG-O	0	DAMPER	SEE DAMPER SCHEDULE
MA-T	1	TE-6316P-1	SENSOR,T-NI,0.1%,17FT AVG
MA-T, TS-x	8	TE-6001-8	CLIP F/AVG ELEMENT,10-PACK
PS-x	2	AFS-460	AIR FLOW SW,SPST,NC RESET 0.05-12IN
R-x	2	RIBU1C	10AMP SPDT 10-30VAC/DC/120VAC
RA-CO2, OA-CO2, DA-CO2	3	CD-P09-00-0	SENSOR,CO2, 0-2000PPM,DUCT MOUNT
RA-T	1	TE-6311P-1	SENSOR,T-NI,0.1%,8IN DUCT
RA-V	1	STA104-F	EBTRON-FAN INLET AIR-FLOW-MEASURING STN-JMB ASSOC.
SA-V	1	STA104-F	EBTRON-FAN INLET AIR-FLOW-MEASURING STN-JMB ASSOC.
SF-C, CS-1, RF-C, RF-S	2	H738	SENS,CURR,1A @30VAC/DC,1/3HP,CMND RELAY
ST-1, ST-2, ST-4	3	FTG18A-600R	SENSING TUBE KIT, F/P32
ST-3	1	A-302	DWYER-STATIC PRESSURE TIP, 1/4" BARB-KELE
	1	A-345	DWYER-FLANGE MOUNTING KIT FOR A-302-KELE
TS-3	1	A19ABB-2C	STAT,CROP DRY,SPST,-30/50F,BULB,OPEN LO
TS-x	2	A70BA-18C	STAT,LL,20FT ELEMENT,MANUAL,15/55F

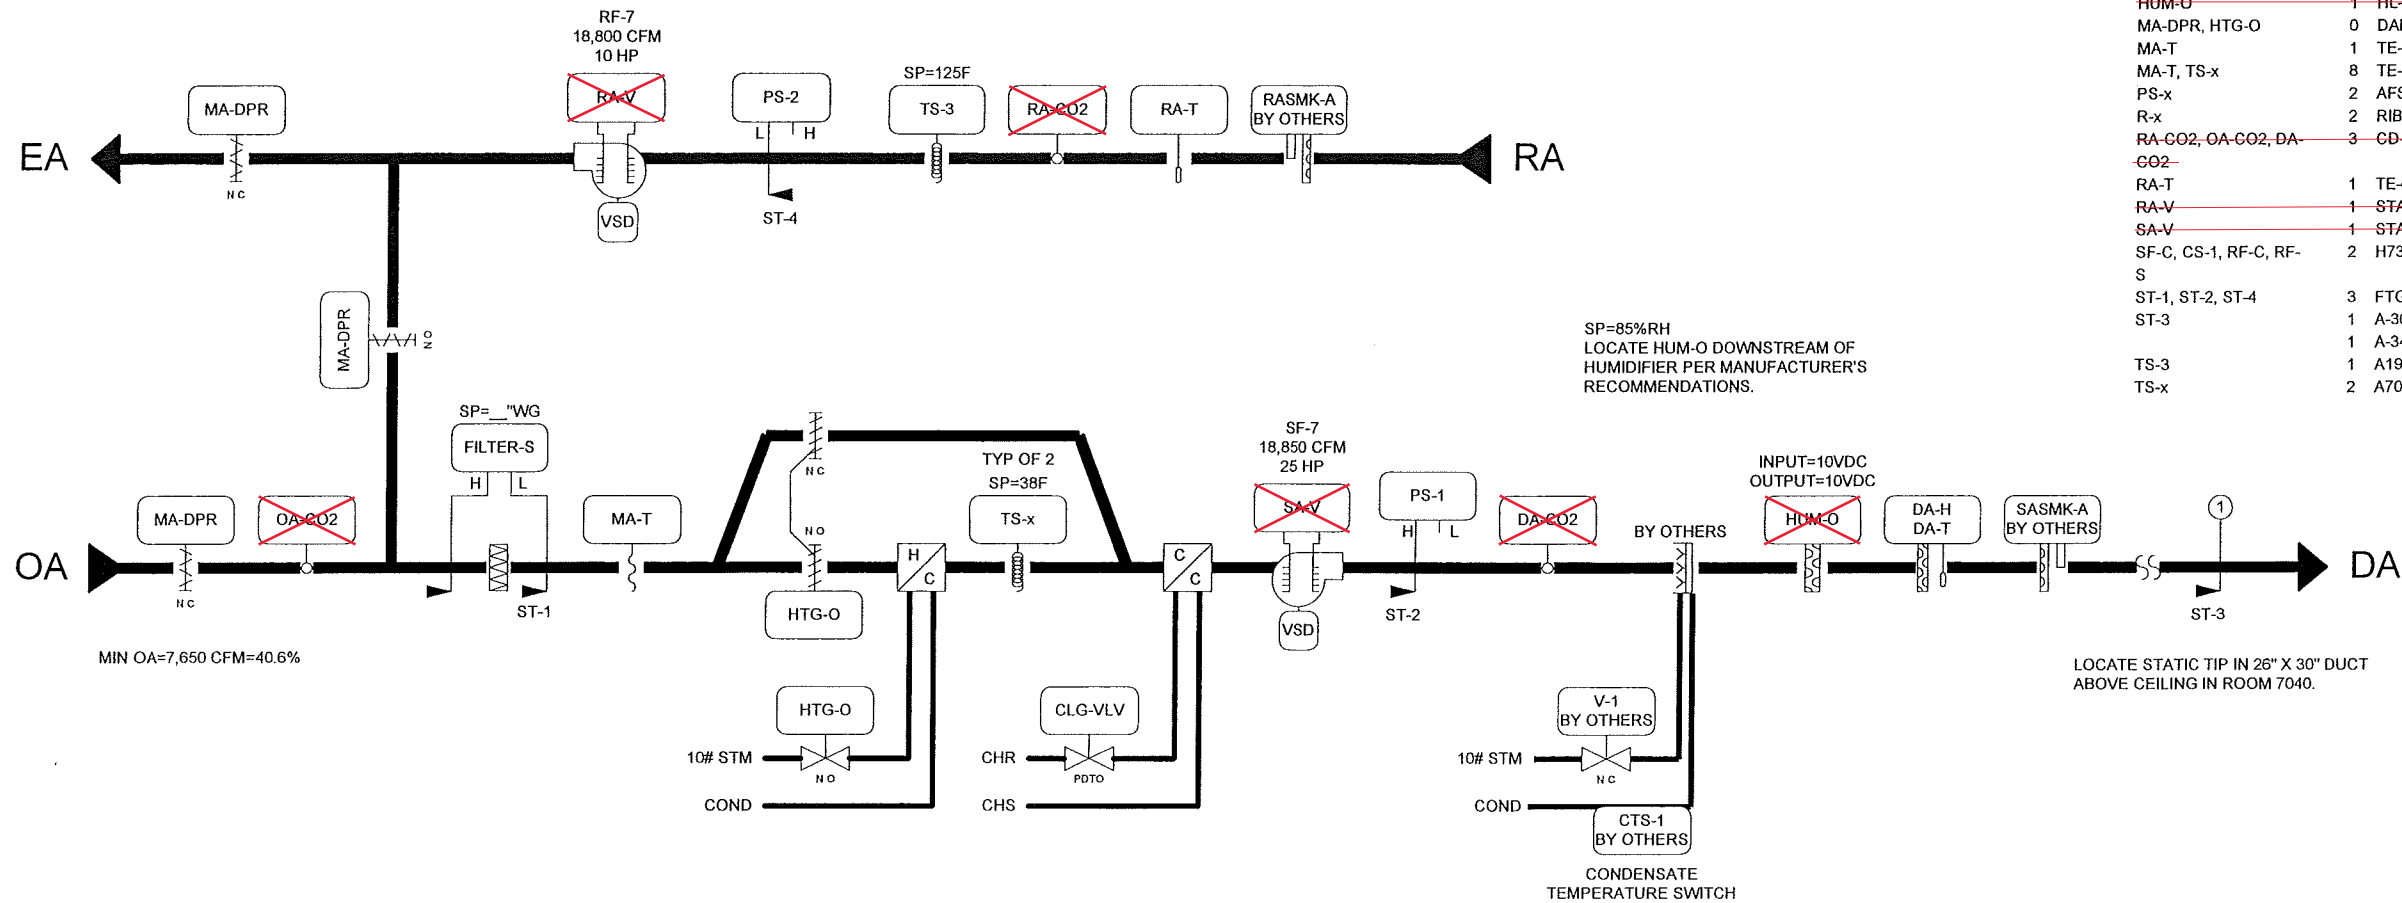



Note: "X" items are no longer in the control sequence.

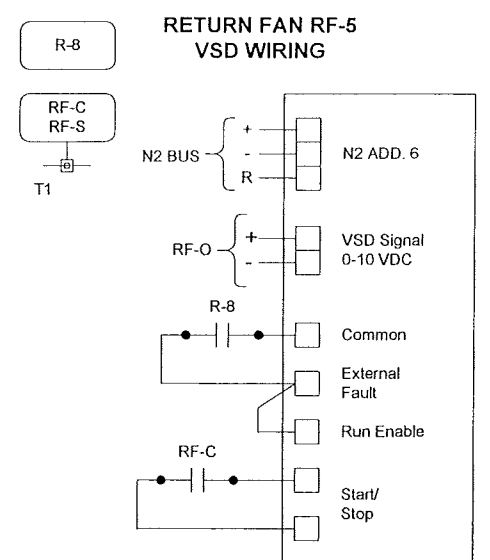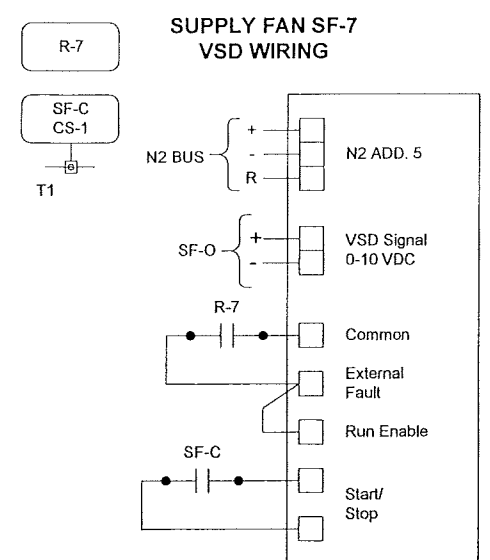

REVISION INFORMATION	Drawing Title				
NUMBER	AHU-7 FLOW				
DATE	04/17/08	1	RECORD DRAWINGS	03/30/08	WCS
TIME	08:12 AM	REFERENCE DRAWING	NO.	REVISION-LOCATION	ECH
FILE NAME	ahu7f.vsd	GLA	SEL	RJM	DATE
Project Title		Application Engineer		APPROVED	
DANE COUNTY COURTHOUSE 215 SOUTH HAMILTON ST. MADISON, WI 53703		Branch Information		CONTRACT NUMBER	
		JOHNSON CONTROLS Systems & Services Division		0 3109-0044	
		Madison Branch 2400 Kilgust Road Madison WI 53713 Phone: 608-222-9100 Fax: 608-222-9490		DRAWING NUMBER 10.1	

BILL OF MATERIALS


Designation	Qty	Part Number	Description
Panel Devices:			
DA-SP	1	DPT2640-2R5B	XMTR,DIFF PR,AIR,-2.5/2.5"WC,0-5VDC,0.5%
DX-7	1	AS-LCPKEY-0	CNTRLR,LCP SERVICE KEY
	1	DX-9100-8454	CNTRLR,DIG,DX,8AI,8AO,6BO,8BI
	1	DX-9100-8990	CNTRLR,DIG,DX,MTG BASE,F/ DX-9170-8454
	1	DX-9100-8991	KIT,CNTRLR,DIG,DX,WIRING PROTECTION
P-7	1	PAN-ENC2436WDP	PANEL, HOFFMAN 24X36X9 PERF-SUB W/ DOOR
R-x, HTG-SO, HUM-E, SF-OFF, RF-OFF	10	PD-101-27	BASE F/109-38,73,74/IDEC #SH3B-05
	10	PD-109-74	RLY,3PDT,10A,24VAC,LED/IDEC RH3B-ULAC24V
RC-1	1	PD-117-02	RECEPTACLE DUPLEX IVORY
	1	PD-121-01	BOX COVER RECPT,EAGLE 2510
	1	PD-121-14	HANDY BOX, 2-1/8IN DEEP
SAFETY-OV	1	RIB2401D	10A PILOT CONTROL RELAY,DPDT,FUNC.DEVICES
TAG-1	1	NAMETAG-CUSTOM	1"X3" TAG, 3-LINES MAX, CUSTOM PNL FACE
TB-1	2	PD-113-44	END CLAMP, WIELAND Z5.522.8553.0
	36	PD-113-52	TERM BLK,6-SQ-MM WIRE SLOT,WIELAND
	1	PD-113-53	END PLATE F/113-52 TERM BLK,WIELAND
TB-PWR	1	PD-112-09	CIRCUIT BREAKER,10A,SQ-D QOU-110
	2	PD-113-44	END CLAMP, WIELAND Z5.522.8553.0
	2	PD-113-52	TERM BLK,6-SQ-MM WIRE SLOT,WIELAND
	1	PD-113-53	END PLATE F/113-52 TERM BLK,WIELAND
	3	PD-114-02	XFMR,120/24VAC,96VA
TX-x	1	XP-9102-8304	CNTRLR,DIG,DX EXPN MOD,6AI,2AO,2/DX,1/XT
XP-1	1	XP-9104-8304	CNTRLR,DIG,DX EXPN MOD,4BI,4BO,2/XT
XP-2	1	XP-9104-8304	CNTRLR,DIG,DX EXPN MOD,4BI,4BO,2/XT
XT-8	1	XT-9100-8304	CNTRLR,DIG,DX EXTENSION MODULE,8/DX

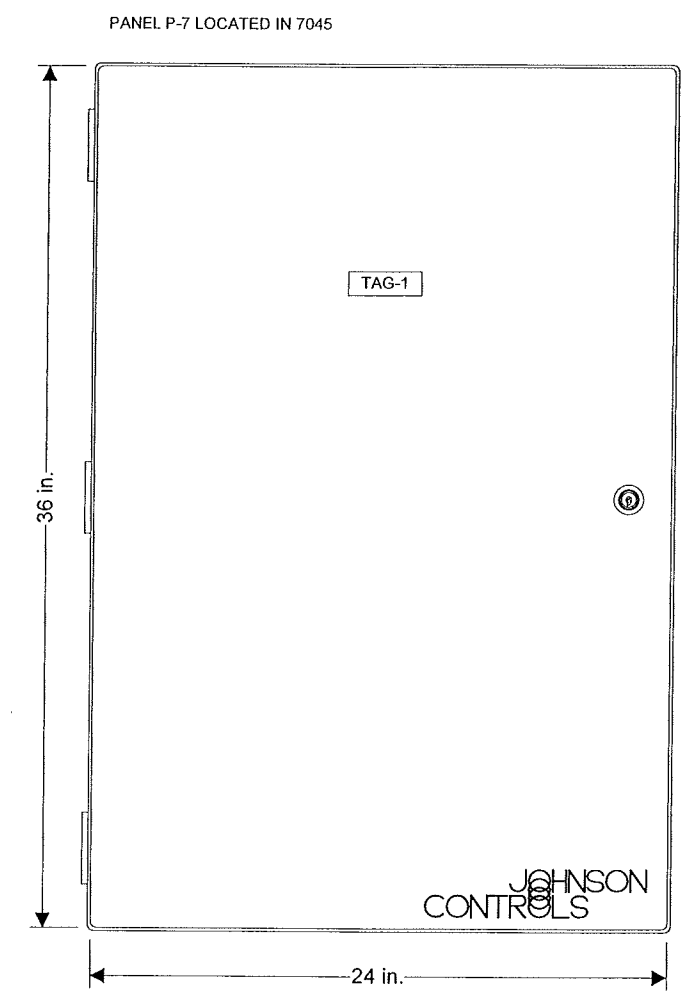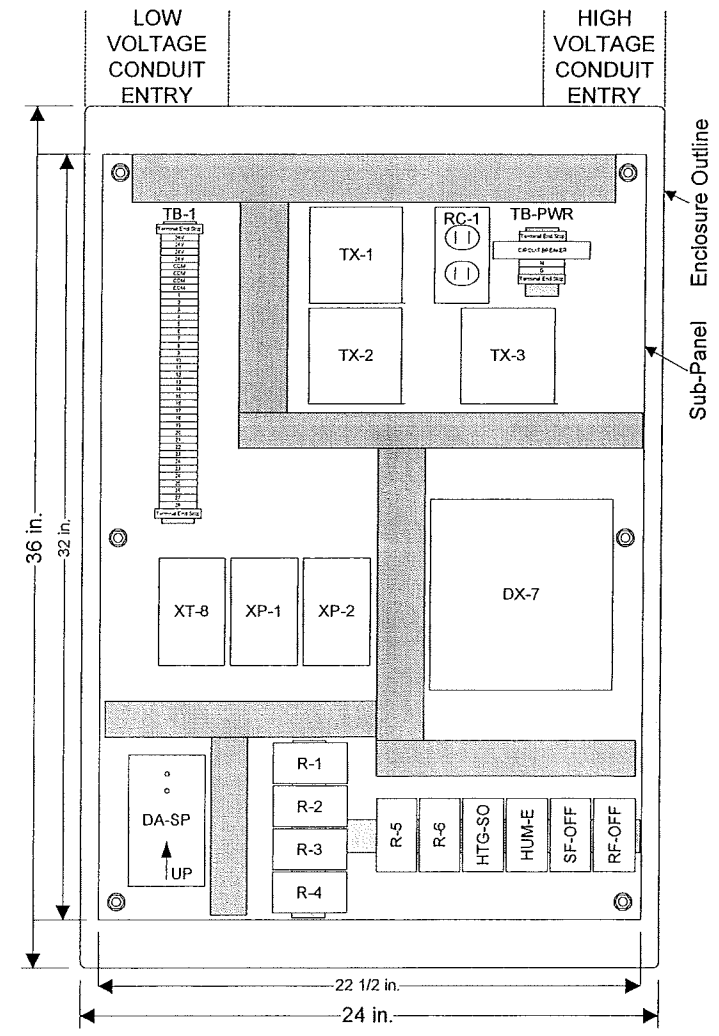



PANEL FACE TAGS:
 TAG-1: PANEL P-7
 AHU-7 SERVING 7TH FLOOR
 JCI 0 3109-0044

REVISION INFORMATION	Drawing Title				
NUMBER	AHU-7 PANEL LOCATED IN 7045				
DATE	04/16/08	1	RECORD DRAWINGS	03/30/08	WCS
TIME	01:07 PM	GLA	SEL	RJM	
FILE NAME	ahu7p.vsd	Project Title		CONTRACT NUMBER	
		DANE COUNTY COURTHOUSE 215 SOUTH HAMILTON ST. MADISON, WI 53703		0 3109-0044	
		JOHNSON CONTROLS Systems & Services Division		DRAWING NUMBER 10.3	
		Branch Information Madison Branch 2400 Kilgust Road Madison WI 53713 Phone: 608-222-9100 Fax: 608-222-9490			



LINE VOLTAGE WIRING DIAGRAM

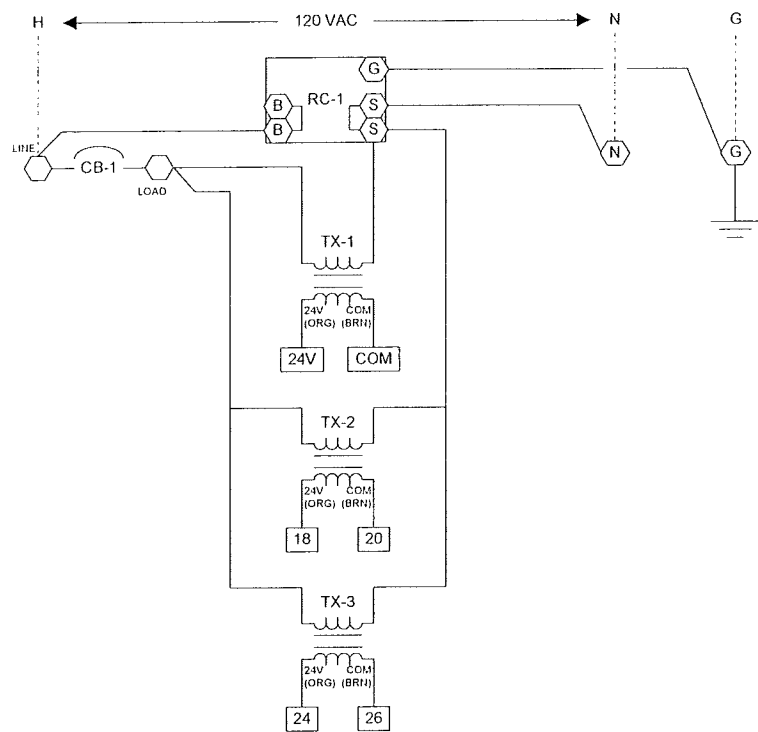

LOW VOLTAGE WIRING DIAGRAM

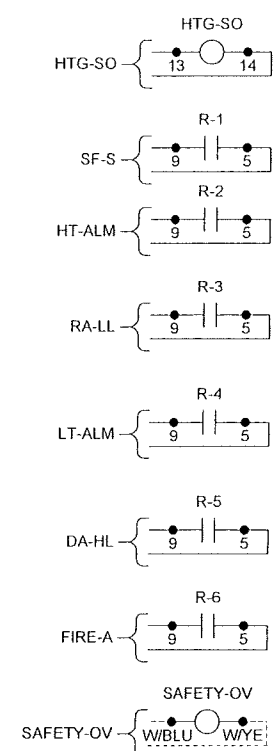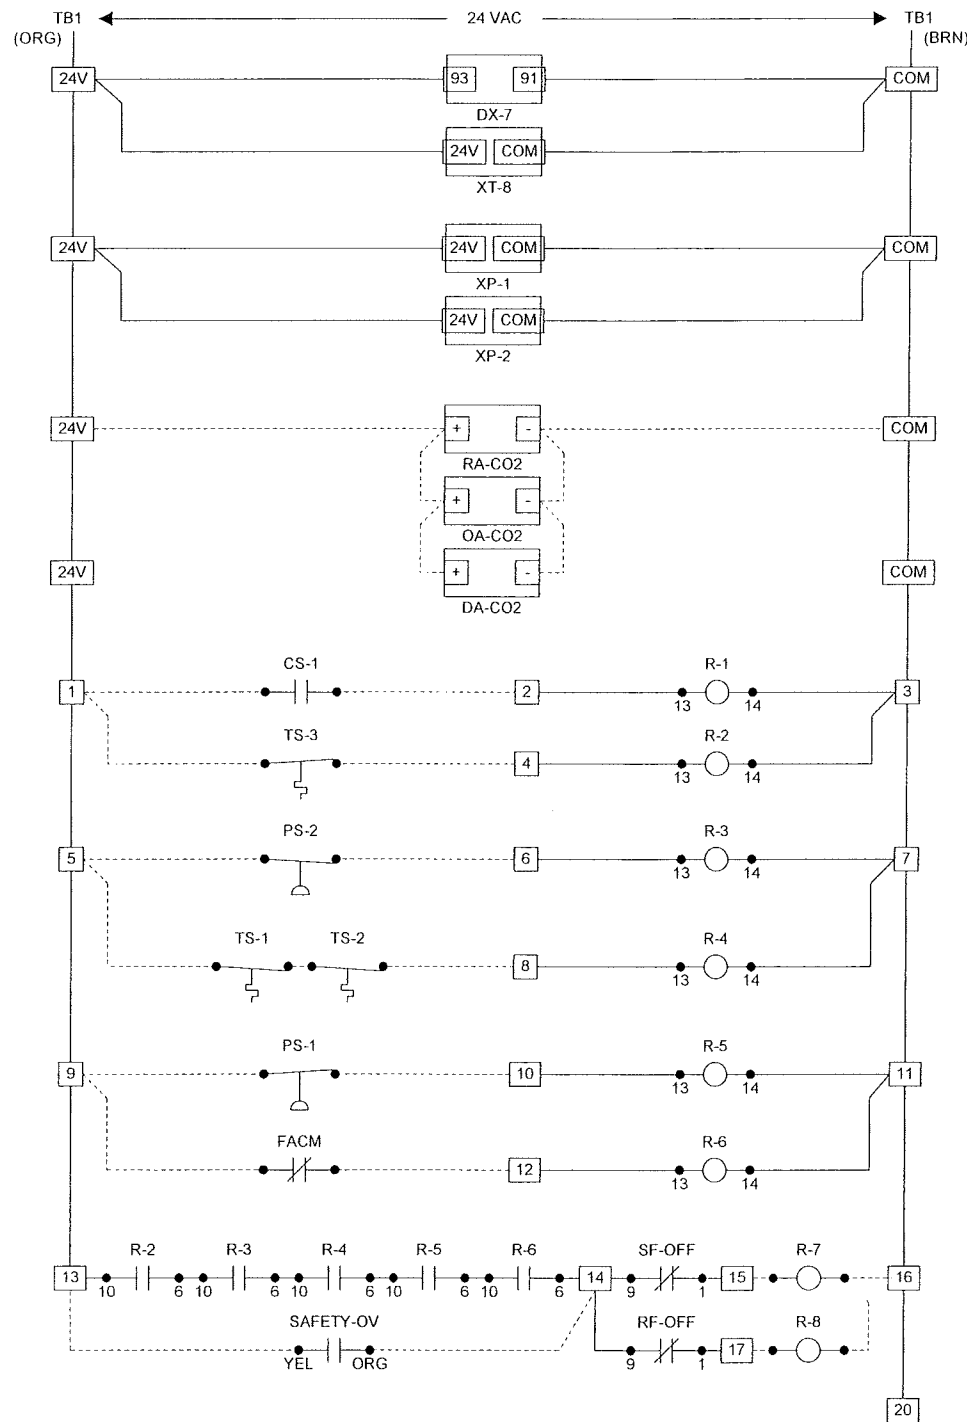

LOW VOLTAGE WIRING DIAGRAM

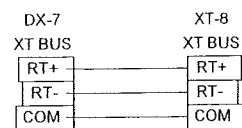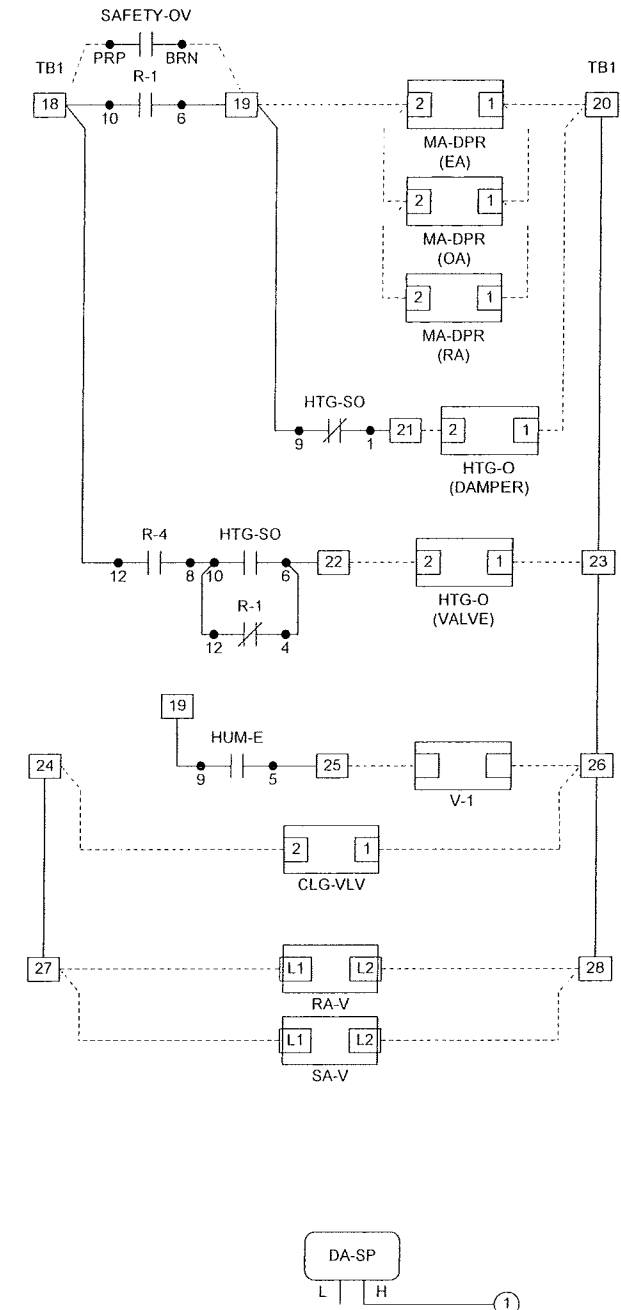

Wiring Legend

- Pneumatic Tubing
- Low Voltage Terminal
- Cable
- Line Voltage Terminal
- Panel Wiring by JCI
- Field Wiring by Others
- VAC Power

REVISION INFORMATION		Drawing Title							
NUMBER		AHU-7 PANEL WIRING							
DATE		04/16/08							
TIME		01:05 PM		Project Title					
FILE NAME		ahu7pw.vsd		DANE COUNTY COURTHOUSE 215 SOUTH HAMILTON ST. MADISON, WI 53703				Madison Branch 2400 Kilgust Road Madison WI 53713 Phone: 608-222-9100 Fax: 608-222-9490	
REFERENCE DRAWING		NO		REVISION LOCATION		ECH		APPROVED	
SALES ENGINEER		PROJECT MANAGER		APPLICATION ENGINEER		DRAWN		DATE	
GLA		SEL		RJM					
CONTRACT NUMBER		0 3109-0044		DRAWING NUMBER		10.4			

Safeties and Alarms:

Filter Condition: Monitor differential pressure across filter and annunciate alarm when differential pressure set point is exceeded.

Low limit: Manual reset low limit thermostat will stop the supply and return fans, close the outdoor air dampers, open steam heating valve on and annunciate alarm should the coil discharge air temperature fall below 38 degrees F.

High Limit: Manual reset high limit thermostat located in the return air will stop the supply and return fans and annunciate alarm should the return air temperature rise above 125 degrees F. Dampers will be indexed to their "System Off" conditions.

Static High Limit: The static high limit sensor located in the discharge of the supply fan will shut down the unit and annunciate alarm if discharge static exceeds 3" w.g. (adj.).

Failure Modes:

Fan Failure: If the supply or return fan fails to operate, both fans will shut down and alarm will be annunciated. Dampers and control valves will be indexed to their "System Off" conditions.

Sensor Failure: Upon the failure of an analog sensor, associated dampers and control valve will remain at their last position and alarm will be annunciated.













Power Failure:

Fans: Upon restoration of power, the supply and return fans will start after an adjustable delay to provide a staggered start of all building loads.

Dampers: Economizer dampers will be provided with spring return actuators to fail to their "System Off" positions.

Valves: Heating valve will be provided with spring return actuator to fail open to the coil.

REVISION INFORMATION	Drawing Title								
NUMBER	SEQUENCE		1	RECORD DRAWINGS		03/30/08	WCS		
DATE	04/17/08	REFERENCE DRAWING	NO.	REVISION-LOCATION	ECN	DATE	BY		
TIME	08:11 AM	GLA	SEL	RJM	BY	DATE	BY	DATE	
FILE NAME	Ahu7s2.vsd	Project Title		DANE COUNTY COURTHOUSE 215 SOUTH HAMILTON ST. MADISON, WI 53703		Branch Information		CONTRACT NUMBER	
		JOHNSON CONTROLS		Systems & Services Division		Madison Branch 2400 Kilgust Road Madison WI 53713 Phone: 608-222-9100 Fax: 608-222-9490		0 3109-0044	
								DRAWING NUMBER	
								10.6	

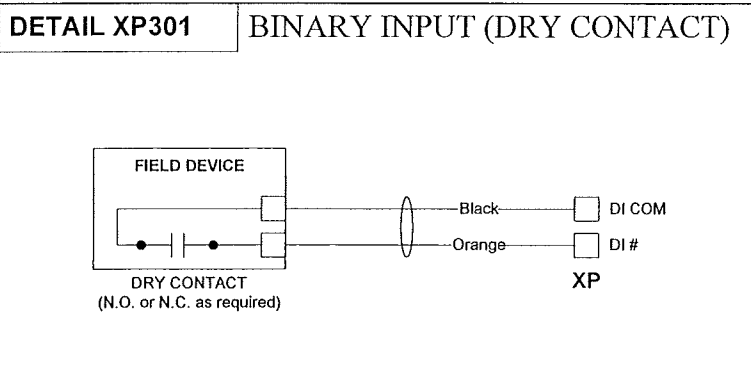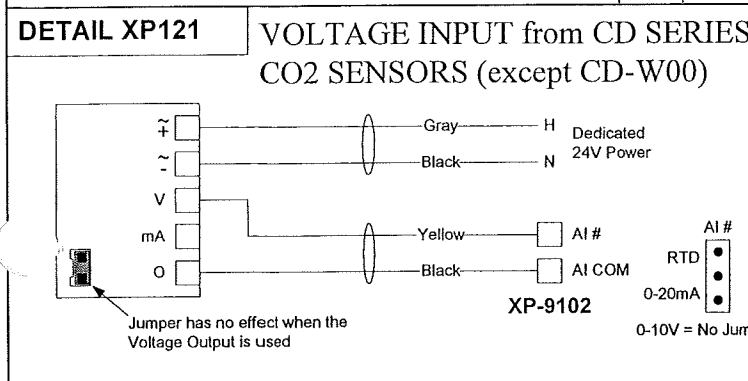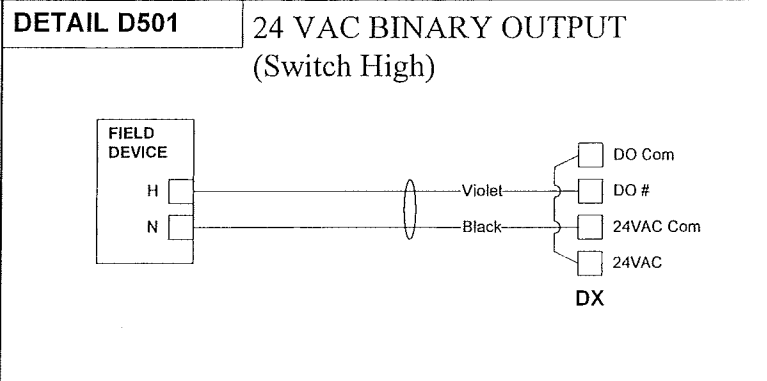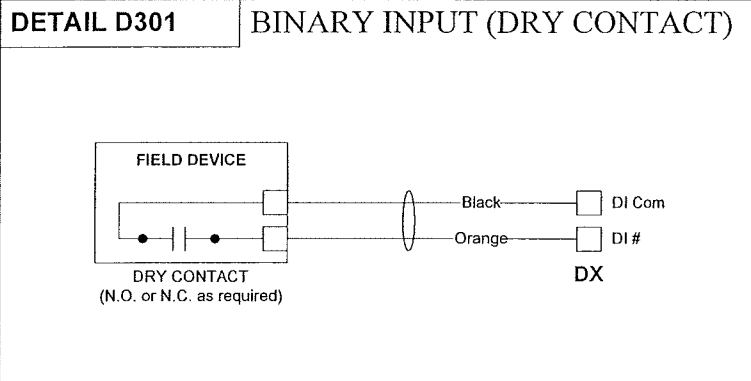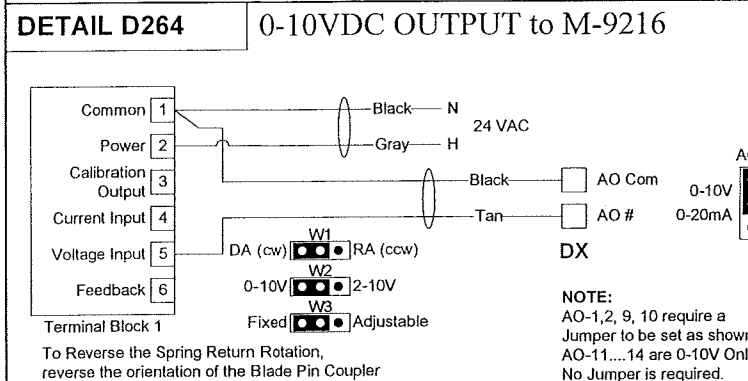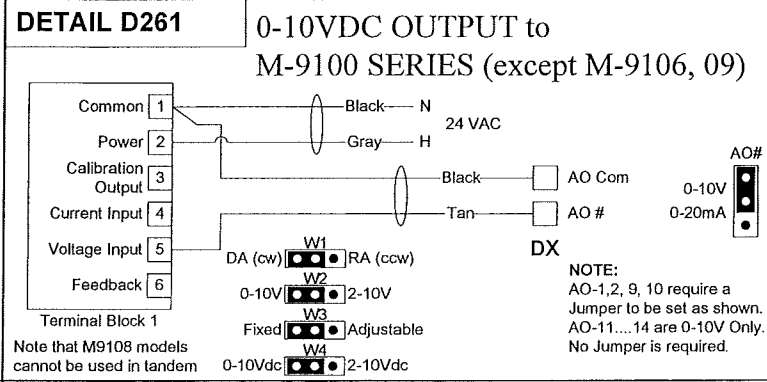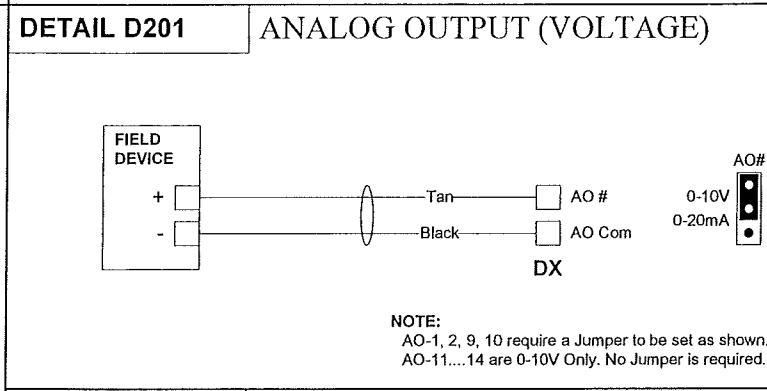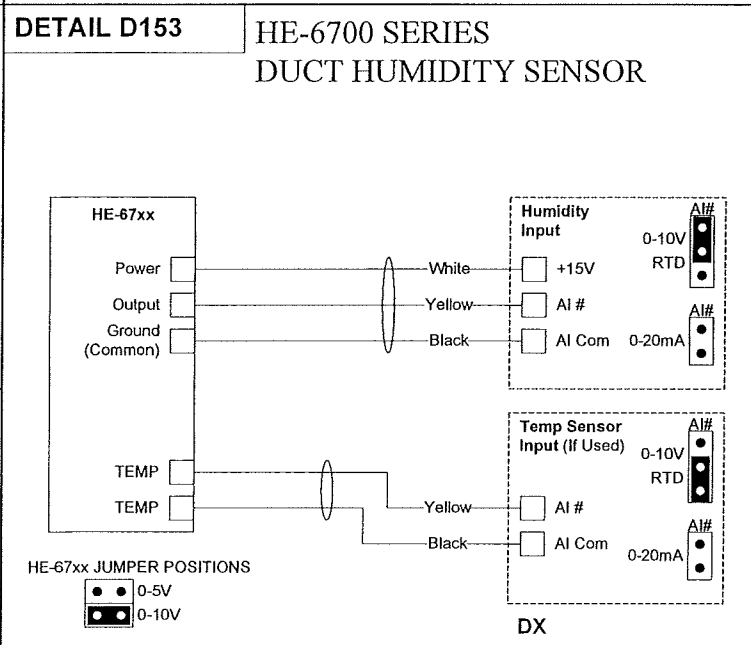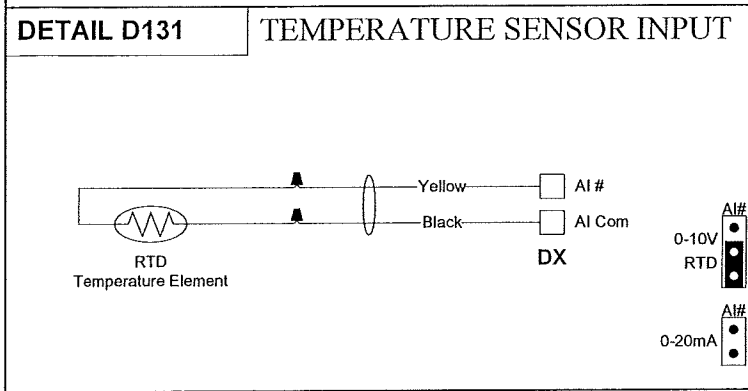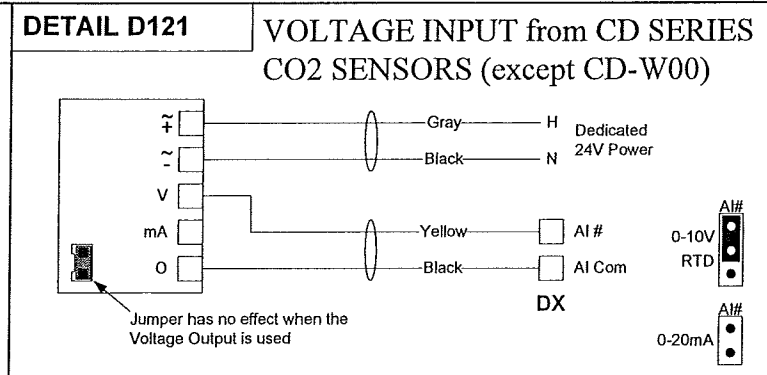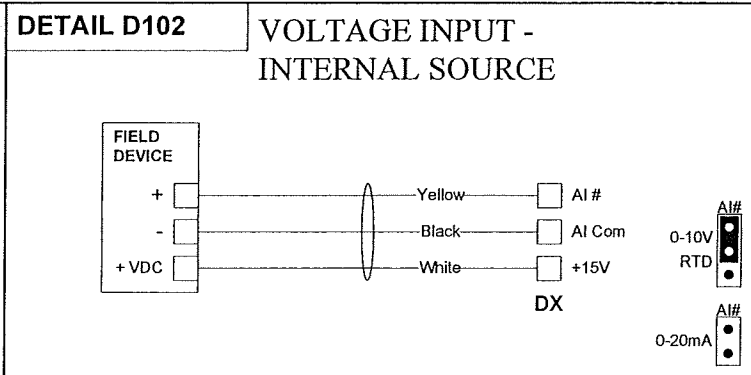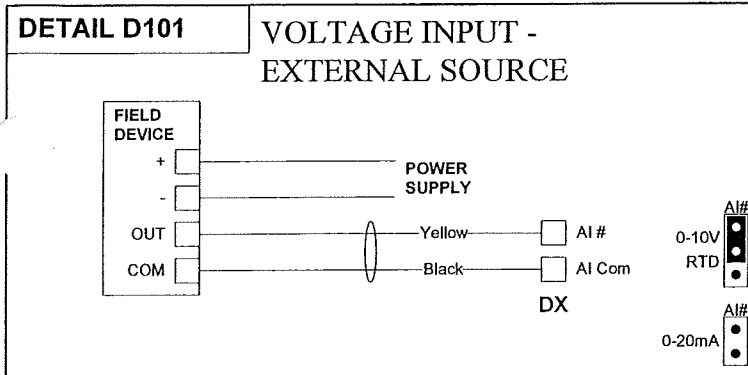


REVISION INFORMATION	Drawing Title				
NUMBER	POINT SCHEDULE				
DATE	04/17/08	1	RECORD DRAWNGS	03/30/08	WCS
TIME	08:11 AM	SALES ENGINEER	PROJECT MANAGER	APPLICATION ENGINEER	APPROVED
FILE NAME	ahu7ps2.vsd	GLA	SEL	RJM	
	Project Title	Branch Information			
	DANE COUNTY COURTHOUSE	Madison Branch			
	215 SOUTH HAMILTON ST.	2400 Kilgust Road			
	MADISON, WI 53703	Madison			
		WI 53713			
		Phone: 608-222-9100			
		Fax: 608-222-9490			
		CONTRACT NUMBER			
		0 3109-0044			
		DRAWING NUMBER			
		10.8			

JOHNSON CONTROLS
Systems & Services Division



BILL OF MATERIALS

Designation	Qty	Part Number	Description
Field Devices:			
CLG-VLV, HTG-O	0	VALVE	SEE VALVE SCHEDULE
DA-H, DA-T	1	HE-67N3-0N00P	SENSOR,3%RH & 1K NI TEMP,DUCT-PROBE
FILTER-S	1	P32AC-2C	PRESS SW,DP,SPDT,5IN WC,U-BRKT
HUM-O	1	HL-67N5-8N00P	HLIMIT,5%RH & 1K NI TMP,WHT,DUCT-PROBE
MA-DPR, HTG-O	0	DAMPER	SEE DAMPER SCHEDULE
MA-T	1	TE-6316P-1	SENSOR,T-NI,0.1%,17FT AVG
MA-T, TS-x	8	TE-6001-8	CLIP F/AVG ELEMENT,10-PACK
PS-x	2	AFS-460	AIR FLOW SW,SPST,NC RESET 0.05-12IN
R-x	2	RIBU1C	10AMP SPDT 10-30VAC/DC/120VAC
RA-CO2, OA-CO2, DA-	3	CD-P00-00-0	SENSOR,CO2, 0-2000PPM,DUCT MOUNT
RA-T	1	TE-6311P-1	SENSOR,T-NI,0.1%,8IN DUCT
RA-V	1	STA104-F	EBTRON-FAN INLET AIR FLOW MEASURING STN-JMB ASSOC.
SA-V	1	STA104-F	EBTRON-FAN INLET AIR FLOW MEASURING STN-JMB ASSOC.
SF-C, CS-1, RF-C, RF-S	2	H738	SENS,CURR,1A @30VAC/DC,1/3HP,CMND RELAY
ST-1, ST-2, ST-4	3	FTG18A-600R	SENSING TUBE KIT, F/P32
ST-3	1	A-302	DWYER-STATIC PRESSURE TIP, 1/4" BARB-KELE
	1	A-345	DWYER-FLANGE MOUNTING KIT FOR A-302-KELE
TS-3	1	A19ABB-2C	STAT,CROP DRY,SPST,-30/50F,BULB,OPEN LO
TS-x	2	A70BA-18C	STAT,LL,20FT ELEMENT,MANUAL,15/55F

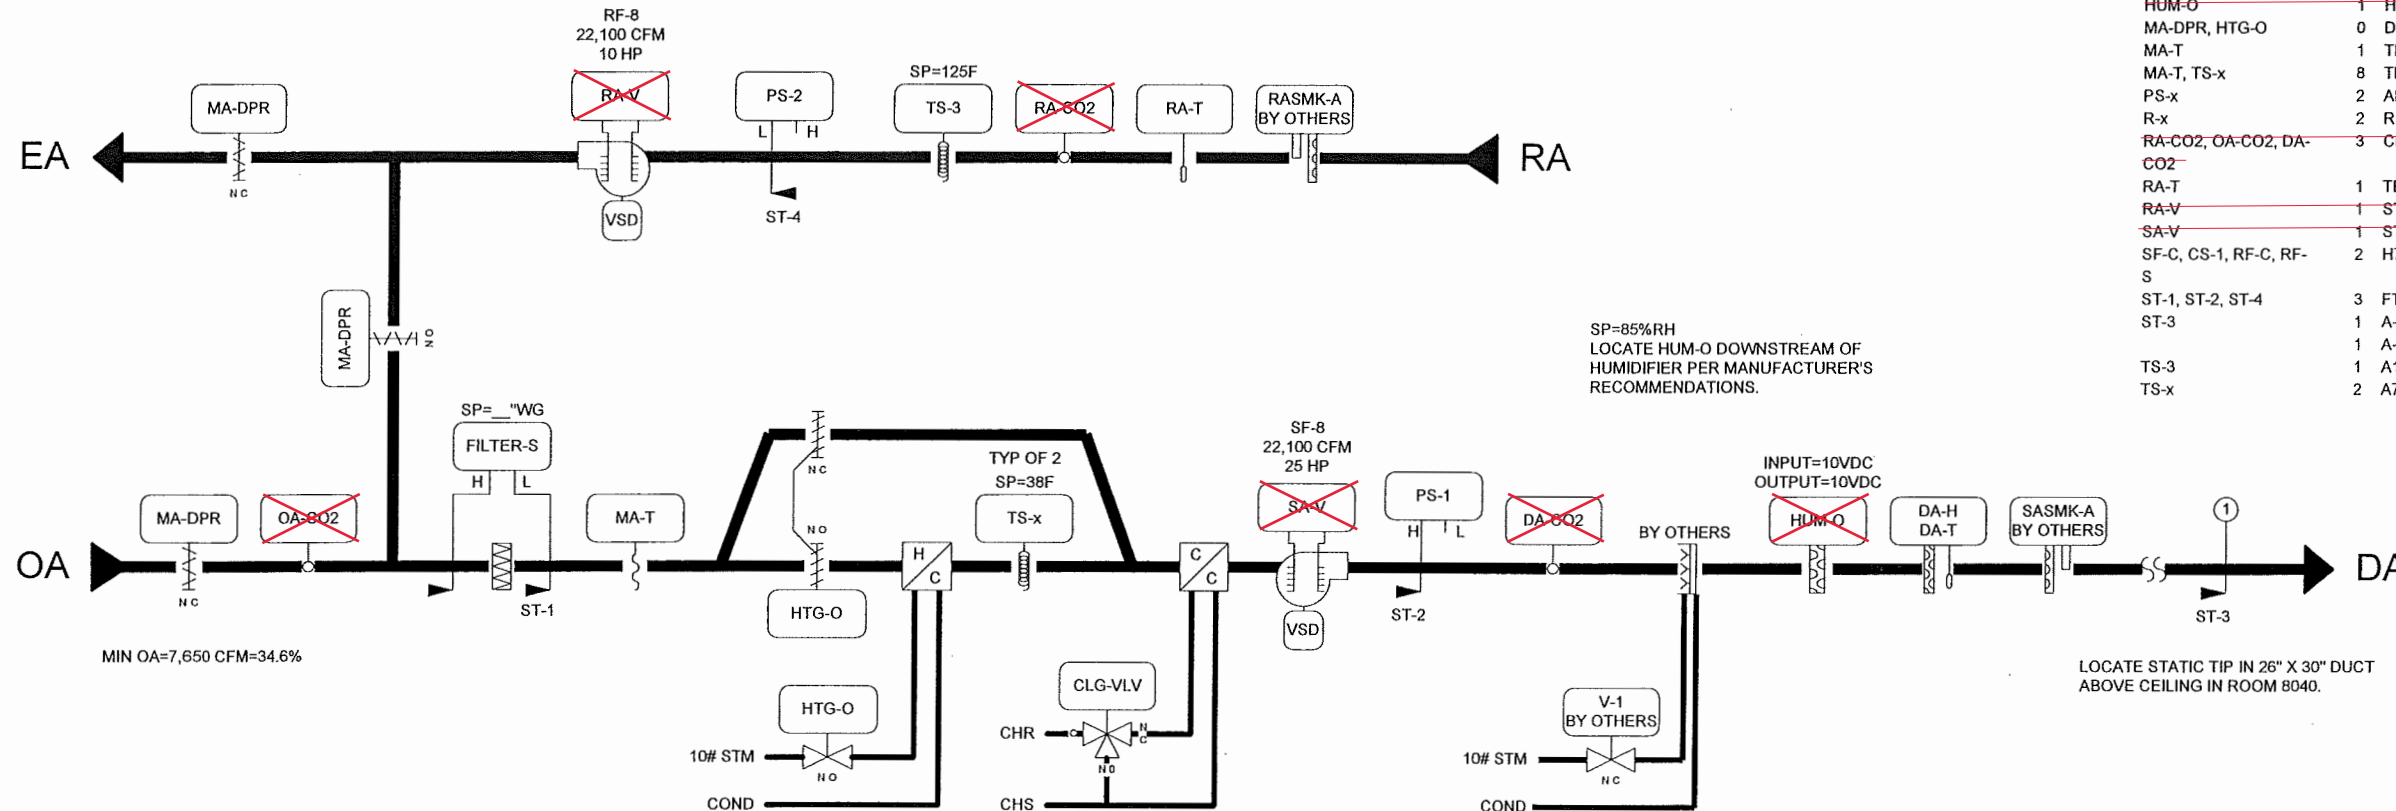

FACM
BY OTHERS
FIRE ALARM
CONTROL MODULE



Note: "X" items are no longer in the control sequence.

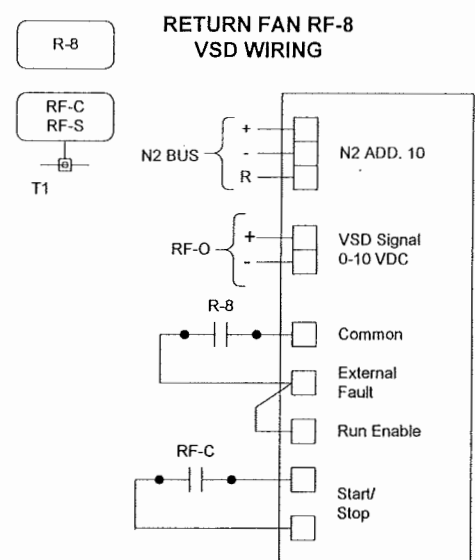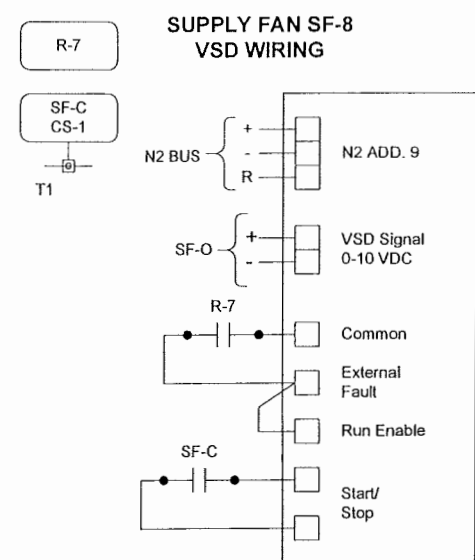

REVISION INFORMATION	Drawing Title				
NUMBER	AHU-8 FLOW	1			
DATE	04/17/08	RECORD DRAWINGS		03/30/08	WCS
TIME	08:11 AM	REVISION-LOCATION			
FILE NAME	ahu8f.vsd	SALES ENGINEER	PROJECT MANAGER	APPLICATION ENGINEER	DATE
		GLA	SEL	RJM	
		BY		DATE	DATE
		BY		DATE	DATE
		Branch Information			CONTRACT NUMBER
		JOHNSON CONTROLS Systems & Services Division			0 3109-0044
		Madison Branch 2400 Kilgust Road Madison WI 53713 Phone: 608-222-9100 Fax: 608-222-9490			DRAWING NUMBER 11.1

BILL OF MATERIALS

Designation	Qty	Part Number	Description
Panel Devices:			
DA-SP	1	DPT2640-2R5B	XMTR,DIFF PR,AIR,-2.5/2.5"WC,0-5VDC,0.5%
DX-11	1	AS-LCPKEY-0	CNTRLR,LCP SERVICE KEY
	1	DX-9100-8454	CNTRLR,DIG,DX,8AI,8AO,6BO,8BI
	1	DX-9100-8990	CNTRLR,DIG,DX,MTG BASE,F/ DX-9170-8454
	1	DX-9100-8991	KIT,CNTRLR,DIG,DX,WIRING PROTECTION
P-8	1	PAN-ENC3042WDP	PANEL, HOFFMAN 30X42X9 PERF-SUB W/ DOOR
R-x, HTG-SO, HUM-E, SF-OFF, RF-OFF	10	PD-101-27	BASE F/109-38,73,74/IDEC #SH3B-05
	10	PD-109-74	RLY,3PDT,10A,24VAC,I/DEC RH3B-ULAC24V
RC-1	1	PD-117-02	RECEPTACLE DUPLEX IVORY
	1	PD-121-01	BOX COVER RECPT,EAGLE 2510
	1	PD-121-14	HANDY BOX, 2-1/8IN DEEP
SAFETY-OV	1	RIB2401D	10A PILOT CONTROL RELAY,DPDT,FUNC.DEVICES
TAG-1	1	NAMETAG-CUSTOM	1"X3" TAG, 3-LINES MAX, CUSTOM PNL FACE
TB-1	2	PD-113-44	END CLAMP, WIELAND Z5.522.8553.0
	38	PD-113-52	TERM BLK,6-SQ-MM WIRE SLOT,WIELAND
	1	PD-113-53	END PLATE F/113-52 TERM BLK,WIELAND
TB-PWR	1	PD-112-09	CIRCUIT BREAKER,10A,SQ-D QOU-110
	2	PD-113-44	END CLAMP, WIELAND Z5.522.8553.0
	2	PD-113-52	TERM BLK,6-SQ-MM WIRE SLOT,WIELAND
	1	PD-113-53	END PLATE F/113-52 TERM BLK,WIELAND
	3	PD-114-02	XFMR,120/24VAC,96VA
TX-x	1	XP-9102-8304	CNTRLR,DIG,DX EXPN MOD,6AI,2AO,2/DX,1/XT
XP-1	2	XP-9104-8304	CNTRLR,DIG,DX EXPN MOD,4BI,4BO,2/XT
XP-2, XP-3	2	XP-9104-8304	CNTRLR,DIG,DX EXPN MOD,4BI,4BO,2/XT
XT-x	2	XT-9100-8304	CNTRLR,DIG,DX EXTENSION MODULE,8/DX

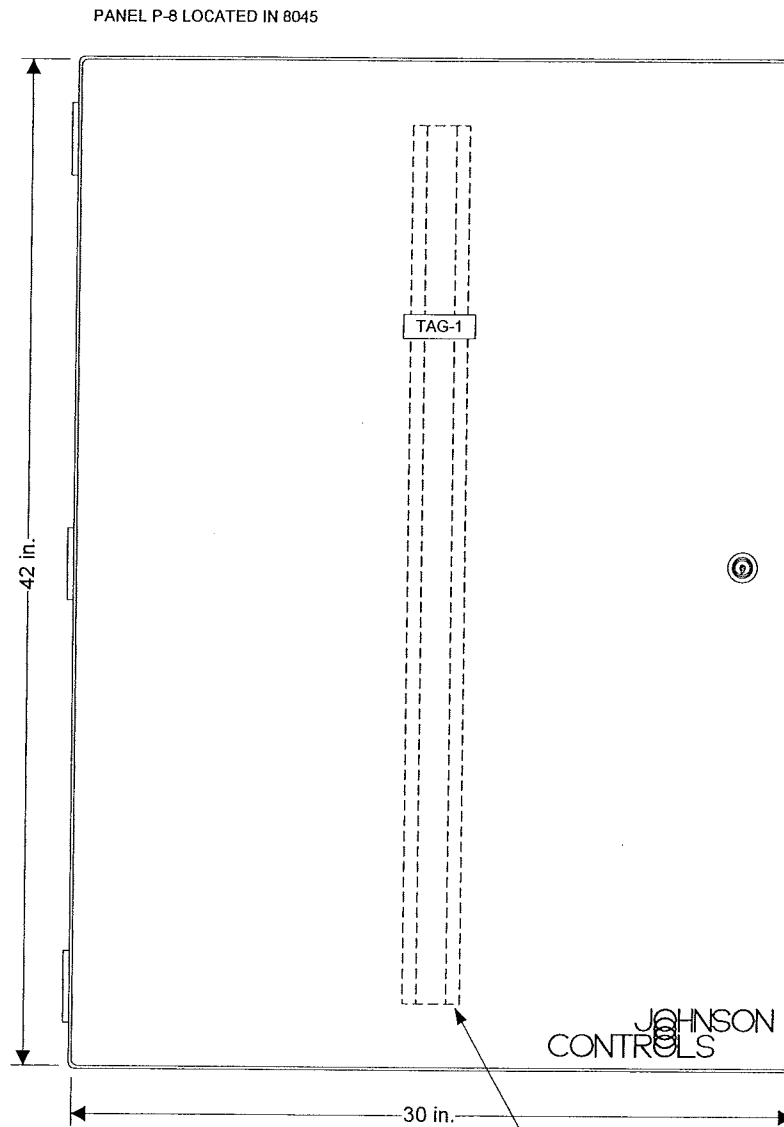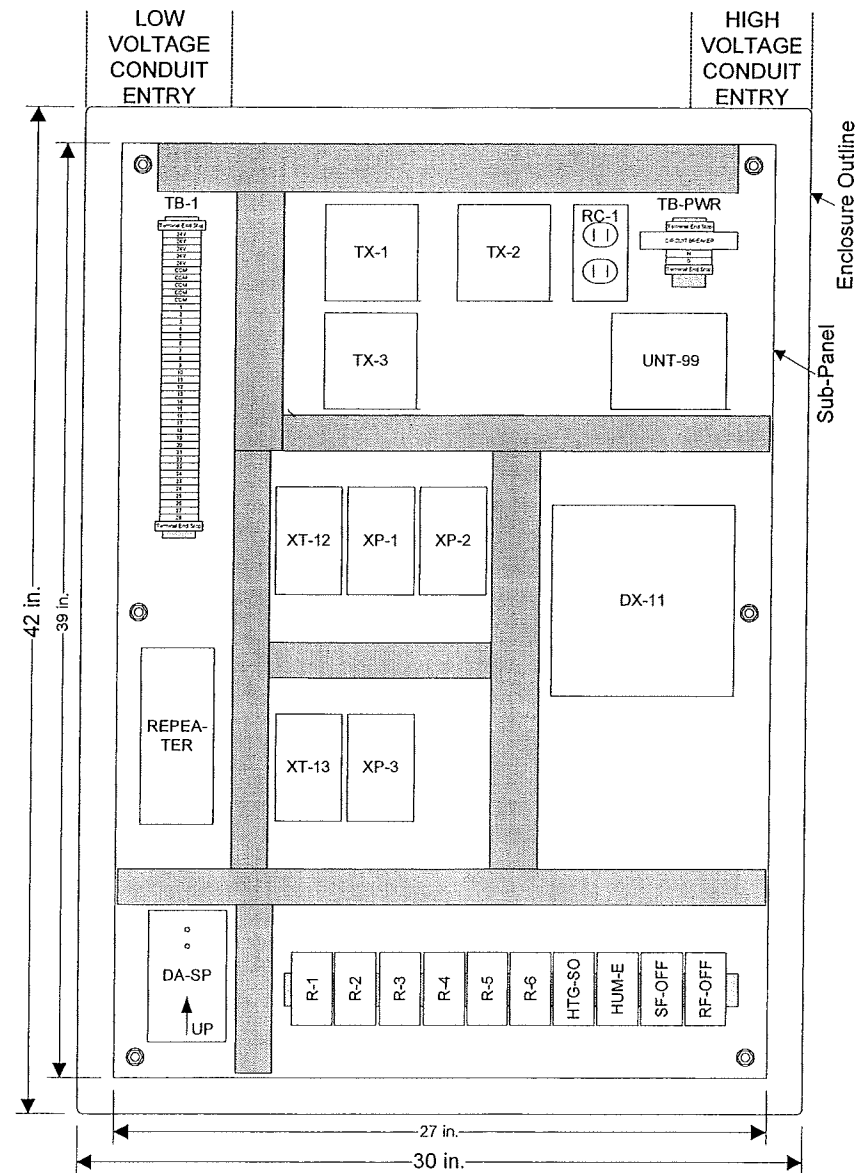


PANEL FACE TAGS:
 TAG-1: PANEL P-8
 AHU-8 SERVING 8TH FLOOR
 JCI 0 3109-0044



Door Stiffener -
 Do not mount devices on
 center 2" of Door.

REVISION INFORMATION	Drawing Title				
NUMBER	AHU-8 PANEL LOCATED IN 8045				
DATE	04/17/08	1	RECORD DRAWINGS	03/30/08	WCS
TIME	08:10 AM				
FILE NAME	ahu8p.vsd				
Project Title		Branch Information		CONTRACT NUMBER	
DANE COUNTY COURTHOUSE 215 SOUTH HAMILTON ST. MADISON, WI 53703		 Madison Branch 2400 Kilgust Road Madison WI 53713 Phone: 608-222-9100 Fax: 608-222-9490		0 3109-0044 DRAWING NUMBER 11.3	




LINE VOLTAGE WIRING DIAGRAM

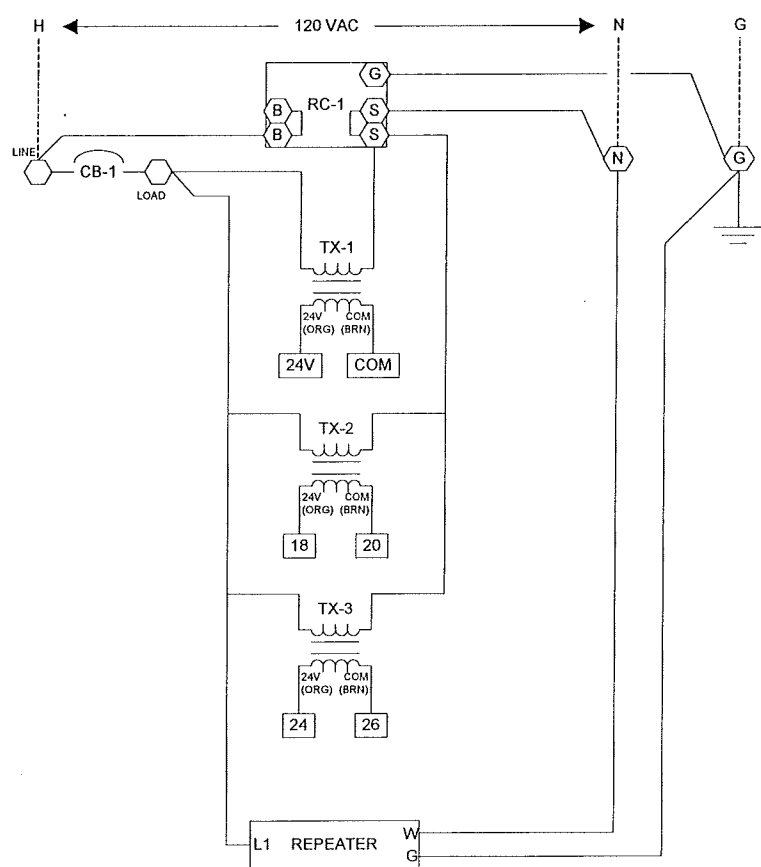





LOW VOLTAGE WIRING DIAGRAM

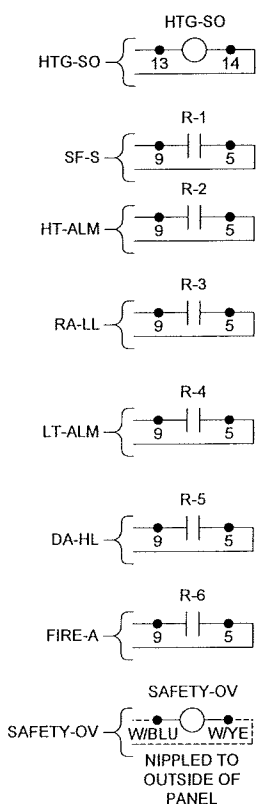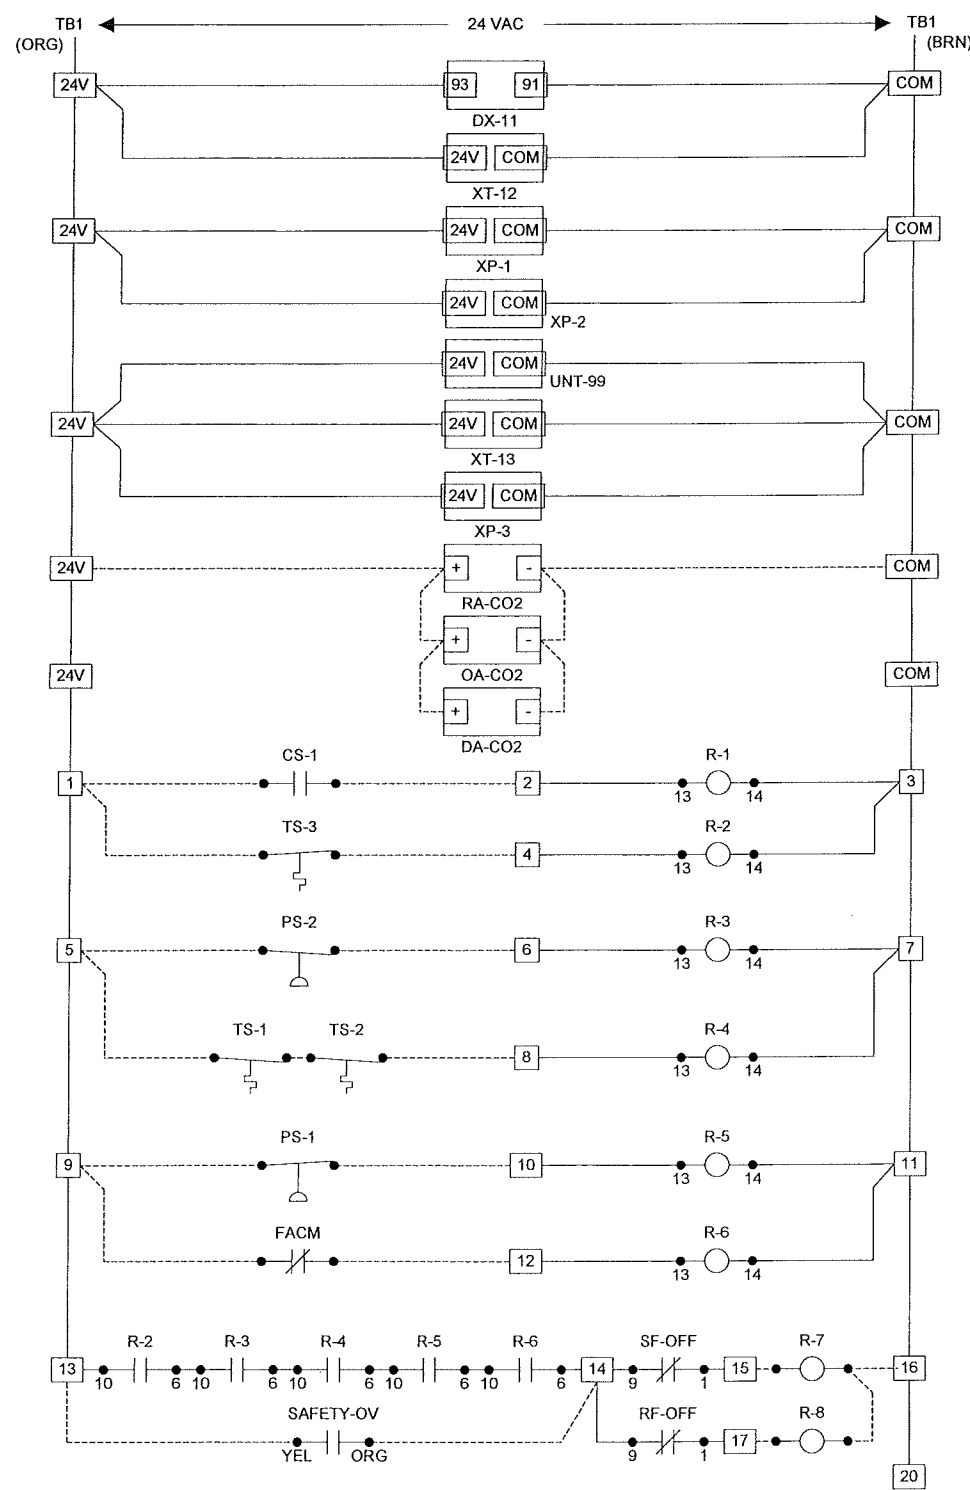

LOW VOLTAGE WIRING DIAGRAM

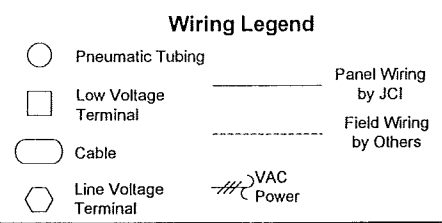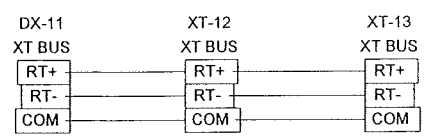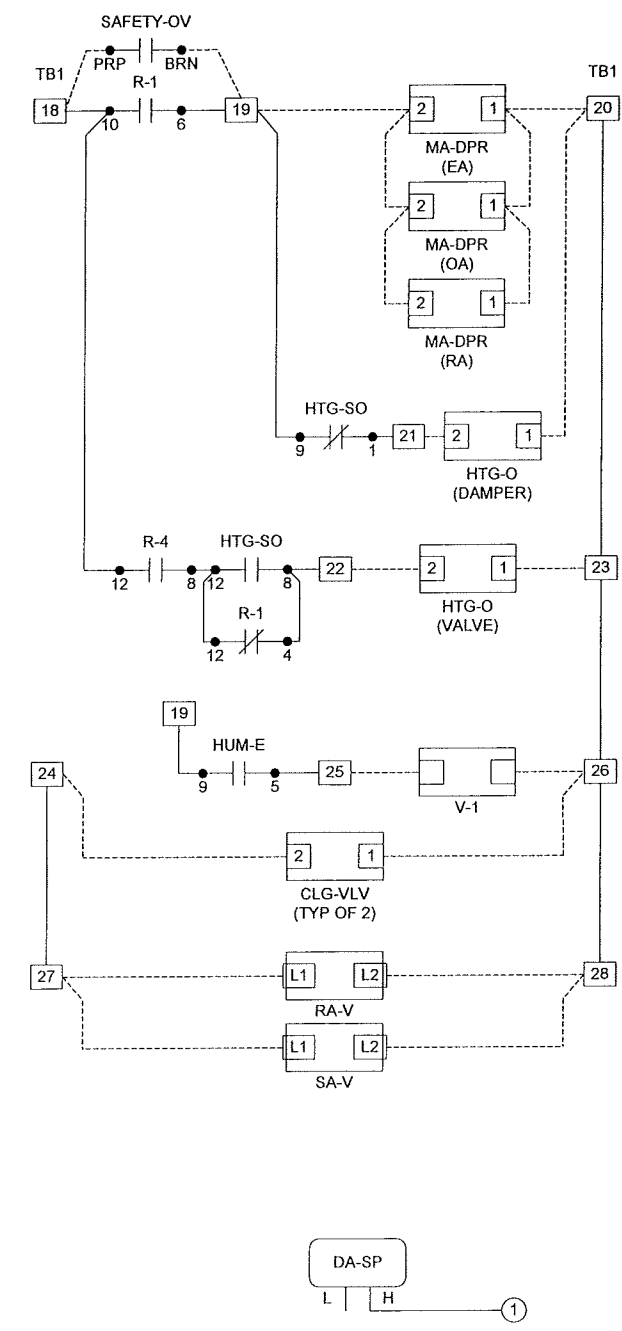

REVISION INFORMATION		Drawing Title									
NUMBER		AHU-8 PANEL WIRING		1		RECORD DRAWINGS		03/30/08		WCS	
DATE		04/16/08		TIME		01:06 PM		FILE NAME		ahu8pw.vsd	
DATE		04/16/08		TIME		01:06 PM		FILE NAME		ahu8pw.vsd	
SALES ENGINEER		PROJECT MANAGER		APPLICATION ENGINEER		DRAWN		APPROVED		CONTRACT NUMBER	
GLA		SEL		RJM		BY		DATE		0 3109-0044	
DRAWING NUMBER		11.4		BRANCH INFORMATION		MADISON BRANCH		2400 KILGUST ROAD		MADISON WI 53713	
SYSTEMS & SERVICES DIVISION		PHONE: 608-222-9100		FAX: 608-222-9490							

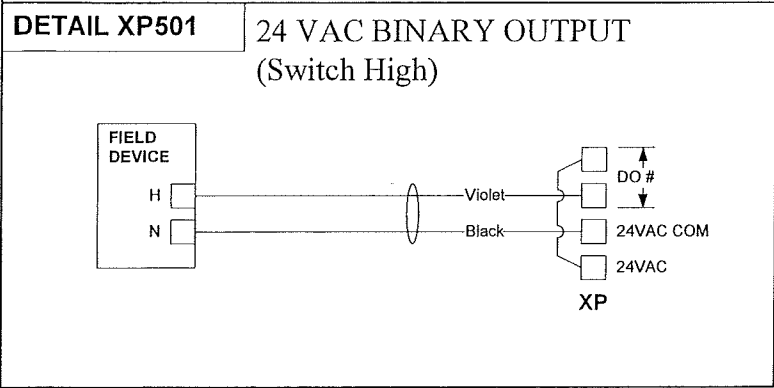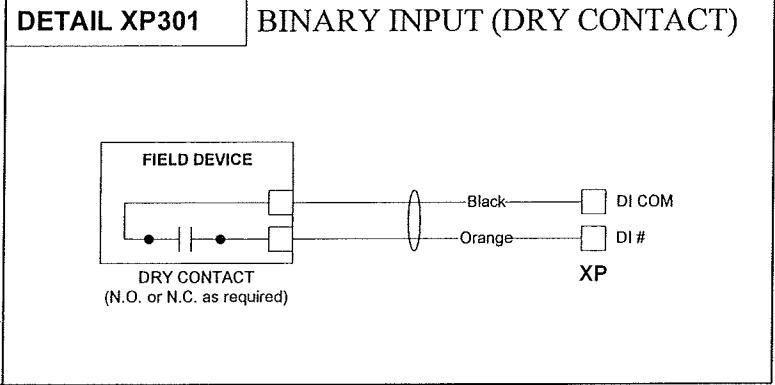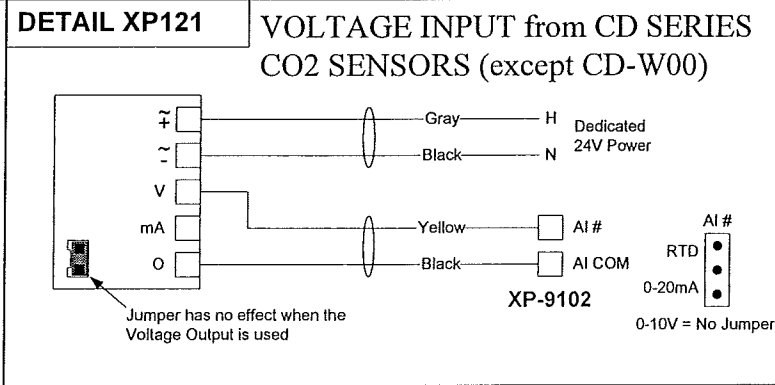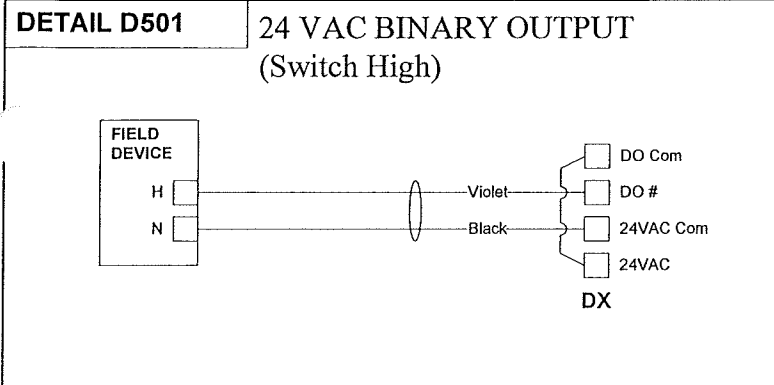


REVISION INFORMATION	Drawing Title					
NUMBER	POINT SCHEDULE					
DATE	04/17/08					
TIME	08:09 AM					
FILE NAME	ahu8ps3.vsc					
Project Title		1		RECORD DRAWINGS		03/30/08 WCS
DANE COUNTY COURTHOUSE 215 SOUTH HAMILTON ST. MADISON, WI 53703		NO.		REVISION-LOCATION		ECN DATE BY
JOHNSON CONTROLS Systems & Services Division		Sales Engineer		Project Manager		Application Engineer
Madison Branch 2400 Kilgust Road Madison WI 53713 Phone: 608-222-9100 Fax: 608-222-9490		GLA		SEL		RJM
CONTRACT NUMBER		BY		DATE		DATE
0 3109-0044		BY		DATE		DATE
DRAWING NUMBER		BY		DATE		DATE
11.9		BY		DATE		DATE


BILL OF MATERIALS

Designation	Qty	Part Number	Description
Field Devices: EFx-C, EFx-S	1	H738	SENS,CURR,1A @30VAC/DC,1/3HP,CMND RELAY

DETAIL A
TYPICAL OF 5

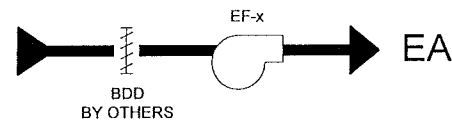

EXHAUST FAN STARTER WIRING

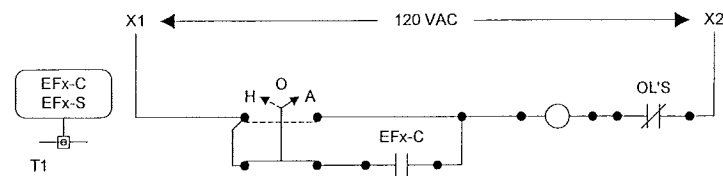


General Exhaust Fan

The exhaust fan will operate anytime the AHU's are operating.


BILL OF MATERIALS

Designation	Qty	Part Number	Description
Field Devices: EF7-C, EF7-S	1	H548	SW,CURR,0.5-20A,MINI,CMND RLY,HOA,ADJUST

DETAIL B
TYPICAL OF 1

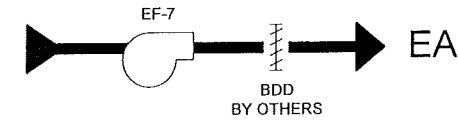

EXHAUST FAN EF-7 WIRING

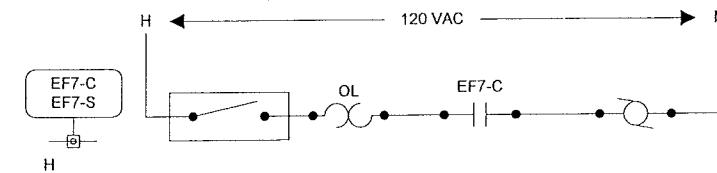

Parking Garage Exhaust Fan


The exhaust fan will operate on an owner determined time schedule.

REVISION INFORMATION	Drawing Title								
NUMBER	FAN DETAILS			1		RECORD DRAWINGS		03/30/08 WCS	
DATE	04/17/08	REFERENCE DRAWING	NO.	REVISION-LOCATION		ECH	DATE	BY	
TIME	08:07 AM	GLA	SEL	RJM	BY	DATE	BY	DATE	
FILE NAME	fandetab.vsd	Project Title		Branch Information		CONTRACT NUMBER			
		DANE COUNTY COURTHOUSE 215 SOUTH HAMILTON ST. MADISON, WI 53703		 Systems & Services Division		Madison Branch 2400 Kilgust Road Madison WI 53713 Phone: 608-222-9100 Fax: 608-222-9490		0 3109-0044	
								DRAWING NUMBER 12.2	


BILL OF MATERIALS

Designation	Qty	Part Number	Description
Field Devices: SPFx-C, SPFx-S	1	H748	SENS,CURR,1A @30VAC/DC,1/4HP,CMND RELAY

DETAIL C
TYPICAL OF 3

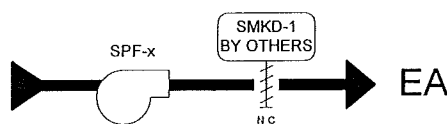

STAIRWELL PRESSURIZATION FAN STARTER WIRING

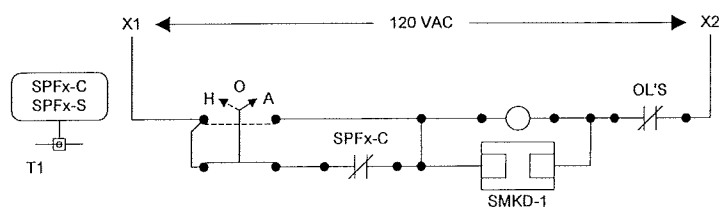

STAIRWELL PRESSURIZATION FANS:

General:
Supply fan to control an individual stair by maintaining a specific pressure in the zone.

System Off:
The damper will close.

The fan will move to the off position.

System Start:
Upon fire detection anywhere in the building, a signal from the FMS system the fan will be turned on and the damper will open.

System On:
Supply fan will operate continuously.

Barometer relief damper will modulate open when the supply fan is activated to maintain stair pressure at 0.15" w.c. positive.

System Stop:
The fan will move to the off position.

Safeties:
The fan will be controllable (on/off).


Failure Modes:
The fan will fail to the on position.

The damper will fail to the closed position.


BILL OF MATERIALS

Designation	Qty	Part Number	Description
Field Devices: SCF1-C, SCF1-S	1	H738	SENS,CURR,1A @30VAC/DC,1/3HP,CMND RELAY

DETAIL D
TYPICAL OF 1

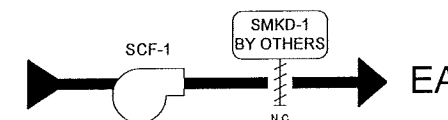

SMOKE CONTROL FAN SCF-1 STARTER WIRING

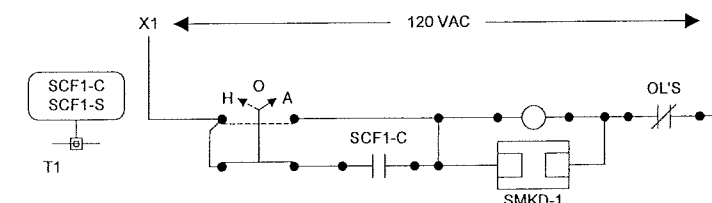

Smoke Control, Fire in Holding:
Supply Fan AHU-1 will stop.

SCF-1 will start and the associated smoke damper will open.

Failure Modes:
The fan will fail to the off position.


The damper will fail to the closed position.

REVISION INFORMATION	Drawing Title				
NUMBER	FAN DETAILS	1	RECORD DRAWINGS	03/30/08	WCS
DATE	04/17/08	SALES ENGINEER	PROJECT MANAGER	APPLICATION ENGINEER	DATE
TIME	08:06 AM	GLA	SEL	RJM	
FILE NAME	Fandctcd.vsd	Project Title		Branch Information	
	DANE COUNTY COURTHOUSE 215 SOUTH HAMILTON ST. MADISON, WI 53703	JOHNSON CONTROLS Systems & Services Division		Madison Branch 2400 Kilgust Road Madison WI 53713 Phone: 608-222-9100 Fax: 608-222-9490	
		CONTRACT NUMBER		0 3109-0044	
		DRAWING NUMBER		12.3	

DETAIL A
TYPICAL OF 179

BILL OF MATERIALS

Designation	Qty	Part Number	Description
Field Devices:			
BXHTG-OP, BXHTG-CL	0	VALVE	SEE ROOM SCHEDULE
DA-T	1	TJBCR01	VERIS-4", 2K PT TEMP SENSOR-VERIS
VMA-x	1	AP-VMA1420-0	VAV MODULAR ASSY - CLG W/ REHEAT
ZN-T, ZNT-SET	1	TE-67NP-2N00	SENSOR, RM, 1K NI, PHONE JACK, SET-PT

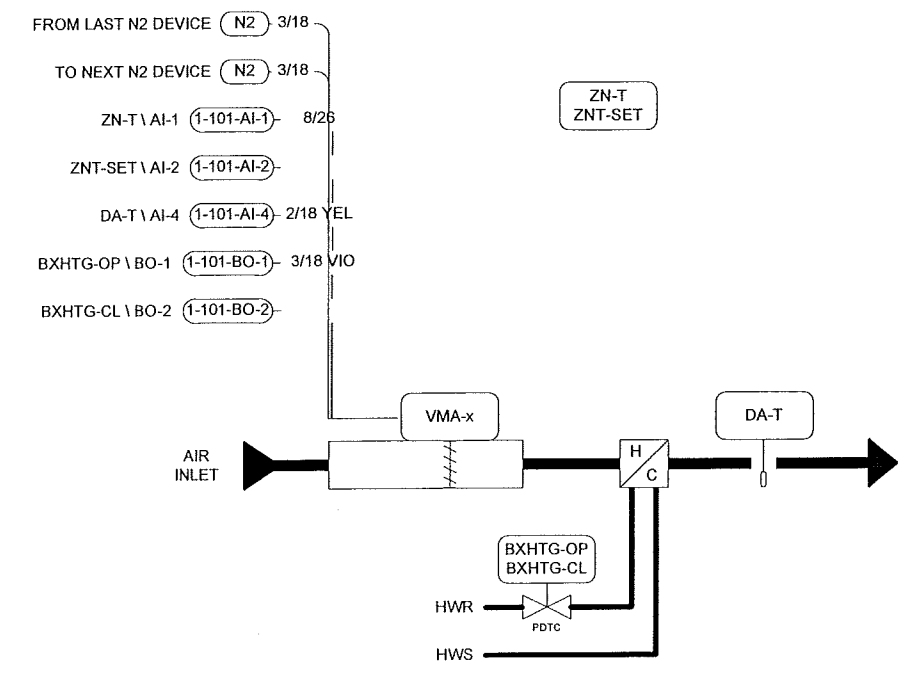

VMA INSTALLATION NOTE: FIELD VERIFY TYPE OF VAV BOXES. 90 DEG BOXES: VMA INSTALLED WITH DAMPER CLOSED; 45 DEG AND 60 DEG BOXES: INSTALL WITH DAMPER OPEN. SEE VMA1400 SERIES CONTROLLERS TECHNICAL BULLETIN.

POWER OBTAINED FROM CENTRAL TRANSFORMER PANEL. MAXIMUM (4) VMA CONTROLLERS PER 100 VA TRANSFORMER.

VAV TERMINAL WITH HOT WATER REHEAT:

General:
Terminal unit control dedicated to individual zones using hot water reheat to condition the zone.

System Off:
The hot water valve will modulate closed.
The damper will move to the closed position.

System Start:
Upon a signal from the FMS for the associated air handling unit serving the terminal box to start, the terminal unit controller will also be activated.

System On:
Upon a rise in room temperature above set point the terminal unit's damper will modulate open, increasing CFM, to maintain room set point.

Upon a decrease in room temperature below set point the terminal unit's damper will modulate closed to maintain room set point.

If the temperature continues to fall and the damper has reached it's minimum position, and the hot water re-heat valve will modulate open to maintain room set point.

Upon a rise in room temperature the reverse will occur.

There will be separate heating and cooling set points.

System Stop:
The hot water valve will close.

The damper will move to the closed position.




Safeties and Alarms:
An alarm will be noted in the event of a low and/or high temperature limit in the zone sensor.

Failure Mode
The terminal unit valve will fail to the closed position.

The terminal unit damper will fail to the open position.

REVISION INFORMATION	Drawing Title								
NUMBER	ROOM SCHEDULE DETAILS		1	RECORD DRAWINGS		03/30/08	WCS		
DATE	04/17/08	SALES ENGINEER	PROJECT MANAGER	APPLICATION ENGINEER	REVISION-LOCATION	ECN	DATE	BY	
TIME	08:06 AM	GLA	SEL	RJM	DRAWN				
FILE NAME	rsdeta.vsd	Project Title		Branch Information		CONTRACT NUMBER			
		DANE COUNTY COURTHOUSE 215 SOUTH HAMILTON ST. MADISON, WI 53703		 Madison Branch 2400 Kilgust Road Madison WI 53713 Phone: 608-222-9100 Fax: 608-222-9490		0 3109-0044		DRAWING NUMBER	
								13.1	


Electrician/Fitter	Point Information				Controller Information					Panel Information				Intermedi		Field Device						
	Tag	Point Type	System Name	Object Name	Expanded ID	Controller Type	Trunk Nbr	Trunk Addr.	Cable Destination Bay/Terminal	Module Type	Termination Out	Panel	Panel Location	Slot Number	Reference Drawing	Cable Number	Wiring /Tubing	Termination In	Device	Location	Ref Detail Shape	Comment
						VMA					VAV-1	@VAV BOX										Power to Controller
						VMA	1	101			VAV-1	@VAV BOX										N2 Trunk
AI-1	VAV	ZNT	Zone Temperature			VMA	1	101 AI-1		Phone Jack	VAV-1	@VAV BOX	0		1-101-AI-1	8/26	Phone Jack	TE-6700 (Jack, No PB)		VMA134		
AI-2	VAV	ZNT-SET	Remote Setpoint			VMA	1	101 AI-2			VAV-1	@VAV BOX	0		1-101-AI-2							
AI-3						VMA	1	101 AI-3			VAV-1	@VAV BOX	0		1-101-AI-3							
AI-4	VAV	DA-T	Discharge Air Temp			VMA	1	101 AI-4		AI4,COM	VAV-1	@VAV BOX	0		1-101-AI-4	2/18 YEL	2-Wire	TE		VMA131		
AI-5	VAV	SA-VP	Supply Delta P			VMA	1	101 AI-5			VAV-1	@VAV BOX	0		1-101-AI-5							
BI-1						VMA	1	101 BI-1			VAV-1	@VAV BOX	0		1-101-BI-1							
BI-2						VMA	1	101 BI-2			VAV-1	@VAV BOX	0		1-101-BI-2							
BI-3						VMA	1	101 BI-3			VAV-1	@VAV BOX	0		1-101-BI-3							
BO-1	VAV	BXHTG-OP	Box Heating Open			VMA	1	101 BO-1		BO-a,BO-b,BCOM	VAV-1	@VAV BOX	0		1-101-BO-1	3/18 VIO	White, Red, Blue	VA-7450 (Incr)		VMA483		
BO-2	VAV	BXHTG-CL	Box Heating Close			VMA	1	101 BO-2			VAV-1	@VAV BOX	0		1-101-BO-2							
BO-3						VMA	1	101 BO-3			VAV-1	@VAV BOX	0		1-101-BO-3							
BO-4						VMA	1	101 BO-4			VAV-1	@VAV BOX	0		1-101-BO-4							
BO-5						VMA	1	101 BO-5			VAV-1	@VAV BOX	0		1-101-BO-5							
AO-1						VMA	1	101 AO-1			VAV-1	@VAV BOX	0		1-101-AO-1							
AO-2						VMA	1	101 AO-2			VAV-1	@VAV BOX	0		1-101-AO-2							

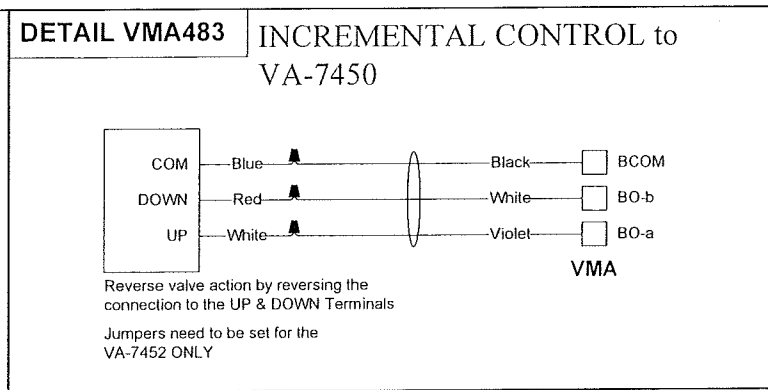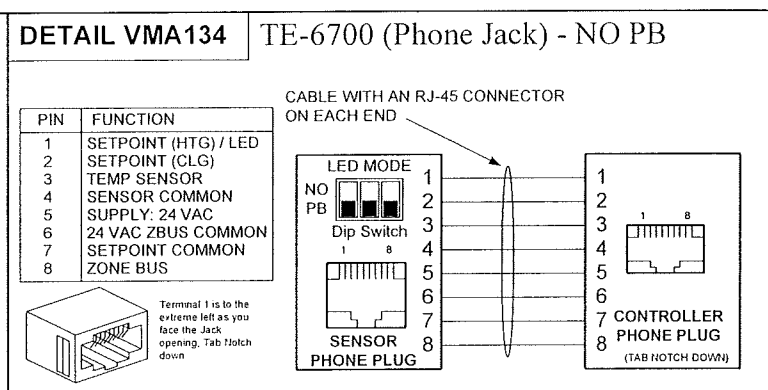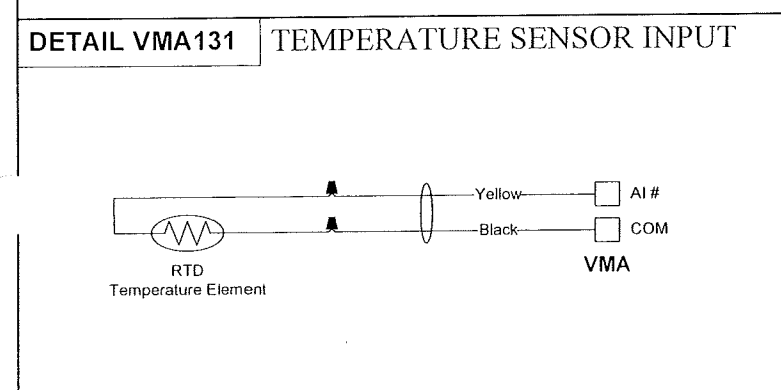


REVISION INFORMATION	Drawing Title						
NUMBER	POINT SCHEDULE						
DATE	04/18/08	REFERENCE DRAWING	NO.	REVISION-LOCATION	ECN	DATE	BY
TIME	09:52 AM	GLA	SEL	RJM	BY	DATE	APPROVED
FILE NAME	rsdetaps1.vsd	Project Title		Branch Information		CONTRACT NUMBER	
		DANE COUNTY COURTHOUSE 215 SOUTH HAMILTON ST. MADISON, WI		JOHNSON CONTROLS Appleton Branch 2140 American Drive Neenah WI 54956 Phone: 920-739-2461 Fax: 920-739-4782		0 3109-0044 DRAWING NUMBER 13.2	

Electrician/Fitter Tag	Point Information				Controller Information					Panel Information			Intermedi		Field Device						
	Point Type	System Name	Object Name	Expanded ID	Controller Type	Trunk Nbr	Trunk Addr.	Cable Destination Bay/Terminal	Module Type	Termination Out	Panel	Panel Location	Slot Number	Reference Drawing	Cable Number	Wiring /Tubing	Termination In	Device	Location	Ref Detail Shape	Comment
					VMA					VAV-2	@VAV BOX										Power to Controller
					VMA	1	102			VAV-2	@VAV BOX										N2 Trunk
AI-1	VAV	ZN-T	Zone Temperature		VMA	1	102 AI-1		Phone Jack	VAV-2	@VAV BOX										
AI-2	VAV	ZNT-SET	Remote Setpoint		VMA	1	102 AI-2			VAV-2	@VAV BOX										
AI-3					VMA	1	102 AI-3			VAV-2	@VAV BOX										
AI-4	VAV	DA-T	Discharge Air Temp		VMA	1	102 AI-4		AI4,COM	VAV-2	@VAV BOX										
AI-5	VAV	SA-VP	Supply Delta P		VMA	1	102 AI-5			VAV-2	@VAV BOX										
BI-1					VMA	1	102 BI-1			VAV-2	@VAV BOX										
BI-2					VMA	1	102 BI-2			VAV-2	@VAV BOX										
BI-3					VMA	1	102 BI-3			VAV-2	@VAV BOX										
BO-1	VAV	BXHTG-OP	Box Heating Open		VMA	1	102 BO-1		BO-a,BO-b,BCOM	VAV-2	@VAV BOX										
BO-2	VAV	BXHTG-CL	Box Heating Close		VMA	1	102 BO-2			VAV-2	@VAV BOX										
BO-3	VAV	xFSD-C	Fire/Smk Damper Cntl		VMA	1	102 BO-3		BO3,BCOM	VAV-2	@VAV BOX										
BO-4					VMA	1	102 BO-4			VAV-2	@VAV BOX										
BO-5					VMA	1	102 BO-5			VAV-2	@VAV BOX										
AO-1					VMA	1	102 AO-1			VAV-2	@VAV BOX										
AO-2					VMA	1	102 AO-2			VAV-2	@VAV BOX										


DETAIL VMA131 TEMPERATURE SENSOR INPUT

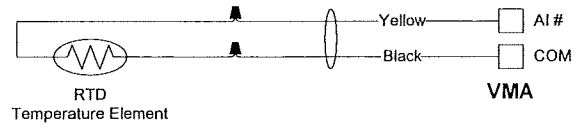


DETAIL VMA134 TE-6700 (Phone Jack) - NO PB

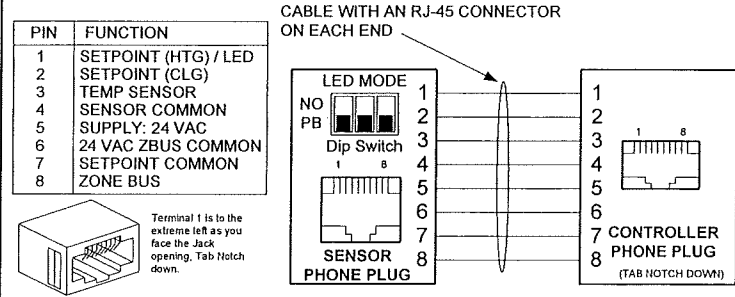

DETAIL VMA401 24 VAC BINARY OUTPUT

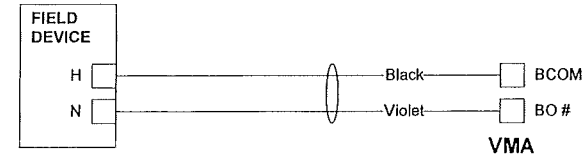

DETAIL VMA483 INCREMENTAL CONTROL to VA-7450

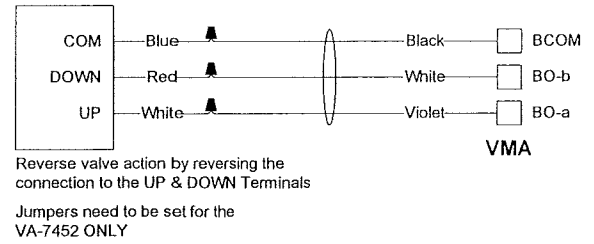

REVISION INFORMATION NUMBER	Drawing Title POINT SCHEDULE				
DATE 04/17/08		REFERENCE DRAWING NO	REVISION-LOCATION NO	ECN	DATE
TIME 10:18 AM	Project Title DANE COUNTY COURTHOUSE 215 SOUTH HAMILTON ST. MADISON, WI	Sales Engineer GLA	Project Manager SEL	Application Engineer RJM	DATE
FILE NAME rsdetaps2.vsd		Branch Information JOHNSON CONTROLS Systems & Services Division		Appleton Branch 2140 American Drive Neenah WI 54956 Phone: 920-739-2461 Fax: 920-739-4782	
		CONTRACT NUMBER 0 3109-0044		DRAWING NUMBER 13.3	

DETAIL B
TYPICAL OF 100

BILL OF MATERIALS

Designation	Qty	Part Number	Description
Field Devices:			
BXHTG-OP, BXHTG-CL	0	VALVE	SEE ROOM SCHEDULE
, RAD-OP, RAD-CL			
DA-T	1	TJBCR01	VERIS-4", 2K PT TEMP SENSOR-VERIS
VMA-x	1	AP-VMA1420-0	VAV MODULAR ASSY - CLG W/ REHEAT
ZN-T, ZNT-SET	1	TE-67NP-2N00	SENSOR, RM, 1K NI, PHONE JACK, SET-PT

VAV TERMINAL WITH HOT WATER REHEAT AND RADIATION:

General:
Terminal unit control dedicated to individual zones using hot water reheat to condition the zone.

System Off:
The hot water valve will modulate closed.

The damper will move to the closed position.

System Start:
Upon a signal from the FMS for the associated air handling unit serving the terminal box to start, the terminal unit controller will also be activated.

System On:
Upon a rise in room temperature above set point the terminal unit's damper will modulate open, increasing CFM, to maintain room set point.

Upon a decrease in room temperature below set point the terminal unit's damper will modulate closed to maintain room set point.

If the temperature continues to fall and the damper has reached it's minimum position, and the hot water re-heat valve will modulate open to maintain room set point.

Upon a rise in room temperature the reverse will occur.

There will be separate heating and cooling set points.

System Stop:
The hot water valve will close.

The damper will move to the closed position.

Safeties and Alarms:
An alarm will be noted in the event of a low and/or high temperature limit in the zone sensor.

Failure Mode
The terminal unit valve will fail to the closed position.

The terminal unit damper will fail to the open position.

FIN RADIATION - HOT WATER:

General:
Control electronically by associated VAV box control.

System Off:
Fin radiation control valve shall be positioned to 100% closed.


System Start:
When the associated hot water system is started, fin radiation control valves shall be permitted to control to set point.

System Run:
Unoccupied Heating Mode:
Fin radiation control valve shall modulate to maintain space temperature at the unoccupied heating set point (adj.).

Occupied Heating Mode:
Fin radiation control valve shall modulate in conjunction with the VAV box to maintain space temperature at the occupied heating set point (adj.).
Set point shall be adjusted remotely from thermostat 65-85F.

System Stop:
Fin radiation control valve shall be indexed to the "System Off" condition.

Safeties and Alarms:
Annunciate alarms when space temperature exceeds minimum and maximum limits.

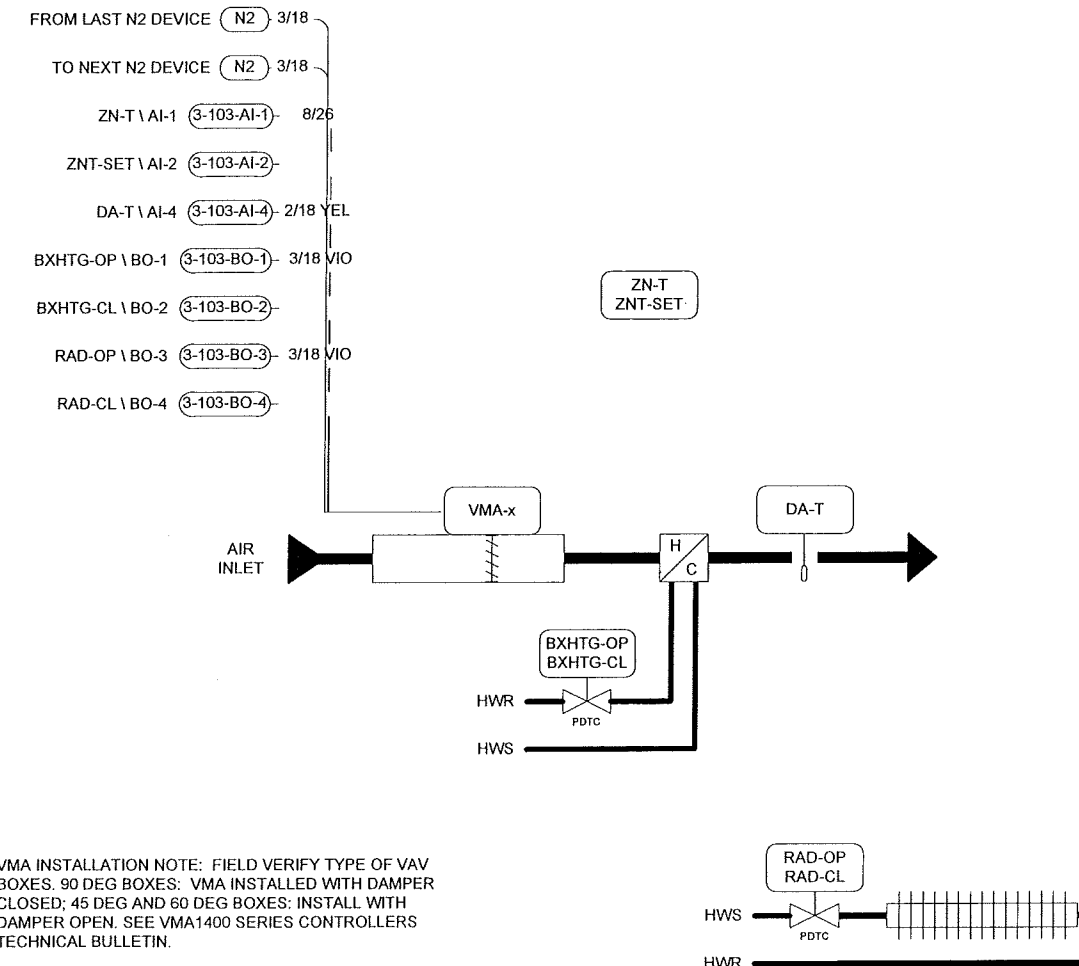

VMA INSTALLATION NOTE: FIELD VERIFY TYPE OF VAV BOXES. 90 DEG BOXES: VMA INSTALLED WITH DAMPER CLOSED; 45 DEG AND 60 DEG BOXES: INSTALL WITH DAMPER OPEN. SEE VMA1400 SERIES CONTROLLERS TECHNICAL BULLETIN.


POWER OBTAINED FROM CENTRAL TRANSFORMER PANEL. MAXIMUM (4) VMA CONTROLLERS PER 100 VA TRANSFORMER.

NOTE: WIRING REFERENCE DETAIL IS SHOWN FOR A VA-7450 ACTUATOR. SOME OF THE RADIATION VALVES HAVE VA-7150 ACTUATORS. SEE INSTALLATION INSTRUCTIONS WITH THE VA-7150 ACTUATORS FOR WIRING DETAILS.


REVISION INFORMATION	Drawing Title								
NUMBER	ROOM SCHEDULE DETAILS	1		RECORD DRAWINGS		03/30/08		WCS	
DATE	04/17/08	SALES ENGINEER	PROJECT MANAGER	APPLICATION ENGINEER	DRAWN	APPROVED			
TIME	08:05 AM	GLA	SEL	RJM	BY	DATE	BY	DATE	
FILE NAME	Rsdetb.vsd	Project Title		Branch Information		CONTRACT NUMBER			
		DANE COUNTY COURTHOUSE 215 SOUTH HAMILTON ST. MADISON, WI 53703		JOHNSON CONTROLS Systems & Services Division		Madison Branch 2400 Kilgust Road Madison WI 53713 Phone: 608-222-9100 Fax: 608-222-9490		0 3109-0044	
								DRAWING NUMBER 13.4	

Electrician/Fitter	Point Information				Controller Information						Panel Information				Intermedi				Field Device			
	Tag	Point Type	System Name	Object Name	Expanded ID	Controller Type	Trunk Nbr	Trunk Addr.	Cable Destination Bay/Terminal	Module Type	Termination Out	Panel	Panel Location	Slot Number	Reference Drawing	Cable Number	Wiring /Tubing	Termination In	Device	Location	Ref Detail Shape	Comment
	AI-1	VAV	ZNT	Zone Temperature		VMA	1	103			VAV-3	@VAV BOX		0								Power to Controller N2 Trunk
	AI-2	VAV	ZNT-SET	Remote Setpoint		VMA	1	103 AI-1		Phone Jack	VAV-3	@VAV BOX		0	3-103-AI-1	8/26	Phone Jack	TE-6700 (Jack, No PB)		VMA134		
	AI-3					VMA	1	103 AI-2			VAV-3	@VAV BOX		0	3-103-AI-2							
	AI-4	VAV	DA-T	Discharge Air Temp		VMA	1	103 AI-3		A4,COM	VAV-3	@VAV BOX		0	3-103-AI-3							
	AI-5	VAV	SA-VP	Supply Delta P		VMA	1	103 AI-4			VAV-3	@VAV BOX		0	3-103-AI-4	2/18 YEL	2-Wire	TE		VMA131		
	BI-1					VMA	1	103 AI-5			VAV-3	@VAV BOX		0	3-103-AI-5							
	BI-2					VMA	1	103 BI-1			VAV-3	@VAV BOX		0	3-103-BI-1							
	BI-3					VMA	1	103 BI-2			VAV-3	@VAV BOX		0	3-103-BI-2							
	BO-1	VAV	BXHTG-OP	Box Heating Open		VMA	1	103 BI-3		BO-a,BO-b,BCOM	VAV-3	@VAV BOX		0	3-103-BI-3							
	BO-2	VAV	BXHTG-CL	Box Heating Close		VMA	1	103 BO-1			VAV-3	@VAV BOX		0	3-103-BO-1	3/18 VIO	White, Red, Blue	VA-7450 (Incr)		VMA483		
	BO-3	VAV	RAD-OP	Suppl Heating Open		VMA	1	103 BO-2		BO-a,BO-b,BCOM	VAV-3	@VAV BOX		0	3-103-BO-2							
	BO-4	VAV	RAD-CL	Suppl Heating Close		VMA	1	103 BO-3			VAV-3	@VAV BOX		0	3-103-BO-3	3/18 VIO	White, Red, Blue	VA-7450 (Incr)		VMA483		
	BO-5					VMA	1	103 BO-4			VAV-3	@VAV BOX		0	3-103-BO-4							
	AO-1					VMA	1	103 BO-5			VAV-3	@VAV BOX		0	3-103-BO-5							
	AO-2					VMA	1	103 AO-1			VAV-3	@VAV BOX		0	3-103-AO-1							
						VMA	1	103 AO-2			VAV-3	@VAV BOX		0	3-103-AO-2							


DETAIL VMA131 TEMPERATURE SENSOR INPUT

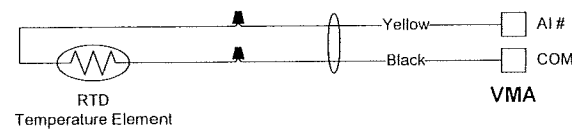

DETAIL VMA134 TE-6700 (Phone Jack) - NO PB




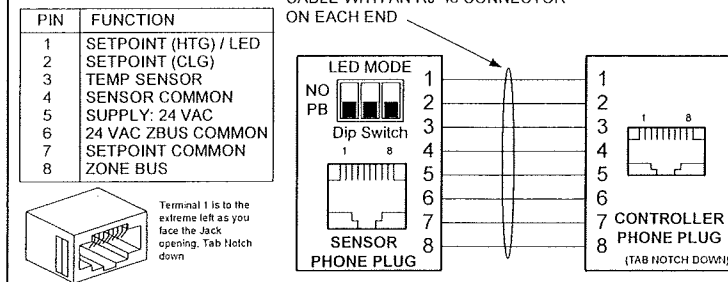


DETAIL VMA483 INCREMENTAL CONTROL to VA-7450

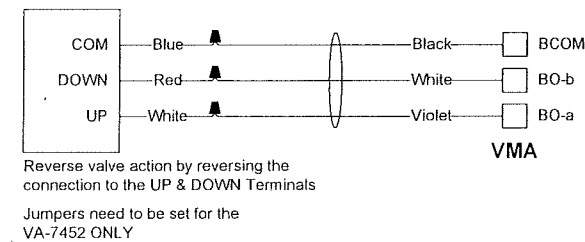

REVISION INFORMATION	Drawing Title								
	NUMBER	POINT SCHEDULE							
DATE	04/18/08								
TIME	04:22 PM								
FILE NAME	rsdelbtps1.vsd								
REFERENCE DRAWING		NO	REVISION-LOCATION		ECN	DATE	BY		
Sales Engineer	Project Manager	Application Engineer	DRAWN		APPROVED				
SRJ	KDK	RJM	BY	DATE	BY	DATE			
Project Title		Branch Information		CONTRACT NUMBER					
DANE COUNTY COURTHOUSE 215 SOUTH HAMILTON ST. MADISON, WI		Appleton Branch 2140 American Drive Neenah WI 54956 Phone: 920-739-2461 Fax: 920-739-4782		0 3109-0044					
		JOHNSON CONTROLS Systems & Services Division		DRAWING NUMBER					
				13.5					

Electrician/Fitter		Point Information			Controller Information					Panel Information			Intermedi		Field Device						
Tag	Point Type	System Name	Object Name	Expanded ID	Controller Type	Trunk Nbr	Trunk Addr.	Cable Destination Bay/Terminal	Module Type	Termination Out	Panel	Panel Location	Slot Number	Reference Drawing	Cable Number	Wiring /Tubing	Termination In	Device	Location	Ref Detail Shape	Comment
					VMA						VAV-4	@VAV BOX									Power to Controller N2 Trunk
AI-1	VAV	ZNT	Zone Temperature		VMA	1	104			Phone Jack	VAV-4	@VAV BOX	0								
AI-2	VAV	ZNT-SET	Remote Setpoint		VMA	1	104 AI-1				VAV-4	@VAV BOX	0		4-104-AI-1	8/26	Phone Jack	TE-6700 (Jack, No PB)		VMA134	
AI-3					VMA	1	104 AI-2				VAV-4	@VAV BOX	0		4-104-AI-2						
AI-4	VAV	DA-T	Discharge Air Temp		VMA	1	104 AI-3			AI,COM	VAV-4	@VAV BOX	0		4-104-AI-3						
AI-5	VAV	SA-VP	Supply Delta P		VMA	1	104 AI-4				VAV-4	@VAV BOX	0		4-104-AI-4	2/18 YEL	2-Wire	TE		VMA131	
BI-1					VMA	1	104 AI-5				VAV-4	@VAV BOX	0		4-104-AI-5						
BI-2					VMA	1	104 BI-1				VAV-4	@VAV BOX	0		4-104-BI-1						
BI-3					VMA	1	104 BI-2				VAV-4	@VAV BOX	0		4-104-BI-2						
BO-1	VAV	BXHTG-OP	Box Heating Open		VMA	1	104 BI-3			BO-a,BO-b,BCOM	VAV-4	@VAV BOX	0		4-104-BI-3						
BO-2	VAV	BXHTG-CL	Box Heating Close		VMA	1	104 BO-1				VAV-4	@VAV BOX	0		4-104-BO-1	3/18 VIO	White, Red, Blue	VA-7450 (Incr)		VMA483	
BO-3	VAV	RAD-OP	Suppl Heating Open		VMA	1	104 BO-2			BO-a,BO-b,BCOM	VAV-4	@VAV BOX	0		4-104-BO-2						
BO-4	VAV	RAD-CL	Suppl Heating Close		VMA	1	104 BO-3				VAV-4	@VAV BOX	0		4-104-BO-3	3/18 VIO	White, Red, Blue	VA-7450 (Incr)		VMA483	
BO-5	VAV	rFSD-C	Fire/Smk Damper Cntl		VMA	1	104 BO-4			BO5,BCOM	VAV-4	@VAV BOX	0		4-104-BO-4						
AO-1					VMA	1	104 BO-5				VAV-4	@VAV BOX	0		4-104-BO-5	2/18 VIO	See wiring detail	24VAC OUT		VMA401	
AO-2					VMA	1	104 AO-1				VAV-4	@VAV BOX	0		4-104-AO-1						
					VMA	1	104 AO-2				VAV-4	@VAV BOX	0		4-104-AO-2						

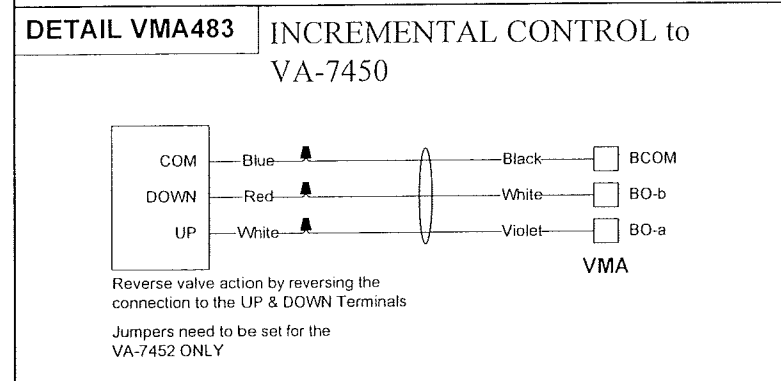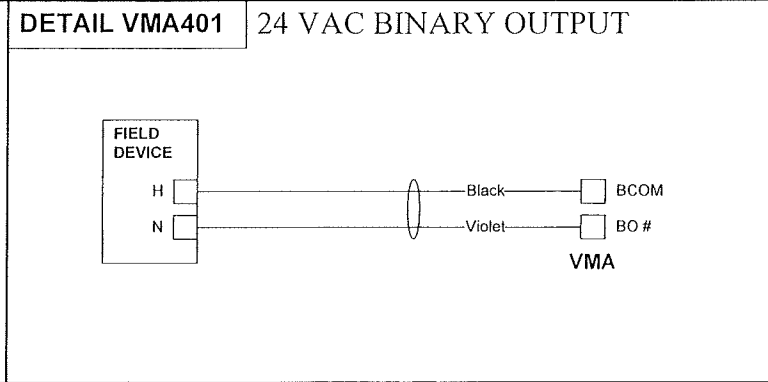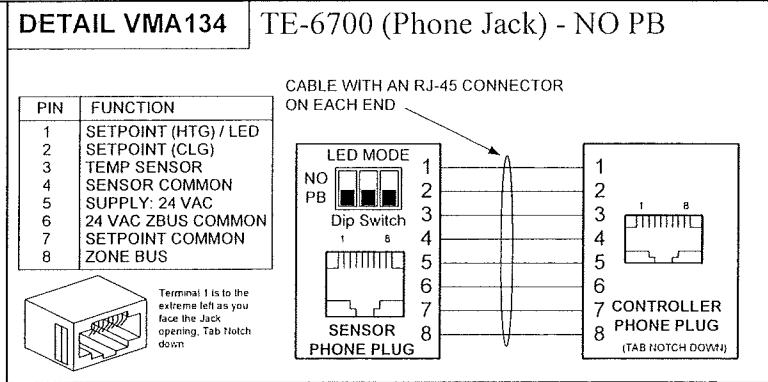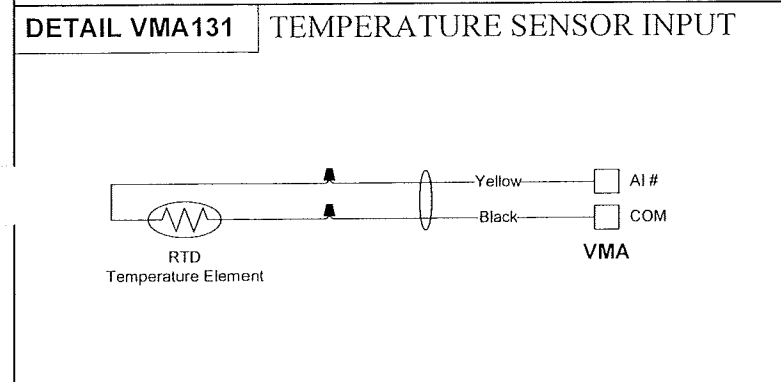


REVISION INFORMATION	Drawing Title								
NUMBER	POINT SCHEDULE								
DATE	04/18/08								
TIME	04:23 PM								
FILE NAME	rsdetbps2.vsd								
Project Title		DANE COUNTY COURTHOUSE		215 SOUTH HAMILTON ST.		MADISON, WI			
Branch Information		Appleton Branch		2140 American Drive		Neenah		WI 54956	
Branch Information		Phone: 920-739-2461		Fax: 920-739-4782					
CONTRACT NUMBER		0 3109-0044		DRAWING NUMBER		13.6			

DETAIL C
TYPICAL OF 12

BILL OF MATERIALS

Designation	Qty	Part Number	Description
Field Devices:			
BXHTG-OP, BXHTG-CL	0	VALVE	SEE ROOM SCHEDULE
DA-T	1	TJBCR01	VERIS-4", 2K PT TEMP SENSOR-VERIS
VMA-x	1	AP-VMA1420-0	VAV MODULAR ASSY - CLG W/ REHEAT
ZN-T	1	TE-6311P-1	SENSOR, T-NI, 0.1%, 8IN DUCT

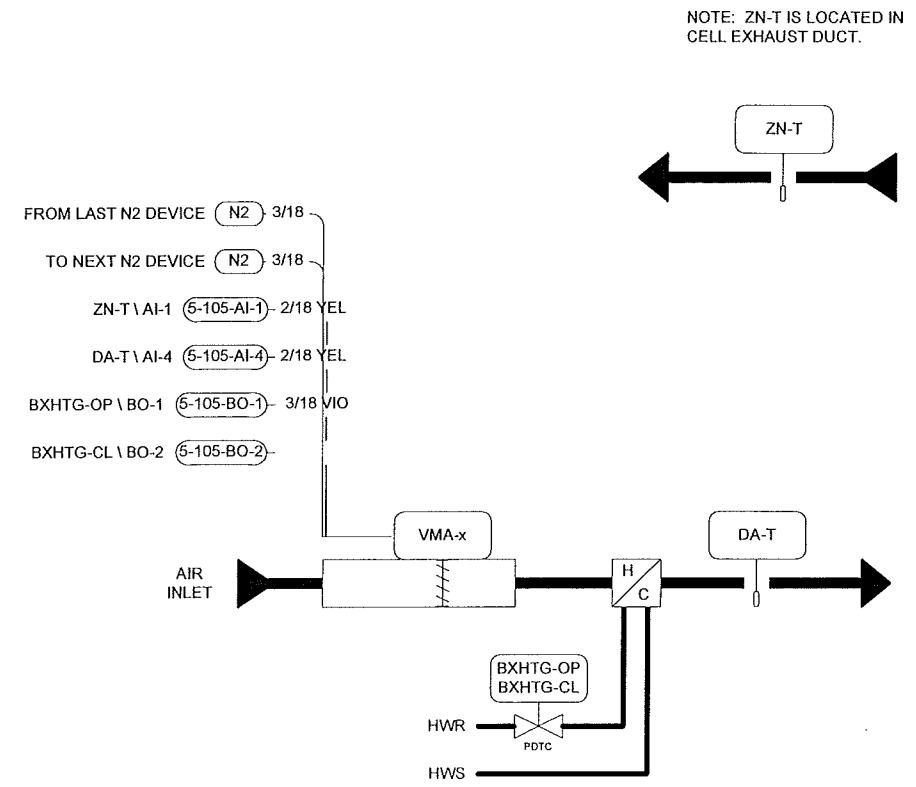

VMA INSTALLATION NOTE: FIELD VERIFY TYPE OF VAV BOXES. 90 DEG BOXES: VMA INSTALLED WITH DAMPER CLOSED; 45 DEG AND 60 DEG BOXES: INSTALL WITH DAMPER OPEN. SEE VMA1400 SERIES CONTROLLERS TECHNICAL BULLETIN.

POWER OBTAINED FROM CENTRAL TRANSFORMER PANEL. MAXIMUM (4) VMA CONTROLLERS PER 100 VA TRANSFORMER.

VAV TERMINAL WITH HOT WATER REHEAT (TEMP SENSOR IN EXHAUST DUCT):

General:
Terminal unit control dedicated to individual zones using hot water reheat to condition the zone.

System Off:
The hot water valve will modulate closed.

The damper will move to the closed position.

System Start:
Upon a signal from the FMS for the associated air handling unit serving the terminal box to start, the terminal unit controller will also be activated.

System On:
Upon a rise in room temperature above set point the terminal unit's damper will modulate open, increasing CFM, to maintain room set point.

Upon a decrease in room temperature below set point the terminal unit's damper will modulate closed to maintain room set point.

If the temperature continues to fall and the damper has reached it's minimum position, and the hot water re-heat valve will modulate open to maintain room set point.

Upon a rise in room temperature the reverse will occur.

There will be separate heating and cooling set points.

System Stop:
The hot water valve will close.

The damper will move to the closed position.

Safeties and Alarms:
An alarm will be noted in the event of a low and/or high temperature limit in the zone sensor.

Failure Mode
The terminal unit valve will fail to the closed position.

The terminal unit damper will fail to the open position.

REVISION INFORMATION	Drawing Title								
NUMBER	ROOM SCHEDULE DETAILS								
DATE	04/17/08	1	RECORD DRAWINGS	03/30/08	WCS				
TIME	08:05 AM	GLA	SEL	RJM	BY	DATE	BY	DATE	CONTRACT NUMBER
FILE NAME	rsdetc.vsd	Project Title		DANE COUNTY COURTHOUSE 215 SOUTH HAMILTON ST. MADISON, WI 53703		Branch Information		0 3109-0044	
		JOHNSON CONTROLS		Systems & Services Division		Madison Branch 2400 Kilgust Road Madison WI 53713 Phone: 608-222-9100 Fax: 608-222-9490		DRAWING NUMBER 13.7	

DETAIL D
TYPICAL OF 1

BILL OF MATERIALS

Designation	Qty	Part Number	Description
Field Devices:			
BXHTG-OP, BXHTG-CL , RAD-OP, RAD-CL	0	VALVE	SEE ROOM SCHEDULE
DA-T	2	TJBCR01	VERIS-4", 2K PT TEMP SENSOR-VERIS
VMA-x	2	AP-VMA1420-0	VAV MODULAR ASSY - CLG W/ REHEAT
ZN-T, ZNT-SET	1	TE-67NP-2N00	SENSOR, RM, 1K NI, PHONE JACK, SET-PT

VAV TERMINAL WITH HOT WATER REHEAT AND RADIATION (ONE ZONE SENSOR SERVING TWO VAV BOXES):

General:
Terminal unit control dedicated to individual zones using hot water reheat to condition the zone.

System Off:
The hot water valve will modulate closed.

The damper will move to the closed position.

System Start:
Upon a signal from the FMS for the associated air handling unit serving the terminal box to start, the terminal unit controller will also be activated.

System On:
Upon a rise in room temperature above set point the terminal unit's damper will modulate open, increasing CFM, to maintain room set point.

Upon a decrease in room temperature below set point the terminal unit's damper will modulate closed to maintain room set point.

If the temperature continues to fall and the damper has reached it's minimum position, and the hot water re-heat valve will modulate open to maintain room set point.

Upon a rise in room temperature the reverse will occur.

There will be separate heating and cooling set points.

System Stop:
The hot water valve will close.

The damper will move to the closed position.

Safeties and Alarms:
An alarm will be noted in the event of a low and/or high temperature limit in the zone sensor.

Failure Mode
The terminal unit valve will fail to the closed position.

The terminal unit damper will fail to the open position.

FIN RADIATION - HOT WATER:

General:
Control electronically by associated VAV box control.

System Off:
Fin radiation control valve shall be positioned to 100% closed.





System Start:
When the associated hot water system is started, fin radiation control valves shall be permitted to control to set point.

System Run:
Unoccupied Heating Mode:
Fin radiation control valve shall modulate to maintain space temperature at the unoccupied heating set point (adj.).

Occupied Heating Mode:
Fin radiation control valve shall modulate in conjunction with the VAV box to maintain space temperature at the occupied heating set point (adj.).
Set point shall be adjusted remotely from thermostat 65-85F.

System Stop:
Fin radiation control valve shall be indexed to the "System Off" condition.

Safeties and Alarms:
Annunciate alarms when space temperature exceeds minimum and maximum limits.

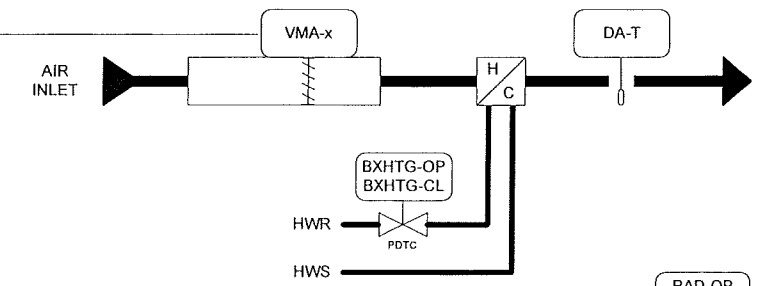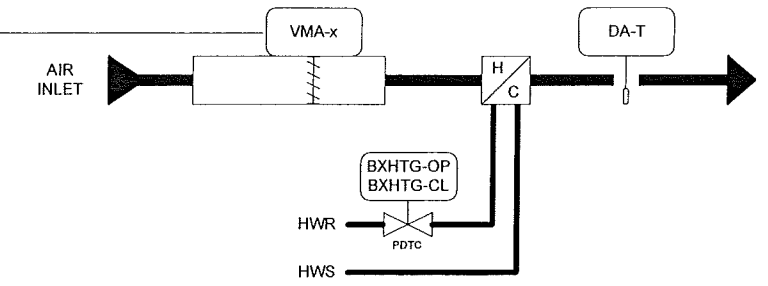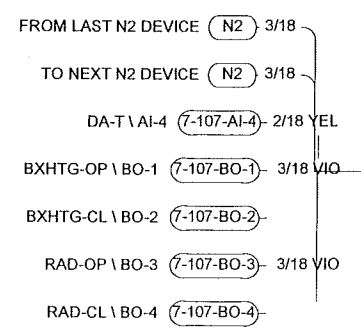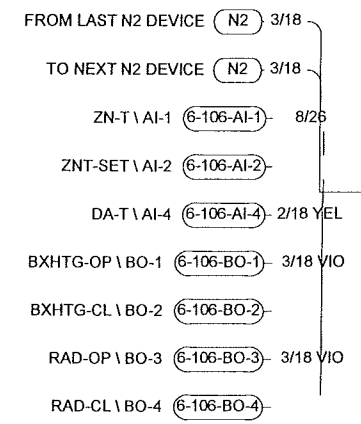


VMA INSTALLATION NOTE: FIELD VERIFY TYPE OF VAV BOXES. 90 DEG BOXES: VMA INSTALLED WITH DAMPER CLOSED; 45 DEG AND 60 DEG BOXES: INSTALL WITH DAMPER OPEN. SEE VMA1400 SERIES CONTROLLERS TECHNICAL BULLETIN.

POWER OBTAINED FROM CENTRAL TRANSFORMER PANEL. MAXIMUM (4) VMA CONTROLLERS PER 100 VA TRANSFORMER.


REVISION INFORMATION	Drawing Title				
NUMBER	ROOM SCHEDULE DETAILS				
DATE	04/17/08	NO.	1	RECORD DRAWINGS	03/30/08 WCS
TIME	08:05 AM	REFERENCE DRAWING	NO.	REVISION-LOCATION	ECN DATE BY
FILE NAME	rsdetd.vsd	Sales Engineer	Project Manager	Application Engineer	DRAWN APPROVED
		GLA	SEL	RJM	BY DATE BY DATE
	Project Title	Branch Information			CONTRACT NUMBER
	DANE COUNTY COURTHOUSE 215 SOUTH HAMILTON ST. MADISON, WI 53703	 Systems & Services Division Madison Branch 2400 Kilgust Road Madison WI 53713 Phone: 608-222-9100 Fax: 608-222-9490			0 3109-0044
					DRAWING NUMBER
					13.9

Electrician/Fitter	Point Information				Controller Information					Panel Information				Intermedi		Field Device				Ref Detail Shape	Comment	
	Tag	Point Type	System Name	Object Name	Expanded ID	Controller Type	Trunk Nbr	Trunk Addr.	Cable Destination Bay/Terminal	Module Type	Termination Out	Panel	Panel Location	Slot Number	Reference Drawing	Cable Number	Wiring /Tubing	Termination In	Device			Location
						VMA					VAV-6	@VAV BOX										Power to Controller N2 Trunk
AI-1	VAV	ZNT	Zone Temperature		VMA	1	106			Phone Jack	VAV-6	@VAV BOX	0		6-106-AI-1	8/26	Phone Jack	TE-6700 (Jack, No PB)		VMA134		
AI-2	VAV	ZNT-SET	Remote Setpoint		VMA	1	106	AI-1			VAV-6	@VAV BOX	0		6-106-AI-2							
AI-3					VMA	1	106	AI-2			VAV-6	@VAV BOX	0		6-106-AI-3							
AI-4	VAV	DA-T	Discharge Air Temp		VMA	1	106	AI-3		AI4,COM	VAV-6	@VAV BOX	0		6-106-AI-4	2/18 YEL	2-Wire	TE		VMA131		
AI-5	VAV	SA-VP	Supply Delta P		VMA	1	106	AI-4			VAV-6	@VAV BOX	0		6-106-AI-5							
BI-1					VMA	1	106	BI-1			VAV-6	@VAV BOX	0		6-106-BI-1							
BI-2					VMA	1	106	BI-2			VAV-6	@VAV BOX	0		6-106-BI-2							
BI-3					VMA	1	106	BI-3			VAV-6	@VAV BOX	0		6-106-BI-3							
BO-1	VAV	BXHTG-OP	Box Heating Open		VMA	1	106	BO-1		BO-a,BO-b,BCOM	VAV-6	@VAV BOX	0		6-106-BO-1	3/18 VIO	White, Red, Blue	VA-7450 (Incr)		VMA483		
BO-2	VAV	BXHTG-CL	Box Heating Close		VMA	1	106	BO-2			VAV-6	@VAV BOX	0		6-106-BO-2							
BO-3	VAV	RAD-OP	Suppl Heating Open		VMA	1	106	BO-3		BO-a,BO-b,BCOM	VAV-6	@VAV BOX	0		6-106-BO-3	3/18 VIO	White, Red, Blue	VA-7450 (Incr)		VMA483		
BO-4	VAV	RAD-CL	Suppl Heating Close		VMA	1	106	BO-4			VAV-6	@VAV BOX	0		6-106-BO-4							
BO-5					VMA	1	106	BO-5			VAV-6	@VAV BOX	0		6-106-BO-5							
AO-1					VMA	1	106	AO-1			VAV-6	@VAV BOX	0		6-106-AO-1							
AO-2					VMA	1	106	AO-2			VAV-6	@VAV BOX	0		6-106-AO-2							


DETAIL VMA131 TEMPERATURE SENSOR INPUT

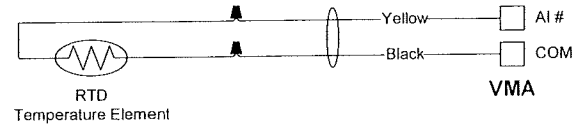

DETAIL VMA134 TE-6700 (Phone Jack) - NO PB

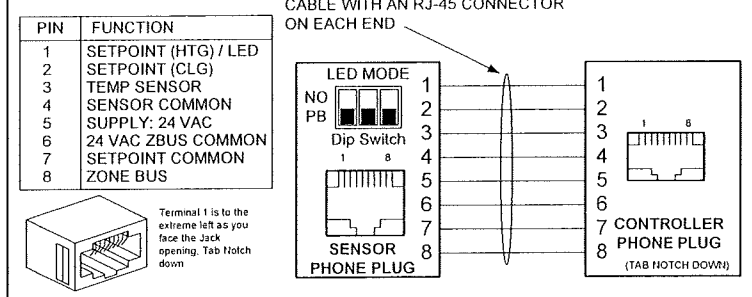


DETAIL VMA483 INCREMENTAL CONTROL to VA-7450

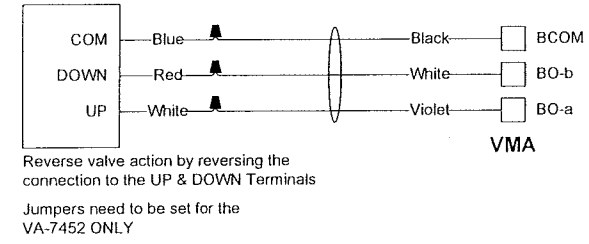


REVISION INFORMATION	Drawing Title								
NUMBER	POINT SCHEDULE								
DATE	04/18/08	REFERENCE DRAWING	NO.	REVISION-LOCATION		ECN	DATE	BY	
TIME	04:24 PM	GLA	SEL	RJM	DATE	DATE	DATE	DATE	
FILE NAME	rsdtdps1.vst	Project Title		Branch Information		CONTRACT NUMBER			
		DANE COUNTY COURTHOUSE 215 SOUTH HAMILTON ST. MADISON, WI		Appleton Branch 2140 American Drive Neenah WI 54956 Phone: 920-739-2461 Fax: 920-739-4782		0 3109-0044			
		JOHNSON CONTROLS Systems & Services Division				DRAWING NUMBER		13.10	

Electrician/Fitter		Point Information			Controller Information					Panel Information			Intermedi		Field Device						
Tag	Point Type	System Name	Object Name	Expanded ID	Controller Type	Trunk Nbr	Trunk Addr.	Cable Destination Bay/Terminal	Module Type	Termination Out	Panel	Panel Location	Slot Number	Reference Drawing	Cable Number	Wiring /Tubing	Termination In	Device	Location	Ref Detail Shape	Comment
					VMA						VAV-7	@VAV BOX									Power to Controller N2 Trunk
					VMA	1	107				VAV-7	@VAV BOX	0								
AI-1	VAV	ZN-T	Zone Temperature		VMA	1	107	AI-1	AI1_AICM		VAV-7	@VAV BOX	0		7-107-AI-1	1/18, BLK	1-Wire	Jumper			
AI-2	VAV	ZNT-SET	Remote Setpoint		VMA	1	107	AI-2	AI2_AICM		VAV-7	@VAV BOX	0		7-107-AI-2	1/18, BLK	1-Wire	Jumper			
AI-3					VMA	1	107	AI-3			VAV-7	@VAV BOX	0		7-107-AI-3						
AI-4	VAV	DA-T	Discharge Air Temp		VMA	1	107	AI-4	AI4_COM		VAV-7	@VAV BOX	0		7-107-AI-4	2/18 YEL	2-Wire	TE		VMA131	
AI-5	VAV	SA-VP	Supply Delta P		VMA	1	107	AI-5			VAV-7	@VAV BOX	0		7-107-AI-5						
BI-1					VMA	1	107	BI-1			VAV-7	@VAV BOX	0		7-107-BI-1						
BI-2					VMA	1	107	BI-2			VAV-7	@VAV BOX	0		7-107-BI-2						
BI-3					VMA	1	107	BI-3			VAV-7	@VAV BOX	0		7-107-BI-3						
BO-1	VAV	BXHTG-OP	Box Heating Open		VMA	1	107	BO-1	BO-a,BO-b,BCOM		VAV-7	@VAV BOX	0		7-107-BO-1	3/18 VIO	White, Red, Blue	VA-7450 (Incr)		VMA483	
BO-2	VAV	BXHTG-CL	Box Heating Close		VMA	1	107	BO-2			VAV-7	@VAV BOX	0		7-107-BO-2						
BO-3	VAV	RAD-OP	Suppl Heating Open		VMA	1	107	BO-3	BO-a,BO-b,BCOM		VAV-7	@VAV BOX	0		7-107-BO-3	3/18 VIO	White, Red, Blue	VA-7450 (Incr)		VMA483	
BO-4	VAV	RAD-CL	Suppl Heating Close		VMA	1	107	BO-4			VAV-7	@VAV BOX	0		7-107-BO-4						
BO-5					VMA	1	107	BO-5			VAV-7	@VAV BOX	0		7-107-BO-5						
AO-1					VMA	1	107	AO-1			VAV-7	@VAV BOX	0		7-107-AO-1						
AO-2					VMA	1	107	AO-2			VAV-7	@VAV BOX	0		7-107-AO-2						

DETAIL VMA131 TEMPERATURE SENSOR INPUT

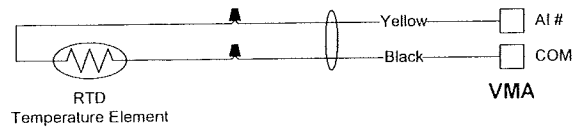

DETAIL VMA483 INCREMENTAL CONTROL to VA-7450

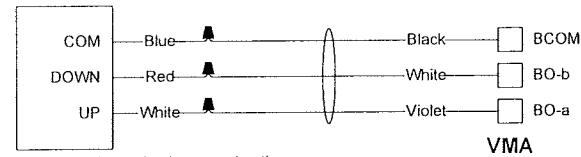

Reverse valve action by reversing the connection to the UP & DOWN Terminals


Jumpers need to be set for the VA-7452 ONLY

REVISION INFORMATION	Drawing Title								
NUMBER	POINT SCHEDULE								
DATE		REFERENCE DRAWING	NO	REVISION LOCATION		ECH	DATE	BY	
04/18/08		GLA	SEL	RJM					
TIME	Project Title	DRAWN		APPROVED		DATE		CONTRACT NUMBER	
04:24 PM	DANE COUNTY COURTHOUSE 215 SOUTH HAMILTON ST. MADISON, WI	JOHNSON CONTROLS		Appleton Branch 2140 American Drive Neenah WI 54956 Phone: 920-739-2461 Fax: 920-739-4782		DATE		0 3109-0044	
FILE NAME	rsdtdps2.vst	Systems & Services Division				DATE		DRAWING NUMBER	
								13.11	


BILL OF MATERIALS

Designation	Qty	Part Number	Description
Field Devices:			
TS-1	1	T26S-18C	STAT, 120VAC, RM, HTG/CLG, ADJ, 40/90F
TS-2	1	A19DAC-1C	STAT, STRP, SPDT, 100/240F
V-1	0	VALVE	SEE ROOM SCHEDULE

DETAIL E
TYPICAL OF 29

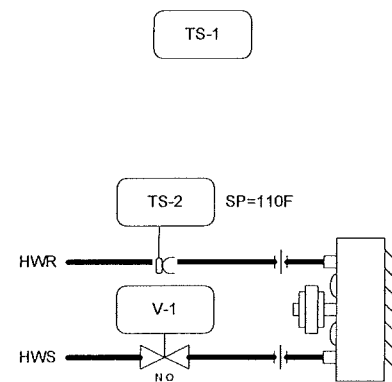

UNIT HEATER WIRING

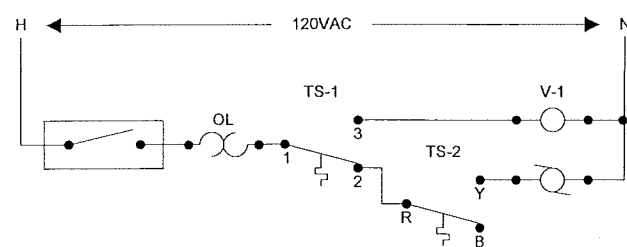

UNIT HEATER / CABINET UNIT HEATER ELECTRIC CONTROL - HOT WATER:

General:
Controlled locally by line voltage thermostat.

System Off:
Unit heater control valve will be closed, and fan disabled.

System Start:
When hot water return pipe is 110 degrees F or greater as sensed by line voltage aquastat, the unit heater will be permitted to run


System Run:
Line voltage electric thermostat will cycle control valve and fan to maintain set point

System Stop:
Unit heater will be indexed to the "System Off" condition.

BILL OF MATERIALS

Designation	Qty	Part Number	Description
Field Devices:			
EF6-C, EF6-S	1	H748	SENS, CURR, 1A @30VAC/DC, 1/4HP, CMND RELAY
EF6-DPR	0	DAMPER	SEE DAMPER SCHEDULE
MECH-T	1	TE-67NT-0N00	TEMP SENSOR 1K NICKEL
TX-1	1	M9000-103	CLASS 2 TRANSFORMER

DETAIL F
TYPICAL OF 1

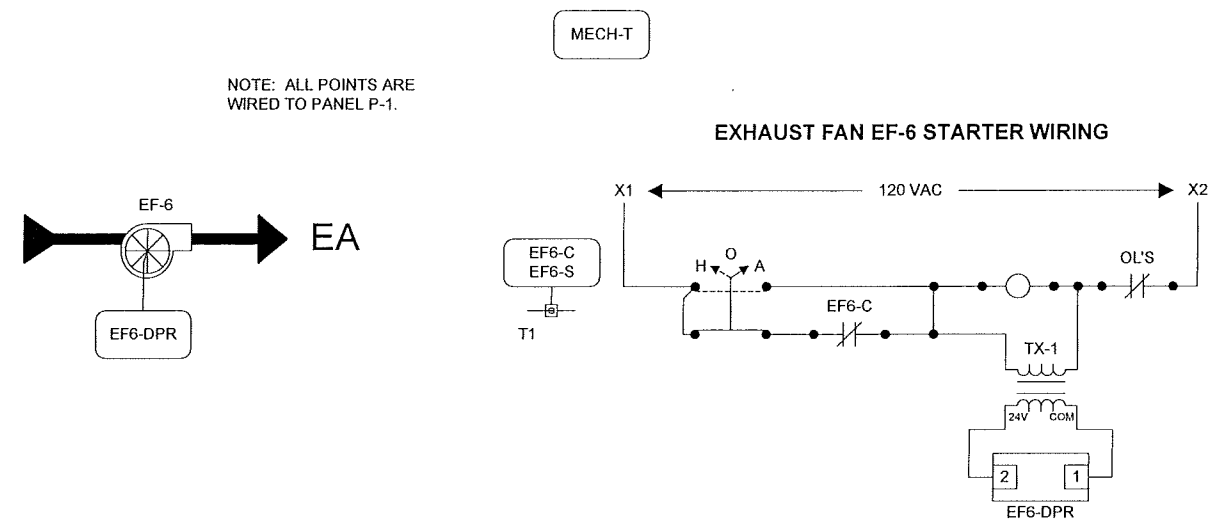

NOTE: ALL POINTS ARE WIRED TO PANEL P-1.

MECHANICAL ROOM EXHAUST FAN EF-6 OCCUPIED/UNOCCUPIED CONTROL:

General:
The exhaust fan will run in different modes when in occupied or unoccupied control. The exhaust fan will operate in low flow when not in high flow as required by Mechanical Refrigeration Code Comm 45.

System Off:
The exhaust fan will operate in low flow when not in high flow as required by Mechanical Refrigeration Code Comm 45.

System Start:
Upon a signal from the FMS system the fan will start and Vortex inlet dampers will vary flow from low to high.

System On:
Upon a call for cooling from the FMS the system fan will start modulate air flow to maximum.

System Stop:
The fan will operate continuously in low flow.

Safeties and Alarms:
The system will have a manual override switch to turn the system on at low flow from the smoke control panel.

Fan EF-6 will operate at full flow upon a high alarm from the refrigerant leak detector (See Section 15675).


Failure Modes:
The fan will fail to on with full flow position.

REVISION INFORMATION	Drawing Title	NO.		REVISION-LOCATION		ECN	DATE	BY
NUMBER	ROOM SCHEDULE DETAILS	1		RECORD DRAWINGS			03/30/08	WCS
DATE		Sales Engineer	Project Manager	Application Engineer	DRAWN	APPROVED		
04/17/08		GLA	SEL	RJM		BY	DATE	BY
TIME	Project Title	Branch Information		CONTRACT NUMBER				
08:05 AM	DANE COUNTY COURTHOUSE 215 SOUTH HAMILTON ST. MADISON, WI 53703	 Systems & Services Division		Madison Branch 2400 Kilgust Road Madison WI 53713 Phone: 608-222-9100 Fax: 608-222-9490		0 3109-0044 DRAWING NUMBER 13.12		
FILE NAME	rsdetef.vsd							


BILL OF MATERIALS

Designation	Qty	Part Number	Description
Field Devices:			
D-x	0	DAMPER	SEE DAMPER SCHEDULE
EF9-C, EF9-S	1	H738	SENS,CURR,1A @30VAC/DC,1/3HP,CMND RELAY
GEN-T	1	TE-67NT-0N00	TEMP SENSOR 1K NICKEL

DETAIL G
TYPICAL OF 1

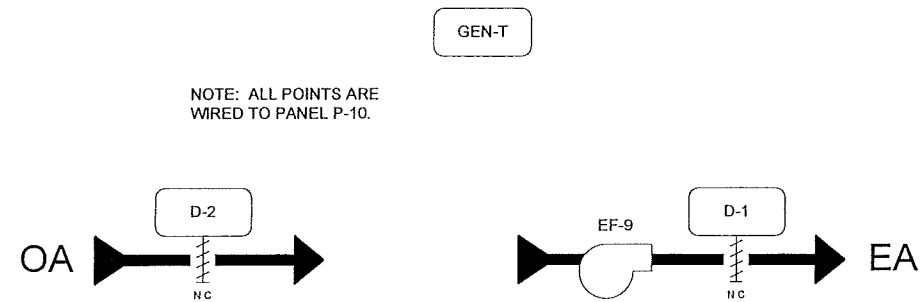

EXHAUST FAN EF-9 STARTER WIRING

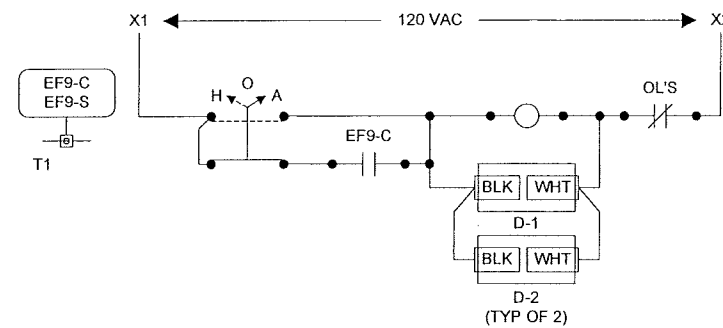

GENERATOR ROOM EXHAUST FAN EF-9 CONTROL:

General:
Exhaust fan control to maintain a thermostat set point throughout the space with electronic control.

System On:
The fan shall operate if space temperature rises above set point. Otherwise, fan is off. The exhaust and outdoor air damper will be open when the fan is energized.


Failure Mode:
The fan shall fail to the off position.

BILL OF MATERIALS


Designation	Qty	Part Number	Description
Field Devices:			
EFx-C, EFx-S	1	H548	SENS,CURR,0.5-20A,MINI,CMND RLY,HOA,ADJU
LL200x-T	1	TE-67NT-0N00	TEMP SENSOR 1K NICKEL

DETAIL H
TYPICAL OF 2

NOTE: ALL POINTS ARE WIRED TO PANEL P-10 FOR BOTH EF-10 AND EF-11 AND THEIR ASSOCIATED ZONE TEMPERATURE SENSORS.

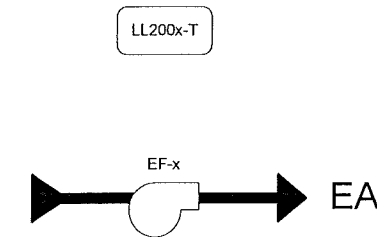

EXHAUST FAN WIRING

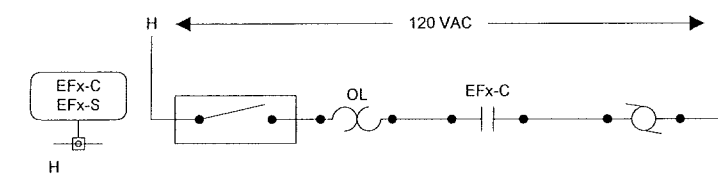

ELECTRICAL EQUIPMENT ROOM EXHAUST FAN CONTROL:

General:
Exhaust fan control to maintain a thermostat set point throughout the space with electronic control.

System On:
The fan shall operate if space temperature rises above set point. Otherwise, fan is off.


Failure Mode:
The fan shall fail to the off position.

REVISION INFORMATION	Drawing Title								
NUMBER	ROOM SCHEDULE DETAILS	1		RECORD DRAWINGS		03/30/08		WCS	
DATE	04/17/08	REFERENCE DRAWING NO.		REVISION LOCATION		ECN		DATE	
TIME	08:05 AM	Sales Engineer		Project Manager		Application Engineer		BY	
FILE NAME	Rsdetgh.vsd	GLA		SEL		RJM		DATE	
Project Title		Branch Information		CONTRACT NUMBER		DRAWING NUMBER			
DANE COUNTY COURTHOUSE 215 SOUTH HAMILTON ST. MADISON, WI 53703		Madison Branch 2400 Kilgust Road Madison WI 53713 Phone: 608-222-9100 Fax: 608-222-9490		0 3109-0044		13.13			
		JOHNSON CONTROLS Systems & Services Division							

BILL OF MATERIALS


Designation	Qty	Part Number	Description
Field Devices:			
D-1	0	DAMPER	SEE DAMPER SCHEDULE
KEF1-C, KEF1-S	1	H738	SENS,CURR,1A @30VAC/DC,1/3HP,CMND RELAY
KITCH-T	1	TE-67NT-0N00	TEMP SENSOR 1K NICKEL

DETAIL I
TYPICAL OF 1

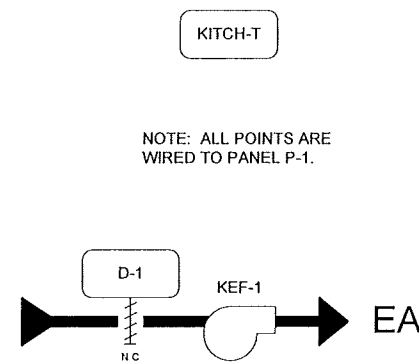

NOTE: ALL POINTS ARE WIRED TO PANEL P-1.

KITCHEN EXHAUST FAN KEF-1 STARTER WIRING

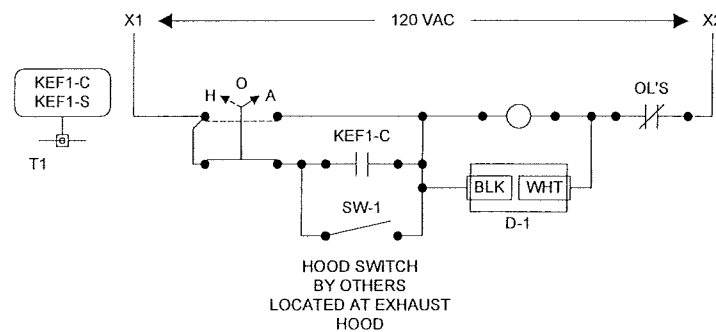

KITCHEN ROOM EXHAUST FAN (TEMPERATURE CONTROL):

General:
Exhaust fan control to maintain a thermostat set point throughout the space with electronic control.

System Off:
The fan will operate if space temperature rises above set point. Otherwise, fan is off.

System On:
When switch at hood is on fan will operate.


System Stop:
Fan will stop and operate as required by space temperature when local switch is in Off position.

Failure Mode:
The fan will fail to the off position.

BILL OF MATERIALS


Designation	Qty	Part Number	Description
Field Devices:			
GAR-COx	2	GWWXS	SENSOR, CO,WALL,ALARM @ 35PPM,0-5/10VDC
SCF2-C, SCF2-S	1	H738	SENS,CURR,1A @30VAC/DC,1/3HP,CMND RELAY
SCF2-DPR	0	DAMPER	SEE DAMPER SCHEDULE
SMK-OVR	1	RIBU1C	10AMP SPDT 10-30VAC/DC/120VAC
TX-1	1	M9000-103	CLASS 2 TRANSFORMER

DETAIL J
TYPICAL OF 1

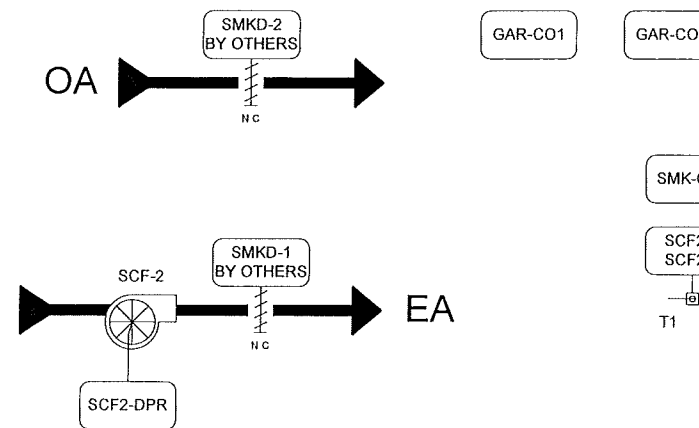

NOTE: ALL POINTS ARE WIRED TO PANEL P-10.

SMOKE CONTROL FAN SCF-2 STARTER WIRING

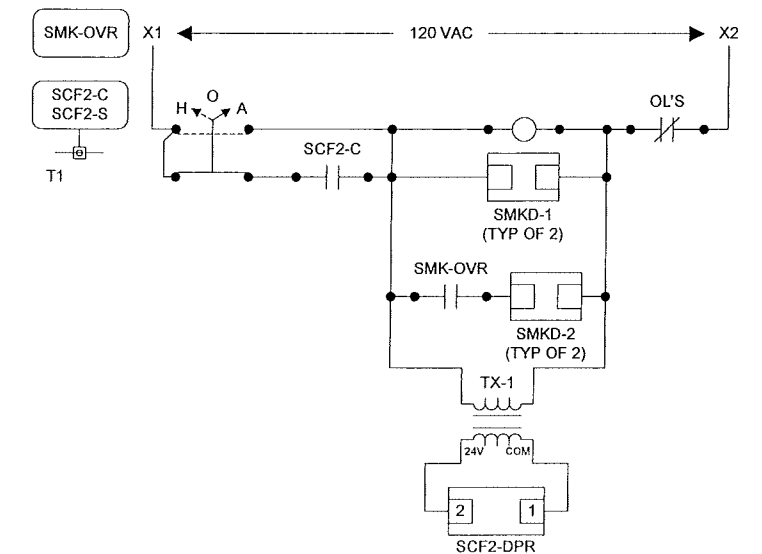

PARKING EXHAUST FAN:

System Off:
SCF-2 is off.

System On:
CO sensor will energize SCF-2 and EL-1 will open. When a ppm of 25 (adjustable) is reached, SCF-2 will operate and EL-1 will open. From 7am to 9am and from 4pm to 7pm daily SCF-2 will operate and EL-1 will open.

System Stop:
The damper will close.

The fan will move to the off position.

Smoke Control, Fire in Parking:
In a smoke control mode the SCF-2 will start, and damper for the associated smoke damper will open. The damper for EL-1 will close.

Failure Modes:
The fan will fail to the off position.


The damper will fail to the closed position.

REVISION INFORMATION	Drawing Title	NO.		REVISION-LOCATION		ECN	DATE	BY
NUMBER	ROOM SCHEDULE DETAILS	1		RECORD DRAWINGS			03/30/08	WCS
DATE		Sales Engineer	Project Manager	Application Engineer	DRAWN		APPROVED	
04/17/08		GLA	SEL	RJM	BY	DATE	BY	DATE
TIME	Project Title	Branch Information		CONTRACT NUMBER				
08:04 AM	DANE COUNTY COURTHOUSE 215 SOUTH HAMILTON ST. MADISON, WI 53703	 Systems & Services Division		Madison Branch 2400 Kilgust Road Madison WI 53713 Phone: 608-222-9100 Fax: 608-222-9490		0 3109-0044 DRAWING NUMBER 13.14		
FILE NAME	Rsdetljj.vsd							


BILL OF MATERIALS

Designation	Qty	Part Number	Description
Field Devices:			
LLx-T	1	TE-67NT-0N00	TEMP SENSOR 1K NICKEL
RADx-OP, RADx-CL	0	VALVE	SEE ROOM SCHEDULE

DETAIL K
TYPICAL OF 3

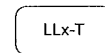

NOTE: ALL POINTS ARE WIRED TO UNIT CONTROLLERS MOUNTED ABOVE THE CEILING SPACE. SEE MISCELLANEOUS DETAIL L FOR DETAILS.

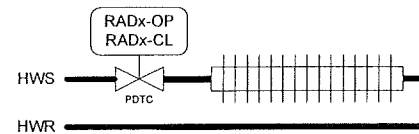

FIN RADIATION - HOT WATER:

System Off:
Fin radiation control valve will be positioned to 100% closed.



System Start:
When the associated hot water system is started, fin radiation control valves will be permitted to control to set point.

System Run:
Fin radiation control valve will modulate to maintain space temperature at the heating set point (adj.).


System Stop:
Fin radiation control valve will be indexed to the "System Off" condition.

Safeties and Alarms:
Annunciate alarms when space temperature exceeds minimum and maximum limits.

DETAIL L
TYPICAL OF 6

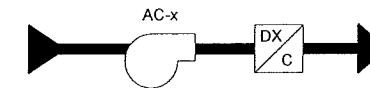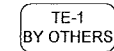

NOTE: WIRING DETAILS NOT AVAILABLE AT TIME OF SUBMITTAL.

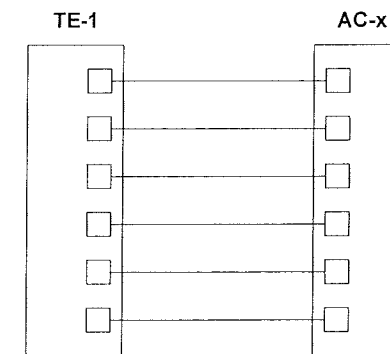

SELF CONTAINED AIR CONDITIONING UNIT:

All of the controls will be provided with the unit. JCI will mount and wire the zone temperature sensor to the unit.

REVISION INFORMATION	Drawing Title								
NUMBER	ROOM SCHEDULE DETAILS		1	RECORD DRAWINGS		03/30/08	WCS		
DATE	04/17/08	REFERENCE DRAWING	NO.	REVISION-LOCATION	ECN	DATE	BY	APPROVED	
TIME	08:04 AM	SALES ENGINEER	PROJECT MANAGER	APPLICATION ENGINEER	BY	DATE	BY	DATE	
FILE NAME	Rsdetkl.vsd	GLA	SEL	RJM					
	Project Title	DANE COUNTY COURTHOUSE 215 SOUTH HAMILTON ST. MADISON, WI 53703			Branch Information		CONTRACT NUMBER		
		JOHNSON CONTROLS Systems & Services Division			Madison Branch 2400 Kilgust Road Madison WI 53713 Phone: 608-222-9100 Fax: 608-222-9490		0 3109-0044		
							DRAWING NUMBER		
							13.15		


BILL OF MATERIALS

Designation	Qty	Part Number	Description
Field Devices:			
FCU2-C	1	RIBU1S	10AMP SPST-NO+HOA 10-30VAC/DC/120VAC
FCU2-CLG, FCU2-HTG	0	VALVE	SEE ROOM SCHEDULE
LL2041-T	1	TE-67NT-0N00	TEMP SENSOR 1K NICKEL


DETAIL M
TYPICAL OF 1

LL2041-T

NOTE: ALL CONTROL POINTS ARE WIRED TO UNIT CONTROLLER LOCATED ABOVE THE CEILING SPACE. SEE MISCELLANEOUS DETAIL L FOR DETAILS.

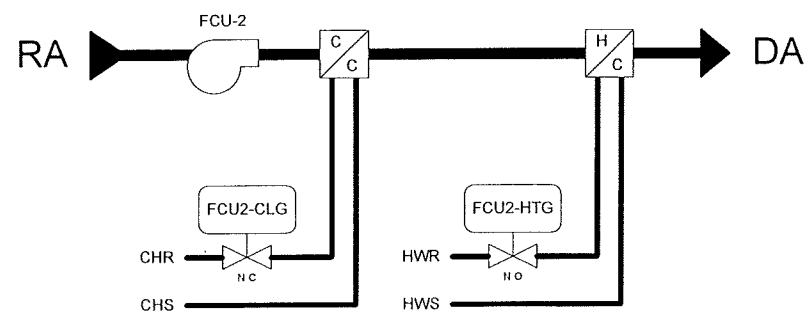

FAN COIL UNIT FCU-2 WIRING

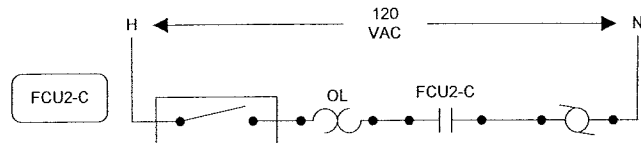

FAN COIL UNIT:

The fan will run continuously during occupied times. When the unit is running, on a call for heat, the hot water valve will open to maintain zone temperature set point. When the unit is running, on a call for cool, the chilled water valve will open to maintain zone temperature set point. During unoccupied times, when the unit is running, both the valves will be closed.

BILL OF MATERIALS

Designation	Qty	Part Number	Description
Field Devices:			
FCU1-C, FCU1-CLG	2	RIBU1S	10AMP SPST-NO+HOA 10-30VAC/DC/120VAC
LL2040-T	1	TE-67NT-0N00	TEMP SENSOR 1K NICKEL

DETAIL N
TYPICAL OF 1


LL2040-T

NOTE: ALL CONTROL POINTS ARE WIRED TO UNIT CONTROLLER LOCATED ABOVE THE CEILING SPACE. SEE MISCELLANEOUS DETAIL L FOR DETAILS.




NOTE: WIRING DETAILS NOT AVAILABLE AT TIME OF SUBMITTAL.

FAN COIL UNIT FCU-1 WIRING

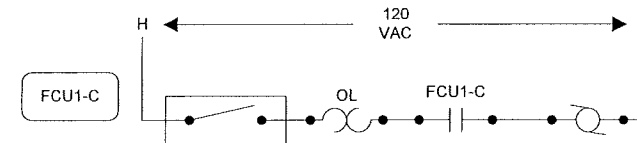

DX COOLING WIRING

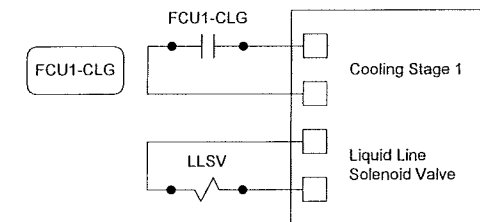

FAN COIL UNIT:



The fan will run continuously during occupied times. When the unit is running, on a call for cool, the DX coil will be cycled on to maintain zone temperature set point. During unoccupied times, when the unit is running, both the valves will be closed.

REVISION INFORMATION	Drawing Title								
NUMBER	ROOM SCHEDULE DETAILS								
DATE	04/17/08	NO.	1	RECORD DRAWINGS		ECN	03/30/08	WCS	
TIME	08:04 AM	SALES ENGINEER	GLA	PROJECT MANAGER	SEL	APPLICATION ENGINEER	RJM	DRAWN BY DATE	
FILE NAME	Rsdetmn.vsd	Project Title		Branch Information		CONTRACT NUMBER			
		DANE COUNTY COURTHOUSE 215 SOUTH HAMILTON ST. MADISON, WI 53703		Madison Branch 2400 Kilgust Road Madison WI 53713 Phone: 608-222-9100 Fax: 608-222-9490		0 3109-0044		DRAWING NUMBER 13.16	
		JOHNSON CONTROLS Systems & Services Division							

DETAIL A
TYPICAL OF 1

BILL OF MATERIALS

Designation	Qty	Part Number	Description
Panel Devices:			
P-10	1	PADPE	PANEL ASSY, DX MOUNTED IN 24X24 ENCL
TAG-1	1	NAMETAG-CUSTOM	1"X3" TAG, 3-LINES MAX, CUSTOM PNL FACE
XP-1	1	XP-9104-8304	CNTRLR,DIG,DX EXPN MOD,4B1,4B0,2/XT
XT-12	1	XT-9100-8304	CNTRLR,DIG,DX EXTENSION MODULE,8/DX

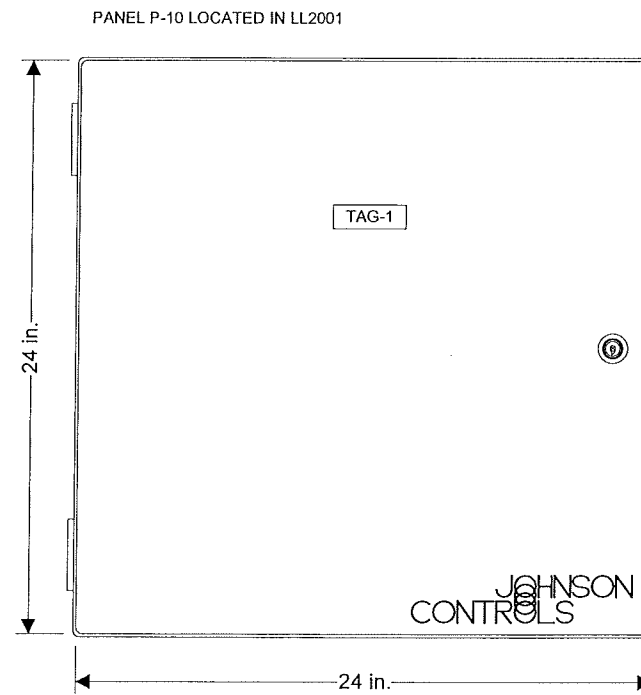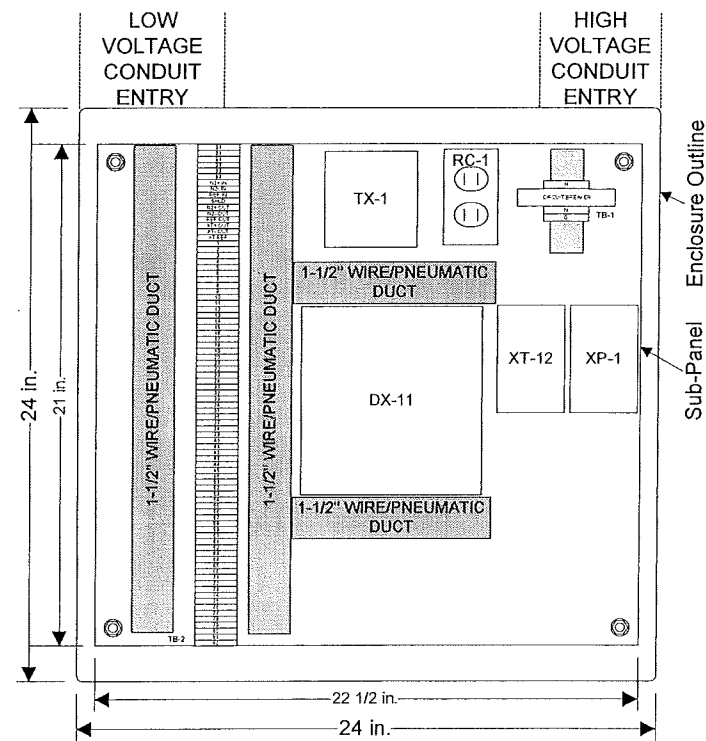


PANEL FACE TAGS:
TAG-1: PANEL P-10
MISC. EXHAUST FAN CONTROL
JCI 0 3109-0044

EXHAUST FANS CONTROL PANEL




REVISION INFORMATION	Drawing Title								
NUMBER	MISCELLANEOUS DETAILS								
DATE	04/17/08	NO.	1	REVISION-LOCATION	RECORD DRAWINGS	ECN	03/30/08	DATE	WCS
TIME	08:03 AM	SALES ENGINEER	GLA	PROJECT MANAGER	SEL	APPLICATION ENGINEER	RJM	DATE	
FILE NAME	msdeta.vsd	Project Title				Branch Information		CONTRACT NUMBER	
		DANE COUNTY COURTHOUSE 215 SOUTH HAMILTON ST. MADISON, WI 53703				 Systems & Services Division Madison Branch 2400 Kilgust Road Madison WI 53713 Phone: 608-222-9100 Fax: 608-222-9490		0 3109-0044 DRAWING NUMBER 14.1	

DETAIL A (CONT.)
TYPICAL OF 1

LINE VOLTAGE WIRING DIAGRAM

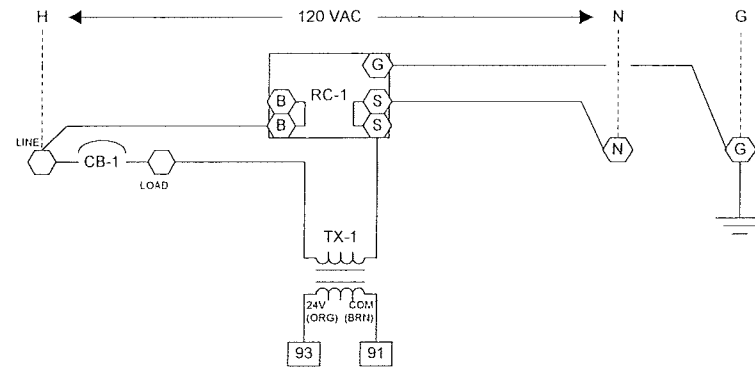

LOW VOLTAGE WIRING DIAGRAM

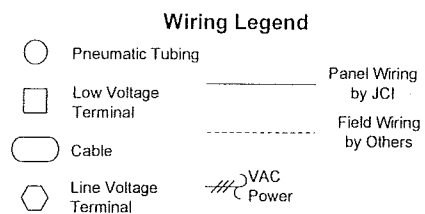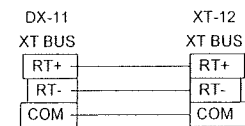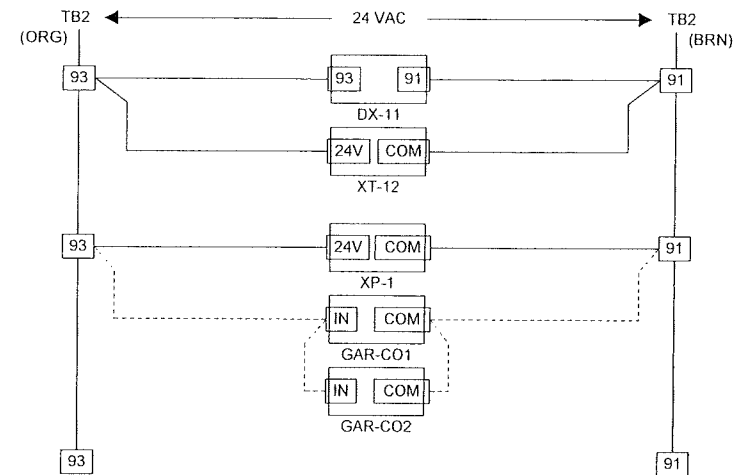


EXHAUST FANS CONTROL PANEL WIRING


REVISION INFORMATION		Drawing Title									
NUMBER		MISCELLANEOUS DETAILS									
DATE		04/17/08		1		RECORD DRAWINGS		03/30/08		WCS	
TIME		08:03 AM		REFERENCE DRAWING		REVISION LOCATION		ECH		DATE	
FILE NAME		msdetapw.vsd		Sales Engineer		Project Manager		Application Engineer		DRAWN	
				GLA		SEL		RJM		APPROVED	
Project Title		DANE COUNTY COURTHOUSE 215 SOUTH HAMILTON ST. MADISON, WI 53703		BY		DATE		BY		DATE	
Branch Information		Madison Branch 2400 Kilgust Road Madison WI 53713 Phone: 608-222-9100 Fax: 608-222-9490		CONTRACT NUMBER		0 3109-0044		DRAWING NUMBER		14.2	

**JOHNSON
CONTROLS**
Systems & Services Division


DETAIL D501 24 VAC BINARY OUTPUT
(Switch High)

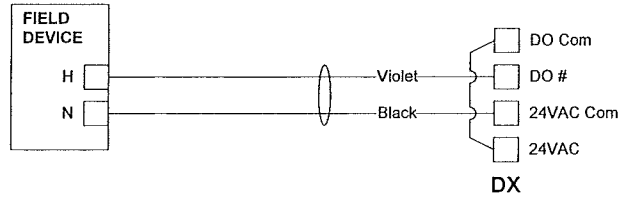

DETAIL XP301 BINARY INPUT (DRY CONTACT)

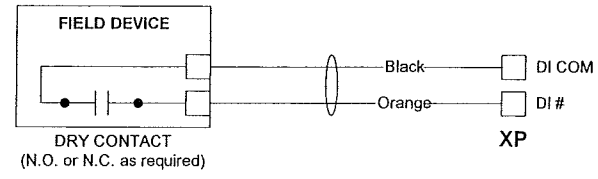

DETAIL XP501 24 VAC BINARY OUTPUT
(Switch High)

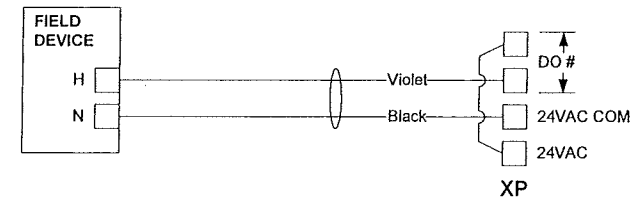


REVISION INFORMATION	Drawing Title								
NUMBER	POINT SCHEDULE								
DATE	04/17/08		1	RECORD DRAWINGS			03/30/08	WCS	
TIME	08:02 AM	Project Title							
FILE NAME	msdetaps2.vsd	DANE COUNTY COURTHOUSE 215 SOUTH HAMILTON ST. MADISON, WI 53703							
			GLA	SEL	RJM	BY	DATE	BY	DATE
			JOHNSON CONTROLS		Branch Information		CONTRACT NUMBER		
			Systems & Services Division		Appleton Branch 2140 American Drive Neenah WI 54956 Phone: 920-739-2461 Fax: 920-739-4782		0 3109-0044		
							DRAWING NUMBER		14.5


DETAIL B
TYPICAL OF 1

BILL OF MATERIALS

Designation	Qty	Part Number	Description
Panel Devices:			
P-11, RC-1	1	EN-EWC12-0	UNIV PKG MOD,SING,PWR BOX
TAG-1	1	NAMETAG-CUSTOM	1"X3" TAG, 3-LINES MAX, CUSTOM PNL FACE
TB-1	2	PD-113-44	END CLAMP, WIELAND Z5.522.8553.0
	4	PD-113-52	TERM BLK,6-SQ-MM WIRE SLOT,WIELAND
	1	PD-113-53	END PLATE F/113-52 TERM BLK,WIELAND
TX-x	2	PD-114-02	XFMR,120/24VAC,96VA

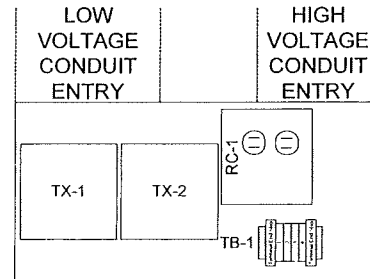

PANEL P-11 LOCATED IN LL2032

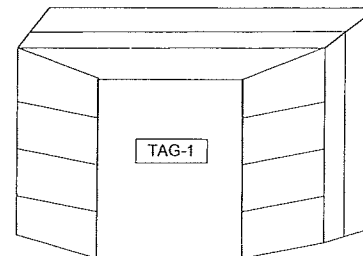

PANEL FACE TAGS:
TAG-1: PANEL P-11
LOWER LEVEL 2 VMA TX PANEL
JCI 0 3109-0044


LOWER LEVEL 2 VMA TRANSFORMER PANEL

REVISION INFORMATION	Drawing Title								
NUMBER	MISCELLANEOUS DETAILS								
DATE	04/17/08		1	RECORD DRAWINGS		03/30/08	WCS		
TIME	08:02 AM	Project Title	DANE COUNTY COURTHOUSE 215 SOUTH HAMILTON ST. MADISON, WI 53703		Branch Information		Madison Branch 2400 Kilgust Road Madison WI 53713 Phone: 608-222-9100 Fax: 608-222-9490		
FILE NAME	msdetb.vsd	JOHNSON CONTROLS Systems & Services Division		CONTRACT NUMBER		0 3109-0044			
						DRAWING NUMBER			
						14.6			


DETAIL C
TYPICAL OF 1

BILL OF MATERIALS

Designation	Qty	Part Number	Description
Panel Devices:			
P-12	1	PAN-ENC2024WDP	PANEL, HOFFMAN 20X24X9 PERF-SUB W/ DOOR
RC-1	1	PD-117-02	RECEPTACLE DUPLEX IVORY
	1	PD-121-01	BOX COVER RECPT,EAGLE 2510
	1	PD-121-14	HANDY BOX, 2-1/8IN DEEP
TAG-1	1	NAMETAG-CUSTOM	1"X3" TAG, 3-LINES MAX, CUSTOM PNL FACE
TB-1	2	PD-113-44	END CLAMP, WIELAND Z5.522.8553.0
	8	PD-113-52	TERM BLK,6-SQ-MM WIRE SLOT,WIELAND
	1	PD-113-53	END PLATE F/113-52 TERM BLK,WIELAND
TB-PWR	1	PD-112-09	CIRCUIT BREAKER,10A,SQ-D QOU-110
	2	PD-113-44	END CLAMP, WIELAND Z5.522.8553.0
	2	PD-113-52	TERM BLK,6-SQ-MM WIRE SLOT,WIELAND
	1	PD-113-53	END PLATE F/113-52 TERM BLK,WIELAND
TX-x	4	PD-114-02	XFMR,120/24VAC,96VA

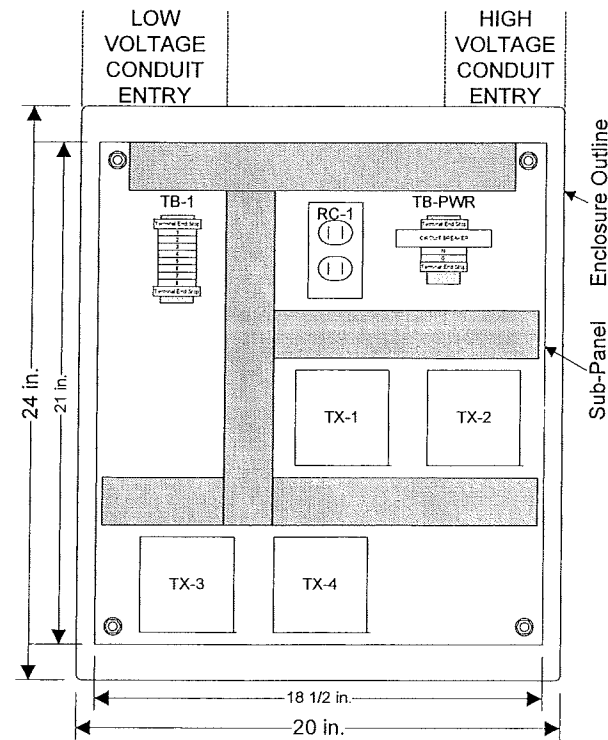

PANEL P-12 LOCATED IN LL1016

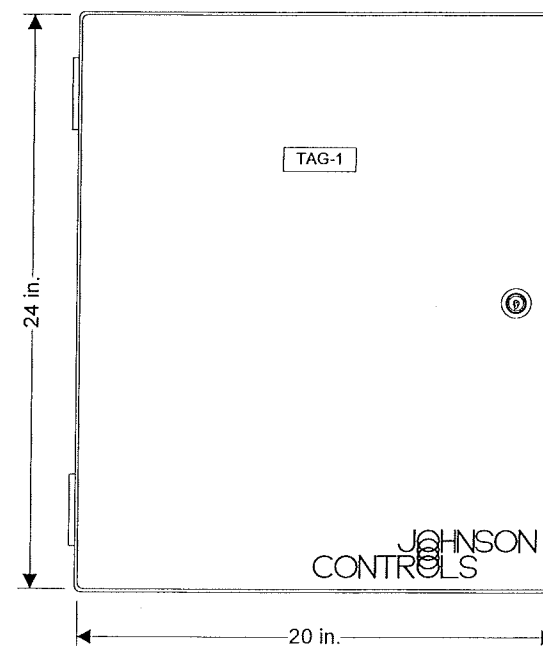

PANEL FACE TAGS:
TAG-1: PANEL P-12
LOWER LEVEL 1 VMA TX PANEL
JCI 0 3109-0044



LOWER LEVEL 1 VMA TRANSFORMER PANEL

REVISION INFORMATION	Drawing Title										
NUMBER	MISCELLANEOUS DETAILS										
DATE	03/31/08		NO. 1		RECORD DRAWINGS		ECH 03/30/08		BY WCS		
TIME	10:55 PM		SALES ENGINEER		PROJECT MANAGER		APPLICATION ENGINEER		DRAWN		
FILE NAME	msdetc.vsd		GLA		SEL		RJM		BY DATE		
Project Title			Branch Information			CONTRACT NUMBER			DRAWING NUMBER		
DANE COUNTY COURTHOUSE 215 SOUTH HAMILTON ST. MADISON, WI 53703			 Systems & Services Division			Madison Branch 2400 Kilgust Road Madison WI 53713 Phone: 608-222-9100 Fax: 608-222-9490			0 3109-0044		
									14.8		

BILL OF MATERIALS

Designation	Qty	Part Number	Description
Panel Devices:			
P-13	1	PAN-ENC2424WDP	PANEL, HOFFMAN 24X24X9 PERF-SUB W/ DOOR
RC-1	1	PD-117-02	RECEPTACLE DUPLEX IVORY
	1	PD-121-01	BOX COVER RECPT.EAGLE 2510
	1	PD-121-14	HANDY BOX, 2-1/8IN DEEP
TAG-1	1	NAMETAG-CUSTOM	1"X3" TAG, 3-LINES MAX, CUSTOM PNL FACE
TB-1	2	PD-113-44	END CLAMP, WIELAND Z5.522.8553.0
	12	PD-113-52	TERM BLK.6-SQ-MM WIRE SLOT,WIELAND
	1	PD-113-53	END PLATE F/113-52 TERM BLK,WIELAND
	1	PD-112-09	CIRCUIT BREAKER,10A,SQ-D QOU-110
TB-PWR	2	PD-113-44	END CLAMP, WIELAND Z5.522.8553.0
	2	PD-113-52	TERM BLK.6-SQ-MM WIRE SLOT,WIELAND
	1	PD-113-53	END PLATE F/113-52 TERM BLK,WIELAND
	1	PD-114-02	XFMR,120/24VAC,96VA
TX-x	6	PD-114-02	XFMR,120/24VAC,96VA

DETAIL D
TYPICAL OF 1

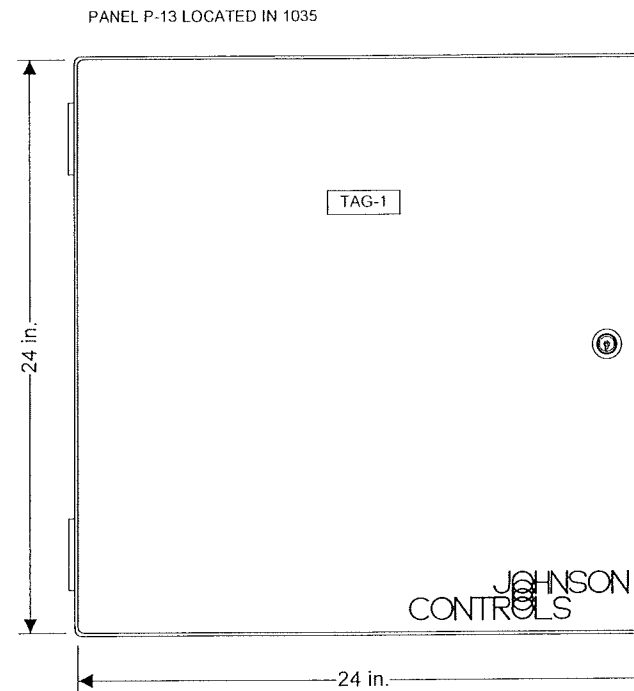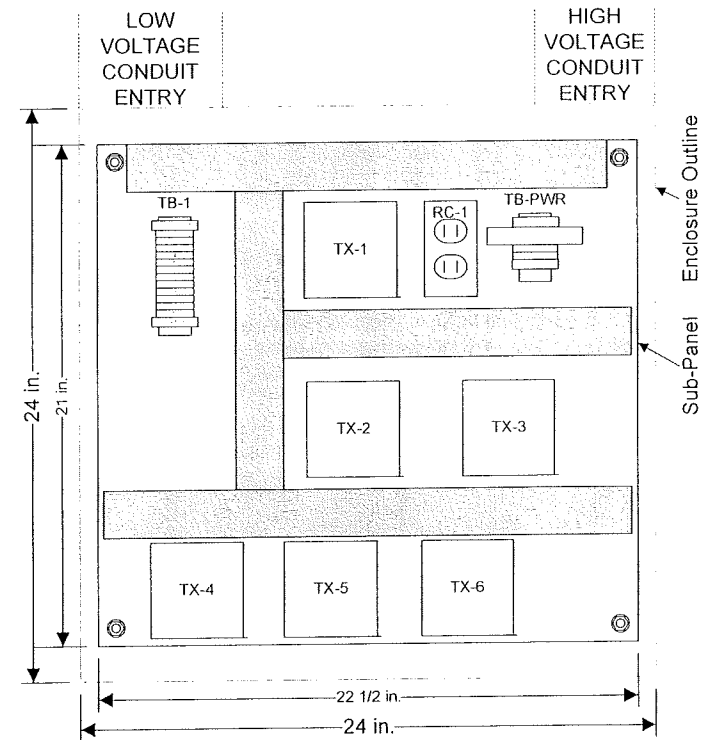

PANEL FACE TAGS:
TAG-1: PANEL P-13
1ST FLOOR VMA TX PANEL
JCI 0 3109-0044


1ST FLOOR VMA TRANSFORMER PANEL

REVISION INFORMATION	Drawing Title				
NUMBER	MISCELLANEOUS DETAILS	1	RECORD DRAWINGS	03/30/08	WCS
DATE	04/16/08	SALES ENGINEER	PROJECT MANAGER	APPLICATION ENGINEER	
TIME	01:47 PM	GLA	SEL	RJM	
FILE NAME	msdetd.vsd	Project Title		Branch Information	
		DANE COUNTY COURTHOUSE 215 SOUTH HAMILTON ST. MADISON, WI 53703		Madison Branch 2400 Kilgust Road Madison WI 53713 Phone: 608-222-9100 Fax: 608-222-9490	
		CONTRACT NUMBER		DRAWING NUMBER	
		0 3109-0044		14.10	


DETAIL E
TYPICAL OF 1

BILL OF MATERIALS

Designation	Qty	Part Number	Description
Panel Devices:			
F-1	1	4WT40	DAYTON-3-1/8" SQUARE AXIAL FAN-GRAINGER
	1	4YD96	AYTON-3-1/8" WIRE FAN GUARD-GRAINGER
P-14	1	PAN-ENC2436WDP	PANEL, HOFFMAN 24X36X9 PERF-SUB W/ DOOR
RC-1	1	PD-117-02	RECEPTACLE DUPLEX IVORY
	1	PD-121-01	BOX COVER RECPT,EAGLE 2510
	1	PD-121-14	HANDY BOX, 2-1/8IN DEEP
TAG-1	1	NAMETAG-CUSTOM	1"X3" TAG, 3-LINES MAX, CUSTOM PNL FACE
TB-1	2	PD-113-44	END CLAMP, WIELAND Z5.522.8553.0
	24	PD-113-52	TERM BLK,6-SQ-MM WIRE SLOT,WIELAND
	1	PD-113-53	END PLATE F/113-52 TERM BLK,WIELAND
TB-PWR	2	PD-112-09	CIRCUIT BREAKER,10A,SQ-D QOU-110
	2	PD-113-44	END CLAMP, WIELAND Z5.522.8553.0
	2	PD-113-52	TERM BLK,6-SQ-MM WIRE SLOT,WIELAND
	1	PD-113-53	END PLATE F/113-52 TERM BLK,WIELAND
TX-x	12	PD-114-02	XFMR,120/24VAC,96VA

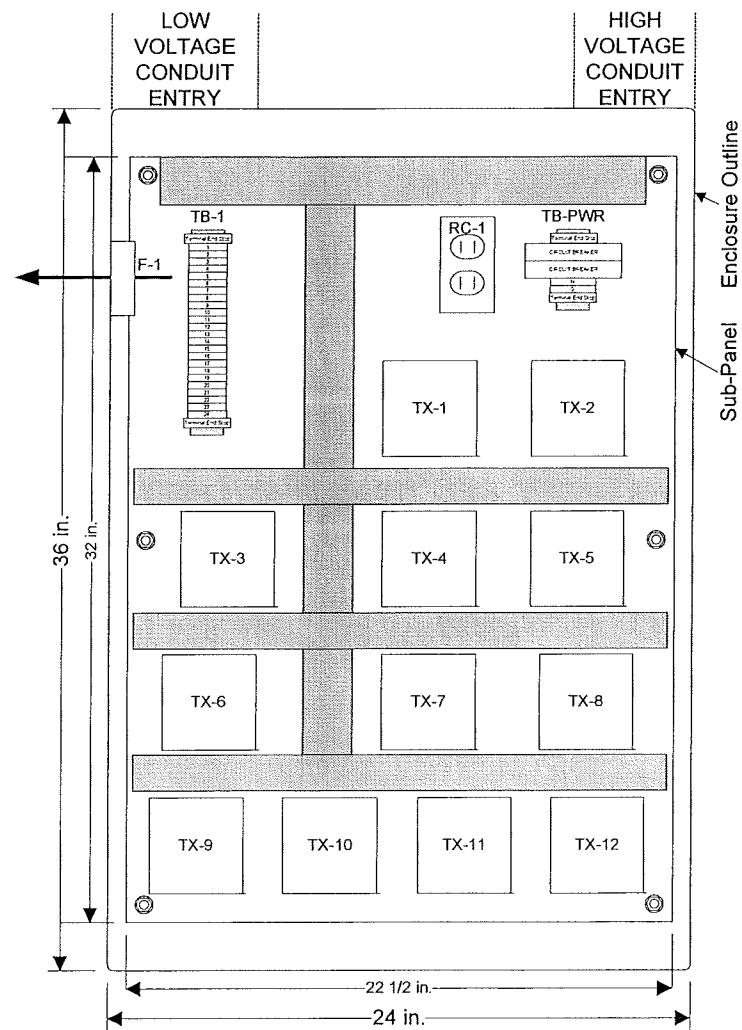

PANEL P-14 LOCATED IN 2052

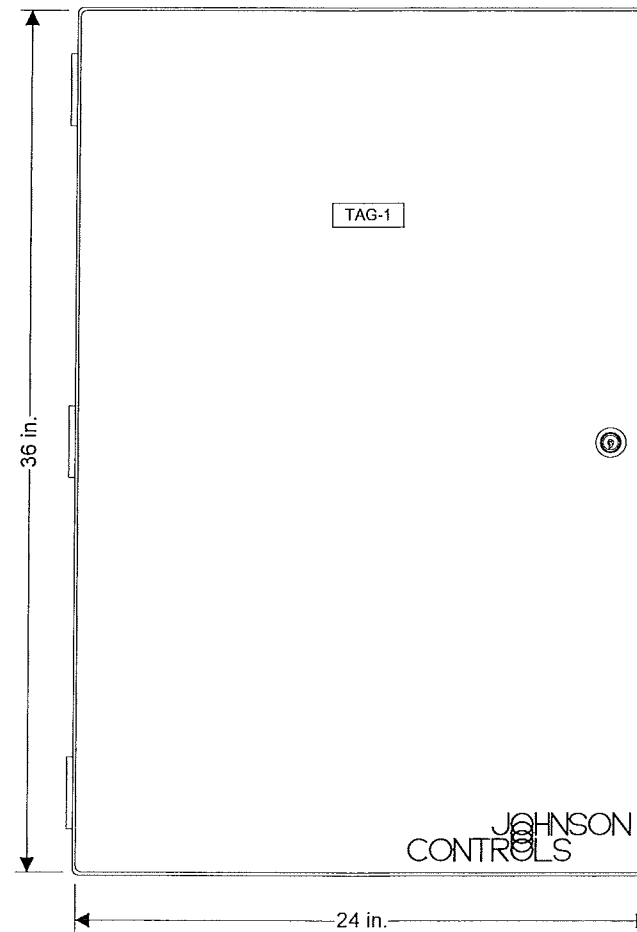


PANEL FACE TAGS:
TAG-1: PANEL P-14
2ND FLOOR VMA TX PANEL
JCI 0 3109-0044

2ND FLOOR VMA TRANSFORMER PANEL


REVISION INFORMATION	Drawing Title										
NUMBER	MISCELLANEOUS DETAILS		1		RECORD DRAWINGS		03/30/08		WCS		
DATE	03/31/08		NO.		REVISION-LOCATION		ECN		DATE		
TIME	11:04 PM		Project Manager		Application Engineer		BY		DATE		
FILE NAME	msdete.vsd		GLA		SEL		RJM		BY		
Project Title			Branch Information			CONTRACT NUMBER					
DANE COUNTY COURTHOUSE 215 SOUTH HAMILTON ST. MADISON, WI 53703			 Systems & Services Division			Madison Branch 2400 Kilgust Road Madison WI 53713 Phone: 608-222-9100 Fax: 608-222-9490			0 3109-0044 DRAWING NUMBER 14.12		

DETAIL E (CONT.)
TYPICAL OF 1


LINE VOLTAGE WIRING DIAGRAM

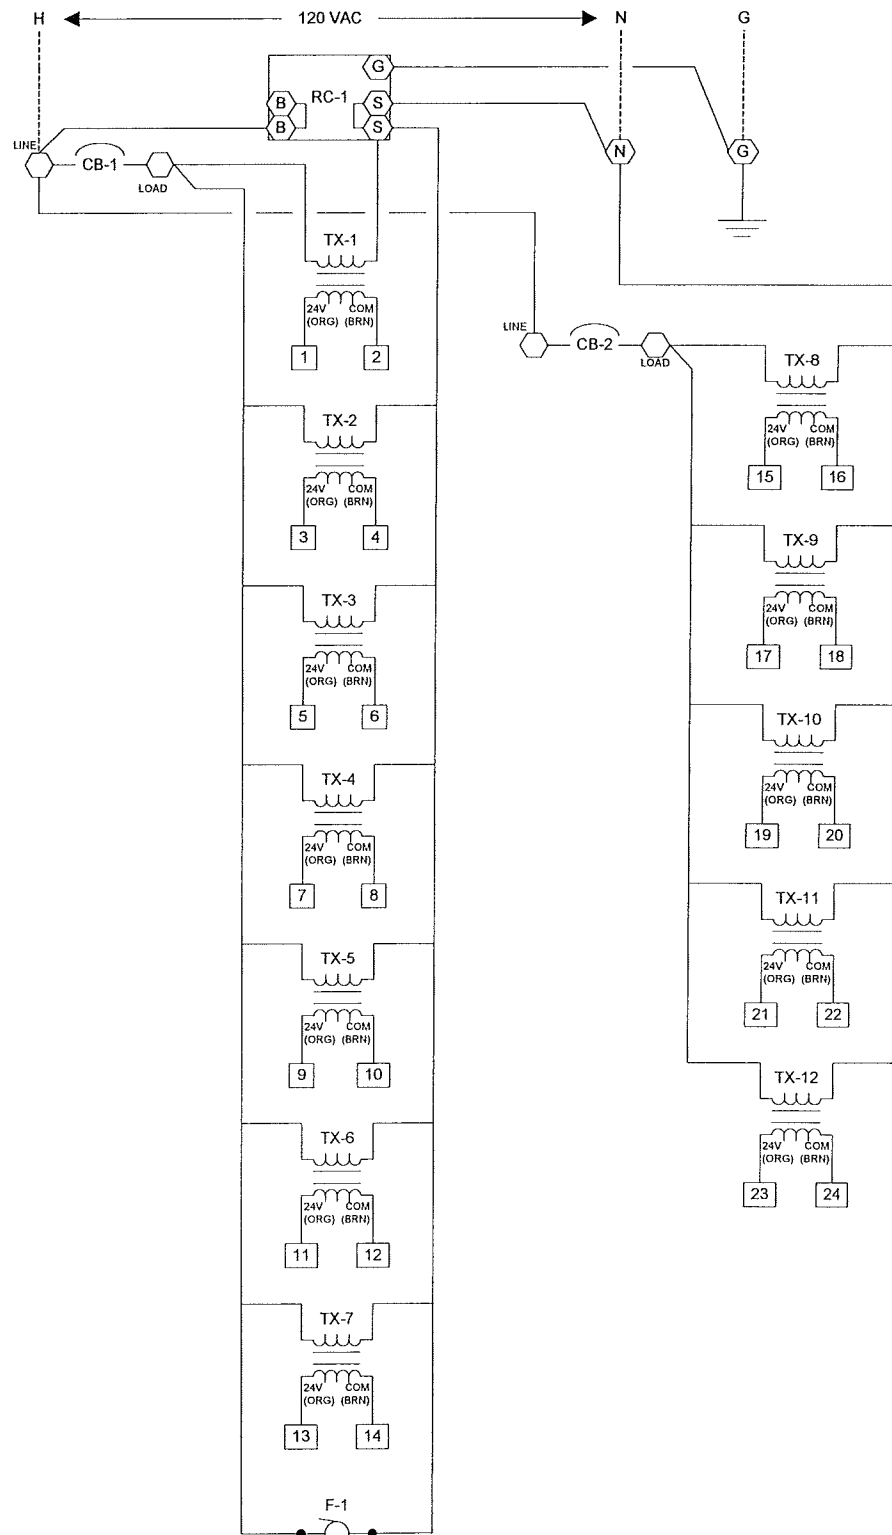

LOW VOLTAGE WIRING DIAGRAM

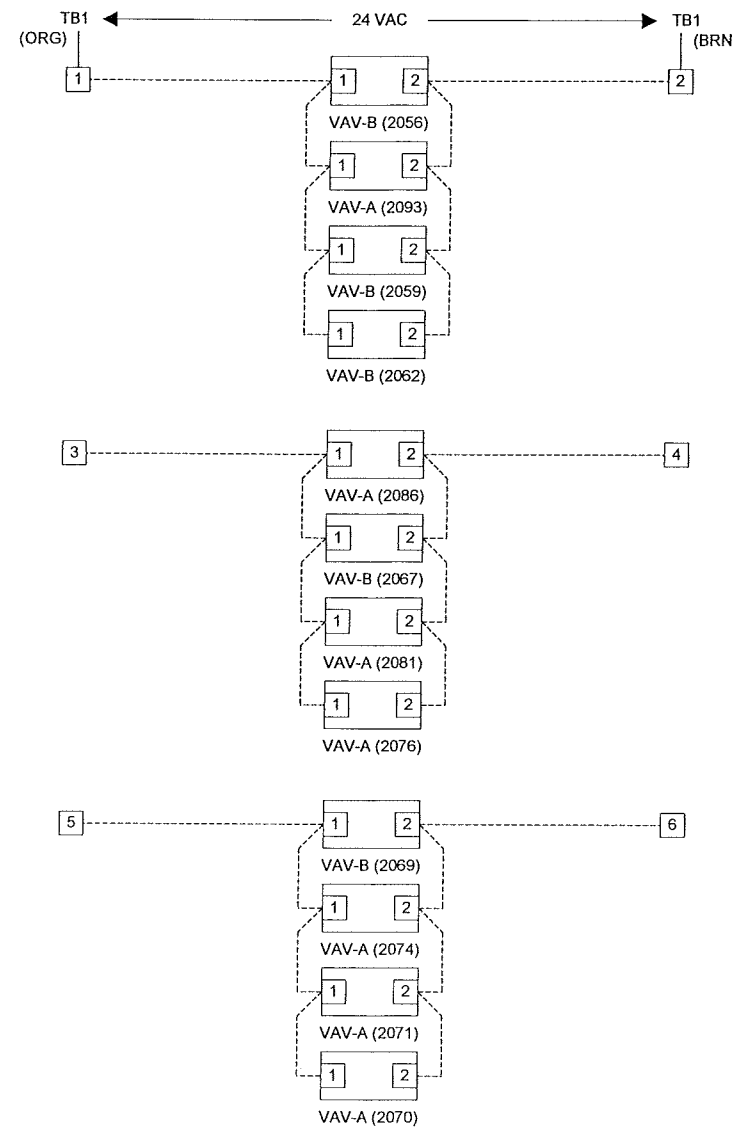

LOW VOLTAGE WIRING DIAGRAM

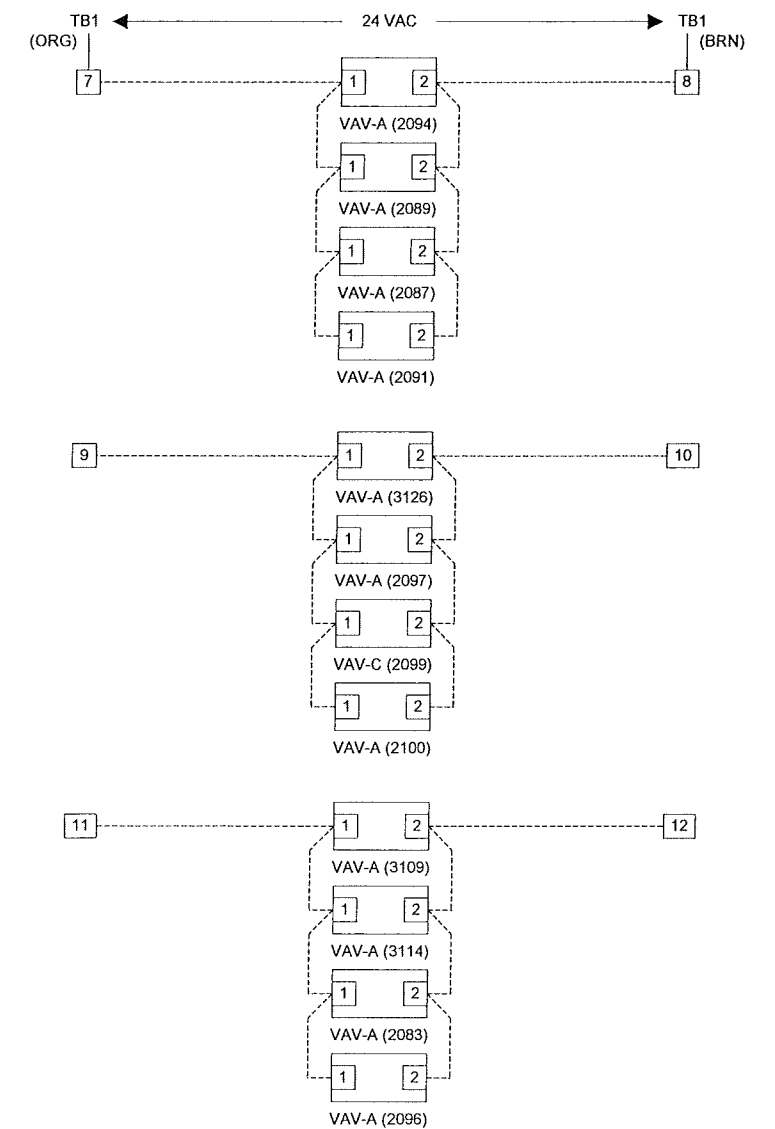


Wiring Legend

- Pneumatic Tubing
- Low Voltage Terminal
- Cable
- Line Voltage Terminal
- Panel Wiring by JCI
- - - Field Wiring by Others
- ⚡ VAC Power


2ND FLOOR VMA TRANSFORMER PANEL WIRING

REVISION INFORMATION		Drawing Title									
NUMBER		MISCELLANEOUS DETAILS		1		RECORD DRAWINGS		03/30/08		WCS	
DATE		04/16/08		NO.		REVISION-LOCATION		ECH		DATE	
TIME		01:46 PM		SALES ENGINEER		PROJECT MANAGER		APPLICATION ENGINEER		DRAWN	
FILE NAME		msdetepw1.vsd		GLA		SEL		RJM		BY	
Project Title		DANE COUNTY COURTHOUSE 215 SOUTH HAMILTON ST. MADISON, WI 53703		Branch Information		Madison Branch 2400 Kilgust Road Madison WI 53713 Phone: 608-222-9100 Fax: 608-222-9490		CONTRACT NUMBER		0 3109-0044	
				Systems & Services Division				DRAWING NUMBER		14.13	

DETAIL F TYPICAL OF 1

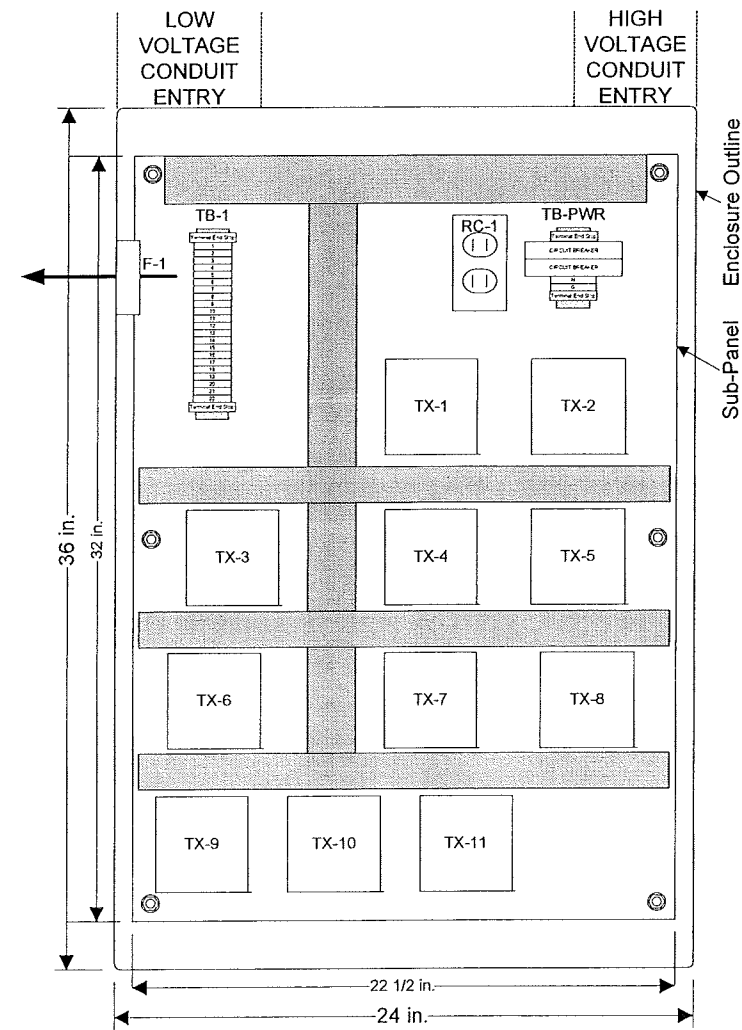

PANEL P-15 LOCATED IN 3096

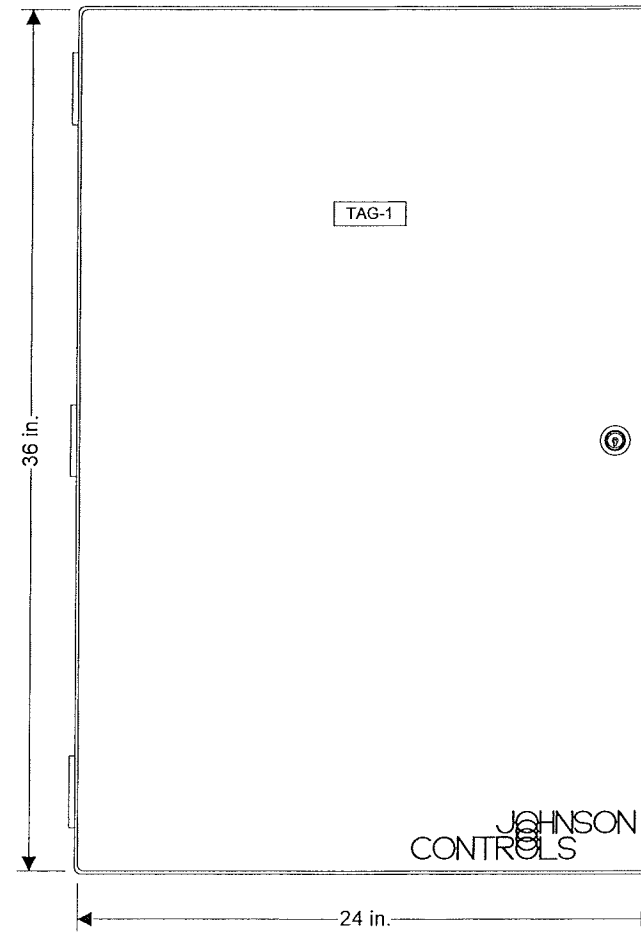

PANEL FACE TAGS:
TAG-1: PANEL P-15
3RD FLOOR VMA TX PANEL
JCI 0 3109-0044

BILL OF MATERIALS

Designation	Qty	Part Number	Description
Panel Devices:			
F-1	1	4WT40	DAYTON-3-1/8" SQUARE AXIAL FAN-GRAINGER
	1	4YD96	AYTON-3-1/8" WIRE FAN GUARD-GRAINGER
P-15	1	PAN-ENC2436WDP	PANEL, HOFFMAN 24X36X9 PERF-SUB W DOOR
RC-1	1	PD-117-02	RECEPTACLE DUPLEX IVORY
	1	PD-121-01	BOX COVER RECPT,EAGLE 2510
	1	PD-121-14	HANDY BOX, 2-1/8IN DEEP
TAG-1	1	NAMETAG-CUSTOM	1"X3" TAG, 3-LINES MAX, CUSTOM PNL FACE
TB-1	2	PD-113-44	END CLAMP, WIELAND Z5.522.8553.0
	22	PD-113-52	TERM BLK,6-SQ-MM WIRE SLOT,WIELAND
	1	PD-113-53	END PLATE F/113-52 TERM BLK,WIELAND
TB-PWR	2	PD-112-09	CIRCUIT BREAKER,10A,SQ-D QOU-110
	2	PD-113-44	END CLAMP, WIELAND Z5.522.8553.0
	2	PD-113-52	TERM BLK,6-SQ-MM WIRE SLOT,WIELAND
	1	PD-113-53	END PLATE F/113-52 TERM BLK,WIELAND
TX-x	11	PD-114-02	XFMR,120/24VAC,96VA


3RD FLOOR VMA TRANSFORMER PANEL

REVISION INFORMATION	Drawing Title							
NUMBER	MISCELLANEOUS DETAILS		1		RECORD DRAWINGS		03/30/08 WCS	
DATE	04/16/08		NO.		REVISION-LOCATION		ECN DATE BY	
TIME	01:44 PM		Sales Engineer		DRAWN		APPROVED	
FILE NAME	msdef.vsd		Project Manager		BY DATE		BY DATE	
			Application Engineer		CONTRACT NUMBER		DRAWING NUMBER	
	Project Title		RJM		0 3109-0044		14.15	
	DANE COUNTY COURTHOUSE 215 SOUTH HAMILTON ST. MADISON, WI 53703		JOHNSON CONTROLS Systems & Services Division		Madison Branch 2400 Kilgust Road Madison WI 53713 Phone: 608-222-9100 Fax: 608-222-9490			


DETAIL F (CONT.)

TYPICAL OF 1


LINE VOLTAGE WIRING DIAGRAM

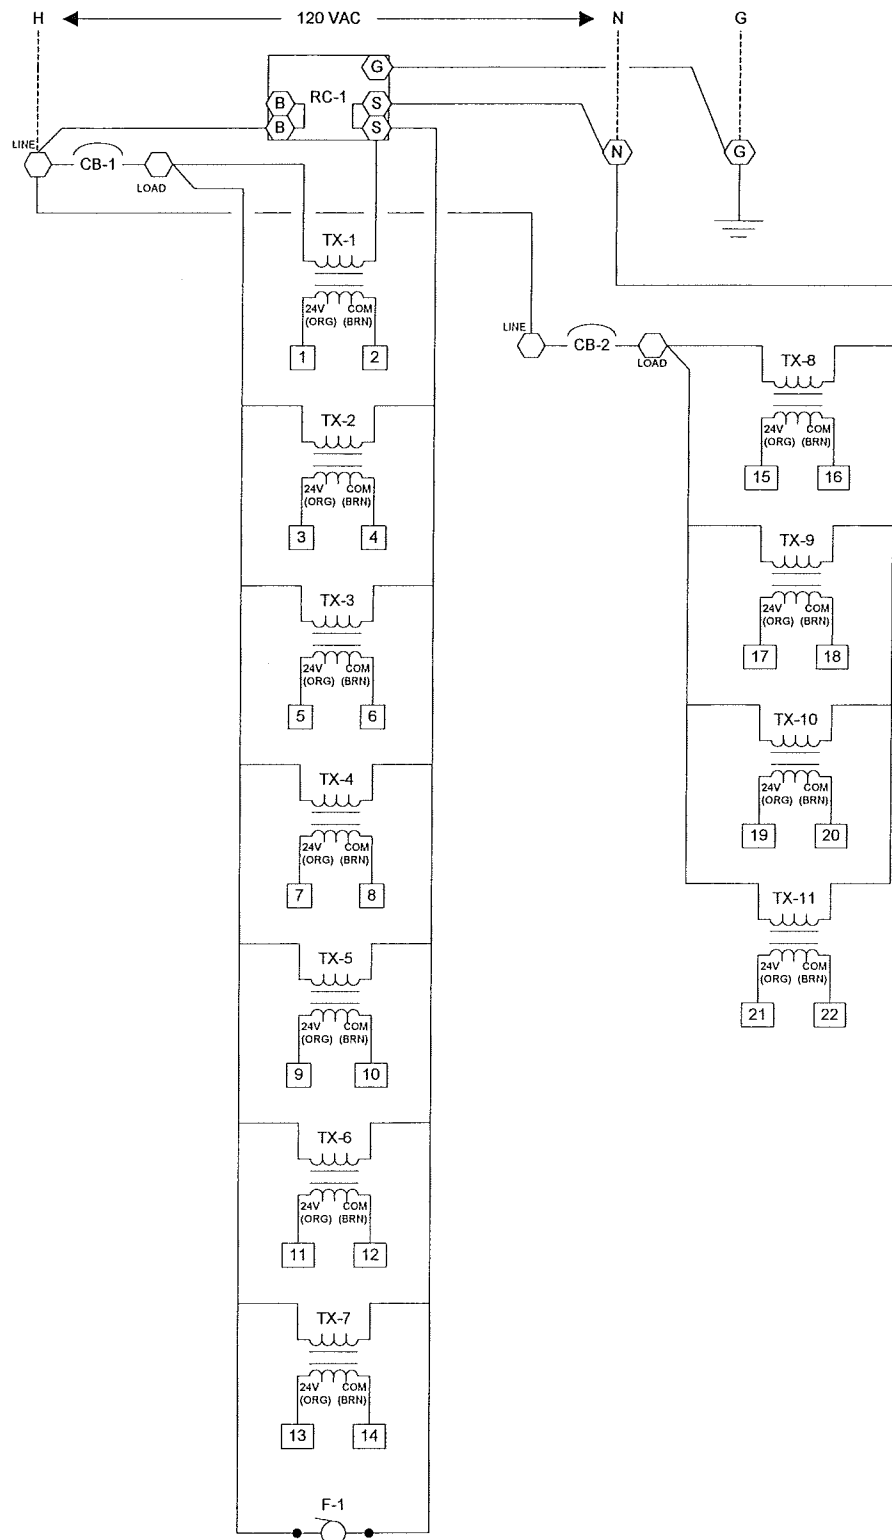

LOW VOLTAGE WIRING DIAGRAM

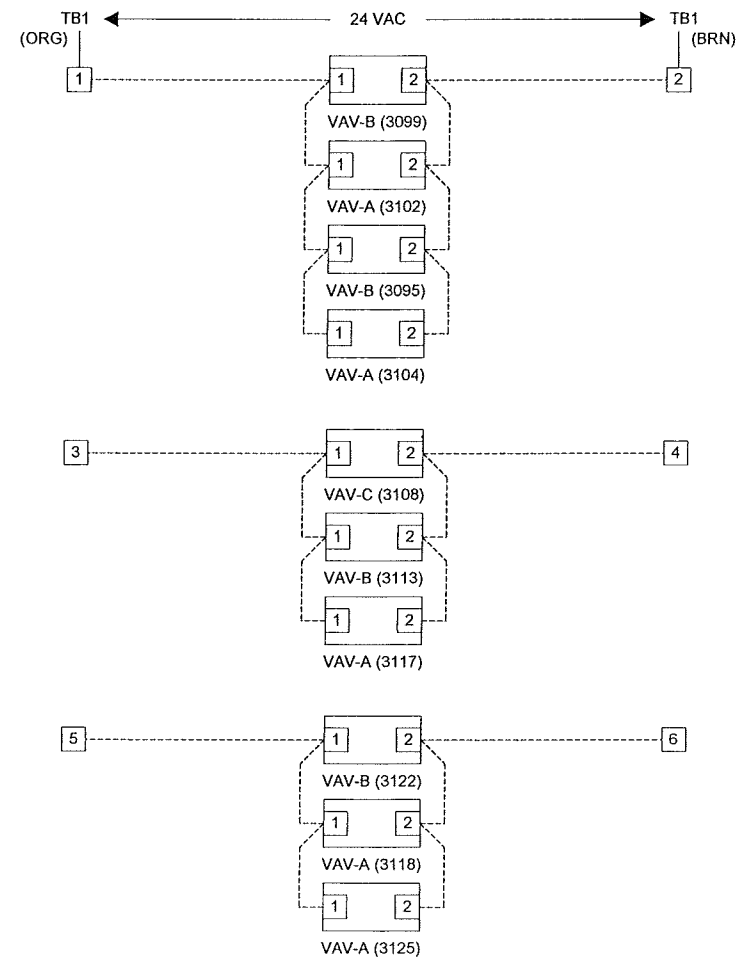

LOW VOLTAGE WIRING DIAGRAM

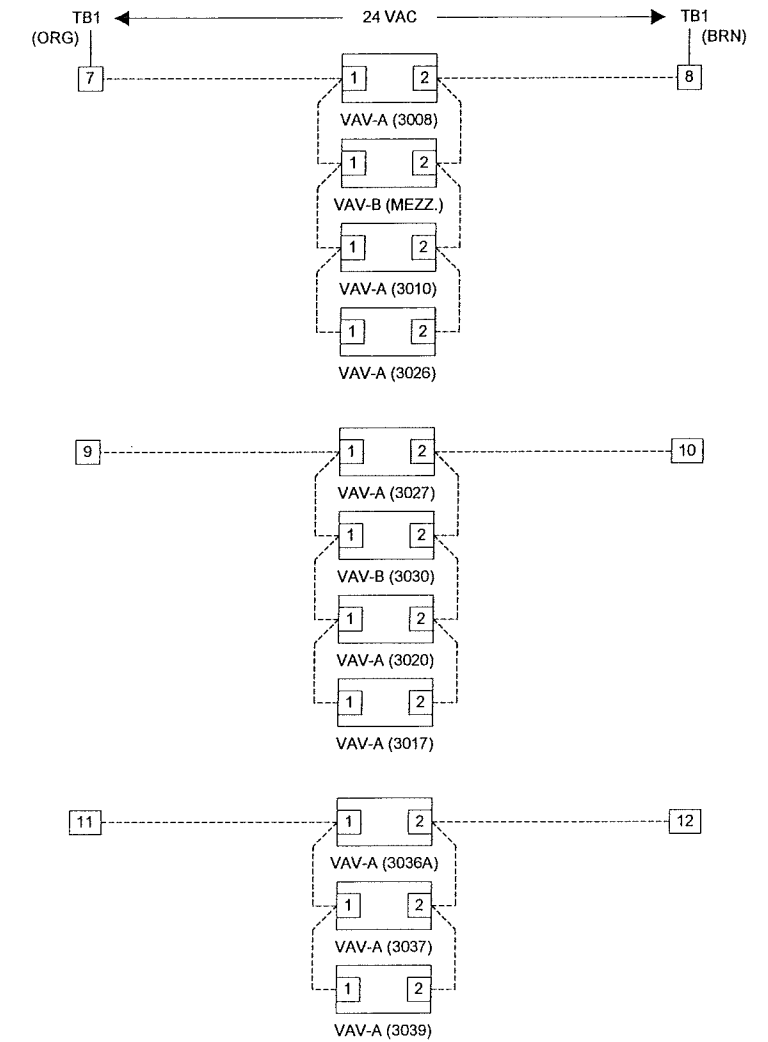

Wiring Legend


- Pneumatic Tubing
- Low Voltage Terminal
- Cable
- Line Voltage Terminal
- VAC Power
- Panel Wiring by JCI
- Field Wiring by Others

3RD FLOOR VMA TRANSFORMER PANEL WIRING


REVISION INFORMATION		Drawing Title									
NUMBER		MISCELLANEOUS DETAILS		1		RECORD DRAWINGS		03/30/08		WCS	
DATE		04/16/08		Sales Engineer		Project Manager		Application Engineer		DRAWN	
TIME		01:44 PM		GLA		SEL		RJM		BY DATE	
FILE NAME		msdelfpw1.vsd		Project Title		Branch Information		CONTRACT NUMBER		DRAWING NUMBER	
		DANE COUNTY COURTHOUSE 215 SOUTH HAMILTON ST. MADISON, WI 53703		JOHNSON CONTROLS Systems & Services Division		Madison Branch 2400 Kilgust Road Madison WI 53713 Phone: 608-222-9100 Fax: 608-222-9490		0 3109-0044		14.16	

DETAIL F (CONT.)
TYPICAL OF 1

LOW VOLTAGE WIRING DIAGRAM

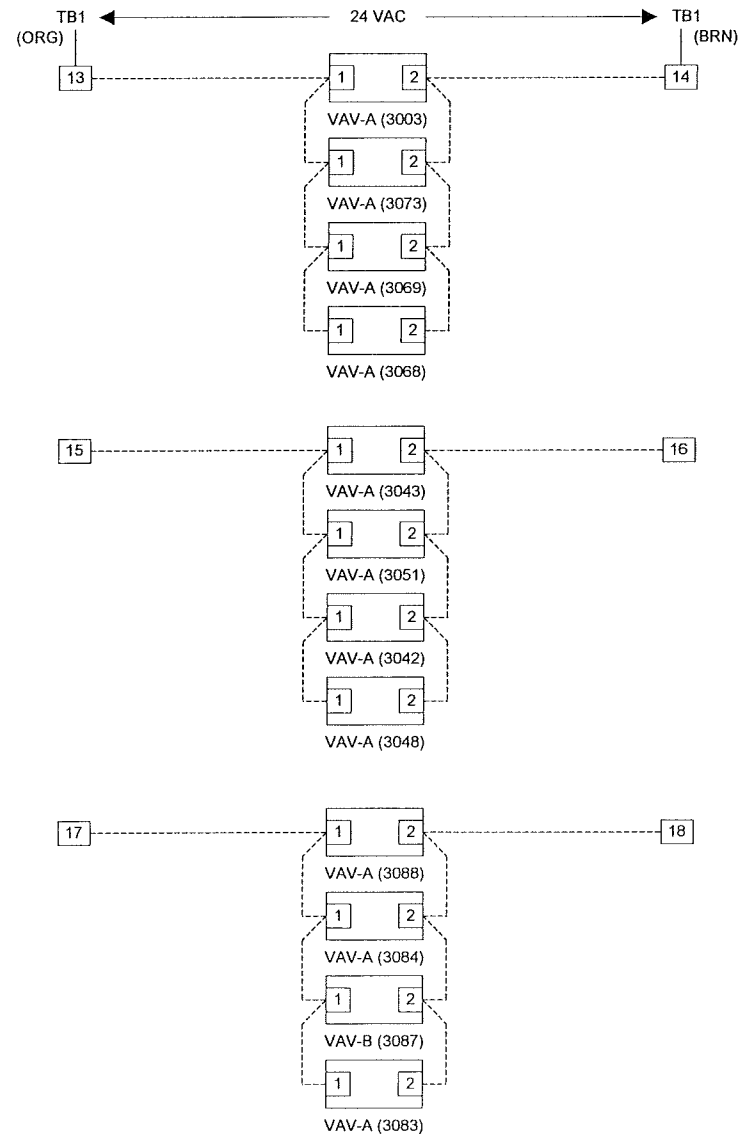

LOW VOLTAGE WIRING DIAGRAM

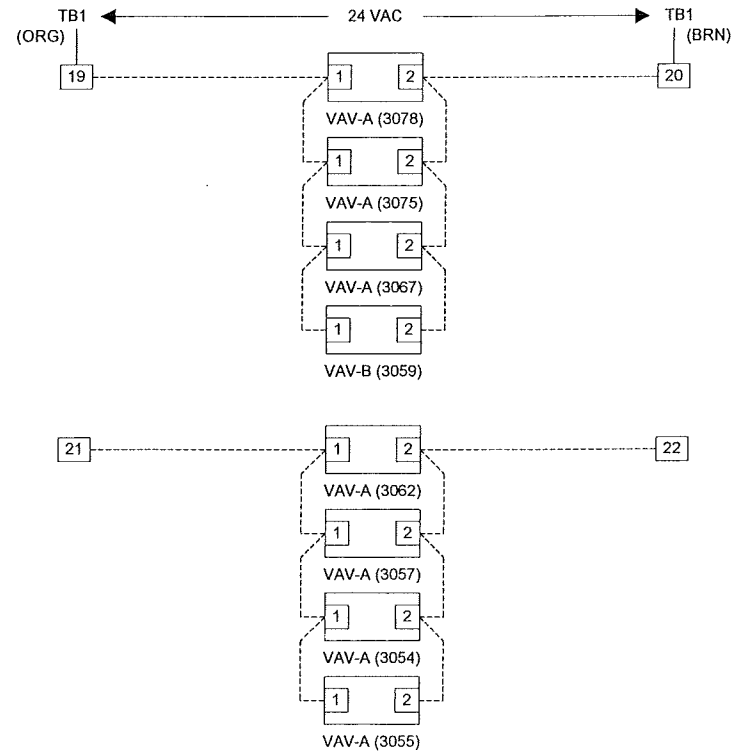

Wiring Legend

- Pneumatic Tubing
- Low Voltage Terminal
- Cable
- ⬢ Line Voltage Terminal
- Panel Wiring by JCI
- - - Field Wiring by Others
- ⚡ VAC Power



3RD FLOOR VMA TRANSFORMER PANEL WIRING

REVISION INFORMATION		Drawing Title									
NUMBER		MISCELLANEOUS DETAILS		1		RECORD DRAWINGS		03/30/08		WCS	
DATE		04/16/08		TIME		01:43 PM		FILE NAME		Msdetfpw2.vsd	
Project Title		DANE COUNTY COURTHOUSE 215 SOUTH HAMILTON ST. MADISON, WI 53703		Sales Engineer		Project Manager		Application Engineer		Branch Information	
GLA		SEL		RJM		BY		DATE		CONTRACT NUMBER	
										0 3109-0044	
										DRAWING NUMBER	
										14.17	

**JOHNSON
CONTROLS**
Systems & Services Division

Madison Branch
2400 Kilgust Road
Madison
WI 53713
Phone: 608-222-9100
Fax: 608-222-9490

DETAIL G
TYPICAL OF 1

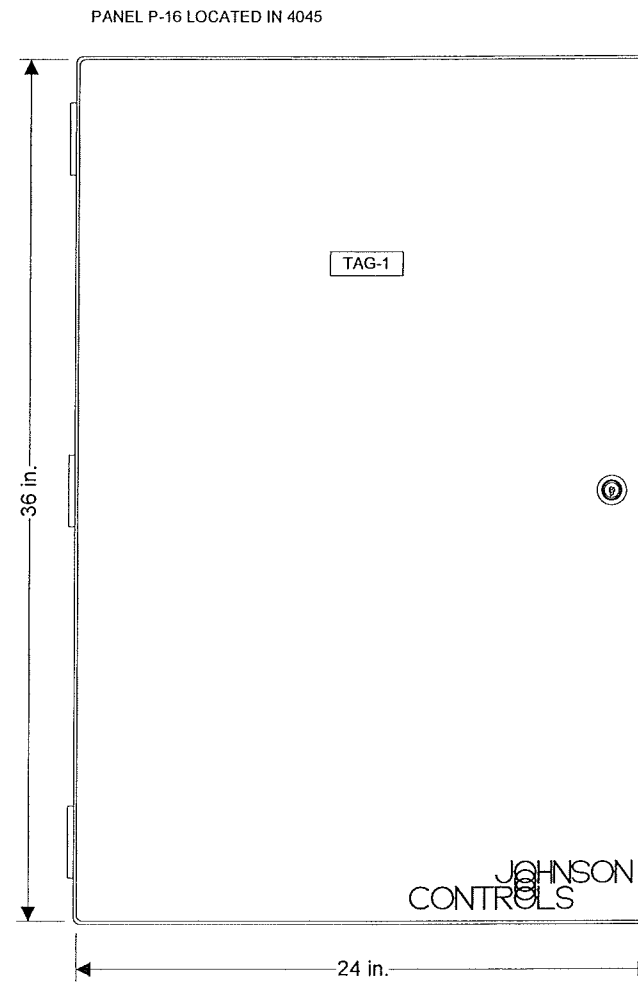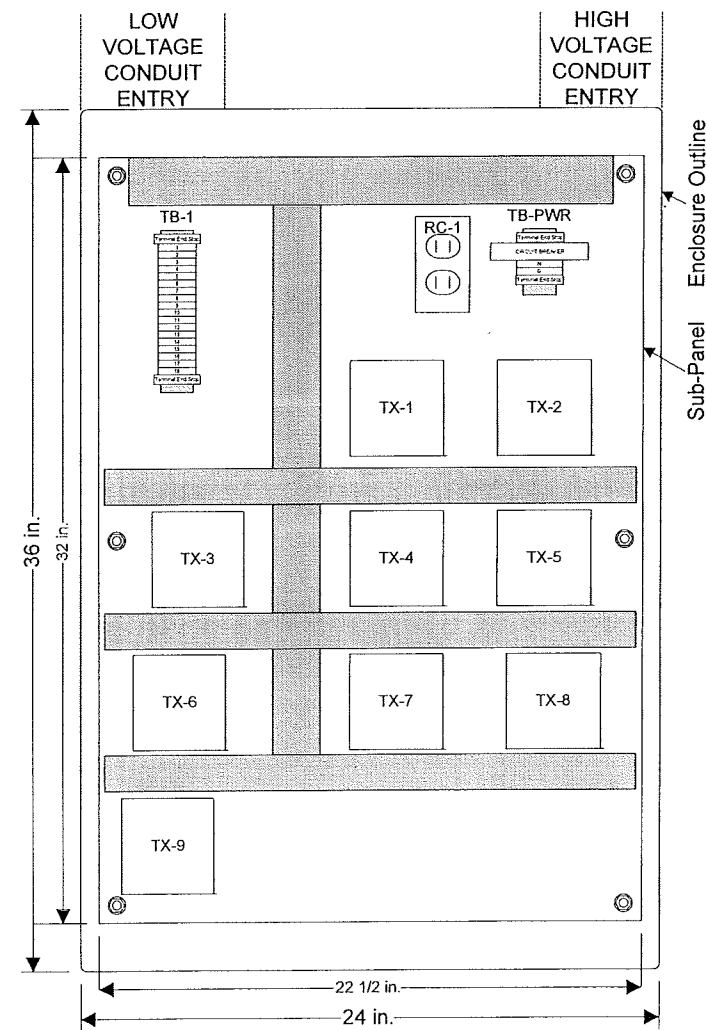

PANEL FACE TAGS:
TAG-1: PANEL P-16
4TH FLOOR VMA TX PANEL
JC10 3109-0044

BILL OF MATERIALS


Designation	Qty	Part Number	Description
Panel Devices:			
P-16	1	PAN-ENC2436WDP	PANEL, HOFFMAN 24X36X9 PERF-SUB W/ DOOR
RC-1	1	PD-117-02	RECEPTACLE DUPLEX IVORY
	1	PD-121-01	BOX COVER RECPT,EAGLE 2510
	1	PD-121-14	HANDY BOX, 2-1/8IN DEEP
TAG-1	1	NAMETAG-CUSTOM	1"X3" TAG, 3-LINES MAX, CUSTOM PNL FACE
TB-1	2	PD-113-44	END CLAMP, WIELAND Z5.522.8553.0
	18	PD-113-52	TERM BLK,6-SQ-MM WIRE SLOT,WIELAND
	1	PD-113-53	END PLATE F/113-52 TERM BLK,WIELAND
	1	PD-112-09	CIRCUIT BREAKER,10A,SQ-D QOU-110
TB-PWR	2	PD-113-44	END CLAMP, WIELAND Z5.522.8553.0
	2	PD-113-52	TERM BLK,6-SQ-MM WIRE SLOT,WIELAND
	1	PD-113-53	END PLATE F/113-52 TERM BLK,WIELAND
	1	PD-114-02	XFMR,120/24VAC,96VA
	9	PD-114-02	

4TH FLOOR VMA TRANSFORMER PANEL


REVISION INFORMATION	Drawing Title								
NUMBER	MISCELLANEOUS DETAILS								
DATE	03/31/08	1	RECORD DRAWINGS	03/30/08	WCS				
TIME	11:16 PM	Project Title		Branch Information		CONTRACT NUMBER			
FILE NAME	msdetg.vsd	DANE COUNTY COURTHOUSE 215 SOUTH HAMILTON ST. MADISON, WI 53703		JOHNSON CONTROLS Madison Branch 2400 Kilgust Road Madison WI 53713 Phone: 608-222-9100 Fax: 608-222-9490		0 3109-0044 DRAWING NUMBER 14.18			

DETAIL G (CONT.)
TYPICAL OF 1


LINE VOLTAGE WIRING DIAGRAM

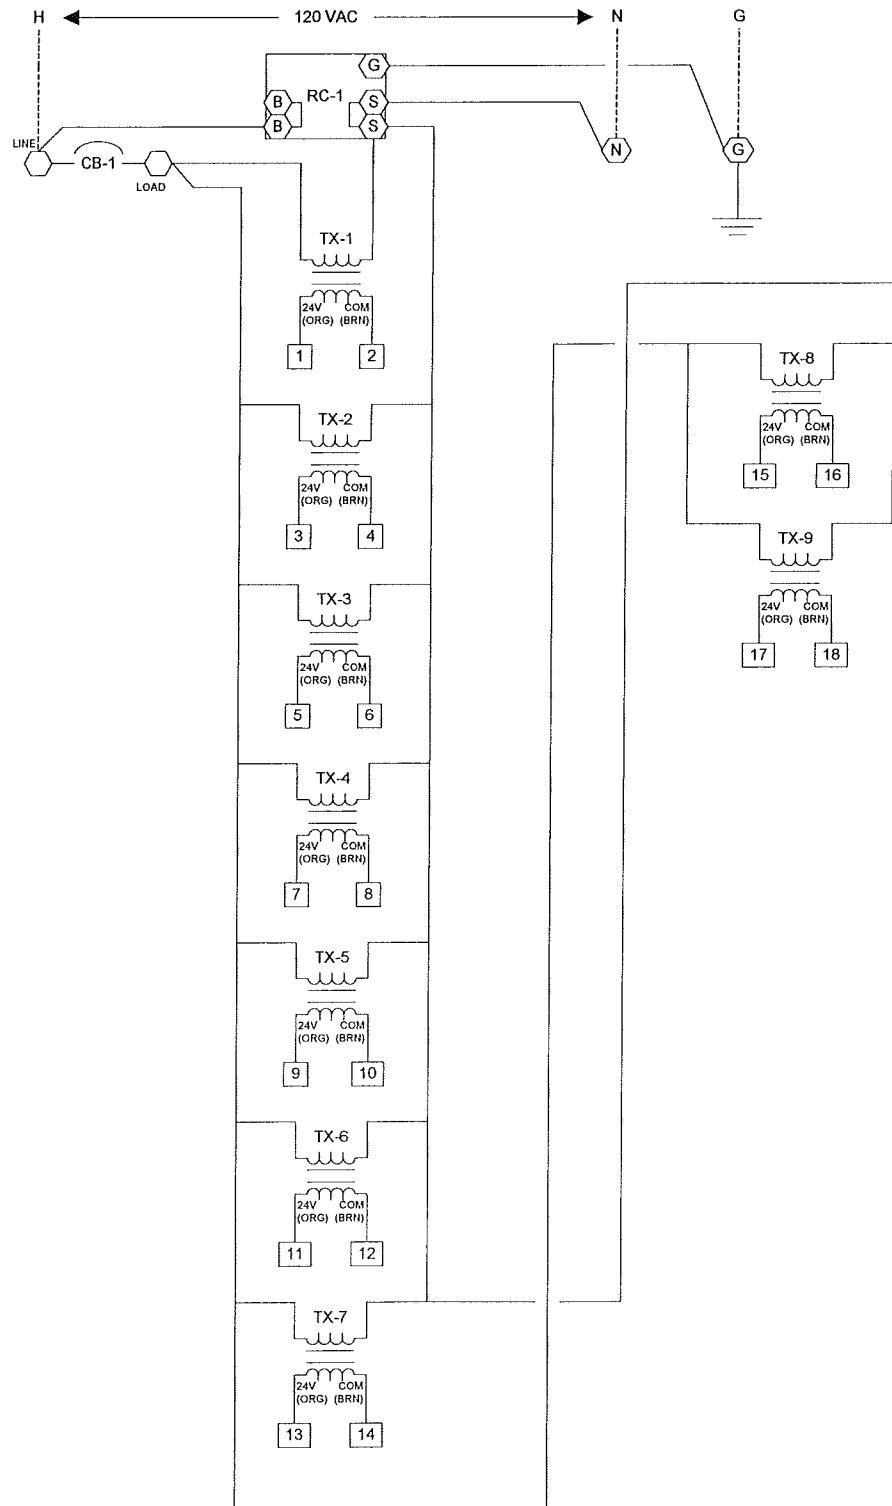

LOW VOLTAGE WIRING DIAGRAM

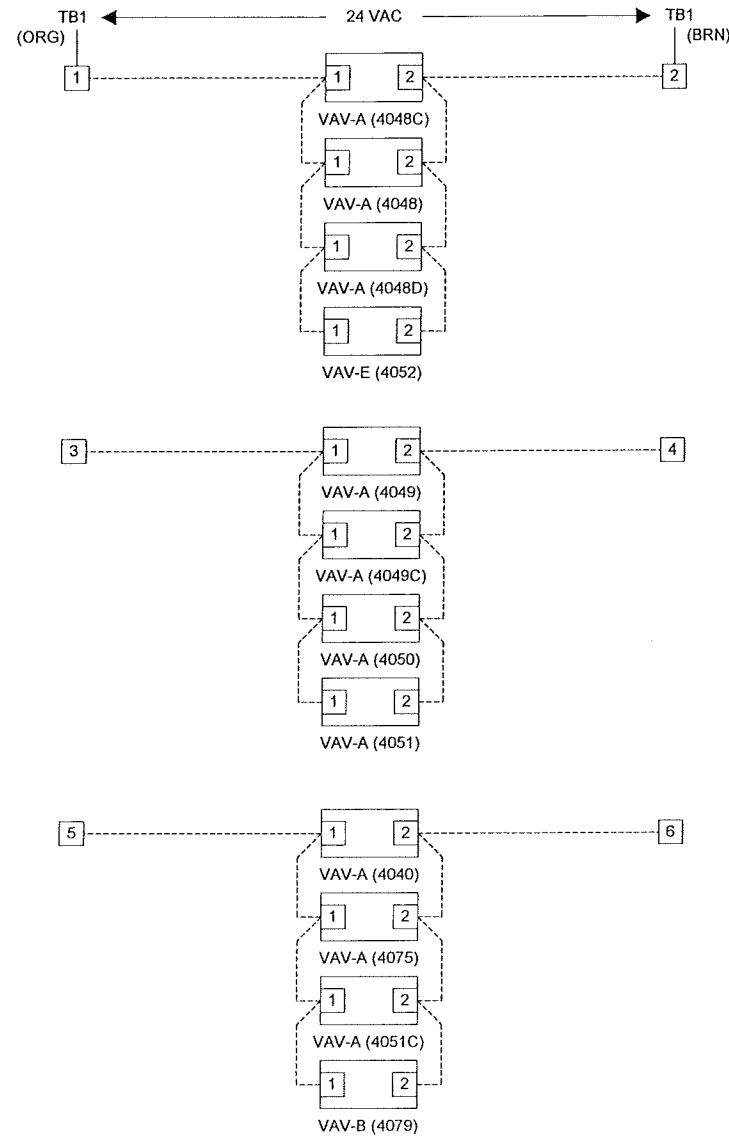

LOW VOLTAGE WIRING DIAGRAM

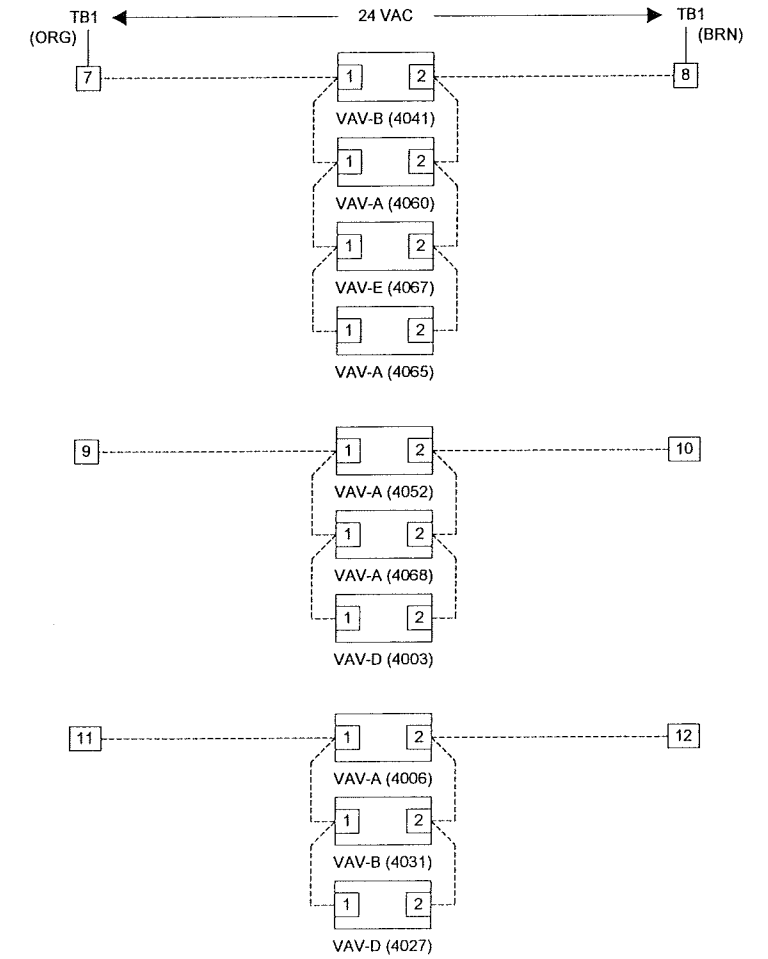

Wiring Legend

- Pneumatic Tubing
- Low Voltage Terminal
- Cable
- Line Voltage Terminal
- Panel Wiring by JCI
- Field Wiring by Others
- VAC Power



4TH FLOOR VMA TRANSFORMER PANEL WIRING

REVISION INFORMATION		Drawing Title									
NUMBER		MISCELLANEOUS DETAILS				1		RECORD DRAWINGS		03/30/08 WCS	
DATE		04/16/08				NO.		REVISION-LOCATION		ECN	
TIME		01:43 PM				SALES ENGINEER		PROJECT MANAGER		APPLICATION ENGINEER	
FILE NAME		msdetgpw1.vsd				GLA		SEL		RJM	
Project Title		DANE COUNTY COURTHOUSE 215 SOUTH HAMILTON ST. MADISON, WI 53703				BY		DATE		APPROVED	
Branch Information		JOHNSON CONTROLS Systems & Services Division				BY		DATE		CONTRACT NUMBER	
						BY		DATE		0 3109-0044	
						BY		DATE		DRAWING NUMBER	
						BY		DATE		14.19	

DETAIL H
TYPICAL OF 1

BILL OF MATERIALS

Designation	Qty	Part Number	Description
Panel Devices:			
P-17	1	PAN-ENC2436WDP	PANEL, HOFFMAN 24X36X9 PERF-SUB W/ DOOR
RC-1	1	PD-117-02	RECEPTACLE DUPLEX IVORY
	1	PD-121-01	BOX COVER RECPT,EAGLE 2510
	1	PD-121-14	HANDY BOX, 2-1/8IN DEEP
TAG-1	1	NAMETAG-CUSTOM	1"X3" TAG, 3-LINES MAX, CUSTOM PNL FACE
TB-1	2	PD-113-44	END CLAMP, WIELAND Z5.522.8553.0
	18	PD-113-52	TERM BLK,6-SQ-MM WIRE SLOT,WIELAND
	1	PD-113-53	END PLATE F/113-52 TERM BLK,WIELAND
TB-PWR	1	PD-112-09	CIRCUIT BREAKER,10A,SQ-D QOU-110
	2	PD-113-44	END CLAMP, WIELAND Z5.522.8553.0
	2	PD-113-52	TERM BLK,6-SQ-MM WIRE SLOT,WIELAND
	1	PD-113-53	END PLATE F/113-52 TERM BLK,WIELAND
TX-x	9	PD-114-02	XFMR,120/24VAC,96VA

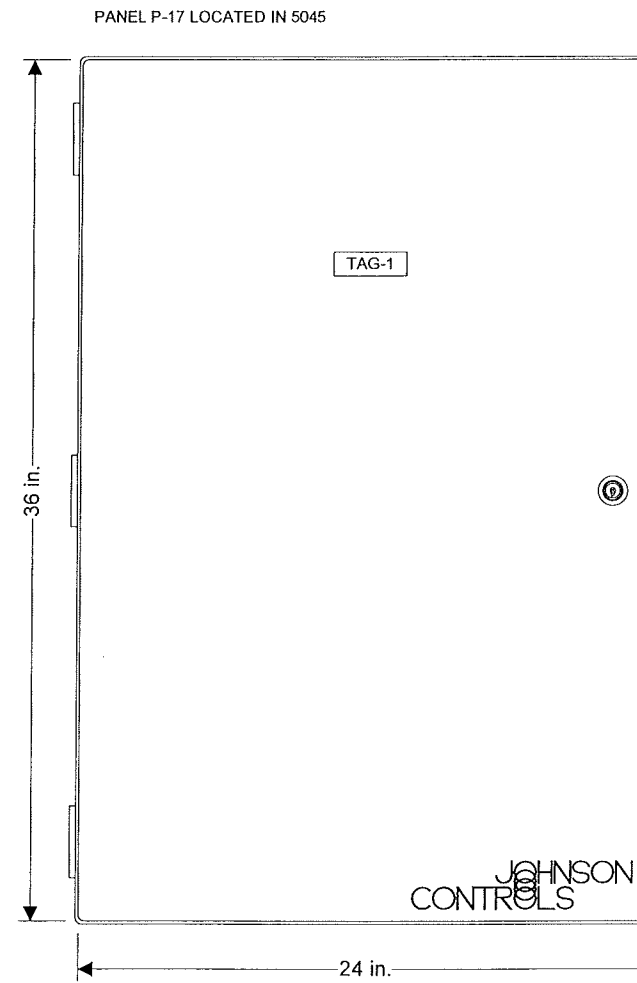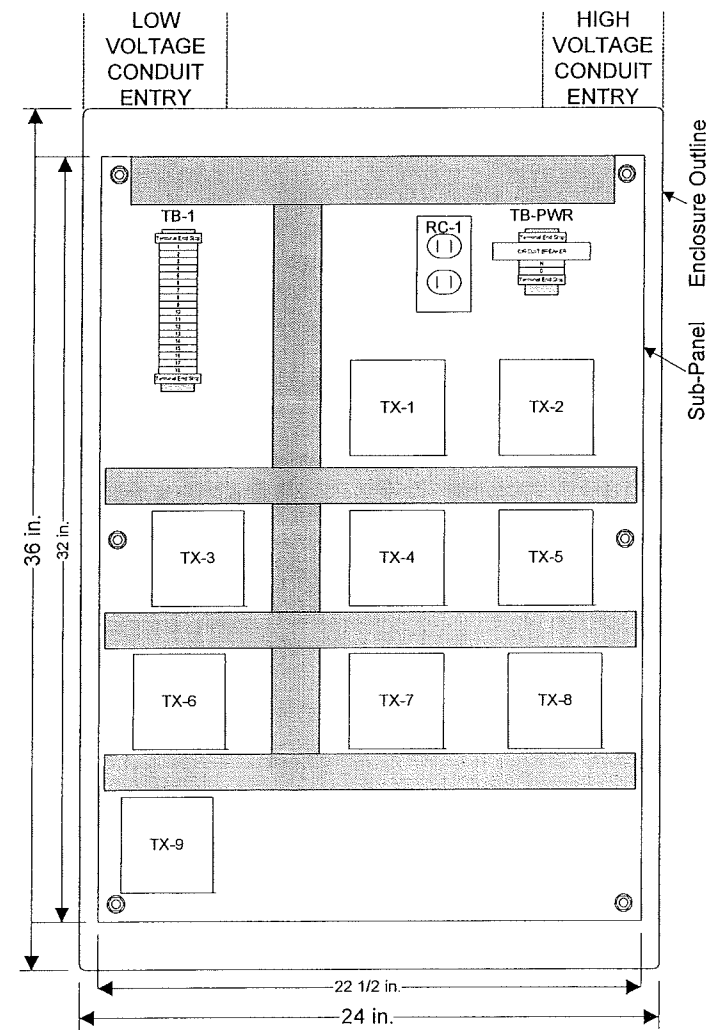


PANEL FACE TAGS:
TAG-1: PANEL P-17
5th FLOOR VMA TX PANEL
JCI 0 3109-0044

5th FLOOR VMA TRANSFORMER PANEL


REVISION INFORMATION	Drawing Title								
NUMBER	MISCELLANEOUS DETAILS								
DATE	04/16/08	NO.	1	RECORD DRAWINGS	ECH	03/30/08	DATE	WCS	
TIME	01:42 PM	SALES ENGINEER	PROJECT MANAGER	APPLICATION ENGINEER	BY	DATE	BY	DATE	
FILE NAME	msdeth.vsd	GLA	SEL	RJM					
Project Title		Branch Information		CONTRACT NUMBER					
DANE COUNTY COURTHOUSE 215 SOUTH HAMILTON ST. MADISON, WI 53703		Madison Branch 2400 Kilgust Road Madison WI 53713 Phone: 608-222-9100 Fax: 608-222-9490		0 3109-0044		DRAWING NUMBER			
		JOHNSON CONTROLS Systems & Services Division				14.21			

DETAIL H (CONT.)
TYPICAL OF 1


LINE VOLTAGE WIRING DIAGRAM

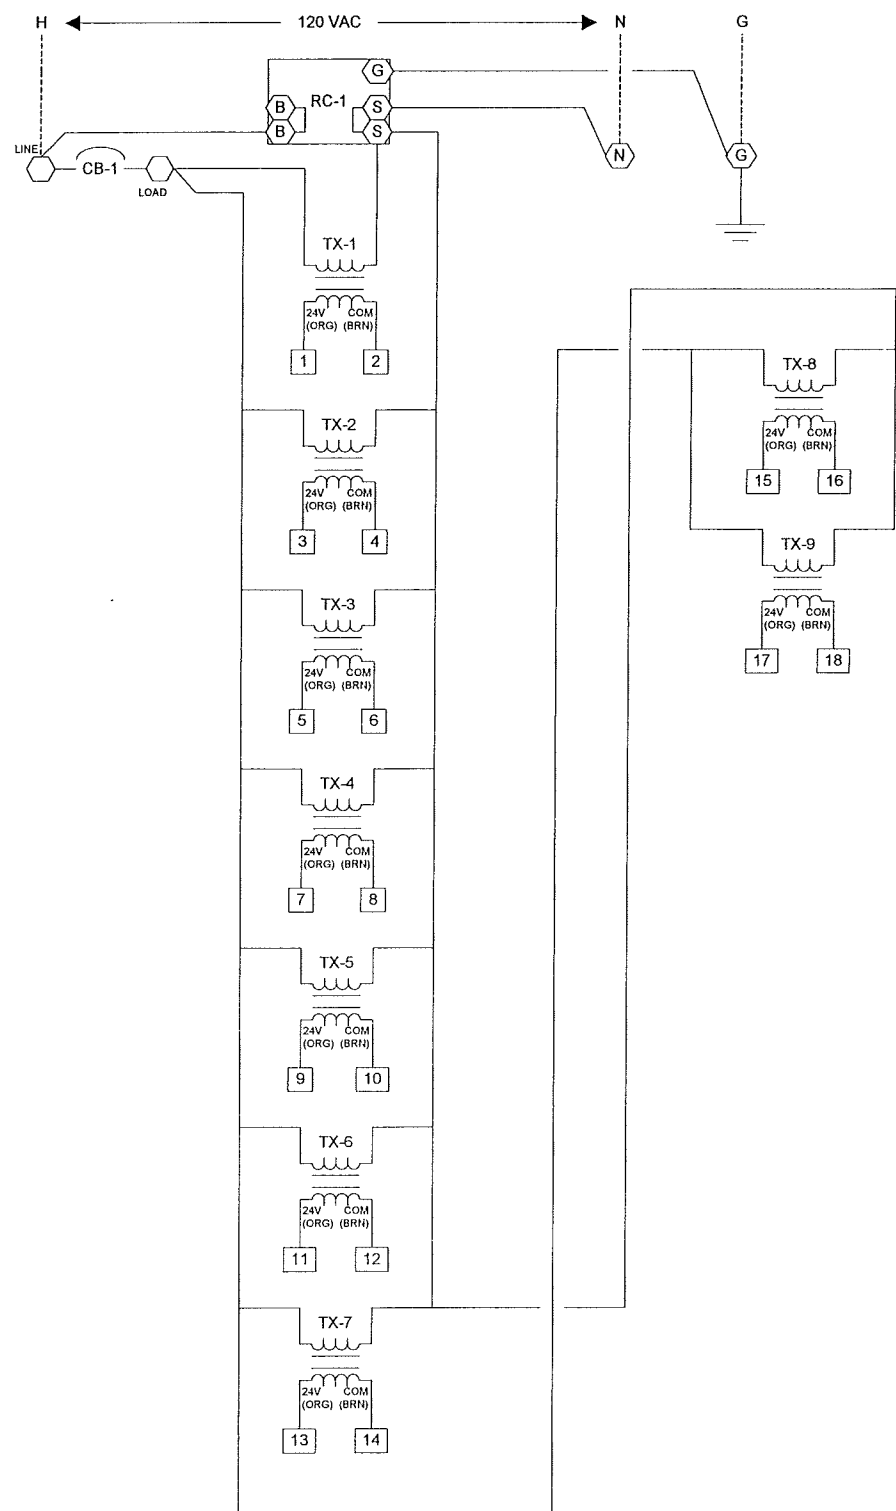

LOW VOLTAGE WIRING DIAGRAM

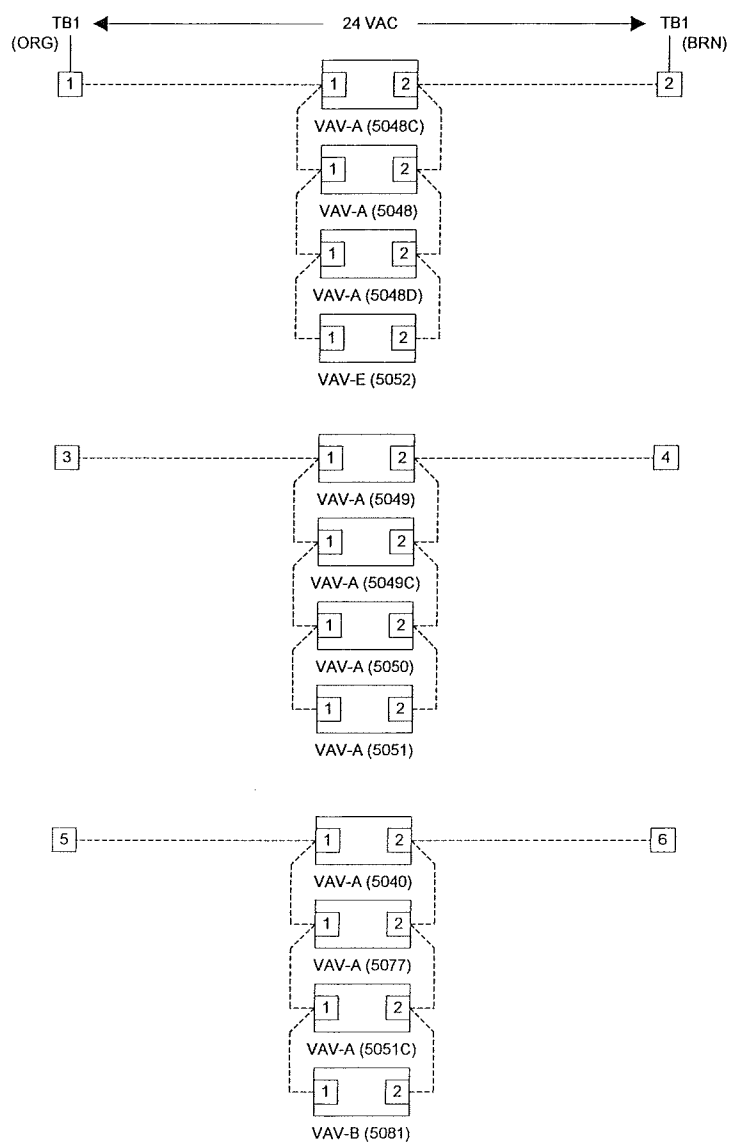

LOW VOLTAGE WIRING DIAGRAM

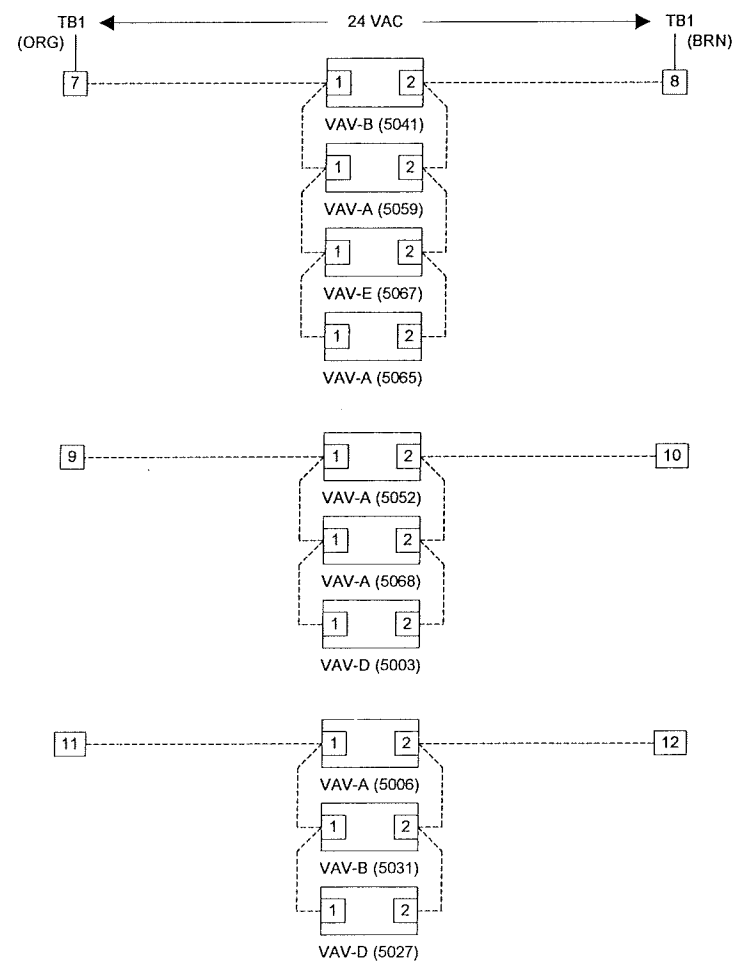


- Wiring Legend**
- Pneumatic Tubing
 - Low Voltage Terminal
 - Cable
 - Line Voltage Terminal
 - Panel Wiring by JCI
 - Field Wiring by Others
 - 24V Power


5TH FLOOR VMA TRANSFORMER PANEL WIRING

REVISION INFORMATION		Drawing Title									
NUMBER		MISCELLANEOUS DETAILS		1		RECORD DRAWINGS		03/30/08		WCS	
DATE		04/16/08		NO.		REVISION-LOCATION		ECH		DATE	
TIME		01:36 PM		SALES ENGINEER		PROJECT MANAGER		APPLICATION ENGINEER		DRAWN	
FILE NAME		msdethpw1.vsd		GLA		SEL		RJM		APPROVED	
Project Title		DANE COUNTY COURTHOUSE 215 SOUTH HAMILTON ST. MADISON, WI 53703		BY		DATE		BY		DATE	
Branch Information		JOHNSON CONTROLS Systems & Services Division		BY		DATE		BY		DATE	
Contract Number		0 3109-0044		BY		DATE		BY		DATE	
Drawing Number		14.22		BY		DATE		BY		DATE	

DETAIL I TYPICAL OF 1

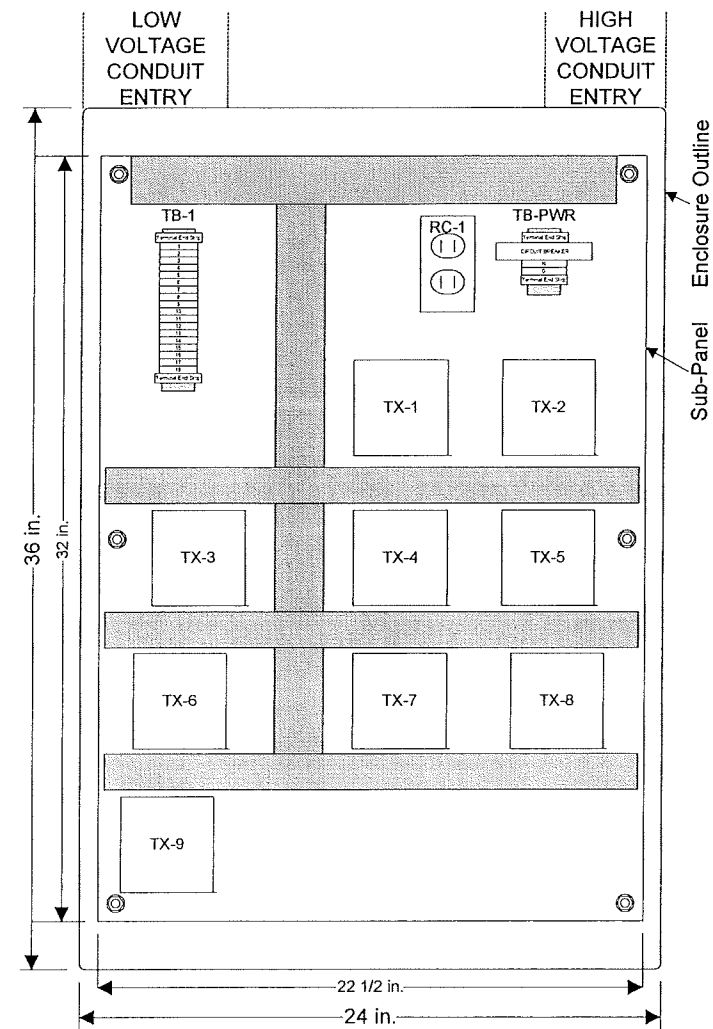

PANEL P-18 LOCATED IN 6045

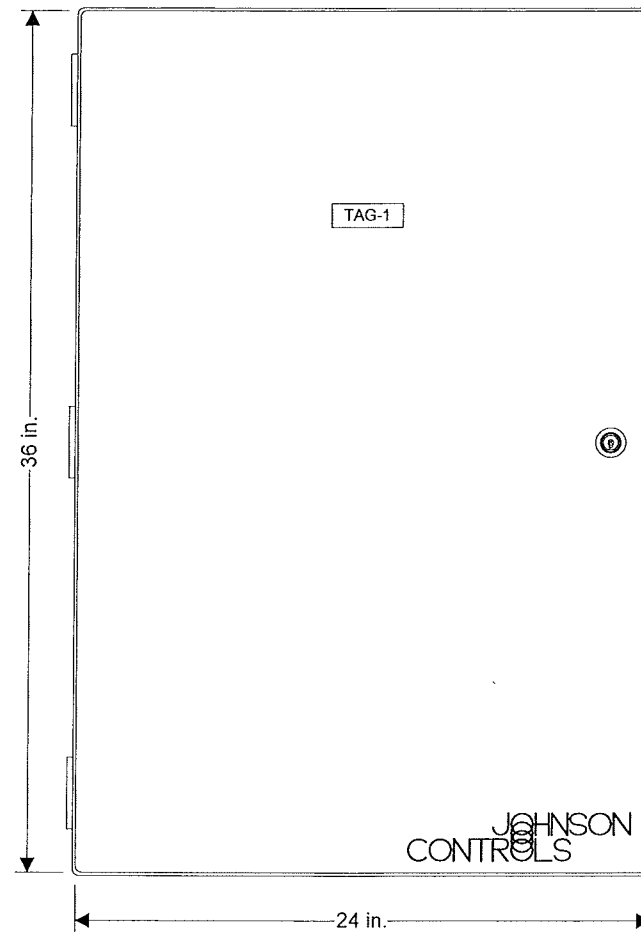

PANEL FACE TAGS:
TAG-1: PANEL P-18
6th FLOOR VMA TX PANEL
JCI 0 3109-0044


BILL OF MATERIALS

Designation	Qty	Part Number	Description
Panel Devices:			
P-18	1	PAN-ENC2436WDP	PANEL, HOFFMAN 24X36X9 PERF-SUB W/ DOOR
RC-1	1	PD-117-02	RECEPTACLE DUPLEX IVORY
	1	PD-121-01	BOX COVER RECPT,EAGLE 2510
	1	PD-121-14	HANDY BOX, 2-1/8IN DEEP
TAG-1	1	NAMETAG-CUSTOM	1"X3" TAG, 3-LINES MAX, CUSTOM PNL FACE
TB-1	2	PD-113-44	END CLAMP, WIELAND Z5.522.8553.0
	18	PD-113-52	TERM BLK,6-SQ-MM WIRE SLOT,WIELAND
	1	PD-113-53	END PLATE F/113-52 TERM BLK,WIELAND
TB-PWR	1	PD-112-09	CIRCUIT BREAKER,10A,SQ-D QOU-110
	2	PD-113-44	END CLAMP, WIELAND Z5.522.8553.0
	2	PD-113-52	TERM BLK,6-SQ-MM WIRE SLOT,WIELAND
	1	PD-113-53	END PLATE F/113-52 TERM BLK,WIELAND
TX-x	9	PD-114-02	XFMR,120/24VAC,96VA

6th FLOOR VMA TRANSFORMER PANEL


REVISION INFORMATION	Drawing Title				
NUMBER	MISCELLANEOUS DETAILS				
DATE	04/16/08	1	RECORD DRAWINGS	03/30/08	WCS
TIME	01:35 PM	REFERENCE DRAWING	NO.	REVISION-LOCATION	ECH DATE BY
FILE NAME	msdettl.vsd	GLA	SEL	RJM	BY DATE APPROVED
Project Title		Branch Information		CONTRACT NUMBER	
DANE COUNTY COURTHOUSE 215 SOUTH HAMILTON ST. MADISON, WI 53703		JOHNSON CONTROLS Systems & Services Division		0 3109-0044	
		Madison Branch 2400 Kilgust Road Madison WI 53713 Phone: 608-222-9100 Fax: 608-222-9490		DRAWING NUMBER 14.24	

LINE VOLTAGE WIRING DIAGRAM

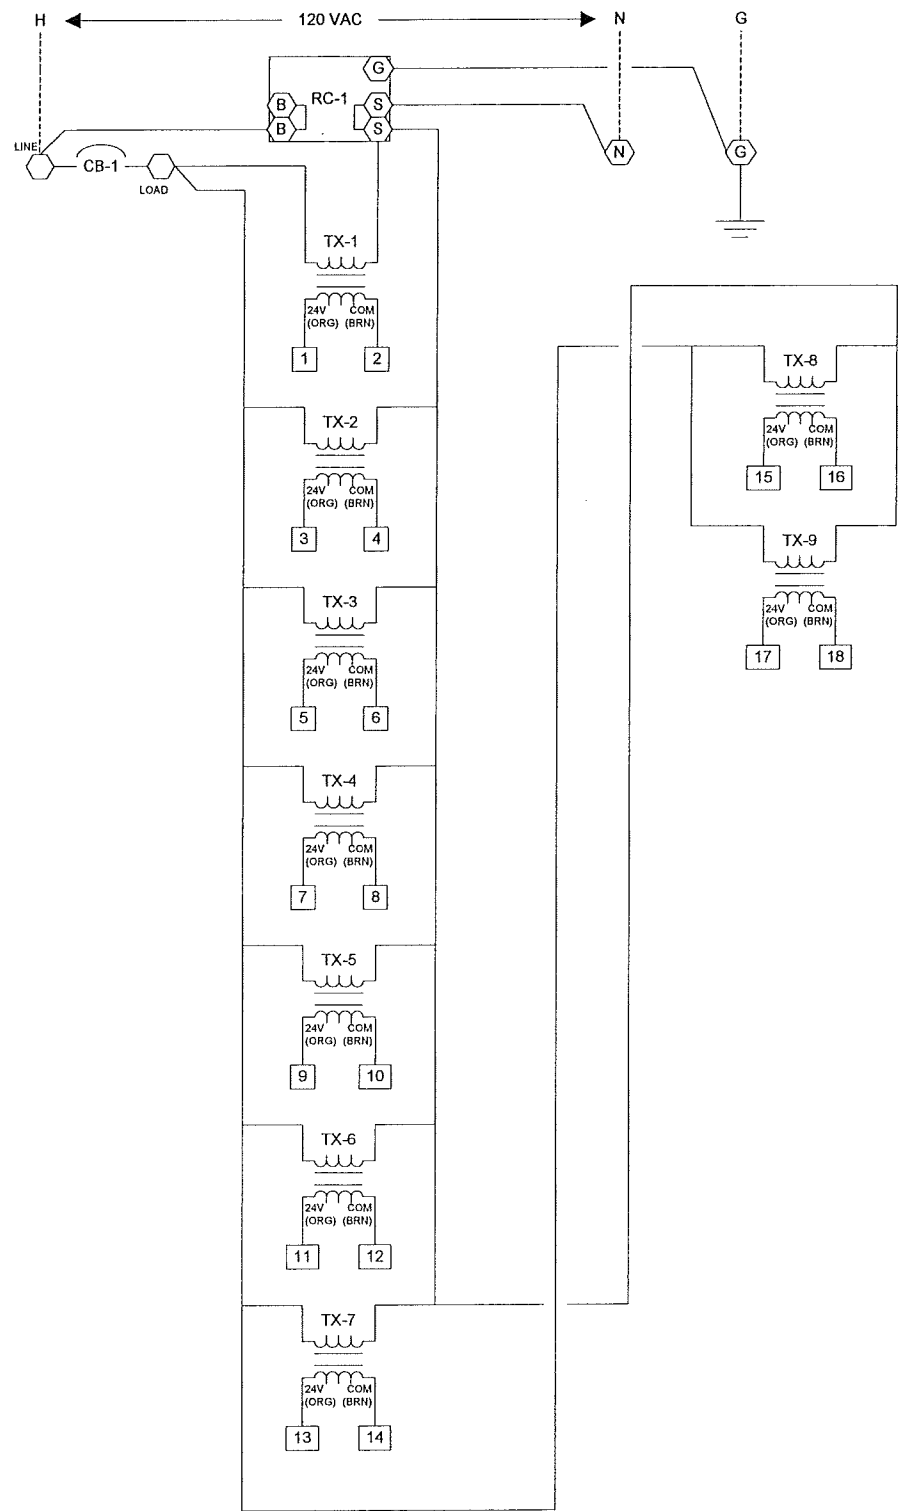


DETAIL I (CONT.)
TYPICAL OF 1


LOW VOLTAGE WIRING DIAGRAM

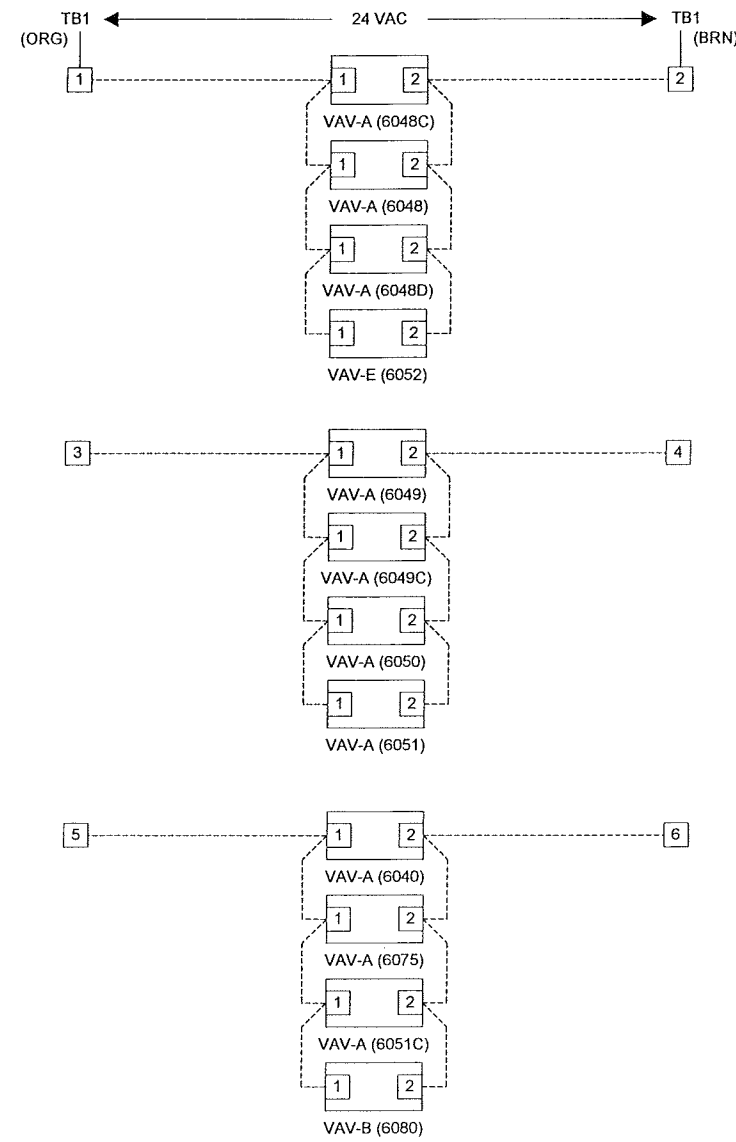

LOW VOLTAGE WIRING DIAGRAM

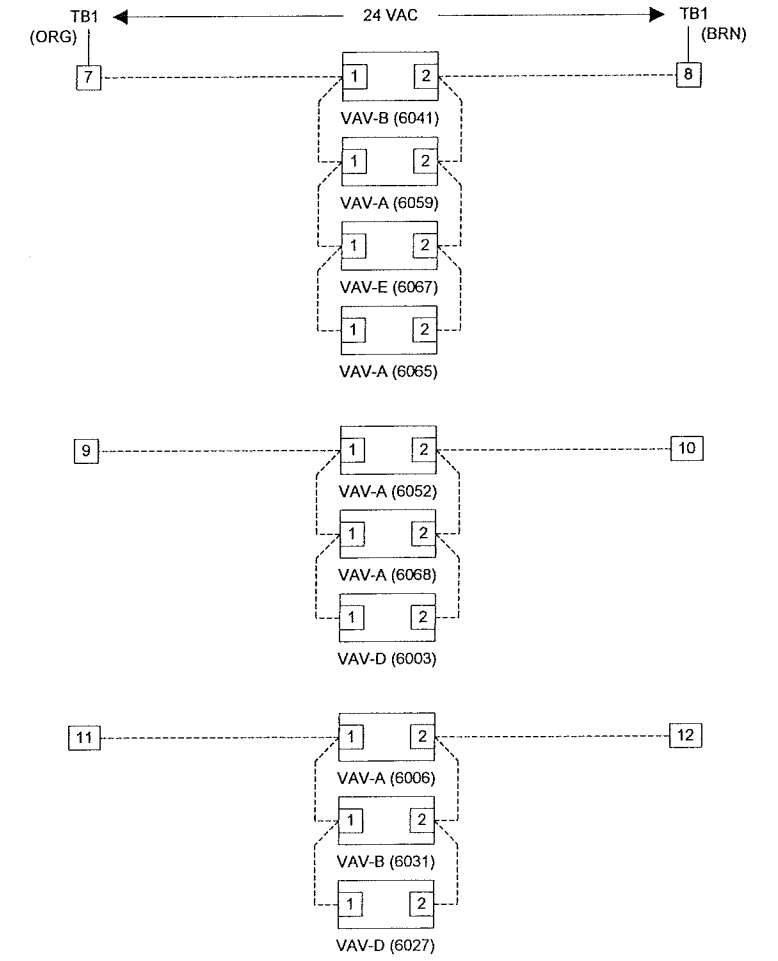


6th FLOOR VMA TRANSFORMER PANEL WIRING

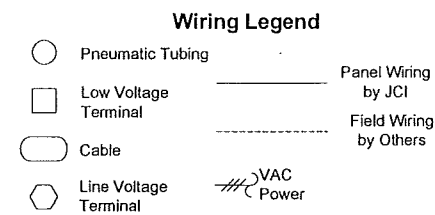

REVISION INFORMATION		Drawing Title									
NUMBER		MISCELLANEOUS DETAILS		1		RECORD DRAWINGS		03/30/08		WCS	
DATE		03/31/08		TIME		11:27 PM		FILE NAME		msdetipw1.vsd	
Project Title		DANE COUNTY COURTHOUSE 215 SOUTH HAMILTON ST. MADISON, WI 53703		Branch Information		Madison Branch 2400 Kilgust Road Madison WI 53713 Phone: 608-222-9100 Fax: 608-222-9490		CONTRACT NUMBER		0 3109-0044	
DRAWN		BY		DATE		APPROVED		BY		DATE	
Sales Engineer		Project Manager		Application Engineer							
GLA		SEL		RJM							
DRAWING NUMBER										14.25	

DETAIL I (CONT.)
TYPICAL OF 1

LOW VOLTAGE WIRING DIAGRAM

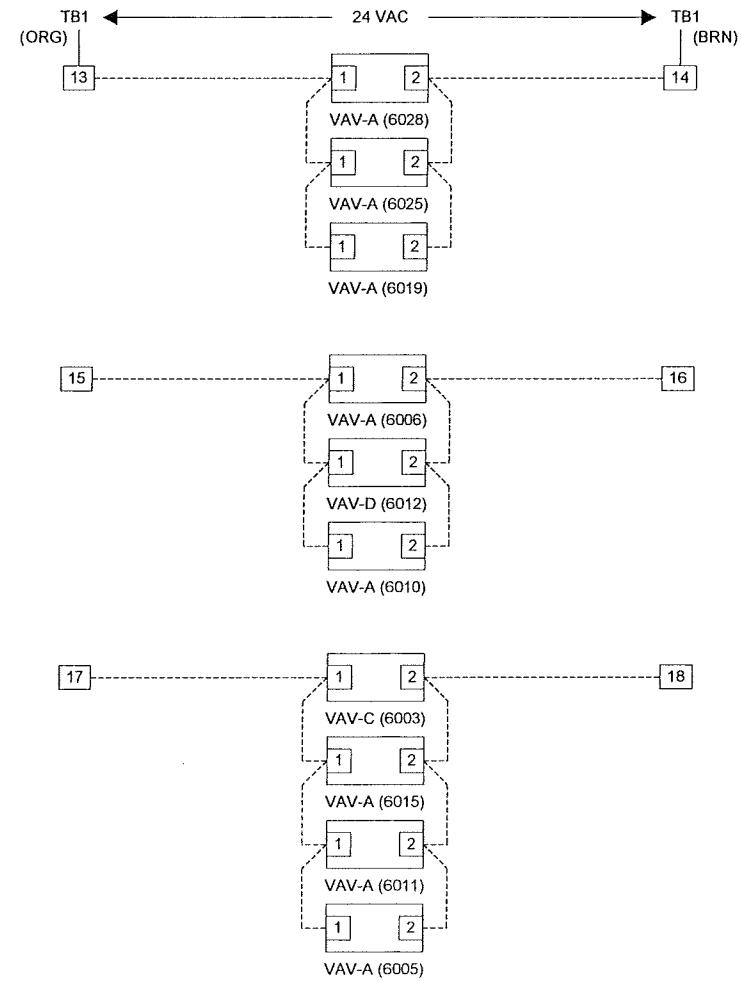


6TH FLOOR VMA TRANSFORMER PANEL WIRING

Wiring Legend


- Pneumatic Tubing
- Low Voltage Terminal
- Cable
- ⬢ Line Voltage Terminal
- Panel Wiring by JCI
- - - Field Wiring by Others
- ⚡ VAC Power

REVISION INFORMATION		Drawing Title									
NUMBER		MISCELLANEOUS DETAILS		1		RECORD DRAWINGS		03/30/08		WCS	
DATE		04/16/08		Project Title		DANE COUNTY COURTHOUSE 215 SOUTH HAMILTON ST. MADISON, WI 53703		Branch Information		CONTRACT NUMBER	
TIME		01:35 PM		FILE NAME		Msdetipw2.vsd		Sales Engineer: GLA Project Manager: SEL Application Engineer: RJM		Madison Branch 2400 Kilgust Road Madison WI 53713 Phone: 608-222-9100 Fax: 608-222-9490	
						DRAWN: BY DATE APPROVED: BY DATE		JOHNSON CONTROLS Systems & Services Division		0 3109-0044 DRAWING NUMBER 14.26	

DETAIL J
TYPICAL OF 1

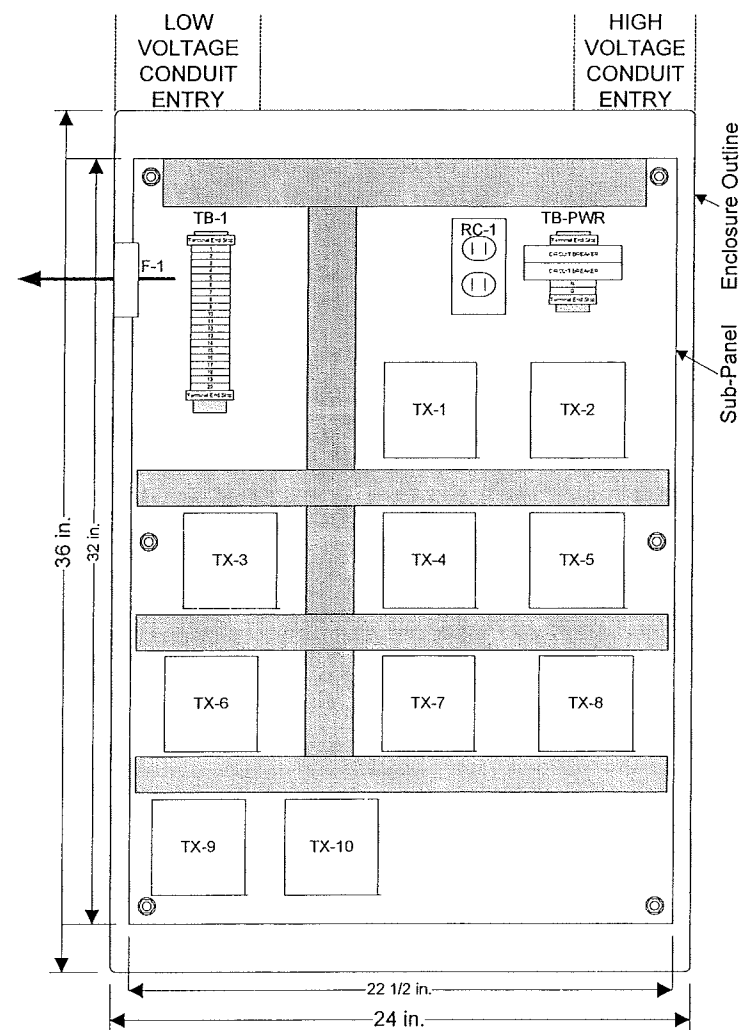

PANEL P-19 LOCATED IN 7045

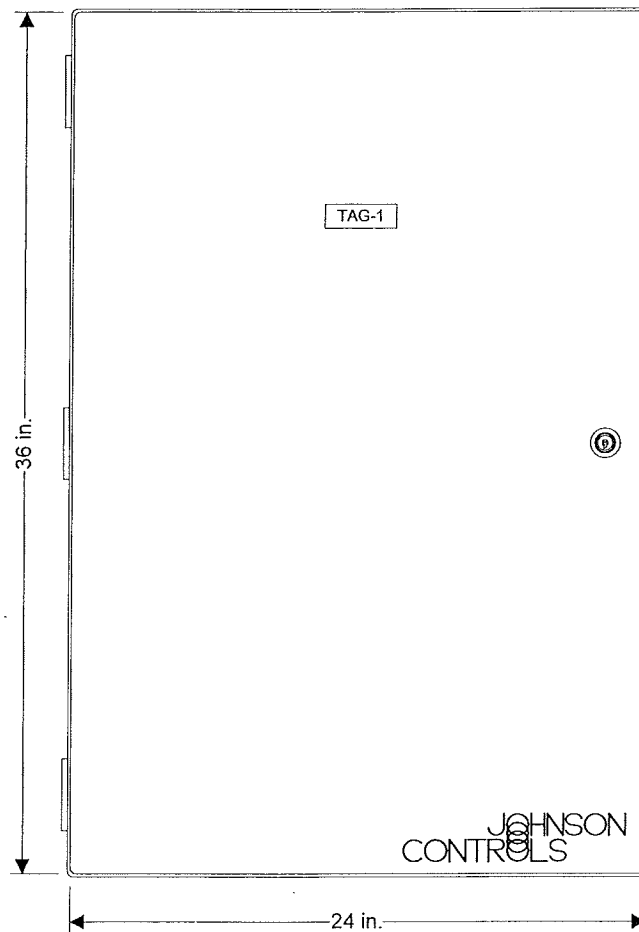

PANEL FACE TAGS:
TAG-1: PANEL P-19
7th FLOOR VMA TX PANEL
JCI 0 3109-0044

BILL OF MATERIALS

Designation	Qty	Part Number	Description
Panel Devices:			
F-1	1	4WT40	DAYTON-3-1/8" SQUARE AXIAL FAN-GRAINGER
	1	4YD96	AYTON-3-1/8" WIRE FAN GUARD-GRAINGER
P-19	1	PAN-ENC2436WDP	PANEL, HOFFMAN 24X36X9 PERF-SUB W/ DOOR
RC-1	1	PD-117-02	RECEPTACLE DUPLEX IVORY
	1	PD-121-01	BOX COVER RECPT,EAGLE 2510
	1	PD-121-14	HANDY BOX, 2-1/8IN DEEP
TAG-1	1	NAMETAG-CUSTOM	1"X3" TAG, 3-LINES MAX, CUSTOM PNL FACE
TB-1	2	PD-113-44	END CLAMP, WIELAND Z5.522.8553.0
	20	PD-113-52	TERM BLK,6-SQ-MM WIRE SLOT,WIELAND
	1	PD-113-53	END PLATE F/113-52 TERM BLK,WIELAND
TB-PWR	2	PD-112-09	CIRCUIT BREAKER,10A,SQ-D QOU-110
	2	PD-113-44	END CLAMP, WIELAND Z5.522.8553.0
	2	PD-113-52	TERM BLK,6-SQ-MM WIRE SLOT,WIELAND
	1	PD-113-53	END PLATE F/113-52 TERM BLK,WIELAND
TX-x	10	PD-114-02	XFMR,120/24VAC,96VA


7th FLOOR VMA TRANSFORMER PANEL

REVISION INFORMATION	Drawing Title									
NUMBER	MISCELLANEOUS DETAILS		1		RECORD DRAWINGS		03/30/08		WCS	
DATE	04/16/08		NO.		REVISION-LOCATION		ECN		DATE	
TIME	01:29 PM		SALES ENGINEER		PROJECT MANAGER		APPLICATION ENGINEER		DRAWN	
FILE NAME	msdetj.vsd		GLA		SEL		RJM		BY	
	Project Title		DATE		DATE		DATE		APPROVED	
	DANE COUNTY COURTHOUSE								CONTRACT NUMBER	
	215 SOUTH HAMILTON ST.								0 3109-0044	
	MADISON, WI 53703								DRAWING NUMBER	
									14.27	

JOHNSON CONTROLS
Systems & Services Division


Madison Branch
2400 Kilgust Road
Madison
WI 53713
Phone: 608-222-9100
Fax: 608-222-9490

LINE VOLTAGE WIRING DIAGRAM

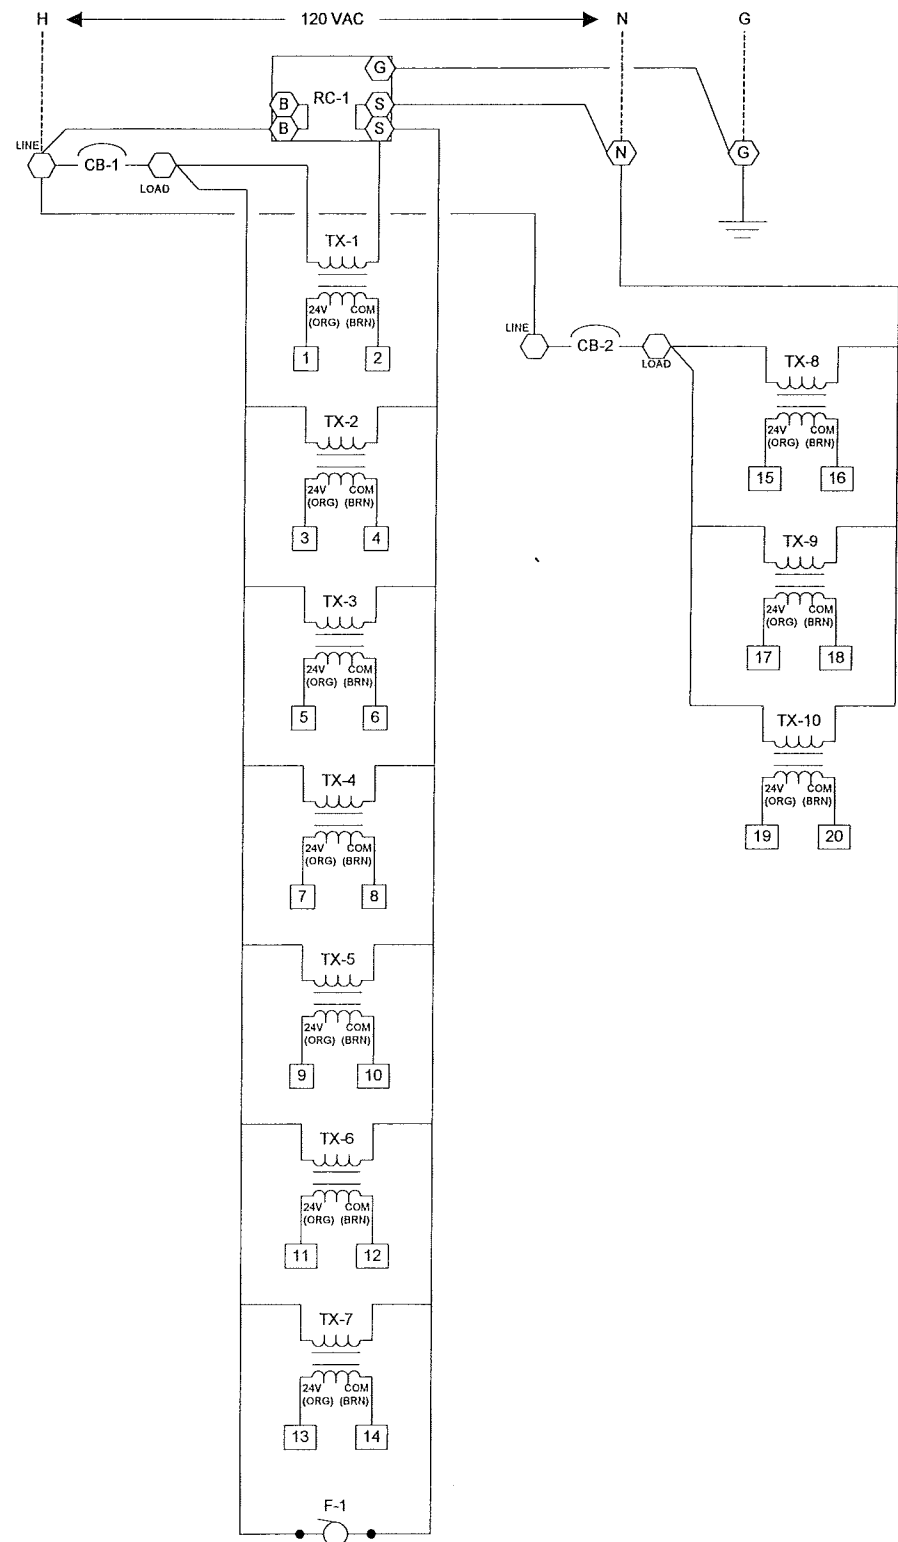


DETAIL J (CONT.)
TYPICAL OF 1

LOW VOLTAGE WIRING DIAGRAM

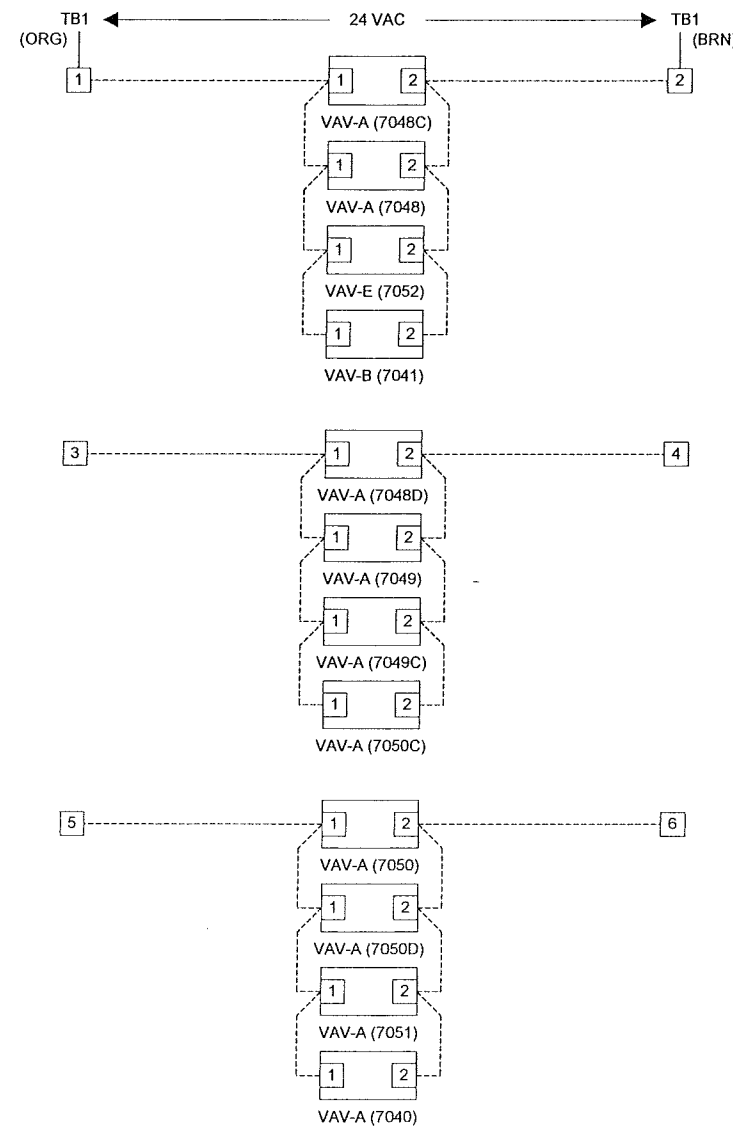

LOW VOLTAGE WIRING DIAGRAM

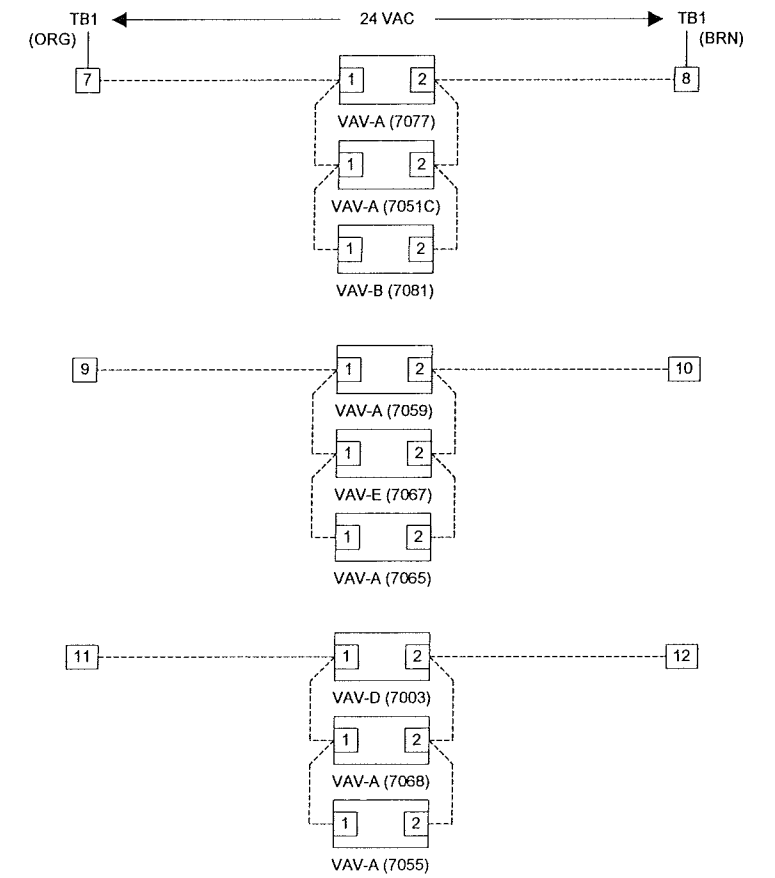

7th FLOOR VMA TRANSFORMER PANEL WIRING


Wiring Legend

- Pneumatic Tubing
- Low Voltage Terminal
- Cable
- ⬡ Line Voltage Terminal
- Panel Wiring by JCI
- - - Field Wiring by Others
- ⚡ VAC Power

REVISION INFORMATION		Drawing Title									
NUMBER		MISCELLANEOUS DETAILS				1		RECORD DRAWINGS		03/30/08 WCS	
DATE		04/16/08									
TIME		01:28 PM									
FILE NAME		msdetjpw1.vsd									
Project Title		DANE COUNTY COURTHOUSE 215 SOUTH HAMILTON ST. MADISON, WI 53703									
Sales Engineer		Project Manager		Application Engineer		DRAWN		APPROVED		CONTRACT NUMBER	
GLA		SEL		RJM		BY DATE		BY DATE		0 3109-0044	
Branch Information		JOHNSON CONTROLS Systems & Services Division				Madison Branch 2400 Kilgust Road Madison WI 53713 Phone: 608-222-9100 Fax: 608-222-9490				DRAWING NUMBER 14.28	

DETAIL J (CONT.)
TYPICAL OF 1

LOW VOLTAGE WIRING DIAGRAM

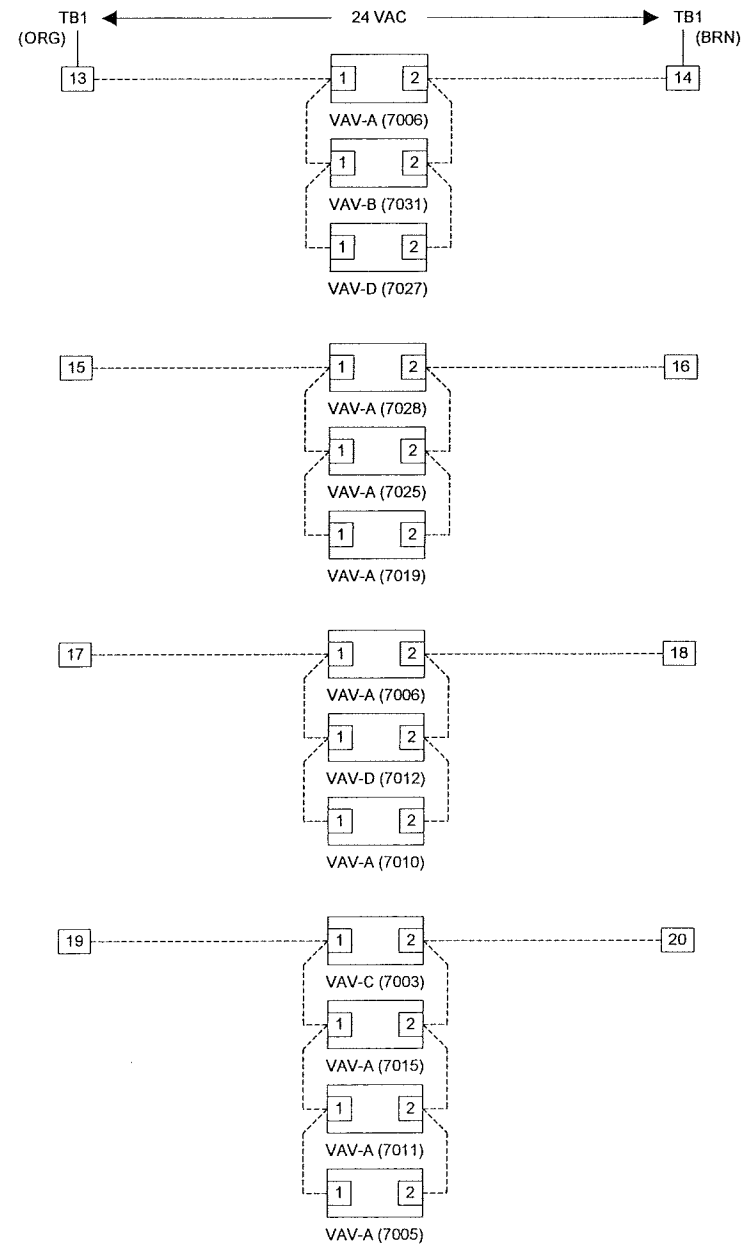

7TH FLOOR VMA TRANSFORMER PANEL WIRING

Wiring Legend

- Pneumatic Tubing
- Low Voltage Terminal
- Cable
- Line Voltage Terminal
- Panel Wiring by JCI
- - - Field Wiring by Others
- ⏏ VAC Power


REVISION INFORMATION		Drawing Title									
NUMBER		1		RECORD DRAWINGS		03/30/08		WCS			
DATE		04/16/08		REFERENCE DRAWING		NO.		REVISION-LOCATION		ECN	
TIME		01:26 PM		Sales Engineer		Project Manager		Application Engineer		DRAWN	
FILE NAME		Msdetjpw2.vsd		GLA		SEL		RJM		BY	
Project Title		DANE COUNTY COURTHOUSE 215 SOUTH HAMILTON ST. MADISON, WI 53703		Branch Information		Madison Branch 2400 Kilgust Road Madison WI 53713 Phone: 608-222-9100 Fax: 608-222-9490		CONTRACT NUMBER		0 3109-0044	
				DRAWING NUMBER		14.29					

**JOHNSON
CONTROLS**
Systems & Services Division


DETAIL K
TYPICAL OF 1

BILL OF MATERIALS

Designation	Qty	Part Number	Description
Panel Devices:			
F-1	1	4WT40	DAYTON-3-1/8" SQUARE AXIAL FAN-GRAINGER
	1	4YD96	AYTON-3-1/8" WIRE FAN GUARD-GRAINGER
P-20	1	PAN-ENC2436WDP	PANEL, HOFFMAN 24X36X9 PERF-SUB W/ DOOR
RC-1	1	PD-117-02	RECEPTACLE DUPLEX IVORY
	1	PD-121-01	BOX COVER RECPT,EAGLE 2510
	1	PD-121-14	HANDY BOX, 2-1/8IN DEEP
TAG-1	1	NAMETAG-CUSTOM	1"X3" TAG, 3-LINES MAX, CUSTOM PNL FACE
TB-1	2	PD-113-44	END CLAMP, WIELAND Z5.522.8553.0
	20	PD-113-52	TERM BLK,6-SQ-MM WIRE SLOT,WIELAND
	1	PD-113-53	END PLATE F/113-52 TERM BLK,WIELAND
TB-PWR	2	PD-112-09	CIRCUIT BREAKER,10A,SQ-D QOU-110
	2	PD-113-44	END CLAMP, WIELAND Z5.522.8553.0
	2	PD-113-52	TERM BLK,6-SQ-MM WIRE SLOT,WIELAND
	1	PD-113-53	END PLATE F/113-52 TERM BLK,WIELAND
TX-x	10	PD-114-02	XFMR,120/24VAC,96VA

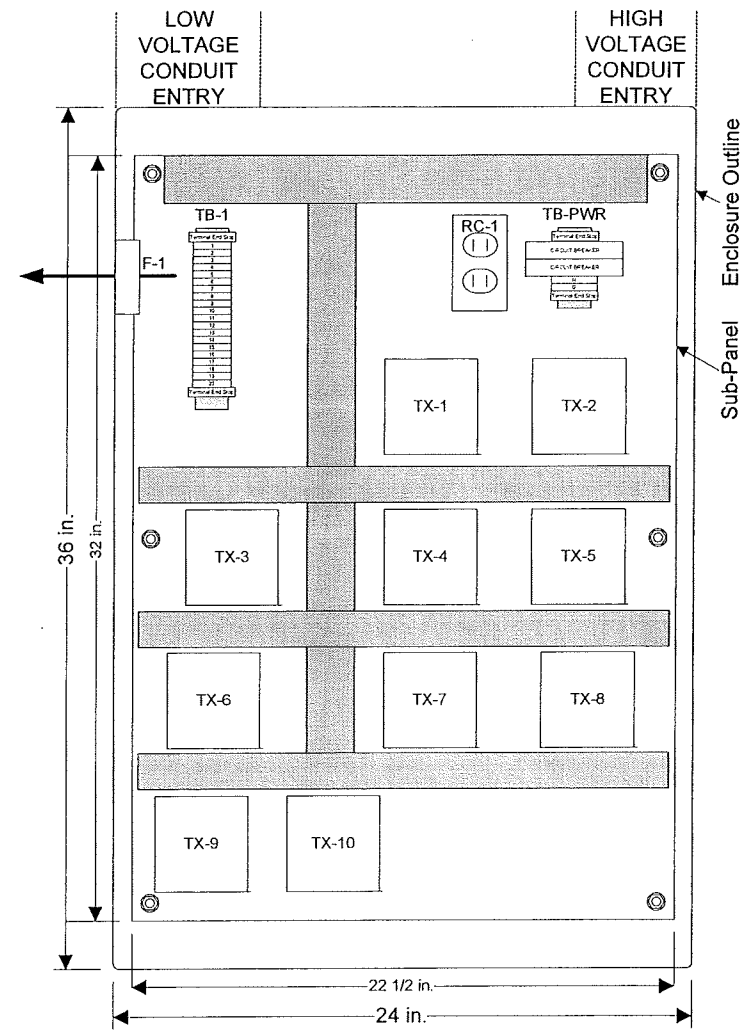

PANEL P-20 LOCATED IN 8045

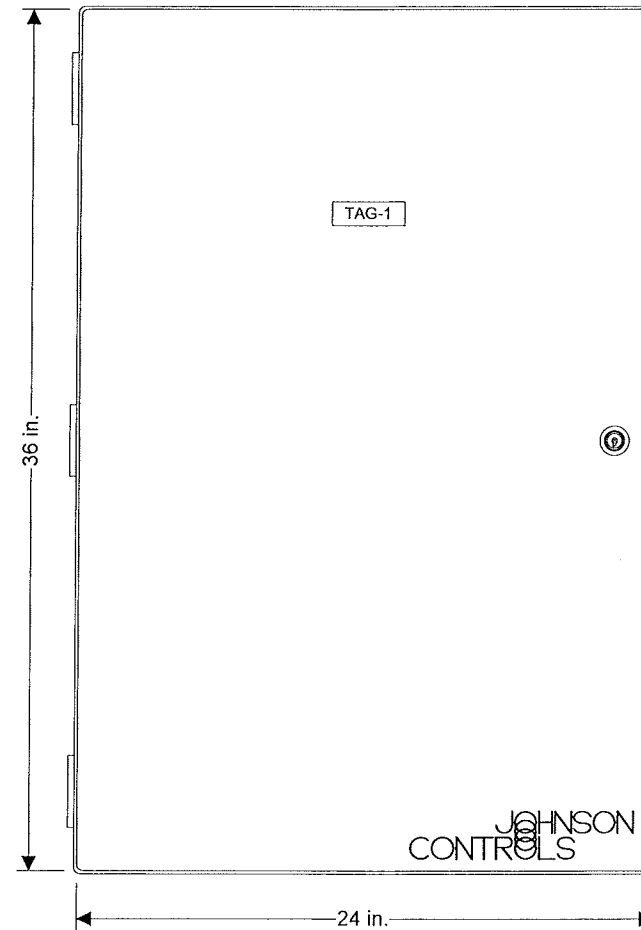


PANEL FACE TAGS:
TAG-1: PANEL P-20
8th FLOOR VMA TX PANEL
JCI 0 3109-0044

8th FLOOR VMA TRANSFORMER PANEL


REVISION INFORMATION	Drawing Title									
NUMBER	MISCELLANEOUS DETAILS		1		RECORD DRAWINGS		03/30/08		WCS	
DATE	04/16/08		NO.		REVISION-LOCATION		EGR		DATE	
TIME	01:26 PM		Sales Engineer		Project Manager		Application Engineer		DRAWN	
FILE NAME	msdetk.vsd		GLA		SEL		RJM		BY	
			DATE		DATE		DATE		DATE	
			Branch Information		CONTRACT NUMBER		BY		DATE	
			Madison Branch		0 3109-0044		BY		DATE	
			2400 Kilgust Road		DRAWING NUMBER		BY		DATE	
			Madison		14.30		BY		DATE	
			WI 53713				BY		DATE	
			Phone: 608-222-9100				BY		DATE	
			Fax: 608-222-9490				BY		DATE	

DETAIL K (CONT.)
TYPICAL OF 1

LOW VOLTAGE WIRING DIAGRAM

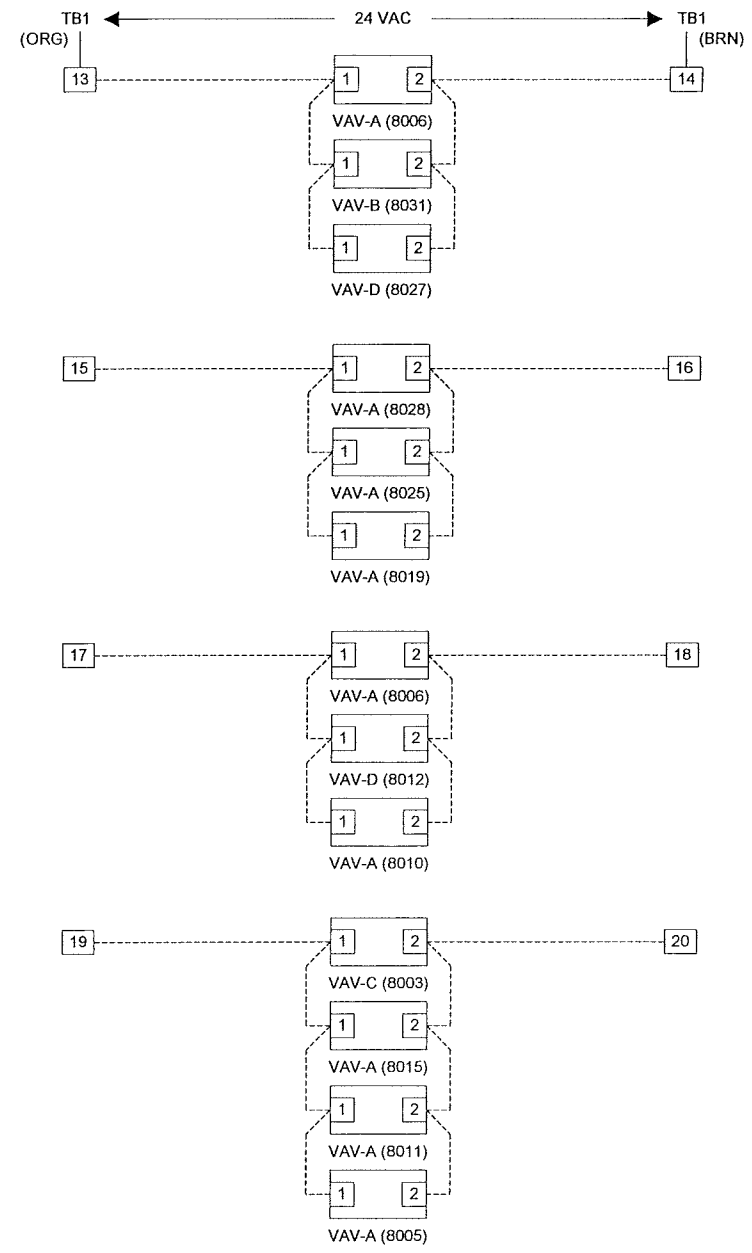

8TH FLOOR VMA TRANSFORMER PANEL WIRING


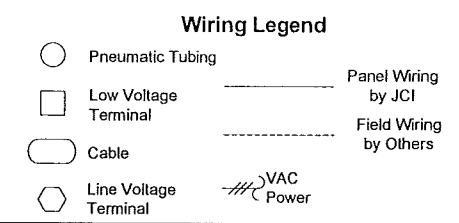


REVISION INFORMATION		Drawing Title									
NUMBER		MISCELLANEOUS DETAILS									
DATE		04/16/08		NO.		1		RECORD DRAWINGS		03/30/08 WCS	
TIME		01:25 PM		REFERENCE DRAWING		NO.		REVISION-LOCATION		ECH DATE BY	
FILE NAME		Msdetkpw2.vsd		Sales Engineer		Project Manager		Application Engineer		DRAWN	
				GLA		SEL		RJM		BY DATE	
				Branch Information						CONTRACT NUMBER	
				Project Title		DANE COUNTY COURTHOUSE 215 SOUTH HAMILTON ST. MADISON, WI 53703				0 3109-0044	
				Systems & Services Division		Madison Branch 2400 Kilgust Road Madison WI 53713 Phone: 608-222-9100 Fax: 608-222-9490		DRAWING NUMBER		14.32	

BILL OF MATERIALS

Designation	Qty	Part Number	Description
Field Devices:			
TX-x	2	Y63T22-0	XFMR, 120-208-240/24,50VA,PLATE [Y63SJB]
UNT-13	1	AS-UNT140-1	CNTRLR,DIG,UNT,6AI,4BI,8BO,SCREW
UNT-14	1	AS-UNT141-1	CNTRLR,DIG,UNT,6AI,4BI,6BO,2AO,SCR

DETAIL L
TYPICAL OF 1

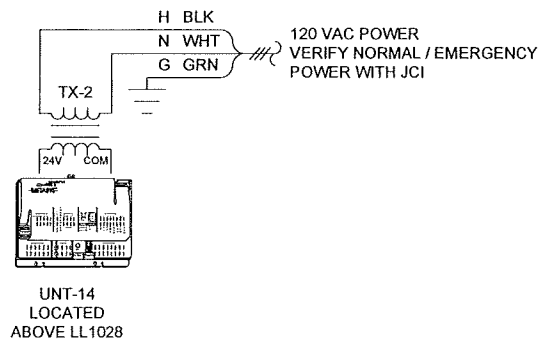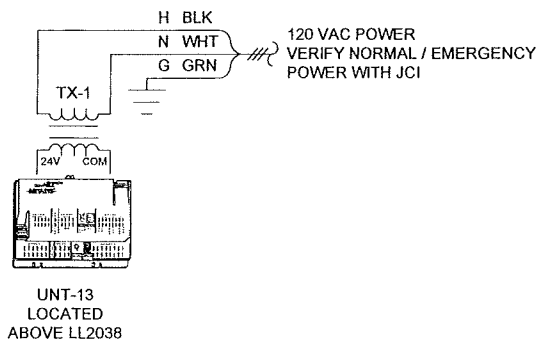

- FROM LAST N2 DEVICE (N2) 3/18
- TO NEXT N2 DEVICE (N2) 3/18
- LL2038-T \ AI-1 (1-13-AI-1) 2/18 YEL
- LL2040-T \ AI-2 (1-13-AI-2) 2/18 YEL
- LL2041-T \ AI-3 (1-13-AI-3) 2/18 YEL
- RAD1-OP \ BO-1 (1-13-BO-1) 3/18 VIO
- RAD1-CL \ BO-2 (1-13-BO-2)
- FCU1-C \ BO-3 (1-13-BO-3) 2/18 VIO
- FCU1-CLG \ BO-4 (1-13-BO-4) 2/18 VIO
- FCU2-C \ BO-5 (1-13-BO-5) 2/18 VIO
- FCU2-HTG \ BO-6 (1-13-BO-6) 2/18 VIO
- FCU2-CLG \ BO-7 (1-13-BO-7) 2/18 VIO


- FROM LAST N2 DEVICE (N2) 3/18
- TO NEXT N2 DEVICE (N2) 3/18
- LL1027-T \ AI-1 (2-14-AI-1) 2/18 YEL
- LL1028-T \ AI-2 (2-14-AI-2) 2/18 YEL
- RAD2-OP \ BO-1 (2-14-BO-1) 3/18 VIO
- RAD2-CL \ BO-2 (2-14-BO-2)
- RAD3-OP \ BO-3 (2-14-BO-3) 3/18 VIO
- RAD3-CL \ BO-4 (2-14-BO-4)

MISCELLANEOUS UNT CONTROLLERS

BILL OF MATERIALS

Designation	Qty	Part Number	Description
Field Devices:			
xFSD-C	1	RIB24P30	30AMP DPDT 24VAC/DC

DETAIL M
TYPICAL OF 10

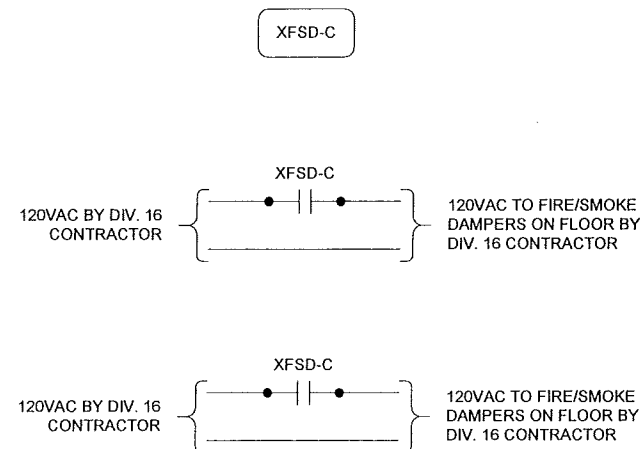

REV	FLOOR	RELAY LOCATED IN ROOM #	RELAY WIRED TO
	LL 2	LL2002	VMA SERVING LL2006 (VAV-A)
	LL 1	LL1016	VMA SERVING LL1018 (VAV-B)
	1ST	1035	VMA SERVING 1034 (VAV-A)
	2ND	2053	VMA SERVING 2056 (VAV-B)
	3RD	3096	VMA SERVING 3099 (VAV-B)



REV	FLOOR	RELAY LOCATED IN ROOM #	RELAY WIRED TO
	4TH	4046	VMA SERVING 4048C (VMA-A)
	5TH	5046	VMA SERVING 5048C (VMA-A)
	6TH	6046	VMA SERVING 6048C (VMA-A)
	7TH	7046	VMA SERVING 7048C (VMA-A)
	8TH	8046	VMA SERVING 8048C (VMA-A)

FIRE / SMOKE DAMPERS CONTROL RELAYS:

A control relay will be provided on each floor by JCI. This relay will be wired to a controller to control the operation of the fire / smoke dampers on a per floor basis. Power wiring to the relay contacts and from the relay contacts to the fire / smoke dampers on the floor will be by the division 16 contractor.





REVISION INFORMATION	Drawing Title								
NUMBER	MISCELLANEOUS DETAILS			1		RECORD DRAWINGS		03/30/08	WCS
DATE	04/16/08	REFERENCE DRAWING	NO.	REVISION-LOCATION	ECN	DATE	APPROVED		
TIME	01:24 PM	Sales Engineer	Project Manager	Application Engineer	BY	DATE	BY	DATE	CONTRACT NUMBER
FILE NAME	msdetlm.vsd	GLA	SEL	RJM	Branch Information		DRAWING NUMBER		
		Project Title			DANE COUNTY COURTHOUSE 215 SOUTH HAMILTON ST. MADISON, WI 53703		0 3109-0044		
		JOHNSON CONTROLS Systems & Services Division			Madison Branch 2400 Kilgust Road Madison WI 53713 Phone: 608-222-9100 Fax: 608-222-9490		14.33		

Electrician/Fitter		Point Information			Controller Information					Panel Information			Intermedi		Field Device						
Tag	Point Type	System Name	Object Name	Expanded ID	Controller Type	Trunk Nbr	Trunk Addr.	Cable Destination Bay/Terminal	Module Type	Termination Out	Panel	Panel Location	Slot Number	Reference Drawing	Cable Number	Wiring /Tubing	Termination In	Device	Location	Ref Detail Shape	Comment
					UNT14x						UNT-2	ABOVE LL1028									Power to Controller N2 Trunk
AI-1	MISC		LL1027-T	Women's TII LL1027 Temp	UNT14x	1	14				UNT-2	ABOVE LL1028	0								
AI-2	MISC		LL1028-T	Storage LL1028 Temp	UNT14x	1	14 AI-1		AI1,A COM		UNT-2	ABOVE LL1028	0		2-14-AI-1	2/18 YEL	1,2	TE-6700-TE (TB, No PB)	UT137		
AI-3					UNT14x	1	14 AI-2		AI2,A COM		UNT-2	ABOVE LL1028	0		2-14-AI-2	2/18 YEL	1,2	TE-6700-TE (TB, No PB)	UT137		
AI-4					UNT14x	1	14 AI-3				UNT-2	ABOVE LL1028	0		2-14-AI-3						
AI-5					UNT14x	1	14 AI-4				UNT-2	ABOVE LL1028	0		2-14-AI-4						
AI-6					UNT14x	1	14 AI-5				UNT-2	ABOVE LL1028	0		2-14-AI-5						
BI-1					UNT14x	1	14 BI-1				UNT-2	ABOVE LL1028	0		2-14-BI-1						
BI-2					UNT14x	1	14 BI-2				UNT-2	ABOVE LL1028	0		2-14-BI-2						
BI-3					UNT14x	1	14 BI-3				UNT-2	ABOVE LL1028	0		2-14-BI-3						
BI-4					UNT14x	1	14 BI-4				UNT-2	ABOVE LL1028	0		2-14-BI-4						
BO-1	MISC		RAD2-OP	LL1027 Radiation Open	UNT14x	1	14 BO-1		BO-a,BO-b,RTN		UNT-2	ABOVE LL1028	0		2-14-BO-1	3/18 VIO	White, Red, Blue	VA-7450 (Incr) (Sw Hi)	UT583		
BO-2	MISC		RAD2-CL	LL1027 Radiation Close	UNT14x	1	14 BO-2				UNT-2	ABOVE LL1028	0		2-14-BO-2						
BO-3	MISC		RAD3-OP	LL1028 Radiation Open	UNT14x	1	14 BO-3		BO-a,BO-b,RTN		UNT-2	ABOVE LL1028	0		2-14-BO-3	3/18 VIO	White, Red, Blue	VA-7450 (Incr) (Sw Hi)	UT583		
BO-4	MISC		RAD3-CL	LL1028 Radiation Close	UNT14x	1	14 BO-4				UNT-2	ABOVE LL1028	0		2-14-BO-4						
BO-5					UNT14x	1	14 BO-5				UNT-2	ABOVE LL1028	0		2-14-BO-5						
BO-6					UNT14x	1	14 BO-6				UNT-2	ABOVE LL1028	0		2-14-BO-6						
AO-1					UNT14x	1	14 AO-1				UNT-2	ABOVE LL1028	0		2-14-AO-1						
AO-2					UNT14x	1	14 AO-2				UNT-2	ABOVE LL1028	0		2-14-AO-2						

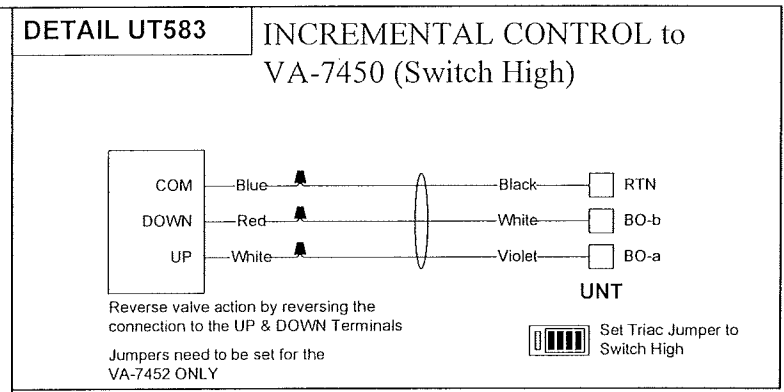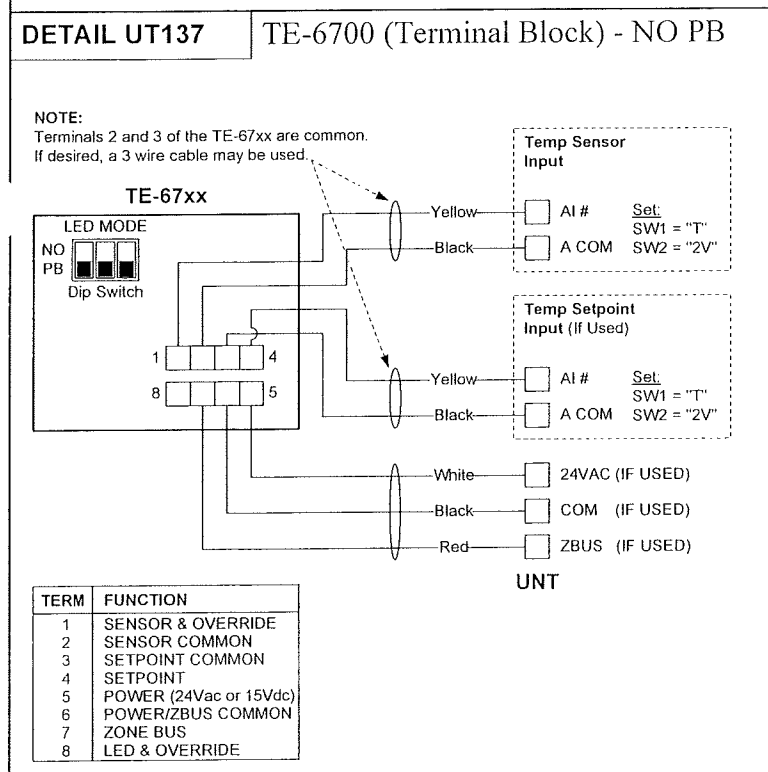


REVISION INFORMATION	Drawing Title				
NUMBER	POINT SCHEDULE				
DATE		REFERENCE DRAWING	NO	REVISION-LOCATION	ECN DATE BY
04/18/08		GLA	SEL	RJM	BY DATE
TIME	Project Title	Branch Information		CONTRACT NUMBER	
10:00 AM	DANE COUNTY COURTHOUSE 215 SOUTH HAMILTON ST. MADISON, WI	Appleton Branch 2140 American Drive Neenah WI 54956 Phone: 920-739-2461 Fax: 920-739-4782		0 3109-0044	
FILE NAME	msdetlps2.vsd	JOHNSON CONTROLS Systems & Services Division		DRAWING NUMBER 14.34	

Electrician/Fitter		Point Information			Controller Information					Panel Information				Intermedi		Field Device					
Tag	Point Type	System Name	Object Name	Expanded ID	Controller Type	Trunk Nbr	Trunk Addr.	Cable Destination Bay/Terminal	Module Type	Termination Out	Panel	Panel Location	Slot Number	Reference Drawing	Cable Number	Wiring /Tubing	Termination In	Device	Location	Ref Detail Shape	Comment
					UNT14x						UNT-1	ABOVE LL2038									Power to Controller N2 Trunk
AI-1	MISC	LL2038-T	Corridor LL2038 Temp		UNT14x	1	13				UNT-1	ABOVE LL2038	0								
AI-2	MISC	LL2040-T	Telecom LL2040 Temp		UNT14x	1	13 AI-1		AI1,A COM		UNT-1	ABOVE LL2038	0		1-13-AI-1	2/18 YEL	1, 2	TE-6700-TE (TB, No PB)		UT137	
AI-3	MISC	LL2041-T	Recv/Screen LL2041 Temp		UNT14x	1	13 AI-2		AI2,A COM		UNT-1	ABOVE LL2038	0		1-13-AI-2	2/18 YEL	1, 2	TE-6700-TE (TB, No PB)		UT137	
AI-4					UNT14x	1	13 AI-3		AI3,A COM		UNT-1	ABOVE LL2038	0		1-13-AI-3	2/18 YEL	1, 2	TE-6700-TE (TB, No PB)		UT137	
AI-5					UNT14x	1	13 AI-4				UNT-1	ABOVE LL2038	0		1-13-AI-4						
AI-6					UNT14x	1	13 AI-5				UNT-1	ABOVE LL2038	0		1-13-AI-5						
BI-1					UNT14x	1	13 BI-1				UNT-1	ABOVE LL2038	0		1-13-BI-1						
BI-2					UNT14x	1	13 BI-2				UNT-1	ABOVE LL2038	0		1-13-BI-2						
BI-3					UNT14x	1	13 BI-3				UNT-1	ABOVE LL2038	0		1-13-BI-3						
BI-4					UNT14x	1	13 BI-4				UNT-1	ABOVE LL2038	0		1-13-BI-4						
BO-1	MISC	RADI-OP	LL2038 Radiation Open		UNT14x	1	13 BO-1		BO-a,BO-b,RTN		UNT-1	ABOVE LL2038	0		1-13-BO-1	3/18 VIO	White, Red, Blue	VA-7450 (Incr) (Sw Hi)		UT583	
BO-2	MISC	RADI-CL	LL2038 Radiation Close		UNT14x	1	13 BO-2				UNT-1	ABOVE LL2038	0		1-13-BO-2						
BO-3	MISC	FCU1-C	LL2040 Fan Coil Cntl		UNT14x	1	13 BO-3		BO3,RTN		UNT-1	ABOVE LL2038	0		1-13-BO-3	2/18 VIO	See wiring detail	24VAC OUT (Sw Hi)		UT501	
BO-4	MISC	FCU1-CLG	Fan Coil 1 DX Clg Cntl		UNT14x	1	13 BO-4		BO4,RTN		UNT-1	ABOVE LL2038	0		1-13-BO-4	2/18 VIO	See wiring detail	24VAC OUT (Sw Hi)		UT501	
BO-5	MISC	FCU2-C	LL2041 Fan Coil Cntl		UNT14x	1	13 BO-5		BO5,RTN		UNT-1	ABOVE LL2038	0		1-13-BO-5	2/18 VIO	See wiring detail	24VAC OUT (Sw Hi)		UT501	
BO-6	MISC	FCU2-HTG	Fan Coil 2 Htg Cntl		UNT14x	1	13 BO-6		BO6,RTN		UNT-1	ABOVE LL2038	0		1-13-BO-6	2/18 VIO	White, White	VA-7010 (On-Off) (Sw Hi)		UT592	
BO-7	MISC	FCU2-CLG	Fan Coil 2 Clg Cntl		UNT14x	1	13 BO-7		BO7,RTN		UNT-1	ABOVE LL2038	0		1-13-BO-7	2/18 VIO	White, White	VA-7010 (On-Off) (Sw Hi)		UT592	
BO-8					UNT14x	1	13 BO-8				UNT-1	ABOVE LL2038	0		1-13-BO-8						

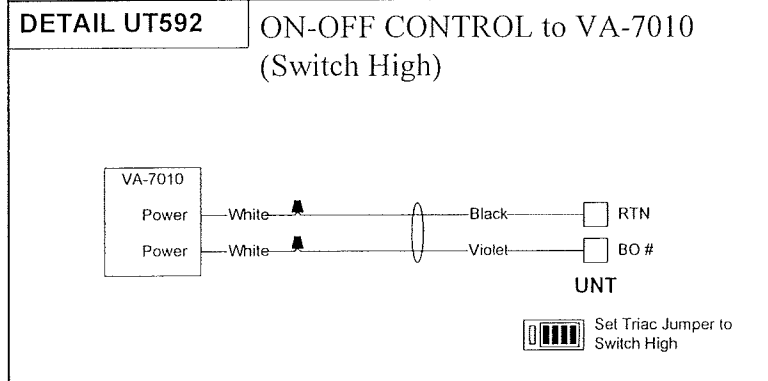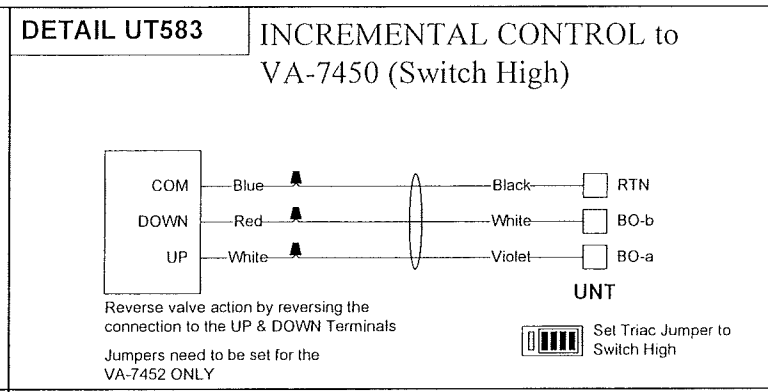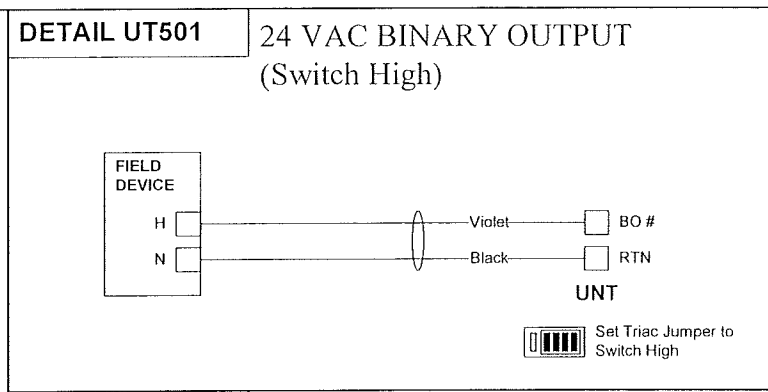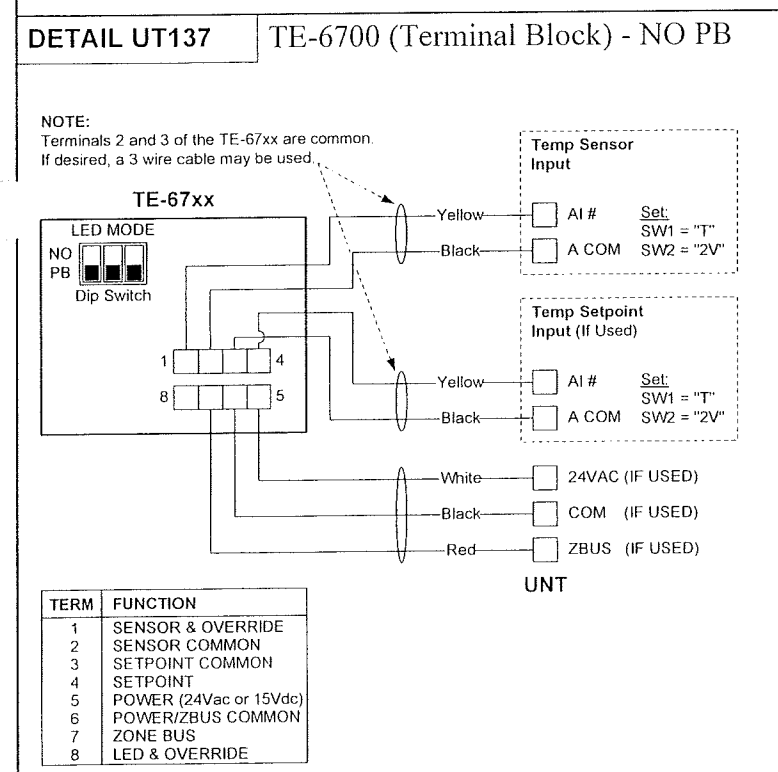

REVISION INFORMATION	Drawing Title				
NUMBER	POINT SCHEDULE				
DATE	04/18/08	REFERENCE DRAWING	NO	REVISION-LOCATION	ECIT DATE BY
TIME	10:01 AM	Sales Engineer	Project Manager	Application Engineer	DRAWN DATE BY APPROVED DATE
FILE NAME	msdetps1.vsd	GLA	SEL	RJM	DATE BY DATE
Project Title		Branch Information		CONTRACT NUMBER	
DANE COUNTY COURTHOUSE 215 SOUTH HAMILTON ST. MADISON, WI		Appleton Branch 2140 American Drive Neenah WI 54956 Phone: 920-739-2461 Fax: 920-739-4782		0 3109-0044	
		JOHNSON CONTROLS Systems & Services Division		DRAWING NUMBER 14.35	

DETAIL N
TYPICAL OF 1

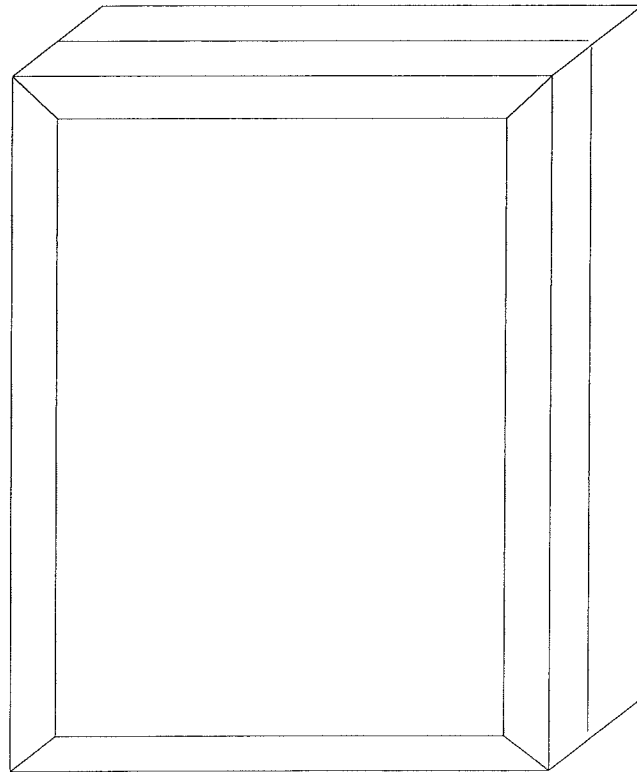

NOTE: A FIRE FIGHTER'S SMOKE CONTROL PANEL WILL BE PROVIDED BY JCI. THE BILL OF MATERIALS WILL BE REVISED AND THE PANEL RESUBMITTED WHEN RFIs ARE ANSWERED AND UPDATED RISER DRAWINGS ARE ISSUED.

FIREMAN'S CONTROL PANEL:


Provide the following functions:
 Auto/Open/Close of combination Fire/Smoke Dampers on a per floor basis.
 Auto/Pressurization/Exhaust of Detention Basement level (SCF-1, EF-3, EF-8, AHU-1).
 Auto/Exhaust of Parking Basement Level (SCF-2 & EF-7).
 Auto/Off Control of AHU-2, 4, 5, 6, 7, 8 Supply Fan.
 Auto/Off Control of RF-2, 4, 5, 6, 7, 8.

REVISION INFORMATION		Drawing Title									
NUMBER		MISCELLANEOUS DETAILS		1		RECORD DRAWINGS		03/30/08		WCS	
DATE		04/16/08		REFERENCE DRAWING		NO.		REVISION-LOCATION		ECH DATE BY	
TIME		01:24 PM		Sales Engineer		Project Manager		Application Engineer		DRAWN APPROVED	
FILE NAME		Msdetn.vsd		GLA		SEL		RJM		BY DATE BY DATE	
Project Title		DANE COUNTY COURTHOUSE 215 SOUTH HAMILTON ST. MADISON, WI 53703		Branch Information		Madison Branch 2400 Kilgust Road Madison WI 53713 Phone: 608-222-9100 Fax: 608-222-9490		CONTRACT NUMBER		0 3109-0044	
				JOHNSON CONTROLS		Systems & Services Division		DRAWING NUMBER		14.36	

BILL OF MATERIALS

Designation	Qty	Part Number	Description
Field Devices:			
SNWMLT-E	1	RIBU1S	10AMP SPST-NO-HOA 10-30VAC/DC/120VAC
V-x	0	VALVE	SEE VALVE SCHEDULE

DETAIL O
TYPICAL OF 1

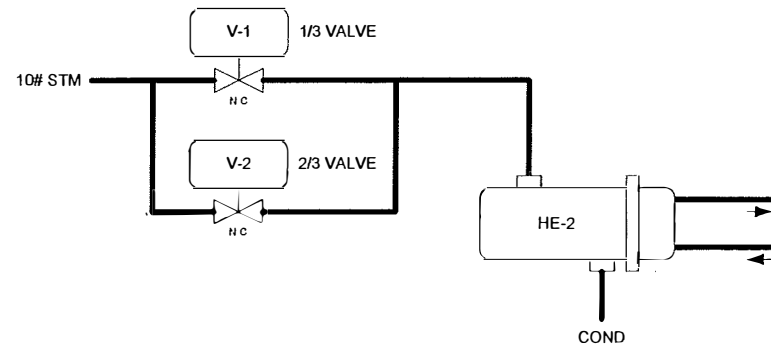

NOTE: WIRING DETAILS NOT AVAILABLE AT TIME OF SUBMITTAL.

SNOWMELT SYSTEM:


All of the control components will be provided with the snowmelt system with the exception of the control valves which will be provided by JCI. JCI will enable the snowmelt system and monitor the run status.

REVISION INFORMATION	Drawing Title								
NUMBER	MISCELLANEOUS DETAILS			1	RECORD DRAWINGS			03/30/08	WCS
DATE		REFERENCE DRAWING	NO.		REVISION-LOCATION	ECN		DATE	BY
04/16/08									
TIME	Project Title	Sales Engineer	Project Manager	Application Engineer	DRAWN	BY	DATE	APPROVED	DATE
01:23 PM	DANE COUNTY COURTHOUSE 215 SOUTH HAMILTON ST. MADISON, WI 53703	GLA	SEL	RJM					
FILE NAME		Branch Information			CONTRACT NUMBER				
Msdeto.vsd		JOHNSON CONTROLS Systems & Services Division			Madison Branch 2400 Kilgust Road Madison WI 53713 Phone: 608-222-9100 Fax: 608-222-9490		0 3109-0044 DRAWING NUMBER 14.37		


Damper Schedule

Tag					Damper Information										*axis dimension do not mount in vertical position.					Actuator Information					Coupled Detail	Comments
Rev	Item	System	Service	Ref. Dwg.	Qty.	Code No.	Fail Pos.	Damper Type	Damper Operation	Blade Type	Bearing Type	Seals	Duct Size		Damper Size			Mtg.	Qty.	Code No.	Pilot	Type	Control Signal	Mtg.		
													W (in.)	H (in.)	W (in.)*	H (in.)	Area (ft²)									
1	EF-9	OA	EA	H1.1	1	IL35	NC	Volume	Parallel	16 Gauge Galv. Stl.	Synthetic	PVC Coated Polyester	138"	36"	138"	36"	34.5	2	M9216-BAA-2	Electric	120vac			INSULATED DAMPER		
2	EF-9	EA	EA	H1.1	1	IL35	NC	Volume	Parallel	16 Gauge Galv. Stl.	Synthetic	PVC Coated Polyester	42"	18"	42"	18"	5.3	1	M9216-BAA-2	Electric	120vac			INSULATED DAMPER		
3	SCF-2	EA (FAN INLET)	EA (FAN INLET)	H1.1	1	BY OTHERS	FULL FLOW	-	-	-	-	-	30.25" Dia.		30.25" Dia.		5.0	1	M9216-HGA-2	Electric	0-10vdc, 0-20mA					
3	AHU-1	EA	EA	H1.2	1	VOPAS-070X034	NC	Volume	Opposed	Double-Piece	Acetal	Santoprene	70"	34"	70"	34"	16.5	1	M9216-HGA-2	Electric	0-10vdc, 0-20mA		A	BLADE-TO-BLADE BRACKET		
4	AHU-1	EA	EA	H1.2	2	DMPR-KC151																				
5	AHU-1	OA	OA	H1.2	1	VOPAS-070X034	NC	Volume	Opposed	Double-Piece	Acetal	Santoprene	70"	34"	70"	34"	16.5	1	M9216-HGA-2	Electric	0-10vdc, 0-20mA		A	BLADE-TO-BLADE BRACKET		
6	AHU-1	OA	OA	H1.2	2	DMPR-KC151																				
7	AHU-1	RA	RA	H1.2	1	VOPAS-070X034	NO	Volume	Opposed	Double-Piece	Acetal	Santoprene	70"	34"	70"	34"	16.5	1	M9216-HGA-2	Electric	0-10vdc, 0-20mA		A	BLADE-TO-BLADE BRACKET		
8	AHU-1	RA	RA	H1.2	2	DMPR-KC151																				
9	AHU-1	FACE & BYPASS	FACE & BYPASS	H1.2	1	BY OTHERS	FACE	-	-	-	-	-														
10	KEF-1	EA	EA	H1.2	1	VPPAS-020X020	NC	Volume	Parallel	Double-Piece	Acetal	Santoprene	20"	20"	20"	20"	2.8	1	M9216-BAA-2	Electric	120vac					
11	EF-6	EA (FAN INLET)	EA (FAN INLET)	H1.2	1	BY OTHERS	FULL FLOW	-	-	-	-	-	17.38" Dia.		17.38" Dia.		1.6	1	M9216-HGA-2	Electric	0-10vdc, 0-20mA					
12	AHU-2	EA	EA	H1.4	1	VOPAS-072X050	NC	Volume	Opposed	Double-Piece	Acetal	Santoprene	72"	50"	72"	50"	25.0	2	M9216-HGA-2	Electric	0-10vdc, 0-20mA		B			
13	AHU-2	OA	OA	H1.4	1	VOPAS-078X034	NC	Volume	Opposed	Double-Piece	Acetal	Santoprene	78"	34"	78"	34"	18.4	1	M9216-HGA-2	Electric	0-10vdc, 0-20mA		A			
14	AHU-2	OA	OA	H1.4	2	DMPR-KC151																				
15	AHU-2	RA	RA	H1.4	1	VOPAS-078X034	NO	Volume	Opposed	Double-Piece	Acetal	Santoprene	78"	34"	78"	34"	18.4	1	M9216-HGA-2	Electric	0-10vdc, 0-20mA		A	BLADE-TO-BLADE BRACKET		
16	AHU-2	RA	RA	H1.4	2	DMPR-KC151																				
17	AHU-2	FACE & BYPASS	FACE & BYPASS	H1.4	1	BY OTHERS	FACE	-	-	-	-	-														
18	AHU-4	EA	EA	H1.6	1	VOPAS-034X046	NC	Volume	Opposed	Double-Piece	Acetal	Santoprene	34"	46"	34"	46"	10.9	1	M9216-HGA-2	Electric	0-10vdc, 0-20mA					
19	AHU-4	OA	OA	H1.6	1	VOPAS-078X034	NC	Volume	Opposed	Double-Piece	Acetal	Santoprene	78"	34"	78"	34"	18.4	1	M9216-HGA-2	Electric	0-10vdc, 0-20mA		A	BLADE-TO-BLADE BRACKET		
20	AHU-4	OA	OA	H1.6	2	DMPR-KC151																				
21	AHU-4	RA	RA	H1.6	1	VOPAS-078X034	NO	Volume	Opposed	Double-Piece	Acetal	Santoprene	78"	34"	78"	34"	18.4	1	M9216-HGA-2	Electric	0-10vdc, 0-20mA		A	BLADE-TO-BLADE BRACKET		
22	AHU-4	RA	RA	H1.6	2	DMPR-KC151																				
23	AHU-4	FACE & BYPASS	FACE & BYPASS	H1.6	1	BY OTHERS	FACE	-	-	-	-	-														
24	AHU-5	EA	EA	H1.7	1	VOPAS-034X046	NC	Volume	Opposed	Double-Piece	Acetal	Santoprene	34"	46"	34"	46"	10.9	1	M9216-HGA-2	Electric	0-10vdc, 0-20mA					
25	AHU-5	OA	OA	H1.7	1	VOPAS-078X034	NC	Volume	Opposed	Double-Piece	Acetal	Santoprene	78"	34"	78"	34"	18.4	1	M9216-HGA-2	Electric	0-10vdc, 0-20mA		A	BLADE-TO-BLADE BRACKET		
26	AHU-5	OA	OA	H1.7	2	DMPR-KC151																				
27	AHU-5	RA	RA	H1.7	1	VOPAS-078X034	NO	Volume	Opposed	Double-Piece	Acetal	Santoprene	78"	34"	78"	34"	18.4	1	M9216-HGA-2	Electric	0-10vdc, 0-20mA		A	BLADE-TO-BLADE BRACKET		
28	AHU-5	RA	RA	H1.7	2	DMPR-KC151																				
29	AHU-5	FACE & BYPASS	FACE & BYPASS	H1.7	1	BY OTHERS	FACE	-	-	-	-	-														
30	AHU-6	EA	EA	H1.8	1	VOPAS-034X046	NC	Volume	Opposed	Double-Piece	Acetal	Santoprene	34"	46"	34"	46"	10.9	1	M9216-HGA-2	Electric	0-10vdc, 0-20mA					
31	AHU-6	OA	OA	H1.8	1	VOPAS-078X034	NC	Volume	Opposed	Double-Piece	Acetal	Santoprene	78"	34"	78"	34"	18.4	1	M9216-HGA-2	Electric	0-10vdc, 0-20mA		A	BLADE-TO-BLADE BRACKET		
32	AHU-6	OA	OA	H1.8	2	DMPR-KC151																				
33	AHU-6	RA	RA	H1.8	1	VOPAS-078X034	NO	Volume	Opposed	Double-Piece	Acetal	Santoprene	78"	34"	78"	34"	18.4	1	M9216-HGA-2	Electric	0-10vdc, 0-20mA		A	BLADE-TO-BLADE BRACKET		
34	AHU-6	RA	RA	H1.8	2	DMPR-KC151																				
35	AHU-6	FACE & BYPASS	FACE & BYPASS	H1.8	1	BY OTHERS	FACE	-	-	-	-	-														
36	AHU-7	EA	EA	H1.9	1	VOPAS-034X046	NC	Volume	Opposed	Double-Piece	Acetal	Santoprene	34"	46"	34"	46"	10.9	1	M9216-HGA-2	Electric	0-10vdc, 0-20mA					
37	AHU-7	OA	OA	H1.9	1	VOPAS-078X034	NC	Volume	Opposed	Double-Piece	Acetal	Santoprene	78"	34"	78"	34"	18.4	1	M9216-HGA-2	Electric	0-10vdc, 0-20mA		A	BLADE-TO-BLADE BRACKET		
38	AHU-7	OA	OA	H1.9	2	DMPR-KC151																				
39	AHU-7	RA	RA	H1.9	1	VOPAS-078X034	NO	Volume	Opposed	Double-Piece	Acetal	Santoprene	78"	34"	78"	34"	18.4	1	M9216-HGA-2	Electric	0-10vdc, 0-20mA		A	BLADE-TO-BLADE BRACKET		
40	AHU-7	RA	RA	H1.9	2	DMPR-KC151																				
41	AHU-7	FACE & BYPASS	FACE & BYPASS	H1.9	1	BY OTHERS	FACE	-	-	-	-	-														
42	AHU-8	EA	EA	H1.10	1	VOPAS-034X046	NC	Volume	Opposed	Double-Piece	Acetal	Santoprene	34"	46"	34"	46"	10.9	1	M9216-HGA-2	Electric	0-10vdc, 0-20mA					
43	AHU-8	OA	OA	H1.10	1	VOPAS-078X030	NC	Volume	Opposed	Double-Piece	Acetal	Santoprene	78"	30"	78"	30"	16.3	1	M9216-HGA-2	Electric	0-10vdc, 0-20mA		A	BLADE-TO-BLADE BRACKET		
44	AHU-8	OA	OA	H1.10	2	DMPR-KC151																				
45	AHU-8	RA	RA	H1.10	1	VOPAS-078X030	NO	Volume	Opposed	Double-Piece	Acetal	Santoprene	78"	30"	78"	30"	16.3	1	M9216-HGA-2	Electric	0-10vdc, 0-20mA		A	BLADE-TO-BLADE BRACKET		
46	AHU-8	RA	RA	H1.10	2	DMPR-KC151																				
47	AHU-8	FACE & BYPASS	FACE & BYPASS	H1.10	1	BY OTHERS	FACE	-	-	-	-	-														


DETAIL A

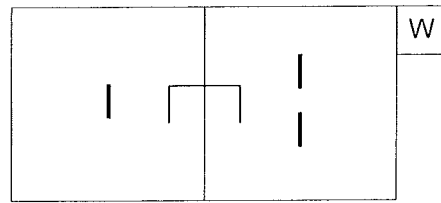


DETAIL B

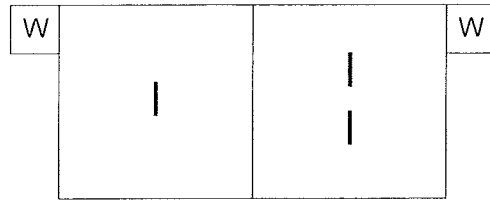


DETAIL C

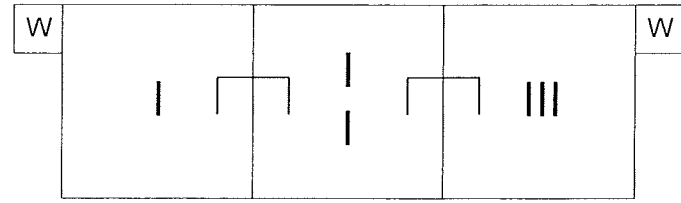


DETAIL D

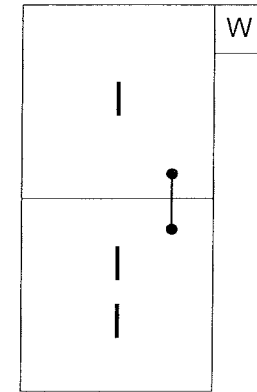


DETAIL E

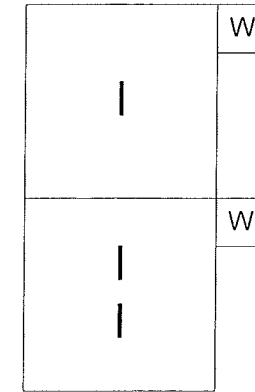


DETAIL F

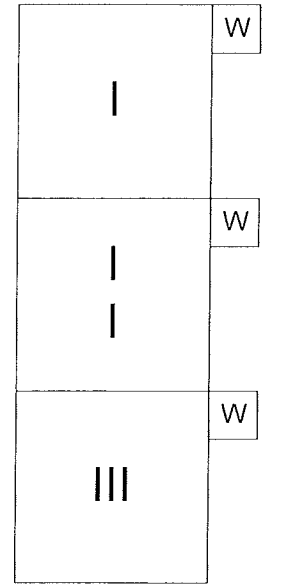


DETAIL G

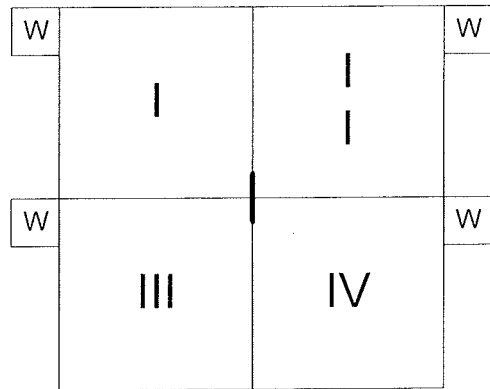


DETAIL H

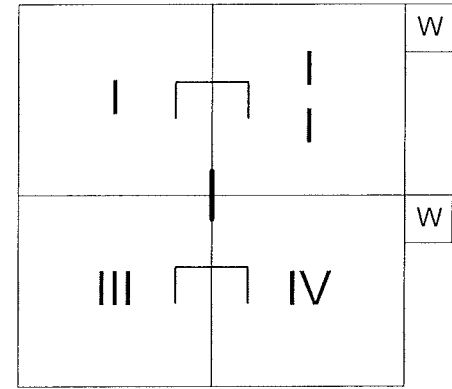


DETAIL I

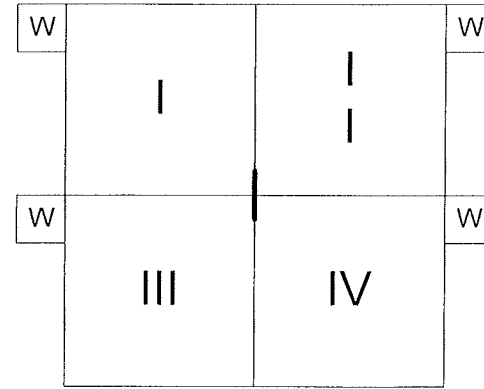

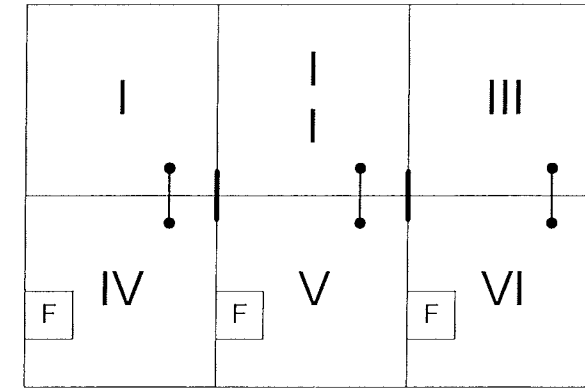



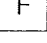
DETAIL J

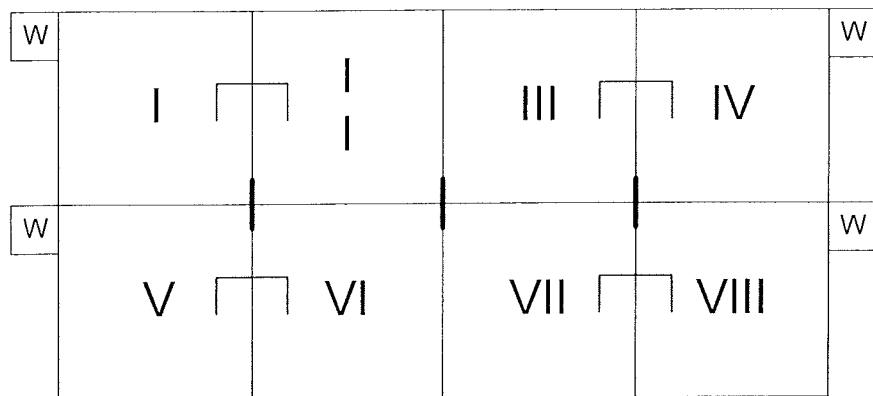



DETAIL K

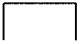

LEGEND

-  DMPR-KC151 (1) REQUIRED FOR EVERY 24" OF DAMPER HEIGHT
-  DMPR-KC100
-  DMPR-KC200 (1) <= FOUR BLADES
(2) >= FOUR BLADES
-  WALL MOUNTED ACTUATOR
-  FRAME MOUNTED ACTUATOR

NOTE:

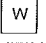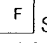THE  AND  SYMBOLS ARE SHOWN ONLY TO INDICATE THE TYPE OF MOUNTING FOR ACTUATORS. SEE PRODUCT LITERATURE FOR PREFERRED DRIVING BLADES. SEE DAMPER SCHEDULE FOR QUANTITIES OF ACTUATORS REQUIRED.

REVISION INFORMATION		Drawing Title									
NUMBER		DAMPER SCHEDULE DETAILS		1		RECORD DRAWINGS		03/30/08		WCS	
DATE		03/31/08		REFERENCE DRAWING		NO.		REVISION-LOCATION		EGR DATE BY	
TIME		11:43 PM		Sales Engineer		Project Manager		Application Engineer		DRAWN APPROVED	
FILE NAME		Dpr-det.vsd		GLA		SEL		RJM		BY DATE	
Project Title		DANE COUNTY COURTHOUSE 215 SOUTH HAMILTON ST. MADISON, WI 53703		Branch Information		CONTRACT NUMBER		0 3109-0044		DRAWING NUMBER	
				JOHNSON CONTROLS Systems & Services Division						D1	

Flow Station Schedule

Tag		Flow Station Information							Transducer Info.			Comments		
Rev.	Item	Service	Ref. dwg.	Qty	Model Type	W (in)	H (in)	Area (ft ²)	Design Flow (CFM)	Design Velocity (ft/m)	Design VP ("wg)		VP Range ("wg)	Code No.
	1	AHU-1 (SUPPLY FAN)	H1.2	1	STA104-F	30.88" Dia.		5.198	31,600	6079.261				PLENUM FAN
	2	AHU-1 (RETURN FAN)	H1.2	1	STA104-F	42.94" Dia.		10.052	31,600	3143.653				PLENUM FAN
	3	AHU-2 (SUPPLY FAN)	H1.4	1	STA104-F	30.88" Dia.		5.198	33,600	6464.025				PLENUM FAN
	4	AHU-2 (RETURN FAN)	H1.4	1	STA104-F	35.25" Dia.		6.774	33,600	4960.142				PLENUM FAN
	5	AHU-4 (SUPPLY FAN)	H1.6	1	STA104-F	17.03" Dia.		3.162	18,850	5961.417				DWDI FAN
	6	AHU-4 (RETURN FAN)	H1.6	1	STA104-F	28.94" Dia.		4.566	18,800	4117.389				PLENUM FAN
	7	AHU-5 (SUPPLY FAN)	H1.7	1	STA104-F	17.03" Dia.		3.162	18,850	5961.417				DWDI FAN
	8	AHU-5 (RETURN FAN)	H1.7	1	STA104-F	28.94" Dia.		4.566	18,800	4117.389				PLENUM FAN
	9	AHU-6 (SUPPLY FAN)	H1.8	1	STA104-F	17.03" Dia.		3.162	18,850	5961.417				DWDI FAN
	10	AHU-6 (RETURN FAN)	H1.8	1	STA104-F	28.94" Dia.		4.566	18,800	4117.389				PLENUM FAN
	11	AHU-7 (SUPPLY FAN)	H1.9	1	STA104-F	17.03" Dia.		3.162	18,850	5961.417				DWDI FAN
	12	AHU-7 (RETURN FAN)	H1.9	1	STA104-F	28.94" Dia.		4.566	18,800	4117.389				PLENUM FAN
	13	AHU-8 (SUPPLY FAN)	H1.10	1	STA104-F	17.03" Dia.		3.162	22,100	6989.247				DWDI FAN
	14	AHU-8 (RETURN FAN)	H1.10	1	STA104-F	28.94" Dia.		4.566	22,100	4840.123				PLENUM FAN


Rev.	Location		Room Controller/Sensor										Reheat Valve					Box Information					Actuator Information				Generate Flag						
	Bldg./Flr.	Room No.	Name	System Name	Ref. dwg.	Controller			Sensor				Serves	Device Code	Valve Body Style	Valve In.	Valve Cv.	Flow GPM	Delta P psi.	Box ID	Box Type	K Factor	Box Type					Code No.	Range	Type	Ref. Detail	Comments	
						PI Sched	N1 Addr	N2 Addr	N3 Addr	CS Model	Inlet Size (Inches)	Inlet Area (Sq Ft)											Cfg Min Flow	Cfg Max Flow	Htg Flow	VMA Box Config							
	SIXTH FLOOR	6048D	COURT REPORTER	AHU-6	H1 8	119	AP-VMA1420-0	3	1	119	TE-67NP-2N00	R-1	VG5240EC+7450G	2-Way	0-1/2"	1.9	0.8	0.2	VAVA-142	VAV	1.91	6	0.2	100	500	250	VMA-3	INTERNAL	0-1.5" WC	SM	B	SERVES TWO SECTIONS OF R-1	
	SIXTH FLOOR	6048D	COURT REPORTER	AHU-6	H1 8	120	AP-VMA1420-0	3	1	120	SERVED BY ABOVE	R-1	VG5240EC+7450G	2-Way	0-1/2"	1.9	0.8	0.2	VAVA-143	VAV	1.91	6	0.2	100	500	250	VMA-3	INTERNAL	0-1.5" WC	SM	B	SERVES ONE SECTION OF R-1	
	SIXTH FLOOR	6049	JUDGES SUITE	AHU-6	H1 8	121	AP-VMA1420-0	3	1	121	SERVED BY ABOVE	RP-1	VG5240EC+7450G	2-Way	0-1/2"	1.9	0.8	0.2	VAVA-144	VAV	1.91	6	0.2	100	500	250	VMA-3	INTERNAL	0-1.5" WC	SM	B	SERVES TWO SECTIONS OF RP-1	
	SIXTH FLOOR	6049C	JUDGES CHAMBER	AHU-6	H1 8	122	AP-VMA1420-0	3	1	122	SERVED BY ABOVE	R-1	VG5240EC+7450G	2-Way	0-1/2"	1.9	0.8	0.2	VAVA-145	VAV	1.91	6	0.2	100	500	250	VMA-3	INTERNAL	0-1.5" WC	SM	B	SERVES ONE SECTION OF R-1	
	SIXTH FLOOR	6050	FUTURE JUDGES SUITE	AHU-6	H1 8	123	AP-VMA1420-0	3	1	123	SERVED BY ABOVE	R-1	VG5240EC+7450G	2-Way	0-1/2"	1.9	0.8	0.2	VAVA-146	VAV	1.91	6	0.2	100	500	250	VMA-3	INTERNAL	0-1.5" WC	SM	B	SERVES ONE SECTION OF R-1	
	SIXTH FLOOR	6051	JUDGES SUITE	AHU-6	H1 8	124	AP-VMA1420-0	3	1	124	SERVED BY ABOVE	RP-1	VG5240EC+7450G	2-Way	0-1/2"	1.9	0.8	0.2	VAVA-147	VAV	1.91	6	0.2	100	500	250	VMA-3	INTERNAL	0-1.5" WC	SM	B	SERVES TWO SECTIONS OF RP-1	
	SIXTH FLOOR	6051C	JUDGES CHAMBER	AHU-6	H1 8	125	AP-VMA1420-0	3	1	125	SERVED BY ABOVE	R-1	VG5240EC+7450G	2-Way	0-1/2"	1.9	0.8	0.2	VAVE-8	VAV	2.20	14	0.96	1000	3000	1500	VMA-1	INTERNAL	0-1.5" WC	SM	A	TEMP SENSOR LOCATED IN EXHAUST DUCT	
	SIXTH FLOOR	6052	FUTURE COURT ROOM	AHU-6	H1 8	126	AP-VMA1420-0	3	1	126	TE-67NP-2N00	R-1	VG5240EC+7450G	2-Way	0-1/2"	1.9	0.8	0.2	VAVA-149	VAV	1.91	6	0.2	100	500	250	VMA-1	INTERNAL	0-1.5" WC	SM	A		
	SIXTH FLOOR	6052	FUTURE COURT ROOM	AHU-6	H1 8	127	AP-VMA1420-0	3	1	127	TE-67NP-2N00	R-1	VG5240EC+7450G	2-Way	0-1/2"	1.9	0.8	0.2	VAVA-150	VAV	1.91	6	0.2	100	500	250	VMA-5	INTERNAL	0-1.5" WC	SM	C	TEMP SENSOR LOCATED IN EXHAUST DUCT	
	SIXTH FLOOR	6052	FUTURE COURT ROOM	AHU-6	H1 8	128	AP-VMA1420-0	3	1	128	TE-67NP-2N00	R-1	VG5240EC+7450G	2-Way	0-1/2"	1.9	0.8	0.2	VAVE-9	VAV	2.20	14	0.96	1000	3000	1500	VMA-1	INTERNAL	0-1.5" WC	SM	A		
	SIXTH FLOOR	6052	FUTURE COURT ROOM	AHU-6	H1 8	129	AP-VMA1420-0	3	1	129	TE-67NP-2N00	R-1	VG5240EC+7450G	2-Way	0-1/2"	1.9	0.8	0.2	VAVA-151	VAV	1.91	6	0.2	100	500	250	VMA-1	INTERNAL	0-1.5" WC	SM	A		
	SIXTH FLOOR	6052	FUTURE COURT ROOM	AHU-6	H1 8	130	AP-VMA1420-0	3	1	130	TE-67NP-2N00	R-1	VG5240EC+7450G	2-Way	0-1/2"	1.9	0.8	0.2	VAVA-152	VAV	1.91	6	0.2	100	500	250	VMA-1	INTERNAL	0-1.5" WC	SM	A		
	SIXTH FLOOR	6052	FUTURE COURT ROOM	AHU-6	H1 8	131	AP-VMA1420-0	3	1	131	TE-67NP-2N00	R-1	VG5240EC+7450G	2-Way	0-1/2"	1.9	0.8	0.2	VAVE-12	VAV	2.20	14	0.96	1000	3000	1500	VMA-1	INTERNAL	0-1.5" WC	SM	A		
	SIXTH FLOOR	6052	FUTURE COURT ROOM	AHU-6	H1 8	132	AP-VMA1420-0	3	1	132	TE-67NP-2N00	R-1	VG5240EC+7450G	2-Way	0-1/2"	1.9	0.8	0.2	VAVE-13	VAV	2.20	14	0.96	1000	3000	1500	VMA-1	INTERNAL	0-1.5" WC	SM	A		
	SIXTH FLOOR	6080	OFFICE	AHU-6	H1 19						SERVED BY ABOVE	R-1	VG5240EC+7450G	2-Way	0-1/2"	1.9	1.2	0.4														SERVES TWO SECTIONS OF R-1	
	SIXTH FLOOR	ST-A	STAIR A	AHU-6	H1 19		T265-18C					CUH-4	VG5240EC+7010A	2-Way	0-1/2"	1.9	1.0	0.3															
	SIXTH FLOOR	ST-D	STAIR C LANDING	AHU-6	H1 19		T265-18C					CUH-3	VG5240EC+7010A	2-Way	0-1/2"	1.9	1.0	0.3															
	SIXTH FLOOR	ST-D	STAIR C LANDING	AHU-6	H1 19		T265-18C					CUH-3	VG5240EC+7010A	2-Way	0-1/2"	1.9	1.0	0.3															
	SEVENTH FLOOR	7003	LOBBY	AHU-7	H1 9	133	AP-VMA1420-0	3	1	133	TE-67NP-2N00	R-1	VG5240EC+7450G	2-Way	0-1/2"	1.9	2.0	1.1	VAVC-14	VAV	1.89	10	0.53	500	1500	750	VMA-1	INTERNAL	0-1.5" WC	SM	A		
	SEVENTH FLOOR	7003	LOBBY	AHU-7	H1 9	146	AP-VMA1420-0	3	2	146	TE-67NP-2N00	R-1	VG5240EC+7450G	2-Way	0-1/2"	1.9	3.0	2.5	VAVD-10	VAV	2.38	12	0.77	700	2100	1050	VMA-1	INTERNAL	0-1.5" WC	SM	A		
	SEVENTH FLOOR	7005	CORRIDOR	AHU-7	H1 9	134	AP-VMA1420-0	3	1	134	TE-67NP-2N00	R-1	VG5240EC+7450G	2-Way	0-1/2"	1.9	0.8	0.2	VAVA-153	VAV	1.91	6	0.2	100	500	250	VMA-1	INTERNAL	0-1.5" WC	SM	A		
	SEVENTH FLOOR	7005	CORRIDOR	AHU-7	H1 9	135	AP-VMA1420-0	3	1	135	TE-67NP-2N00	R-1	VG5240EC+7450G	2-Way	0-1/2"	1.9	0.8	0.2	VAVA-154	VAV	1.91	6	0.2	100	500	250	VMA-1	INTERNAL	0-1.5" WC	SM	A		
	SEVENTH FLOOR	7006	CORRIDOR	AHU-7	H1 9	136	AP-VMA1420-0	3	1	136	TE-67NP-2N00	R-1	VG5240EC+7450G	2-Way	0-1/2"	1.9	0.8	0.2	VAVA-155	VAV	1.91	6	0.2	100	500	250	VMA-1	INTERNAL	0-1.5" WC	SM	A		
	SEVENTH FLOOR	7010	JURY DELIBERATIONS	AHU-7	H1 9	137	AP-VMA1420-0	3	1	137	TE-67NP-2N00	R-1	VG5240EC+7450G	2-Way	0-1/2"	1.9	0.8	0.2	VAVA-156	VAV	1.91	6	0.2	100	500	250	VMA-1	INTERNAL	0-1.5" WC	SM	A		
	SEVENTH FLOOR	7011	MEDIA ROOM	AHU-7	H1 9	138	AP-VMA1420-0	3	1	138	TE-67NP-2N00	R-1	VG5240EC+7450G	2-Way	0-1/2"	1.9	0.8	0.2	VAVA-157	VAV	1.91	6	0.2	100	500	250	VMA-1	INTERNAL	0-1.5" WC	SM	A		
	SEVENTH FLOOR	7012	COURT ROOM	AHU-7	H1 9	139	AP-VMA1420-0	3	1	139	TE-67NP-2N00	R-1	VG5240EC+7450G	2-Way	0-1/2"	1.9	3.0	2.5	VAVD-11	VAV	2.38	12	0.77	700	2100	1050	VMA-1	INTERNAL	0-1.5" WC	SM	A		
	SEVENTH FLOOR	7015	CONFERENCE ROOM	AHU-7	H1 9	140	AP-VMA1420-0	3	1	140	TE-67NP-2N00	R-1	VG5240EC+7450G	2-Way	0-1/2"	1.9	0.8	0.2	VAVA-158	VAV	1.91	6	0.2	100	500	250	VMA-1	INTERNAL	0-1.5" WC	SM	A		
	SEVENTH FLOOR	7019	CONFERENCE ROOM	AHU-7	H1 9	141	AP-VMA1420-0	3	1	141	TE-67NP-2N00	R-1	VG5240EC+7450G	2-Way	0-1/2"	1.9	0.8	0.2	VAVA-159	VAV	1.91	6	0.2	100	500	250	VMA-1	INTERNAL	0-1.5" WC	SM	A		
	SEVENTH FLOOR	7025	HOLDING	AHU-7	H1 9	142	AP-VMA1420-0	3	1	142	TE-67NP-2N00	R-1	VG5240EC+7450G	2-Way	0-1/2"	1.9	0.8	0.2	VAVA-160	VAV	1.91	6	0.2	100	500	250	VMA-5	INTERNAL	0-1.5" WC	SM	C	TEMP SENSOR LOCATED IN EXHAUST DUCT	
	SEVENTH FLOOR	7027	COURT ROOM	AHU-7	H1 9	143	AP-VMA1420-0	3	1	143	TE-67NP-2N00	R-1	VG5240EC+7450G	2-Way	0-1/2"	1.9	3.0	2.5	VAVD-12	VAV	2.38	12	0.77	700	2100	1050	VMA-1	INTERNAL	0-1.5" WC	SM	A		
	SEVENTH FLOOR	7028	CONFERENCE ROOM	AHU-7	H1 9	144	AP-VMA1420-0	3	1	144	TE-67NP-2N00	R-1	VG5240EC+7450G	2-Way	0-1/2"	1.9	0.8	0.2	VAVA-161	VAV	1.91	6	0.2	100	500	250	VMA-1	INTERNAL	0-1.5" WC	SM	A		
	SEVENTH FLOOR	7031	JURY DELIBERATIONS	AHU-7	H1 9	145	AP-VMA1420-0	3	1	145	TE-67NP-2N00	R-1	VG5240EC+7450G	2-Way	0-1/2"	1.9	1.4	0.5	VAVB-43	VAV	2.10	8	0.35	250	1000	500	VMA-1	INTERNAL	0-1.5" WC	SM	A		
	SEVENTH FLOOR	7040	CORRIDOR	AHU-7	H1 9	147	AP-VMA1420-0	3	2	147	TE-67NP-2N00	R-1	VG5240EC+7450G	2-Way	0-1/2"	1.9	0.8	0.2	VAVA-162	VAV	1.91	6	0.2	100	500	250	VMA-1	INTERNAL	0-1.5" WC	SM	A		
	SEVENTH FLOOR	7041	OFFICE	AHU-7	H1 9	148	AP-VMA1420-0	3	2	148	TE-67NP-2N00	R-1	VG5240EC+7450G	2-Way	0-1/2"	1.9	1.4	0.5	VAVB-44	VAV	2.10	8	0.35	250	1000	500	VMA-1	INTERNAL	0-1.5" WC	SM	A		
	SEVENTH FLOOR	7048	JUDGES SUITE	AHU-7	H1 9	149	AP-VMA1420-0	3	2	149	TE-67NP-2N00	R-1	VG5240EC+7450G	2-Way	0-1/2"	1.9	0.8	0.2	VAVA-163	VAV	1.91	6	0.2	100	500	250	VMA-3	INTERNAL	0-1.5" WC	SM	B	SERVES ONE SECTION OF R-1	
	SEVENTH FLOOR	7048	JUDGES SUITE	AHU-7	H1 20						SERVED BY ABOVE	R-1	VG5240EC+7450G	2-Way	0-1/2"	1.9	0.3	0.0															
	SEVENTH FLOOR	7048C	JUDGES CHAMBER	AHU-7	H1 9	150	AP-VMA1420-0	3	2	150	TE-67NP-2N00	R-1	VG5240EC+7450G	2-Way	0-1/2"	1.9	0.8	0.2	VAVA-164	VAV	1.91	6	0.2	100	500	250	VMA-4	INTERNAL	0-1.5" WC	SM	B	SERVES TWO SECTIONS OF RP-1	
	SEVENTH FLOOR	7048C	JUDGES CHAMBER	AHU-7	H1 20						SERVED BY ABOVE	RP-1	VG5240EC+7450G	2-Way	0-1/2"	1.9	0.3	0.0															
	SEVENTH FLOOR	7048D	COURT REPORTER	AHU-7	H1 20	151	AP-VMA1420-0	3	2	151	TE-67NP-2N00	R-1	VG5240EC+7450G	2-Way	0-1/																		

Room Schedule

Location				Room Controller/Sensor					Relief Valve					Box Information					Actuator Information				Comments	Generate Flag												
Rev.	Bldg./Flr.	Room No.	Room Name	System Name	Ref. dwg.	Pt. Sched. N2 Addr.	Controller				Sensor Code No.	Serves	Device Code	Valve				Box Type							VMA Box Config	Code No.	Range	Type	Ref. Detail							
							Code No.	NAE #	N2 Trunk	N2 Addr				CS Model	Body Style	Size In.	Valve Cv	Flow GPM	Delta P psi	Box ID	Box Type	K Factor								Inlet Size (Inches)	Inlet Size (Area)	Cig Min Flow	Cig Max Flow	Hig Flow		
	EIGHTH FLOOR	8065	HOLDING	AHU-8	H1 10	196	AP-V/LA1420-0	3	2	196	TE-631P-1		VG5240EC+7450G	2-Way	0-1/2"	1.9	0.8	0.2	VAVA-200	VAV	191	6	0.2	100	500	250	V/LA-5	INTERNAL	0-1.5' WC	SM	C	TEMP SENSOR LOCATED IN EXHAUST DUCT				
	EIGHTH FLOOR	8067	COURT ROOM	AHU-8	H1 10	197	AP-V/LA1420-0	3	2	197	TE-67NP-2N00		VG5240EC+7450G	2-Way	0-1/2"	1.9	0.8	0.2	VAVA-201	VAV	191	6	0.2	100	500	250	V/LA-1	INTERNAL	0-1.5' WC	SM	A					
	EIGHTH FLOOR	8068	CONFERENCE ROOM	AHU-8	H1 10	198	AP-V/LA1420-0	3	2	198	TE-67NP-2N00		VG5240EC+7450G	2-Way	0-1/2"	1.9	3.0	2.5	VAVE-13	VAV	220	14	0.96	1000	3000	1500	V/LA-1	INTERNAL	0-1.5' WC	SM	A					
	EIGHTH FLOOR	8076	WAITING ROOM	AHU-8	H1 10	199	AP-V/LA1420-0	3	2	199	TE-67NP-2N00		VG5240EC+7450G	2-Way	0-1/2"	1.9	0.8	0.2	VAVA-202	VAV	191	6	0.2	100	500	250	V/LA-1	INTERNAL	0-1.5' WC	SM	A					
	EIGHTH FLOOR	8080	JURY DELIBERATIONS	AHU-8	H1 10	200	AP-V/LA1420-0	3	2	200	TE-67NP-2N00		VG5240EC+7450G	2-Way	0-1/2"	1.9	1.4	0.5	VAVB-48	VAV	210	8	0.35	250	1000	500	V/LA-3	INTERNAL	0-1.5' WC	SM	B					
	EIGHTH FLOOR	8080	JURY DELIBERATIONS		H1 21						SERVED BY ABOVE	R-1	VG5240EC+7450G	2-Way	0-1/2"	1.9	1.4	0.5															SERVES TWO SECTIONS OF R-1			
	EIGHTH FLOOR	ST-A	STAIR A		H1 21		T26S-18C						VG5240EC+7010A	2-Way	0-1/2"	1.9	1.0	0.3																		
	EIGHTH FLOOR	ST-D	STAIR C LANDING		H1 21		T26S-18C						VG5240EC+7010A	2-Way	0-1/2"	1.9	1.0	0.3																		
	EIGHTH FLOOR	ST-D	STAIR D LANDING		H1 21		T26S-18C						VG5240EC+7010A	2-Way	0-1/2"	1.9	1.0	0.3																		
	ROOF	EL-ER	ELEVATOR 'E' MACHINE ROOM		H1 11						BY OTHERS	AC-1																								
	ROOF	EL-FR	ELEVATOR 'F' MACHINE ROOM		H1 11						BY OTHERS	AC-2																								
	ROOF	EL-AR	ELEVATOR 'A-D' MACHINE ROOM		H1 11						BY OTHERS	AC-3																								
	ROOF	EL-AR	ELEVATOR 'A-D' MACHINE ROOM		H1 11						BY OTHERS	AC-4																								
	ROOF	EL-GR	ELEVATOR 'G' MACHINE ROOM		H1 11						BY OTHERS	AC-5																								


Valve Schedule

Tag				Valve Information											Actuator Information				Piping Detail	Comments		
Rev	Item	System	Service	Ref. Dwg.	Qty.	Code Number	Cfg.	Fail Pos.	Pipe Size	Valve Size	Body Cfg.	Close Off	Flow	Valve Coefficient	Design Coefficient	Design Delta P	Valve Delta P	Code No.			Pilot	Type
	1	HE-1 (1/3 Valve) Heating	Steam	H3.2	1	VG2231UM+926GGA	2-Way	NO	5-0/0"	3-0/0"	Flanged	20 psi	2280.0 lb/hr	Cv = 83	Cv = 62.72	7.0 psi	3.7 psi	M9216-GGA-2	None	Electric	0-10vdc	Linkage: M9000-531, sized for 10 psi entering steam
	2	HE-1 (2/3 Valve) Heating	Steam	H3.2	1	VG2231VM2926GGA	2-Way	NO	5-0/0"	4-0/0"	Flanged	23 psi	4560.0 lb/hr	Cv = 150	Cv = 125.44	7.0 psi	4.6 psi	M9216-GGA-2	None	Electric	0-10vdc	Linkage: M9000-532, sized for 10 psi entering steam
	3	HE-2 (1/3 Valve) Snowmelt	Steam	H3.2	1	VG7241LT+946HGA	2-Way	NC	5-0/0"	0-3/4"	Threaded	289 psi	209.0 lb/hr	Cv = 7.3	Cv = 5.75	7.0 psi	4.1 psi	M9216-HGA-2	None	Electric	0-10vdc	Linkage: M9000-500, sized for 10 psi entering steam
	4	HE-2 (2/3 Valve) Snowmelt	Steam	H3.2	1	VG7241NT+946HGA	2-Way	NC	5-0/0"	1-0/0"	Threaded	182 psi	418.0 lb/hr	Cv = 11.6	Cv = 11.50	7.0 psi	6.9 psi	M9216-HGA-2	None	Electric	0-10vdc	Linkage: M9000-500, sized for 10 psi entering steam
	5	CH-1	Condenser Water	H3.2	1	VF4831DE+926GGA	3-Way E	Bypass Tower	6-0/0"	4-0/0"	Flanged	175 psi	720.0 gpm	Cv = 390	Cv = 321.99	5 psi	3.4 psi	M9216-GGA-2	None	Electric	0-10 VDC, 0(4)-20 mA	BFLY STYLE E
	6	CH-2	Condenser Water	H3.2	1	5RL3/DM24-280	3-Way E	Bypass Tower	8-0/0"	5-0/0"	Flanged	50 psi	1200.0 gpm	Cv = 561.1	Cv = 536.66	5 psi	4.6 psi	DM24-280	None	Electric	0-10 VDC, 0(4)-20 mA	BFLY STYLE E
	7	AHU-1	Steam	H3.2	1	VG7241RT+926HGA	2-Way	NO	4-0/0"	1-1/2"	Threaded	71 psi	921.9 lb/hr	Cv = 28.9	Cv = 25.36	7.0 psi	5.2 psi	M9216-HGA-2	None	Electric	0-10vdc	Linkage: M9000-500
	8	AHU-1	Chilled Water	H3.2	1	VG2231VM2924GGA	2-Way	Last Position	4-0/0"	4-0/0"	Flanged	49 psi	225.9 gpm	Cv = 150	Cv = 101.03	5 psi	2.3 psi	M9124-GGA-2	None	Electric	0-10vdc	Linkage: M9000-532
	9	AHU-2	Steam	H1.15	1	VG7241RT+926HGA	2-Way	NO	3-0/0"	1-1/2"	Threaded	71 psi	781.3 lb/hr	Cv = 28.9	Cv = 21.49	7.0 psi	3.6 psi	M9216-HGA-2	None	Electric	0-10vdc	Linkage: M9000-500
	10	AHU-2	Chilled Water	H1.15	1	VG2231VM2924GGA	2-Way	Last Position	4-0/0"	4-0/0"	Flanged	49 psi	270.8 gpm	Cv = 150	Cv = 121.11	5 psi	3.3 psi	M9124-GGA-2	None	Electric	0-10vdc	Linkage: M9000-532
	11	AHU-4	Steam	H1.17	1	VG7241RT+926HGA	2-Way	NO	3-0/0"	1-1/2"	Threaded	71 psi	750.6 lb/hr	Cv = 28.9	Cv = 20.65	7.0 psi	3.3 psi	M9216-HGA-2	None	Electric	0-10vdc	Linkage: M9000-500
	12	AHU-4	Chilled Water	H1.17	1	VG2231UM+924GGA	2-Way	Last Position	3-0/0"	3-0/0"	Flanged	43 psi	143.2 gpm	Cv = 83	Cv = 64.04	5 psi	3.0 psi	M9124-GGA-2	None	Electric	0-10vdc	Linkage: M9000-531
	13	AHU-5	Steam	H1.18	1	VG7241RT+926HGA	2-Way	NO	3-0/0"	1-1/2"	Threaded	71 psi	750.6 lb/hr	Cv = 28.9	Cv = 20.65	7.0 psi	3.3 psi	M9216-HGA-2	None	Electric	0-10vdc	Linkage: M9000-500
	14	AHU-5	Chilled Water	H1.18	1	VG2231UM+924GGA	2-Way	Last Position	3-0/0"	3-0/0"	Flanged	43 psi	143.2 gpm	Cv = 83	Cv = 64.04	5 psi	3.0 psi	M9124-GGA-2	None	Electric	0-10vdc	Linkage: M9000-531
	15	AHU-6	Steam	H1.19	1	VG7241RT+926HGA	2-Way	NO	3-0/0"	1-1/2"	Threaded	71 psi	750.6 lb/hr	Cv = 28.9	Cv = 20.65	7.0 psi	3.3 psi	M9216-HGA-2	None	Electric	0-10vdc	Linkage: M9000-500
	16	AHU-6	Chilled Water	H1.19	1	VG2231UM+924GGA	2-Way	Last Position	3-0/0"	3-0/0"	Flanged	43 psi	143.2 gpm	Cv = 83	Cv = 64.04	5 psi	3.0 psi	M9124-GGA-2	None	Electric	0-10vdc	Linkage: M9000-531
	17	AHU-7	Steam	H1.20	1	VG7241RT+926HGA	2-Way	NO	3-0/0"	1-1/2"	Threaded	71 psi	750.6 lb/hr	Cv = 28.9	Cv = 20.65	7.0 psi	3.3 psi	M9216-HGA-2	None	Electric	0-10vdc	Linkage: M9000-500
	18	AHU-7	Chilled Water	H1.20	1	VG2231UM+924GGA	2-Way	Last Position	3-0/0"	3-0/0"	Flanged	43 psi	143.2 gpm	Cv = 83	Cv = 64.04	5 psi	3.0 psi	M9124-GGA-2	None	Electric	0-10vdc	Linkage: M9000-531
	19	AHU-8	Steam	H1.21	1	VG7241RT+926HGA	2-Way	NO	3-0/0"	1-1/2"	Threaded	71 psi	750.6 lb/hr	Cv = 28.9	Cv = 20.65	7.0 psi	3.3 psi	M9216-HGA-2	None	Electric	0-10vdc	Linkage: M9000-500
	20	AHU-8	Chilled Water	H1.21	1	VG2831UM2924GGA	3-Way Mix	Last Position	3-0/0"	3-0/0"	Flanged	53 psi	171.9 gpm	Cv = 80	Cv = 76.88	5 psi	4.6 psi	M9124-GGA-2	None	Electric	0-10vdc	E Linkage: M9000-532
	21	VAV-A	Hot Water		202	VG5240EC+7450G	2-Way	Last Position	0-1/2"	Threaded	30 psi	0.8 gpm	Cv = 1.9	Cv = 0.36	5 psi	0.2 psi	VA-7450-10011	None	Electric	24vac	Room Schedule Valves	
	22	VAV-B	Hot Water		48	VG5240EC+7450G	2-Way	Last Position	0-1/2"	Threaded	30 psi	1.4 gpm	Cv = 1.9	Cv = 0.63	5 psi	0.5 psi	VA-7450-10011	None	Electric	24vac	Room Schedule Valves	
	23	VAV-C	Hot Water		15	VG5240EC+7450G	2-Way	Last Position	0-1/2"	Threaded	30 psi	2.0 gpm	Cv = 1.9	Cv = 0.89	5 psi	1.1 psi	VA-7450-10011	None	Electric	24vac	Room Schedule Valves	
	24	VAV-D	Hot Water		15	VG5240EC+7450G	2-Way	Last Position	0-1/2"	Threaded	30 psi	3.0 gpm	Cv = 1.9	Cv = 1.34	5 psi	2.5 psi	VA-7450-10011	None	Electric	24vac	Room Schedule Valves	
	25	VAV-E	Hot Water		13	VG5240EC+7450G	2-Way	Last Position	0-1/2"	Threaded	30 psi	3.0 gpm	Cv = 1.9	Cv = 1.34	5 psi	2.5 psi	VA-7450-10011	None	Electric	24vac	Room Schedule Valves	
	26	R-1, RP-1	Hot Water		107	VG5240EC+7450G	2-Way	Last Position	0-1/2"	Threaded	30 psi	4.0 gpm	Cv = 1.9	Cv = 1.79	5 psi	4.4 psi	VA-7450-10011	None	Electric	24vac	Room Schedule Valves	
	27	R-1, RP-1	Hot Water		2	VG7241GT+7150G	2-Way	Last Position	0-1/2"	Threaded	216 psi	8.0 gpm	Cv = 4.6	Cv = 3.58	5 psi	3.0 psi	VA-7150-1001	None	Electric	24vac	Room Schedule Valves	
	28	R-1, RP-1	Hot Water		1	VG7241LT+7150G	2-Way	Last Position	0-3/4"	Threaded	138 psi	13.7 gpm	Cv = 7.3	Cv = 6.13	5 psi	3.5 psi	VA-7150-1001	None	Electric	24vac	Room Schedule Valve	
	29	CUH, UH	Hot Water		29	VG5240EC+7010A	2-Way	NO	0-1/2"	Threaded	30 psi	2.5 gpm	Cv = 1.9	Cv = 1.12	5 psi	1.7 psi	VA-7010-8002	None	Electric	120vac	Room Schedule Valves	
	30	FCU-2	Hot Water		1	VG5240EC+7010G	2-Way	NO	0-1/2"	Threaded	30 psi	0.5 gpm	Cv = 1.9	Cv = 0.22	5 psi	0.1 psi	VA-7010-8001	None	Electric	24vac	Room Schedule Valve	
	31	FCU-2	Chilled Water		1	VG5440EC+7010G	2-Way	NC	0-1/2"	Threaded	30 psi	1.0 gpm	Cv = 1.9	Cv = 0.45	5 psi	0.3 psi	VA-7010-8001	None	Electric	24vac	Room Schedule Valve	

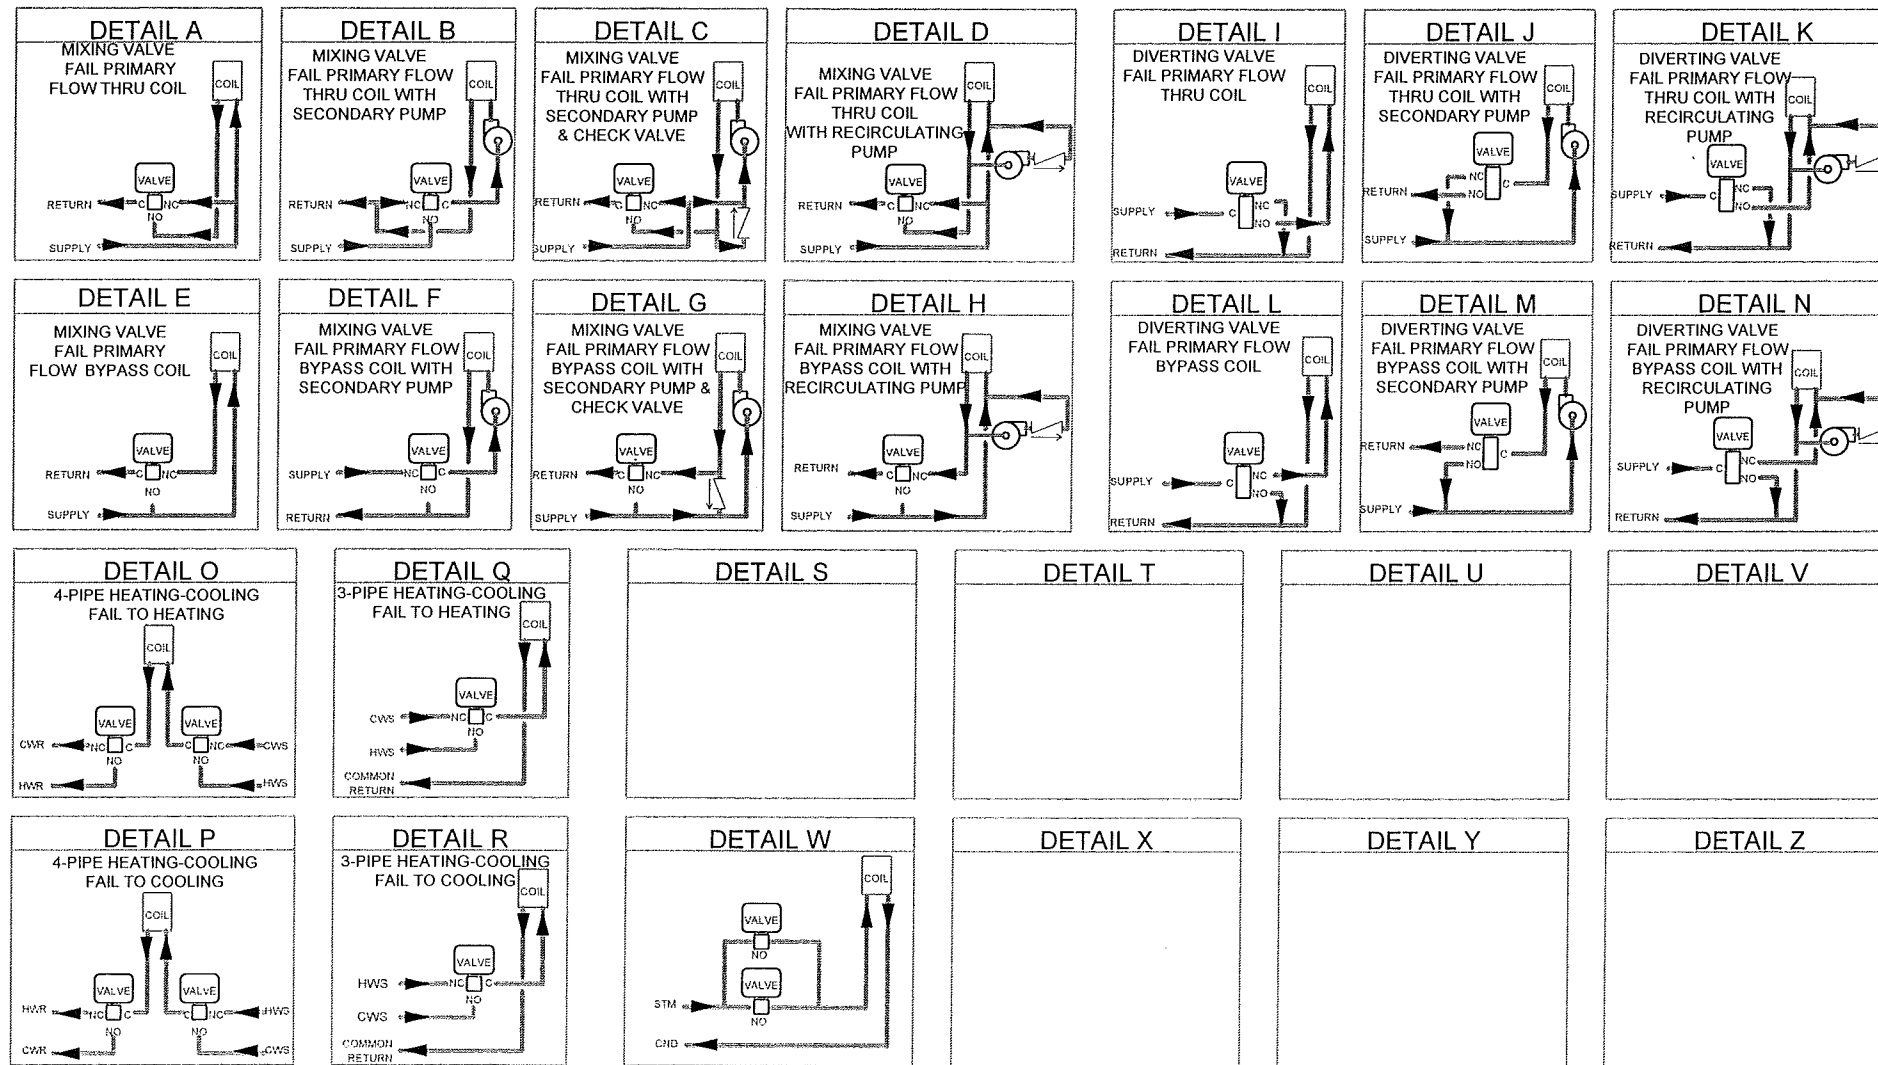

BUTTERFLY VALVE CONFIGURATIONS

NOTE: THE BUTTERFLY VALVE CONFIGURATIONS SHOWN REPRESENT A VIEW FROM THE ACTUATOR SIDE OF THE VALVE BODY

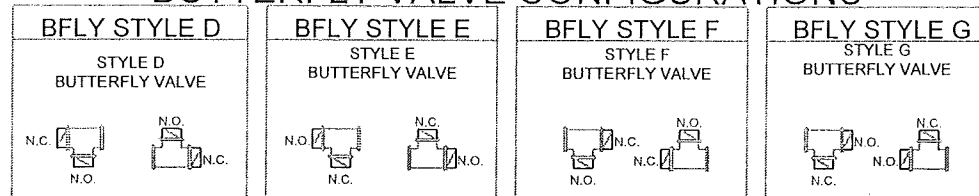

REVISION INFORMATION	Drawing Title								
NUMBER	VALVE SCHEDULE DETAILS			1		RECORD DRAWINGS		03/30/08	WCS
DATE	03/31/08	REFERENCE DRAWING		NO.		REVISION-LOCATION		ECN	DATE
TIME	11:45 PM	Sales Engineer		Project Manager		Application Engineer		BY	APPROVED
FILE NAME	Vlv-det.vsd	GLA		SEL		RJM		BY	DATE
Project Title		DANE COUNTY COURTHOUSE		215 SOUTH HAMILTON ST.		MADISON, WI 53703		CONTRACT NUMBER	
		JOHNSON CONTROLS		Systems & Services Division				0 3109-0044	
								DRAWING NUMBER	
								D2	


Well/Tap/Meter Schedule

Tag Information				Well Information							Sensor Information			Comments		
Rev.	Item	System	Service	Ref. Sensor	Ref. dwg.	Line Size (in.)	Location	Code No.	Material	Stem Length (in.)	Thread Type	Ref. Detail	Tag		Code No.	Detail
WELL																
	1	Hot Water	Hot Water Supply Temperature	H3.1		6-0/0"	LL1012	WZ-1000-5	Brass	2-3/8"	0-1/2" NPT		HWS-T	TE-631AP-1	F	
	2	Chilled Water	Chilled Water Supply Temperature	H3.1		8-0/0"	LL1012	WZ-1000-5	Brass	2-3/8"	0-1/2" NPT		CHS-T	TE-631AP-1	F	
	3	Chilled Water	Chilled Water Return Temperature	H3.1		8-0/0"	LL1012	WZ-1000-5	Brass	2-3/8"	0-1/2" NPT		CHR-T	TE-631AP-1	F	
	4	Condenser Water	Common Condenser Water Supply Temperature	H3.1		10-0/0"	LL1012	WZ-1000-5	Brass	2-3/8"	0-1/2" NPT		CWS-T	TE-631AP-1	F	
	5	Condenser Water	CT-1 Condenser Water Supply Temperature	H3.1		6-0/0"	Above 8031	WZ-1000-5	Brass	2-3/8"	0-1/2" NPT		CT1S-T	TE-631AP-1	F	
	6	Condenser Water	CT-1 Condenser Water Return Temperature	H3.1		6-0/0"	Above 8031	WZ-1000-5	Brass	2-3/8"	0-1/2" NPT		CT1R-T	TE-631AP-1	F	
	7	Condenser Water	CT-2A Condenser Water Supply Temperature	H3.1		6-0/0"	Above 8032	WZ-1000-5	Brass	2-3/8"	0-1/2" NPT		CT2AS-T	TE-631AP-1	F	
	8	Condenser Water	CT-2B Condenser Water Supply Temperature	H3.1		6-0/0"	Above 8037	WZ-1000-5	Brass	2-3/8"	0-1/2" NPT		CT2BS-T	TE-631AP-1	F	
	9	Condenser Water	CT-2A & CT-2B Common Condenser Water Return Temperature	H3.1		8-0/0"	Above 8033	WZ-1000-5	Brass	2-3/8"	0-1/2" NPT		CT2ABR-T	TE-631AP-1	F	
METER																
	10	Chilled Water	Bypass Loop Flow	H3.1		6-0/0"	LL1012	-	-	-	1" NPT		CH-FLOW	FB-1211	-	RANGE: 0-1400 GPM, SEE INSTALLATION INSTRUCTIONS WITH METER

DETAIL A

PRESSURE TAP


FOR WATER APPLICATIONS

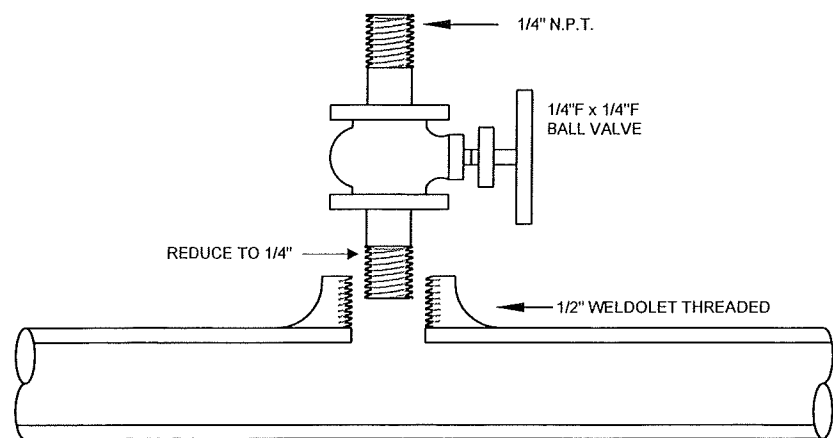

DETAIL B


PRESSURE TAP

FOR STEAM APPLICATIONS

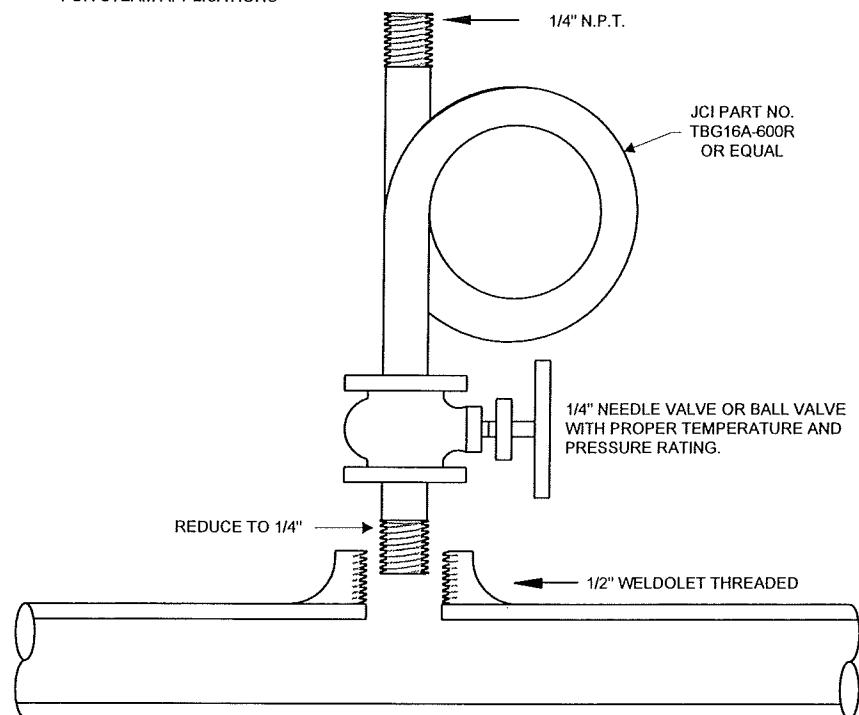


DETAIL C

DIFFERENTIAL PRESSURE

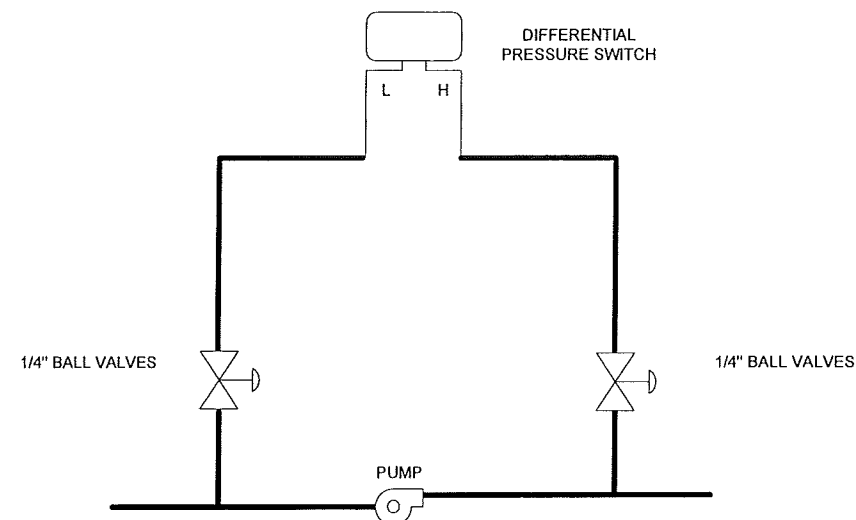


DETAIL D

DIFFERENTIAL PRESSURE

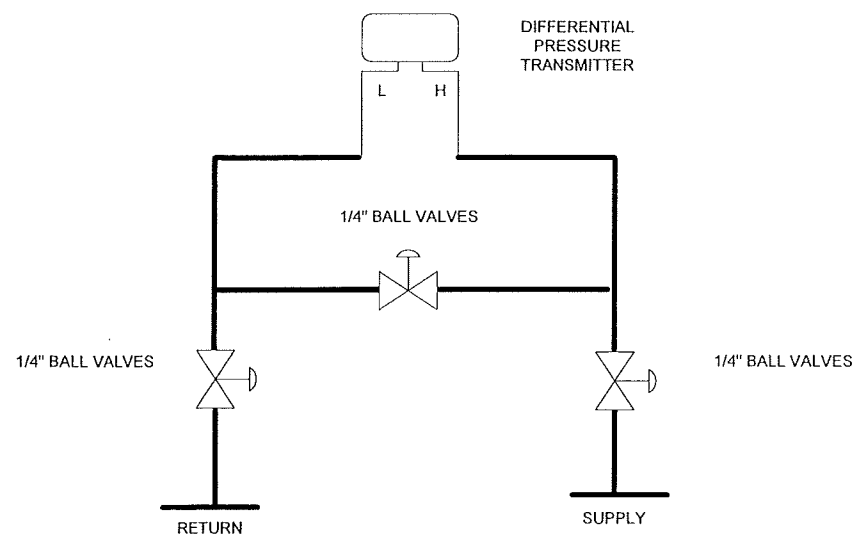

DETAIL E

FLOW SWITCH

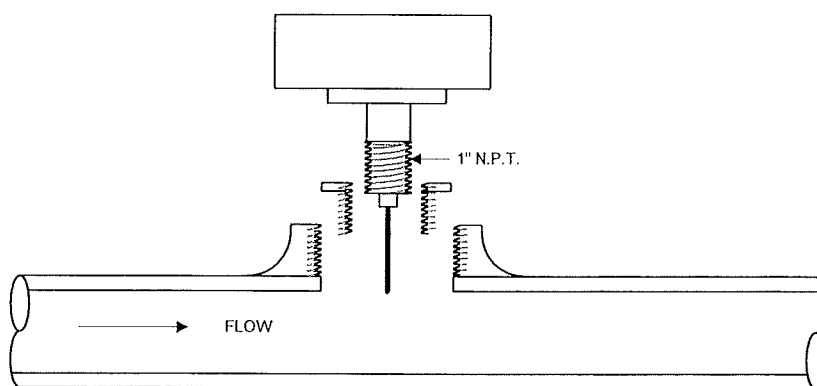

REVISION INFORMATION	Drawing Title								
NUMBER	WELL/TAP/METER SCHEDULE DETAILS	1		RECORD DRAWINGS		03/30/08		WCS	
DATE	03/31/08	REFERENCE DRAWING	NO.	REVISION-LOCATION	ECH	DATE	BY		
TIME	11:48 PM	Sales Engineer	Project Manager	Application Engineer	DRAWN		APPROVED		
FILE NAME	Tap-det.vsd	GLA	SEL	RJM	BY	DATE	BY	DATE	CONTRACT NUMBER
				Branch Information				0 3109-0044	
				JOHNSON CONTROLS Systems & Services Division		Madison Branch 2400 Kilgust Road Madison WI 53713 Phone: 608-222-9100 Fax: 608-222-9490		DRAWING NUMBER D3	

DANE COUNTY COURTHOUSE

BID PACKAGE #2 - COURTHOUSE

215 SOUTH HAMILTON ST.
MADISON, WISCONSIN 53703



THE ARCHITECT, CONTRACTOR, ENGINEER, LANDSCAPE ARCHITECT, AND INTERIOR DESIGNER SHALL BE RESPONSIBLE FOR THE DESIGN AND CONSTRUCTION OF THE PROJECT. THE ARCHITECT SHALL BE RESPONSIBLE FOR THE DESIGN AND CONSTRUCTION OF THE PROJECT. THE CONTRACTOR SHALL BE RESPONSIBLE FOR THE CONSTRUCTION OF THE PROJECT. THE ENGINEER SHALL BE RESPONSIBLE FOR THE DESIGN AND CONSTRUCTION OF THE PROJECT. THE LANDSCAPE ARCHITECT SHALL BE RESPONSIBLE FOR THE DESIGN AND CONSTRUCTION OF THE PROJECT. THE INTERIOR DESIGNER SHALL BE RESPONSIBLE FOR THE DESIGN AND CONSTRUCTION OF THE PROJECT.

CIVIL ENGINEERING: GRANT, ANHOLT, SCHUBERT
LANDSCAPE ARCHITECT: LANDSCAPE ARCHITECTS, INC.
INTERIOR DESIGNER: STOWART DESIGN ASSOCIATES, INC.
ELECTRICAL: LERCH BATES & ASSOCIATES, INC.


REVISIONS

PROJECT NO.	0324.00
DATE	12/5/02
DRAWN BY	DER
CHECKED BY	CFJ
SHEET CONTENTS	
HVAC - LOWER LEVEL 2	
PLAN	


SHEET
H1.1
145 OF 263

ROOM NUMBERS AND NAMES

LL2000	SECURED PARKING
LL2001	SECURED PARKING
LL2002	SECURED PARKING
LL2100	SECURED PARKING

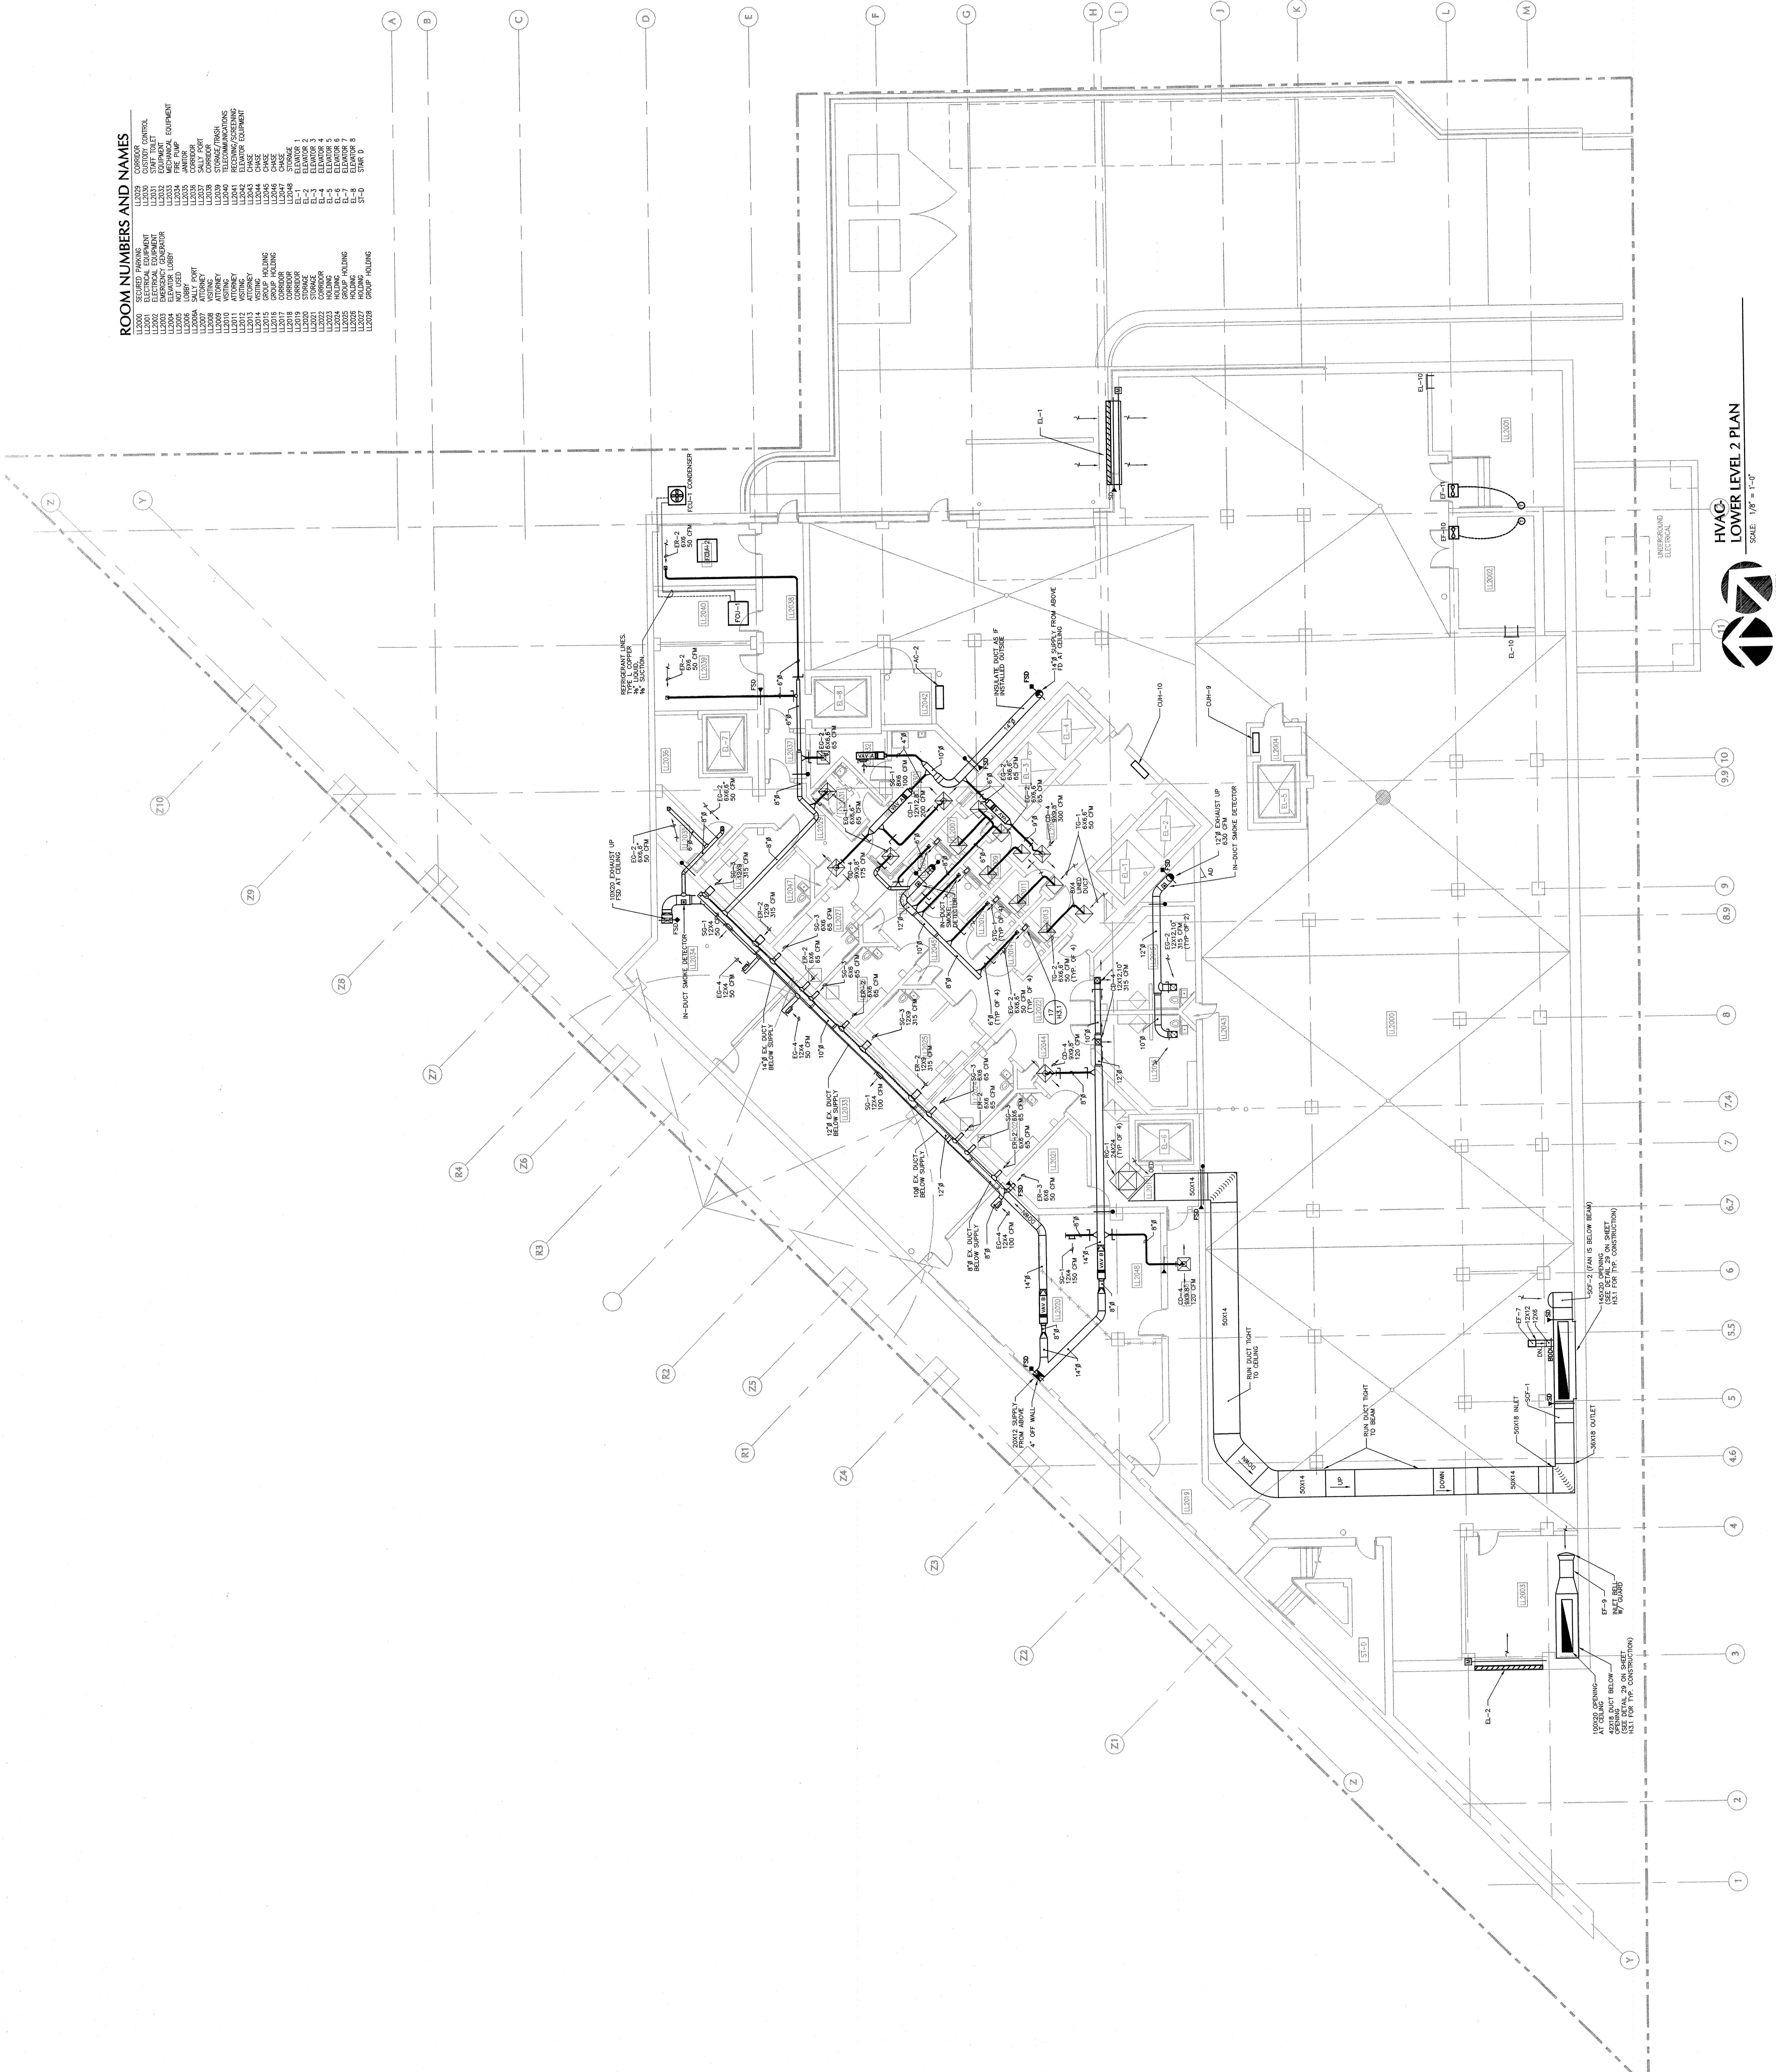

HVAC - LOWER LEVEL 2 PLAN
SCALE: 1/8" = 1'-0"
PLAN NORTH

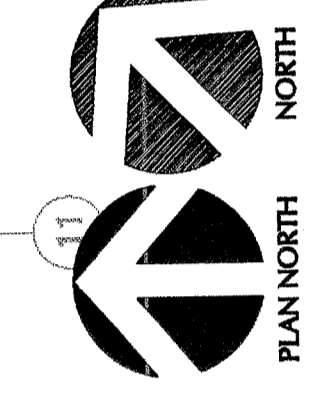

DANE COUNTY COURTHOUSE

BID PACKAGE #2 - COURTHOUSE

215 SOUTH HAMILTON ST.
MADISON, WISCONSIN 53703




THE ARCHITECTS: DARRANT ARCHITECTS, INC.
1000 UNIVERSITY AVENUE, SUITE 200
MADISON, WISCONSIN 53706
TEL: 608.261.1111
WWW.DARRANTARCHITECTS.COM

CIVIL ENGINEERING:
GRAEF, ANHOLT, SCHLOEMER
LANDSCAPE ARCHITECTS, INC.
STEWART KEESON ASSOCS. INC.
LEITCH BATES & ASSOCS. INC.

REVISIONS

PROJECT NO.	03004.00
DATE	12/06/02
DRAWN BY	DER
CHECKED BY	CJF
SHEET CONTENTS	
HVAC	1ST FLOOR PLAN

SHEET
H1.3
147 OF 263

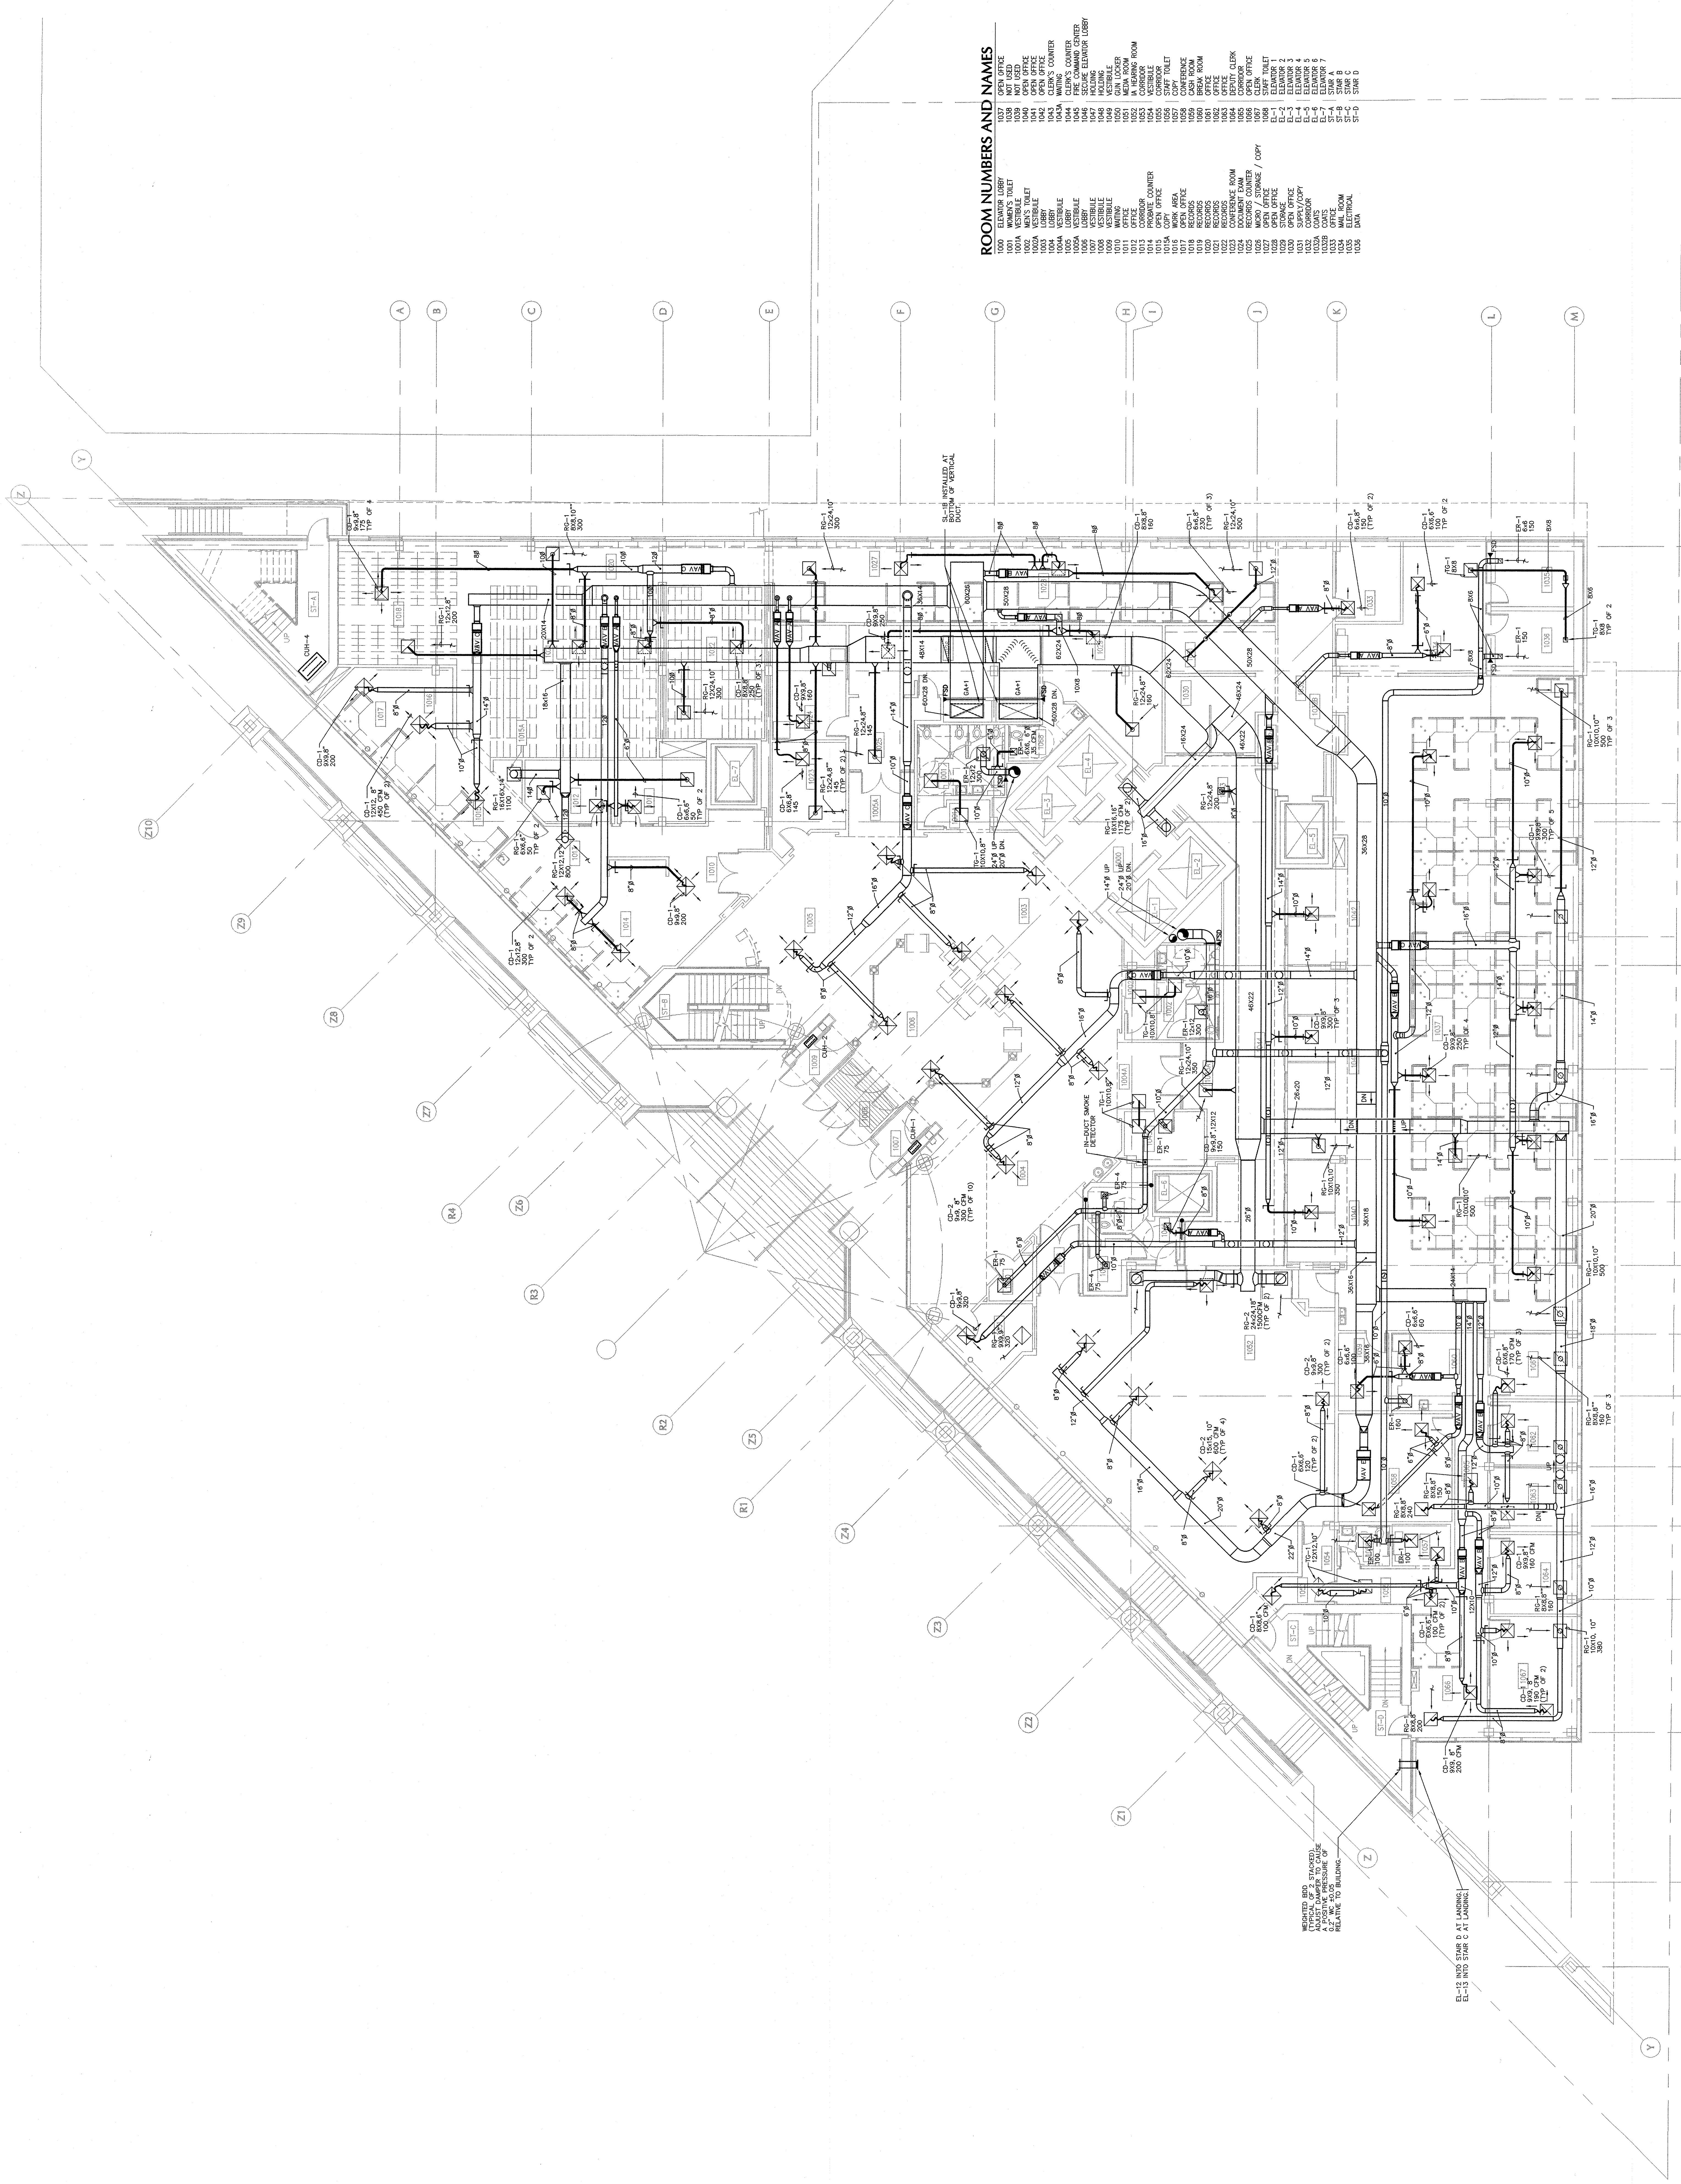

ROOM NUMBERS AND NAMES

1000	ELEVATOR LOBBY
1001	ELEVATOR LOBBY
1002	RESTROOM
1003	RESTROOM
HVAC
1ST FLOOR PLAN
SCALE: 1/8" = 1'-0"
NORTH

1 2 3 4 4.5 5 5.5 6 6.7 7 7.4 8 8.9 9 9.9 10 12

DANE COUNTY COURTHOUSE

BID PACKAGE #2 - COURTHOUSE

215 SOUTH HAMILTON ST.
MADISON, WISCONSIN 53703




THE SUBMITTER HEREBY WARRANTS THAT THE INFORMATION CONTAINED HEREIN IS TRUE AND CORRECT TO THE BEST OF HIS KNOWLEDGE AND BELIEF. THE SUBMITTER SHALL BE RESPONSIBLE FOR OBTAINING ALL NECESSARY PERMITS AND APPROVALS FROM THE APPROPRIATE AGENCIES. THE SUBMITTER SHALL BE RESPONSIBLE FOR OBTAINING ALL NECESSARY INFORMATION FROM THE ARCHITECT AND OTHER CONSULTANTS. THE SUBMITTER SHALL BE RESPONSIBLE FOR OBTAINING ALL NECESSARY INFORMATION FROM THE ARCHITECT AND OTHER CONSULTANTS. THE SUBMITTER SHALL BE RESPONSIBLE FOR OBTAINING ALL NECESSARY INFORMATION FROM THE ARCHITECT AND OTHER CONSULTANTS.

CIVIL ENGINEERING:
GRAEF, ANHOLT, SCHLOEMER
LANDSCAPE ARCHITECTS, INC.
LANDSCAPE ARCHITECTS, INC.
STEWART DESIGN ASSOCIATES, INC.
LEACH BATES & ASSOCIATES, INC.




PROJECT NO.	00304.00
DATE	12/06/02
DRAWN BY	SCK
CHECKED BY	CUF
SHEET CONTENTS	
HVAC	4TH FLOOR
PLAN	

SHEET
H1.6
150 OF 263

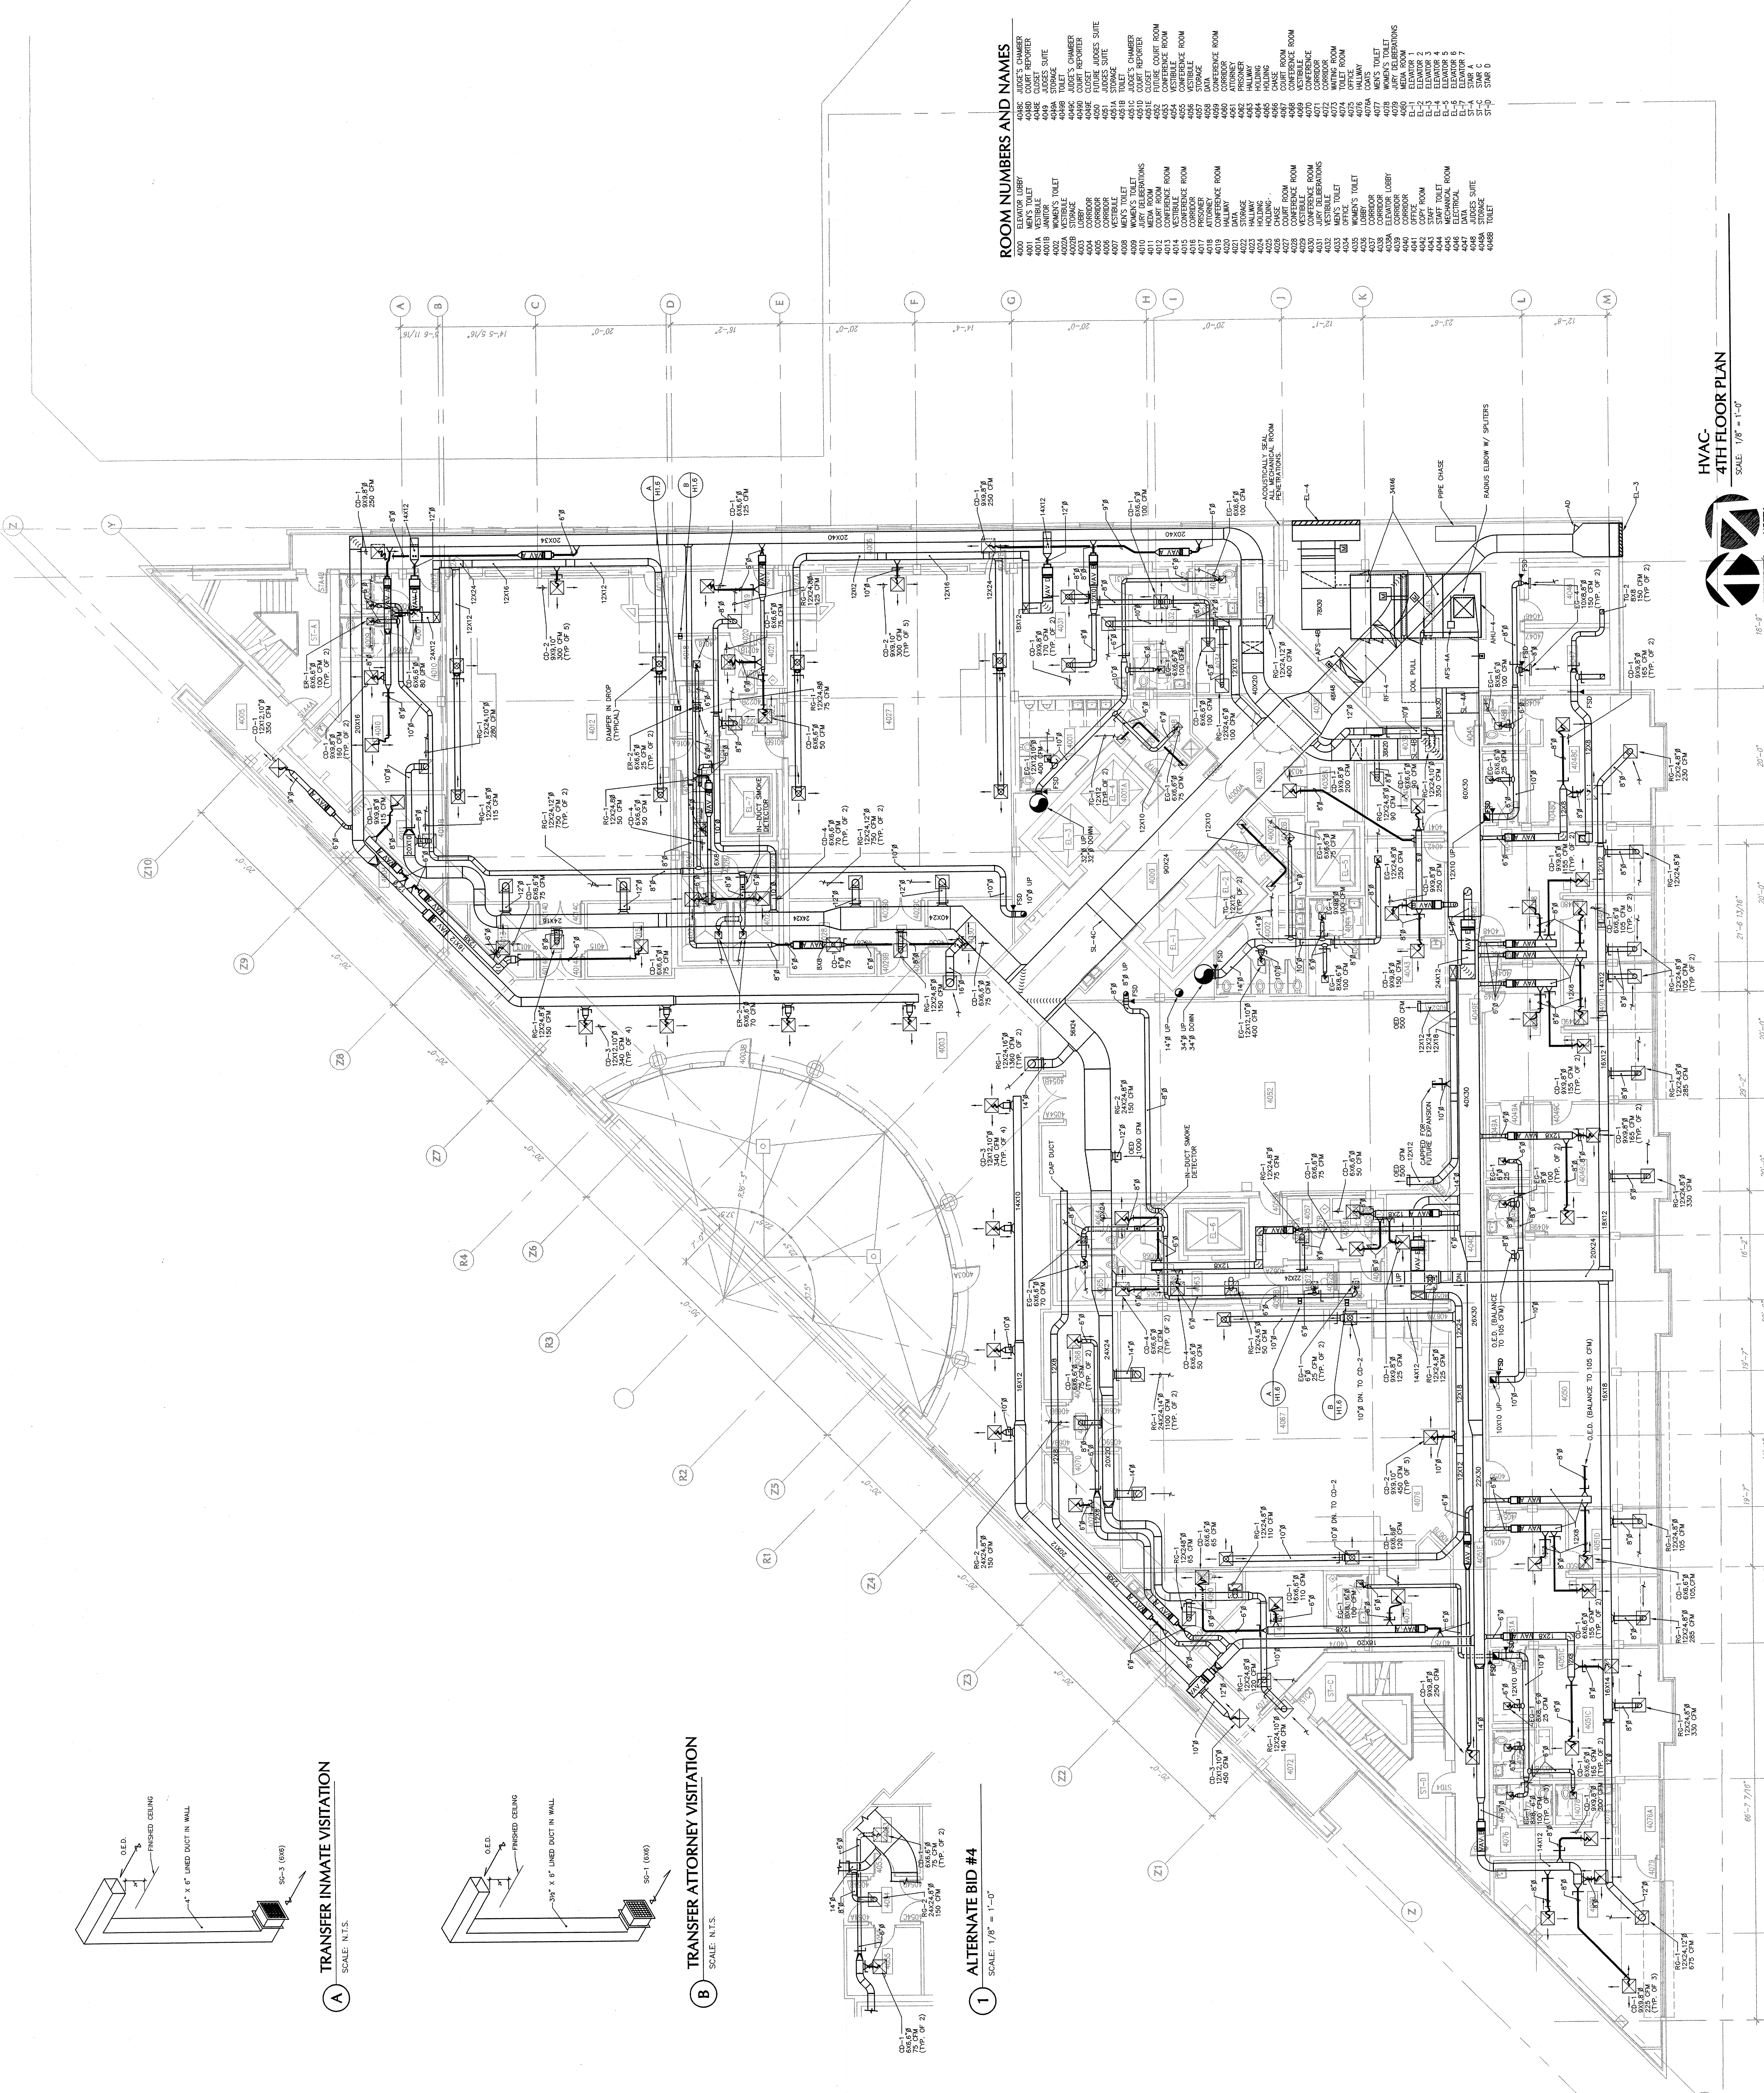


ROOM NUMBERS AND NAMES

4001	NEWS TOILET
4002	COURT REPORTER
4003	NEWS TOILET
4004	NEWS TOILET
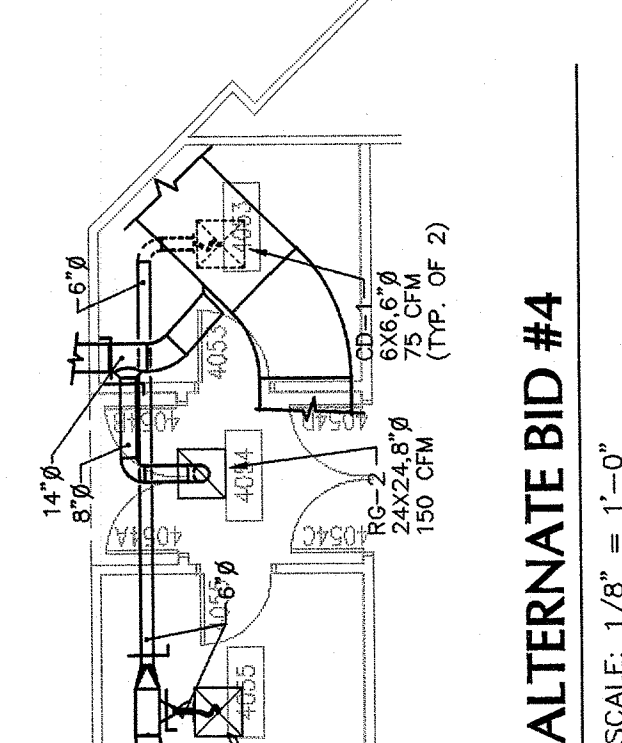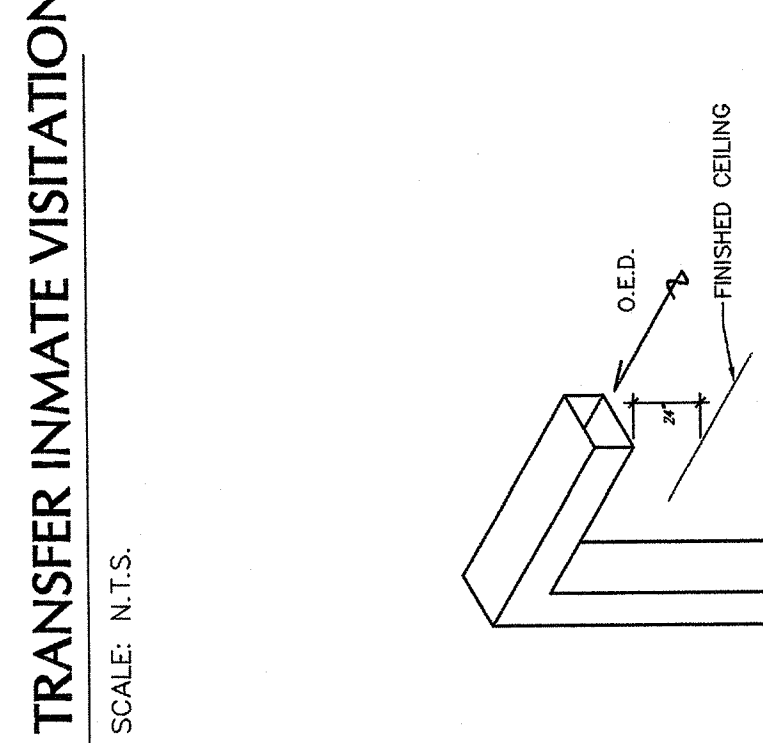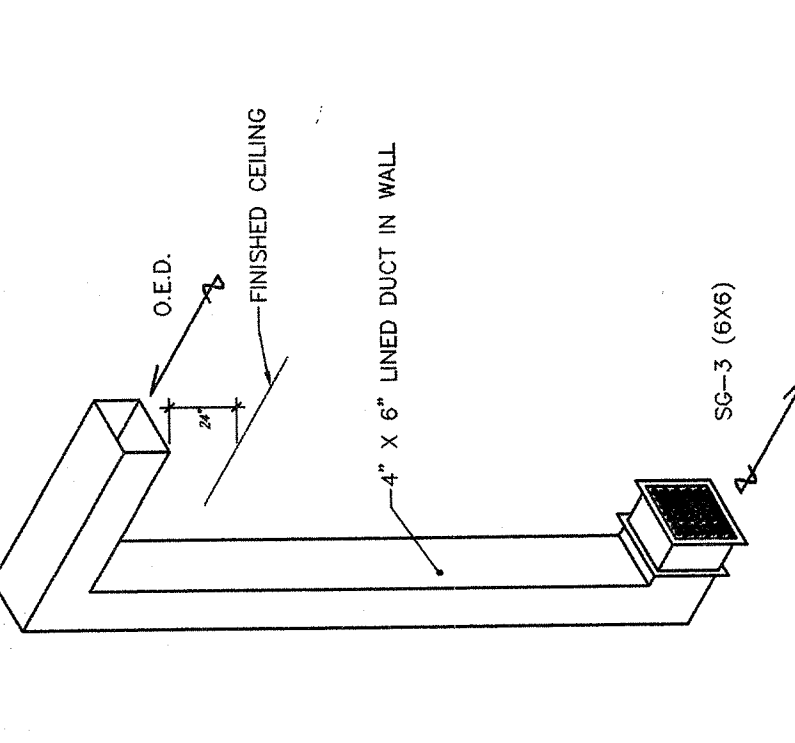

HVAC-
4TH FLOOR PLAN
SCALE: 1/8" = 1'-0"

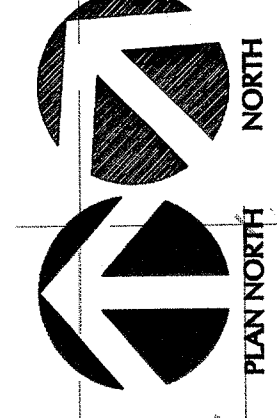

16'-5"

11'-0"

11'-0"

DANE COUNTY COURTHOUSE

BID PACKAGE #2 - COURTHOUSE

215 SOUTH HAMILTON ST.
MADISON, WISCONSIN 53703



THE ASSOCIATION OF ARCHITECTS OF WISCONSIN
100 EAST WASHINGTON AVENUE, SUITE 1000
MADISON, WISCONSIN 53703
TEL: 608.261.1000 FAX: 608.261.1001
WWW.AAOWISCONSIN.ORG



CIVIL ENGINEERING:
GRAEF, ANHOLT, SCHLOEMER
LANDSCAPE ARCHITECTS, INC.
STEVENS DESIGN ASSOCIATES, INC.
LEITCH BATES & ASSOCIATES, INC.

PROJECT NO.	00304.00
DATE	12/6/02
DRAWN BY	DER
CHECKED BY	CJF
SHEET CONTENTS	
HVAC	5TH FLOOR PLAN

SHEET
H1.7
151 OF 203

ROOM NUMBERS AND NAMES

5000	ELEVATOR LOBBY
5001	MEN'S TOILET
5002	WOMEN'S TOILET
5003	MEN'S TOILET
5004	WOMEN'S TOILET
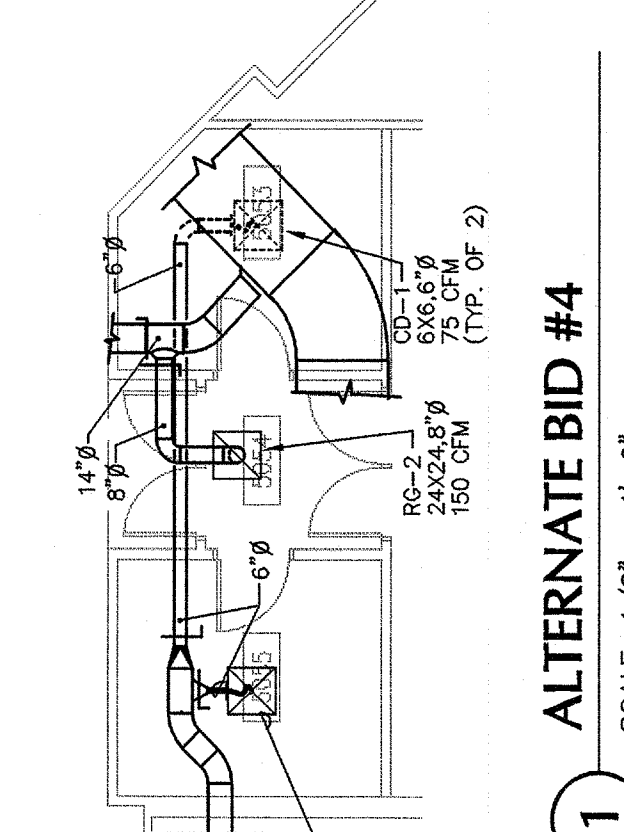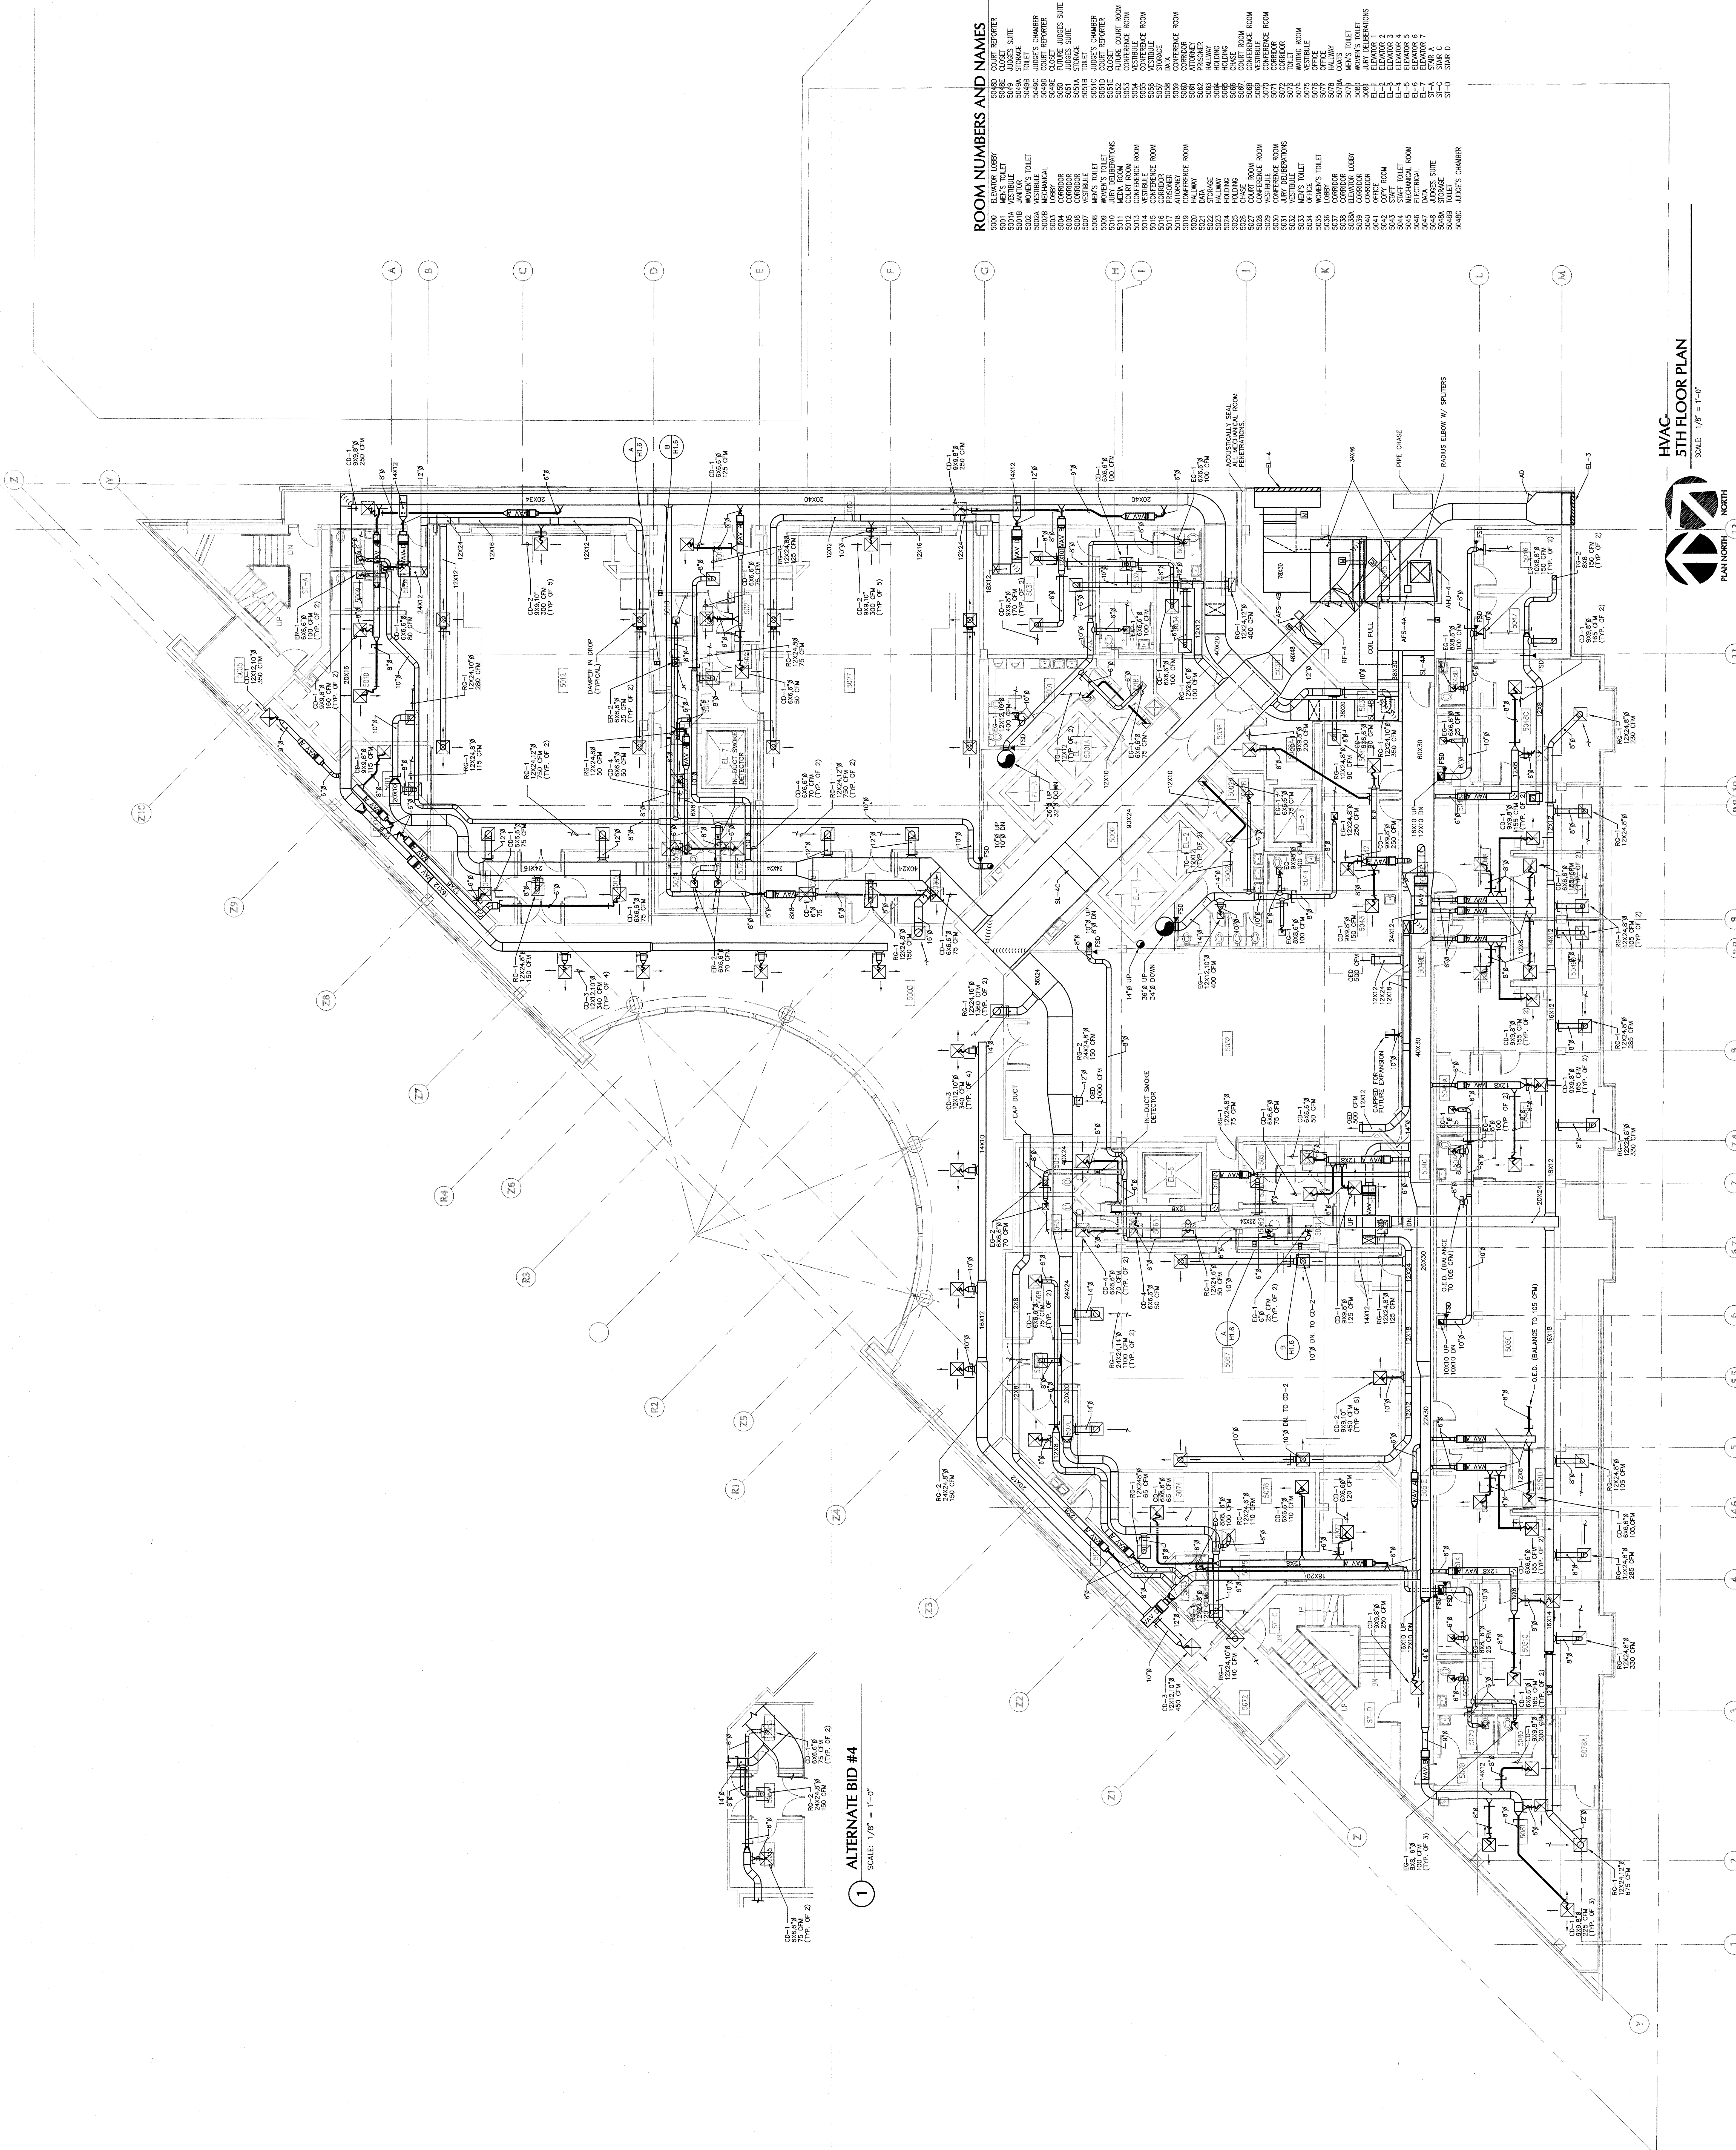

HVAC 5TH FLOOR PLAN
SCALE: 1/8" = 1'-0"
PLAN NORTH

DANE COUNTY COURTHOUSE

BID PACKAGE #2 - COURTHOUSE

215 SOUTH HAMILTON ST.
MADISON, WISCONSIN 53703



PROJECT NO. 0030A.00
DATE 12/9/02
DRAWN BY C/JF
CHECKED BY C/JF

SHEET CONTENTS
HVAC 6TH FLOOR
PLAN

REVISIONS

SHEET H1.8
152 OF 263



ROOM NUMBERS AND NAMES

6000	ELEVATOR LOBBY
6001	ELEVATOR LOBBY
6002	ELEVATOR LOBBY

HVAC 6TH FLOOR PLAN
SCALE: 1/8" = 1'-0"
PLAN NORTH

1 ALTERNATE BID #4
SCALE: 1/8" = 1'-0"

DANE COUNTY COURTHOUSE

BID PACKAGE #2 - COURTHOUSE

215 SOUTH HAMILTON ST.
MADISON, WISCONSIN 53703

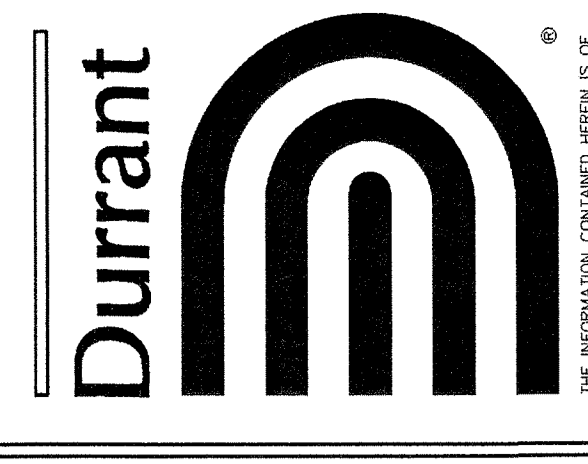

© Copyright 2002 by The Durrant Group, Inc.
All rights reserved. This drawing is the property of The Durrant Group, Inc. and is not to be reproduced, stored in a retrieval system, or transmitted in any form or by any means, electronic, mechanical, photocopying, recording, or by any information storage and retrieval system, without the prior written permission of The Durrant Group, Inc.

CIVIL ENGINEERING:
DURRANT GROUP, INC.
1000 UNIVERSITY AVENUE, SUITE 100
MADISON, WISCONSIN 53706
TEL: 608-261-1111
WWW.DURRANTGROUP.COM

LANDSCAPE ARCHITECT:
LANDSCAPE ARCHITECTS, INC.
1000 UNIVERSITY AVENUE, SUITE 100
MADISON, WISCONSIN 53706
TEL: 608-261-1111
WWW.LANDSCAPEARCHITECTS.COM

FOOD SERVICE:
STEWART DESIGN ASSOCIATES, INC.
1000 UNIVERSITY AVENUE, SUITE 100
MADISON, WISCONSIN 53706
TEL: 608-261-1111
WWW.STEWARTDESIGN.COM

ELEVATOR:
LEIGH BATES & ASSOCIATES, INC.
1000 UNIVERSITY AVENUE, SUITE 100
MADISON, WISCONSIN 53706
TEL: 608-261-1111
WWW.LEIGHBATES.COM

PROJECT NO: 00394-00
DATE: 12/6/02
DRAWN BY: DER
CHECKED BY: CUF
SHEET CONTENTS:
HVAC
8TH FLOOR
PLAN

SHEET H1.10
154 OF 263



ROOM NUMBERS AND NAMES

8000	ELEVATOR LOBBY
8001	ELEVATOR LOBBY
8002	VESTIBULE
8003	VESTIBULE
HVAC- 8TH FLOOR PLAN
SCALE: 1/8" = 1'-0"
PLAN NORTH

