

DANE COUNTY DEPARTMENT of PUBLIC WORKS, HIGHWAY and TRANSPORTATION

County Executive
Kathleen M. Falk

1919 Alliant Energy Center Way ♦ Madison, Wisconsin 53713
Phone: (608) 266-4018 ♦ Fax: (608) 267-1533

Commissioner / Director
Gerald J. Mandli

MONDAY, JANUARY 28, 2008

ATTENTION ALL REQUEST FOR BID (RFB) HOLDERS

RFB NO. 108027 - ADDENDUM NO. 1

AT&T TELEPHONE LINE FROM CCB TO COURTHOUSE

BIDS DUE: MONDAY, FEBRUARY 4, 2008, 2:00 PM. DUE DATE AND TIME ARE NOT CHANGED BY THIS ADDENDUM.

This Addendum is issued to modify, explain or clarify the original Request for Bid (RFB) and is hereby made a part of the RFB. Please attach this Addendum to the RFB.

PLEASE MAKE THE FOLLOWING CHANGES:

1. **Document Index**
Replace original with new Document Index.
2. **Bid Form**
Replace original with new Bid Form.
3. **Scope of Work**
Replace original with new Scope of Work.
4. **Drawings**
Replace 4 original drawings with 4 new drawings.

If any additional information about this Addendum is needed, please call John Schraufnagel at 608/266-4798.

Sincerely,

John Schraufnagel
Project Engineer

Enclosures:
Document Index
Bid Form
Scope of Work
Drawings 1-4

Addendum No. 1
RFB No. 108027

DOCUMENT INDEX FOR RFB NO. 108027

PROCUREMENT AND CONTRACTING REQUIREMENTS

Project Manual Cover Page
Documents Index and Dane County Vendor Registration Program
Bid Form
Fair Labor Practices Certification
Conditions of Contract
Scope of Work
Drawings

DANE COUNTY VENDOR REGISTRATION PROGRAM

All bidders / proposers wishing to submit a bid / proposal should be registered with Dane County Purchasing before bid / proposal opening & must be registered before award of contract. Complete a Vendor Registration Form at www.danepurchasing.com, or obtain one by calling 608/266-4131.

BID FORM

BID NO. 108027

**PROJECT: AT&T TELEPHONE LINE FROM CCB TO COURTHOUSE
CITY COUNTY BUILDING**

**TO: DANE COUNTY DEPARTMENT OF PUBLIC WORKS, HIGHWAY &
TRANSPORTATION PROJECT ENGINEER
1919 ALLIANT ENERGY CENTER WAY
MADISON, WISCONSIN 53713**

BASE BID - LUMP SUM:

The undersigned, having examined the site where the Work is to be executed and having become familiar with local conditions affecting the cost of the Work and having carefully examined the Drawings and Specifications, all other Construction Documents and Addenda thereto prepared by Dane County Department of Public Works, Highway & Transportation hereby agrees to provide all labor, materials, equipment and services necessary for the complete and satisfactory execution of the entire Work, which includes: furnish and install 850 ln.ft. - 1" PVC innerduct and pull string, furnish and install 135 ln.ft - 2" PVC conduit, the installation of one (1) metal 12" x 12" x 6" electrical junction box fastened to the concrete ceiling, the drilling and fittings necessary to connect the contractor installed 2" PVC conduit to 4 different metal electrical junction boxes, as specified in the Construction Documents, for the Base Bid stipulated sum of:

_____ and _____/100 Dollars
Written Price

\$ _____
Numeric Price

UNIT PRICING

The undersigned, having examined the site where the Work is to be executed and having become familiar with local conditions affecting the cost of the Work and having carefully examined the Drawings and Specifications, all other Construction Documents and Addenda thereto prepared by Dane County Department of Public Works, Highway & Transportation hereby agrees to provide all labor, materials, equipment and services necessary for the complete and satisfactory execution of the entire Work, as specified in the Construction Documents, to add or deduct from the base bid quantity:

- Furnish and Install 1" PVC Innerduct and pull string: @ \$ _____/ln.ft.
- Furnish and Install 2" PVC conduit: @ \$ _____/ln.ft.

Receipt of the following addenda and inclusion of their provisions in this Bid is hereby acknowledged:

Addendum No(s). _____ through _____

Dated _____

Dane County Information Technology must have this project completed by February 29, 2008. Assuming this Work can be started by February 11, 2008, what dates can you commence and complete this job?

Commencement Date: _____ Completion Date: _____
(final, not substantial)

Name of Bidder: _____

Address: _____

Telephone No.: _____ Fax No.: _____

Contact Person: _____

SIGNATURE: _____
(Bid is invalid without signature)


BID CHECK LIST:

These items **must** be included with Bid or completed **before** bidding

Bid Form

Fair Labor Practices Certification

Vendor Registration




**DANE COUNTY DEPT. OF
PUBLIC WORKS, HIGHWAY &
TRANSPORTATION**

1919 Alliant Energy Center Way
Madison, Wisconsin 53713
Office: 608/266-4018 ♦ Fax: 608/267-1533
Public Works Engineering Division
Public Works Solid Waste Division

SCOPE OF WORK

- A. Dane County is seeking services for the furnishing and installation of 1” PVC innerduct with pull string in 850’ of conduit running from the City County Building telephone room (GA2) to the Courthouse telephone room (LL2040).
- B. Work Site: City County Building and Dane County Public Safety Building and Courthouse
210 Martin Luther King Jr. Blvd.
(See attached Figures)
- C. Specifics:
1. Contractor installed conduit is to be 135’ of 2” schedule 40 grey electrical PVC conduit without any sharp turns.
 2. Contractor installed innerduct is to be 1” smooth electrical PVC innerduct and pull string, without any sharp turns (Note: AT&T is to install fiber telephone cable).
 3. Work in the Caged Evidence Storage Room (SB09), in the sub-basement of the Public Safety Building must be monitored by a Dane County Sheriff; provide 48 hours notice to Public Works Project Engineer before beginning this specific aspect of the Work.
 4. There shall be a campus / work site walk-through on Friday, January 25, 2008 at 1:00 PM. Meet in the City County Building main entrance off of Martin Luther King Jr. Blvd.
 5. Contractor to be paid on an actual per foot installed basis.
- D. Changes:
1. Modifications of the work maybe required during or after project;
 2. Public Works Project Engineer is “Owner” the only one authorized to direct changes to this work. Public Works Project Engineer is John Schraufnagel; contact information on Project Manual cover.

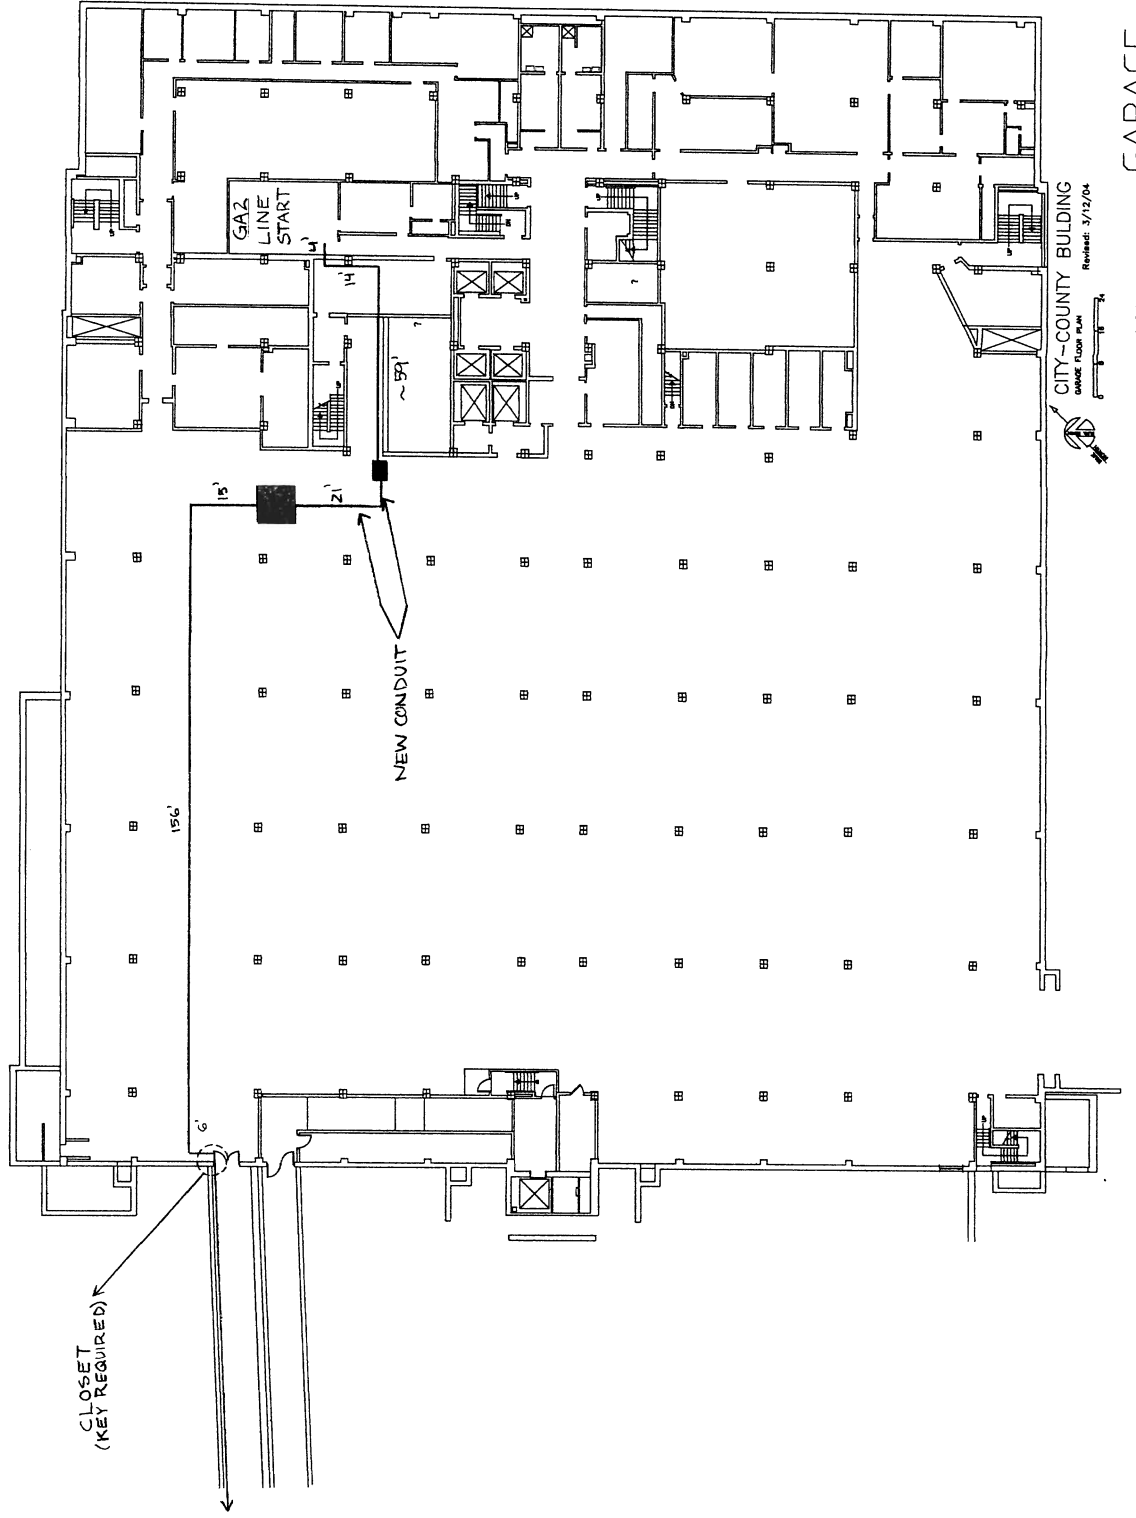

CITY-COUNTY BUILDING
GARAGE FLOOR PLAN
Revised: 3/12/04

NOT TO SCALE GARAGE

DOAN COUNTY JAIL

MADISON, WISCONSIN

Durrott Engineers Inc.



Professional Engineer
 License No. 10001
 State of Wisconsin
 Date of Issue: 10/1/90
 Expiration Date: 10/1/95
 License No. 10001
 State of Wisconsin
 Date of Issue: 10/1/90
 Expiration Date: 10/1/95

Project No.	111014
Sheet No.	105
Drawn by	AS
Checked by	AS
Scale	AS SHOWN
Date	11/28/90


18 OF 175

DOOR MARK LIST



ELECTRICAL MARKS
 ALL ELECTRICAL MARKS, SYMBOLS, AND NOTATIONS ARE TO BE PLACED AS SHOWN ON THIS DRAWING. THE MARKS ARE TO BE PLACED IN THE CENTER OF THE SYMBOL UNLESS OTHERWISE NOTED.

ELECTRICAL PLUMBING NOTES
 1. ALL CONDUIT SHALL BE 1/2" O.D. UNLESS OTHERWISE NOTED.
 2. CONDUIT SHALL BE PLACED AS SHOWN ON THIS DRAWING.
 3. CONDUIT SHALL BE PLACED IN THE CENTER OF THE SYMBOL UNLESS OTHERWISE NOTED.

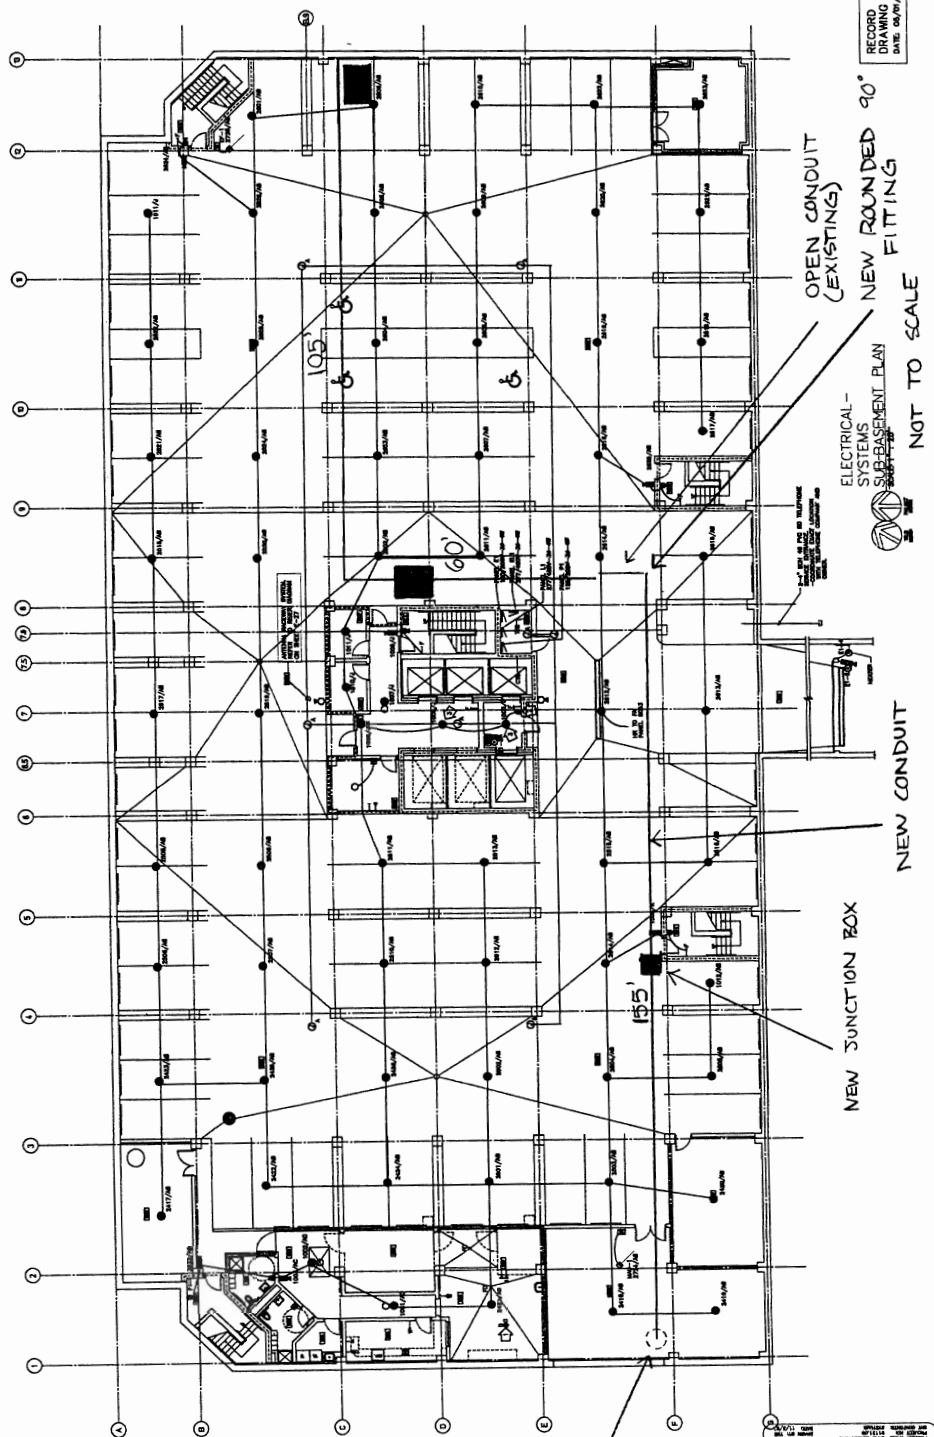

RECORD DRAWING
 DATE 08/07/98

OPEN CONDUIT (EXISTING)
 NEW ROUNDED 90° FITTING
 NOT TO SCALE


ELECTRICAL SYSTEMS
 SUB-BASEMENT PLAN



NEW CONDUIT

NEW JUNCTION BOX

DOWN TO COURTHOUSE TELECOM LL2040

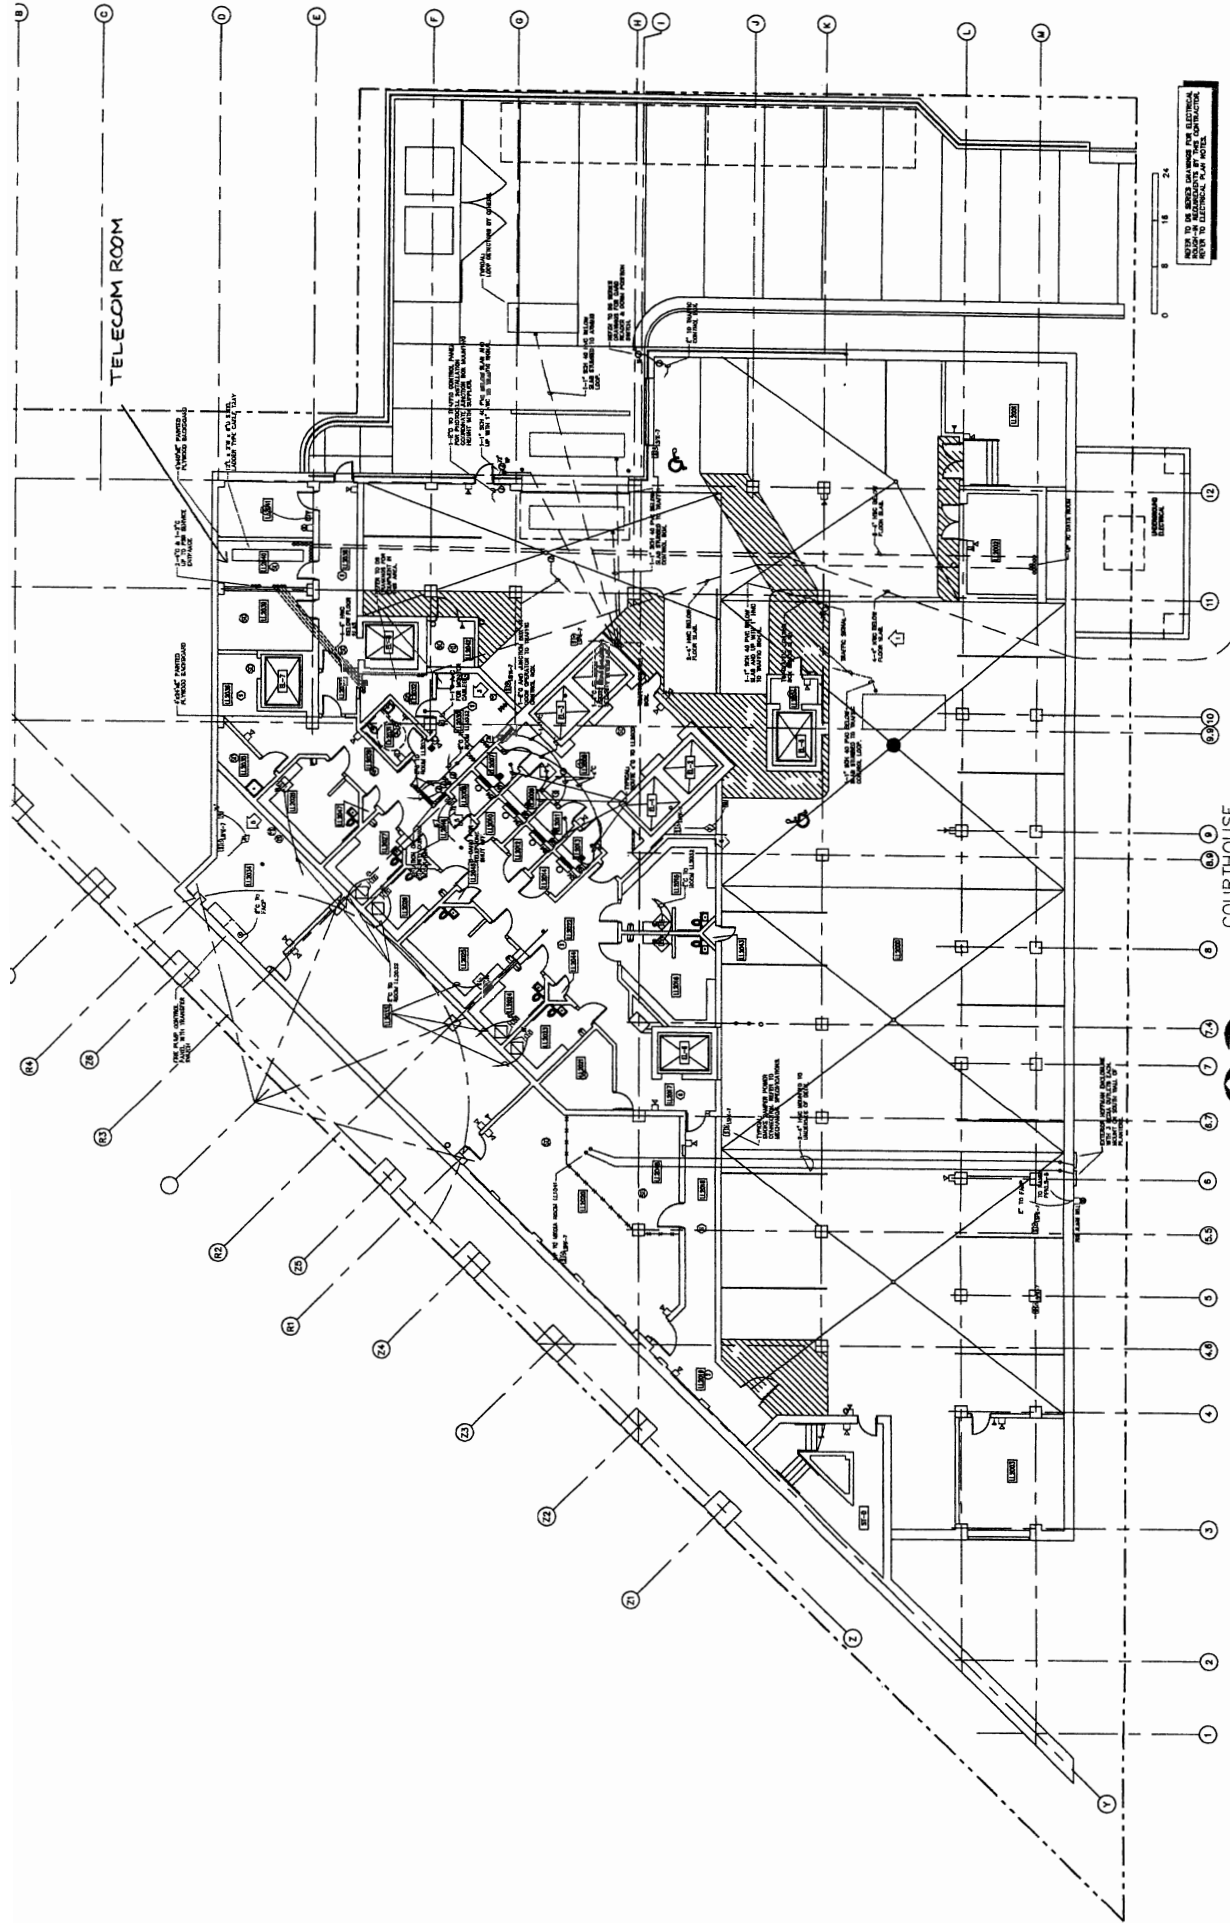

SEE ELECTRICAL SYMBOLS FOR ALL ELECTRICAL SYMBOLS REFER TO ELECTRICAL PLAN HOTEL

COURTHOUSE LOWER LEVEL 2



DATE: 11/10/00