



# DANE COUNTY DEPARTMENT of PUBLIC WORKS, HIGHWAY and TRANSPORTATION

---

**County Executive**  
Joseph T. Parisi

1919 Alliant Energy Center Way ♦ Madison, Wisconsin 53713  
Phone: (608) 266-4018 ♦ Fax: (608) 267-1533

**Commissioner / Director**  
Gerald J. Mandli

February 12, 2015

**ATTENTION ALL REQUEST FOR BID RFB HOLDERS**

**RFB NO. 313083 - ADDENDUM NO. 1**

**CONSTRUCTION OF EAST HIGHWAY GARAGE – SALT  
STORAGE FACILITY (BID PACKAGE A) AND  
MEDICAL EXAMINER OFFICE BUILDING (BID PACKAGE B)**

**DEPARTMENT OF PUBLIC WORKS,  
HIGHWAY & TRANSPORTATION  
3562 COUNTY HIGHWAY AB  
MCFARLAND, WISCONSIN**

---

**BIDS DUE MARCH 2, 2015, 2:00 PM. DUE DATE AND  
TIME ARE CHANGED BY THIS ADDENDUM.**

---

This Addendum is issued to modify, explain or clarify the original Request for Bid (RFB) and is hereby made a part of the RFB. Please attach this Addendum to the RFB. Acknowledge this addendum on the Bid Form.

**PLEASE MAKE THE FOLLOWING CHANGES:**

**1. All Cover Pages – Bid Due Date Change**

**CONSTRUCTION OF EAST HIGHWAY GARAGE – SALT STORAGE FACILITY  
(BID PACKAGE A) AND  
MEDICAL EXAMINER OFFICE BUILDING (BID PACKAGE B)**

The bid due date has changed. On all cover pages for both projects,

Replace: “Due Date / Time: **THURSDAY, FEBURARY 19, 2015, 2:00 P.M.**”

With: “Due Date / Time: **MONDAY, MARCH 2, 2015, 2:00 P.M.**”

**2. Cover Letter**

- Change on both projects the two references to due date from “**2:00 p.m., THURSDAY, FEBURARY 19, 2015.**” to read “**2:00 p.m., MONDAY, MARCH 2, 2015.**”
- Delete: Please be sure to complete one unbound original and four bound copies of the entire proposal package. To return your proposal, please follow these instructions:
  1. Place the signed Signature Page on top as page 1.
  2. Place the signed Fair Labor Practices Certification after the Signature Page as page 2.
  3. Place the Proposal information after Fair Labor Practices Certification.
  4. Place the Equal Benefits Compliance Payment Certification after the Proposal information.
  5. Clearly label your envelope containing your proposal in the lower left-hand corner as follows:
- Replace with issued with this Addendum.  
Please be sure to complete one unbound original copy of the entire bid package **A** and bid package **B**. To return your bid, please follow these instructions:
  1. Place the signed Fair Labor Practices Certification after Bid Form.
  2. Place the Bid information after Fair Labor Practices Certification.
  3. Place the Equal Benefits Compliance Payment Certification after the Bid information.
  4. Clearly label your envelope containing your bid in the lower left-hand corner as follows:

Bid No. 313083

Construction of East Highway Garage – Salt Storage Facility (Bid Package A) and Medical Examiner Office Building (Bid Package B)

2:00 p.m., Monday, March 2, 2015

**2. Bid Package A**

This Addendum is issued to modify, explain or correct the original Drawings and Specifications as noted in Addendum #A1 – Bid Package A attached, and is hereby made a part of the Contract documents. Please attach this Addendum to the Specifications in your possession. Acknowledge receipt of this Addendum in the space provided on the Bid Form. Failure to do so may subject Bidder to disqualification.

This Addendum consists of 14 written pages, (1) 15 page added specification section, and 7 revised sheets.

**3. Bid Package B**

This Addendum is issued to modify, explain or correct the original Drawings and Specifications as noted in Addendum B1 – Bid Package B attached, and is hereby made a part of the Contract documents. Please attach this Addendum to the Specifications in your

possession. Acknowledge receipt of this Addendum in the space provided on the Bid Form. Failure to do so may subject Bidder to disqualification.  
This Addendum consists of 87 written pages, 29 revised sheets and 3 Addendum B1 Bid Questions and Answers written pages.

- **There will be an Addendum 2 to follow before the revised bid date.**

If any additional information about this Addendum is needed, please call Rob Nebel at 608/267-0119 or 608/575-0890 [nebel@countyofdane.com](mailto:nebel@countyofdane.com) or [neitzel-knox@countyofdane.com](mailto:neitzel-knox@countyofdane.com)

Sincerely,  
Rob Nebel  
Assistant Public Works Director

Enclosures:

**Addendum A1 – East Highway Garage – Salt Storage Facility (Bid Package A)**

Drawings

E-212 Waste Heat Loop Pump Enclosure  
A-208 Salt Building Plans  
A-209 Salt Building Elevations & Sections  
A-410 Salt building Sections and Details  
A-601 Door Schedule  
A-701 Interior Elevations  
A-702 Interior Elevations, Floor Finish & Details

**Addendum B1- Medical Examiner Office Building (Bid Package B)**

Drawings

C100 Site Grading Plan  
C200 Site Utilities  
C600 Site and Planting Details  
A200 First Floor Plan  
A201 Roof Plan  
A210 Enlarged Floor Plans  
A503 Exterior Wall Sections  
A604 Exterior Details  
A606 Exterior Details  
A609 Exterior Details  
A800 Interior Elevations  
Q210 Enlarged Floor Plan  
Q821 Autopsy Details  
S100 Foundation Plan  
S200 Roof Framing Plan  
S201 Misc Framing Plans  
S300 Foundation Details  
S301 Foundation Details  
S401 Framing Details  
P100 Plumbing Underfloor Plan  
P200 Plumbing First Floor Plan  
P701 Plumbing Process Waste and Vent Isometrics  
P702 Plumbing Domestic Water Isometrics  
P900 Plumbing Schedules  
M200 HVAC First Floor Plan  
M201 HVAC Roof Plan and Details  
M300 HVAC First Floor and Penthouse Plans  
M401 HVAC Enlarged Plans and Sections  
M900 HVAC Schedules  
Addendum B1 Bid Questions and Answers

Page Intentionally Left Blank

# **ADDENDUM 1**

## **EAST HIGHWAY GARAGE – SALT STORAGE FACILITY (BID PACKAGE A)**

**BID NO. 313083**

**ADDENDUM A1 (Bid Package A): The following pages are addendum1 for East Highway Garage – Salt Storage Facility (Bid Package A)**

February 12, 2015

## **ADDENDUM #A1 – BID PACKAGE A**

### **Dane County Bid No. 313083 Madison, Wisconsin**

**BIDS DUE: MONDAY, MARCH 2, 2015 AT 2:00 (REVISED)** at the Dane County Public Works, Highway & Transportation Dept., 1919 Alliant Energy Center Way, Madison, WI 53713 At that time Bids will be opened publicly for consideration by the Owner.

To all Contract Bidders of record.

This Addendum is issued to modify, explain or correct the original Drawings and Specifications as noted below, and is hereby made a part of the Contract documents. Please attach this Addendum to the Specifications in your possession. Acknowledge receipt of this Addendum in the space provided on the Bid Form. Failure to do so may subject Bidder to disqualification.

This Addendum consists of fourteen (14) written pages, one (1) 15 page added specification section, and seven (7) revised sheets.

#### **GENERAL COMMENTS**

1. The specifications included in the contract documents consist of two separate projects. The specifications for Bid Package A do not apply to Bid Package B and vice versa.

#### **QUESTIONS & ANSWERS**

1. **Q:** I am looking through the spec book for this project and I believe spec sections 22 13 53, 23 74 00, and 27 60 00 are missing. Do you have any information on these? **A:** See information provided in this addendum.
2. **Q:** I am contacting you in regard to the current ornamental fence specification. I was hoping to discuss the way the spec is currently written. It calls for Ameristar's "Aegis II" product. This product is a 1" x 14GA Steel Industrial Grade system. It is one of our older product lines and something we keep around when custom heights or custom colors are needed. The product comes with a 10 year warranty. The issue we are seeing is that, the spec is calling for our Aegis II as a 1" x 16GA Steel Picket. We do not offer a 16GA Steel Picket in Aegis II. If you are wanting an Industrial Grade Product but, don't need the biggest one, I would encourage you to issue an addendum changing the spec to Ameristar's "Montage Industrial". Montage Industrial is a 1" x 16GA Steel Picket. This product is available in Black or Bronze, comes with a 20 year warranty, and is available in 3', 3 1/2', 4', 5', 6', 7', & 8' Heights. This product is fusion welded (preassembled) and will reduce the labor costs as well. I have attached a Word Document Spec that may be formatted to for your project along with a warranty, Ameristar's E-Coat Process, and our LEED Letter. Would you let me know which product you would like to have bid on this job? **A:** See information provided in this addendum.
3. **Q:** Civil Drawings – The curb and gutter work along Luds Lane and C.T.H. AB is unclear as to who provides that work. Are the bolder curved curb & gutter at the intersection and any of the road side curb be included in the project? **A:** See information provided in this addendum.
4. **Q:** Civil Drawings – Is there a new turn lane going in along C.T.H. AB where it turns right onto Luds Lane? **A:** See information provided in this addendum.

5. **Q:** Dtl 9/A406 – Please confirm the screen wall at Wash Area along column line 'B' is a precast panel or provide reinforcing requirements for a C.I.P. wall. **A:** See information provided in this addendum.
6. **Q:** S-901 & A-407 – Please provide slab thickness at Fire Pump Bldg. **A:** Sheet S-901 shows the concrete in the fire pump room as Type 'B'.
7. **Q:** Detail 4/ A501 – Please provide sizing, number of shear studs per and spacing of embeds at footing & wall Precast connections. **A:** See information provided in this addendum.
8. **Q:** Sheet P-204 – Should there be plumbing schedules included on plan sheet for the alternate Satellite Bldg? **A:** See information provided in this addendum.
9. **Q:** Sect. 3/A-405, Sheet P-200 – Please provide details or product data for the elevator sump pit and what is it made of? **A:** See information provided in this addendum.
10. **Q:** Sheet A-701 – Elevation 13/A-701 references two cuts thru that view but neither appears to apply. 6/A-409 refers to Entrance details and 6/A-205 refers to a section cut of Stairs 133 & 155 that doesn't extend far enough over to show the casework depths and heights. Please provide casework clarifications. **A:** See information provided in this addendum.
11. **Q:** Section 4/A-413 – At the alternate Satellite Building, slab-on-grade is shown as 8" thick with 6 mil vapor barrier in Support 302 and Toilet 303, but on Plan 1/S-910 it calls for concrete type "A" which, according to the concrete slab notes on S-901, is a 4" thick slab w/ 10 mil barrier. Please clarify if the concrete slab notes on S-901 should be referenced and take precedence for all buildings in this Bid Package or just the Highway Building. **A:** See information provided in this addendum.
12. **Q:** Sheet A-210, Plan 1 – At alternate Satellite Bldg exterior concrete pavement calls for Concrete Type "C". Please verify if 10 mil vapor barrier should be installed, per concrete slab notes on S-901. **A:** See information provided in this addendum.
13. **Q:** We have reviewed the (asphalt paving) plans and specifications for this project and are missing some information and also may have some conflicting specs that need to be clarified. Please review the following and provide direction within the plans and specifications where we can find the missing information or clarify in writing. **A:** See information provided in this addendum.
14. **Q:** Sheet E001 & sheet E-101 from Bid Pkg A: Please clarify which bid package is responsible for setting and sizing of the conductors coming from the Medical Examiner building's site transformer depicted on the south side of the ME bldg. It was noted at the pre-bid meeting that site utilities to within 5' of the Medical Examiner building are to be included in A, please confirm that is true for the electrical service side too. **A:** See information provided in this addendum.
15. **Q:** Please see the attached Request for Approved Equal regarding the East Garage Salt Storage Facility/Medical Examiner Office Bid Packet A project. (Request for Approved Equal - ABT Trench Drains.) **A:** See information provided in this addendum.
16. **Q:** Please review the attached data on Advanced Floor Products RetroPlate System for polishing concrete. Advanced Floor Products (AFP) was formed over 15 years ago to create and develop a state-of-the-art concrete polishing system. AFP was the originator of the concrete polishing industry, and is the source from which all other systems are based upon. AFP manufactures RetroPlate 99, a catalyzed sodium silicate sealer, hardener, and dust proofing material which is applied during the polishing process. **A:** See information provided in this addendum.

17. **Q:** Drawing sheet P-001 - Who is responsible for installation of the piping from the well location to the building? **A:** See information provided in this addendum.
18. **Q:** Drawing sheet P-001 - Who is responsible for the installation of the FP piping from FP room to both buildings and storage tank? **A:** See information provided in this addendum.
19. **Q:** Drawing sheet P-001 - Who is responsible for the 4' wet well for the fire pump (~21'deep)? **A:** See information provided in this addendum.
20. **Q:** Drawing sheet P-204 - Who is responsible for the LP piping? **A:** The Plumber.
21. **Q:** Drawing sheet P-204 - Who is responsible for the underground LP line from tank to building? **A:** The Plumber.
22. **Q:** Drawing sheet P-305 detail 1: is the 4" PSan at the bottom of the detail coming from item (39) overflow tank for evaporator system (and attached vent) part of alternate #6? **A:** See information provided in this addendum.
23. **Q:** Drawing sheet P-305 detail 2: Are items number (9), (12), (17) and (36) to be included in base bid or alternate #3? **A:** See information provided in this addendum.
24. **Q:** Specification section 22 05 14 (page4 and 5): Water make-up for fire protection tank is listed twice under Part 2 - Products. Is this a typo? **A:** See information provided in this addendum.
25. **Q:** In reference to the Hwy Garage project. We (Metropolitan Crane) would like to be listed as one of your qualified manufactures of the bridge cranes going up in the parking garage. Please see our qualification letter attached and let me know if there is anything else you will need from us on your end. **A:** See information provided in this addendum.
26. **Q:** Per the specifications, the flat roof is to be EPDM. Would you consider the use of Duro-Last material? It is a mechanically installed material. I am asking because we do not want to have our bid dismissed due to bidding an unacceptable material. **A:** Dane County requires a black fully adhered roof. As this product cannot meet these requirements, it is not an approved equal.
27. **Q:** The plans call for vinyl coated chain link. Can you tell me what the 32 31 19 Ornamental Fences and Gates spec is for? **A:** See information provided in this addendum.
28. **Q:** Sheet A-601 – Please provide door schedule information for door S1001 (Salt Building entrance door). **A:** See information provided in this addendum.
29. **Q:** Sheet A-210 – Please provide door schedule information for all doors in the Satellite Building. **A:** See information provided in this addendum.
30. **Q:** We have been told by our Franklin Fueling Products representative that their products will come out as spec'd in an addendum. To whom do we "submit specifications and other data" for other "or equal" products we would like to use? 11 11 28 1.1 B states they must be in 8 days prior to closing of bids. **A:** See information provided in this addendum.
31. **Q:** Section 11 11 28 2.1 I states that stage II Vapor Recovery line is to be installed. Stage II vapor recovery is not required by the state of Wisconsin. **A:** See information provided in this addendum.



32. **Q:** P-001, Spec.s 21 05 00 & 21 40 00: The plumbing drawings call for a 4' diameter, 21' deep wet well under the fire pump building, page 3 of spec section 21 05 00 notes a pump wet well with no sizing and spec 21 40 00 notes a vertical pump vault with no sizing. Please confirm these are all one in the same units and that it is a prefabricated unit that wouldn't require additional cast-in-place concrete work. **A:** It is to be a prefabricated fiberglass vault provided and installed by Division 21 00 00 contractor.
33. **Q:** Do the tanks shown on sheet P-305 for the car wash reclaim need to be traffic rated H-20? **A:** See information provided in this addendum.
34. **Q:** What is the capacity of the overflow tank for evaporation system? **A:** See information provided in this addendum.
35. **Q:** Please provide a door schedule for the salt storage and satellite buildings. **A:** See information provided in this addendum.
36. **Q:** Please provide specification 07 60 00 referenced on drawing A-212. **A:** Section 07 60 00 is Flashing and Sheet Metal and is part of the project manual.
37. **Q:** P-001 calls for a 4" diameter wet well for the fire pump, what is this constructed of? Precast? No details on the pump, is this provided by owner? **A:** See information provided in this addendum.
38. **Q:** What is the size of the buried FP water storage tank shown on sheet P-001? **A:** This will be determined by Fire Protection contractor.
39. **Q:** What is the size of the septic tank (informative bid b) shown on sheet P-001? **A:** This to be determined by Section 22 13 53 contractor.
40. **Q:** What is the size of the sanitary pump chamber (informative bid b) shown on sheet P-001? **A:** This to be determined by Section 22 13 53 contractor.
41. **Q:** Are the 5000 gallon process sanitary pump tank and 6000 gallon process sanitary holding tank included in the base bid A? **A:** Yes.

## **SPECIFICATIONS**

### **Section 01 23 00 – Alternates**

1. Paragraph 2.2 B 9 – Additional Information – LED lights for Alternate Bid #9 are as follows:

Type A: 2x4 architectural LED, Lithonia, 2ALL4-49L-MVOLT-D50-LP840-BLD, 120V/277V, 4900 Lumens, 4000K, bi-level dimming driver, L80 at 50,000 hours, 50W, recess mount in ceiling grid.

Type B: 2x2 architectural LED, Lithonia, 2ALL2-37L-MVOLT-D37-LP840-NX or BLD, 277V, 3700 Lumens, 4000K, dimming or bi-level dimming driver, L80 at 50,000 hours, 37W, recess mount in ceiling grid. The dimming or bi-level dimming option will not be used. Light switch and/or occupancy sensors to turn on lights to full brightness.

Type C: Remains as LED downlight specified in light fixture schedule or equal on sheet E-501.

Type D: 2x4 architectural LED, Lithonia, 2ALL4-49L-MVOLT-D50-LP840-NX or BLD, 277V, 4900 Lumens, 4000K, dimming or bi-level dimming driver, L80 at 50,000 hours, 50W, recess mount in ceiling grid. The dimming or bi-level dimming option will not be used. Light switch and/or occupancy sensors to turn on lights to full brightness.

Type E: Remains as LED downlight specified in light fixture schedule or equal on sheet E-501.

Type F: 2x4 lensed troffer LED, Lithonia, 2TL4-46L-FW-A19-MVOLT-D50-LP840-NX or BLD, 277V, 4600 Lumens, 4000K, dimming or bi-level dimming driver, L80 at 50,000 hours, 50W, recess mount in ceiling grid, A19 #19 pattern acrylic .156", flush white aluminum door. The dimming or bi-level dimming option will not be used. Light switch and/or occupancy sensors to turn on lights to full brightness.

Type G: 2x2 lensed troffer LED, Lithonia, 2TL2-33L-FW-A19-MVOLT-D38-LP840-NX or BLD, 277V, 3300 Lumens, 4000K, dimming or bi-level dimming driver, L80 at 50,000 hours, 38W, recess mount in ceiling grid, A19 #19 pattern acrylic .156", flush white aluminum door. The dimming or bi-level dimming option will not be used. Light switch and/or occupancy sensors to turn on lights to full brightness.

Type H (lower level areas and satellite building): lensed LED striplight, Lithonia, ZL2N-L48-5000LM-MDD-MVOLT-40K-80CRI-WH, 120/277V, 5000 Lumens, 4000K, 0-10VDC dimming driver, L85 at 44,000 hours, 42W, aircraft cable mount. The dimming option will not be used. Light switch and/or occupancy sensors to turn on lights to full brightness.

Type H (pump enclosure, fire pump building, all lights shown on mezzanine lighting plan E-204): linear LED striplight, Lithonia, PTNSL4-WD-MVOLT-OSR-LP841, 120/277V, 3600 Lumens, 4100K, 0-10VDC dimming driver, 47W, aircraft cable mount, +41 Deg F to +105 Deg F ambient temperature. The dimming option will not be used. Light switch to turn on lights to full brightness.

Type K: LED rated high bay, Lithonia, IBL-18L-WD-SD125-MVOLT-LP740DLC-CS93W-DWH-ZACVH-MSE360, 277V, 18,000 Lumens, 4000K, 0-10VDC dimming driver, L95 at 60,000 hours, 192W, 360 degree occupancy sensor, aircraft cable mount, +131 Deg F Ambient temperature, semi-diffuse acrylic lens. The dimming option will not be used. Light switch and lighting control panel to turn on lights to full brightness.

Type L (all lights shown on mezzanine lighting plan E-204): linear LED striplight, Lithonia, PTNSL8-WD-MVOLT-OSR-LP841, 277V, 7200 Lumens, 4100K, 0-10VDC dimming driver, 92W, aircraft cable mount, +41 Deg F to +105 Deg F ambient temperature. The dimming option will not be used. Light switch to turn on lights to full brightness.

Type M (lower level): lensed LED striplight with occupancy sensor, Lithonia, ZL2N-L48-5000LM-MDD-MVOLT-40K-80CRI-WH-LSXR-610, 120/277V, 5000 Lumens, 4000K, 0-10VDC dimming driver, L85 at 44,000 hours, 42W, aircraft cable mount, 360 degree occupancy sensor with high and low bay lenses. The dimming option will not be used. Light switch and/or occupancy sensors to turn on lights to full brightness.

Type N: No LED alternate. Light as shown in light fixture schedule will be used in the base bid and alternate bid #9.

Type O: LED rated high bay, Lithonia, IBL-24L-WD-SD125-MVOLT-LP740DLC-CS93W-DWH-ZACVH, 277V, 24,000 Lumens, 4000K, 0-10VDC dimming driver, L95 at 60,000 hours, 241W, aircraft cable mount, +131 Deg F Ambient temperature, semi-diffuse acrylic lens. The dimming option will not be used. Light switch and lighting control panel to turn on lights to full brightness.

Type P: LED rated high bay, Lithonia, IBL-18L-WD-SD125-MVOLT-LP740DLC-CS93W-DWH-ZACVH, 277V, 18,000 Lumens, 4000K, 0-10VDC dimming driver, L95 at 60,000 hours, 192W, aircraft cable mount, +131 Deg F Ambient temperature, semi-diffuse acrylic lens. The dimming option will not be used. Light switch and lighting control panel to turn on lights to full brightness.

Type R: LED vaporproof, RAB, VXBRLLED26NDG, 120V, 1473 Lumens, 4000K, LED driver, 100,000 hours based on LM-80, 30W, wall mount, includes die cast guard and frosted globe.

Type T: LED IP rated high bay, Lithonia, JHBL-24000LM-GL-WD-MVOLT(208V)-GZ10-40K-70CRI-DF-HA-DWH-CR, 208V, 24,000 Lumens, 4000K, 0-10VDC dimming driver, L70 at 100,000+ hours, 238W, pendant mount, +149 Deg F Ambient temperature, corrosion resistant finish, dual fuses, glass lens, white housing. The dimming option will not be used. Light switch to turn on lights to full brightness.

Typical of all light fixtures: include all accessories and mounting hardware as required for a complete installation. Above light fixtures are as specified or equals from Genlyte Thomas, Hubbell, Ruud, Cree, LSI and Cooper lighting. Equivalent light fixtures will be equal or better than the specified light fixture. Any light fixture that is not equal will be rejected.

### **Section 03 35 43 – Polished Concrete**

1. Section 2.1 A – Add the following to Acceptable Manufacturers:
  - a. Advanced Floor Products at PO Box 50533, Provo, UT 84605, (801)812-3420
2. Section 2.2 A – Add the following to Acceptable Products and Manufacturers:
  - a. Advanced Floor Products – Retro Plate System.
3. Section 2.2 D – The following Substitution will be permitted:
  - a. Advanced Floor Products, Retro-Plate 99 penetrating liquid floor densifying agent.
  - b. Advanced Floor Products, Retro-Pel oil repellent.
  - c. Advanced Floor Products, Retro Guard penetrating stain repellent.
  - d. ChemSystems, Inc, Helix Color Systems Dye for use with the Retro Plate Concrete Dye System. Allow three colors for the project.
  - e. CureCrete, CreteClean Plus concrete cleaner.

### **Section 08 30 00 – Special Doors**

1. Coiling Door for Salt Shed – Basis of Design – Overhead Door Company, 610 Series.
2. Section 2.1 B – Operable Coiling Doors – Section 1 - General shall be revised as follows:
  - a. Slats shall be No. F265, 20 gauge.
  - b. Bottom bar angles shall be galvanized.
  - c. Slat and Hood Finish shall be – Galvanized Steel: Slats and hood galvanized in accordance with ASTM A 653 and receive rust-inhibitive, roll coating process, including 0.2 mils thick baked-on prime paint, and 0.6 mils thick baked-on polyester top coat.
  - d. Guides Finish shall be -- PowderGuard Zinc Finish for guides, bottom bar and head plate.
  - e. Brackets shall be – Galvanized steel to support counterbalance, curtain and hood.
3. Section 2.1 B – Operable Coiling Doors – Section 2 – Electrically Operated Doors shall be revised as follows:
  - a. Electric Motor Operation: Provide UL listed electric operator, size as recommended by manufacturer to move door in either direction at not less than 2/3 foot or more than 1 foot per second.
    - i. Sensing Edge Protection:
      - 1) Pneumatic sensing edge.
      - 2) Electric sensing edge.
    - ii. Operator Controls:
      - 1) Push-button operated control stations with open, close, and stop buttons.
      - 2) Controls for exterior location, surface mounted inside building;
    - iii. Motor Voltage: Per electrical drawings.

4. Section 2.1 B – Operable Coiling Doors – Sections 3, 4, and 5 are omitted.

#### **Section 08 71 00 – Hardware**

1. Weatherstripping shall be as follows:
  - a. Head and Jamb – Zero #326 aluminum to sizes, color and profiles to fit door application and hardware color.
  - b. Sill Sweep – Zero #39W aluminum to color to fit hardware color.

#### **Section 09 91 00 – Painting**

1. Paragraph 3.6 C 13 – Exposed Overhead Work – Change references to waterborne and acrylic to oil-based.

#### **Section 10 14 19 – Flat Cut Letters and Logos**

1. Paragraph 2.5 A – Cast Aluminum Letters will also be acceptable. Thickness of cast letters shall be  $\frac{3}{4}$ "

#### **Section 11 11 28 – Vehicle Fuel Equipment and Canopy**

1. Paragraph 2.1 A – Xerxes double wall, fiberglass reinforced plastic tanks meeting or exceeding the specifications will be acceptable. Provide all required tie-downs.
2. Paragraph 2.1 I – Stage II Vapor Recovery is not required.
3. OPW and Franklin Fueling Systems components are acceptable provided they meet or exceed the specifications, including the following:
  - a. 1½ hp Fixed Speed Submersible Turbine Pumps.
  - b. UPP Dispenser Sumps.
  - c. XP Pressure and Suction Product Piping
  - d. Defender Series Overfill Prevention Valve
  - e. TS-1001 Full Feature Compliance Consoles
4. The following components are acceptable provided they meet or exceed the specifications.
  - a. EBW FlexCatch Below Grade Spill Containers
  - b. Bennett Series 3700S pumps and dispensers.
  - c. Hose Master Inc 300 Series stainless Hydroformed corrugated hose.

#### **Section 11 11 30 – Card Activated Management System**

1. Section 6.0 – Software: The Owner currently owns and operates the PC Software. The work of this project includes necessary programming and troubleshooting to allow the new installation to communicate remotely with the existing system off site.
2. Section 8.0 – Required Equipment, Installation, and Training. The following changes apply to this section:
  - a. Software is not required, program existing software to communicate with new installation.
  - b. New card encoder and 100 cards are still to be included. Encoder will be located at the existing Madison shop located at 2302 Fish Hatchery Road, Madison, WI 53713.

### **Section 22 05 14 – Plumbing Specialties**

1. On Page 2, at “Trench Drain”, add the following:
  - a. ABT #2010 Channel with #2513 ductile iron grate and frame with all accessories as needed to meet specifications.
2. On Page 4, add the following:
  - a. 1” aluminum Nozzle, Kochek # NZ030 (FireHoseDirect).
  - b. Thread Adapter, Grainger 6ANXO, 1”NTP male to 1”NPSH male adapter.
  - c. 1” NTP brass coupler.
3. On Page 5, delete second reference in Specifications for Water Make-up for Fire Protection Tank.

### **Section 22 13 53 - Septic System**

1. Footer is incorrect (22 13 00 Facility Sanitary Sewerage)

### **Section 22 30 00 – Plumbing Equipment**

1. Page 2 – See Gas Fired Water Heater Schedule on Sheet P301 for Information on Gas Water heater, DWH6.
2. Page 4 – At Water Reclaim System, Water Reclaim Separator Tanks (Underground) (4 reqd.)  
ADD:
  - a. Tanks are to be 1500 gallons.
  - b. Tanks are to be H20 rated for truck traffic.
3. Page 4 – At Water Reclaim System, Overflow Tank for Evaporator System (Underground) (1 reqd.)  
ADD:
  - a. Tank is to be H20 rated for truck traffic.

### **Section 23 09 14 – Electric Instrumentation and Control Devices for HVAC**

1. Page 7 – Eliminate Electronic thermostats section. Radiant heat controlled shall be controlled through the DDC system
2. Page 8 – Gas detectors table – CO 1st alarm limit should be changed from 100ppm to 35ppm

### **Section 23 09 15 – Direct Digital Control Input / Output Point Summary (New Section)**

1. See attached Direct Digital Control Input / Output Point Summary Tables as referenced in Section 23 09 23.

### **Section 23 09 93 – Sequence of Operation for HVAC Controls**

1. Page 5 – Make up air unit MUA-1 - change the sequence to the following to remove the building pressure controls.
  - a. *Make up air unit MUA-1 shall be interlocked with CO/NO2/NG detection system in large vehicle storage garage. The burner shall be controlled by a discharge air sensor mounted in the discharge air plenum. The discharge air shall be held at 70°F(adjustable). The Make-up air unit shall be equipped with a VFD for soft start operation. For softstart operation the VFD shall be programmable to slowly ramp up to full speed within 30seconds of control signal to start.*
2. Page 5 – Make up air unit MUA-3 - change the OA temp to enable the gas heat in the make-up air unit from 35°F to 40°F
3. Page 5 – Make up air unit MUA-3 - add the follow control sequence to make up air MUA-3
  - a. *When the outside air temp is below 35°F and the make-up air unit is off the coil valve shall remain open for freeze protection.*
4. Page 6 – Radiant floor – add the text to the second second sentence to read as follows:
  - a. *The radiant floor zone shall be controlled through the DDC system with a room temperature sensor and a slab temperature sensor.*

### **Section 23 74 00 – Package Rooftop Units**

1. This section has been removed from the project.

### **Section 26 36 23 – Automatic Transfer Switches**

1. Paragraph 2.1 A – Paragraph indicates a Kohler KPS (programmed transition) with MPAC 1500 solid state control for optional emergency transfer switch ATS2. The Kohler KPS is no longer made and shall be replaced with the KCP (programmed transition) model or equal.
2. Paragraph 2.1 A – Paragraph indicates a Kohler KSS (standard transition) with MPAC 1500 solid state control for emergency load automatic transfer switch ATS3. The emergency load automatic transfer switch ATS3 shall be a Kohler KSS with MPAC 1200 solid state control or equal.

### **Section 32 12 00 – Asphaltic Concrete Paving**

1. Paragraph 1.3 B – Mix Designs shall comply with Sheet C-105 as further defined in this Addendum.
2. Paragraph 2.2 A – Mix Designs shall comply with Sheet C-105 as further defined in this Addendum.

### **Section 32 31 19 – Ornamental Metal Fences and Gates**

1. Delete this section; there is no ornamental fence work for Bid Package A.

**Section 33 21 00 – Well System**

1. At SCOPE, Change the Well requirements to:
  - a. Depth of well to be 500’.
  - b. 8” grouted casing to extend 200’
  - c. See REVISED BID FORM for unit prices for additional well depth and casing depth.
  - d. Contractor will be responsible for High Capacity well Permit from DNR.
  - e. Include test pumping of well.

**Section 41 22 00 – Hoists and Cranes**

1. Paragraph 1.1 A – Clarification: The structural steel runway which includes the beam and channel cap, and related haunches is part of Section 05 12 00. The crane rail itself is part of this section. Available lift is to be +/- 28’-5”
2. Add Paragraph 1.1 B (Existing Paragraph B to become Paragraph C – Related Work) – ALTERNATE #A7 – One (1) Seven and One Half (7.5) Ton Capacity Crane – Location – Large Vehicle Storage 138
  - a. (Large Vehicle Storage 138) The work under this Alternate Bid Section includes all labor, materials, and equipment for fabrication and installation on one (1) Seven and One Half (7.5) Ton capacity, floor controlled, bridge mounted overhead traveling crane; 95’-3” span, 25’-5” available lift, for operation of 480 volt, 3 phase, 60, A.C. All motors controlled from pendant festoon system.
3. Paragraph 2.2 A – Make the following corrections to the crane specifications:
  - a. Crane is for Weld Bay 145, not Vehicle Repair 131 as listed.
  - b. Span = 34’-2”
  - c. Lift = 28’-5”
  - d. Wheel Load = 6,300 lbs.
  - e. Bridge Endtruck = Std. 6’-7” wheel base.
  - f. ASCE Rail = 40#/yd
  - g. Runway Length = 96’-4”
4. Paragraph 2.2 A – Add the following crane specifications for the 7.5 ton crane listed above for ALTERNATE #A7:

Crane Type	Top Running Double Girder	# of Cranes	1
Capacity	7.5 tons	Operation	Indoors
Span	95’-3”	Power	480V3ph/60Hz
Lift	25’-5”	Reeving	6 Part double
Hoist	7.5 tons wire rope	Control Encl.	NEMA 12
Whl Load	17,700 lbs.	CMAA Class	C Moderate Duty
Bridge Endtruck	Std. 9’-9” wheel base	Operation Type	Sliding PB
Configuration	Double Girder	Control Voltage	110V
Girder T.	Welded box construction	Cross Conductors	Festooned
Walkway	N/A	Paint	Yellow
Runway	N/A	Runway Conduct.	Cond. Bar
ASCE Rail	40#/yd ASCE rail	Runway Collect.	SpringShoe
Columns	By Bldg. Contractor	Runway Length	196’-6”

5. Paragraph 2.3 A – Add the following to the list of acceptable manufacturers:
  - a. Metropolitan Crane & Hoist Company

## **DRAWINGS**

### **Sheet C-102 – Phase 1 Site Plan**

1. The curb & gutter off of Luds Lane and Luds Lane itself are not part of this bid. This bid stops at the line shown at the entrances on sheet C-102 and noted "DESIGN BY DANE COUNTY".
2. The turn lane off of CTH AB is not part of this bid.

### **Sheet C-105 – Phase 1 Paving Plan**

1. For exterior concrete pavement, See Sheet A-201 for required reinforcing.
2. Asphaltic Concrete Pavement shall be as follows:
  - a. Passenger Vehicle Parking / Low Traffic Areas Detail
    - i. Type: WisDOT Type E-1.0
    - ii. Lower Layer Thickness: 2.25 inches
    - iii. Lower Layer Gradation: 19.0 mm
    - iv. Lower Layer Performance Grade: PG 58-28
    - v. Upper Layer Thickness: 1.75 inches
    - vi. Upper Layer Gradation: 12.5 mm
    - vii. Upper Layer Performance Grade: PG 58-28
  - b. Truck Traffic Areas Detail
    - i. Type: WisDOT Type E-10
    - ii. Lower Layer Thickness: 4.0 inches
    - iii. Lower Layer Gradation: 19.0 mm
    - iv. Lower Layer Performance Grade: PG 58-28
    - v. Upper Layer Thickness: 2.0 inches
    - vi. Upper Layer Gradation: 12.5 mm
    - vii. Upper Layer Performance Grade: PG 58-28

### **Sheet A-208 – Salt Building Plans**

1. See revised sheet showing door tags.

### **Sheet A-209 – Salt Building Elevations and Sections**

1. See revised sheet showing door and hardware schedules.

### **Sheet A-210 – Satellite Building – Floor Plan and Roof Plan**

1. Exterior concrete slabs called out at Type C: Slabs shall follow the details on Sheet S-901 with the exception of the vapor barrier. A vapor barrier is not required for exterior concrete slabs.

### **Sheet A-406 – Wall Sections**

1. Section 9 – Screen Wall @ Wash Area – The note at the top of the section is incorrect. The screen wall is a precast concrete wall per Section 03 41 00. The footing shown remains cast in place concrete.



**Sheet A-410 – Wall Sections**

1. Section 2 – See revised sheet showing Coiling Door, exterior face mounted.

**Sheet A-413 – Satellite Building Wall Sections**

1. Section 4 – Concrete slab notes are incorrect. Concrete slab-on-grade in Support 302, Toilet 303, and Toilet 304 shall be Concrete Type 'A' as shown on Sheet S-910.

**Sheet A-501 – Building Details**

1. Detail 4 is a typical detail for all base wall connections at precast concrete. Cast-in plates will be designed and provided by the precast wall panel contractor. The size and number will be dependent on their design.

**Sheet A-601 – Door Schedule**

1. See revised sheet showing Door and Hardware Schedule for the Outbuilding.

**Sheet A-701 – Interior Elevations**

1. See revised Sheet showing section references for millwork shown on revised Sheet A-702 in this addendum.

**Sheet A-702 – Interior Elevations, Floor Finish & Details**

1. See revised Sheet for new section Details 2, 7, 8, and 9.

**Sheet S-910 – Satellite Building Foundation and Framing Plans**

1. Concrete slab-on-grade types called out on this sheet refer to the same slab types as the main building. See Sheet S-901.

**Sheet P-001 – Plumbing Site Plan**

1. See Section 33 21 00 for piping from well to building.
2. See Section 21 05 00 for fire protection piping from fire protection room to both buildings and storage tank.
3. See Section 21 05 00 and 21 40 00 for the 4' wet well for the fire pump.

**Sheet P-200 – Plumbing Overall Underground Plan**

1. Specifications for Elevator Sump and pump are in Specification Section 22 30 00.

### **Sheet P-201 – Plumbing Overall Above Ground Plan**

1. Drawing 2, there is a CB1 between Columns A&B/9.7, see P200 for exact location.
2. Drawing 1, Add Labels at WR1 & AR1 at Column E.6 &2 (RM 140 NW corner).

### **Sheet P-203 – Plumbing Office Plan**

1. Drawing 1, ADD a FD at SH1's & 2's in drying area of stall (total of 6), include additional venting.

### **Sheet P-204 – Plumbing Plan (and Schedules)**

1. DELETE "and Schedules" from Sheet name, there are NO schedules on this sheet.
2. Drawing 1, ADD note at underground Propane piping:
  - a. Buried (3' depth) 1"K copper piping in 4"PVC sleeve provide moisture stops at end of pipe, 2<sup>nd</sup> stage regulator at building 425MBH, strainer and valve.
  - b. At four (4) Propane connections to HVAC equipment: Install drip leg, union, valve and SS flex hose, connect to equipment.
3. Drawing 1, ADD:
  - a. NOTE for above ground Propane piping use SCH 40 black steel pipe with screw thread fittings, Pipe and installation to conform to Fuel Gas code requirements.

### **Sheet P-301 – Plumbing Domestic Isometrics, Schedules, and Details**

1. Drawing 2, ADD 1" RBPB for pressure washer (located on south side of wall), See P201 Drawing 2 for location.
2. Drawing 4, WR1, Change ¾"Watts 008PCQT to 1"Watts 008 PCQT.

### **Sheet P-305 – Car Wash Supplemental Drawing**

1. Drawing 2, the 4" sanitary drain piping from Tank 39 is part of ALTERNATE BID #2.
2. Drawing 2, Items 9,12,17,17 & 36 are part of ALTERNATE BID #3.

### **Sheet M-300 – Mechanical Schedules**

1. Eliminate Note #5 on Make-up Air Unit Schedule. – Control shall be provided through DDC system.

### **Sheet E-101 – Electrical Site Plan**

1. Sheet Note #15 indicates that the electrical contractor is to stub 4" primary conduits out from utility pad mount transformer. To clarify, the electrical contractor is to stub two 5" primary conduits out from the utility pad mount transformer. Conductors themselves will be provided and installed by Alliant Energy. As noted on this site plan, coordinate electrical service with

Alliant Energy. Any work related to the electrical service for the ME Building is to be part of Bid Package B.

**Sheet E-205 – Office and Small Vehicle Storage Power and Systems Plan**

1. Added sub-feeds from solar electrical panel to inverters and 120V circuit to combiner boxes. Sheet note #29 changed to: "Photovoltaic panels and distribution system - Alternate Bid #8: provide 225A circuit breaker (must be listed as a back fed device) in panel MDP. Provide 225A feeder to solar electrical panel on roof near column line H.6-2. From solar electrical panel, provide 90A feeder to west inverter (near column G-2) and 125A feeder to east inverter (near column G-4). In addition to power conduits, provide three 4" conduit sleeves thru roof for solar panel controls. Verify location with solar contractor. Provide 15/1 circuit (RP1-10) to three solar combiner boxes. Solar combiner boxes located near columns G-2 and G-4 (two combiner boxes near G-4)". Solar electrical panel, inverters and combiner boxes provided and mounted by solar contractor.

**Sheet E-212 – Waste Heat Loop Pump Enclosure**

1. Waste heat loop pump enclosure electrical plans shown in following figures 1 thru 3 on added Sheet E-212. Feeder from an existing building or a new service lateral to panel MDP to be determined and added to a future addendum.

**Sheet E-501 – Schedules, Details**

1. See information in this Addendum regarding light fixtures for Alternate #9.

**CONTACT INFORMATION**

**Architect:**

Kueny Architects, LLC  
Jon Wallenkamp  
(262) 857-8101  
jonw@kuenyarch.com

**Fire Protection & Plumbing**

Southport Engineered Systems  
Bob Novak  
(262) 818-4409  
bnovak@southportengsys.com

**Structural:**

Kueny Architects, LLC  
John Schmidbauer  
(262) 857-8101  
johns@kuenyarch.com

**HVAC:**

Southport Engineered Systems  
Tim Pann  
(262) 654-6630  
tpann@southportengsys.com

**Civil:**

Snyder & Associates  
Brett Biwer  
(608) 838-0444  
bbiwer@snyder-associates.com

**Electrical:**

David L. Hanson Associates  
Dave Hanson  
(262) 654-2010  
davehansoneci@sbcglobal.net

\* \* \* \* \*



**DDC INPUT / OUTPUT SUMMARY TABLE**

DDC CONTROLLERS PROVIDED UNDER SPECIFICATION SECTION 23 09 25

Project No 49-1354

POINT DESCRIPTION	HARDWARE										SOFTWARE																	Comments							
	OUTPUT					INPUT					ALARMS			ENERGY MANAGEMENT SYSTEM FUNCTIONS																					
	DIGITAL		ANALOG			DIGITAL		ANALOG			DIGITAL	ANALOG		Trend	Totalization	Scheduled Start/Stop	Optimum Start/Stop	Duty Cycling	Dial-up I/O	Demand Limiting	Day/Night Setback	Equipment Integration	Fire Alarm Integration	Security/Access Integration	Elect PGM Integration	Chiller Integration	Dry-bulb Economizer		HW/OA Reset	CHW Reset	Smoke Control	Fire Alarm Override			
Luds Lane and County AB																																			
Air cooled condensing units for AHU-1																																			
Compressor Status																																			
Cooling Enable																																			



# DDC INPUT / OUTPUT SUMMARY TABLE

DDC CONTROLLERS PROVIDED UNDER SPECIFICATION SECTION 23 09 25

PROJECT:		HARDWARE										SOFTWARE										Comments																																					
Project No	Facility	OUTPUT					INPUT					ALARMS					ENERGY MANAGEMENT SYSTEM FUNCTIONS	
LOCATION:	Room	DIGITAL		ANALOG		DIGITAL			ANALOG		DIGITAL			ANALOG	
POINT DESCRIPTION	Energy Recovery Ventilator	24VAC Control Relay	Contactors	2-Pos Actuator	Tri-State Actuator	Duration Adjust Actuator	4-20 mA	0-10 VDC	Current Sensing Switch	Control Relay Contact	Switch Closure	Auxiliary Contact	Diff Pressure Switch	Flow Switch	Temperature	Relative Humidity	Differential Pressure	Gauge Pressure	Static Pressure	Flow	Equipment Status	Maintenance	Pressure	High Limit	Low Limit	Maintenance	Day/Night Setback	Demand Limiting	Dial-up I/O	Duty Cycling	Optimum Start/Stop	Scheduled Start/Stop	Totalization	Trend	Equipment Integration	Fire Alarm Integration	Security/Access Integration	Elect PGM Integration	Chiller Integration	Dry-bulb Economizer	HW/OA Reset	CHW Reset	Smoke Control	Fire Alarm Override															
Outside Air Temperature															X																															Globally shared													
Exhaust Air Temperature Out															X	
Exhaust Air Temperature In															X	
Supply Air Temperature															X	
Supply Fan Status									X	
Supply Fan Start/Stop									X	
Exhaust Fan Status										X	
Exhaust Fan Start/Stop										X	

















# DDC INPUT / OUTPUT SUMMARY TABLE

DDC CONTROLLERS PROVIDED UNDER SPECIFICATION SECTION 23 09 25




PROJECT: Dane County Highway Facility	SOFTWARE																				Comments																			
	HARDWARE										SOFTWARE																													
	OUTPUT					INPUT					ALARMS					ENERGY MANAGEMENT SYSTEM FUNCTIONS																								
MUA-3	POINT DESCRIPTION	DIGITAL		ANALOG		DIGITAL		ANALOG			DIGITAL		ANALOG			DIGITAL		ANALOG			Day/Night setback	Demand Limiting	Dial-up I/O	Duty Cycling	Optimum Start/Stop	Scheduled Start/Stop	Totalization	Trend	Equipment Integration	Fire Alarm Integration	Security/Access Integration	Elect PGM Integration	Chiller Integration	Dry-bulb Economizer	HW/OA Reset	CHW Reset	Smoke Control	Fire Alarm Override	Globally shared point.	
		Control Relay	24VAC Contactor	2-Pos Actuator	Tri-State Actuator	Duration Adjust Actuator	4-20 mA	0-10 VDC	Current Sensing Switch	Control Relay Contact	Switch Closure	Auxiliary Contact	Diff Pressure Switch	Flow Switch	Temperature	Relative Humidity	Differential Pressure	Gauge Pressure	Static Pressure	Flow	Equipment Status	Maintenance	Pressure	High Limit	Low Limit	Maintenance	Equipment Integration	Fire Alarm Integration	Security/Access Integration	Elect PGM Integration	Chiller Integration	Dry-bulb Economizer	HW/OA Reset	CHW Reset	Smoke Control	Fire Alarm Override				
	Outside air Temperature																																							
	Supply Air Temperature After																																							
	Direct Fired Burner																																							
	Heating Enable									X																														
	Supply Air Temperature After																																							
	HW Coil																																							
	Space Temperature																																							
	Heating Coil Valve							X																																
	Minimum OA Damper							X																																
	Supply Fan Status																																							
	Supply Fan Start/Stop							X																																
	Freeze Stat																																							
	Fire Alarm Shutdown									X																														
	Service Shutdown Switch									X																														
	Shutdown Reset Switch									X																														
	OA Damper																																							











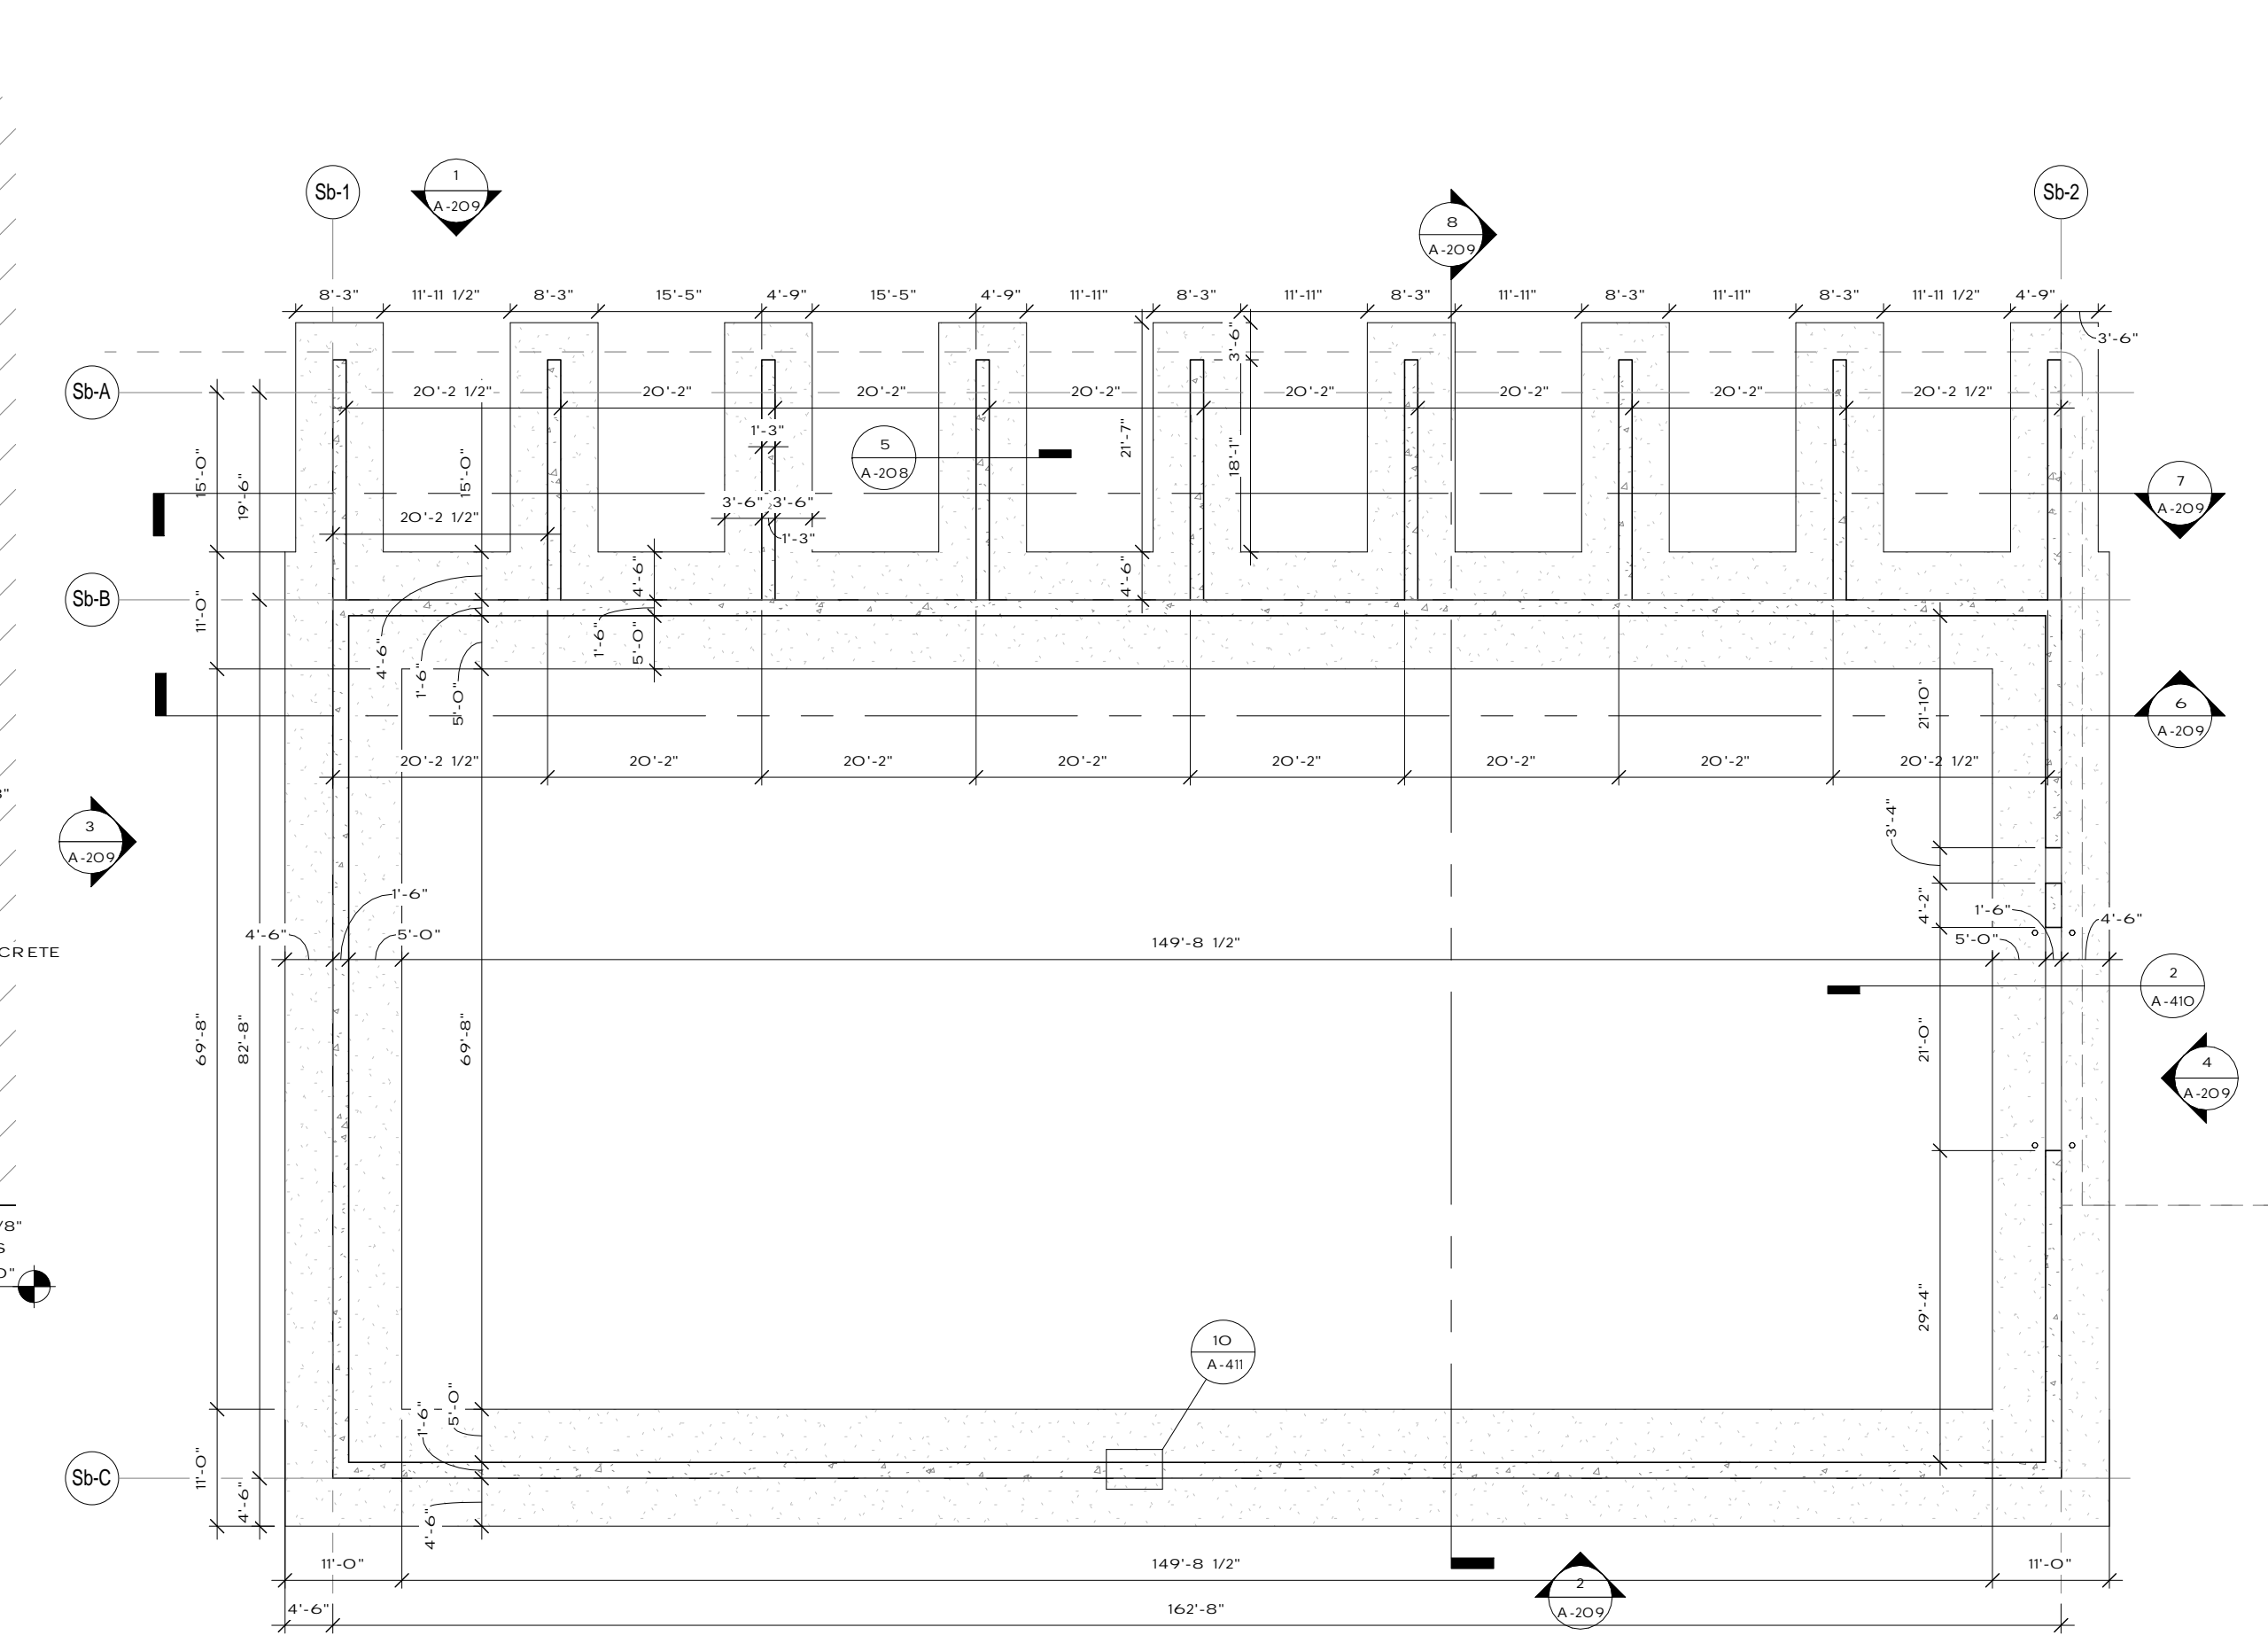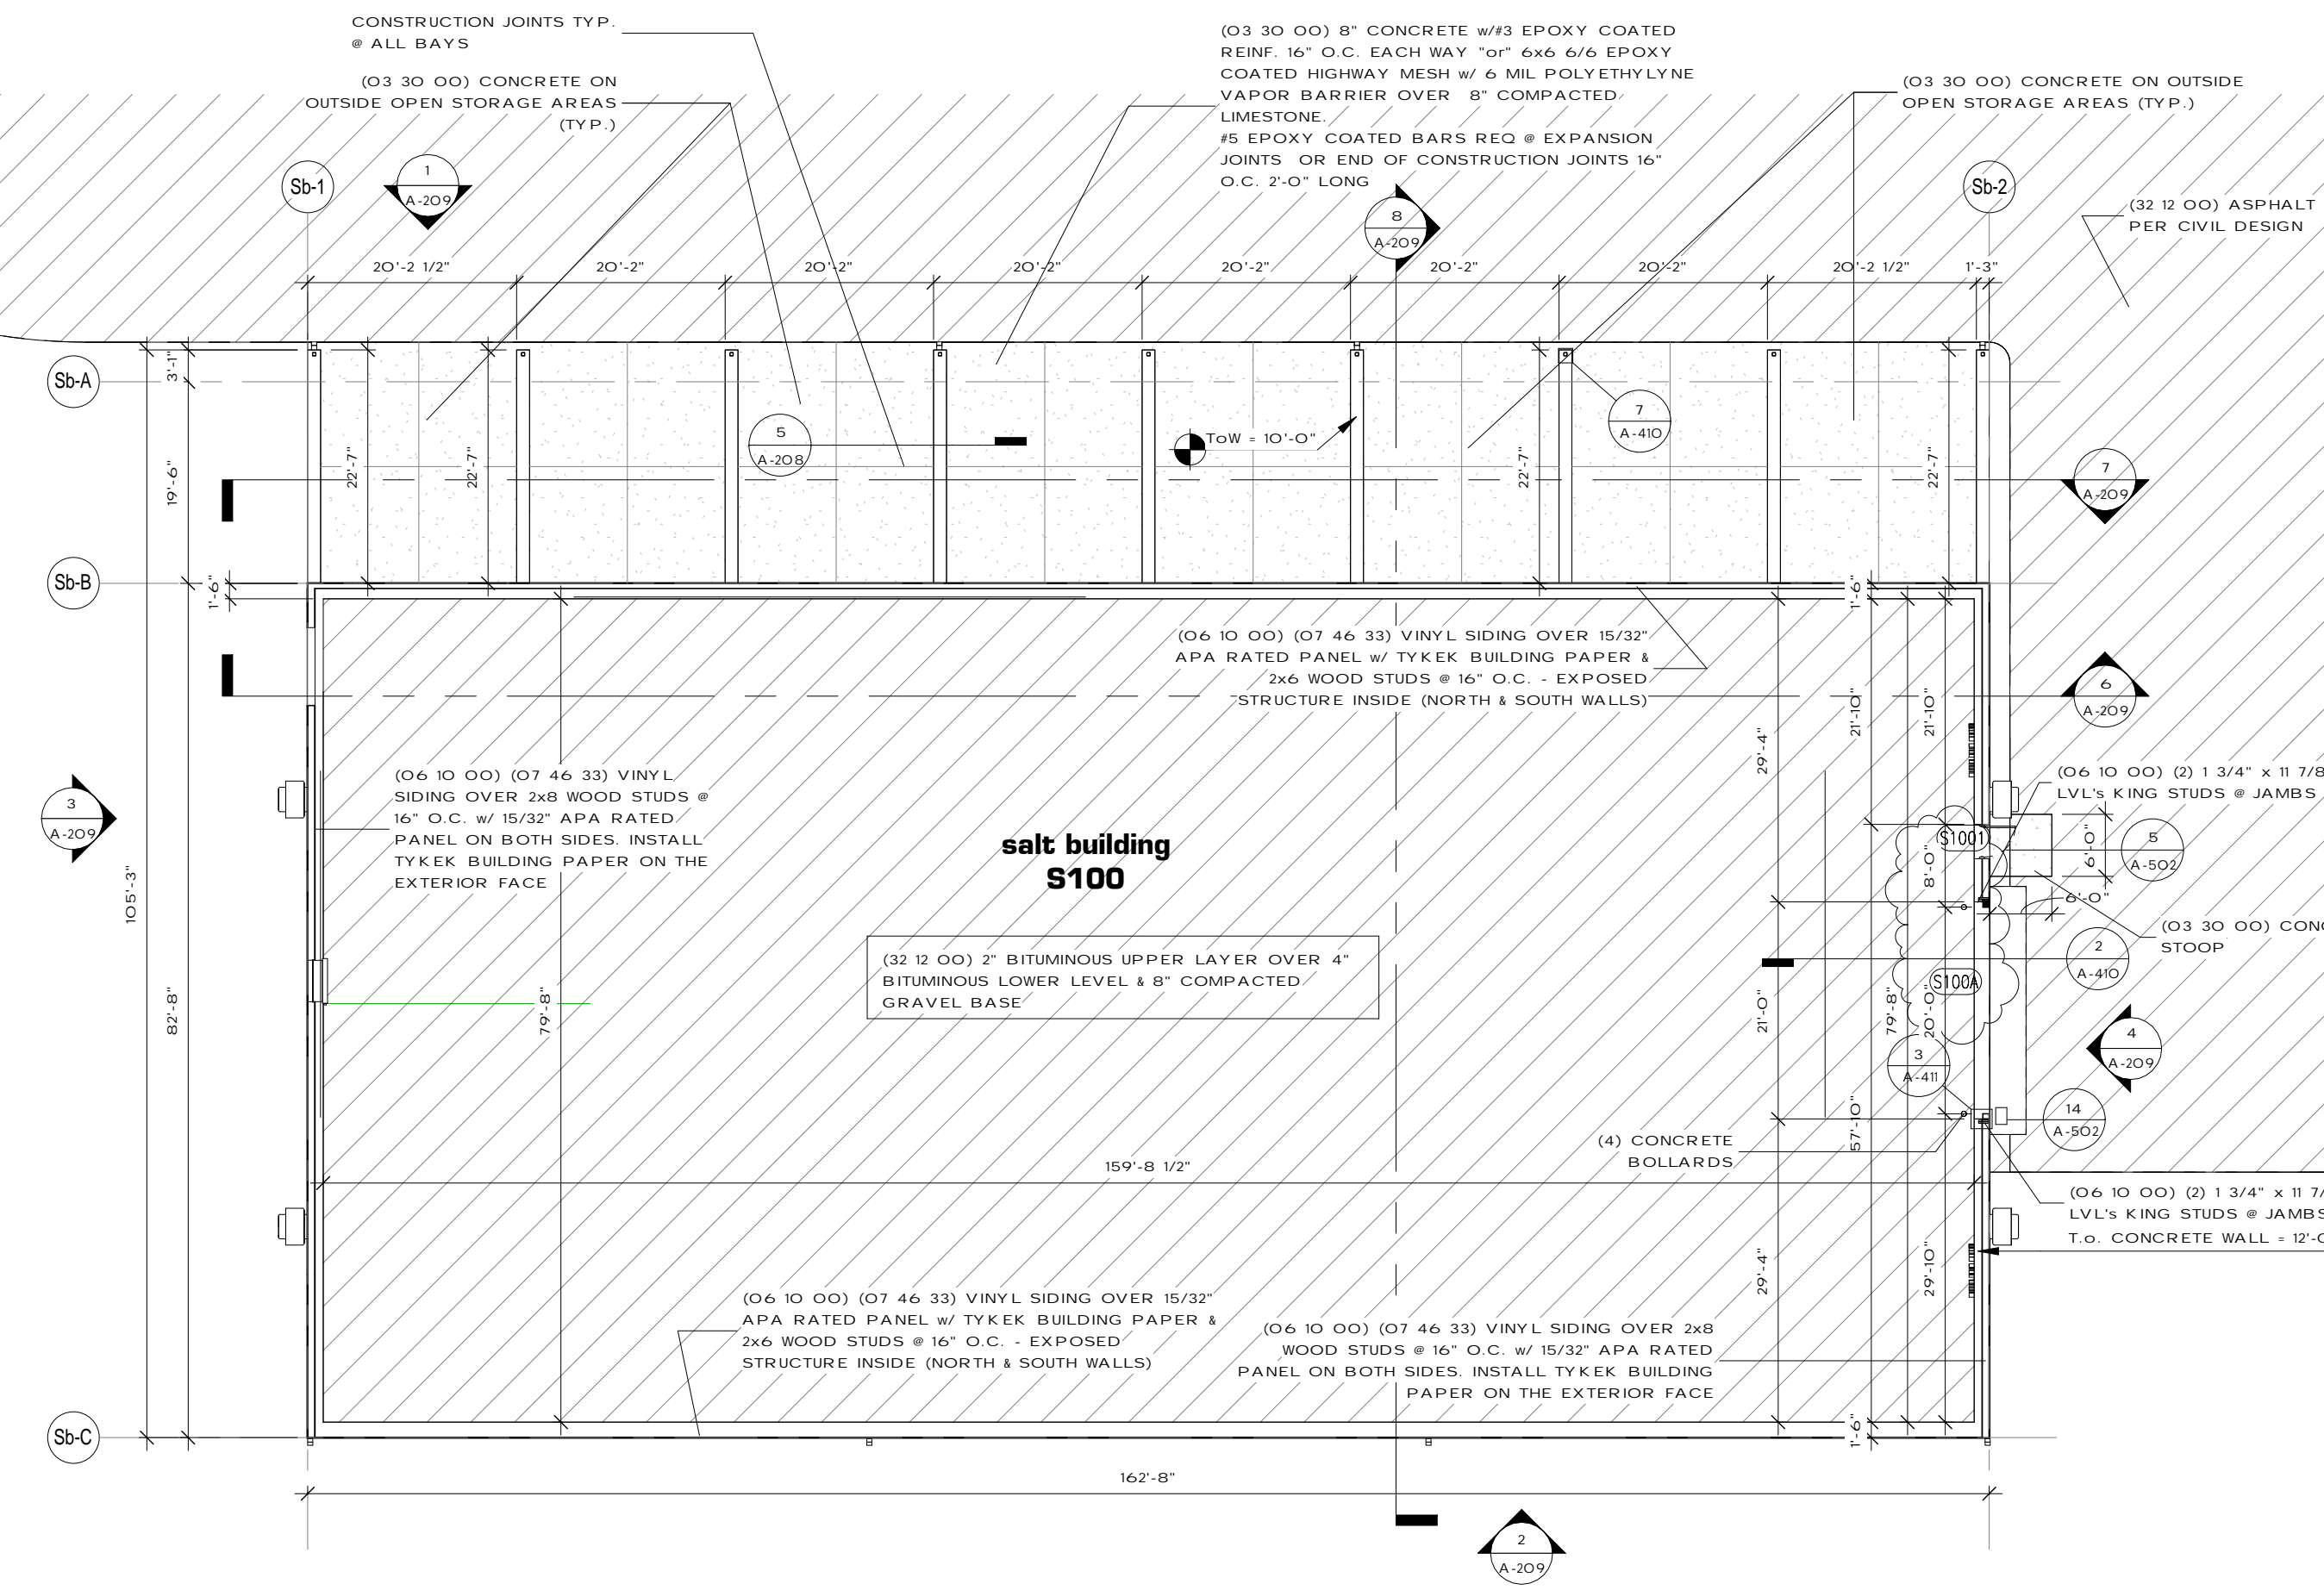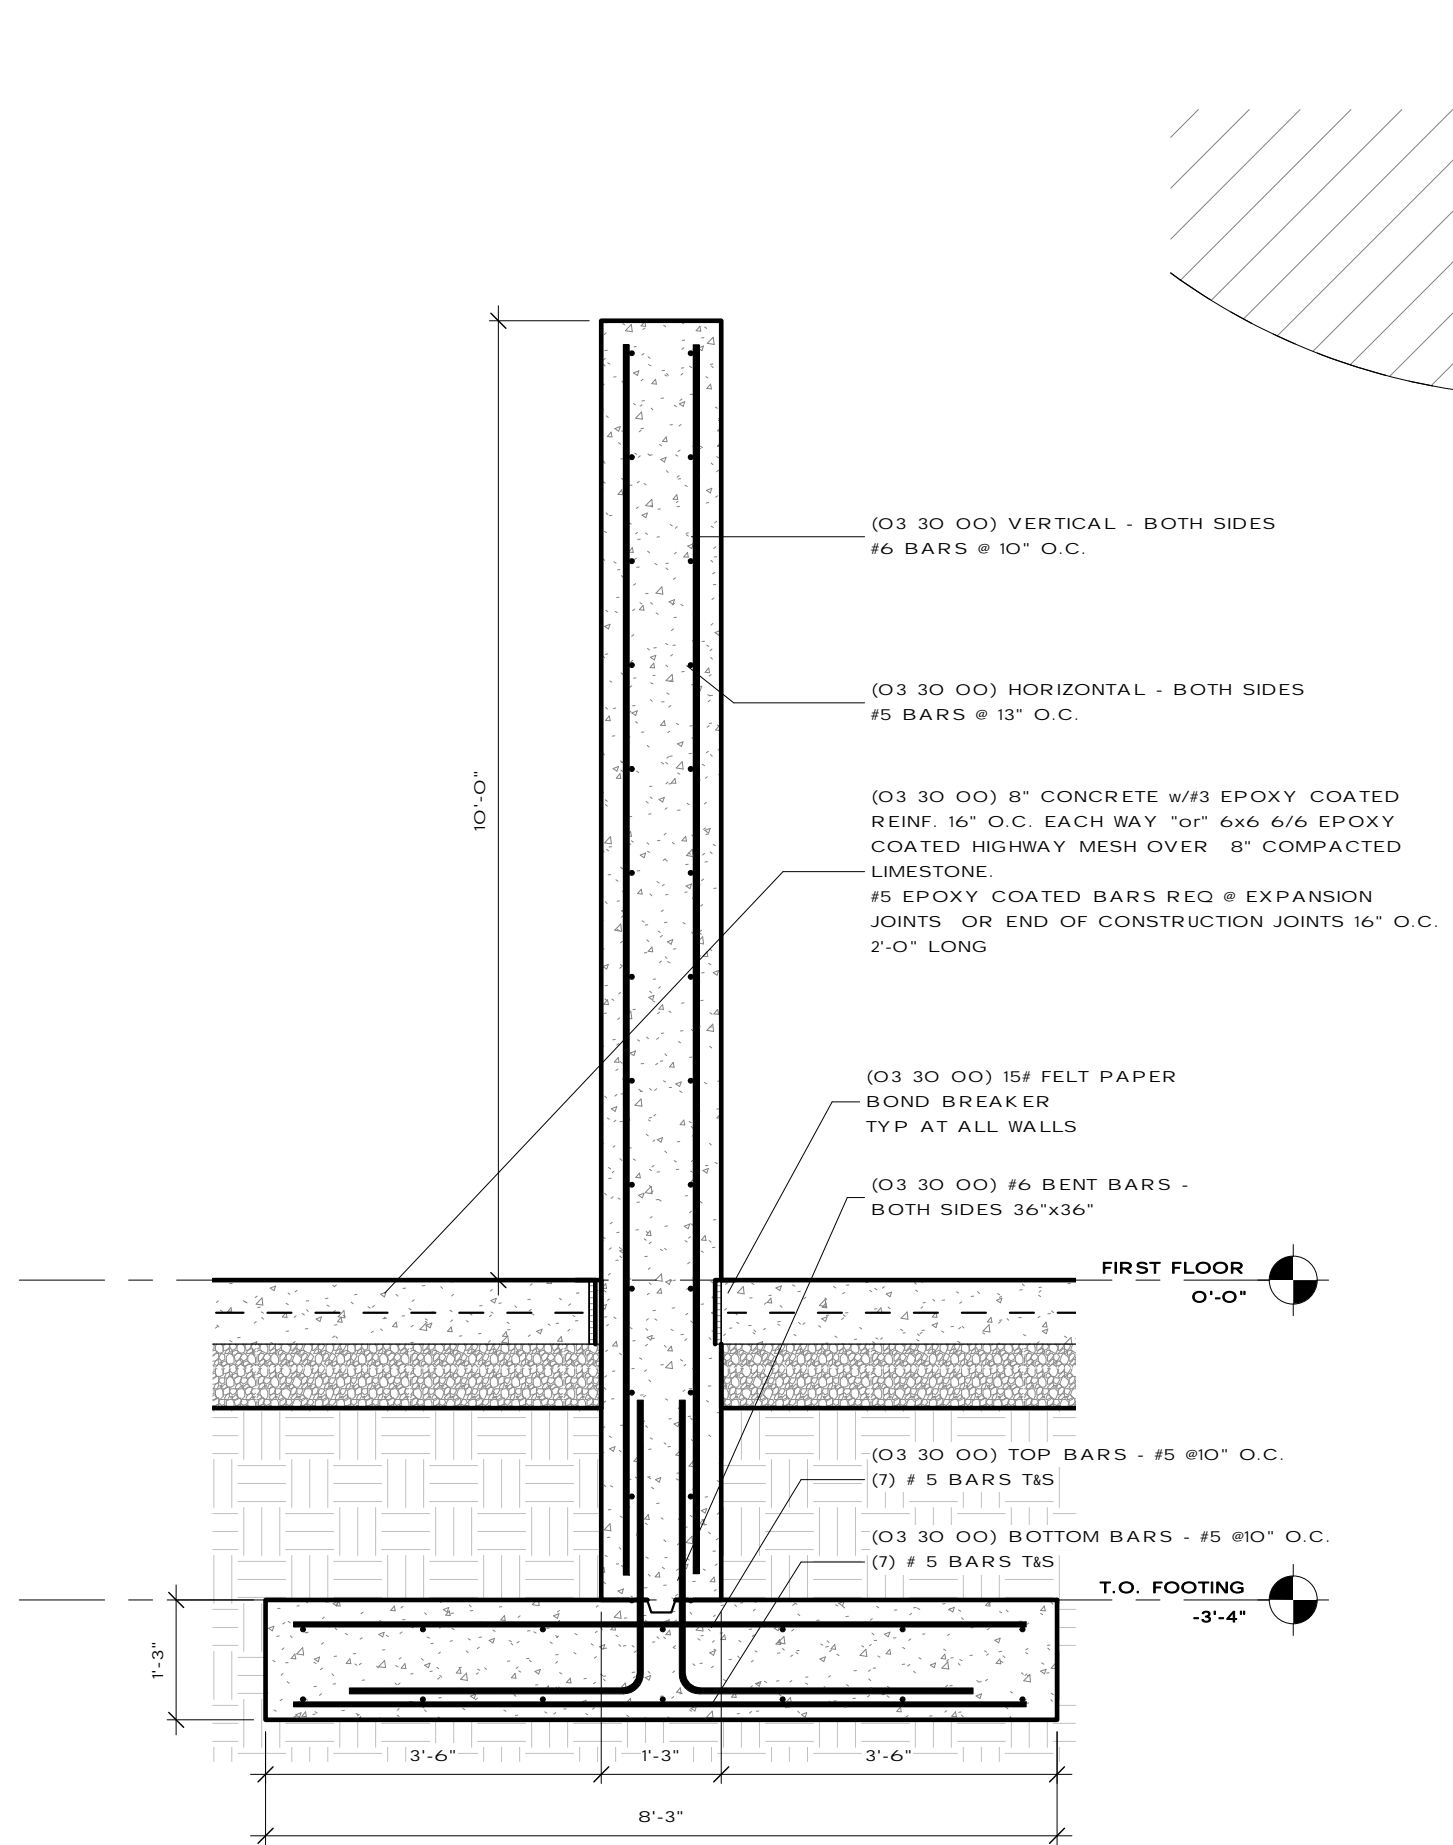

**5 Salt Building - Side Bins Typ. Wall**  
1/2" = 1'-0"


**2 Salt Building - Floor Plan - Phase 1**  
1/16" = 1'-0"

**1 Salt Building - Foundation Plan - Phase 1**  
1/16" = 1'-0"

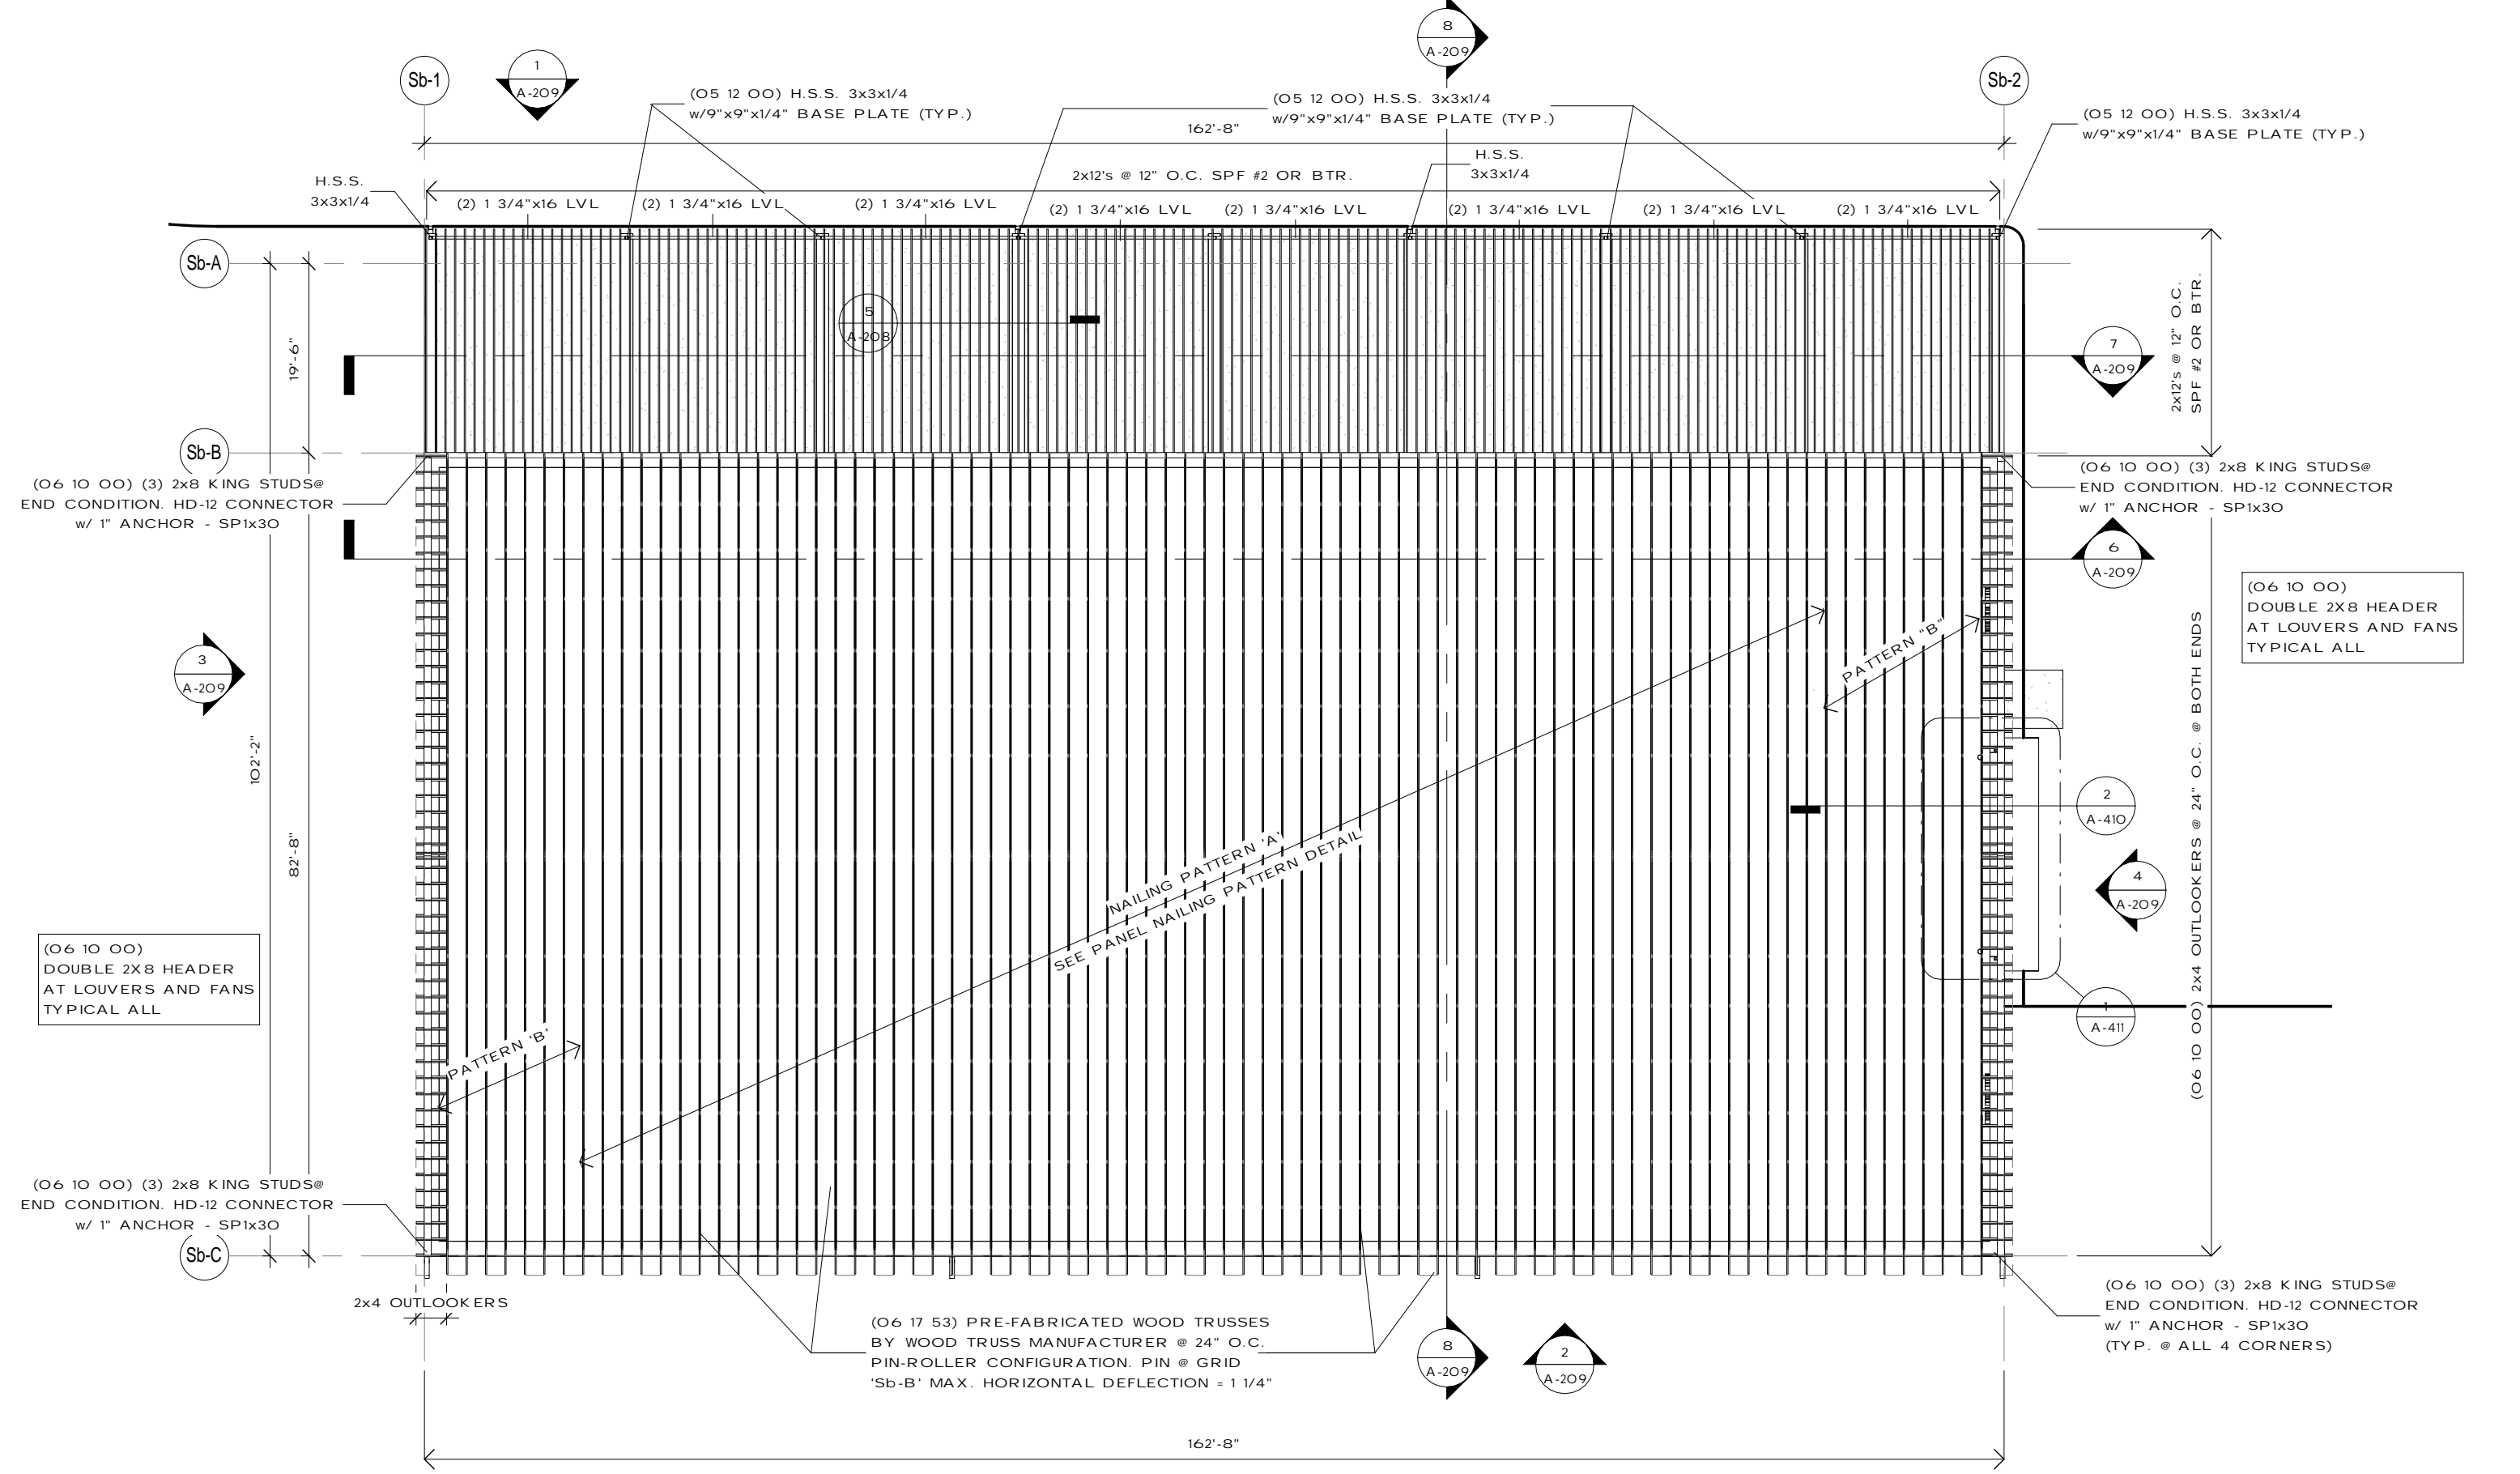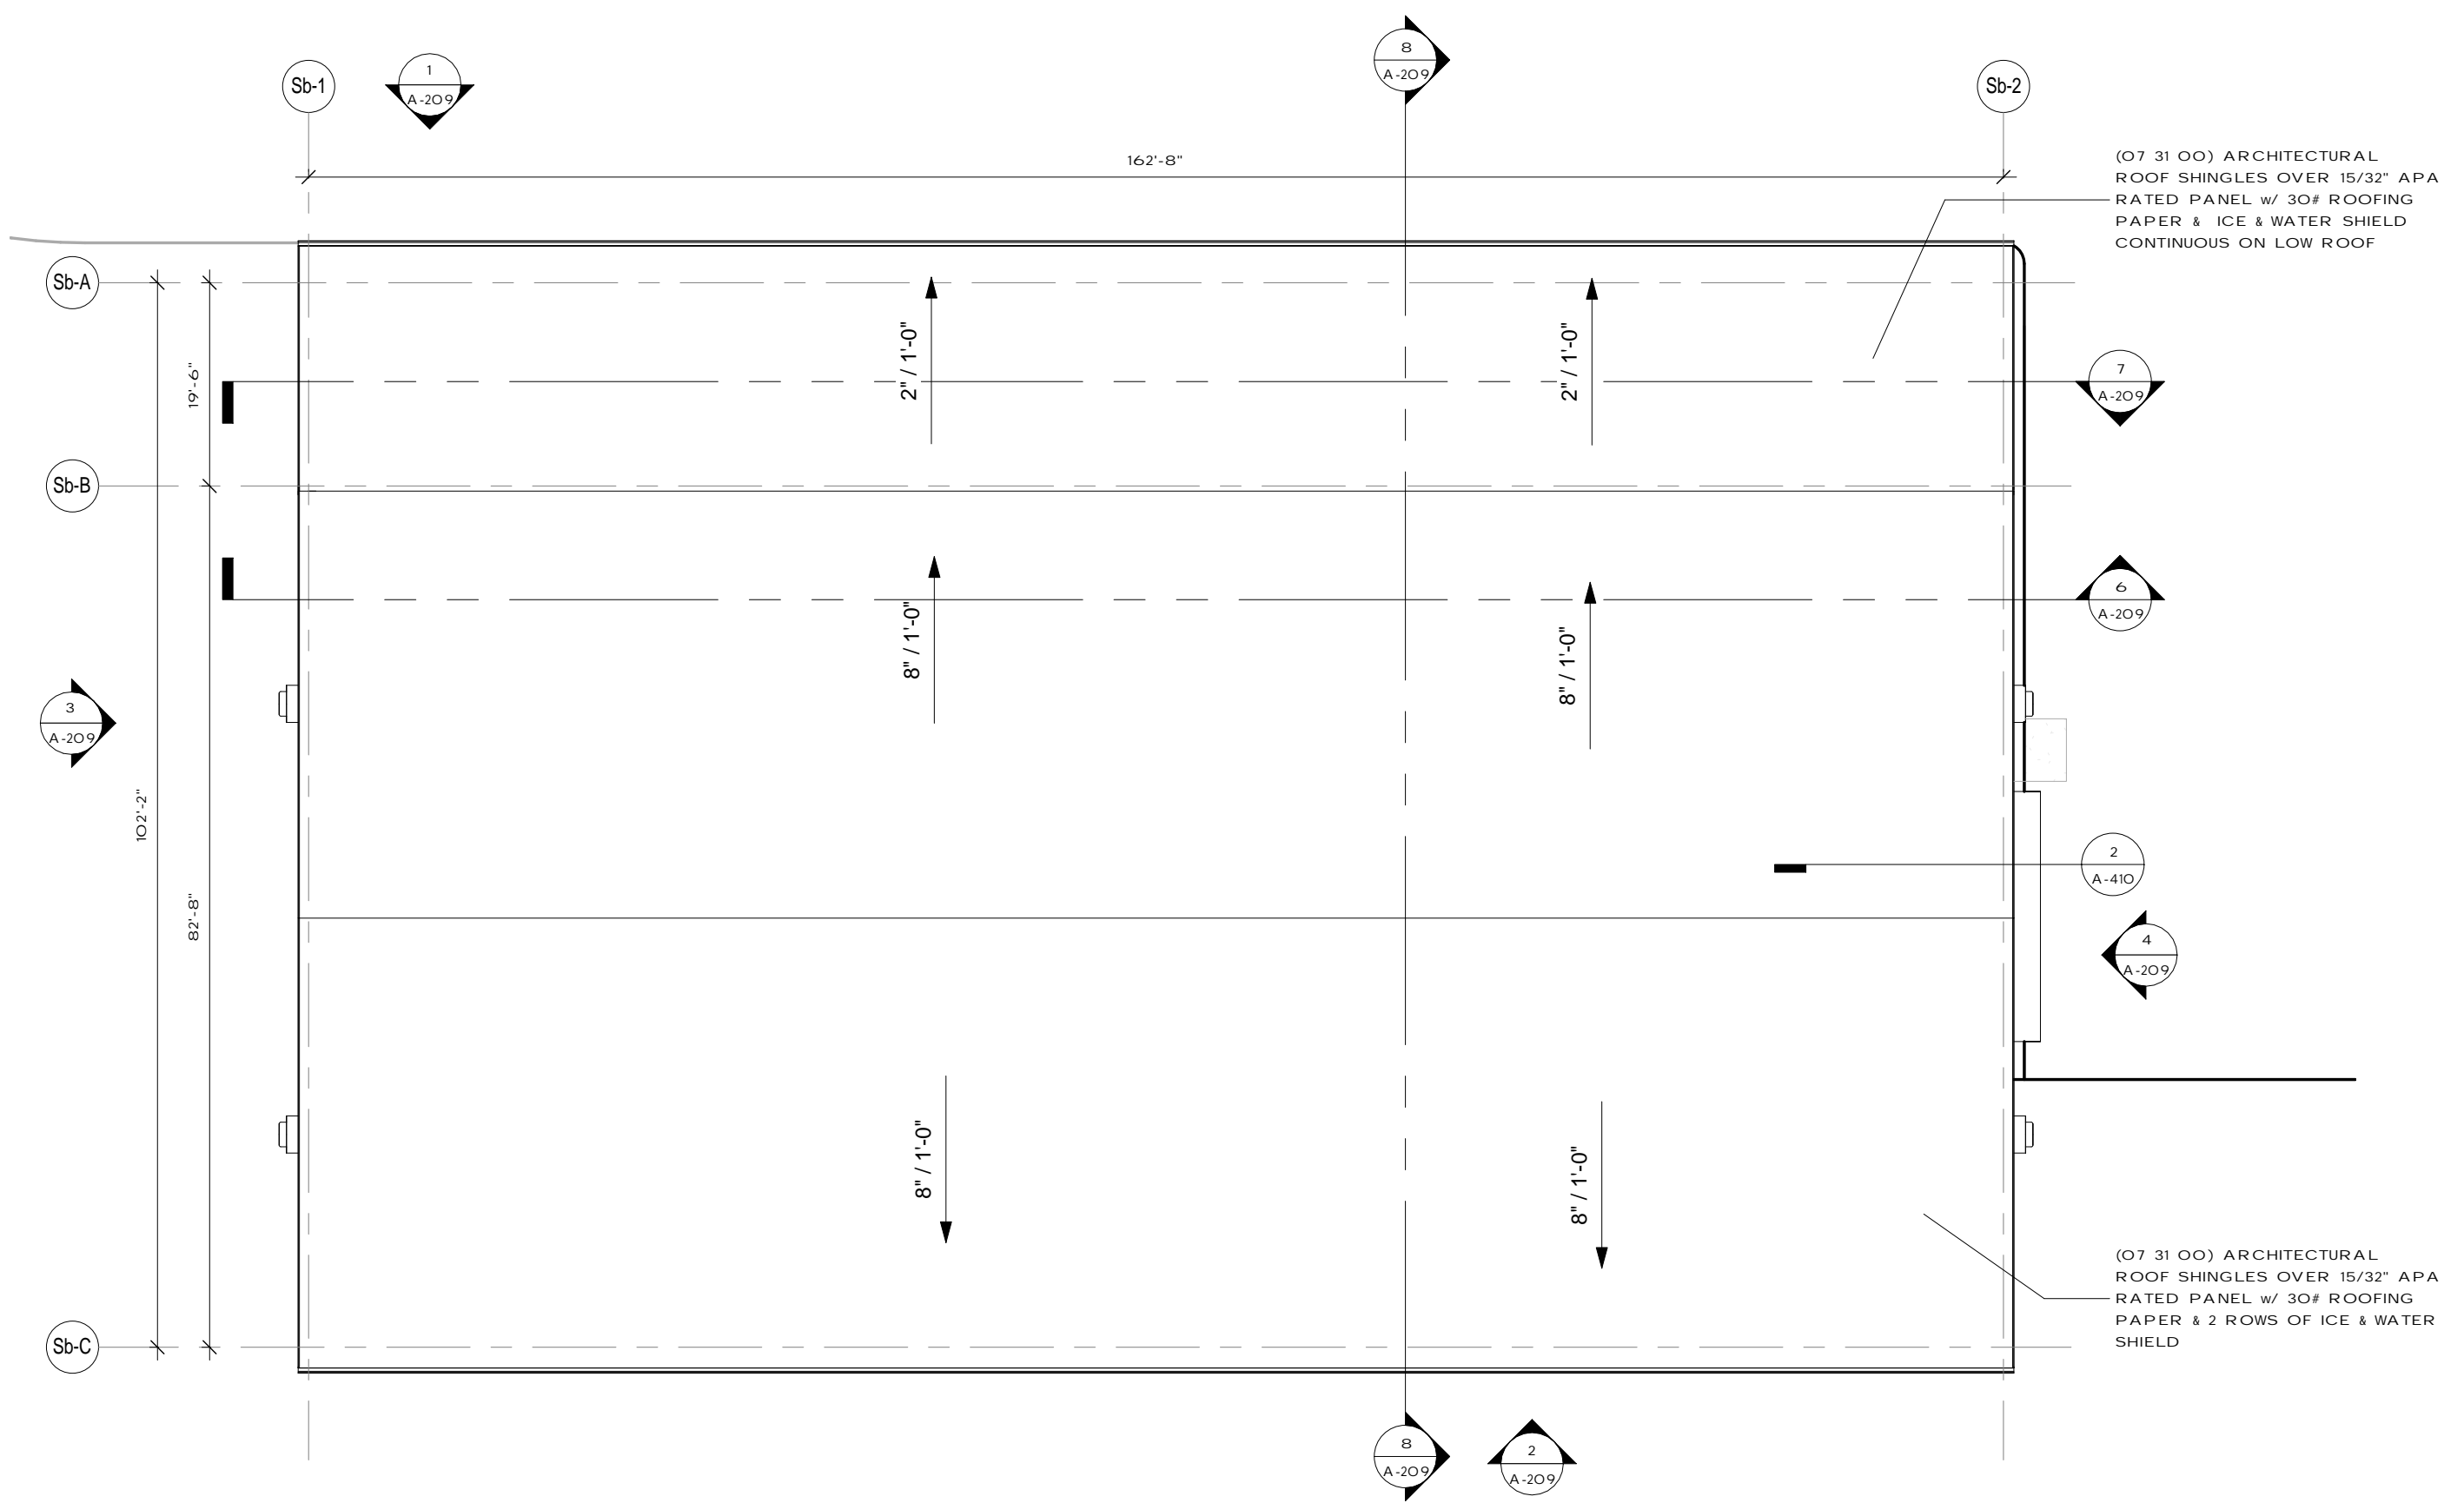


**4 Salt Building - Roof Plan - Phase 1**  
1/16" = 1'-0"


**3 Salt Building - Framing - Phase 1**  
1/16" = 1'-0"

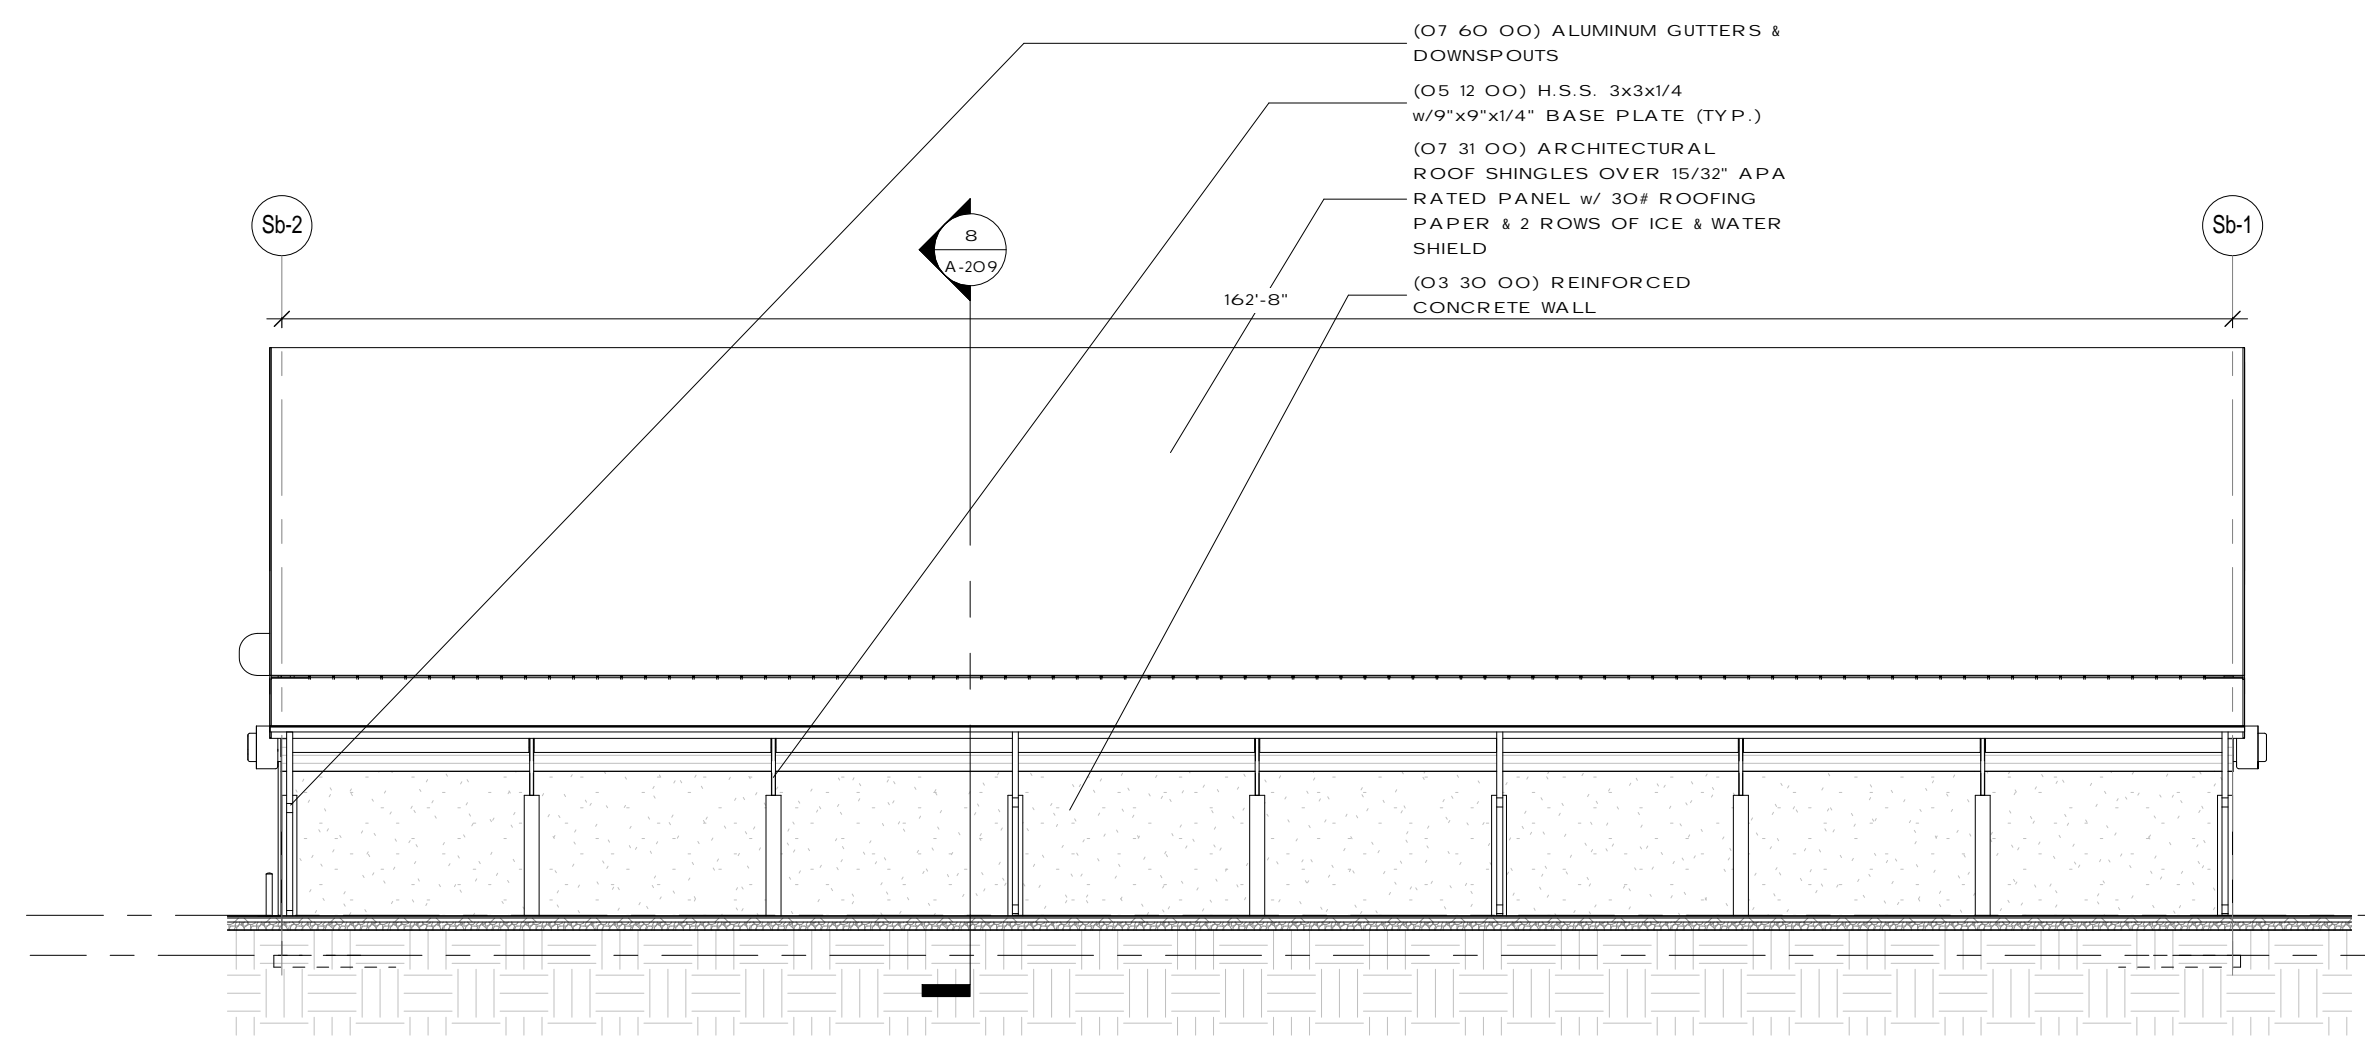


**1 Salt Building - North Elevation**  
1/16" = 1'-0"

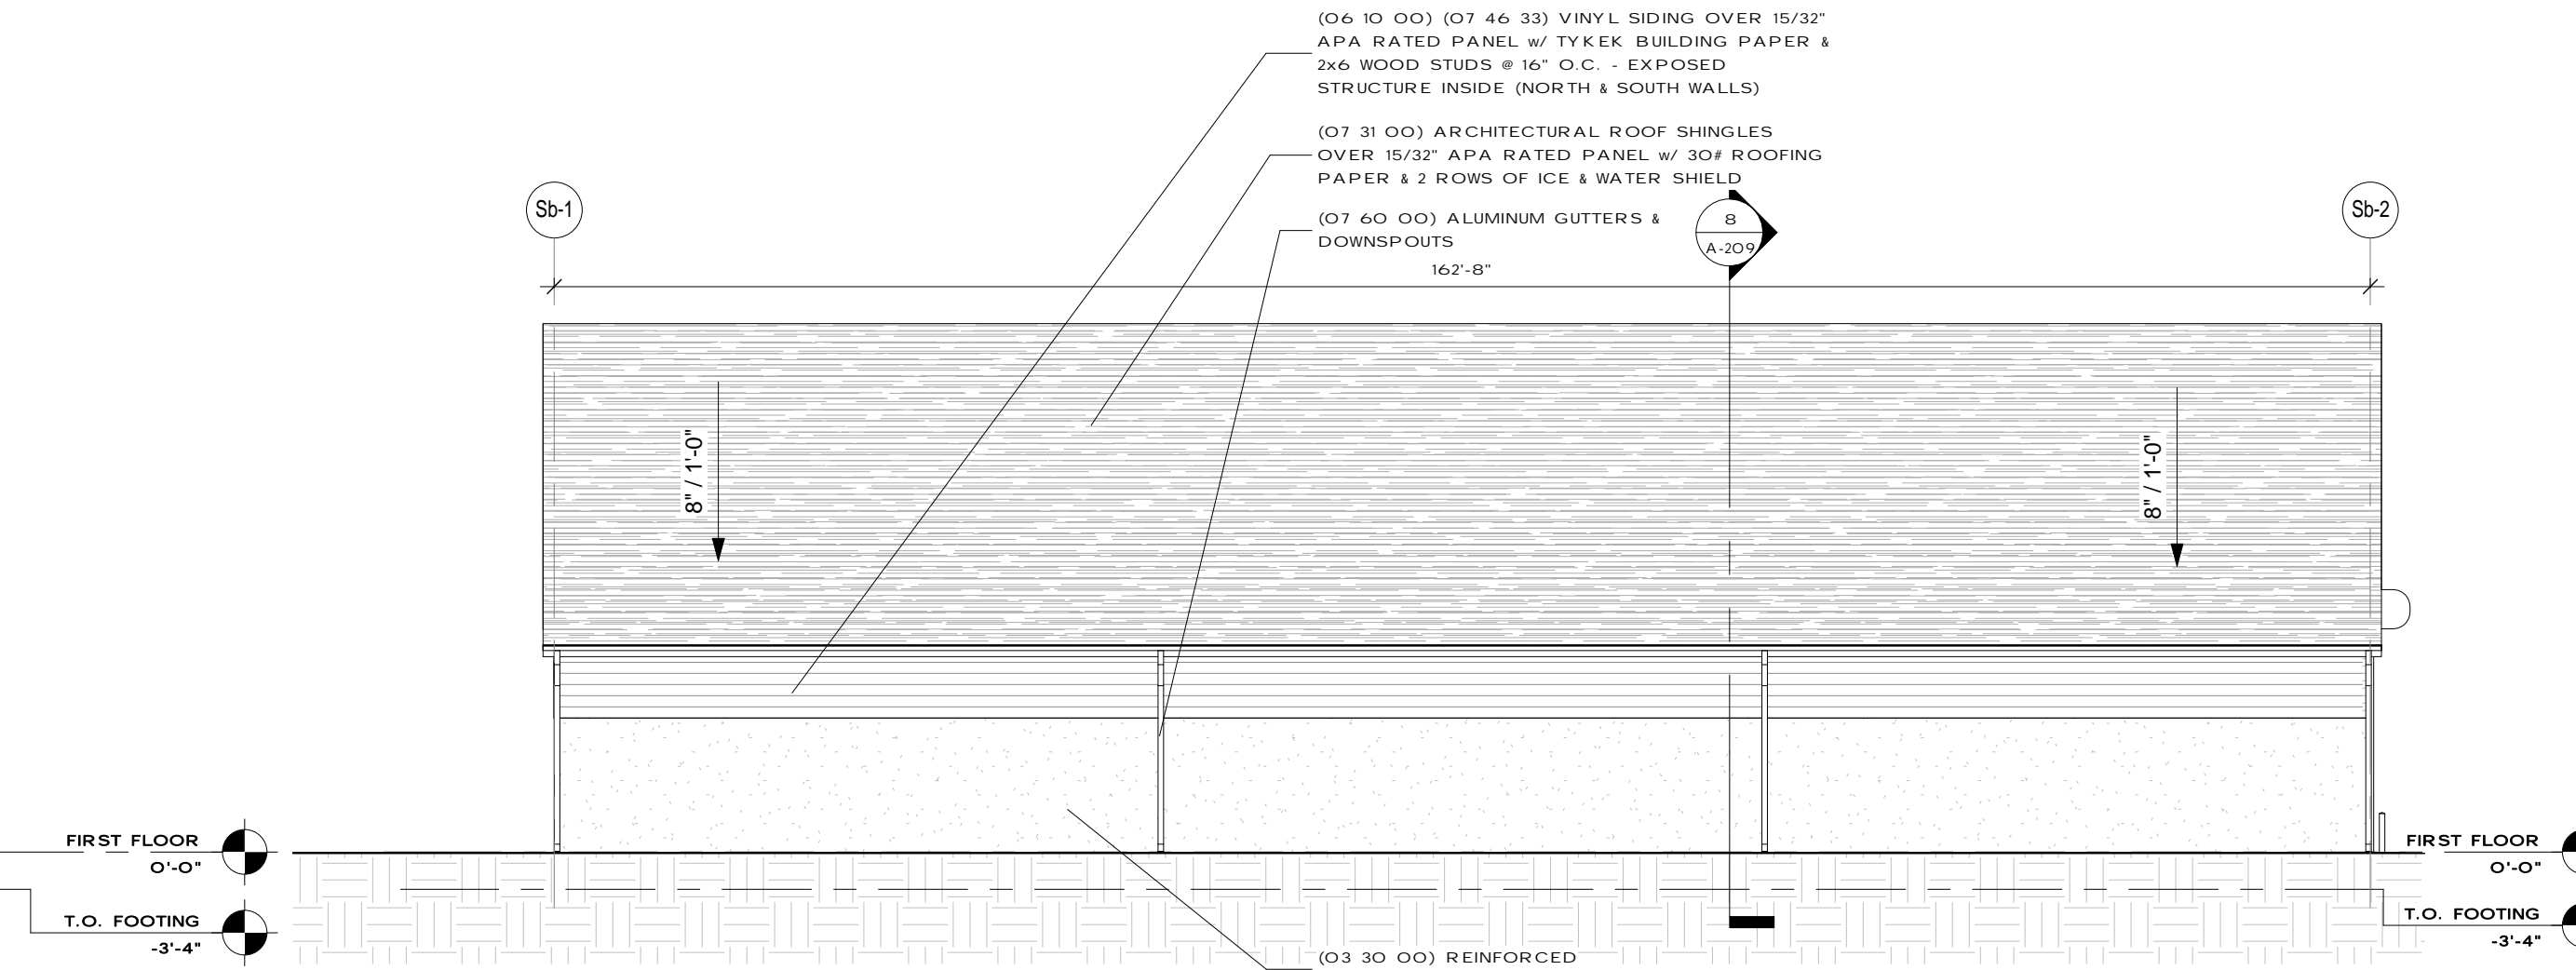


**2 Salt Building - South Elevation**  
1/16" = 1'-0"

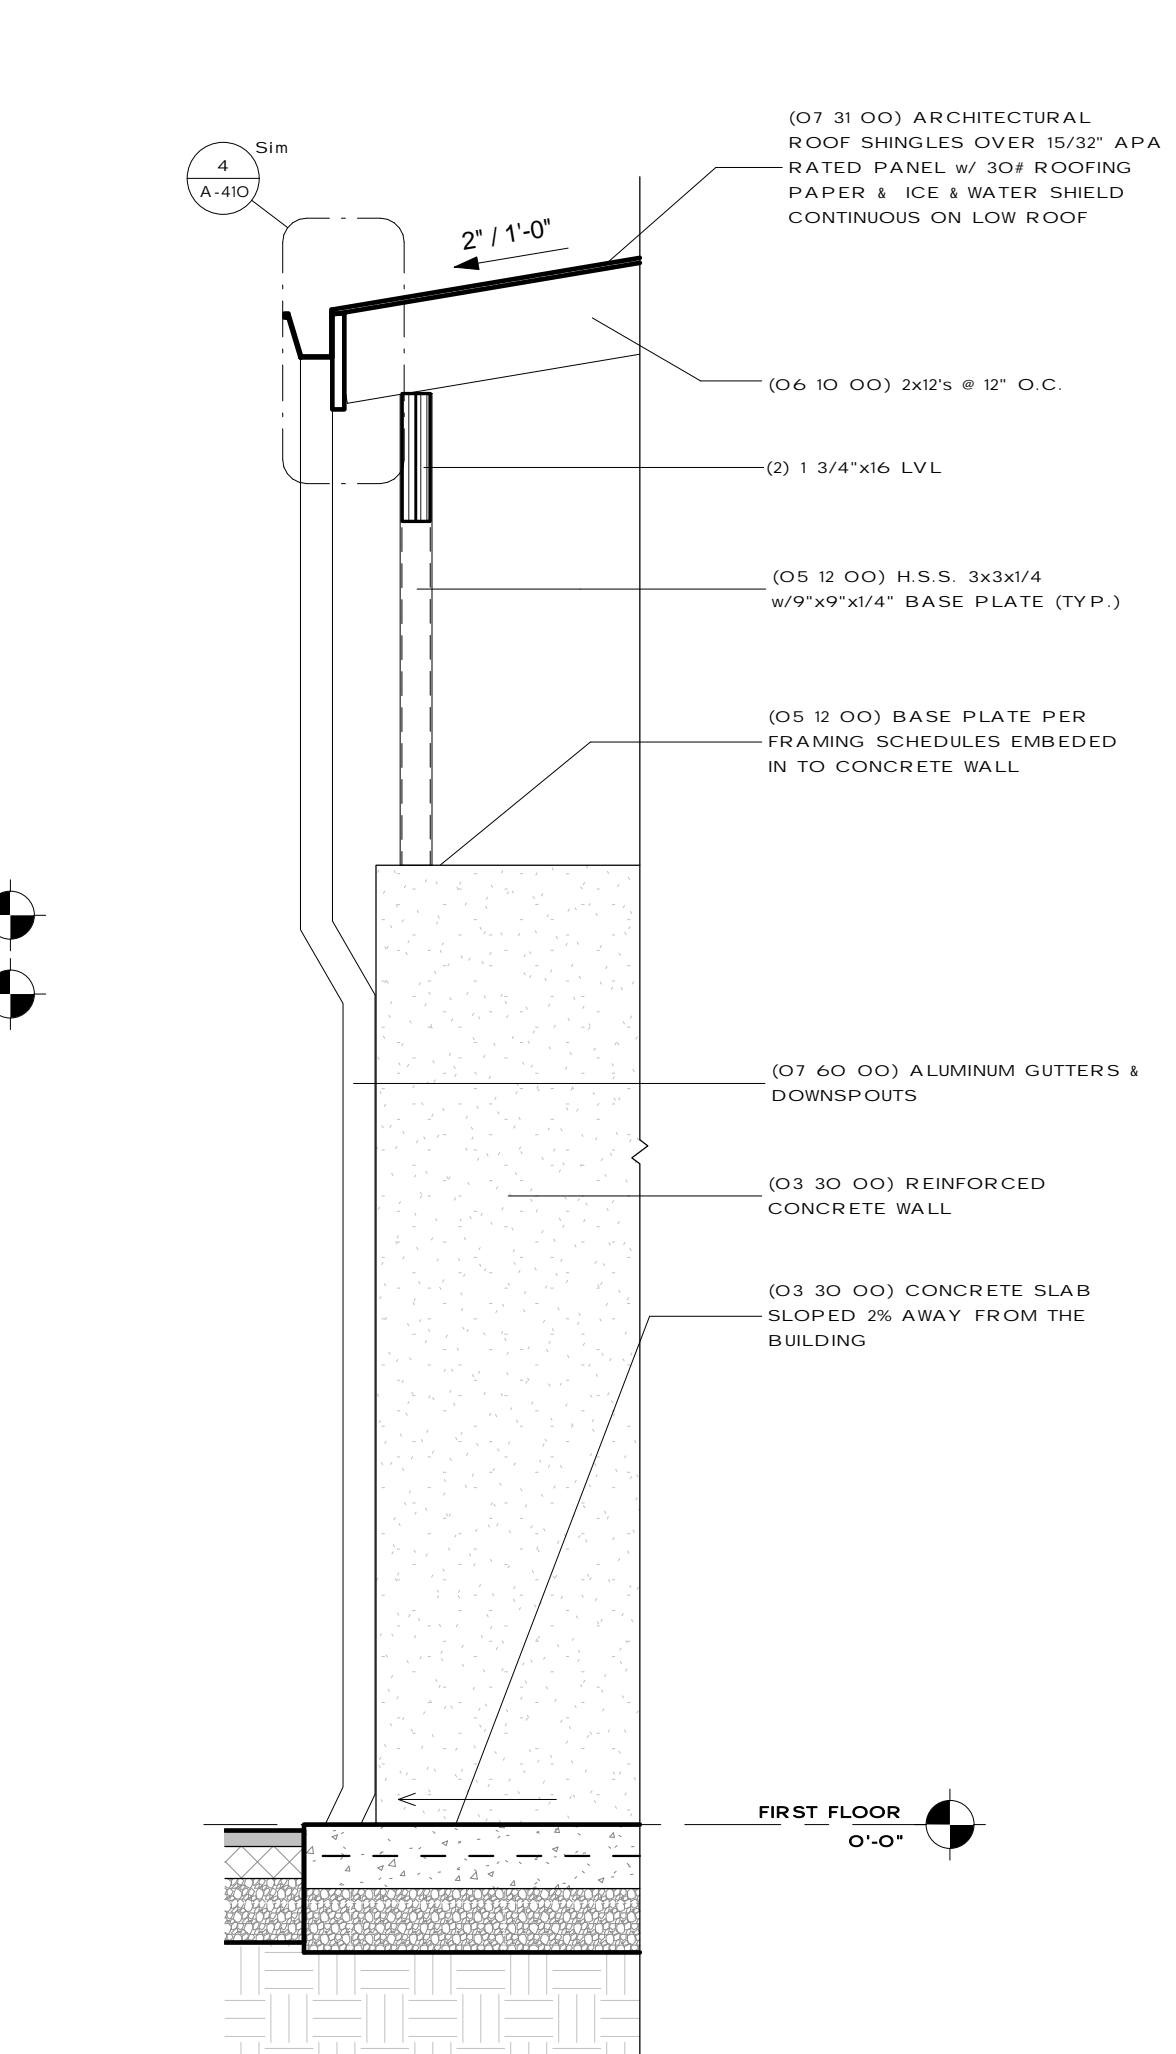


**5 Salt Building - Wall Section 2**  
1/2" = 1'-0"

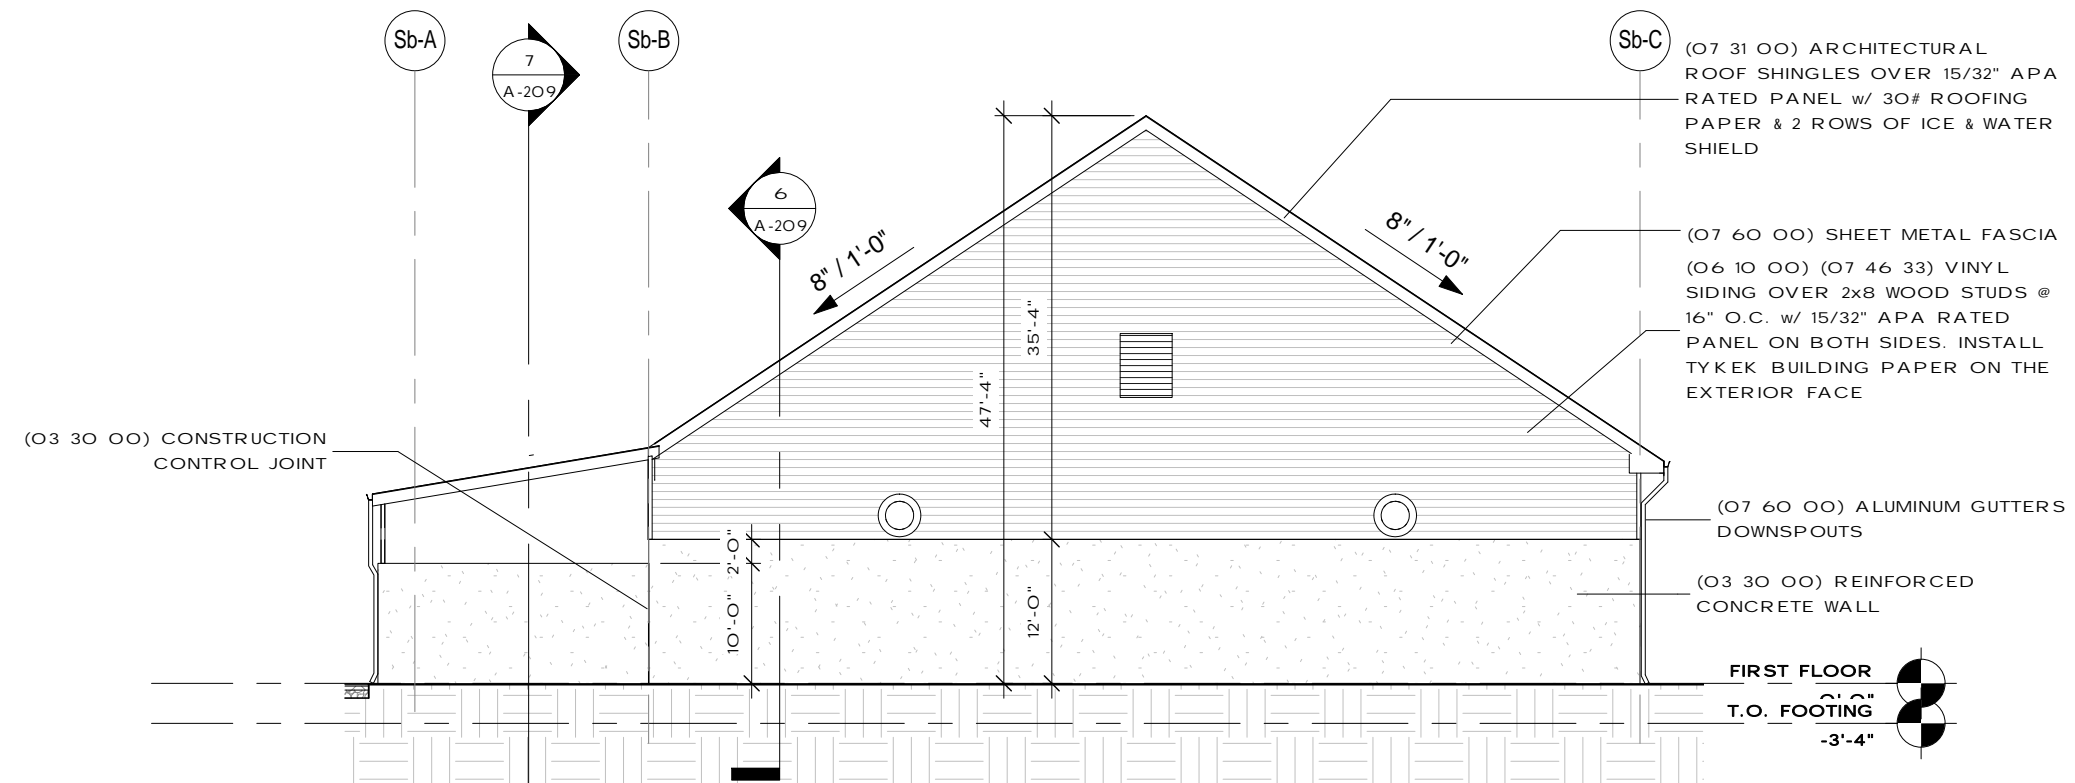


**3 Salt Building - West Elevation**  
1/16" = 1'-0"

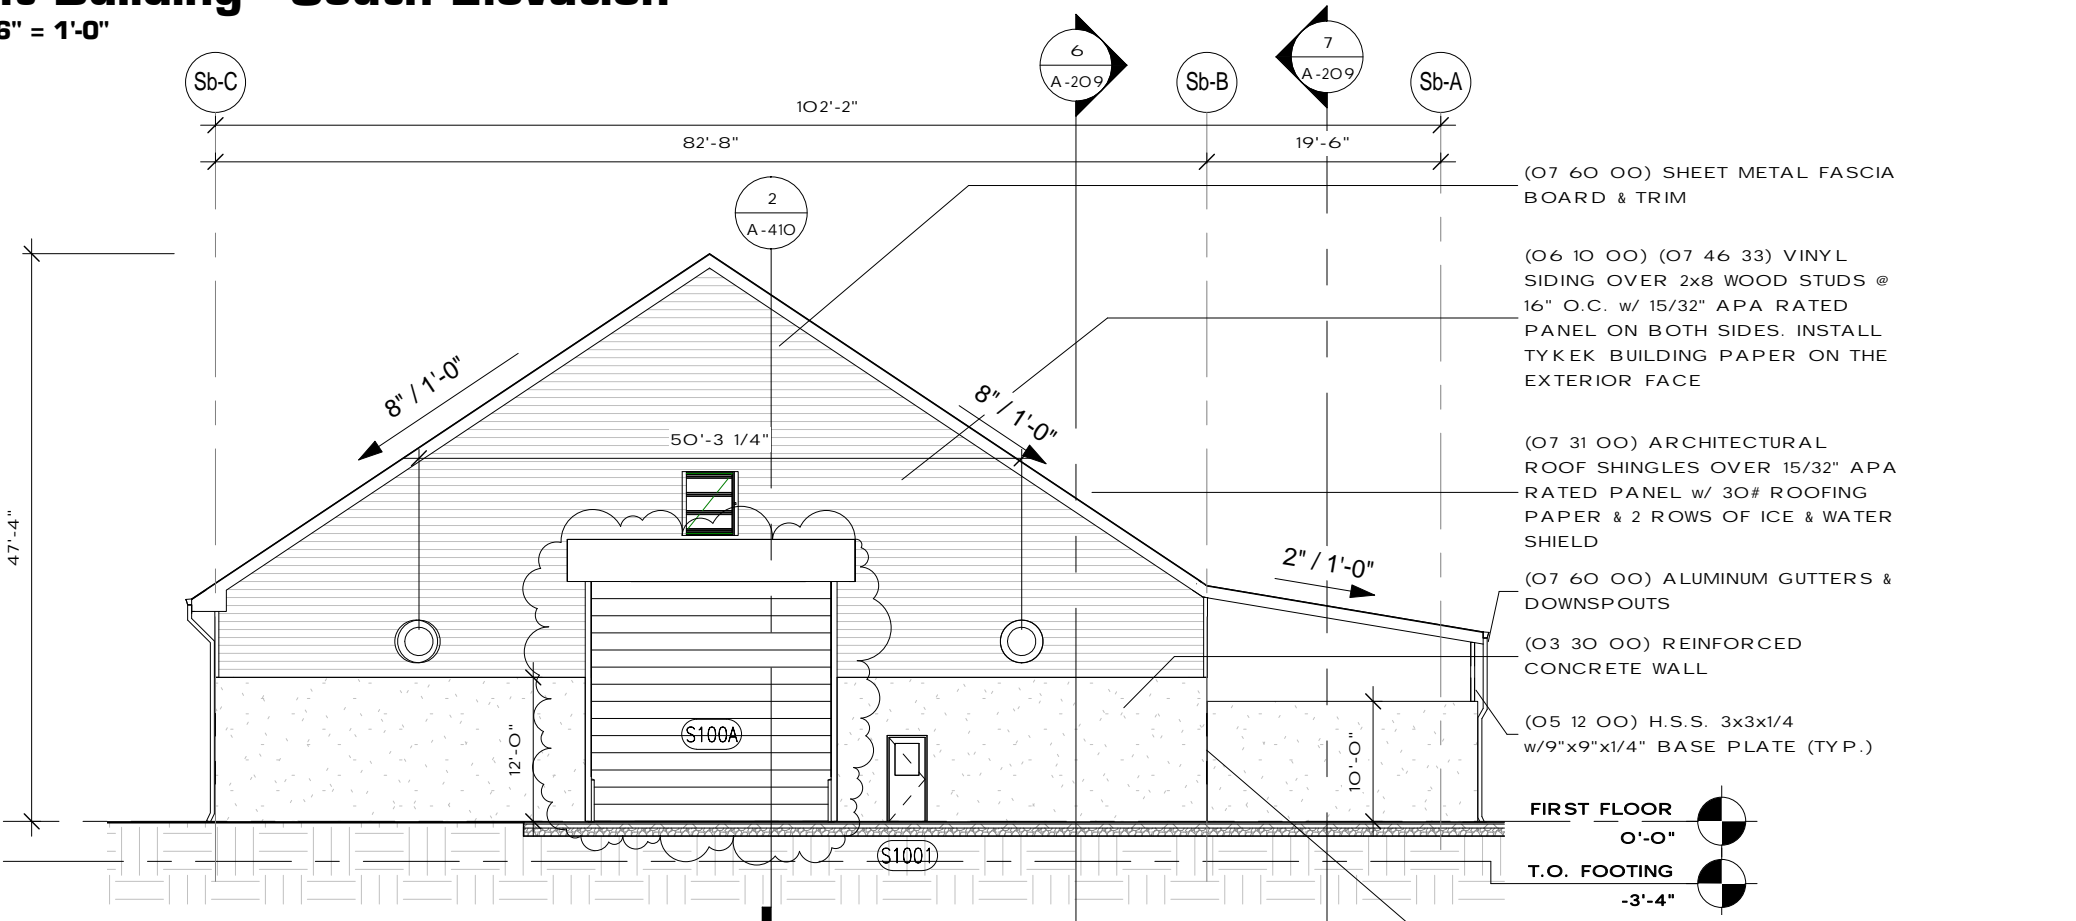


**4 Salt Building - East Elevation**  
1/16" = 1'-0"

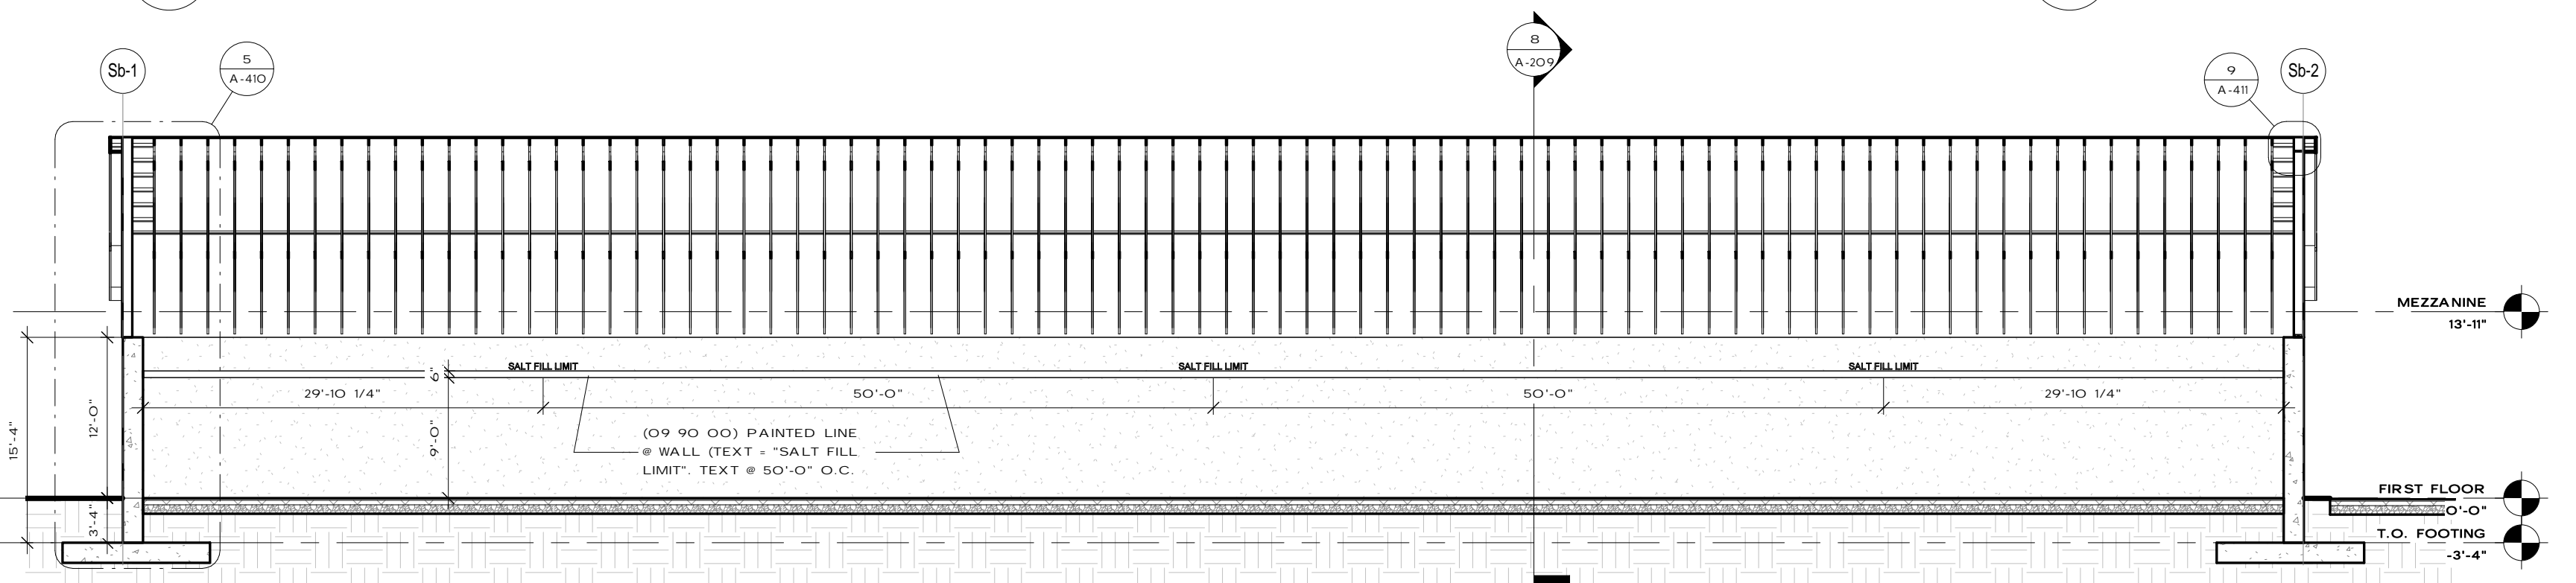

**6 Salt Building - Section B-B**  
3/32" = 1'-0"

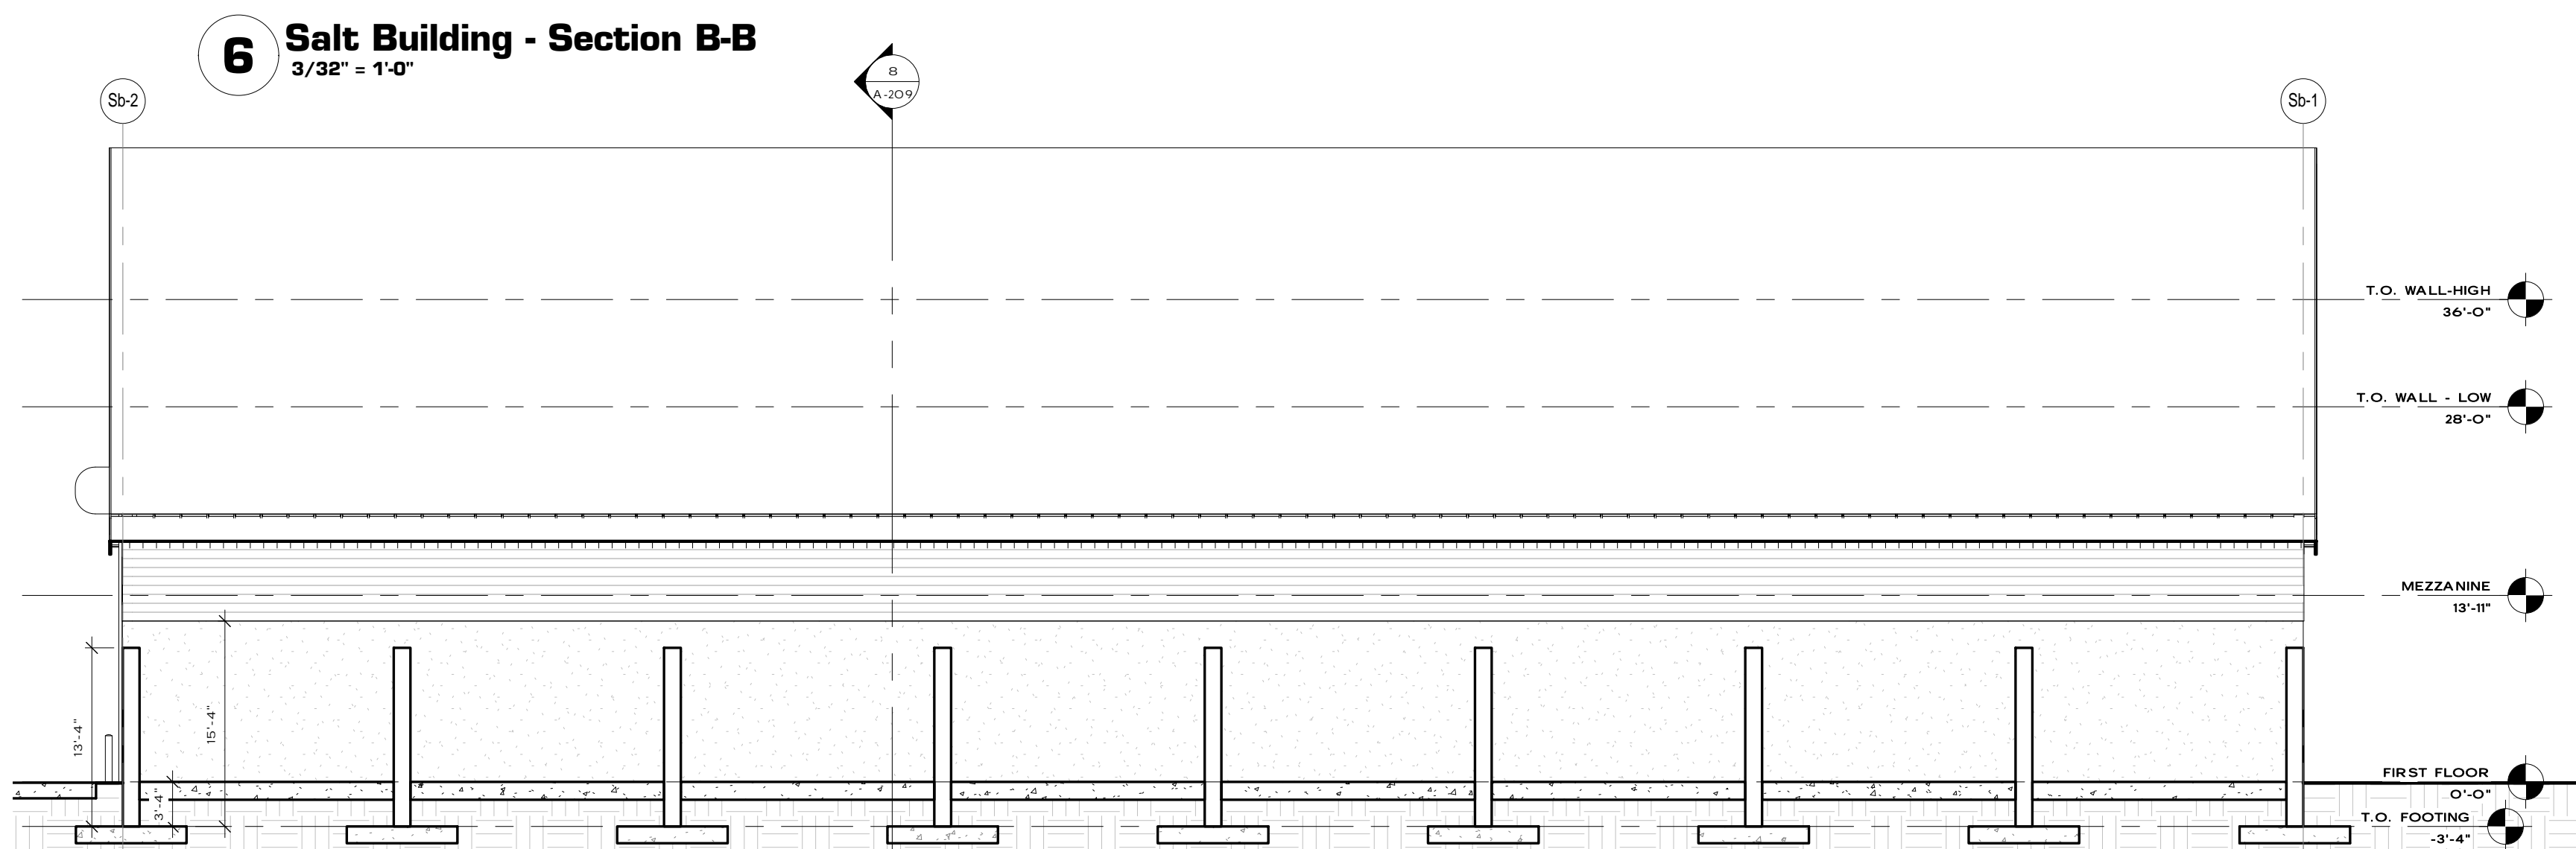

**7 Salt Building - Section C-C**  
3/32" = 1'-0"

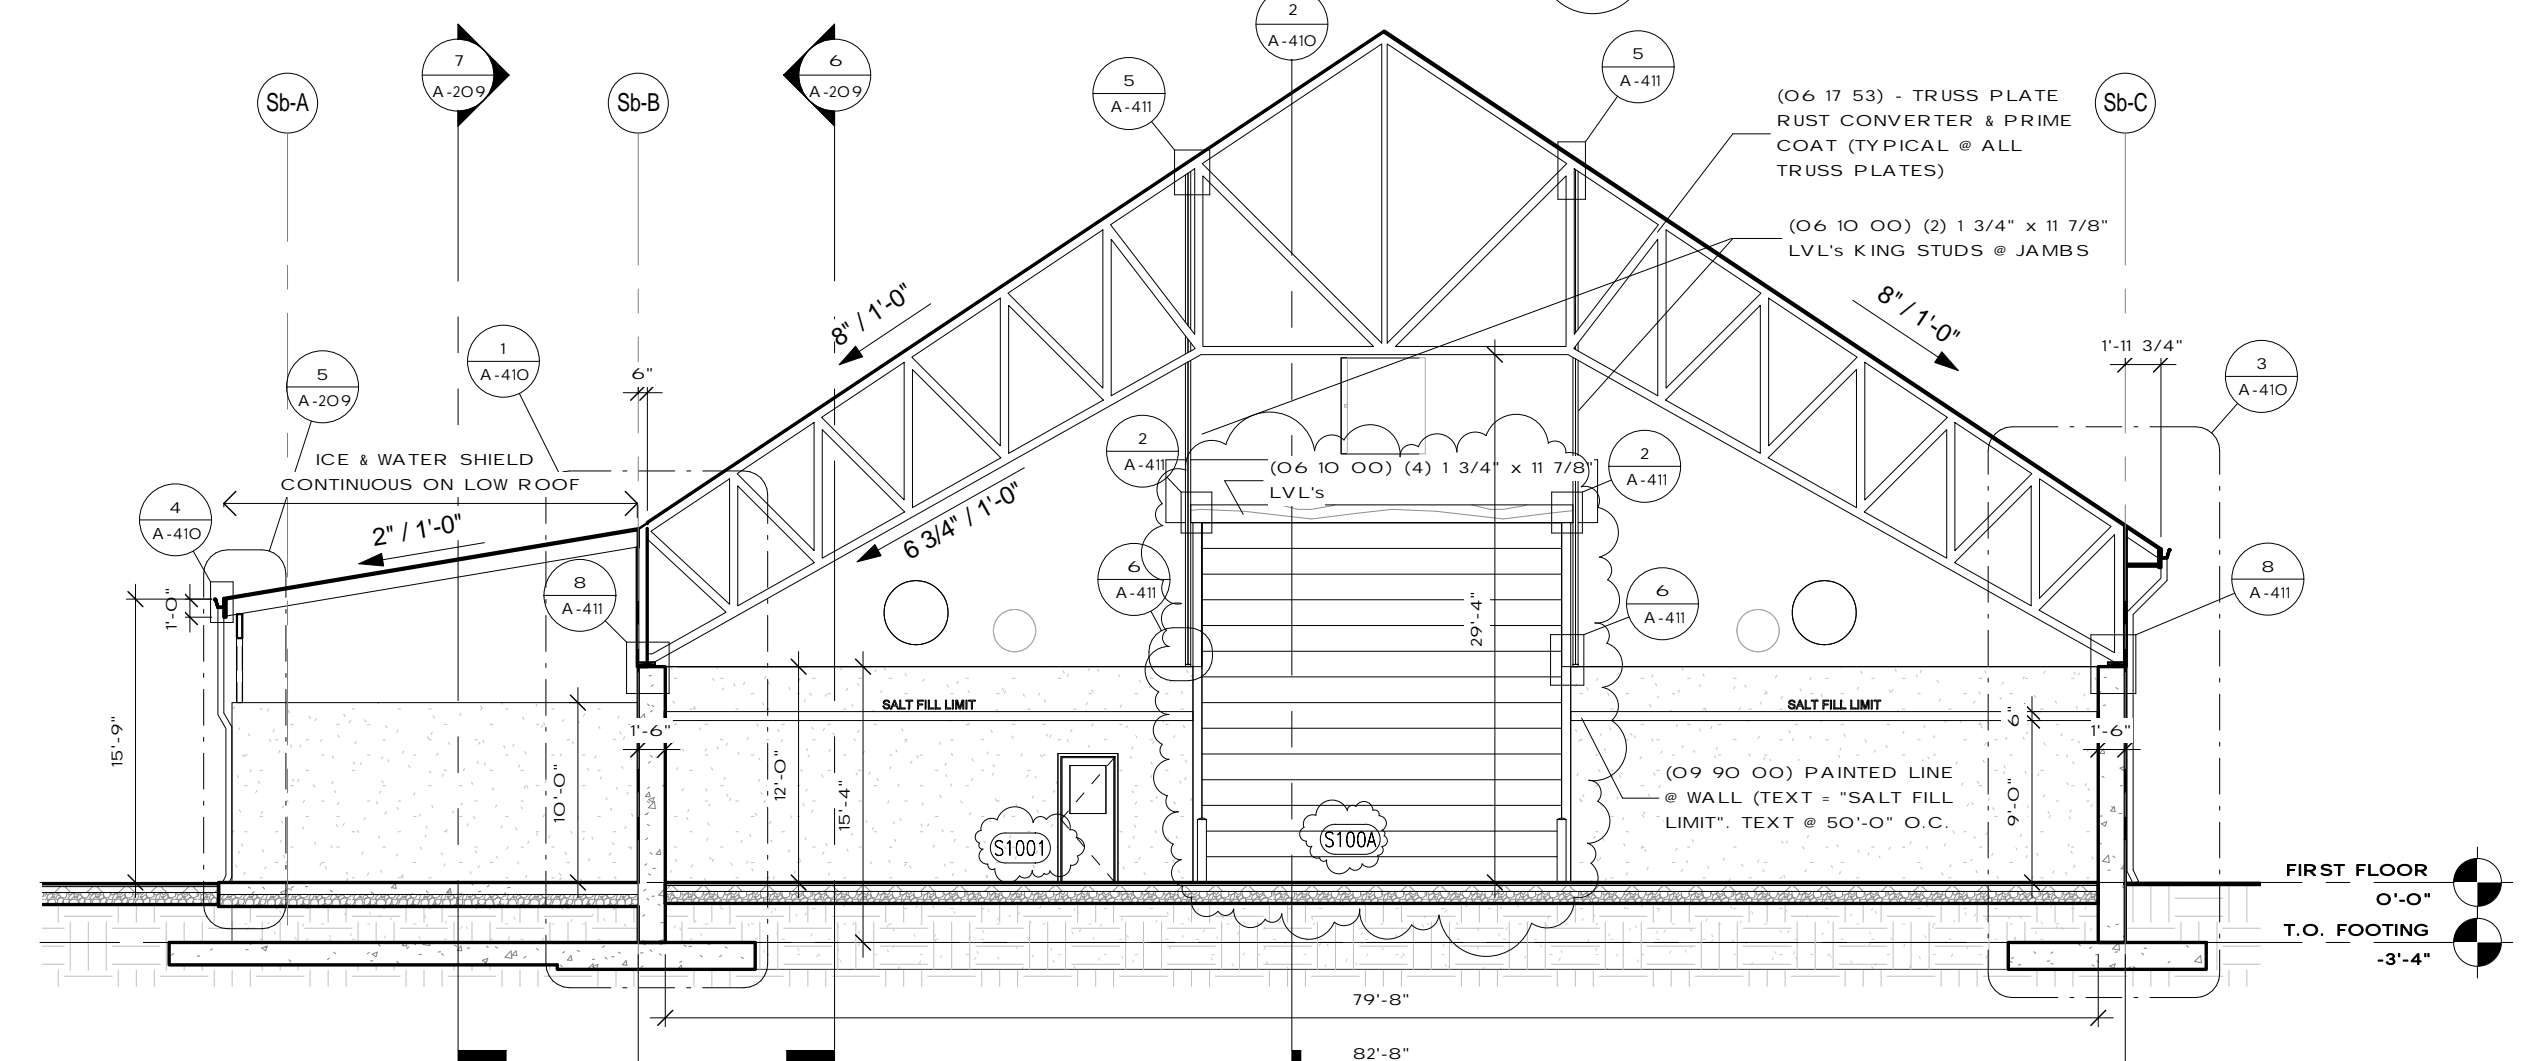


**8 Salt Building - Section A-A**  
3/32" = 1'-0"

**DOOR SCHEDULE - SALT BUILDING**


MARK	FROM ROOM	TO ROOM	DOOR							FRAME			REMARKS			
			NUM	NAME	TYPE	MATERIAL	SWING	WIDTH	HEIGHT	THICKNESS	LOUVER	GLASS		TYPE	MATERIAL	GLASS
S100A	S100 salt building	exterior	-	exterior	CD				20'-0"	20'-0"	2"					Hardware by (08 30 00)
S1001	exterior	S100 salt building	HG	FRP	RHR	3'-0"	7'-0"	1 3/4"				GL-2	E	ALUMINUM		

**HARDWARE SCHEDULE - SALT BUILDING**


MARK	LOCKSET	PUSH-PULL	HOLD OPEN	CLOSER	HINGE	DOOR STOP	THRESHOLD	WEATHER STRIP	KICK PLATE	SOUND STOP	NAMEPLATE	NOTES
S100A												
S1001	Entrance			X	B.B.		X	X	X			

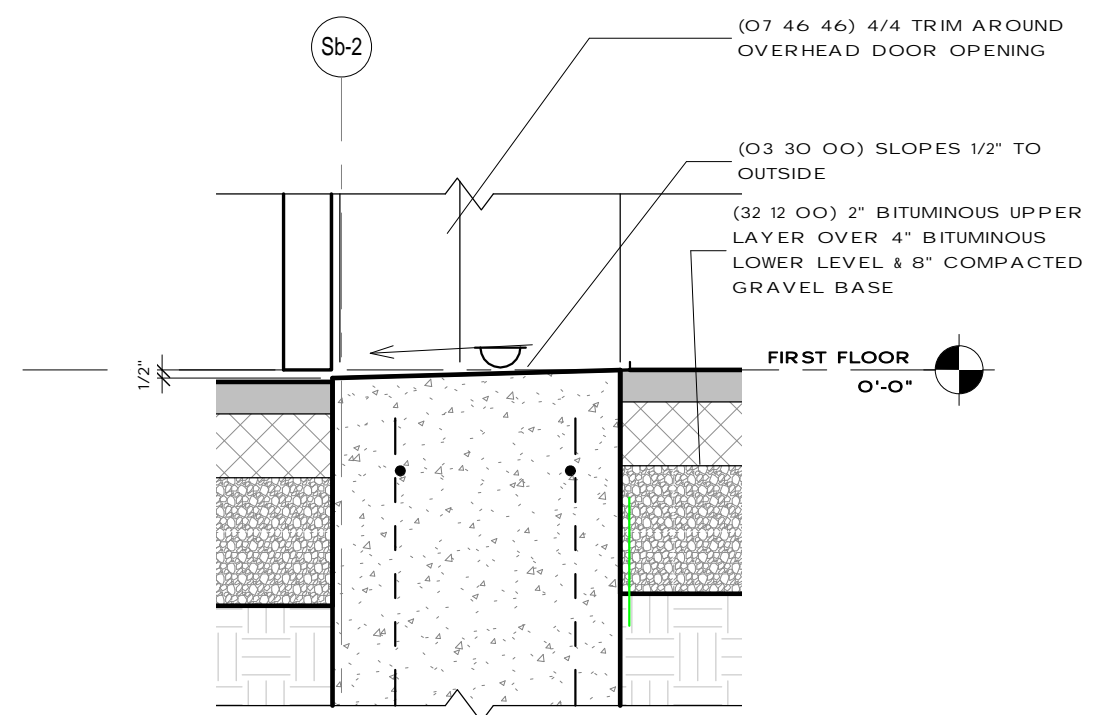


**6 Salt Building - Slab Detail @ OH Door**  
1" = 1'-0"

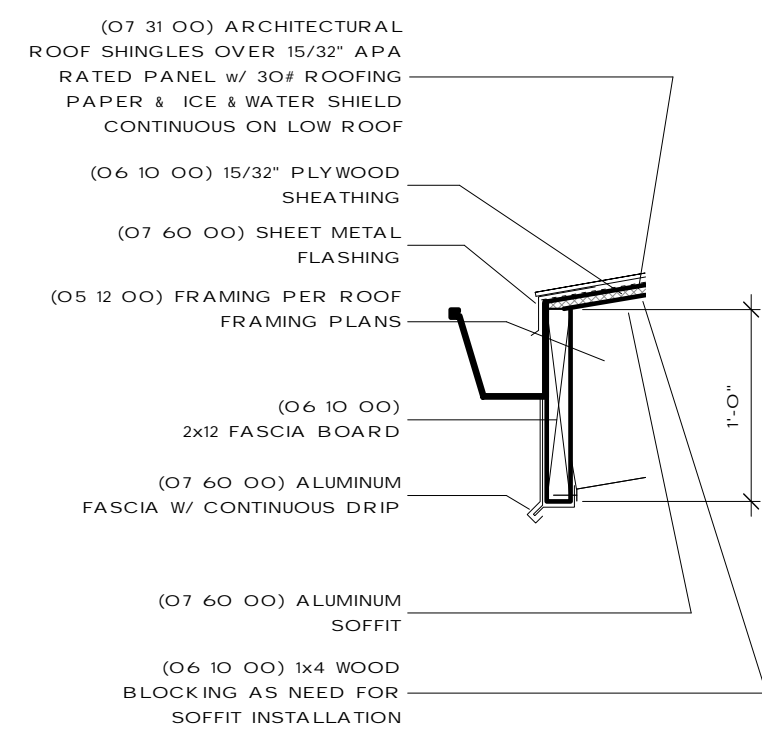


**4 Salt Building - Fascia Board Detail**  
1" = 1'-0"

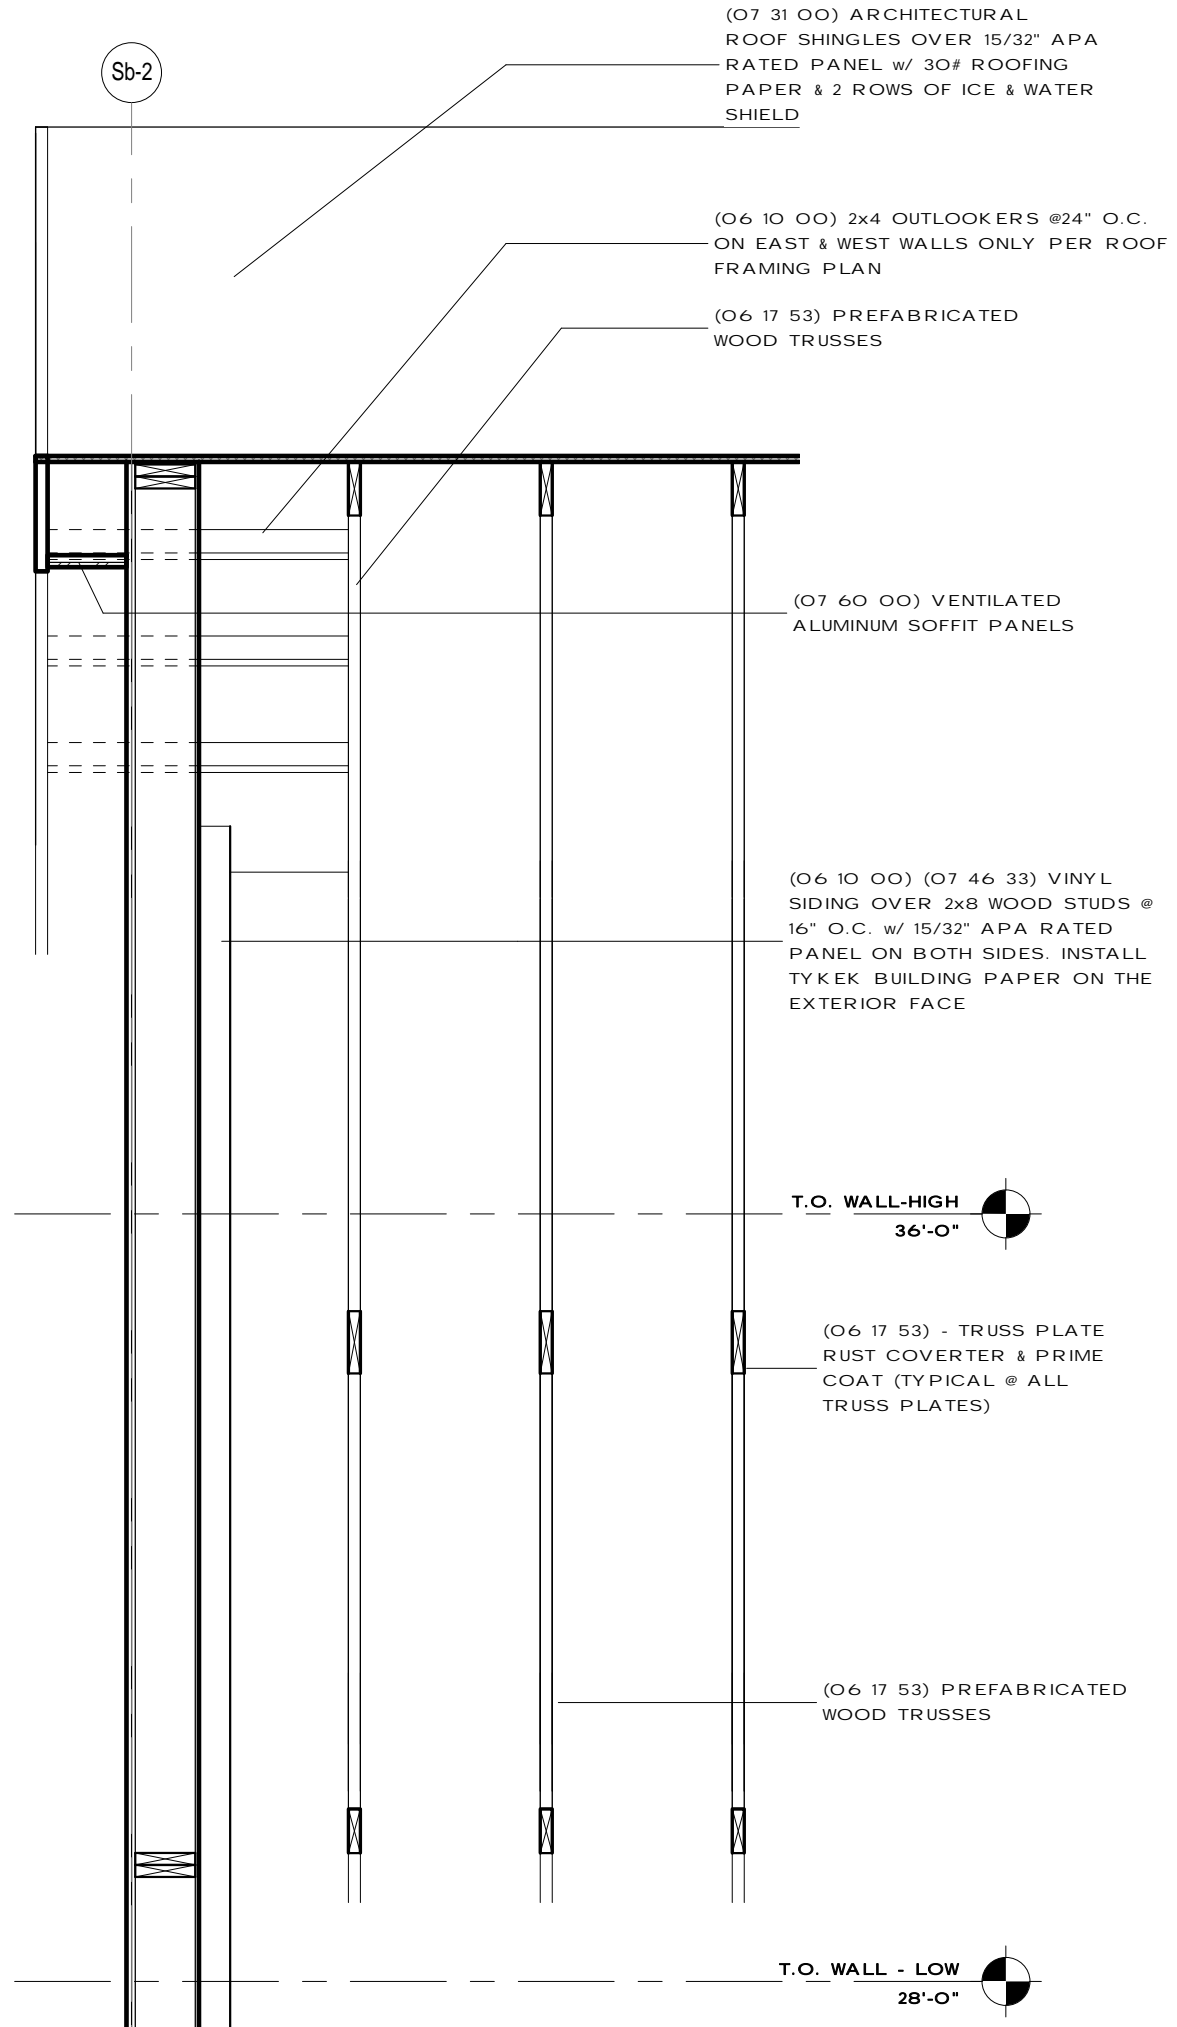


**2 Salt Building - Wall Section @ OH Door**  
1/2" = 1'-0"

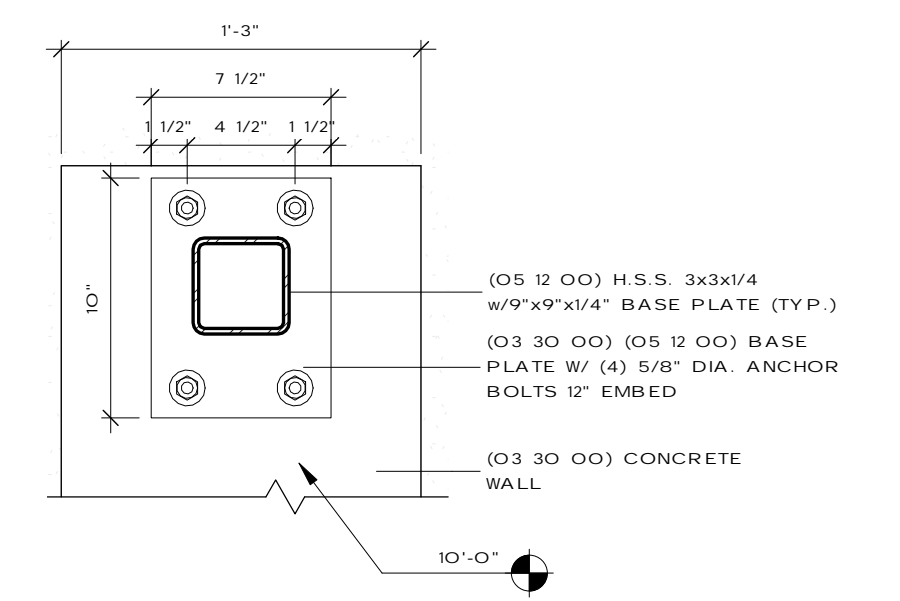



**7 Salt Building - Column Base Plate Detail**  
1 1/2" = 1'-0"

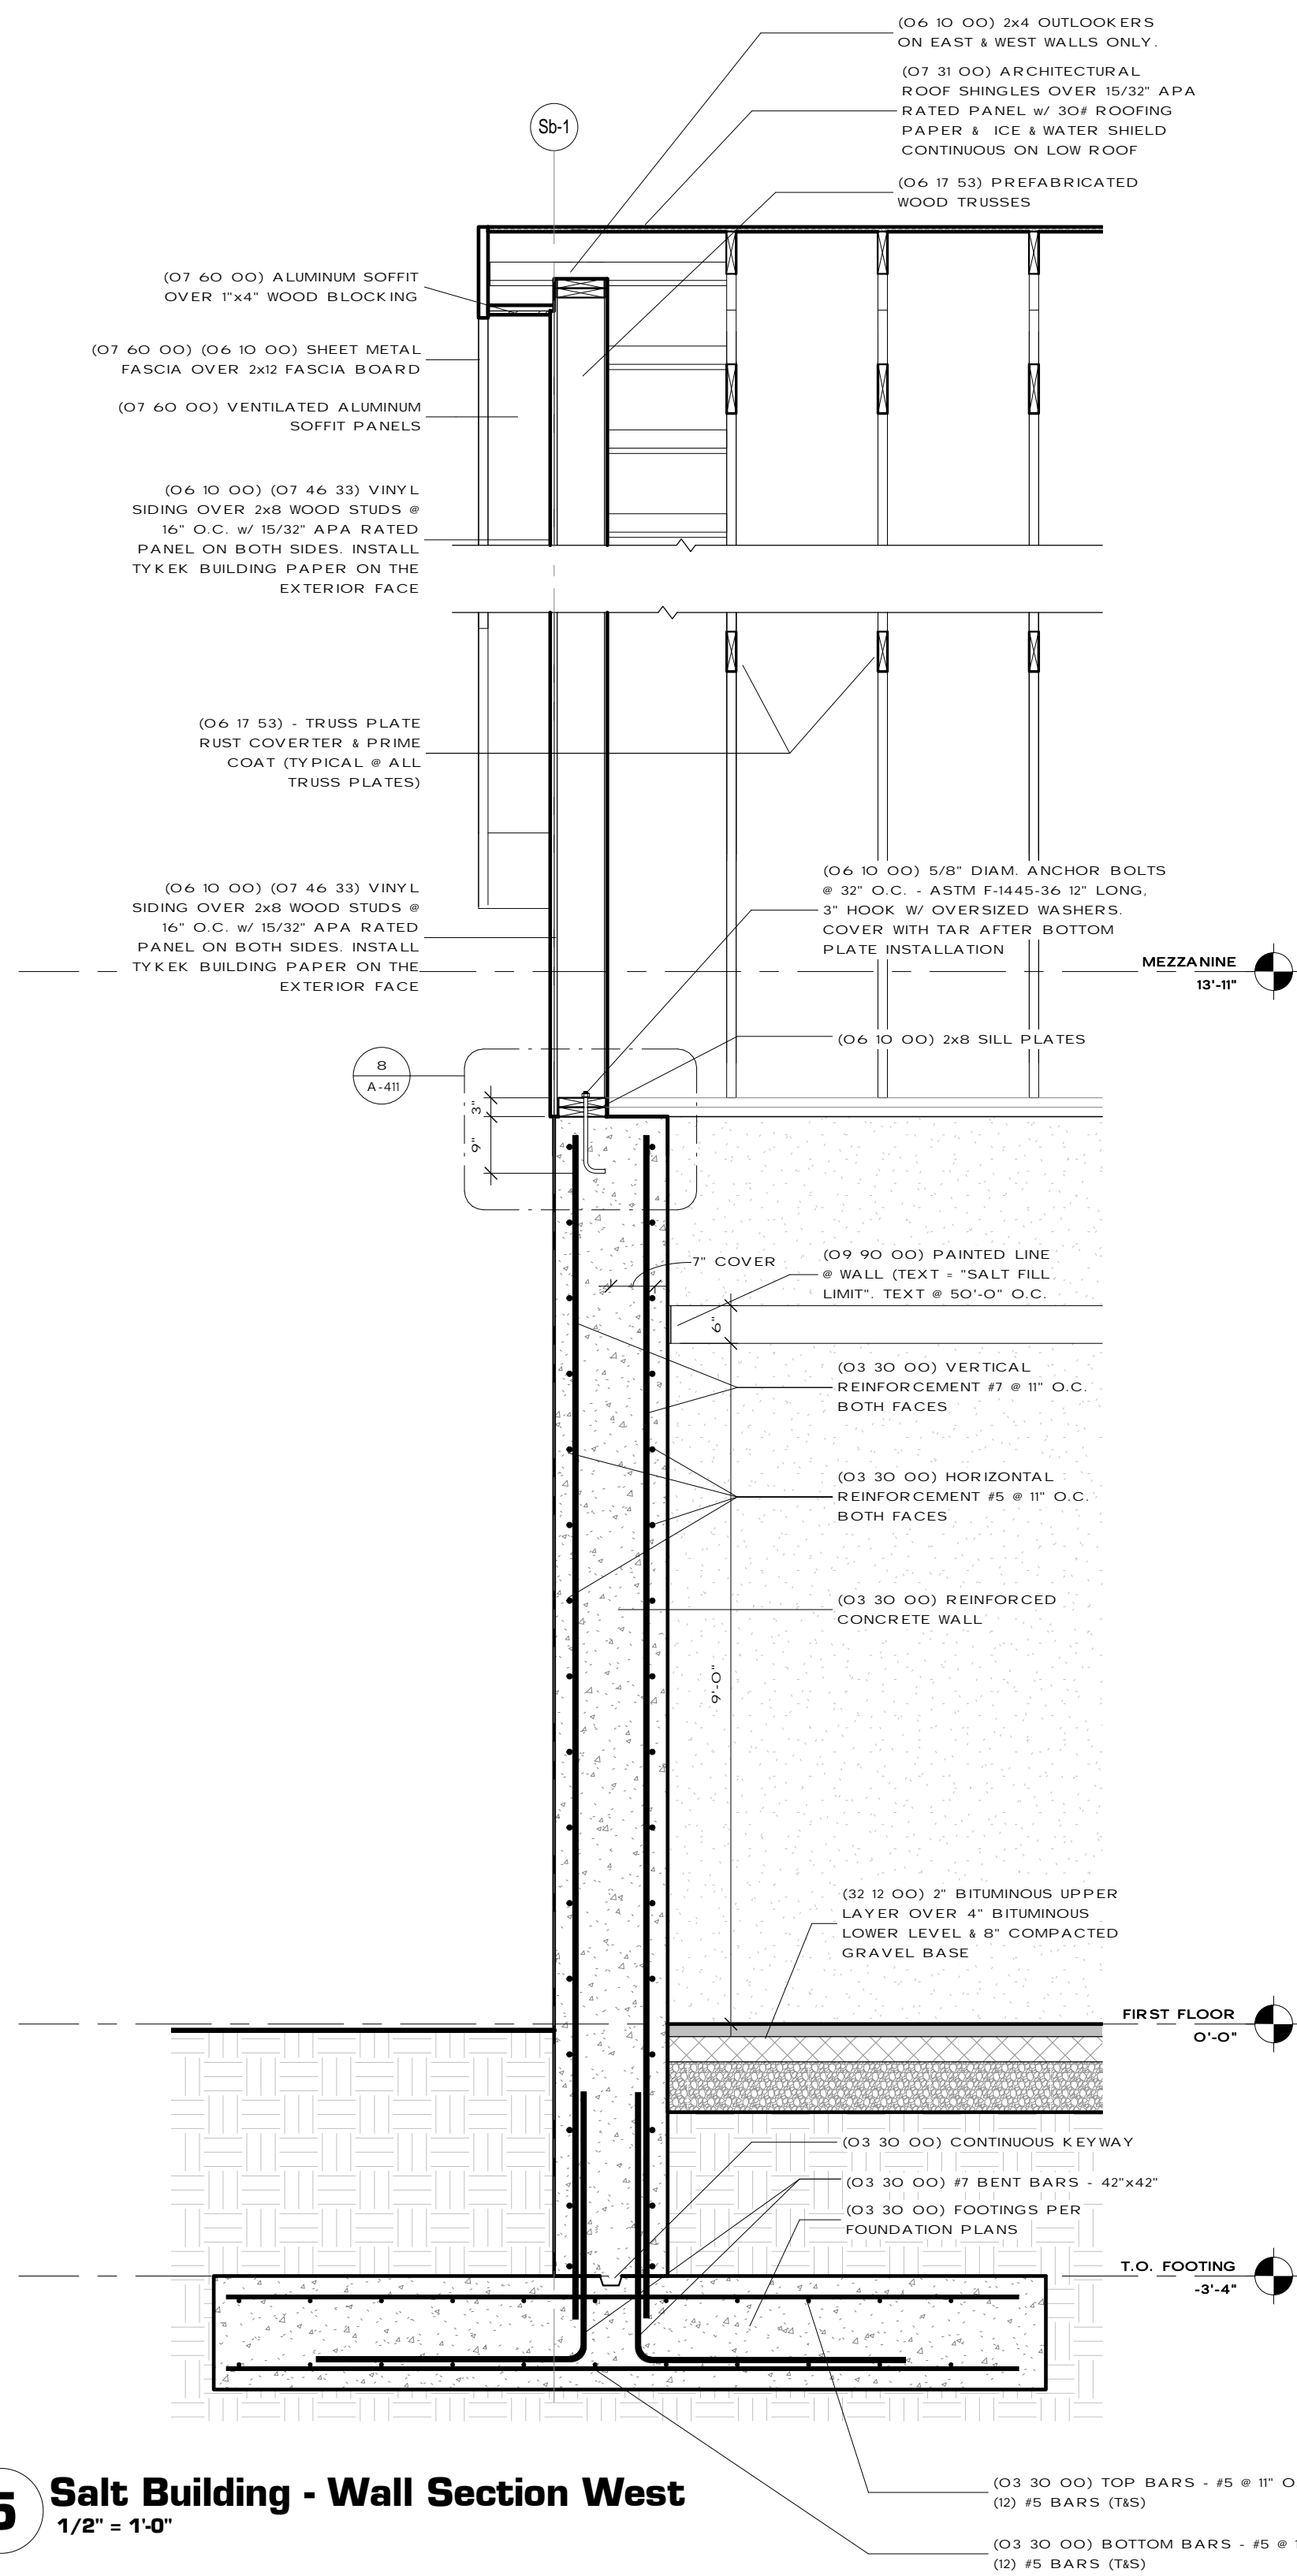

**5 Salt Building - Wall Section West**  
1/2" = 1'-0"


















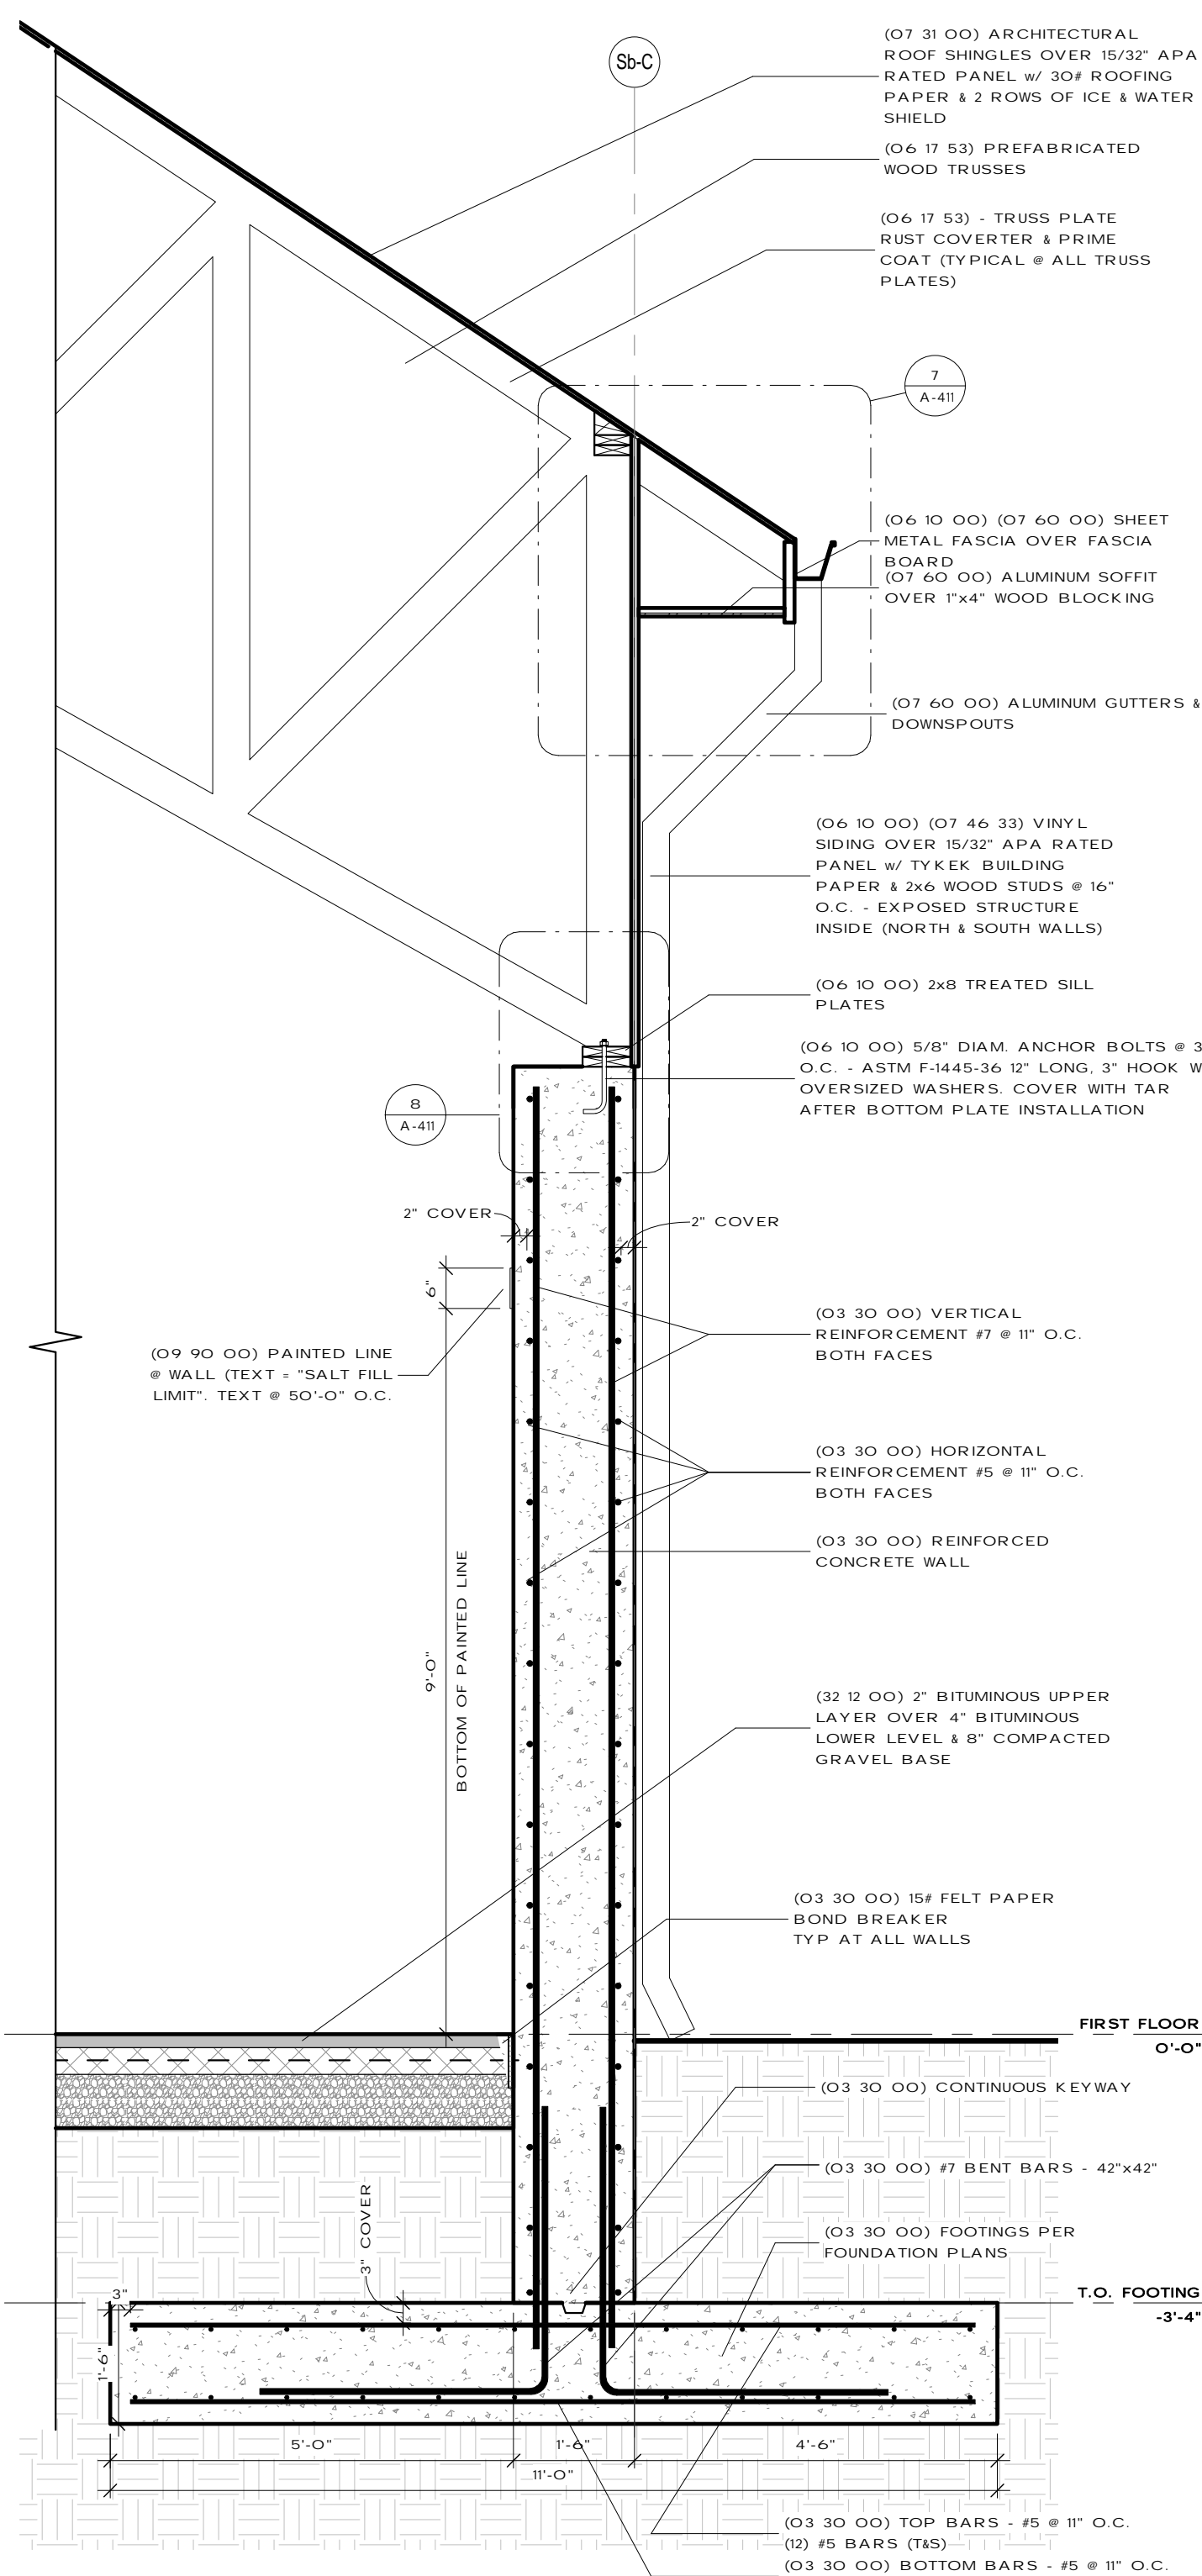


**3 Salt Building - Wall Section 3**  
1/2" = 1'-0"

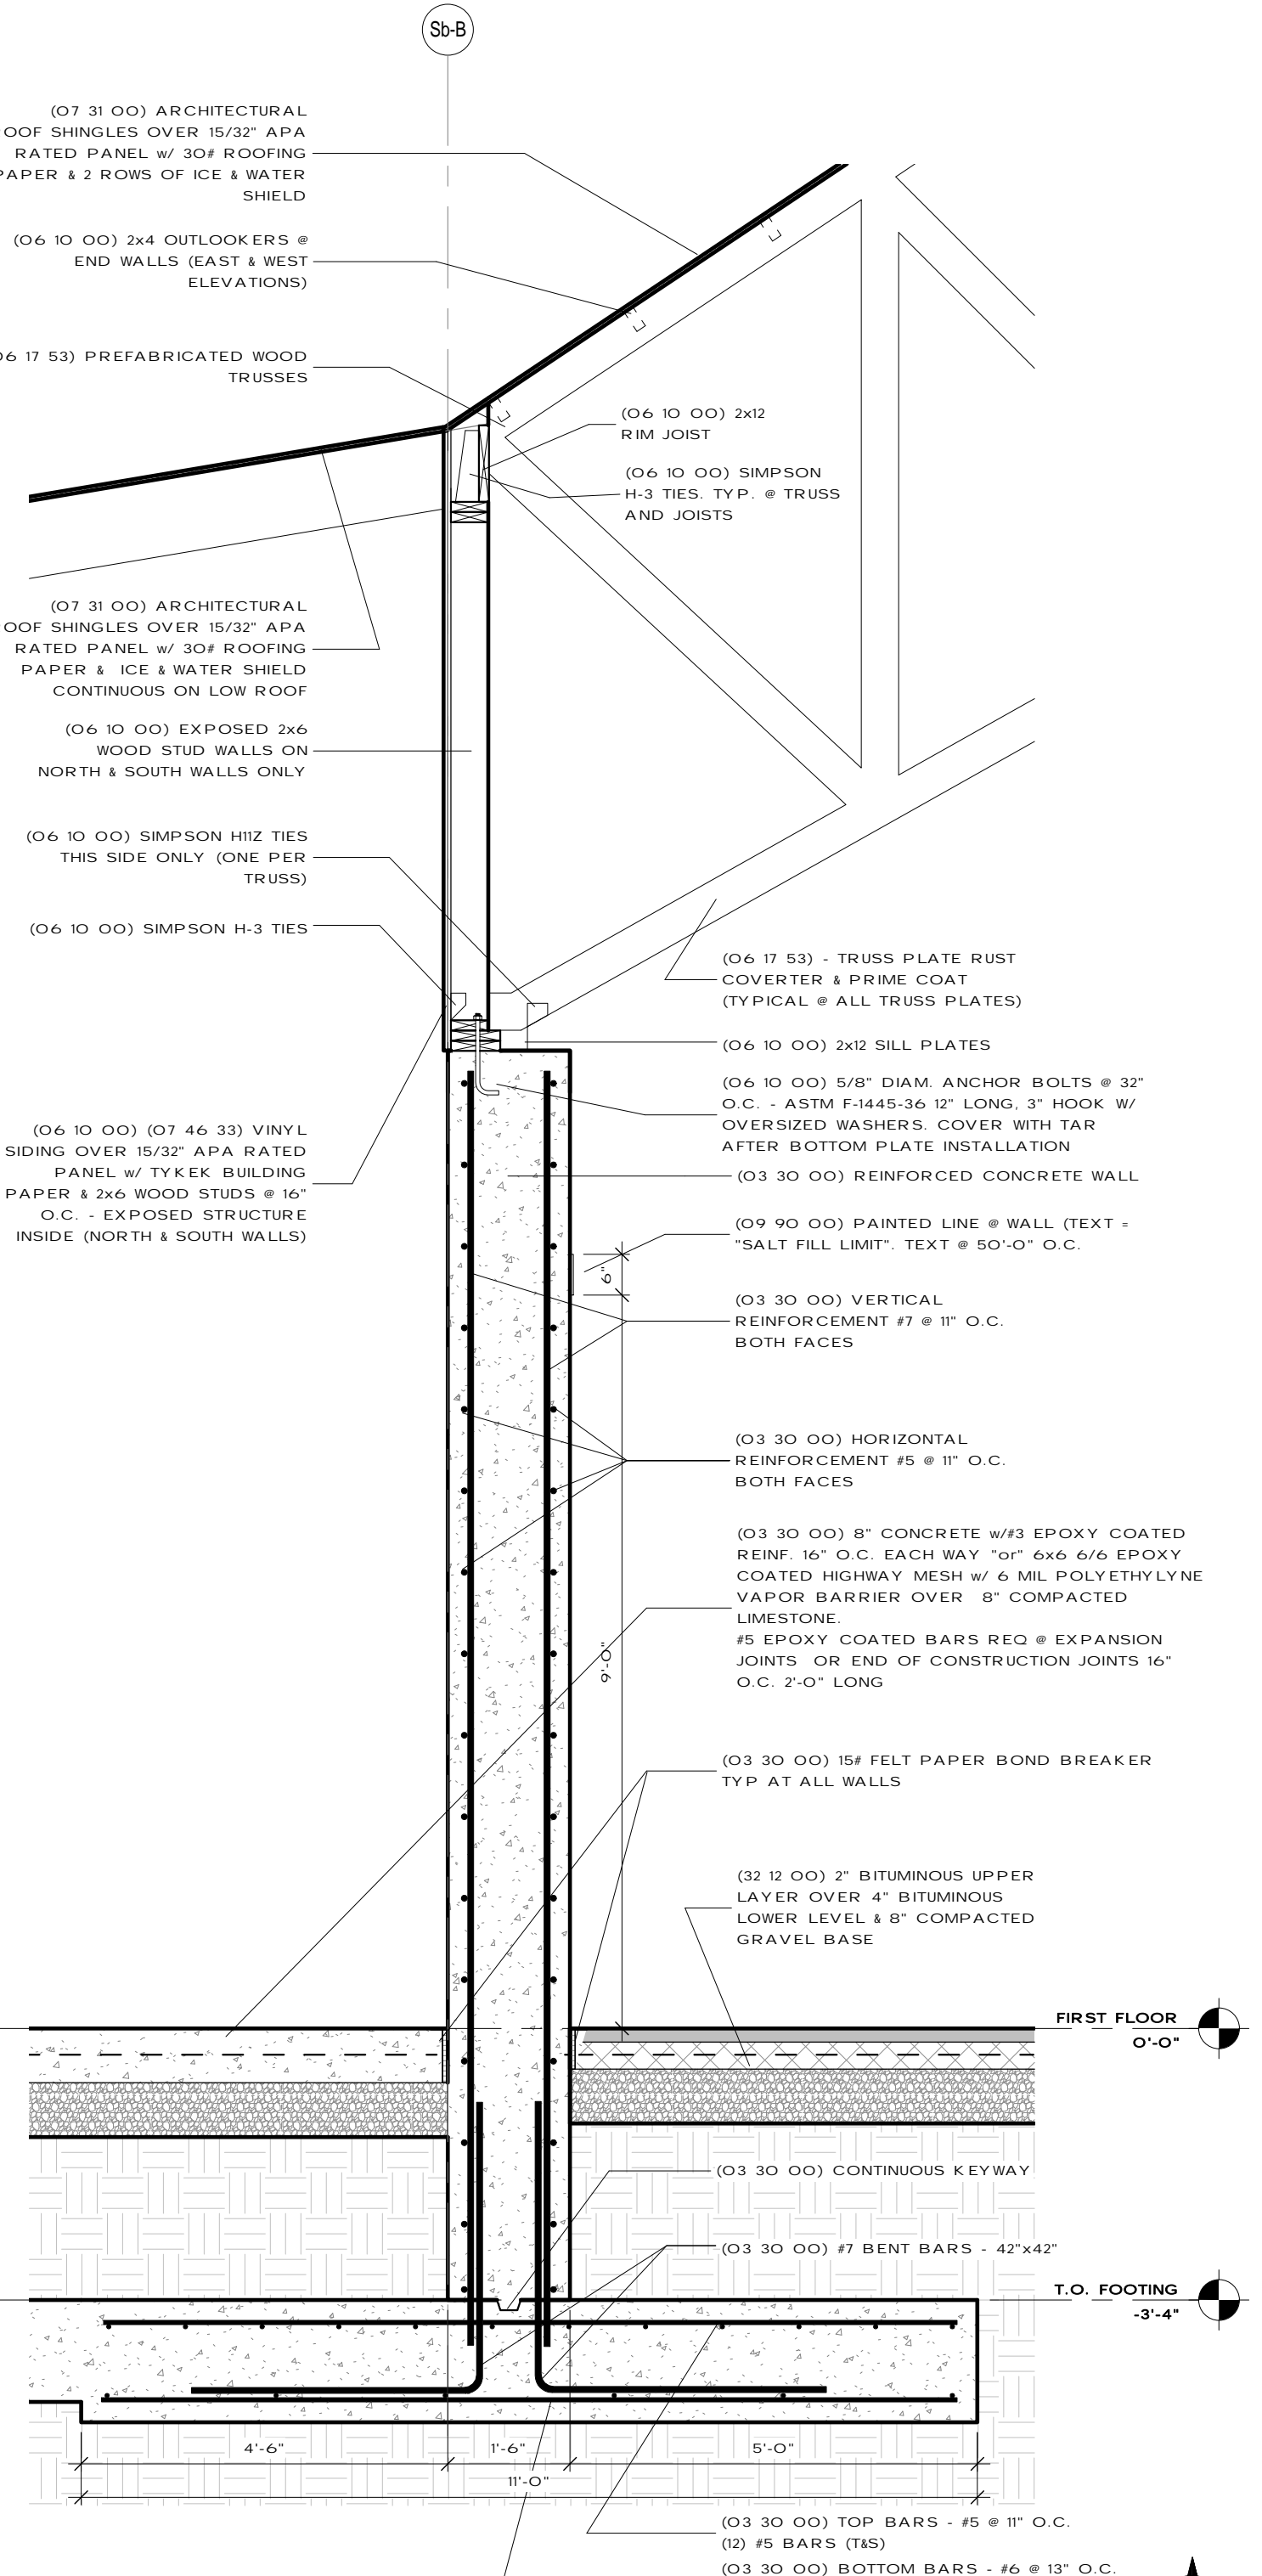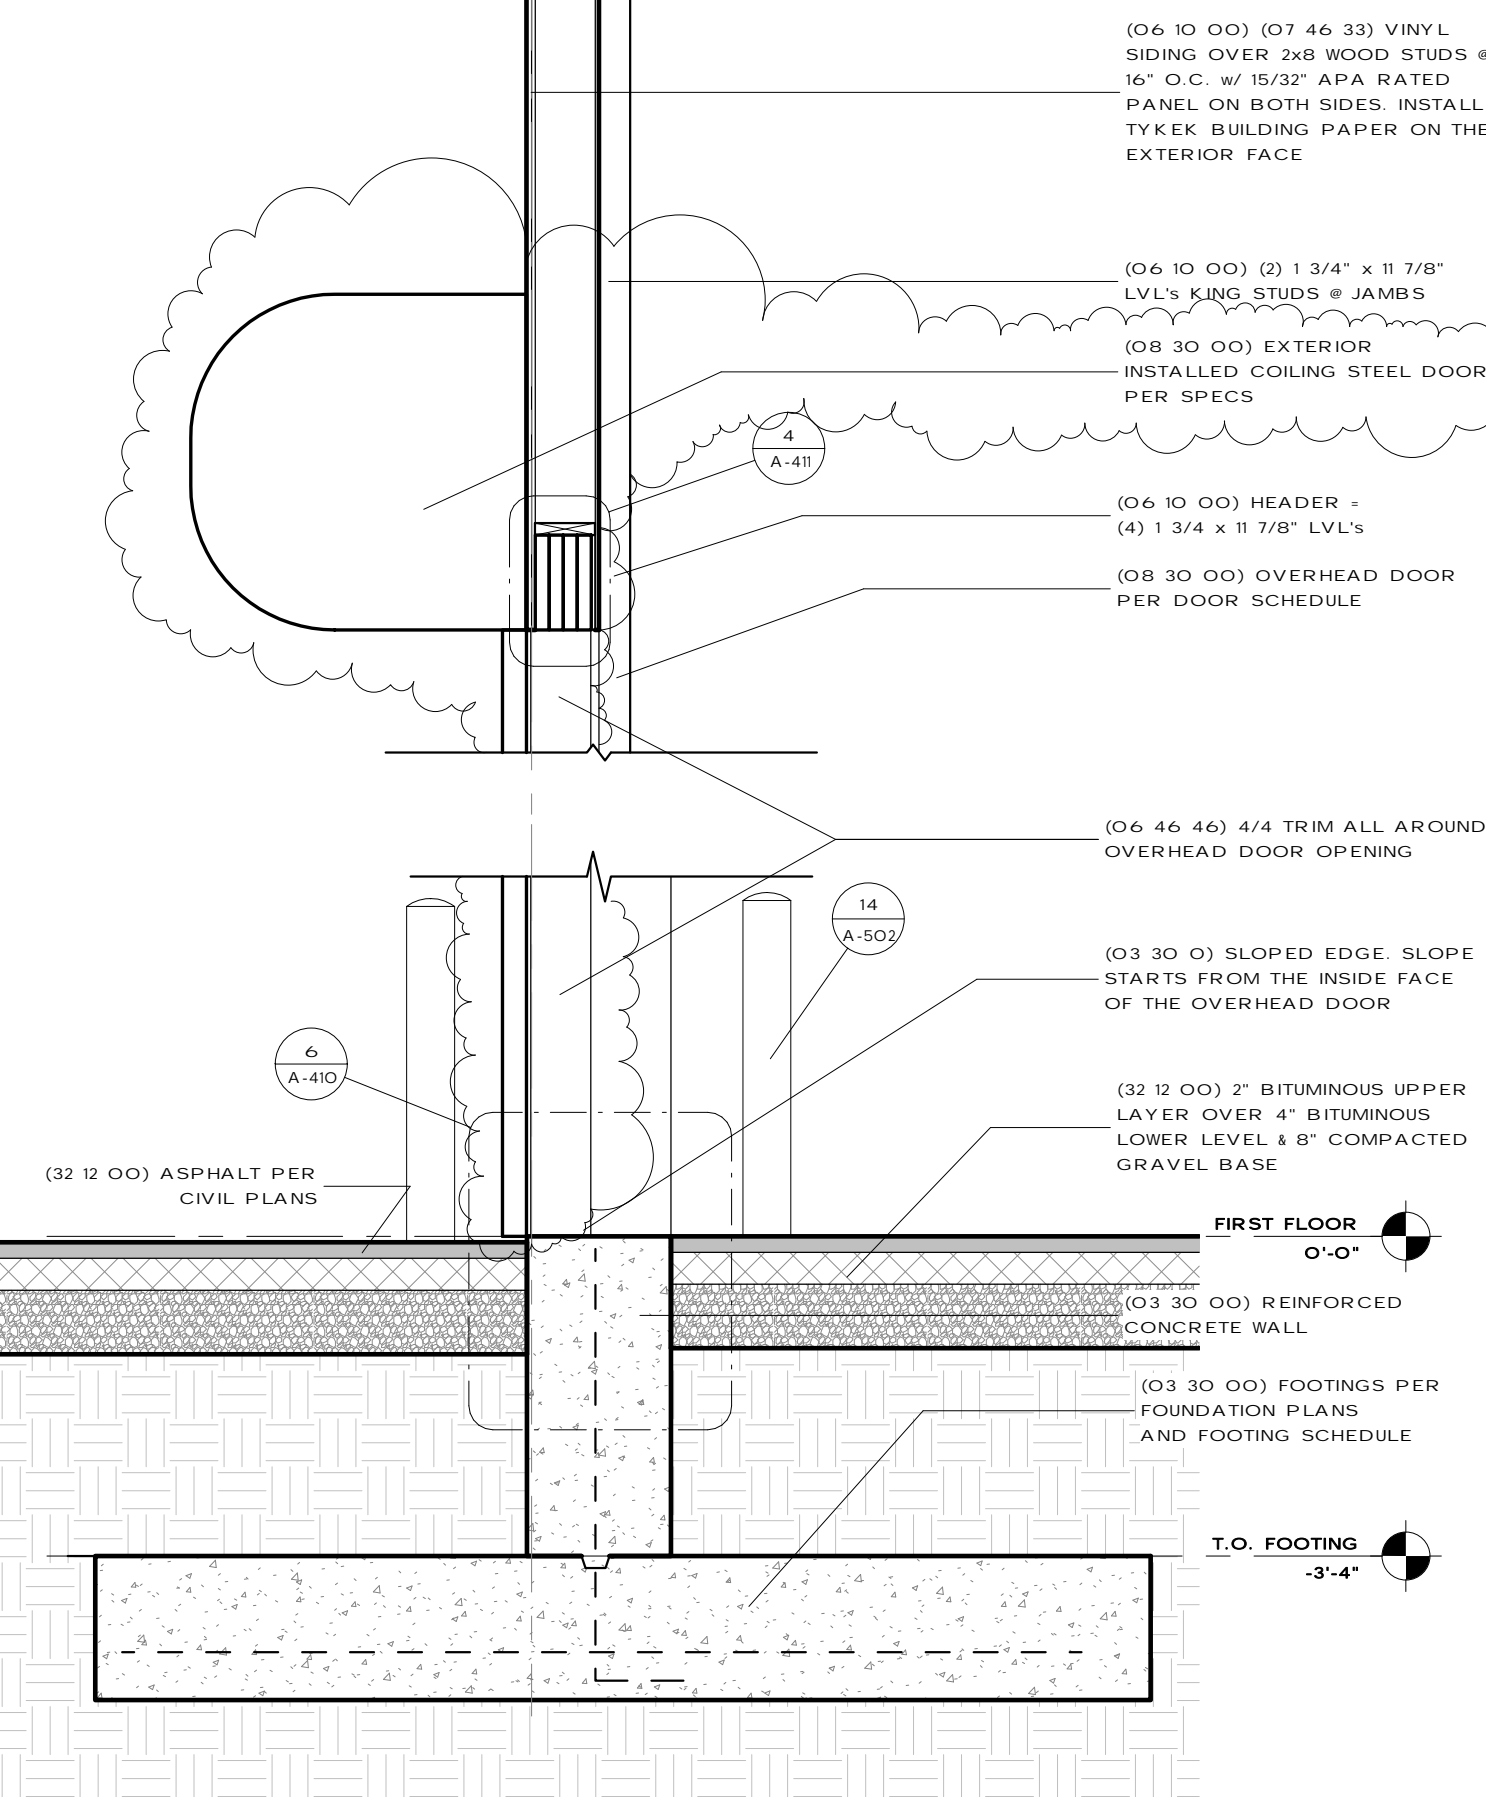

**1 Salt Building - Wall Section 1**  
1/2" = 1'-0"



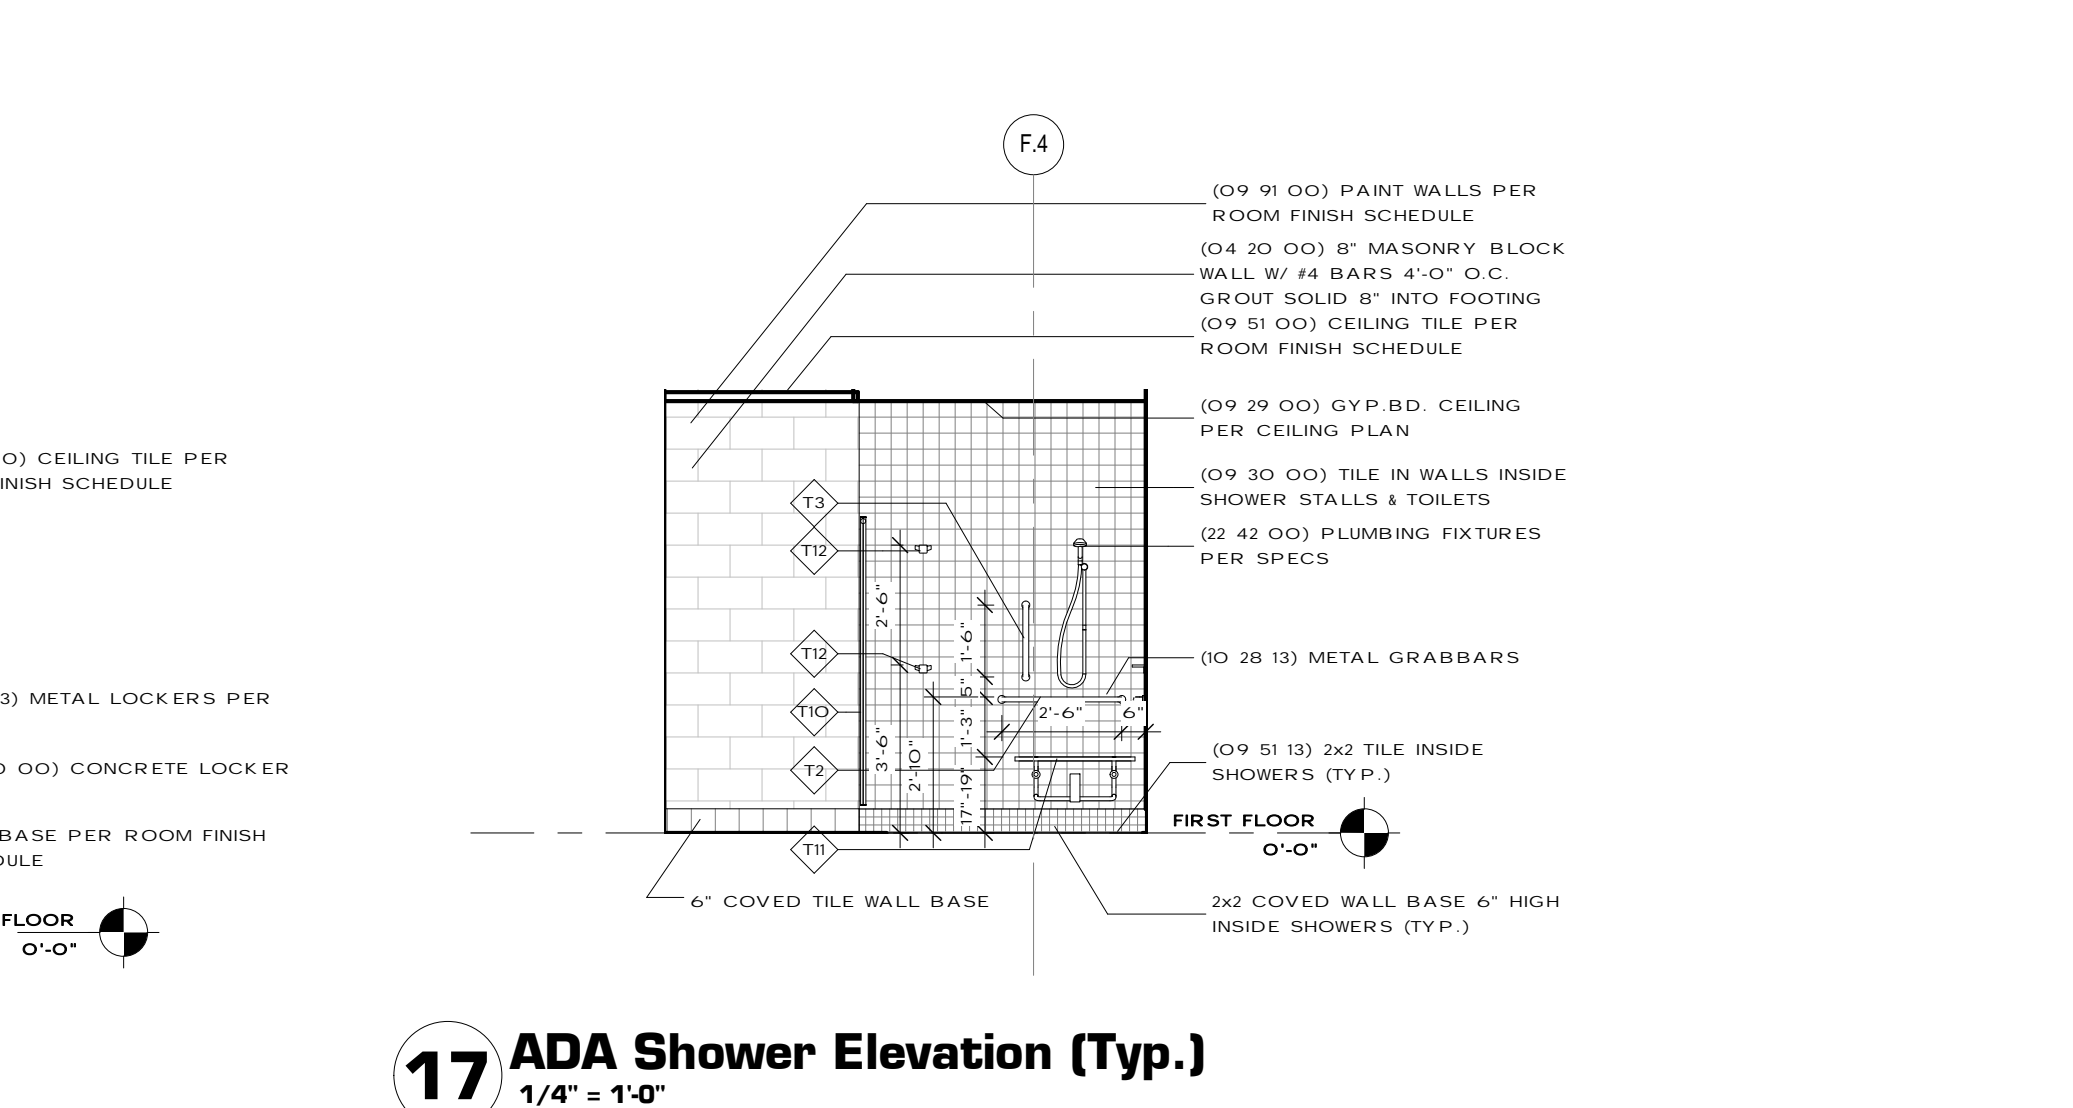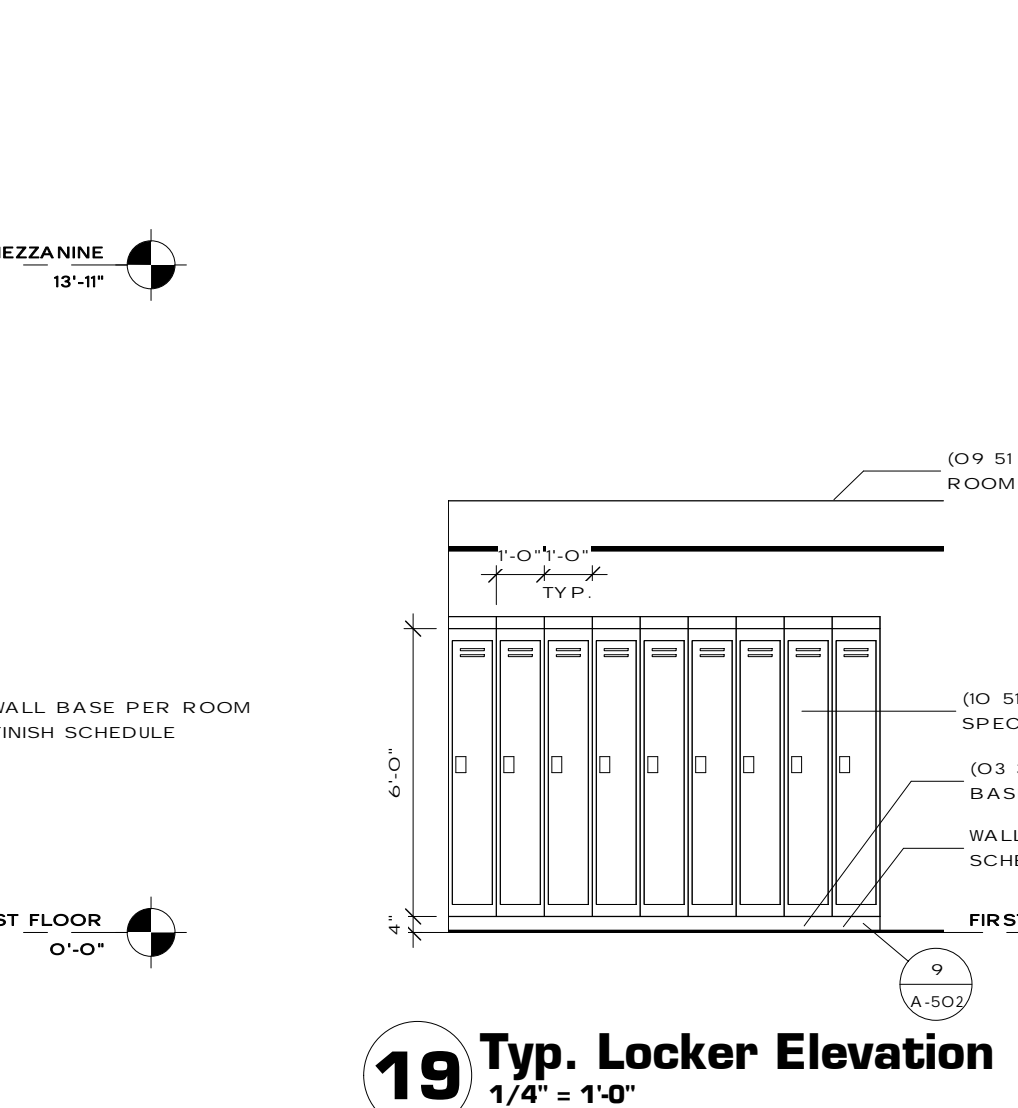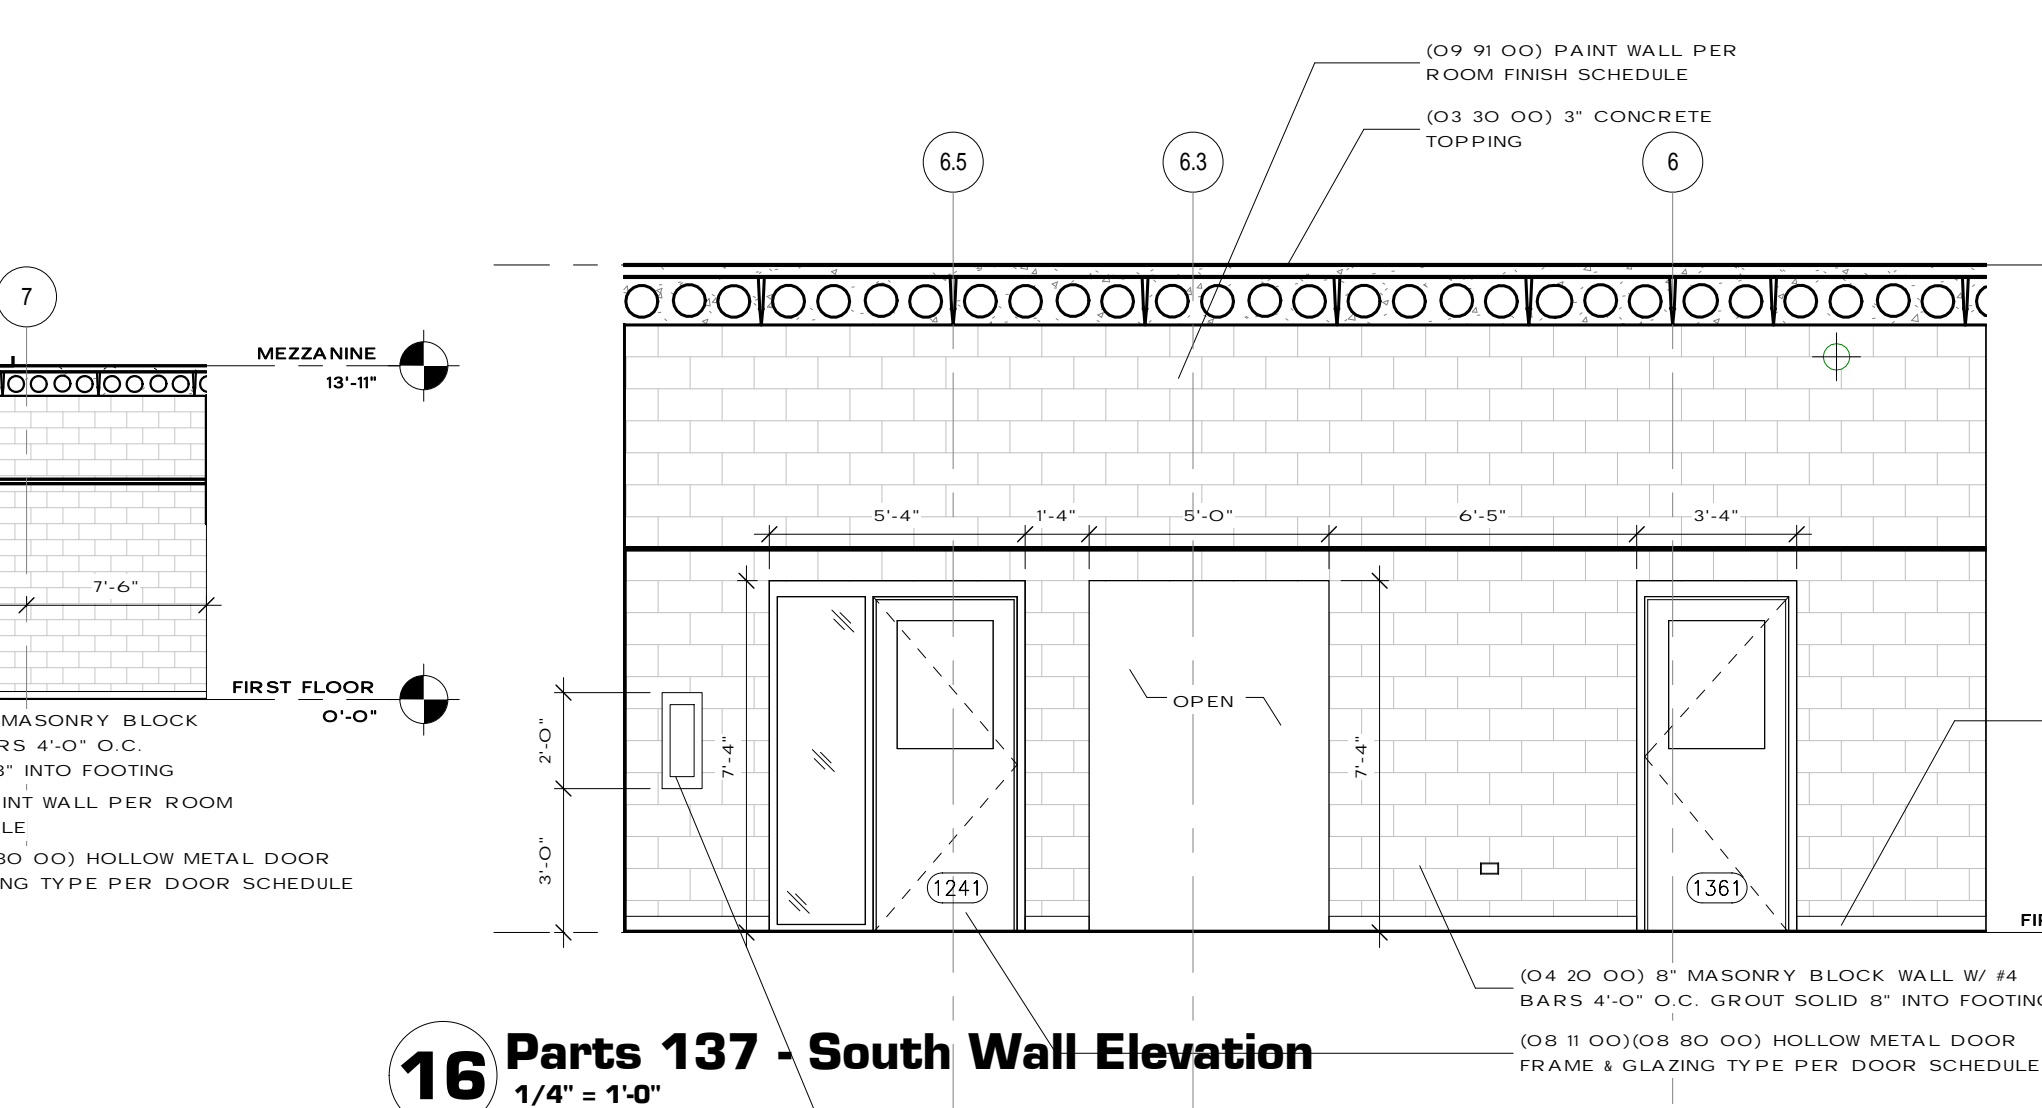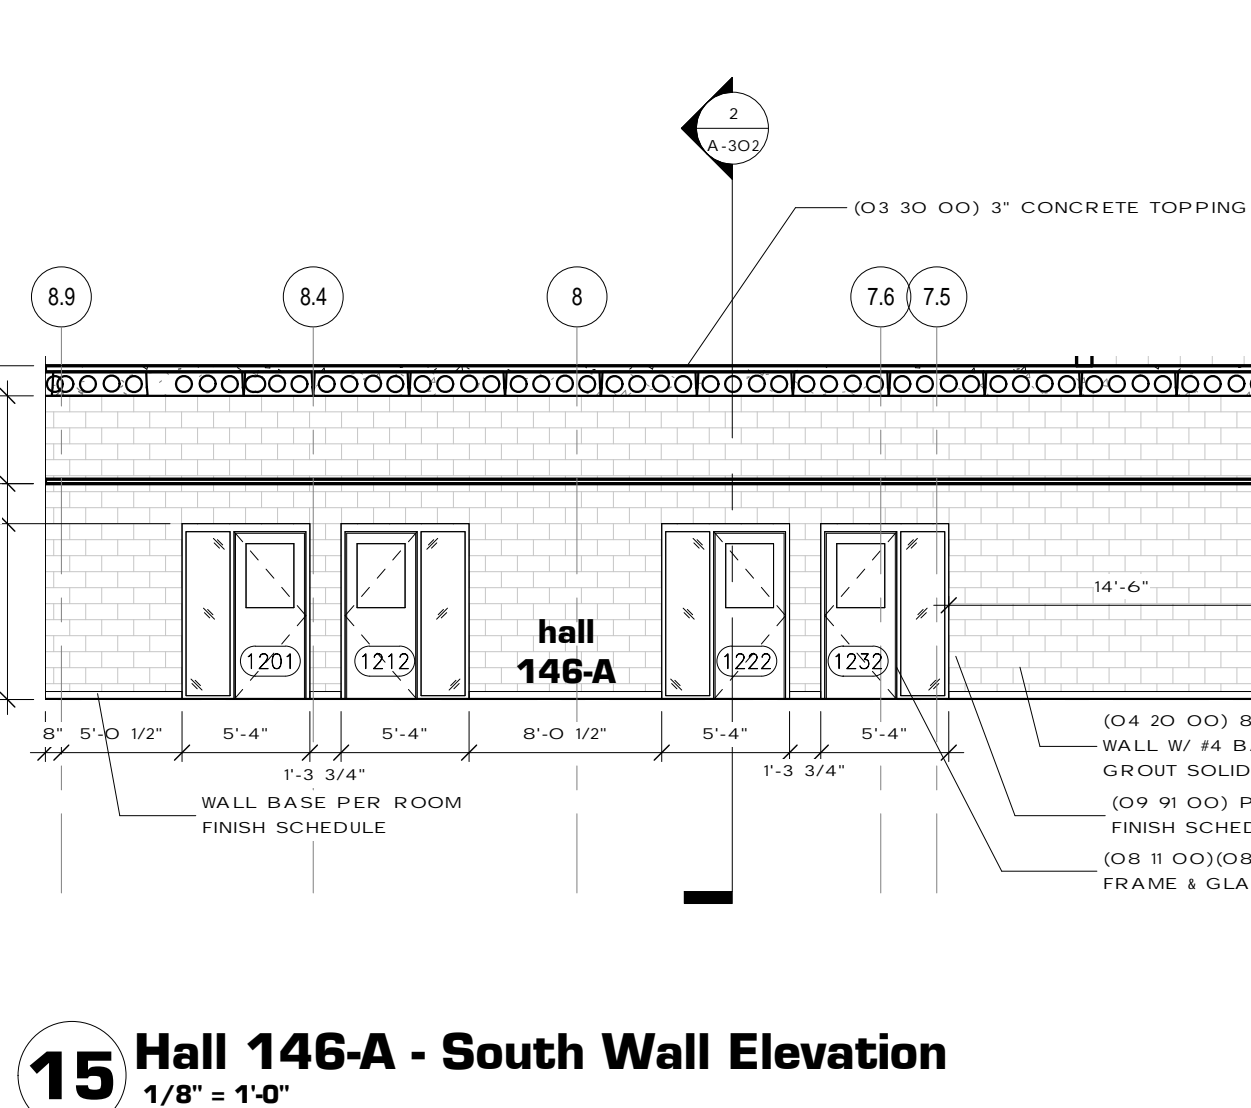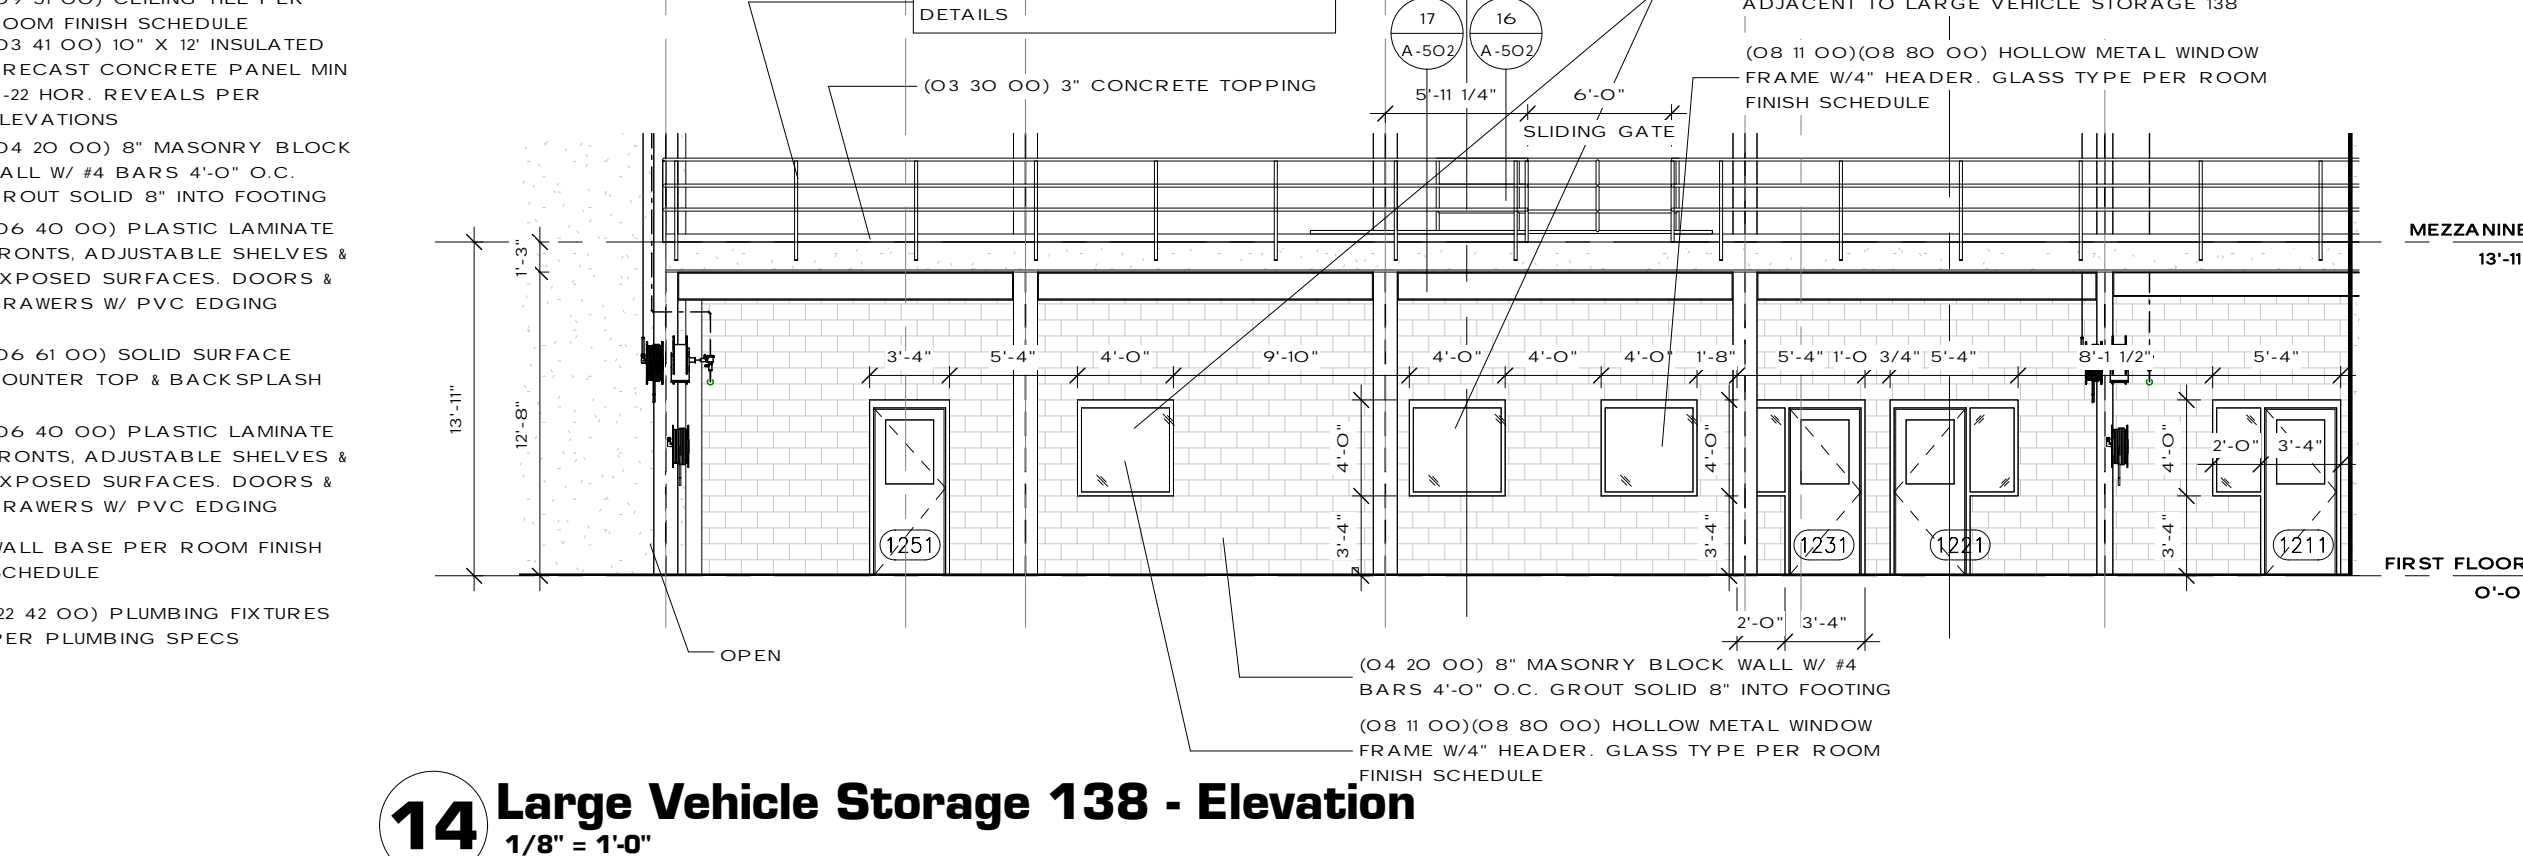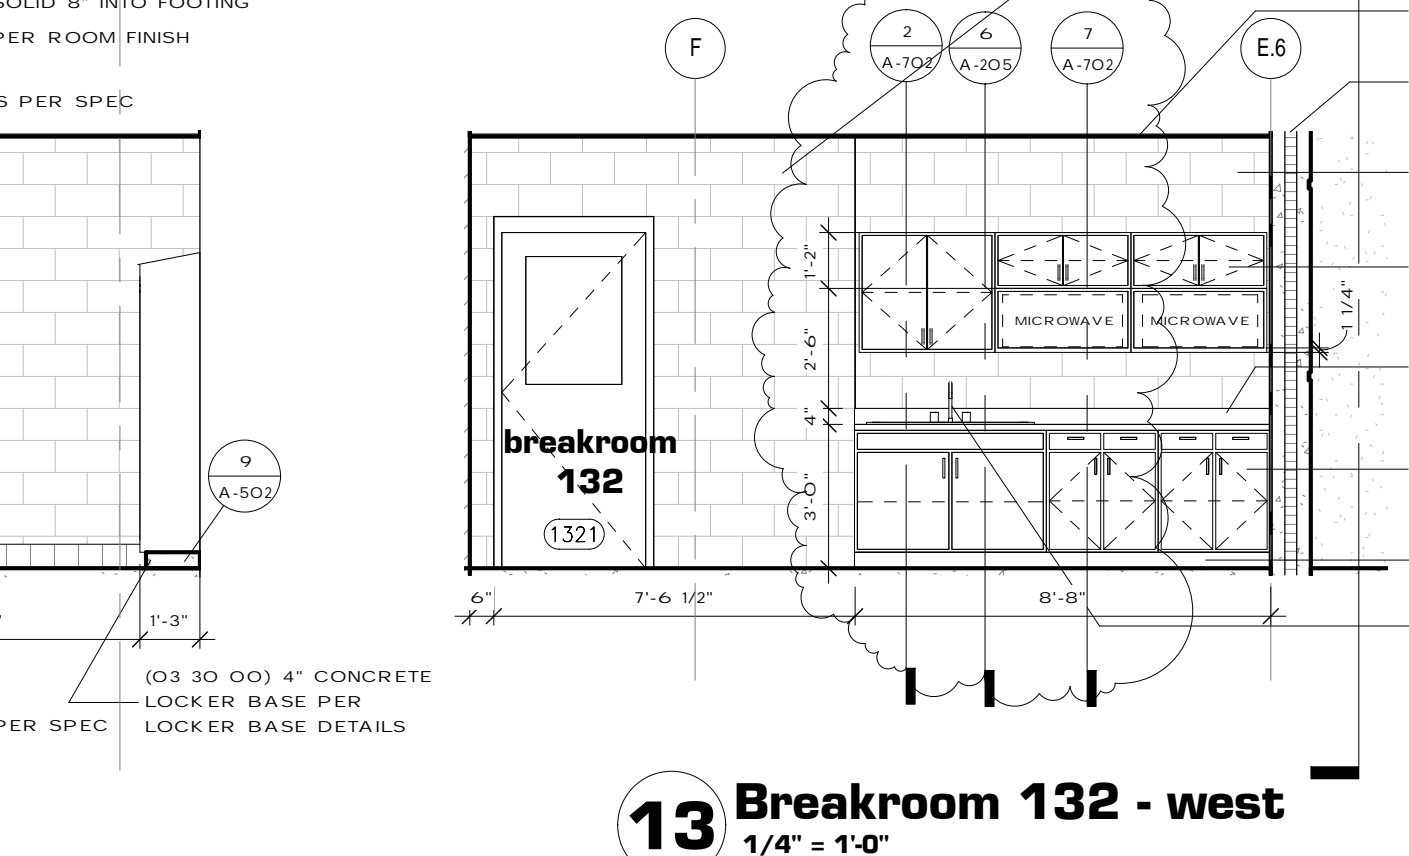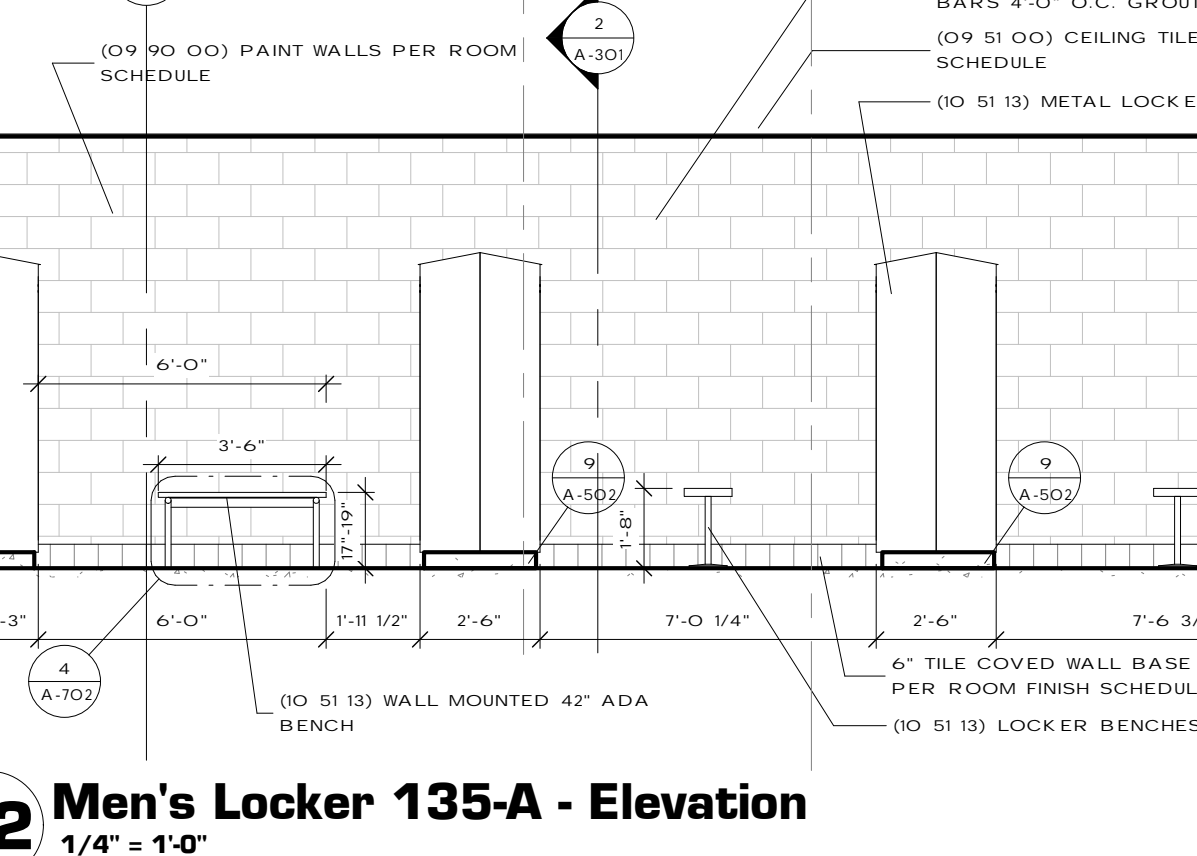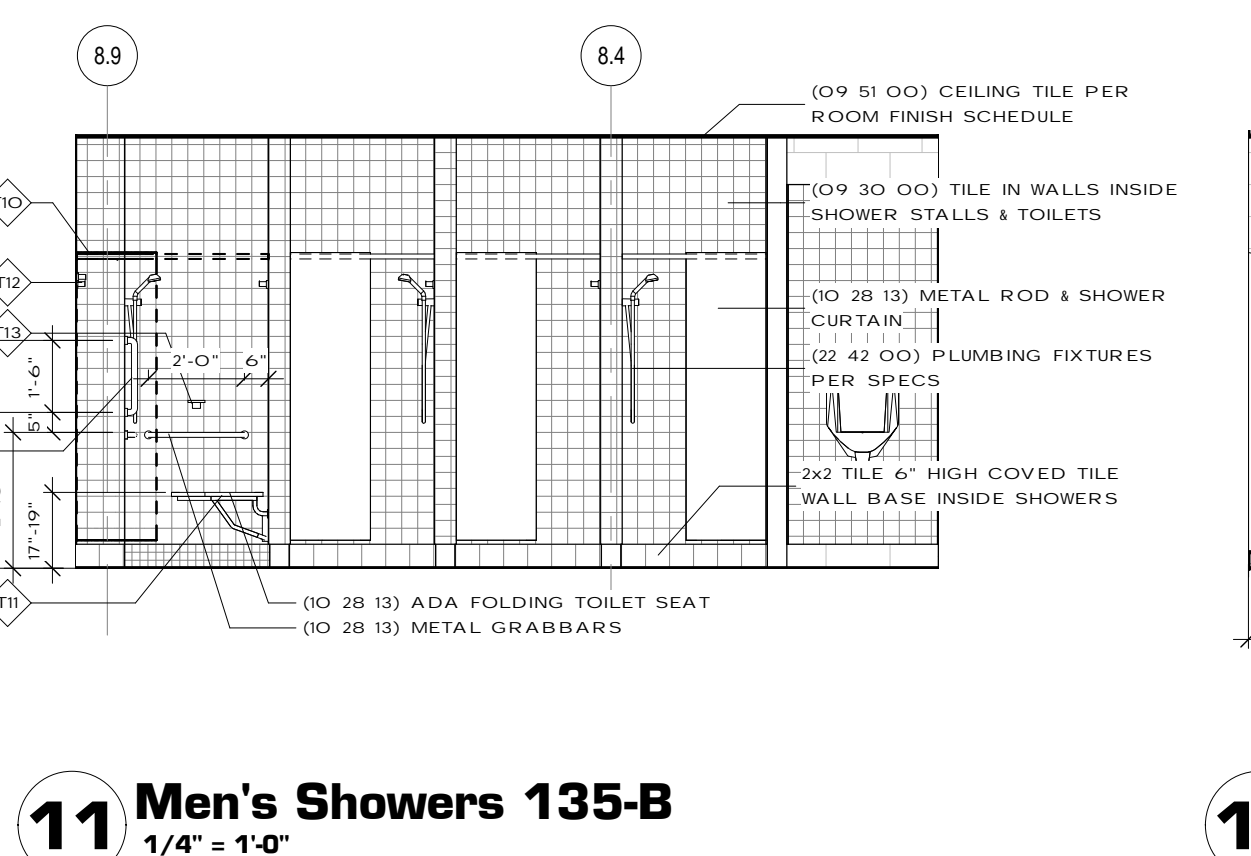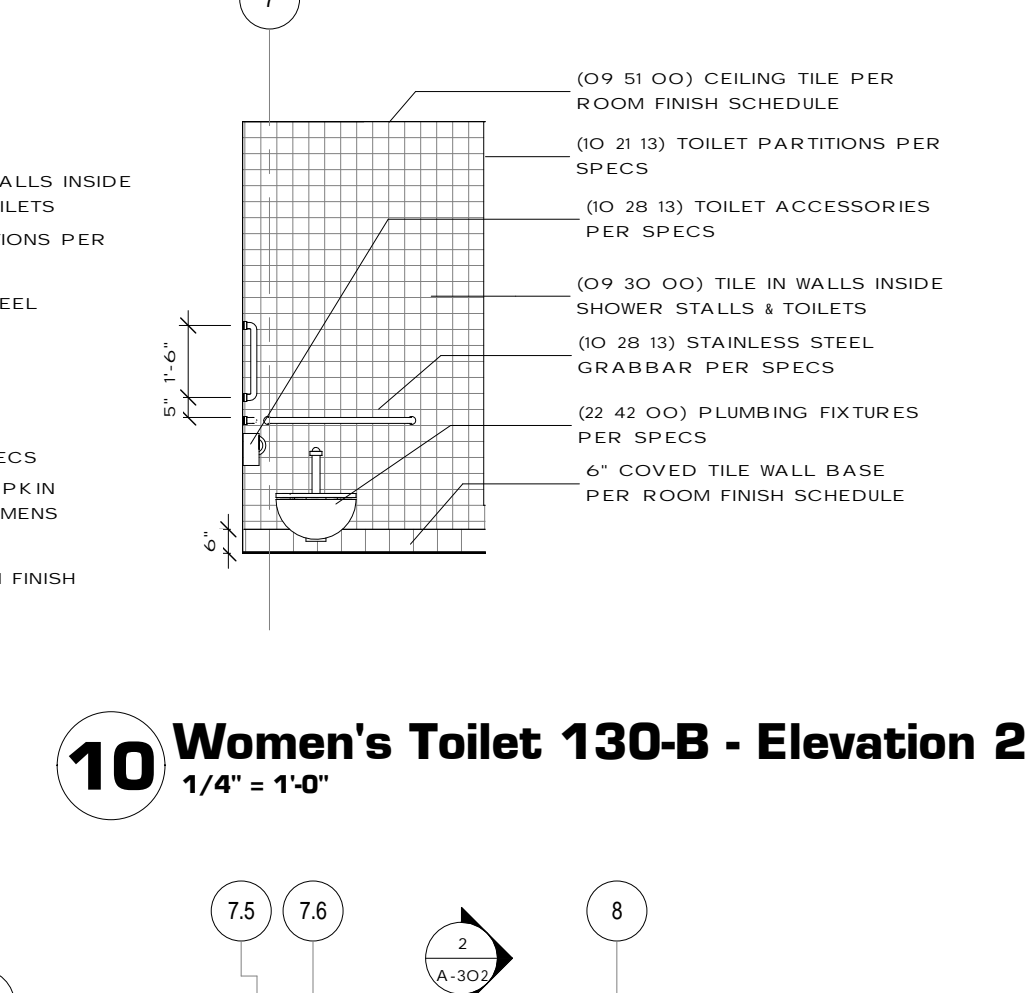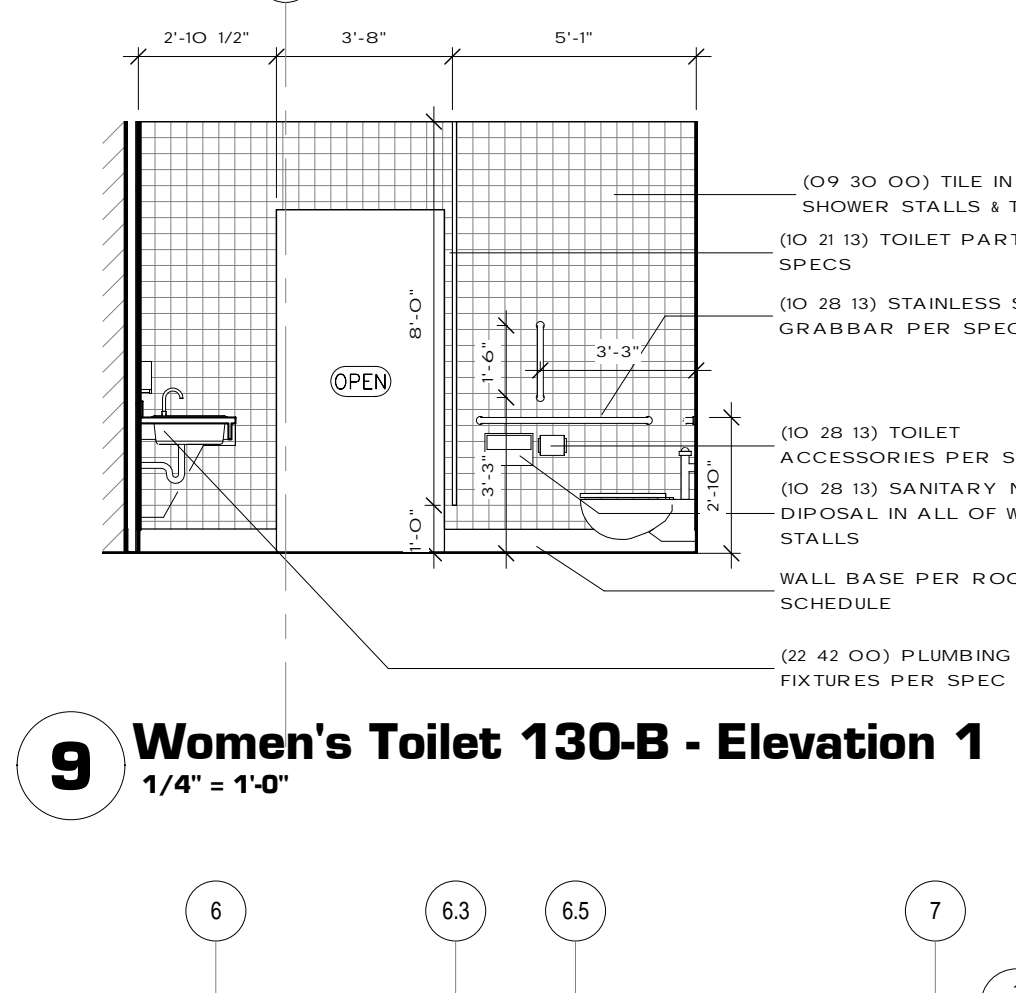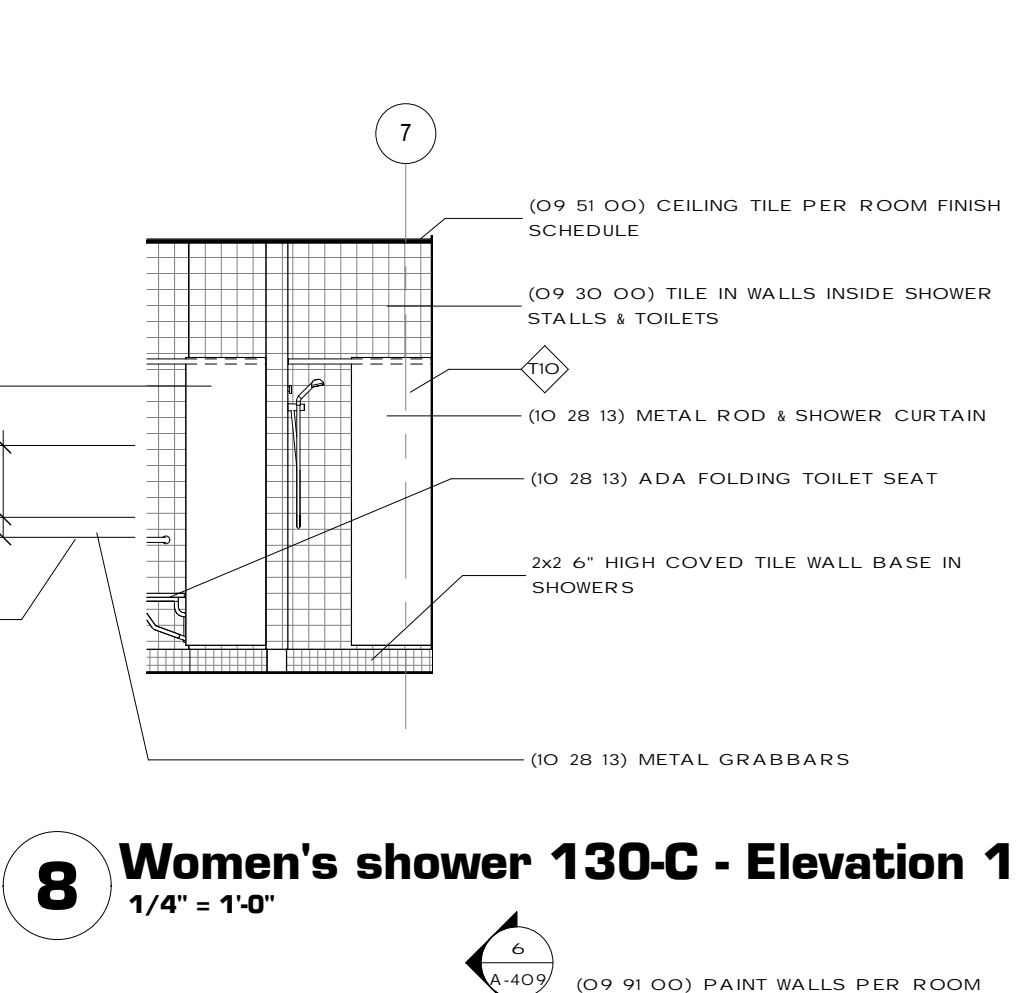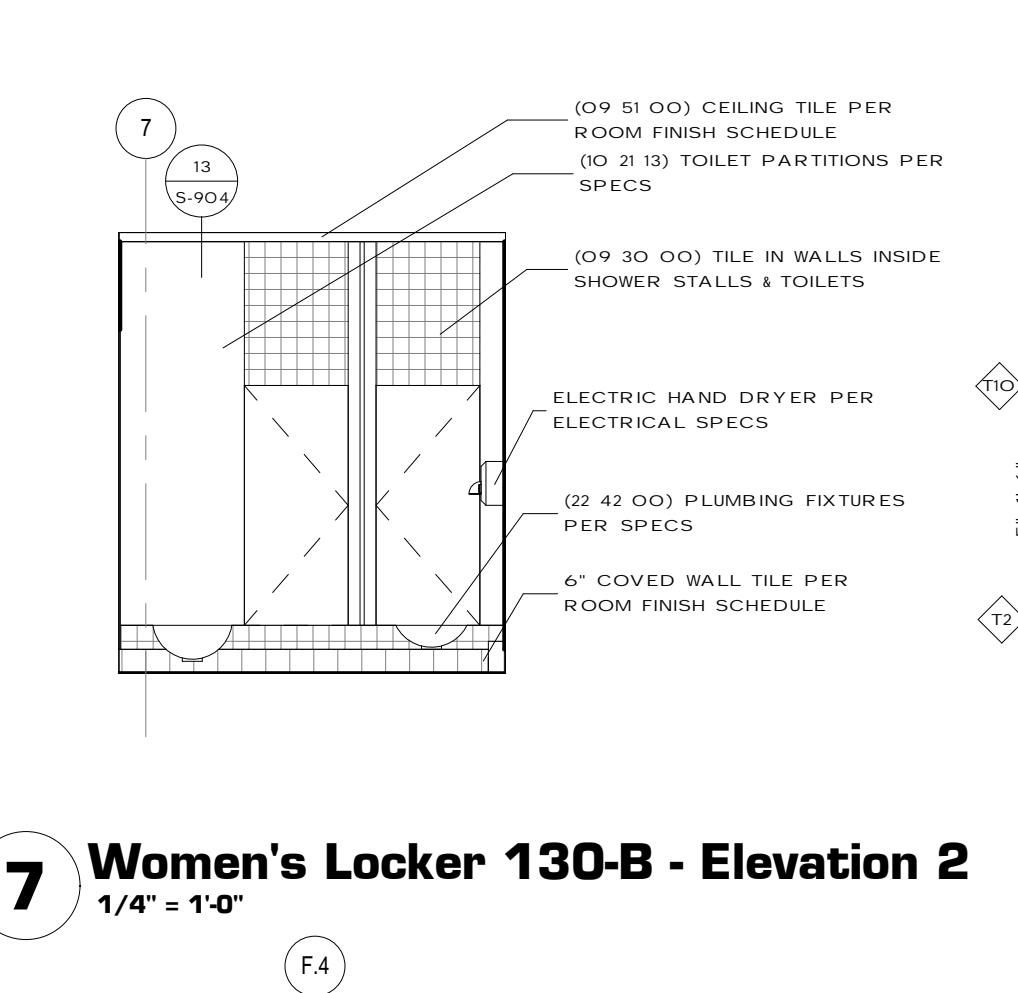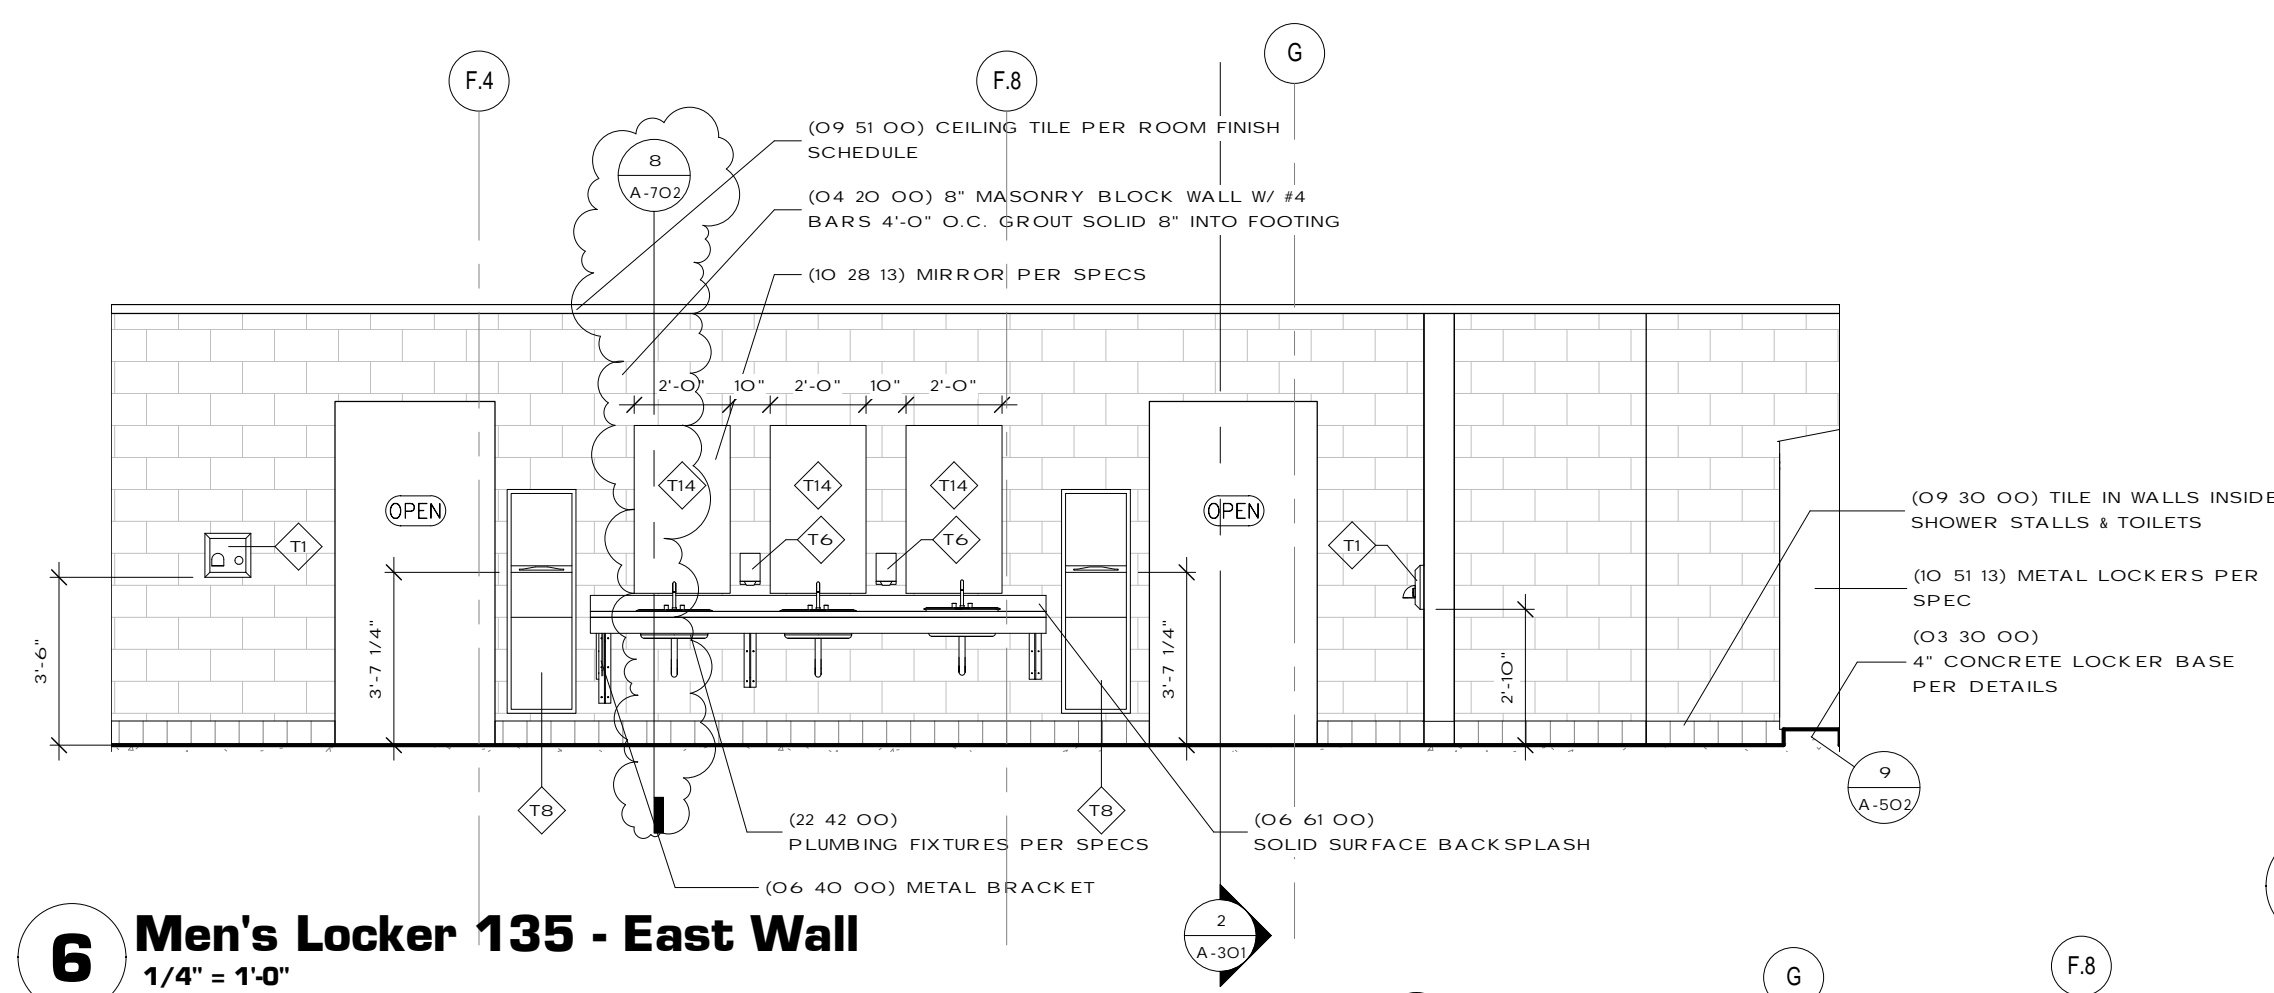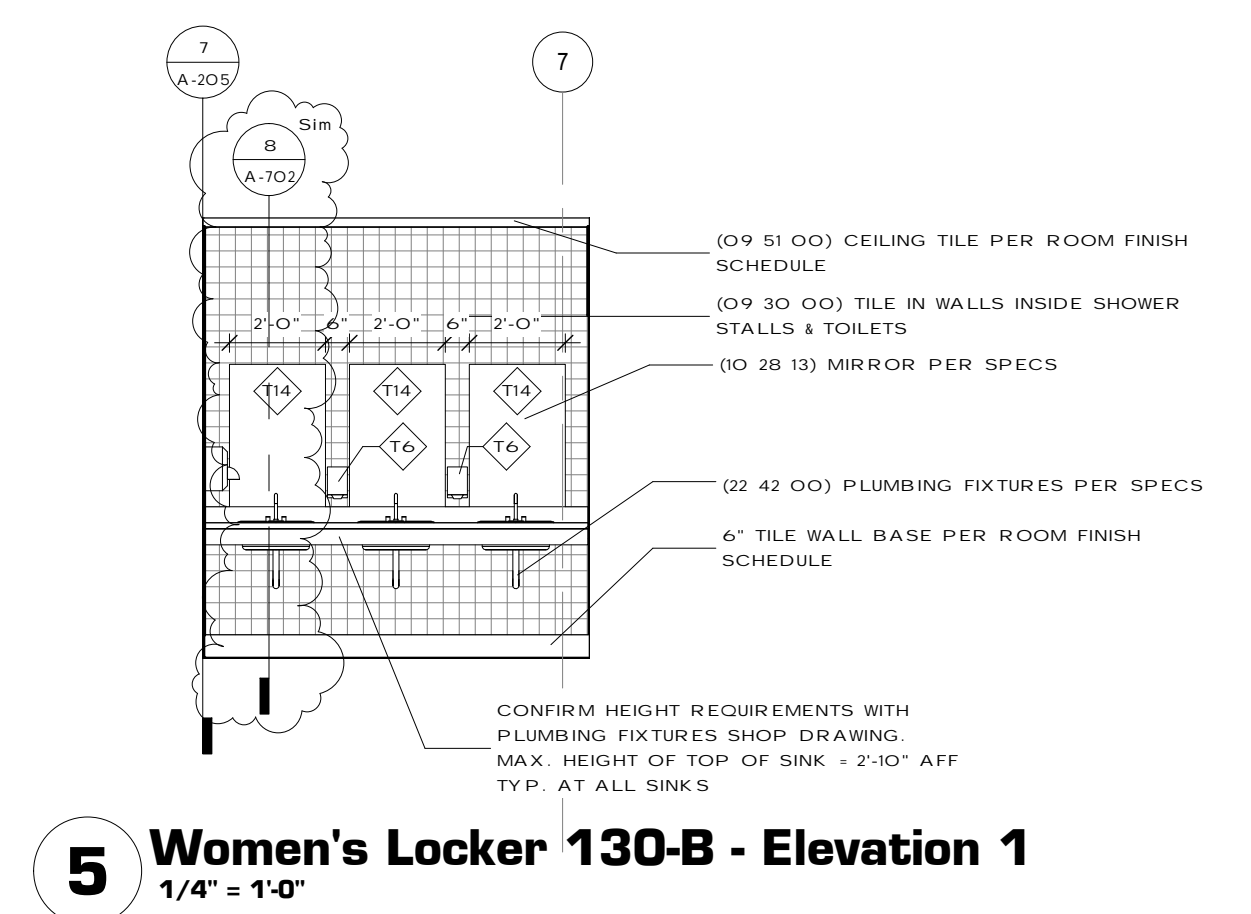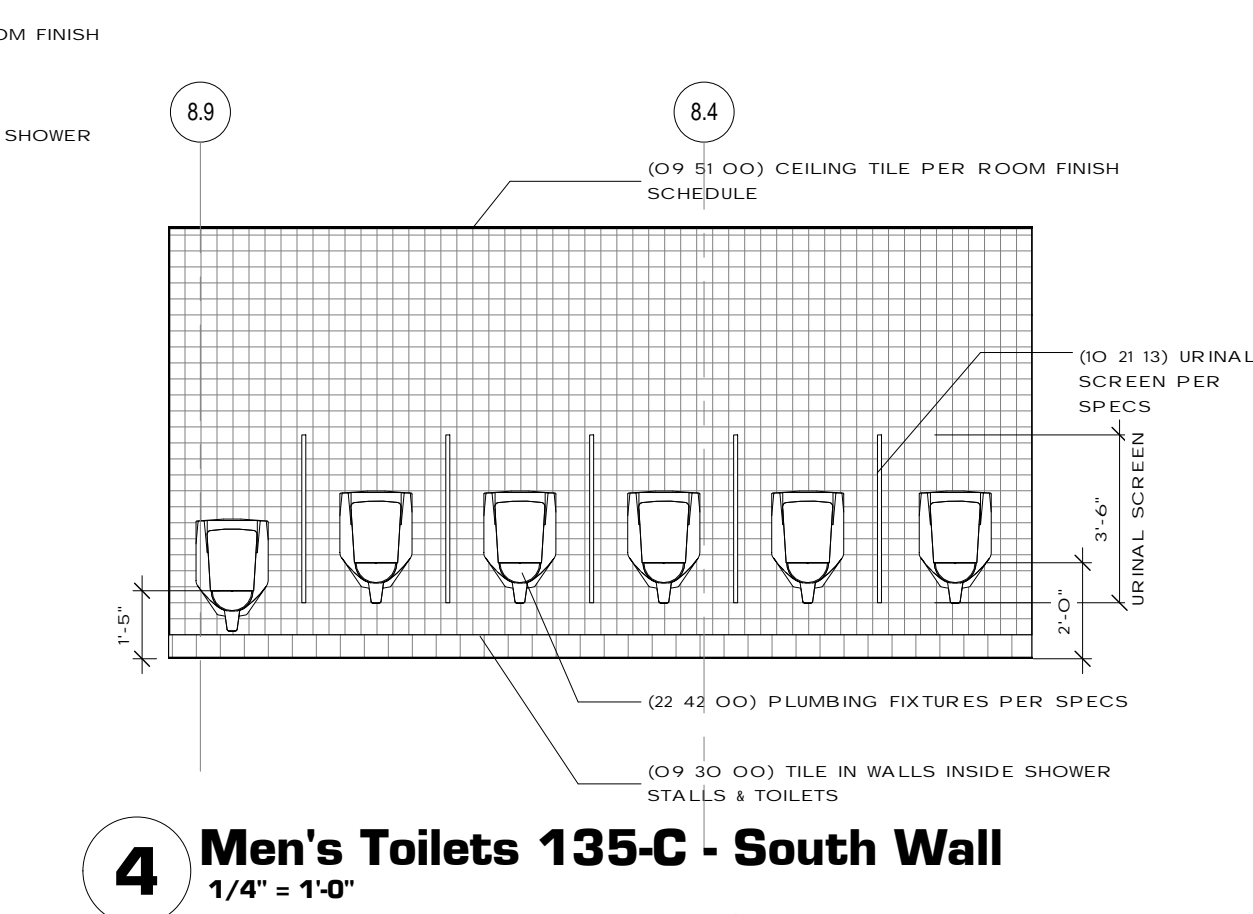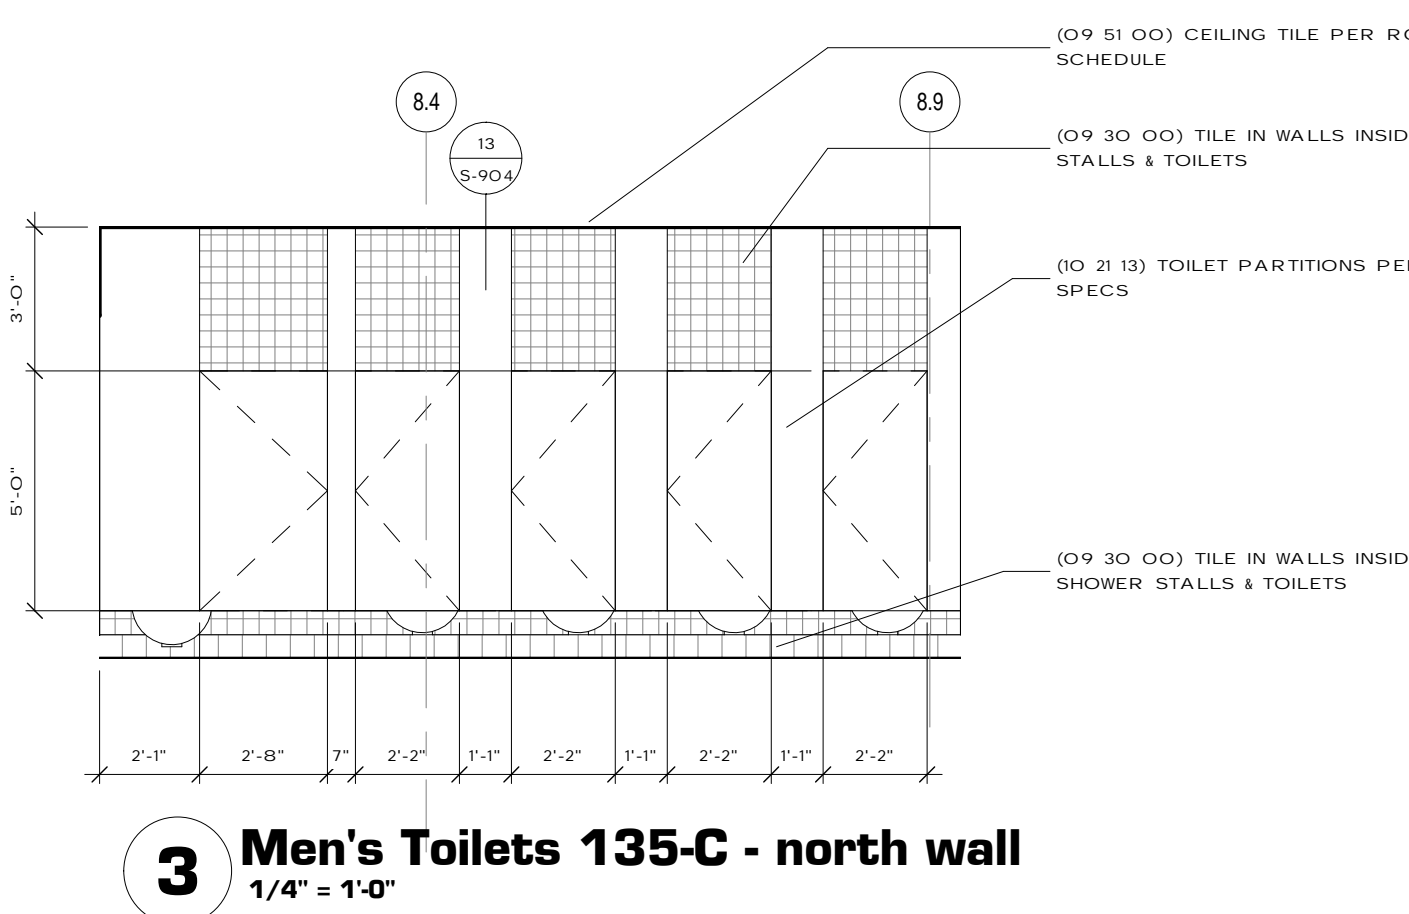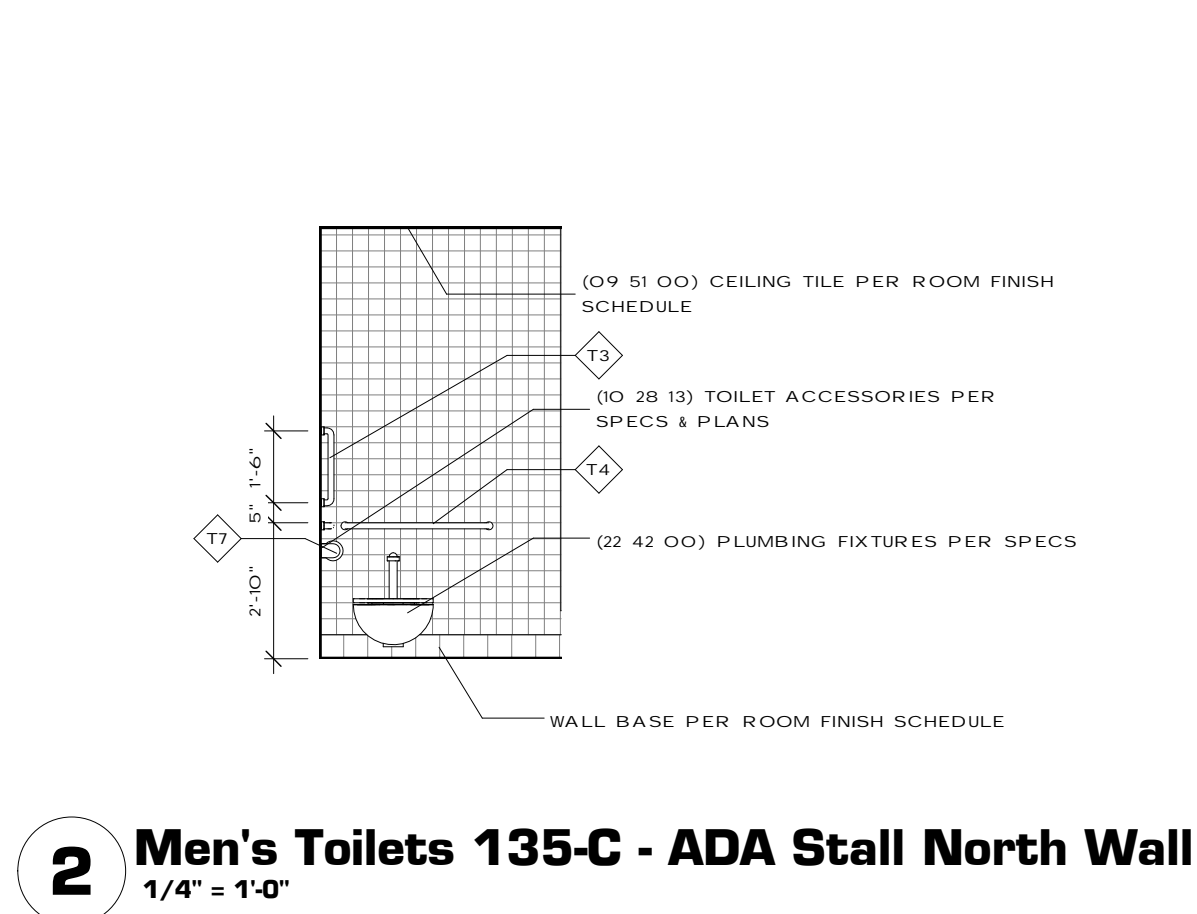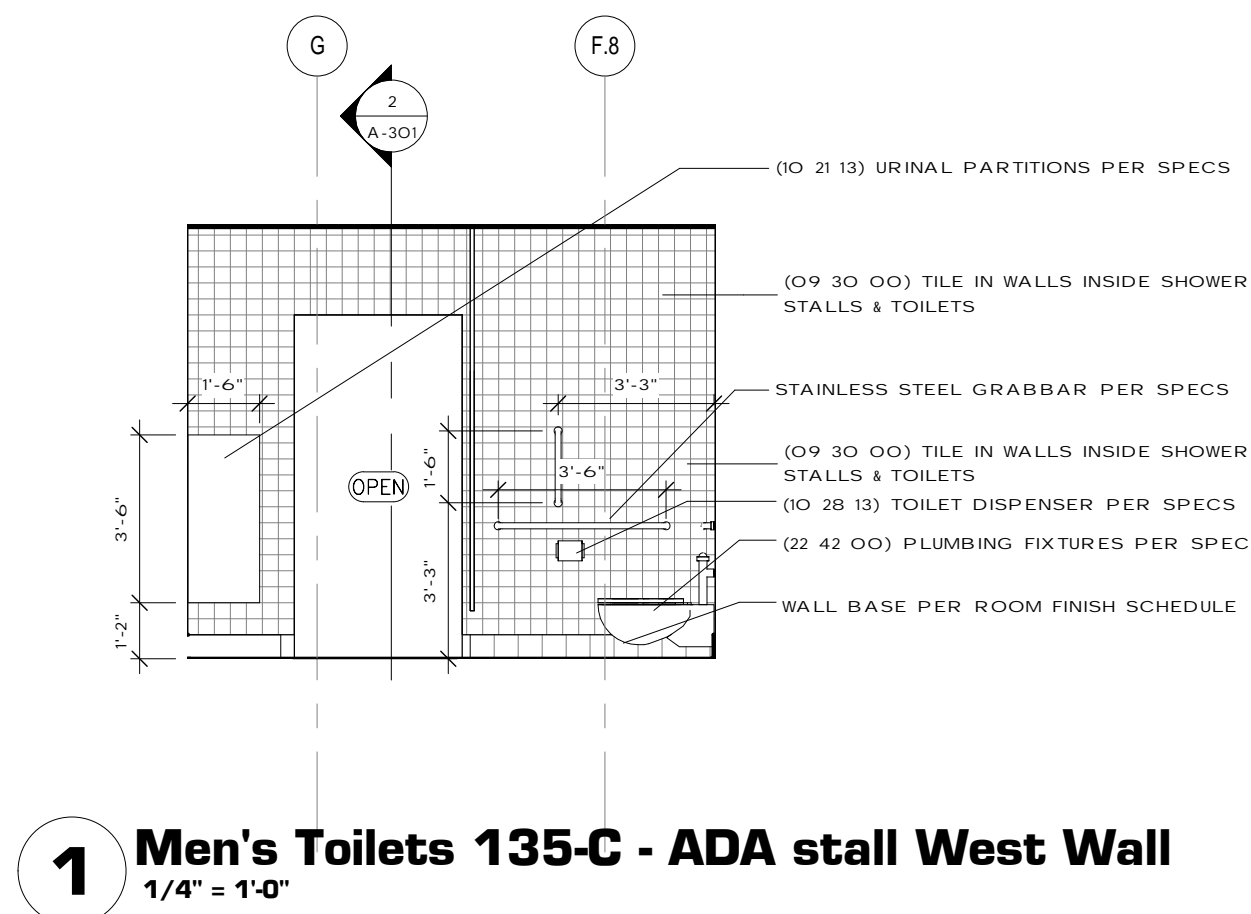

**15 Hall 146-A - South Wall Elevation**  
1/8" = 1'-0"

**16 Parts 137 - South Wall Elevation**  
1/4" = 1'-0"


**19 Typ. Locker Elevation**  
1/4" = 1'-0"

**17 ADA Shower Elevation (Typ.)**  
1/4" = 1'-0"


**TOILET ROOM & SHOWERS ACCESSORIES**

Type Mark	Description	Comments	Option 1	Option 2
T1	Electric Hand Dryer	Per Electric Specs		
T2	Heavy Duty Shower Grab Bars	Spec Section 10 28 13		
T3	Heavy Duty Grab Bar - 18"	Spec Section 10 28 13		
T4	Heavy Duty Grab Bar - 36"	Spec Section 10 28 13		
T5	Heavy Duty Grab Bar - 42"	Spec Section 10 28 13		
T6	Wall Mounted Soap Dispenser	Spec Section 10 28 13	Bay West # 91210	Kimberly Clark # 92145
T7	Toilet Paper Dispenser	Spec Section 10 28 13	Bay West # 80200	Kimberly Clark # 09604
T8	Paper Towel Dispenser w/ Waste Receptacle	Spec Section 10 28 13	Bobrick # B-3944	Bradley #234
T9	Sanitary Napkin Disposal	Spec Section 10 28 13	Bobrick # B-353	Bradley #4737
T10	Shower Rod w/Curtain	Spec Section 10 28 13	Bobrick # B-207	Bradley #9538
T11	Folding Shower Seat	Spec Section 10 28 13	Bobrick # B-5181	Bradley # 956
T12	Shower Hook	Spec Section 10 28 13	Bobrick # B-672	Bradley # 9124
T13	Soap Dish - Wall Mounted	Spec Section 10 28 13	Bobrick # B-680	Bradley # 901
T14	Tempered Glass Mirror w/ Channel Frame	Spec Section 10 28 13	Bobrick # B-2436	Bradley # 781


**2 Breakroom 132- Cabinet Section**  
1/2" = 1'-0"

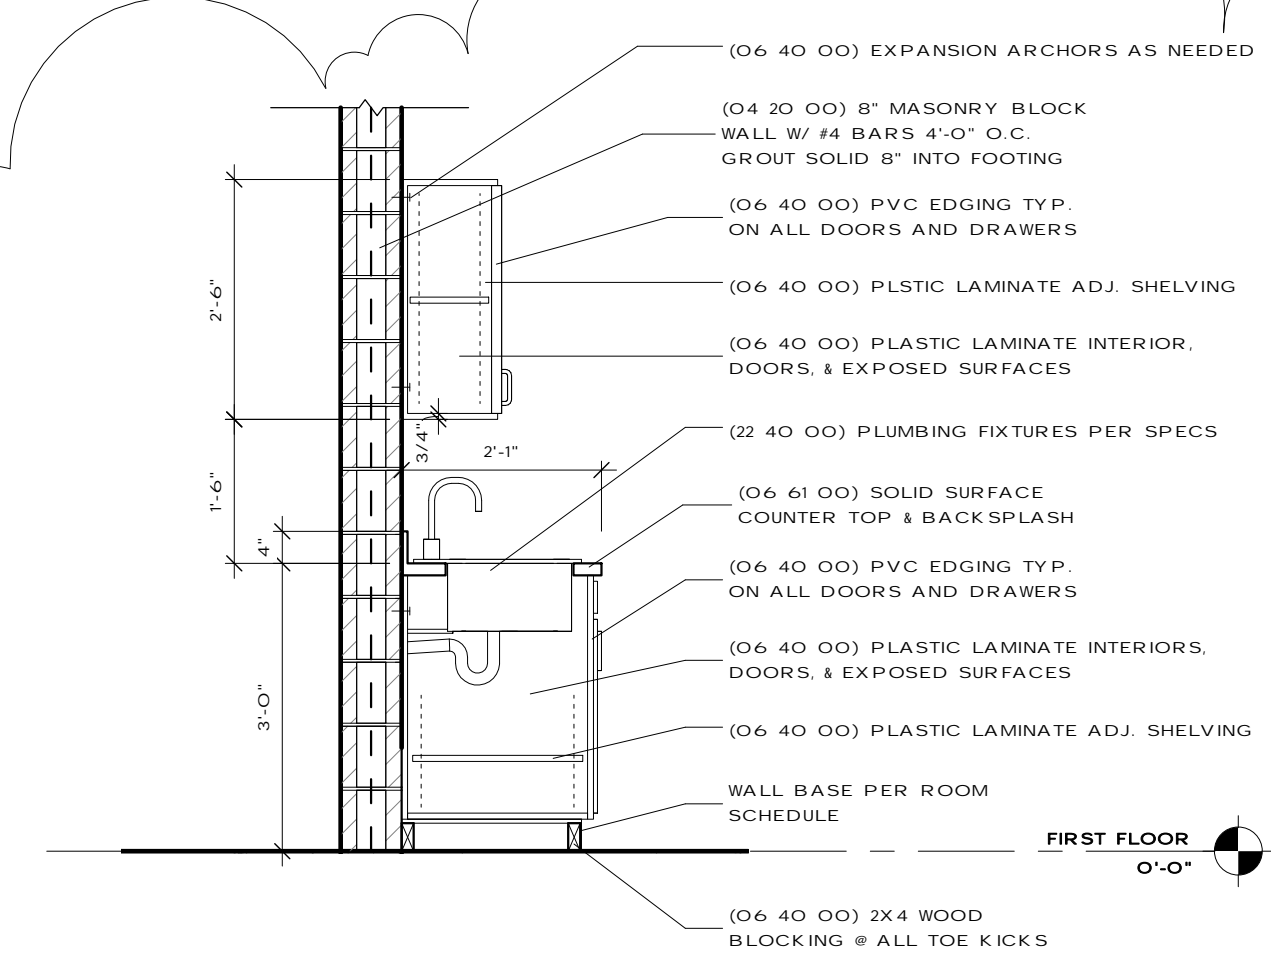



**7 Breakroom 132- Cabinet Section Through Microwave**  
1/2" = 1'-0"

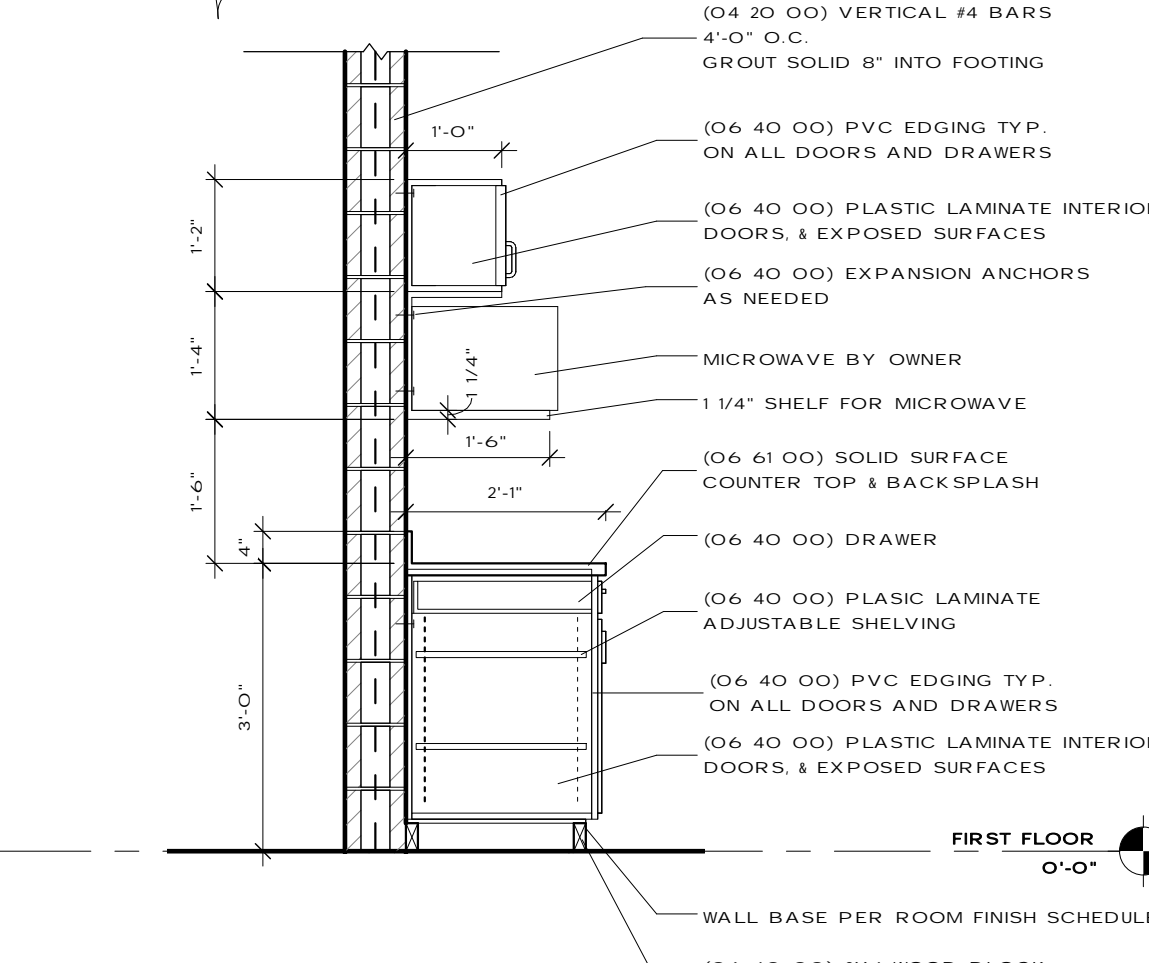


**8 Mens Locker 135-A- Sink Section**  
1/2" = 1'-0"

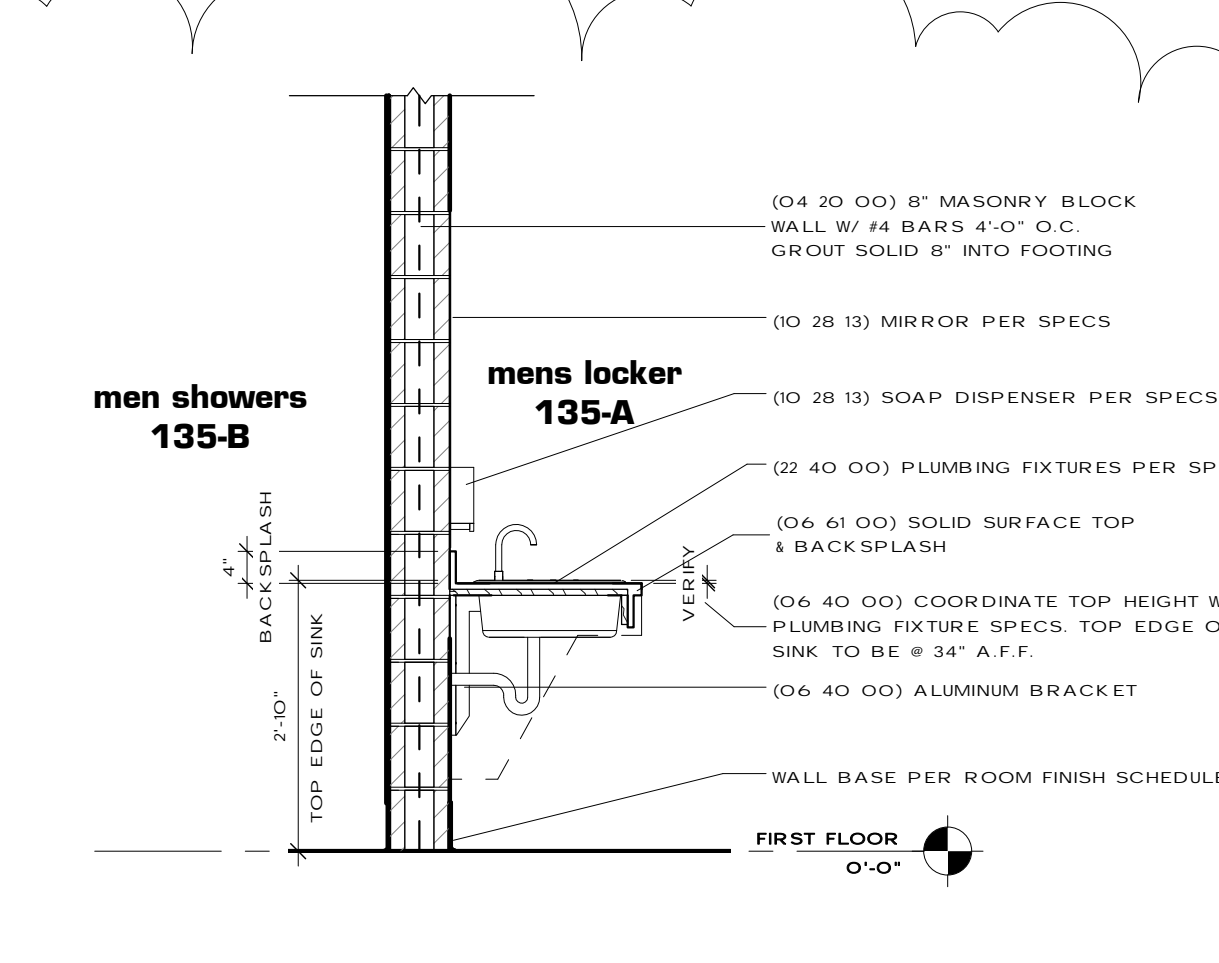

**9 Breakroom 132 - Counter Detail**  
1/2" = 1'-0"

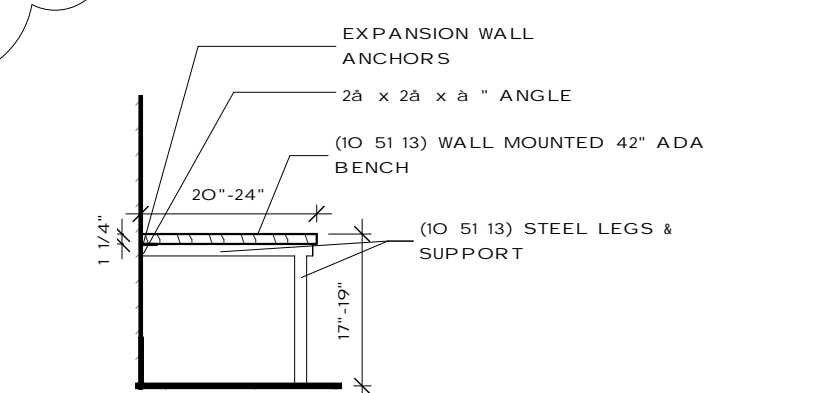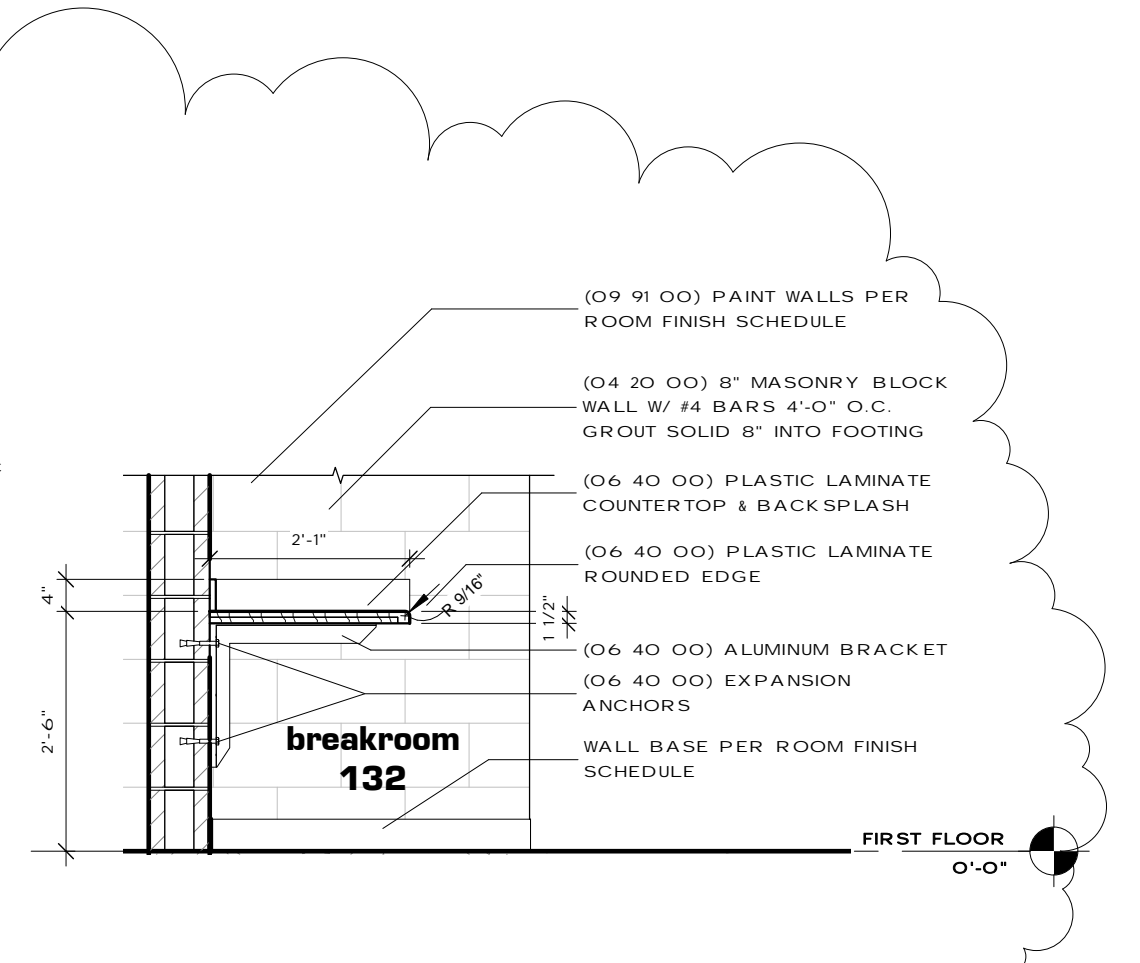


**5 ADA Bench - Detail 2**  
1/2" = 1'-0"

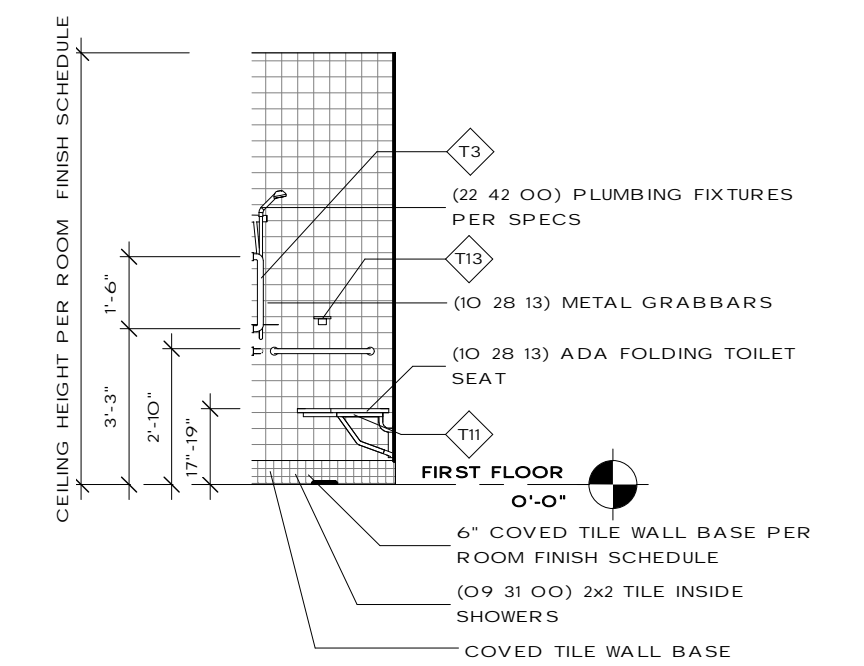


**3 ADA Shower Elevation**  
1/4" = 1'-0"


**1 Counter @ Break Room 132**  
1/4" = 1'-0"

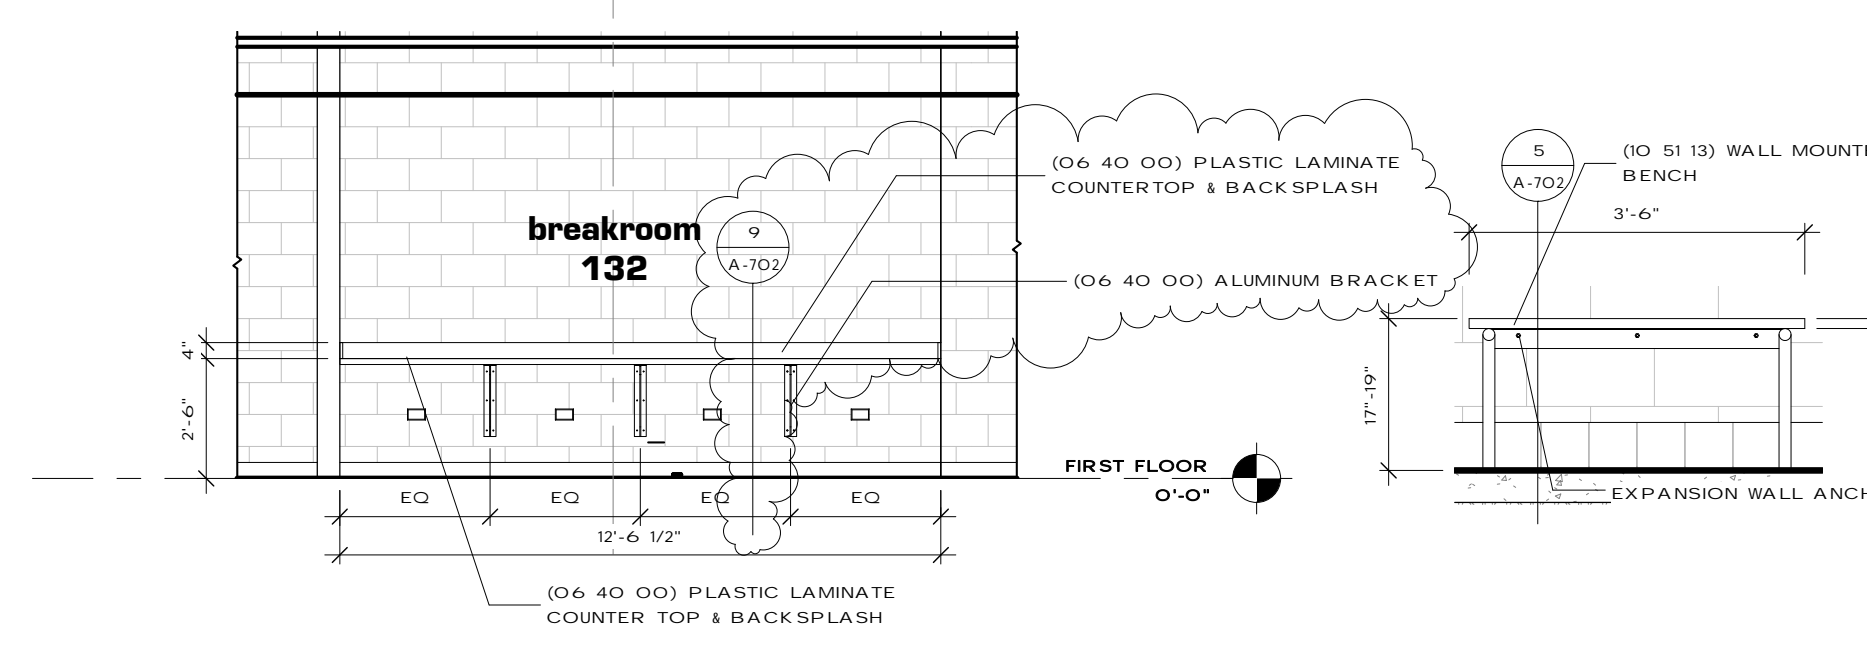

**4 ADA Bench - Detail 1**  
1/2" = 1'-0"


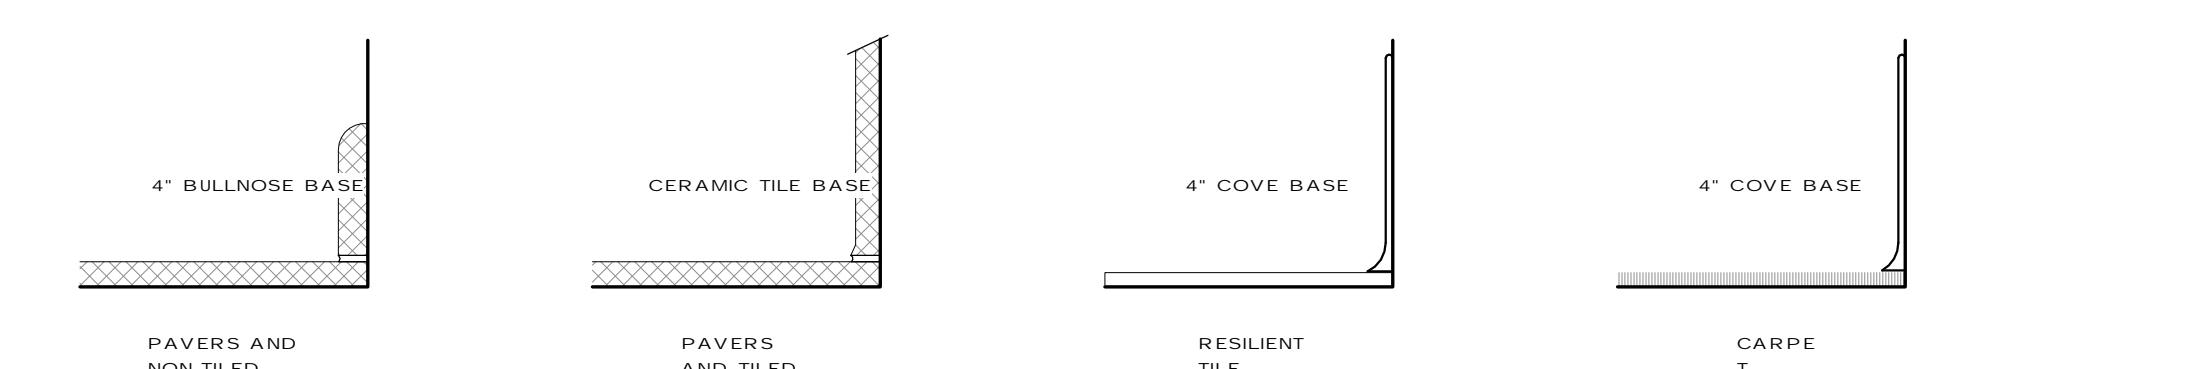


**Base Details**

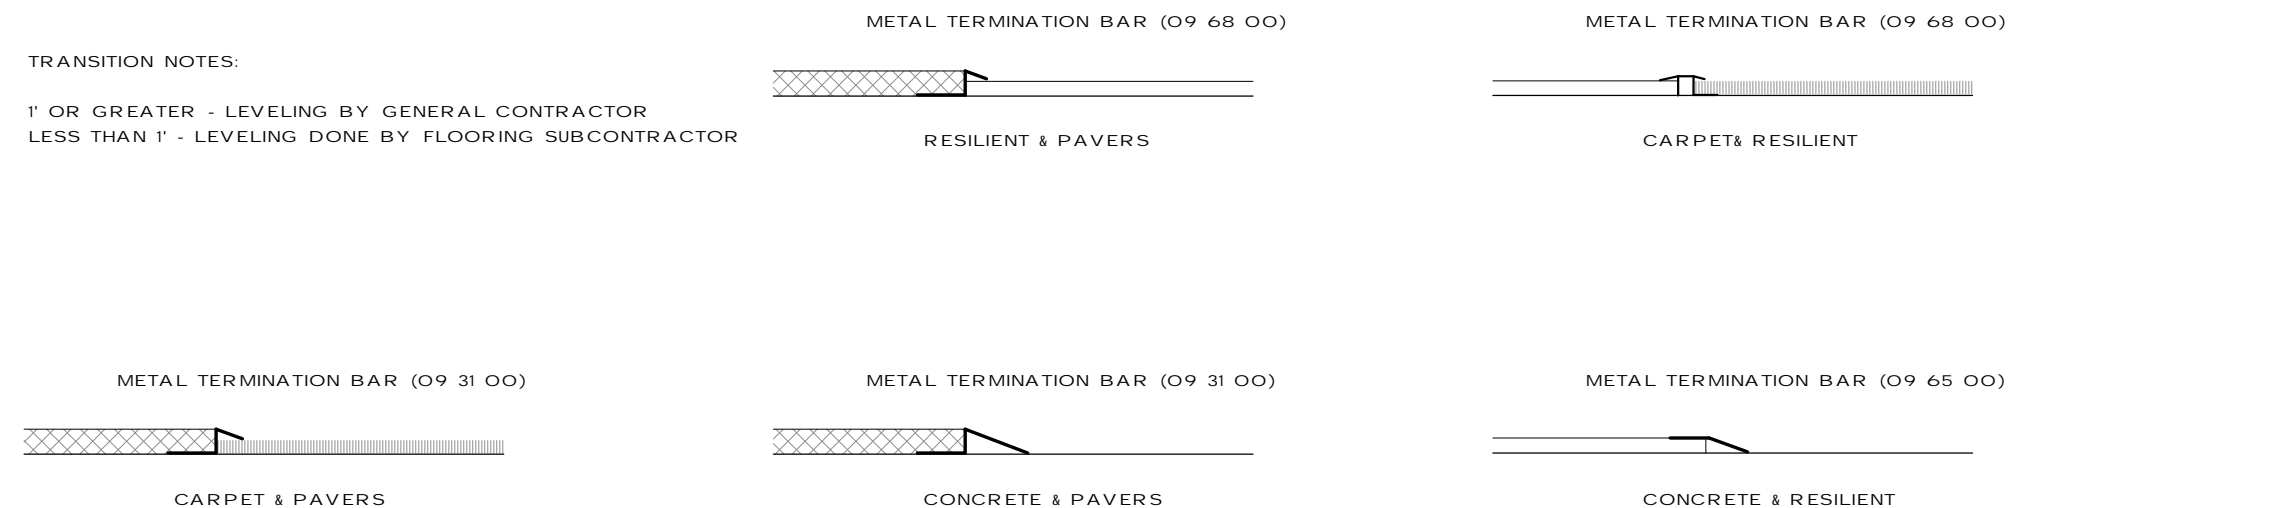


**Threshold Details**

**Joint Details**

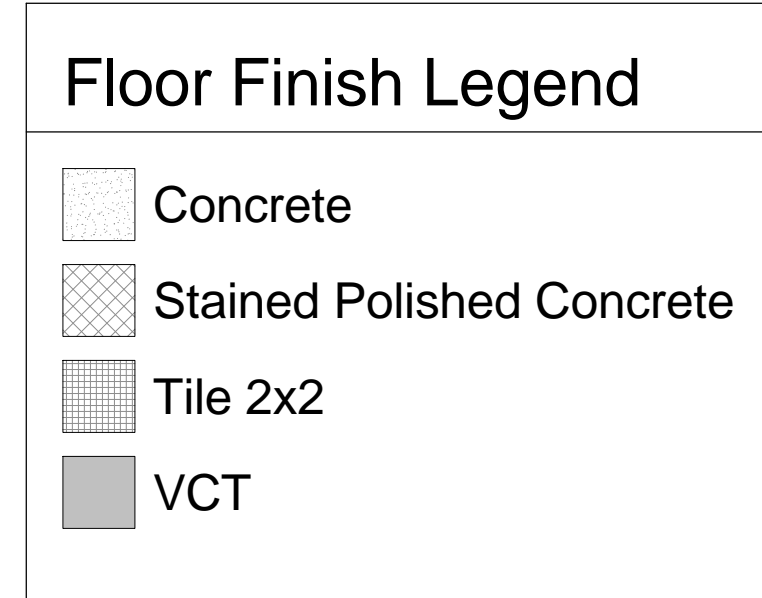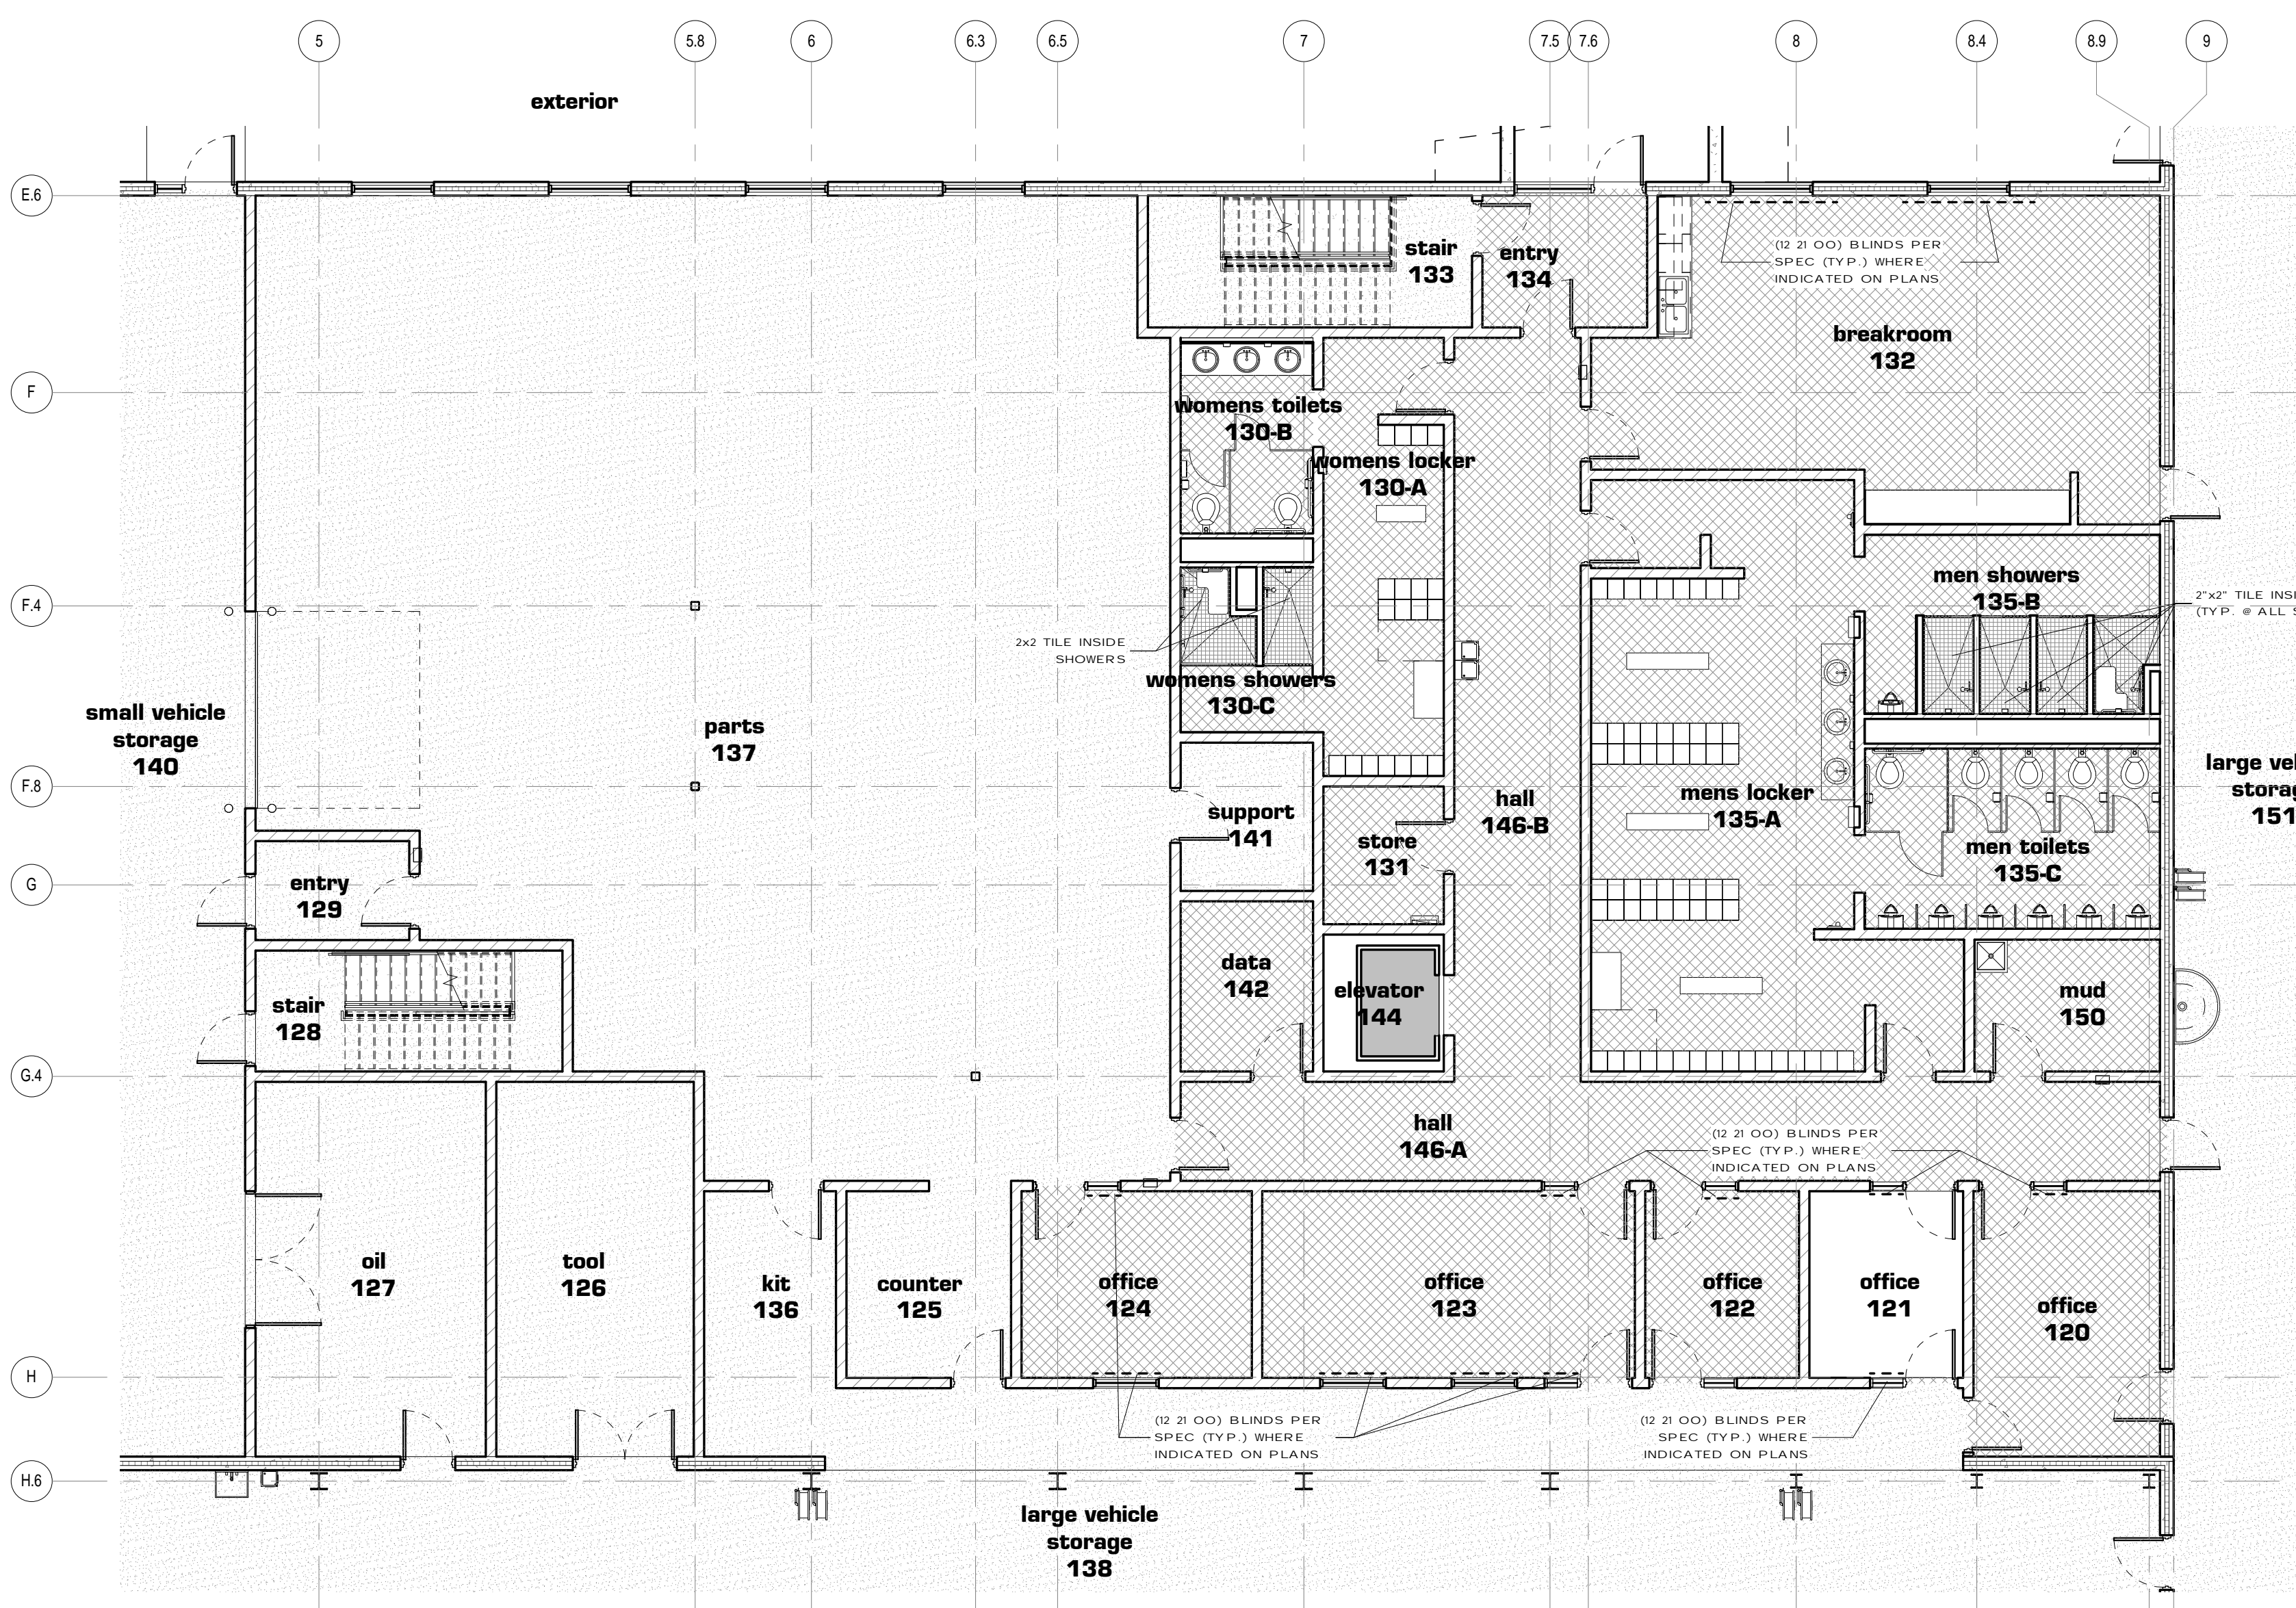

**6 Floor Finish Plan - Offices**  
1/8" = 1'-0"



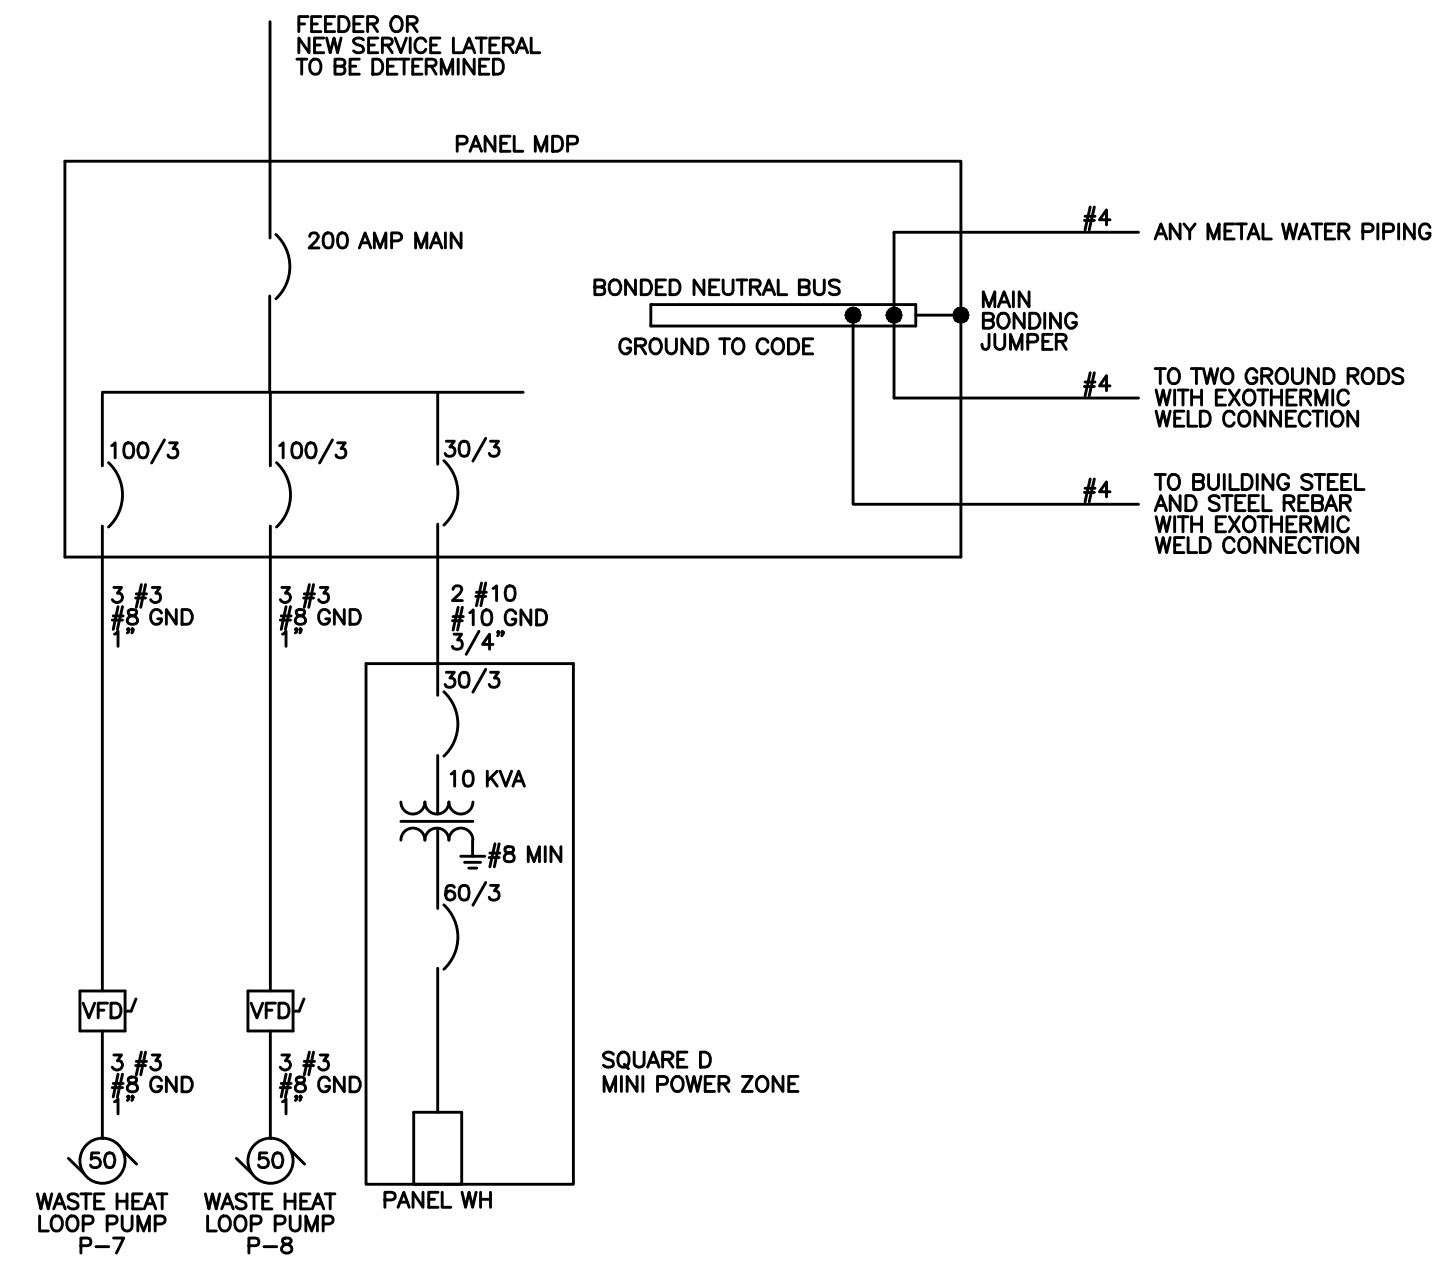

2 PUMP ENCLOSURE ONE-LINE  
NO SCALE



PANEL MDP – PUMP ENCLOSURE

225A MLO 27" SPACE 480V 3 PHASE 4 WIRE COPPER BUS W/GRD BUS SQUARE D HCN I-LINE NEMA 3R			
CIRCUIT BREAKERS: 65 KAIC MINIMUM			
NO.	DESCRIPTION	BKR	KW SPACE
1	WASTE HEAT LOOP PUMP P-7	100/3	54.04 4.5"
2	WASTE HEAT LOOP PUMP P-8	100/3	54.04 4.5"
3	PANEL A TRANSFORMER	30/2	- 3.0"
4	SPACE FOR 225 AMP FRAME CIRCUIT BREAKER	-	- 4.5"
5	SPACE FOR 225 AMP FRAME CIRCUIT BREAKER	-	- 4.5"
6	SPACE FOR 225 AMP FRAME CIRCUIT BREAKER	-	- 4.5"
TOTAL SPACE AVAILABLE		-	- 27"
TOTAL SPACE USED		-	- 12.0"
TOTAL SPACE REMAINING		-	- 15.0"

PANEL WH – WASTE HEAT PUMP ENCLOSURE

SQUARE D MINI POWER-ZONE MPZB10540F65K NEMA 3R 480V - 120/240V 1 PH, 3 W 10 KVA SINGLE PHASE TRANSFORMER								
30 AMP PRIMARY CIRCUIT BREAKER 60 AMP SECONDARY CIRCUIT BREAKER		10 POLE PANEL						
MAIN CIRCUIT BREAKER: 65 KAIC MINIMUM			BRANCH CIRCUIT BREAKERS: 10 KAIC MINIMUM					
NO.	DESCRIPTION	BKR	KW	PHASE	KW	BKR	DESCRIPTION	NO.
1	INTERIOR LIGHTS	15/1	.10	A	2.00	15/2	HEATER	2
3	EXTERIOR LIGHT	15/1	.01	B	-	-	-	4
5	RECEPTACLE	20/1	.18	A	-	20/1	SPARE	6
7	PUMP CONTROL MODULE	15/1	.18	B	-	20/1	SPARE	8
9	SPARE	20/1	-	A	-	20/1	SPARE	10

3 PUMP ENCLOSURE PANEL SCHEDULES  
NO SCALE

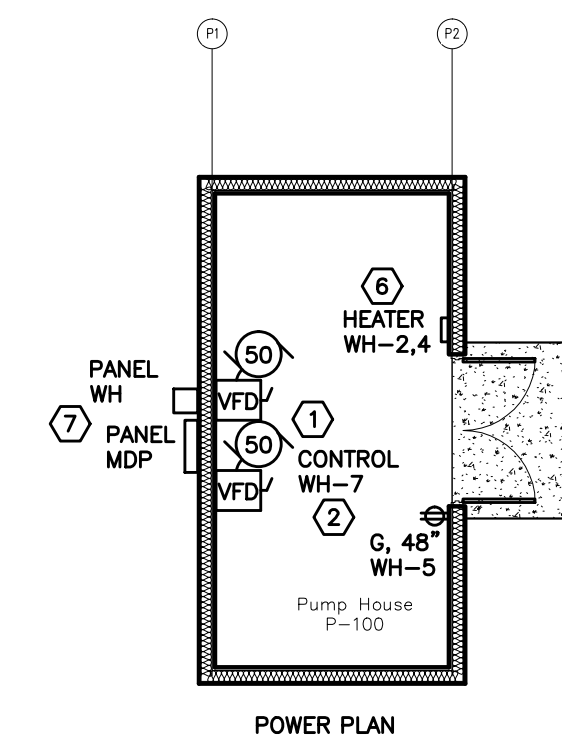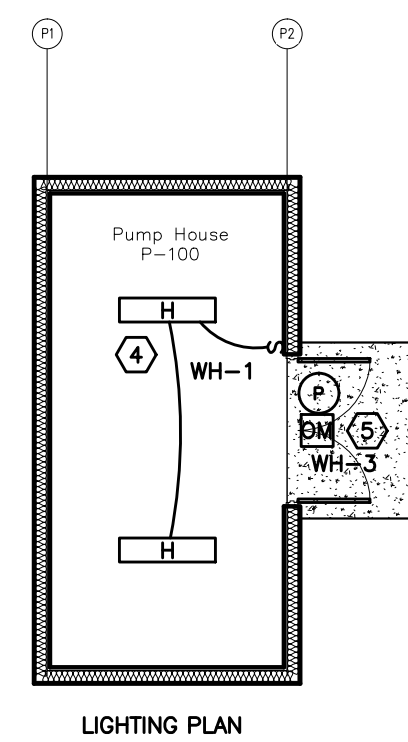

PUMP HOUSE NOTES

- ① PUMP P-7 AND PUMP P-8 VARIABLE FREQUENCY DRIVES AND DISCONNECTS PROVIDED BY HVAC CONTRACTOR AND MOUNTED AND WIRED BY THE ELECTRICAL CONTRACTOR. ELECTRICAL CONTRACTOR TO PROVIDE POWER WIRING ONLY. LOW VOLTAGE CONTROL WIRING BY HVAC CONTRACTOR.
- ② PROVIDE CIRCUIT TO HVAC CONTROL MODULE TO BE MOUNTED NEAR THE VARIABLE FREQUENCY DRIVES. PROVIDE RECEPTACLE OR LIGHT SWITCH AS A DISCONNECT AS REQUIRED.
- ③ GENERAL NOTE: VERIFY ALL ELECTRICAL EQUIPMENT AND DEVICE LOCATIONS WITH MECHANICAL CONTRACTORS.
- ④ CHAIN MOUNT TYPE H LIGHTS AROUND PIPING. VERIFY BEST LOCATION.
- ⑤ CENTER TYPE OM OUTDOOR LIGHT BETWEEN TOP OF DOOR AND SOFFIT. TYPE OM LIGHT IS A DARK BRONZE LED CUT OFF SECURITY LIGHT WITH PHOTOCELL (RAB SLIM12N/PC, 1372 LUMEN, 4000K, 120 VOLT, 14 WATT OR EQUAL).
- ⑥ VERIFY HEATER LOCATION WITH HVAC CONTRACTOR.
- ⑦ USE GALVANIZED STRUT TO MOUNT PANELS TO BUILDING.

1 PUMP ENCLOSURE ELECTRICAL PLANS  
SCALE: 1/8" = 1'

Page Intentionally Left Blank

# **ADDENDUM 1**

## **MEDICAL EXAMINER OFFICE BUILDING (BID PACKAGE B)**

**BID NO. 313083**

**ADDENDUM B1 (Bid Package B):** The following pages are addendum 1 for Medical Examiner Office Building (Bid Package B)



# DANE COUNTY DEPARTMENT of PUBLIC WORKS, HIGHWAY and TRANSPORTATION

County Executive  
Joseph T. Parisi

1919 Alliant Energy Center Way ♦ Madison, Wisconsin 53713  
Phone: (608) 266-4018 ♦ Fax: (608) 267-1533

Commissioner / Director  
Gerald J. Mandli

February 12, 2015

## **CONSTRUCTION OF EAST HIGHWAY GARAGE – SALT STORAGE FACILITY (BID PACKAGE A) AND MEDICAL EXAMINER OFFICE BUILDING (BID PACKAGE B)**

### **DEPARTMENT OF PUBLIC WORKS, HIGHWAY & TRANSPORTATION 3562 COUNTY HIGHWAY AB MCFARLAND, WISCONSIN**

## **MEDICAL EXAMINER OFFICE BUILDING (BID PACKAGE B)**

This Addendum is issued to modify, explain or clarify the original Request for Bid (RFB) and is hereby made a part of the RFB. Acknowledge this addendum on the Bid Form. The portion of this Addendum relating to Bid Package B is referenced as Addendum B1 for clarity.

### **CHANGES TO SPECIFICATIONS**

1. Document Index
  - a. Add 10 21 23 Cubicle Curtains
  - b. Add 23 57 00 Heat Exchangers
  - c. Add 23 84 13 Humidifiers
2. 01 00 00 Basic Requirements
  - a. 1.19 C. Revise to indicate “Temporary Water Service: Refer to Bid Package A”.
3. 04 20 00 Unit Masonry
  - a. 2.04.A.1.b: Revise to: “Size: 4 inch high by 12 inch wide by 4 inch deep”.
  - b. 2.04.A.1.c: Revise to: “Type - 1 Field Brick Color: Medium Ironspot, 46, Smooth”.
4. 07 42 13 Metal Wall Panels:
  - a. 2.05.B.1: Modify to include additional profile option: “Basis-of Design Product Centria Architectural System Profile BR5-36 or Style-Rib, solid and Ecoscreen Perforated Screenwall.”
5. 07 62 00 Sheet Metal Flashing and Trim:
  - a. Replace in its entirety to add gutter (gutter liner) to the work included as part of this specification.
6. 09 51 00 Acoustic Ceilings
  - a. 2.01.A.2: Modify to “Or USG Halcyon, 98225, or approved equal”.
  - b. 2.01.B.2: Modify to “Or USG Clean Room, 56099, or approved equal.”.

**Addendum No. B1 (Bid Package B)**

RFB No. 313083

- 1 -

rev. 08/14

- c. 2.01.C.2: Modify to “Or USG, Sheetrock™ Lay-in Ceiling Panels, ClimaPlus™, or approved equal”.
  - d. 2.02.B.2.c Modify to “Donn/USG: CE Grid with Gaskets”.
7. 09 90 00 Painting
- a. 3.08A. revise to read “General”.
  - b. Add 3.08.B Exterior Paint Schedule.

System	Material	Type/Sheen	Number and Type of Coating
EPS-1	Ferrous Metal (hollow metal, exposed plates, angles, bolts, etc.)	Latex /Semi-Gloss	One coat “Kem-Kromik Universal” primer; Two coats "DTM Acrylic”
EPS-2	Galvanized Metal (hollow metal, equipment housings, steel, etc.)	Latex /Semi-Gloss	One coat "Pro-Cryl Univeral" primer; Two coats "DTM Acrylic”

8. Add Section 10 21 23 Cubicle Curtains in its entirety.
9. 10 56 26 Mobile Storage Shelving
- a. Revise 2.01 F. 2. to read: “Provide end face panels at control end of movable shelving units: Steel.”
  - b. Remove 2.03 Item B.
  - c. 2.05 F. 1. Add: “Closed upright style at ends of rows, open upright style acceptable at intermediate uprights provided all performance requirements are met.”
  - d. Add Section 2.09 “Accessories, A. Bins: Flex Containers, Carousel Container, 16” length x 10” width x 10” height, straight wall, steel reinforced corrugated plastic containers. One color to be selected from manufacturer’s standard colors. Quantity: 546. Or approved equal.”
  - e. Revise 3.05 3. a. width to “36”W”.
  - f. Revise 3.05 3. b. quantity to “(12)”.
  - g. Revise 3.05 3. c. quantity to “(10)”.
10. 11 78 10 Autopsy & Morgue Equipment
- a. Modify 2.1 A. to “2.1 Acceptable Manufacturers A. Provide products as manufactured by Mortech Manufacturing, 411 North Aerojet Way, Azusa, CA 91702, [www.mortechmfg.com](http://www.mortechmfg.com) (phone 626-334-1471), or Mopec, 21750 Coolidge Highway, Oak Park, MI, 48237, [www.mopec.com](http://www.mopec.com) (phone 800-362-8491) or equal products pre-approved in writing 10 days prior to bid date.”
  - b. Modify 2.7 to be as follows: “2.7 RECESSED BODY SCALE WITH DIGITAL READOUT (Equipment Number **ME2**): Model LW458 QC by Rice Lake Weighing Systems Roughdeck QC (*Quick Clean*) #50411 with model 420 Plus HMI Digital Weight Indicator, or equal products pre-approved in writing 10 days prior to bid date.
  - c. Modify 2.13 to be as follows: 2.13 TISSUE GROSSING STATION (**Equipment Number H1**): Provide products as manufactured by Mortech Manufacturing, 411 North Aerojet Way, Azusa, CA 91702, [www.mortechmfg.com](http://www.mortechmfg.com) (phone 626-334-1471), Model GL105, or equal products pre-approved in writing 10 days prior to bid date.”
11. 12 48 40 Entrance Floor Mats and Frames:
- a. 2.01.B.1 Revise to read “Acceptable Manufacturers/Product: 1. Kadee Industries Inc., a. KD38 Stainless Steel Grating.
  - b. Add 2.01.B.2 to read “Or approved equal”.
12. 13 34 19 Metal Building Systems

- a. Replace in its entirety to clarify and modify the Scope of the Work in this section.  
General modifications: Gutter support/framings work remains as part of this specification section. The gutter (gutter liner) scope of the work has been moved to 07 62 00, Sheet Metal Flashing and Trim. Parapet support/framing has been clarified as part of the scope of work for this section. Approved equals have been indicated.
13. 22 13 00 Facility Sanitary Sewerage
- a. Under TRENCH DRAINS add “**ABT PolyDrain**” and after Manufacturers.
14. 22 30 00 Plumbing Equipment
- b. Page 3, line 2, under PLATE AND FRAME HEAT EXCHANGERS add “Bell and Gossett” and “Alfa Laval” after Manufacturers.
15. 23 09 14 Pneumatic and Electric Instrumentation and Control Devices for HVAC
- a. Page 1, Line 44: **Add** the following: “Fume Hood Sash Position and Face Velocity Sensors”
  - b. Page 11, Line 31: **Add** the following:
 

“Fume Hood Sash Position and Face Velocity Sensors  
Provide Safety Monitor/Alarm System for each fume hood, which monitors face velocity / sash position and provides audible and visual alarm if face velocity drops below safe levels. As the internal fume hood pressure changes while the sash is closed and opened, the flow passing over the thermistor is calibrated to a face velocity, which is displayed on the monitor front.

Safety Monitor: UL listed, tamper proof, with all alarm circuits, electric components, external tubing, and manifolds furnished complete and factory installed.

Calibration is the responsibility of the fume hood manufacturer, to be accomplished in the field. and is required once the hood is stationed and the hood exhausts and room supply systems are balanced. A secondary calibration has been factory set into the alarm's memory only to determine that the alarm is functional and ready for shipment. The primary calibration must be completed in the field.

Airflow Sensor: Thermally compensated glass-beaded thermistor, factory connected to a sidewall port on the interior of the fume hood.

Alarm Signal: Audible and visual signal.

Silence pushbutton, which disables the audible alarm, shall be accessible on the front of the safety monitor.

Provide alternate mode in which audible alarm is silenced indefinitely but visual alarm remains activated until the alarm condition is corrected.

Provide test circuit to verify proper Safety Monitor operation.”
  - c. Page 16, Line 62: Add the following:
 

“Fume Hood Presence Sensors  
Fume hood presence sensors shall be calibrated and set to existing site conditions by a certified technician. Document certified calibration and include in the project Operation and Maintenance Manuals.

Fume Hood Sash Position and Face Velocity Sensors  
Coordinate sensors and controller with fume hood manufacturer for seamless integration. Turn over sensors, operator interface, controllers, etc. to fume hood manufacturer for

factory installation. Fume hood safety monitors / alarm systems shall be calibrated by the fume hood manufacturer. Document certified calibration and include in the project Operation and Maintenance Manuals.”

16. 23 09 15 DDC Input / Output Summary Table
  - a. Page 9: Under Supply Air Terminals, add a point for “Space Pressure Switch (Tissue Recovery). Point to have digital input.
  - b. Remove existing page 23 09 15-13, and replace with new page 23 09 15-13, attached.
  - c. Add page 23 09 15-14 and 23 09 15-15, attached.
17. 23 09 23 – Direct Digital Control System for HVAC
  - a. Page 13: Delete lines 25 thru 64. Replace with “The existing system server located at the City County Building shall be used for the building automation system. All BAS graphics and controls shall be accessible from any computer with an internet browser.”
18. 23 09 93 – Sequence of Operation for HVAC Controls
  - a. Remove existing Section (pages 1 thru 31) and replace with revised Section, attached (Pages 1 thru 42).
19. 23 21 23 Hydronic Pumps
  - a. Page 2, line 27: Add Armstrong as an acceptable manufacturer.
  - b. Page 2, line 56: Add Armstrong as an acceptable manufacturer.
20. 23 34 00 HVAC Fans
  - a. Page 3, line 9. Add “**Loren Cook is an acceptable manufacturer.**”
21. 23 52 00 Heating Boilers
  - a. Page 3: Delete lines 31 thru 44 and replace with: “Boilers will be controlled by the building automation system. Boilers shall be able to receive an on/off signal and modulating capacity signal (0-10 Vdc or 4-20 mA) from the building automation system utilizing BacNet MSTP or LonWorks communication protocol.”
22. 23 57 00 Heat Exchangers
  - a. Add Section 23 57 00 Heat Exchangers, attached.
23. 23 84 13 Humidifiers
  - a. Add Section 23 84 13 Humidifiers, attached.
24. Section 25 00 00
  - c. Add in 1.03 “D. The SI shall integrate the IACS with the gate controls in Section 32 31 16 for control of the gates via the IACS.”
25. Section 26 23 00
  - a. In 2.01D, revise “65KA” to “35KA.”
26. Section 26 31 10
  - a. In 1.04A, add “8. Meet with Alliant Energy Distributed Resources Specialist David Sinner (DavidSinner@alliantenergy.com, phone 608-458-3215) prior to any work, including preparation of shop drawings to review all aspects of the installation and to clarify all Alliant Energy requirements.”
  - b. In 1.04C, add “3. Complete application for interconnection (PSCW 6028). Assist owner in completing Interconnection Agreement (PSCW 6030).”
  - c. Add in 2.02 “E. Auto-disconnection contactor: provide contactor to disconnect system upon failure of utility. System to remain isolated even when utility power is temporarily reestablished by recloser action. Contactor is also to be locked out when automatic transfer switch is in emergency position.”
  - d. Add in 2.02A “4. With integral DC disconnect.”

27. Section 26 32 13
- a. In 2.06A, add “2. Provide auxiliary contact to close on signal to start for use by controls contractor in initiating motor starting timed sequence.”
28. Section 26 41 00
- a. In 2.01A, add “Equivalent materials by Preferred Lightning Protection are acceptable.”
29. Section 27 60 00
- a. Add attached section
30. Section 28 31 00
- a. In 1.07, add “D. Acceptable manufacturers are Notifier, Simplex and Edwards. Gamewell equipment is acceptable IF IN FULL COMPLIANCE WITH THE SPECIFICATIONS IN EVERY DETAIL.”
31. 32 12 16 Asphalt Paving
- a. 2.02.A Replace “PG 62-22” with “PG 58-28.”
  - b. 2.04.A.1 Omit “Provide Mixture Type E-3.0 from the WisDOT SSHSC Section 460-2 per Geotechnical Report recommendations”.
  - c. 2.04.A. Add item 2:
    - Passenger Vehicle Parking / Low Traffic Areas Detail
      - a. Type: WisDOT Type E-1.0
      - b. Lower Layer Thickness: 2.25 inches
      - c. Lower Layer Gradation: 19.0 mm
      - d. Lower Layer Performance Grade: PG 58-28
      - e. Upper Layer Thickness: 1.75 inches
      - f. Upper Layer Gradation: 12.5 mm
      - g. Upper Layer Performance Grade: PG 58-28
  - d. 2.04.A. Add item 3: Truck Traffic Areas Detail
    - a. Type: WisDOT Type E-10
    - b. Lower Layer Thickness: 4.0 inches
    - c. Lower Layer Gradation: 19.0 mm
    - d. Lower Layer Performance Grade: PG 58-28
    - e. Upper Layer Thickness: 2.0 inches
    - f. Upper Layer Gradation: 12.5 mm
    - g. Upper Layer Performance Grade: PG 58-28
32. 32 31 16 Welded Wire Fences and Gates
- a. 1.2. B.2. Replace section “270000 Communications Cable and Equipment” with “275123 ‘Intercom System’ for gate control communications.”
  - b. 2.4.A. Replace “Master Halco, Access Control, Orange, CA Phone (800) 229-5615 Fax (714) 385-0104” with “LiftMaster; 845 Larch Avenue; Elmhurst, IL 60126-1196. Toll-Free: 800.282.6225. Email: specs@LiftMaster.com. Web: LiftMaster.com.”
  - c. 2.4.C. Replace “For gates up to 20’- MODEL: MHAC 076047, H.P. ½, VOLTS-110VAC, PHASE- Single” with “Gate Operators: LiftMaster SL585 Industrial Gear-Driven Slide Gate Operator.
    1. Compliance: UL 325 listed, UL 991 and CSA C22.2 No. 247 standards.
      - a. Ratings: Class II.
    2. Warranty: 2 years.
    3. Operator Speed: 11 inches per second.
    4. Electrical Power Requirements: 115/208/230V AC, single phase, 60 Hz.
    5. Electrical Power Requirements: 208/230/460/575V AC, 3-phase, 60 Hz.
    6. Accessory Electrical Power Requirements: 24V AC.
    7. Gear Reduction: 20:1 wormgear reducer in synthetic oil bath.”
  - d. 2.4.D. Replace “For gates 20’ to 30’- MODEL: MHAC 076108, H.P.- 1, VOLTS-230VAC, PHASE- Single” with



“Motor for gates up to 20’: 1/2 HP, continuous duty.

1. Capacity: Supports gate lengths up to 45 feet and gate weights up to 1,000 pounds.
2. Recommended Cycles per Hour: 20.

Motor for gates up to 35’: 1 HP, continuous duty.

1. Capacity: Supports gate lengths up to 70 feet and gate weights up to 1,600 pounds.
2. Recommended Cycles per Hour: 20.”

- e. 2.4 Renumber Emergency Access Requirements from A. to H.
- f. 2.4 Renumber Item beginning Motorized gate from B. to I.
- g. 2.4 Renumber Interface with radio controlled devices and loop detectors from C. to J.
- h. 2.4 Renumber item beginning Gate reader from D. to K.
- i. 2.4 Add item “L. The gates are to open on a successful card read from the associated reader. Gate card reader furnished under section 28 13 00. Intercoms shall be furnished under Section 27 51 23. The gates are to open on a signal entered from the telephone system. Gate installer to coordinate with owner’s telephone vendor.”

## CHANGES TO DRAWINGS

### 33. SHEET C100:

- a. Added dimensions to proposed building from property lines.
- b. Modified 884 contour.
- c. Removed utilities not in the scope of this Bid Package.

### 34. SHEET C200

- a. Removed electric from southeast corner of building.
- b. Added Note 3, “Refer to Electric, Plumbing and Mechanical Drawings for Detailed Utility Information.”

### 35. SHEET C600:

- a. 3/C600: Revise surface course to 1.75” depth and binder course to 2.25” depth.
- b. 4/C600: Revise surface course to 2” depth and binder course to 4” depth.

### 36. SHEET A200:

- a. Replace in its entirety.
- b. 1/A200, First Floor Plan: Added details and dimensions at door 1012b (Column H/3.8).
- c. 1/A200, First Floor Plan: Clarified dimensions on floor plan.
- d. 1/A200: Added Detail references to Door 1012b.
- e. 1/A200: Revised P-Types.
- f. Floor Plan Keynotes: Added the following to Keynote”5” – “See 2/A821 for locations”.

### 37. SHEET A201:

- a. Replace in its entirety.
- b. 1/A201, Roof Plan: Added the following note, “Air Cooled Condensing Units By Others”.
- c. 1/A201: Added garage downspouts on north and south side.

### 38. SHEET A210:

- a. Replace in its entirety.
- b. 1/A210, Unisex Toilet: Clarified dimensions as shown.
- c. 2/A210, Toilet Rooms: Clarified dimensions as shown.
- d. 3/A210: Eliminated reference to P-Type 1E, and referenced 1/A800 and 10/A820 for wall information.
- e. 6/A210, Mens and Womens Lockers: Clarified dimensions and added notes as shown. Added interior elevations 31, 32, 33, and 34/A800.
- f. 8/A210, Changed title to “Unisex Toilets”. Clarified dimensions as shown.

39. SHEET A300:
  - a. Ceiling Plan Keynotes: Revise keynote 3 to read “Not Used”.
  - b. Added the following to the end of keynote 8 – “See 2/A821 for locations”.
40. SHEET A503:
  - a. Replace in its entirety.
  - b. 1, 2 and 3/A503: Revised wall sections for clarification of Pre-Engineered Metal Building responsibilities.
41. SHEET A604:
  - a. Replace in its entirety.
  - b. 3, 10 and 11/A603: Modified details for clarification of Pre-Engineered Metal Building responsibilities.
42. SHEET A606:
  - a. Replace in its entirety.
  - b. 7 and 8/A606: Revised details to account for aluminum framed storefront type 1 conditions.
43. SHEET A609:
  - a. Replace in its entirety.
  - b. Added details 8/A609 and 10/A609 for hollow metal door conditions.
44. SHEET A701:
  - a. Door Schedule: Door “125A” – Revised hardware set to “13”. Door “200” – Revised hardware set to “16”.
45. SHEET A800:
  - a. Replace in its entirety.
  - b. Added the following Interior Elevations: 31, 32, 33, and 34/A800.
46. SHEET A830:
  - a. 9/A830, Window Stool: Added the following note “Align edge of window stool with face of Gypsum Wallboard”.
47. SHEET Q210
  - a. Replace with the attached drawing, deleted South monitor at Autopsy station (KN#27).
  - b. Replace with the attached drawing, revise reference to Key Note 23 to Key Note 73 located pointing to the grossing station (H1) exhaust duct in General Lab 133.
  - c. Revise Key Notes to indicate: 25. Not Used, 36. Not Used, 39. Not Used, 50. Not Used, 62. Not Used, 64. Not Used, 75. Not Used.
48. SHEET Q211:
  - a. Revise Key Notes to indicate: 25. Not Used, 36. Not Used, 39. Not Used, 50. Not Used, 62. Not Used, 64. Not Used, 75. Not Used.
49. SHEET Q800:
  - a. Revise Key Notes to indicate: 25. Not Used, 36. Not Used, 39. Not Used, 50. Not Used, 62. Not Used, 64. Not Used, 75. Not Used.
50. SHEET Q821:
  - a. Replace in its entirety.
  - b. Modified detail 7/Q821 so that the 1-inch dimension changed to “varies see plan”.
51. SHEET S100:
  - a. Replace in its entirety.
  - b. Detail 1/S100: Sloped slabs in locker rooms near grid E-4 and E-6. Added room outlines.

- c. Detail 1/S100: Body Cooler room 103E. Added sloped floor designation to plan.
  - d. Detail 1/S100: Grid D.2-8. Dropped footing elevation to clear scale pit.
  - e. Keyed Notes: Revised note 1. Added notes 21,22.
52. SHEET S200:
- a. Replace in its entirety.
  - b. Detail 1/S200: Added unit weight for EF-4 in the Garage building.
  - c. Detail 1/S200: Added note 62 to garage plan noting the location of cord reel supports.
  - d. Detail 1/S200: Added note 63 to garage plan noting the roof deck at the garage.
  - e. Detail 1/S200: Added note 4 to the “Notes for Framing of Pre-Engineered Metal Building Garage”.
  - f. Keyed Notes: Revised note 49. Added notes 62,63.
53. SHEET S201:
- a. Replace in its entirety.
  - b. Detail 2/S201: Added location of cord reel supports.
  - c. Misc Framing Plan Keyed Notes: Added note 14.
54. SHEET S300:
- a. Replace in its entirety.
  - b. Details 5,6,7,9,11,12,24/S300: Added underfloor rigid insulation.
55. SHEET S301:
- a. Replace in its entirety.
  - b. Details 7,8/S301: Added underfloor rigid insulation.
  - c. Added detail 17/S301.
56. SHEET S401:
- a. Replace in its entirety.
  - b. Added detail 11/S401.
57. SHEET P100:
- a. See revised drawing, P100, attached.
58. SHEET P200:
- a. See revised drawing, P200, attached.
59. SHEET P701
- a. See revised drawing, P701, attached.
60. SHEET P702
- a. See revised drawing, P702, attached.
61. SHEET P900
- a. See revised drawing, P900, attached.
62. SHEET M200
- a. See revised drawing, M200, attached.
63. SHEET M201
- a. See revised drawing, M201, attached.
64. SHEET M300
- a. See revised drawing, M300, attached.
65. SHEET M401
- a. See revised drawing, M401, attached.

66. SHEET M500
- a. Detail 5/M500: Remove reference to double wall duct.
67. SHEET M900
- a. See revised drawing, M900, attached.
68. SHEET E001:
- a. In keyed note 1, add “twelve inches” after rebar.
  - b. Relocate the CT cabinet/meter to a concrete pad adjacent to the utility transformer.
69. SHEET E101:
- a. Add TV outlet in 105-north wall, east corner at 8’-0” AFF. Provide duplex receptacle adjacent on ckt. LA-15.
  - b. Add a special outlet TCP and voice/data outlet in 154 on south wall, east of doors. Wire to LB-34.
  - c. Add a special outlet TCP and voice/data outlet in 110, west wall. Wire to LA-6.
  - d. Add EF-7 in Electrical Room 139-1/4 HP, 120V. Provide manual starter. Wire fan speed control. Wiring 3#12-1/2”c. from 20A, 1P breaker (LB-36).
  - e. Add UH-10 in Electrical Room 139-9W, 120V. Provide manual starter. Wiring 3#12-1/2”c. from 20A, 1P breaker (LB-36).
  - f. Revise General Note 3 to read: “CNG vehicles will be stored in Garage 150. Keep all wiring 18” below ceiling. Any wiring closer than 18” to ceiling must be Class 1 Division 2.”
  - g. In keyed note 30 add “or 132” after 130.
  - h. Relocate electric meter/termination compartment to a concrete pad adjacent to the pad mounted transformer.
  - i. Add a special outlet – Humidifier-in Chiller Room 154-18KW-480volts, three phase – wiring 4# 10-1”conduit from 30A, 3P breaker (HB-31, 33, 35)
70. SHEET E102:
- a. In keyed note 2, change “1 inch conduit” to “2 inch conduit terminated on a weatherhead”.
71. SHEET E103:
- a. In 140, wire two special outlets TCP for CRAC-1, 2. Wire to LB-34. See M200 for locations. Provide a voice/data outlet at each TCP.
72. SHEET E200:
- a. Wiring Diagram – Occupancy Sensor: Add a second power pack controlled by daylight sensor, occupancy sensor and local switch to provide off-override for 50% lighting level when daylight level is adequate. Other local switch to control remaining 50% of lighting via occupancy sensor.
73. SHEET E300:
- a. Add note regarding incoming primary “Stub (2) 5” conduits out 10’-0” past distributed earth for incoming primary cables.”
  - b. Revise breaker AIC to 35KA
  - c. Add general note 3 “Provide 3 1/2” concrete housekeeping pad for service entrance rated automatic transfer switch.”
74. SHEET E400:
- a. Light Fixture Schedule - Alternate Bid - LED
    - i. Revise type M to (6) lamp fluorescent-F54THO/SPX35/ECO - Daybrite ST8245-3/F/F8240/277/ECB. Apply notes 2, 6, 8.
    - ii. Revise type N to (3) lamp fluorescent- F54THO/SPX35/ECO - Daybrite ST8145-2/F/F8140/277/ECB. Apply note 2.
    - iii. Change OB to Gardco 101L-3-35LA-NW-UNIV-BRP.

iv. Change OC to Gardco 101L-3-55 LA-NW-UNIV-BRP.

75. SHEET E401:

- a. Special Outlet Schedule
  - i. Revise note 13 to read “Provide fire alarm monitor modules to indicate panel in alarm, panel trouble, clean agent discharge and tank supervisory alarm.”
- b. Special Outlet Schedule – Medical Examiners Equipment
  - ii. Add “8. See Detail A on E101.” Apply to outlet ME13.

76. SHEET E402:

- a. In panel HB, revise AIC to 35KA.
- b. In panel HB, add one 30A, 3P.

77. SHEET E403

- a. Motor Schedule
  - i. Delete note 1 for CRAC-1, 2. Apply new note “5. Provide duct detector at supply duct with RTS/I in room 140 and control module. Program control module to control smoke damper in supply duct. Provide area detector at return grille. Provide control module to control smoke damper in return duct.”
  - ii. Revise P-9 to 120V – 1/6HP wired to LA-1.
  - iii. Revise AHU-2 to 30HP, wiring to #6 in 1”c.
  - iv. Revise starter type for P-5, 6 to VFD.
  - v. Revise starter type for P-12, 13 and EF-5 to VFD. delete note 1.

END OF ADDENDUM B1

Enclosures:

Section 07 62 00 Sheet Metal Flashing and Trim  
Section 10 21 23 Cubicle Curtains  
Section 13 34 19 Metal Building Systems  
Pages 23 09 15-13, 23 09 15-14 and 23 09 15-15  
Section 23 09 93 Sequence of Operation for HVAC Controls  
Section 23 57 00 Heat Exchangers  
Section 23 84 13 Humidifiers  
Section 27 60 00 Radio Reinforcement

C100, C200, C600, A200, A201, A210, A503, A604, A606, A609, A800, Q210, Q821, S100, S200, S201, S300, S301, S401, P100, P200, P701, P702, P900, M200, M201, M300, M401, M900

SECTION 07 62 00

SHEET METAL FLASHING AND TRIM

PART 1 - GENERAL

1.01 RELATED DOCUMENTS

- A. Conditions of the Contract and portions of Division One of this Project Manual apply to this Section as though repeated herein.

1.02 WORK INCLUDED

- A. Metal Counter Flashing.
- B. Exposed Metal Trim/Fascia/Copings.
- C. Miscellaneous Sheet Metal Accessories.
- D. Flashing.
- E. Gutter (Gutter Liner).

1.03 RELATED WORK

- A. Sections 04 01 00, 04 20 00, 04 43 00 and 04 72 00 for Thru-Wall Flashing at Masonry.
- B. Section 06 10 00, Rough Carpentry for Wood Blocking, Nailers.
- C. Section 07 53 23, Ethylene-Propylene-Diene-Monomer Roofing
- D. Section 07 92 00, Joint Sealants
- E. Section 13 41 19, Metal Building Systems
- F. Division 22: Plumbing
- G. Division 23: HVAC

1.04 PERFORMANCE REQUIREMENTS

- A. General: Manufacture and install copings, fascia, and scuppers to resist thermally induced movement and exposure to weather without failing, rattling, leaking, and fastener disengagement.
- B. FMG Listing: Manufacture and install copings, fascia, and scuppers that are listed in FMG's "Approval Guide" and approved for Windstorm Classification, Class 1-60. Identify materials with FMG markings.
- C. Thermal Movements: Provide manufactured copings, fascia, and scuppers that allow for thermal movements resulting from the following maximum change (range) in ambient and surface temperatures by preventing buckling, opening of joints, hole elongation, overstressing of components, failure of joint sealants, failure of connections, and other detrimental effects. Provide clips that resist rotation and avoid shear stress as a result of thermal movements. Base

1 engineering calculation on surface temperatures of materials due to both solar heat gain and  
2 nighttime-sky heat loss.

3  
4 1. Temperature Change (Range): 120 deg F, ambient; 180 deg F, material surfaces.  
5

6 1.05 REFERENCES  
7

8 A. Referenced Standards Recommended practices and details as set forth by the 1993 Edition of the  
9 Sheet Metal and Air Conditioning Contractors National Association, Inc. (SMACNA) in the  
10 "Architectural Sheet Metal Manual" are incorporated by reference made a part of this work.

- 11 1. AISI – American Iron and Steel Institute.
- 12 2. ASTM 240 Type 304 Stainless Steel
- 13 3. ASTM A653 - Steel Sheet, Zinc Coated (Galvanized) or Zinc-Iron Alloy-Coated  
14 (Galvannealed) by the Hot-Dip Process.
- 15 4. ASTM B32 - Solder Metal.
- 16 5. ASTM B209 - Aluminum and Aluminum-Alloy Sheet and Plate.
- 17 6. ASTM C920 – Elastomeric Joint Sealants.
- 18 7. ASTM D2244 – Test Method for Calculation of Color Differences from Instrumentally  
19 Measured Color Coordinates.
- 20 8. ASTM D4214 – Test Methods for Evaluating Degree of Chalking of Exterior Paint Films.
- 21 9. NRCA - Roofing and Waterproofing Manual.
- 22 10. SMACNA - Architectural Sheet Metal Manual.

23  
24 1.06 SUBMITTALS  
25

26 A. Submit in accordance with the General Conditions of the Contract.

- 27 1. Shop Drawings showing profiles, joint treatment, fastening methods, gauge and finish of  
28 materials.
- 29 2. Actual samples of pre-finished sheet metal showing the exact color(s) and texture(s) available  
30 for selection from manufacturer's full range.

31 B. Provide mock-ups as indicated on Drawings.

- 32 1. All components of wall construction, wall openings, wall base, window sills, flashing, etc. to  
33 be included in mock-up as indicated on drawings.
- 34 2. Mock-up to be stand-alone assembly separate from work at the building.
- 35 3. Provide Shop Drawings for Mock-up as is shown on drawings.
- 36 4. Refer to Section 01 00 00 for more information.

37  
38  
39 1.07 GUARANTEE  
40

41 A. Manufacturer's Warranty: Provide the sheet metal manufacturer's standard twenty (20) year  
42 warranty stating at a minimum that the metal finish will not chalk in excess of an eight (8) rating,  
43 or fade in excess of a five (5) rating, when tested in accordance with ASTM D2244 and ASTM  
44 D4214.  
45

46 1.08 ENVIRONMENTAL REQUIREMENTS  
47

48 A. Low-Emitting Materials, Adhesives, and Sealants: Materials used on the interior of the building  
49 (defined as inside the weatherproofing system and applied on site) must not exceed the following  
50 requirements.

- 51 1. Adhesives, Sealants and Sealant Primers: South Coast Air Quality Management  
52 (SCAQMD) Rule # 1168, requirements in effect on July 1, 2005, and rule amendment  
53 date January 7, 2005.
- 54 2. Aerosol Adhesives: Green Seal Standard for Commercial Adhesives GS-36, requirements  
55 in effect on October 19, 2000.

1  
2  
- B. Recycled Content of Aluminum Materials: Provide aluminum materials containing the maximum possible amount of postconsumer and preconsumer recycled aluminum content.

PART 2 - PRODUCTS

2.01 MANUFACTURERS

- A. Manufacturers: Subject to requirements, provide products of one of the following:
  1. Cheney Flashing Company.
  2. Hickman, W. P. Company.
  3. Metal-Era, Inc.
  4. MM Systems Corporation.
  5. Perimeter Systems, a division of Southern Aluminum Finishing Co.
  6. Petersen Aluminum Corp.

2.02 METAL COUNTER FLASHING

- A. Zinc-Coated (Galvanized) Steel Sheet: ASTM A 653/A 653M, G90 coating designation; structural quality.
- B. Minimum 22 gauge stainless steel or as indicated on drawings.

2.03 EXPOSED METAL TRIM, FASCIA, COPINGS, SCUPPERS

- A. Aluminum Sheet: ASTM B 209, alloy and temper recommended by manufacturer for use and finish indicated, finished as follows:
  1. Aluminum: Coping, fascia and trim: 0.080 inch thick; Scupper: 0.063 inch thick.
  2. Copings: Manufactured coping system consisting of formed-metal coping cap in section lengths not exceeding 12 feet, concealed anchorage, concealed splice plates with same finish as coping caps, mitered corner units, and end cap units.
    - a. Acceptable Manufacturer: Econosnap, or approved equal.
    - b. Corners: Mechanically clinched and sealed watertight.
    - c. Anchor Plates: Concealed, galvanized steel sheet, 12 inches wide, 0.028 inch thick, with integral cleats.
    - d. Coping dimensions as indicated in drawings.
  3. Surface: Smooth, flat finish.
  4. High-Performance Organic Finish: AA-C12C42R1x (Chemical Finish: cleaned with inhibited chemicals; Chemical Finish: acid-chromate-fluoride-phosphate conversion coating; Organic Coating: as specified below). Prepare, pretreat, and apply coating to exposed metal surfaces to comply with coating and resin manufacturers' written instructions.
    - a. Fluoropolymer 2-Coat System: Manufacturer's standard 2-coat, thermocured system consisting of specially formulated inhibitive primer and fluoropolymer color topcoat. Color as selected by Architect

2.04 ACCESSORIES

- A. Fasteners: Where not specified, size fasteners to suit conditions. No dissimilar metals allowed.
- B. Blind rivets: 1/8" copper "pop" rivets.
- C. Solder: As specified by manufacturer.
- D. Flux: As specified by manufacturer.



- 1  
2 E. Self-Adhering, High-Temperature Sheet Flashing: Minimum 30 to 40 mils thick, consisting of slip-  
3 resisting polyethylene-film top surface laminated to layer of butyl or SBS-modified asphalt adhesive,  
4 with release-paper backing; cold applied. Provide primer when recommended by underlayment  
5 manufacturer.  
6 1. Thermal Stability: ASTM D 1970; stable after testing at 240 deg F.  
7 2. Low-Temperature Flexibility: ASTM D 1970; passes after testing at minus 20 deg F.  
8 3. Products: Subject to compliance with requirements, available products that may be  
9 incorporated into the Work include, but are not limited to, the following:  
10 a. Carlisle Coatings & Waterproofing Inc.; CCW WIP 300HT.  
11 b. Grace Construction Products, a unit of W. R. Grace & Co.; Ultra.  
12 c. Henry Company; Blueskin PE200 HT.  
13 d. Metal-Fab Manufacturing, LLC; MetShield.  
14 e. Owens Corning; WeatherLock Metal High Temperature Underlayment.  
15  
16 F. Flexible Flashing: 0.045" EPDM.  
17  
18 G. Other products, not specifically described, but required for a complete and proper installation of the  
19 work in this section shall be selected by the Contractor subject to the approval of the A/E.  
20

21 2.05 GUTTERS:

- 22  
23 A. Material:  
24 1. 18 gauge stainless steel, type 304.  
25 2. Size: Custom break metal shape as indicated on drawings.  
26

27 2.06 SEALANT:

- 28  
29 A. Meets ASTM C-920, Type M, Grade NS, Class 25, use T, NT, M, G, A, O.  
30  
31 B. Federal Specification TT-S-00227E;  
32  
33 C. CRD C 506, Type II, Multi-part polyurethane base, elastomeric joint sealing compound;  
34 1. Color: Selected by A/E from manufacturer's full range of colors.  
35

36 PART 3 - EXECUTION

37  
38 3.01 EXAMINATION

- 39  
40 A. Examine surfaces to be covered by sheet metal. Report any improper defective surfaces to  
41 Contractor in writing. Beginning of sheet metal work over surfaces: Presumed as acceptance of  
42 surfaces as satisfactory by sheet metal sub-contractor.  
43

44 3.02 FABRICATION

- 45  
46 A. Fabricate sections as detailed. Form sections true to shape, accurate in size, square and free from  
47 distortion or defects. Do not "punch" metal at brake points.  
48  
49 B. Form all pieces in lengths of 8'-0" or 10'-0" where practical. Sections less than 3' long are  
50 unacceptable unless that section comprises the entire run.  
51  
52 C. Unless detailed otherwise, hem exposed edges on underside 1/2"; fabricate vertical faces with  
53 bottom edge formed outward 3/4" at 30 degrees and hemmed to form drip.  
54

- 1 D. Miter and seam inside and outside corners using rivets and multi-part polyurethane sealant.  
2 Outside corners shall be prefabricated with outside face of section broken at corner; seam at  
3 corner is unacceptable. Pieces shall be a minimum of 18" in length, in both directions from the  
4 corner.  
5  
6 E. Utilize a minimum 4" back dam and 1 1/2" end dams.  
7  
8 F. Metal Counter Flashing:  
9 1. Formed in 8-foot minimum sections, lap end joints 3 inches.  
10 2. Do not seal joints; make continuous at angles; overlap base flashing minimum of 3 inches.  
11

12 3.03 INSTALLATION  
13

- 14 A. General: Install copings, fascia, and scuppers according to manufacturer's written instructions.  
15 Anchor copings and scuppers securely in place and capable of resisting forces specified in  
16 performance requirements. Use fasteners, separators, sealants, and other miscellaneous items as  
17 required to complete manufactured roof specialty systems.  
18 1. Install with provisions for thermal and structural movement.  
19 2. Torch cutting is not permitted.  
20  
21 B. Metal Protection: Where dissimilar metals will contact each other or corrosive substrates, protect  
22 against galvanic action by painting contact surfaces with bituminous coating or by other permanent  
23 separation as recommended by manufacturer.  
24 1. Underlayment: Where installing exposed-to-view components of manufactured roof  
25 specialties directly on cementitious or wood substrates, install a course of polyethylene  
26 underlayment.  
27  
28 C. Installation to have seams and lines as established by the approved shop erection drawings.  
29  
30 D. Coping/Scuppers: Install cleats, anchor plates, and other anchoring and attachment accessories and  
31 devices with concealed fasteners.  
32  
33 E. Minimize all exposed fasteners, utilize cleated seams whenever possible.  
34  
35 F. Anchor to resist uplift and outward forces according to performance requirements.  
36  
37 G. Install level, plumb, true to line and elevation, and without warping, jogs in alignment, excessive oil-  
38 canning, buckling, or tool marks.  
39  
40 H. Install to fit substrates and to result in watertight performance. Verify shapes and dimensions of  
41 surfaces to be covered before manufacture.  
42  
43 I. Expansion Provisions: Provide for thermal expansion of exposed copings and scuppers. Space  
44 movement joints at a maximum of 12 feet with no unplanned joints within 18 inches of corners or  
45 intersections.  
46  
47 J. Fasteners: Use fasteners of type and size recommended by manufacturer but of sizes that will  
48 penetrate substrate not less than 1-1/4 inches for nails and not less than 3/4 inch for wood screws.  
49  
50 K. Details should be per SMACNA ARCHITECTURAL SHEET METAL MANUAL recommended  
51 details.  
52  
53 L. Parapet Scuppers: Install scuppers where indicated through parapet. Continuously support scupper,  
54 set to correct elevation, and seal flanges to interior and exterior wall faces, over cants or tapered  
55 edge strips, and under roofing membrane.

- 1  
2 M. Gutters (Gutter liner):  
3 1. Joints in gutter should be lapped one inch minimum, welded or riveted 2 inches on center and  
4 soldered.  
5 2. The allowance for expansion: 1-1/8 inches for 50-foot lengths.  
6 a. Expansion joints must be located as to be a minimum of 15-feet from outlets.  
7 3. Width of the cap for the expansion joint is 3-1/4" 50-foot lengths.  
8 4. Support for gutter (built-in) by Section 13 34 19.  
9 5. Install gutters to form watertight assembly.  
10 a. Form gutters without longitudinal seams.  
11 b. Gutter joints and expansion joint caps shall be lapped 1-5/8" in the direction of  
12 waterflow. Riveted and soldered.  
13 1) Rivets shall be 3/16" in diameter with burrs under peened heads. Rivets shall  
14 be spaced not more than 3" apart in two staggered rows, with 1/2" edge and  
15 end distance.  
16 c. Slope gutter bottoms as indicated to roof drain conductor as indicated on Drawings.  
17 d. Complete all soldering with joints flat, before installing gutter. Block and band gutter,  
18 as necessary, to prevent deflection and breaking solder joints while installing gutter.  
19 e. Outlet tubes shall extend into roof drain conductor at least 3".  
20 1) Upper end of tube shall be flanged 1/2" and soldered to gutter. Longitudinal  
21 seam shall be locked and soldered.  
22 2) Provide removable strainers at all outlets.

23  
24 3.04 WORKMANSHIP

- 25  
26 A. Make all work weather and watertight throughout; provide allowances for material expansion and  
27 contraction.  
28  
29 B. Sections shall be uniform, accurately fitted so as to line up straight and true and rigidly secured in  
30 place, without kinks or buckles. Joints at corners and angles shall be smooth, tight and neatly  
31 mitered and seamed.  
32  
33 C. Unless detailed otherwise, lap all vertical joints between adjacent sections a minimum of 2".  
34  
35 D. Where metal is hooked to a continuous cleat, crimp metal to cleat along entire length.  
36  
37 E. Repair or replace all damaged or defective work.  
38  
39 F. Soldering:  
40  
41 1. Rivet pieces prior to soldering.  
42  
43 2. Soldering shall be done with heavy soldering coppers of blunt design, properly tinned before  
44 using. Coppers shall weigh not less than 10 pounds per pair. Use of a gas torch is not  
45 allowed.  
46  
47 3. Follow manufacturer's recommendations for cleaning, tinning and soldering metal.  
48  
49 4. Soldering shall be done slowly to heat sheet metal thoroughly and to sweat solder completely  
50 through full width of seam. Whenever possible, soldering shall be done in flat position;  
51 seams on slopes shall be soldered a second time.  
52  
53 5. Clean all flux from metal after soldering is completed.  
54

55 3.05 COUNTERFLASHING RECEIVER:

1  
2  
- A. Install new receiver as detailed or where required.
- B. Notch and lap joints 3" between sections.
- C. Apply sealant at the joint between the receiver and the masonry wall where receiver is not part of a thru-wall flashing; DO NOT APPLY SEALANT between masonry and thru-wall flashings.

3.06 COUNTERFLASHING:

- A. Fasten counterflashing to receiver with stainless steel sheet metal screws 24" O.C.
- B. Notch and lap joints 3" between sections; bayonet joints are unacceptable. Do not fasten joints between sections.
- C. Counterflashing shall be creased longitudinally just enough to provide a spring action that will hold bottom edge firmly against flashing.

3.07 WALL FLASHING: (FOR THROUGH-WALL FLASHINGS FOR MASONRY CAVITY WALLS.)

- A. Install flashings in accordance with Division 4.

3.08 MISCELLANEOUS FLASHINGS:

- A. Install appropriate flashings at all exhausts, vents and penetrations not specifically called out but required.
- B. Remount and secure all rooftop equipment. Use threaded fasteners.

3.09 CLEANING

- A. Clean exposed sheet metal of roofing materials, mortar, hand marks, other foreign materials.
- B. Remove temporary protective coverings and strippable films as copings and scuppers are installed. On completion of installation, clean finished surfaces, including removing unused fasteners, metal filings, pop rivet stems, and pieces of flashing. Maintain in a clean condition during construction.
- C. Replace items that have been damaged or that cannot be successfully repaired by finish touchup or similar minor repair procedures.

END OF SECTION 07 62 00

Page Intentionally Left Blank

SECTION 10 21 23

CUBICLE CURTAINS

PART 1 - GENERAL

1.01 RELATED DOCUMENTS

- A. Conditions of the Contract and portions of Division One of this Project Manual apply to this Section as though repeated herein.

1.02 WORK INCLUDED

- A. Cubicle tracking systems.
- B. Overhead curtain track and guides.
- C. Track accessories and attachments.
- D. Cubicle curtains.

1.03 RELATED WORK

- A. Metal Fabrications: Section 05 50 00.
- B. Gypsum Board: Section 09 29 00.

1.04 REFERENCES

- A. National Fire Protection Association (NFPA).

1.05 SUBMITTALS

- A. Submit in accord with the General Conditions of the Contract.
  - 1. Product Data: Manufacturer's printed product data for each type of cubicle tracking system specified.
  - 2. Detail Drawings: Mounting details with the appropriate fasteners for specific project substrates.
  - 3. Track Samples: Verification samples of cubicle track, 4" long, in full size, with carriers and end cap.
  - 4. Curtain Samples: Fabric samples showing manufacturer's full color range for selection by A/E.

1.06 DELIVERY, STORAGE AND HANDLING

- A. Deliver materials in unopened factory packaging to the jobsite.
- B. Store in original packaging in a climate controlled location away from direct sunlight.

1.07 PROJECT CONDITIONS

- A. Environmental Requirements: Products must be installed in an interior climate controlled environment.

1.08 WARRANTY

- 1  
2 A. Warranty: Manufacturer's standard, limited lifetime warranty against material and manufacturing  
3 defects.  
4

5 PART 2 - PRODUCTS  
6

7 2.01 MANUFACTURERS  
8

- 9 A. Acceptable Manufacturers: Basis of Design is Clickeze, InPro Corporation, Muskego, WI; (800)  
10 222-5556, www.inprocorp.com. Other manufacturers not limited to the following:  
11 1. Coldraco, Inc.  
12 2. Covoc Corporation.  
13 3. Or approved equal.  
14

- 15 B. Provide all cubicle tracking systems and curtains from a single source.  
16

17 2.02 TRACK MATERIALS  
18

- 19 A. Cubicle Tracking System, Bracket Support Mounted.  
20 1. Equal to Clickeze, "Ultra Cube", heavy duty extruded aluminum cubicle track with white  
21 baked acrylic enamel finish. Dimensions: height 1 1/8" (13mm), width 1 1/4" (16mm).  
22

23 2.03 TRACK COMPONENTS  
24

- 25 A. Track Attachment: Provide appropriate attachment accessories as required for gypsum board ceiling  
26 including Ultra Cube hard ceiling support brackets.  
27

- 28 B. Ultra/Whisper Pop-Out Curtain Carriers: Non-binding canted wheel carrier of self-lubricating  
29 Delrin, fitted to curtain with "pop-out hook" for safety.  
30 1. (2.2) carriers per lineal foot of track length.  
31

32 2.04 CURTAINS  
33

- 34 A. Fire Performance Characteristics: Provide curtains that are fire retardant or fire resistant.  
35

- 36 B. Privacy Curtain: Equal to Clickeze, InPro Corporation, "Shield Antimicrobial Fabric" collection.  
37 1. Fabric: Provide 100% polyester curtains. Fabric is to be opaque, washable, flame retardant  
38 and closely woven.  
39 2. Shield Fabric: Provide 100% polyester, impregnated and multi-coated with Aqueous based  
40 microporous polymers.  
41

- 42 C. Finish and Color, Privacy Curtain Fabric.  
43

- 44 1. Solid or patterned fabric from selected by A/E from manufacturer's standard selections.  
45

46 D. FABRICATION  
47

- 48 1. Curtain Width: Manufacture curtains of one piece, sized to 10 percent wider than the track  
49 length but no less than 1 foot extra fullness.  
50 2. Curtain Height: Refer to drawings.  
51 a. Bottom of privacy curtains hang 12" - 15" above floor.  
52 b. Verify existing conditions.  
53 3. Curtain Heading: Manufacture with heading of open mesh cloth, to the same width as the  
curtain fabric. Include 4-ounce nickel-plated grommets, 6" on center for carriers.  
4. Seams

1  
2  
- a. Privacy Curtain: Bottom hem shall be double-fold and 1 1/4" wide. Curtains shall be seamless if possible or lock stitch seams in two rows. Turn seam edges and lock stitch. Sewing thread to be triple-ply twisted nylon.

PART 3 - EXECUTION

3.01 EXAMINATION

- A. Examine areas and conditions in which the cubicle tracking systems will be installed.
  - 1. Complete all finishing operations, including painting, before beginning installation of cubicle tracking system materials.
  - 2. Verify that surfaces and above ceiling supports are ready to receive work.

3.02 PREPARATION

- A. General: Prior to installation, clean substrate to remove dust, debris and loose particles.

3.03 INSTALLATION

- A. General: Locate the cubicle track as indicated on the approved detail drawing for the appropriate substrate and in compliance with manufacturer's installation instructions.
- B. Installation of Cubicle Tracking Systems:
  - 1. Fasten cubicle track, secure and rigid, and true to ceiling line with mechanical fasteners.
  - 2. Slide carriers onto the track.
  - 3. Install end cap or stop device.
  - 4. Install curtains on carriers ensuring smooth operation.

3.04 CLEANING

- A. At completion of the installation, remove any debris and clean surfaces in accordance with manufacturer's instructions.

END OF SECTION 10 21 23



Page Intentionally Left Blank

SECTION 13 34 19

METAL BUILDING SYSTEMS

PART 1- GENERAL

1.01 RELATED DOCUMENTS

- A. Conditions of the Contract and portions of Division One of this Project Manual apply to this Section as though repeated herein.

1.02 SUMMARY

- A. Pre-engineered metal building including: engineering, supplying and installing of steel structural members, structural framing, girts, parapet support/framing, gutter support/framing, insulation, flashing, closure components and trim.

1.03 RELATED SECTIONS

- A. Section 03 30 00: Cast-in-Place Concrete
- B. Section 04 20 00: Unit Masonry
- C. Section 05 31 00: Steel Decking
- D. Section 05 40 00: Cold Formed Metal Framing
- E. Section 06 10 00: Rough Carpentry
- F. Section 07 42 13: Metal Wall Panels
- G. Section 07 53 23: Ethylene-Propylene-Diene-Monomer Roofing
- H. Section 08 11 13: Hollow Metal Doors and Frames
- I. Section 08 36 13: Sectional Overhead Doors
- J. Section 08 71 00: Door Hardware
- K. Section 23 33 00: Air Duct Accessories
- L. Division 26: Electrical and Photovoltaic

1.04 REFERENCES

- A. AISI – Specification for the Design of Cold-Formed Steel Structural Members – 1986 Edition with 1989 Addendum.
- B. AISC – Specification for Structural Steel Buildings – 1999.
- C. AISC – Code of Standard Practice for Steel Buildings and Bridges – 2000.
- D. ASTM A36-00 – Specification for Structural Steel.
- E. ASTM A-153-00 – Specification for Zinc Coated (Hot Dip) on Iron and Steel Hardware.

- 1 F. ASTM A307-00 – Specification for Carbon Steel Bolts and Studs, 60,000 psi Tensile.  
2  
3 G. ASTM A325-00 – Specification for High Strength Bolts for Structural Steel Joists.  
4  
5 H. ASTM A123-00 – Specification for Zinc (Hot-Dip Galvanized) Coatings on Iron and Steel  
6 Products.  
7  
8 I. ASTM A653-00 – Specification for Steel Sheet, Zinc-Coated (Galvanized) or Zinc-Iron Alloy  
9 Coated (Galvanealed) by the Hot-Dip Process.  
10  
11 J. ASTM A490-00 – Specification for Quenched and Tempered Alloy Steel Bolts for Structural Steel  
12 Joints.  
13  
14 K. ASTM A501-99 – Hot Formed Welded and Seamless Carbon Steel Structural Tubing.  
15  
16 L. ASTM A529-96 – Structural Steel with 50,000 psi Minimum Yield Point.  
17  
18 M. ASTM A1011-00 – Specification for Hot-Rolled Carbon Steel Sheet and Strip, Structural Quality.  
19  
20 N. ASTM 792-99 – Specification for Steel Sheet Aluminum Zinc Alloy Coated by the Hot-Dip  
21 Process, General Requirements.  
22  
23 O. ASTM C991-98 – Specification for Flexible Glass Fiber Insulation for Metal Buildings  
24  
25 P. ASTM E1514-98 – Specification for Structural Standing Seam Steel Roof Panel Systems.  
26  
27 Q. AWS A2.4-98 – Standard Welding Symbols.  
28  
29 R. AWS D1.1-2000 – Structural Welding Code – Steel.  
30  
31 S. AWS D1.3-98 – Structural Welding Code – Sheet Steel.  
32  
33 T. IBC (International Building Code) – 1604.3.1. Deflections – 2000 Edition.  
34  
35 U. MBMA Low Rise Building Systems Manual – 1996 Edition.  
36  
37 V. NAIMA 404-96 – Standard for Flexible Fiberglass Insulation Systems in Metal Buildings.  
38  
39 W. SJI – Standard Specifications, Load Tables and Weight Tables for Steel Joists and Joist Girders –  
40 1994.  
41

#### 42 1.05 SUBMITTALS

43

- 44 A. Contractor will submit the following documents for review: Engineer’s Letter of Certification,  
45 Permit Drawings, Column Reactions, Anchor Rod Plan, Building Erection Drawings.  
46  
47 B. Installation Instructions: Manufacturer will provide installation instructions that indicate  
48 preparation requirements and assembly sequence.  
49

#### 50 1.06 QUALITY ASSURANCE

51

- 52 A. Fabricate structural steel members in accordance with MBMA Low Rise Building Systems  
53 Manual, and, for items not covered, AISC – Specification for Structural Steel for Buildings.  
54

#### 55 1.07 QUALIFICATIONS

56

- 1 A. Manufacturer: The Manufacturer shall have a minimum of five (5) years experience in the  
2 manufacture of metal building systems.  
3  
4 B. Quality System: Manufacturer shall submit a Quality Policy document stating the Manufacturer's  
5 commitment to quality.  
6  
7 C. Licensed Engineer: Structural framing shall be designed by a Professional Engineer licensed in the  
8 state in which the Project is located.  
9  
10 D. Field Measurements: Metal building contractor shall verify that field measurements are as  
11 indicated on the drawings.  
12

#### 13 1.08 WARRANTY

- 14  
15 A. Workmanship: Manufacturer's Workmanship Warranty shall be for of 1 year.  
16  
17 B. Panel Warranty: Manufacturer's Panel Warranty shall be for 20 years.  
18  
19 C. All nomenclature shall conform to the MBMA Low Rise Building Systems Manual.  
20  
21 D. Coordination and administration of the work shall be in accordance with the MBMA Low Rise  
22 Building Systems Manual – Common Industry Practices.  
23

#### 24 PART 2-PRODUCTS

##### 25 2.01 MANUFACTURERS

- 26  
27 A. Basis of Design:  
28  
29 1. Butler Manufacturing Company, Landmark 2000, or equal by the following manufacturers  
30 a. Varco-Pruden Buildings.  
31 b. Foremost Buildings, Inc.  
32 c. American Buildings Company.  
33 d. Inland Buildings.  
34 e. Metallic Building. Co.  
35 f. Ceco Building Systems.  
36 g. Or approved equal.  
37  
38 2. Refer to drawings for details.  
39

##### 40 2.02 DESIGN REQUIREMENTS

- 41  
42 A. Members to withstand the following loads:  
43 1. Building system dead loads.  
44 2. Live Load: 20 psf, without tributary area load reduction  
45 3. Collateral Load: 5 psf  
46 4. Refer to Drawings for any additional actual or estimated loads  
47 5. Ground Snow Load: 35 psf , Snow Exposure C.  
48 6. Wind Velocity: 90 mph , Wind Exposure C.  
49 7. Seismic Acceleration: Ss: 11.1%g, S1=4.4%g, Site class to be verified by Geotechnical  
50 Engineer.  
51 8. MBMA Building Use Category: 2.  
52 9. All loads shall be proportioned and applied in accordance with the latest edition of the  
53 MBMA Low Rise Building Systems Manual.  
54

##### 55 a. MATERIALS

- 1 A. Sheet Steel Stock: Zinc-aluminum coated to AZ55 designation as required by manufacturer's  
2 design.  
3
- 4 B. Roof Insulation: ASTM C991-98 roll glass fiber type, faced with white vinyl, UL frame spread  
5 classification of 25 or less where exposed, 4 inches thick. Provide external wire support.  
6 1. Or system with equal R Value as recommended by manufacturer.  
7
- 8 C. Steel Decking as per drawings and Specification Section 05 31 00.  
9
- 10 D. Fully adhered EPDM Roof. See Specification Section 07 53 23.  
11
- 12 E. Fasteners:  
13 1. Through-fastened System: Panels shall be attached to the secondary framing members by  
14 means of a self-drilling structural carbon steel screw with a zinc-alloy head, finished to match  
15 roof panel, and assembled with an EPDM washer.  
16
- 17 F. Wall Systems  
18 1. Refer to Section 04 20 00 for masonry  
19 2. Refer to Section 05 40 00 for cold form metal framing (structural steel studs).  
20 3. Refer to Section 07 42 13 for metal wall panels Type MP-1.  
21 4. Wall Insulation: ASTM C991-98 roll glass fiber type, faced with white vinyl, UL frame  
22 spread classification of 25 or less where exposed, 4 inches thick. Provide external wire  
23 support.  
24 a. Or unless noted otherwise on drawings.  
25  
26 5. Closures and miscellaneous fasteners (clips): Manufacturer's standard type, unless noted  
27 otherwise on drawings.  
28 6. Fasteners: Wall panels shall be attached to the secondary framing members by means of a  
29 self-drilling fastener of carbon steel, hex washer head with EPDM bonded washers.  
30 7. Exterior Panel Finish: Refer to 07 42 13.  
31
- 32 G. Trim:  
33 1. Flashings, internal and external corners, closure pieces, and etc. shall be the same material  
34 and finish as adjacent material. Profiles shall be Manufacturer's standard. Custom colors to  
35 match Architects sample refer to 07 42 13.  
36 2. Continuous Closure: Provide weathertight, sheet metal closure where building abuts existing  
37 construction. Closure to match color and material of roof panels. Allow for thermal movement  
38 and differential settlement between building and existing construction.  
39
- 40 H. Metal Personnel Doors and Frames:  
41 1. Refer to Section 08 11 13 for hollow metal doors and frames.  
42 2. Door jambs shall be constructed for non-hand installation.  
43 3. Door frames shall be provided with head and jamb flashing and optional weather strip.  
44 4. See Section 08 71 00 for door hardware. Coordinate keying with User.  
45 5. Door threshold shall be aluminum, supplied with flat head screws and expansion shields for  
46 attachment to concrete floor.  
47
- 48 I. Sectional Overhead Doors  
49 1. Refer to Section 08 36 13: Sectional Overhead Doors  
50
- 51 b. FABRICATIONS - PRIMARY FRAMING  
52
- 53 A. Framing/enclosure dimensional criteria:  
54 1. A minimum of 14'-0" clear must be maintained from the finished floor to the bottom of the  
55 structural framing members in alignment with the overhead doors.

- 1           2. The ridge of the pre-engineered building component including all enclosure elements must  
2           not exceed 16'-6" AFF.  
3
- 4           B. Framing Members: Clean in accordance with SSPC-SP2, prepare, and coat with Manufacturer's  
5           standard primer.  
6
- 7           C. Hot rolled members shall be fabricated in accordance with AISC Specification for pipe, tube, and  
8           rolled structural shapes.  
9
- 10          D. Fabricate built-up members in accordance with MBMA Low Rise Building Systems Manual,  
11          Common Industry Practices.
- 12
- 13          c.        FABRICATION – WALL AND ROOF FRAMING  
14
- 15           A. Framing Members: Clean in accordance with SSPC-SP2, prepare, and coat with Manufacturer's  
16           standard primer.  
17
- 18           B. Cold Formed Members: Cold formed shapes shall be fabricated in accordance with MBMA Low  
19           Rise Building Systems Manual, Common Industry Practices.  
20
- 21          d.        FABRICATION – GUTTER  
22
- 23           A. Refer to drawings for location of full insulated inside parapet gutter  
24
- 25           B. Refer to Section 07 62 00 for gutter (gutter liner) fabrication.  
26
- 27           C. Gutter (gutter liner) profile as indicated on drawings.  
28
- 29           D. Metal Building System Manufacturer is responsible for gutter (gutter liner) support/framing.  
30
- 31          e.        FABRICATION – PARAPET  
32
- 33           A. Parapet profile and size as indicated on drawings.  
34
- 35           B. Metal Building System Manufacturer is responsible for parapet support/framing.  
36  
37
- 38          PART 3 – EXECUTION  
39
- 40          3.01       EXAMINATION:  
41
- 42           A. Verify that placed anchor rods are in correct position.  
43
- 44           B. Provide access to the work as scheduled for Owner provided inspections, if required. The cost of  
45           any required inspection is the responsibility of the Contractor.  
46
- 47          3.02       ERECTION – FRAMING  
48
- 49           A. Erect framing in accordance with MBMA Low Rise Building Systems Manual, Common Industry  
50           Practices.  
51
- 52           B. The Erector shall furnish temporary guys and bracing where needed for squaring, plumbing, and  
53           securing the structural framing against loads, such as wind loads acting on the exposed framing  
54           and seismic forces, as well as loads due to erection equipment and erection operation, but not  
55           including loads resulting from the performance of work by others. Bracing furnished by the

1           Manufacturer for the metal building system cannot be assumed to be adequate during erection.  
2           The temporary guys, braces, falseworks and cribbing are the property of the Erector, and the  
3           Erector shall remove them immediately upon completion of erection.  
4

5           C. Do not cut or alter structural members without approval of the Manufacturer.  
6

7           D. After erection, prime welds, abrasions, and surfaces not shop primed.  
8

9   3.03   ERECTION – WALL AND ROOFING SYSTEMS  
10

11          A. Install in accordance with Manufacturer’s instructions.  
12

13          B. Exercise care when cutting pre-finished material to ensure cuttings do not remain on finish  
14             surface.  
15

16          C. Fasten cladding to structural supports, aligned level and plumb.  
17

18   3.04   TOLERANCES  
19

20          A. All work shall be performed in a workmanlike manner.  
21

22          B. Install framing in accordance with MBMA Low Rise Building Systems Manual, Common  
23             Industry Practices.  
24

25  
26

END OF SECTION 13 34 19





## DDC INPUT / OUTPUT SUMMARY TABLE

PROJECT:	HARDWARE											SOFTWARE	
<b>Medical Examiner Office Bldg</b>	
LOCATION:	OUTPUT											INPUT											ALARMS		ENERGY MANAGEMENT SYSTEM FUNCTIONS																													
<b>Madison, WI</b>	DIGITAL			ANALOG								DIGITAL			ANALOG								DIGITAL		ANALOG																													
SYSTEM: Miscellaneous Points	Control Relay	Solenoid	Contact	2-Pos Actuator	Elect/Pneu Transducer	Electric Actuator	4-20 mA	0-10 VDC	Current Sensing Switch	Control Relay Contact	Switch Closure	Auxiliary Contact	Diff Pressure Switch	Flow Switch	Temperature	Relative Humidity	Differential Pressure	Gauge Pressure	Static Pressure	Flow	Equipment Status	Maintenance Pressure	High Limit	Low Limit	Day/Night Setback	Demand Limiting	Dial-up I/O	Duty Cycling	Optimum Start/Stop	Scheduled Start/Stop	Totalization	Trend	Equipment Integration	Lighting Integration	Fire Alarm Integration	Security/Access Integration	Elect PGM Integration	Chiller Integration	Manual Changeover	HW/OA Reset	CHW Reset	Smoke Control	Fire Alarm Override	<b>Comments</b>										
POINT DESCRIPTION	
<b>Body Cooler</b>	
Temperature						X	
Humidity						X	
Low Temp Alarm												X	
High Temp Alarm												X	
High Humidity Alarm												X	
General Alarm												X	
<b>Body Freezer</b>	
Temperature						X	
Humidity						X	
Low Temp Alarm												X	
High Temp Alarm												X	
High Humidity Alarm												X	
General Alarm												X	
<b>Fume Hoods</b>	
Fume Hood - Room 132	
Alarm												X	
Presence Sensor												X	
Fume Hood - Room 133	
Alarm												X	
Presence Sensor												X	
<b>Building DP Sensors</b>	
DP Sensor - Office to Lab Area																	X																																					
DP Sensor - Lab Area to Intake																	X																																					
DP Sensor - Lab Area to Garage																	X																																					



SECTION 23 09 93

SEQUENCE OF OPERATION FOR HVAC CONTROLS

PART 1 - GENERAL

SCOPE

This section includes control sequences for HVAC equipment as well as equipment furnished by others that may need monitoring or control. Included are the following topics:

PART 1 - GENERAL

- Scope
- Related Work
- Description of Work
- Submittals
- Operation and Maintenance Data
- Design Criteria

PART 2 - PRODUCTS

- Not Applicable

PART 3 - EXECUTION

- General Control
- Heat Exchanger (HX-1)
- Boiler Plant
- Pumps P-3 and P-4
- Heat Exchanger (HX-2)
- Pumps P-5 and P-6
- Snowmelt System
- Chilled Water Plant
- Pumps P-12 and P-13
- In-Floor Radiant Pump System (P-8)
- In-Floor Radiant Pump System (P-9)
- Rooftop Air Handling Unit (AHU-1)
- Rooftop Air Handling Unit (AHU-2)
- Rooftop Air Handling Unit (AHU-3)
- Air Handling Unit and Exhaust F and (AHU-4 and EF-4)
- Office Area – VAV Terminal Unit with Reheat and In-Floor Radiation
- Lab/Autopsy Area – VAV Terminal Unit with Reheat and In-Floor Radiation and Exhaust Valve
- Chiller Room Ventilation (EF-5 and UH-9)
- Exhaust Fan (EF-1)
- Exhaust Fan (EF-2)
- Exhaust Fan (EF-3)
- Exhaust Fan (EF-6)
- Exhaust Fan (EF-7)
- Cabinet Unit Heaters (CUH-1 and CUH-2)
- Unit Heaters (UH-1 thru 8, UH-10)
- Convectors (C-1 and C-2)
- Emergency Generator Operation / Staging

RELATED WORK

Conditions of the Contract and portions of Division One of this Project Manual apply to this Section as though repeated herein.

Applicable provisions of Division 1 govern work under this Section.

1 Section 01 91 01 – Commissioning Process  
2 Section 23 05 93 - Testing, Adjusting, and Balancing for HVAC – Coordination  
3 Section 23 09 23 - Direct Digital Controls (DDC)  
4 Division 23 - HVAC - Equipment provided to be controlled or monitored  
5  
6 Division 26 - Electrical - Equipment provided to be controlled or monitored  
7

#### 8 REFERENCE

9 Section 23 09 23 work includes furnishing and installing all field devices, including electronic sensors for  
10 the DDC of this section, equipment, and all related field wiring, interlocking control wiring between  
11 equipment, pneumatic tubing, sensor mounting, etc., that is covered in that section.  
12 Motorized control dampers and actuators, thermowells (temperature sensing wells), automatic control  
13 valves and their actuators are also covered in Section 23 09 23.  
14

#### 15 DESCRIPTION OF WORK

16 Control sequences are hereby defined as the manner and method by which automatic controls function.  
17 Requirements for each type of operation are specified in this section.  
18

19 Operation equipment, devices and system components required for automatic control systems are specified  
20 in other Division 23 control sections of these specifications.  
21

22 Sequences for equipment controlled by Direct Digital Controls (DDC) as specified are accomplished by  
23 hardware and software provided under Section 23 09 23.  
24

#### 25 SUBMITTALS

26 Refer to Division 1, General Conditions, Submittals, Section 23 05 00 and Sections 23 09 23 for  
27 descriptions of what should be included in the submittals.  
28

29 Shop drawings shall be provided by contractor(s) providing equipment under Sections 23 09 23. The  
30 contractor providing the DDC equipment shall provide a complete narrative of the sequence of operations  
31 for equipment that is controlled through the DDC system. The narrative of the sequence of operation shall  
32 not be a verbatim copy of the sequences contained herein, but shall reflect the actual operation as applied  
33 by the contractor.  
34

#### 35 DESIGN CRITERIA

36 Reference Section 23 09 23.  
37

## 38 P A R T 2 - P R O D U C T S

39  
40 Not applicable to this Section – reference Sections 23 09 23 for product descriptions.  
41

## 42 P A R T 3 - E X E C U T I O N

### 43 CONTROL SEQUENCES

#### 44 GENERAL:

#### 45 SETPOINTS:

46 All setpoints indicated in the control specification are to be adjustable. The setpoints shall be readily  
47 available to be modified in the mechanical system software system summary (either textual or graphic  
48 based) and under the same software level as hardware points. The setpoints indicated herein are only  
49 specified as a calculated starting point (or initial system operation). It is expected that setpoint adjustments  
50 and control loop tuning shall be required to provide optimum system operation based on requirements of  
51 the building. The control contractor shall work with the balancing contractor and the Owner to provide the  
52 final system setpoint adjustments and control loop tuning after the system is in operation and building is in  
53  
54  
55

1 use. Document all final setpoints on the as-built control drawings. Any questions regarding the intended  
2 operation of the HVAC equipment and control systems shall be referred to the HVAC design engineer  
3 through the appropriate construction communication process. The following setpoints should be used as  
4 initial setpoints unless otherwise specified in the individual control sequences or instructed by the Owner.  
5 If the contractor fails to check with the user Owner for final setpoints, they shall adjust setpoints at no  
6 additional cost.

- 7
- 8 ○ Occupied Space Terminal Unit Heating: 68° F
- 9 ○ Occupied Space Terminal Unit Cooling: 72° F
- 10 ○ Unoccupied Space Terminal Unit Heating: 62° F
- 11 ○ Unoccupied Space Terminal Unit Cooling: 82° F
- 12 ○ Entry Way Heating: 60° F
- 13 ○ Mechanical or Unoccupied Space Ventilation: 82° F
- 14 ○ Mechanical or Unoccupied Space Heating: 60° F
- 15

#### 16 ANTI-CYCLING:

17 When HVAC equipment or a sequence is specified to be started and stopped by a temperature, humidity,  
18 pressure setpoint or any other controlled variable, there shall be an adjustable differential setpoint that shall  
19 be set to prevent short cycling of the systems and equipment due to minor changes in the controlled  
20 variable. Temperature differential setpoints shall be set at 2° F and non-temperature setpoints shall be set at  
21 10% of the controlled range unless otherwise specified. Setpoints shall indicate at when the process should  
22 be turned on. Heating and cooling differentials shall be set for above setpoint and will be used to turn the  
23 process off. For example, an economizer sequence called to switch at 68° F, would turn on at 68° F and off  
24 at 70° F since it is a cooling function. A heating lockout setpoint of 50° F would turn on heating control at  
25 50° F and off at 52° F Non-temperature differentials shall be set above setpoint if the setpoint is indicating  
26 a minimum value or below setpoint if the setpoint is indicating a maximum value. Provide minimum  
27 runtime timers for loads that are cycled to prevent over-cycling. Timers shall be set as specified or as  
28 needed to prevent damage or excessive wear to the equipment. Unless otherwise specified in the individual  
29 control sequences, fans and pumps shall have a minimum runtime on timers of 15 minutes (adj.) and off  
30 timers of 5 minutes (adj.). Safeties shall override runtime timers.

#### 31 DEADBANDS:

32 Provide deadbands for all DDC control loops to prevent constant hunting of output signals to controlled  
33 devices. Deadbands shall be set to provide adequate control around setpoint as follows unless otherwise  
34 specified in the individual control sequences:

- 35
- 36 ○ Temperature Control:  $\pm 0.5^{\circ}$  F
- 37 ○ Humidity Control:  $\pm 1\%$  RH
- 38 ○ Airflow Control:  $\pm 2\%$  of total flow
- 39 ○ AHU Static Pressure Control:  $\pm 0.01$  in. w.c.
- 40

#### 41 ALARMS:

42 Provide all alarmed points with adjustable time delays to prevent nuisance tripping under normal operation  
43 and on equipment start-up. For all commanded outputs that have status feedback, provide an alarm that  
44 will indicate the commanded output is not in its commanded state. Provide alarms on all points as  
45 indicated on point charts. For existing campus automations systems, add/delete what is called on the point  
46 charts for after consultation with user Agency to provide consistent alarming throughout the automation  
47 system.

48

49 For devices that have form “C” contacts available for alarm monitoring, use closed contacts for the Normal  
50 condition and open contacts on Alarm condition. This will provide a level of supervision by detecting a  
51 break in the wiring.

#### 52 EQUIPMENT START/STOP FAILURE STATES:

53 All start/stop points for equipment shall utilize normally open contacts unless called out specifically in the  
54 individual control sequences.  
55

1 LEAD/LAG SEQUENCING:

2 For sequences that call for lead/lag of equipment connected to building automation systems, the lead device  
3 shall be able to be chosen through a selectable day of the week and time of day through the building  
4 automation system. Coordinate with the user Agency for scheduling switchover and frequency. Unless  
5 otherwise directed, switchover shall occur at 10AM Tuesday and shall rotate the lead device on a weekly  
6 cycle rotating through all devices sequentially. For standalone lead/lag sequence controllers (non-DDC),  
7 the lead device shall be selected by a switch on the panel face.

8  
9 VARIABLE FREQUENCY DRIVE (VFD) MOTOR RUN STATUS:

10 Use the VFD programmable relay dry contact output specified to be provided with the VFD under Section  
11 23 05 20 to prove motor run status and detect belt loss or coupling break. If a bypass contactor is provided  
12 with the VFD, provide an adjustable current switch and wire it in parallel with the VFD output for proving  
13 motor status.

14  
15 VFD BYPASS & SAFETY INTERLOCKS:

16 VFD's equipped with bypass starters shall be interlocked so that the start/stop and safety circuits that are  
17 called out for VFD operation shall be functional when the VFD is indexed to the bypass starter mode.  
18 Unless otherwise specified in the sequence below, the switch from inverter to bypass starter modes shall be  
19 through a manual switch provided on the VFD/bypass starter package.

20  
21 VFD MINIMUM SPEED & RAMP TIMERS:

22 The VFD start-up technician shall work with the DDC Temperature Control Contractor determine the  
23 minimum speed required for the motor controlled by the VFD to provide cooling of the motor as installed  
24 to prevent heat related problems. This minimum speed shall be set in the VFD controller. The VFD start-  
25 up technician shall work with the DDC Temperature Control Contractor to set the acceleration and  
26 deceleration timers in the VFD controller at 30 seconds for motors less than 40 HP and 60 seconds for  
27 motors 40 HP and greater.

28  
29 CURRENT SWITCH SETUP:

30 When current switches are used for proving fan or pump status, they shall be set up so that they will detect  
31 belt or coupling loss by the reduction in current draw on loss of coupled load. The current switch set up  
32 shall be redone by the 23 09 23 contractor after the balancer is complete.

33  
34 DAMPER INTERLOCKS FOR FANS WITH VFD'S:

35 For fan systems with VFD's and shutoff dampers specified with end switches, hardwire interlock the  
36 shutoff damper with the fan VFD. When the fan is remotely or locally commanded to start, VFD contacts  
37 shall energize damper actuator to open damper. The damper position end switch shall be wired to run  
38 permissive input on the VFD and enable the VFD to start when the damper position end switch provides  
39 the damper is open. This operation shall be provided for VFD and bypass operation if the VFD is provided  
40 with a bypass. The damper end switch shall also be monitored by the DDC system. For fan systems that  
41 are ducted in parallel, see specific sequence for fan system on additional interlock requirements.

42  
43 FAN INTERLOCKING:

44 Provide interlocks between supply and return or exhaust fan systems as scheduled on the plans or called out  
45 in individual control sequences. If DDC controlled, interlocks shall be done through DDC start/stop points  
46 unless otherwise specified in individual control sequences. If not DDC controlled, interlocks shall be  
47 accomplished via hardwire interlocks between fan starters or VFD's.

48  
49 THERMOSTATS AND SENSORS:

50 All devices and equipment including terminal units, specified to be controlled in a control sequence by a  
51 thermostat or sensor, shall be provided with a thermostat or sensor, whether or not the device is indicated  
52 on the plans. Consult the HVAC design engineer for the thermostat or sensor location.

1 ORIGINAL EQUIPMENT MANUFACTURER (OEM) CONTROLLER DDC INTEGRATION:

2 Provide DDC programming to define all equipment integral input/output points, setpoints, data points,  
3 calculations, etc. that are available through the manufacturers communication interface. Consult with the  
4 Agency DDC operations personnel to determine if some of the points should be omitted (for clarity or lack  
5 of value). The following equipment shall be integrated into the DDC system:

- 6 o Boilers
- 7 o Chillers
- 8 o Pumps with Integral Variable Frequency Drives.
- 9 o Variable Frequency Drives
- 10 o Laboratory Fume Hood Control
- 11 o Computer Room Air Conditioners
- 12 o BTU / Energy Meters

13  
14 WATCH DOG TIMER

15 Where the integrated system consists of programmable DDC controllers with BACnet objects mapped to an  
16 enterprise level Building Automation System (BAS) and it is shown that the BACnet objects do not  
17 indicate when they are offline on the enterprise level BAS when communication is lost between the two  
18 systems, software algorithms shall be provided to alarm when communication is lost. The integrated  
19 system shall program a binary data object that is toggled on and off at an adjustable rate (initially one  
20 minute) that shall be monitored by the enterprise level BAS which shall alarm if the toggling ceases.

21  
22 WEEKLY SCHEDULING

23 Provide scheduling of DDC terminal units in groups based on occupancy. Work with the user Agency to  
24 determine how many groups are required and which zones should be included. Individual terminal units  
25 shall be able to receive temporary schedules that will override the group schedules. Temporary override  
26 buttons at the zone sensor (where specified on point charts) shall override the scheduling to occupied.  
27 When groups that consist of more than 20% of terminal units are indexed to occupied, the associated air  
28 handling unit shall start if not already running.

29  
30 DDC CONTROLLER COMMUNICATION BUS CONFIGURATION

31 The actively controlled primary mechanical equipment (AHU's, hot water, chilled water, boilers, etc.)  
32 DDC controllers shall be configured to be located on the same supervisory controller BACnet MSTP  
33 communication trunk unless the supervisory controller capacity prevents it. If this is the case, the primary  
34 mechanical equipment DDC controllers shall be separated onto supervisory controllers in such a way that  
35 the systems that need to share information for operation and interlocking shall reside on the same  
36 supervisory controllers. When AHU systems have associated exhaust fan systems that are interlocked and  
37 designed to operate together as a combined air system within a building, these must be on the same BACnet  
38 MSTP trunk. Peer to peer communication shall be used for interlocks and data sharing between the AHU  
39 and exhaust fans systems when possible to limit air system disruptions in the event of a supervisory  
40 controller failure. Other critical building systems that require communication between DDC controllers to  
41 operate shall be on the same BACnet MSTP communication trunk. Terminal unit controllers shall be  
42 located on a separate BACnet MSTP trunks if necessary to allow for primary equipment to reside on the  
43 same BACnet MSTP trunk. If the DDC controllers used for control of primary mechanical equipment and  
44 interlocks or point information is required for proper operation as described above do not use BACnet  
45 MSTP communication but use Ethernet communication, the DDC controllers shall be connected to the  
46 same Ethernet switch. If the controllers cannot be connected to the same switch, hardwired points between  
47 controllers shall be used to share information.

48  
49 CONTROLLED VARIABLE REQUIREMENTS

50 All controlled variables, i.e. static pressure, differential pressure, temperature, humidity, etc., shall be wired  
51 directly to the DDC controller in which the software PID loop or other similar software loop resides unless  
52 the control sequence specifically allows the controlled variable to be routed over the network. Where a  
53 controlled variable is used for reset of a PID loop, the controlled variable shall be allowed to be shared over  
54 the network unless specified to be directly wired to the DDC controller.

1 CALCULATED DATA POINTS

2 Provide a calculated data point for outside airflow for all fans that have return and outside air mixing  
3 dampers and the points required to allow for the following equation:

4     o   Outside Airflow = Supply CFM x (MAT-RAT)/(OAT-RAT)

5  
6 Where Supply CFM is measured either on variable volume fans or as balanced on constant volume units,  
7 MAT is Mixed Air Temperature, RAT is Return Air Temperature, and OAT is Outside Air Temperature.  
8 This point is designed as a check for outside air flow stations accuracy and outside air ventilation minimum  
9 damper positions. It should be noted that the accuracy of the calculated outside airflow will diminish as  
10 outside air temperature approaches return air temperature. It should be used as a check only when the RAT  
11 and OAT are greater than 20 DegF and the accuracy of the RAT and OAT temperature sensors are assured.

12  
13 **HEAT EXCHANGER (HX-1):**

14 This is a “site” hot water to “building” hot water heat exchanger.

15  
16 This water to water heat exchanger system consists of:

- 17     • Plate and frame heat exchanger.
- 18     • Temperature sensors:
  - 19         o Site HWS (inlet of HX).
  - 20         o Site HWR (outlet of HX).
  - 21         o Building HWS (outlet of HX).
  - 22         o Building HWR (in main loop piping).
- 23     • Modulating 2-way temperature control valve (fail to heat exchanger) for “site” hot water (waste  
24 heat from site generator reclaim system).
- 25     • Two position 2-way temperature control valve (fail closed) for building hot water.
- 26     • Water flow and BTU management station on “site” side of heat exchanger.

27  
28 The 2-way control valve on the “site” side of the heat exchanger shall modulate to maintain a minimum  
29 180°F (Adj.) leaving (building) water temperature from the heat exchanger. The 2-way valve (site) shall  
30 have a minimum position of 10% open to maintain flow from the waste heat loop.

31  
32 On a rise in “building” return water temperature the control valve (site) shall modulate closed. When the  
33 building return water temperature drops below setpoint the valve shall modulate open.

34  
35 The control valve (site) shall fail to full flow through the heat exchanger.

36  
37 The “building” hot water supply setpoint shall be 180°F (adj.) at an outside air dry bulb reference  
38 temperature of 10° F (adj.) and shall be reset to 140°F (adj.) at an outside air dry bulb reference  
39 temperature of 60° F (adj.).

40  
41 The 2-way, 2-position control valve on the “building” hot water shall be closed whenever “Site” hot water  
42 is available (flow and temperature) and the “site” hot water is at least 5°F (adj.) above the “Building” return  
43 hot water temperature.

44  
45 If “site” hot water is not available, or if the “site” hot water temperature is less than 5°F (adj.) above the  
46 “building” return hot water temperature, the building valve shall be open to bypass HX-1.

47  
48 If the “building” hot water supply temperature exceeds 210° F (adj.) the building automation system shall  
49 send an alarm and the “site” 2-way control valve shall modulate closed.

50  
51 The building automation system shall trend site hot water usage thru the BTU management system.



1 **BOILER PLANT**

2 The boiler plant consists of:

- 3 • (2) Modular high efficiency modulating boilers (**B-1** and **B-2**)
- 4 • (2) constant volume in-line primary boiler pumps (**P-1** and **P-2**)
- 5 • 2-way, 2 position natural gas emergency shutdown valve (normally open).
- 6 • Natural gas emergency shutdown switch with pilot light.

7  
8 The hot water boiler plant is a back-up heating system to heat exchanger (HX-1). When HX-1 cannot  
9 maintain system setpoint temperature for any 15 minute period (adj.), or when the 2-way valve bypasses  
10 water thru HX-1 is open, the boiler plant shall be enabled.

11  
12 If the 2-way valve forcing water thru HX-1 closes, the boiler plant shall be disabled.

13  
14 Boiler (B-1 & B-2) shall be indexed and sequenced by the building automation system. The building  
15 automation system shall:

- 16 • Energize and stage the boiler plant operation.
  - 17 ○ On a call for boiler plant operation with HWS temperature below setpoint, the lead boiler
  - 18 shall energize and fire up to 80% capacity. Upon exceeding 80% capacity, the lag boiler
  - 19 shall also energize, the lead boiler shall reduce capacity and both boilers shall modulate
  - 20 in parallel. The opposite shall occur when the HWS temperature is above setpoint.
- 21 • Rotate boiler operation for maintenance and to equalize operating hours.
- 22 • Provide alarm signals through BAS on any boiler fault.

23  
24 The BAS shall provide the boiler plant, when enabled, with the desired hot water supply temperature as  
25 described under the control sequence for HX-1.

26  
27 The primary inline pump for each boiler shall be interlocked and controlled by the building automation  
28 system. When water flow is proved in the boiler, the boiler burner shall be enabled and shall fire as  
29 required. Provide a current sensor for each pump to provide pump operation.

30  
31 Upon a manual initiation of the emergency natural gas shutdown switch, the emergency natural gas  
32 shutdown valve shall close.

33  
34 This Contractor shall be responsible for installing and providing complete control wiring for the  
35 installation.

36  
37 **PUMPS P-3 AND P-4**

38 These pumps serve the building hot water heating loop.

39  
40 This system consists of:

- 41 • Base mounted variable volume pump P-3 with associated variable frequency drive (VFD-1).
- 42 • Base mounted variable volume Pump P-4 with associated variable frequency drive (VFD-2).
- 43 • System differential pressure sensor.
- 44 • Modulating 2-way by-pass valve.
- 45 • Temperature sensor
  - 46 ○ HWS to building (downstream of boiler plant).

47  
48 These pumps operate in a 100% standby (lead/lag) arrangement and shall be controlled by the DDC system.

49  
50 Start/Stop: The DDC system shall start the lead pump whenever the outside air temperature is below 60° F  
51 (adj) or on a call for system VAV reheat or infloor heating. The lag pump shall normally remain off. The  
52 hot water pump start/stop relays shall utilize normally closed contacts so upon failure of the relay or DDC  
53 controller the pump will fail on.

1 Lead / Lag Control: Current status switches, either integral to the VFD and/or discreet devices, shall prove  
2 lead and lag pump operation. If the lead pump is called to run and the current status switch indicates that  
3 the lead pump is not operating for 30 seconds (adj.), an alarm shall be sent to the operator interface and the  
4 BAS shall start the lag pump. Upon sensing the lead pump is operating, the lag pump shall be stopped.  
5 The DDC system shall index the lag pump to become the lead pump through weekly scheduling feature of  
6 the building automation system. The BAS shall also allow for manual lead/lag selection between the two  
7 pumps.

8  
9 Speed Control: Install a differential pressure sensor across the supply and return piping at the point in the  
10 system with the highest pressure drop as indicated on plans. The DDC system shall control the operating  
11 pump VFD to maintain a setpoint as described below.

12  
13 Constant Differential Pressure Setpoint Control: The operating pump VFD shall be modulated to maintain a  
14 constant setpoint of 10 psig (adj.) at the differential pressure sensor. Final setpoint shall be optimized by  
15 the Balancing Contractor.

16  
17 By-Pass Valve Control:

18 Provide modulating, 2-way bypass control valve at remote location in system for minimum pump flow  
19 maintenance. Control valve shall be set to maintain pressure at 5 ft (adj) above differential pressure  
20 setpoint. As pressure increases to 5 ft above differential pressure setpoint, valve shall modulate open. On a  
21 decrease in pressure, valve shall modulate closed.

#### 22 23 **HEAT EXCHANGER (HX-2):**

24 This is a “building hot water” to “building glycol water” heat exchanger.

25  
26 This water to water heat exchanger system consists of:

- 27 • Plate and frame heat exchanger.
- 28 • Temperature sensors:
  - 29 ○ Glycol HWS (outlet of HX).
  - 30 ○ Glycol HWR (inlet of HX).
  - 31 ○ Building HWR (outlet of HX).
- 32 • Modulating 2-way temperature control valve (fail to heat exchanger) for building hot water.

33  
34 The 2-way control valve on the “building hot water” side of the heat exchanger shall modulate to maintain  
35 a minimum 175°F (Adj.) leaving (building glycol) water temperature from the heat exchanger.

36  
37 On a rise in “building glycol) return water temperature the control valve (site) shall modulate closed.  
38 When the building return water temperature drops below setpoint the valve shall modulate open.

39  
40 The control valve (site) shall fail to full flow through the heat exchanger.

41  
42 The building glycol water supply setpoint shall be 175° F (adj.) at an outside air dry bulb reference  
43 temperature of 10° F (adj.) and shall be reset to 140° F (adj.) at an outside air dry bulb reference  
44 temperature of 60° F (adj.).

45  
46 If the “building glycol” water supply temperature exceeds 210° F (adj.) the building automation system  
47 shall send an alarm and the “building hot water” 2-way control valve shall modulate closed.

#### 48 49 **PUMPS P-5 AND P-6**

50 These pumps serve the building chilled water loop.

51  
52 This system consists of:

- 53 • Inline variable volume pump P-5 with associated variable frequency drive (VFD-3).
- 54 • Inline variable volume Pump P-6 with associated variable frequency drive (VFD-4).
- 55 • System differential pressure sensor.

1 These pumps operate in a 100% standby (lead/lag) arrangement.

2  
3 Start/Stop: The DDC system shall start the lead pump whenever the outside air temperature is below 60° F  
4 (adj). The lag pump shall normally remain off. The glycol water pump start/stop relays shall utilize  
5 normally closed contacts so upon failure of the relay or DDC controller the pump will fail on. Glycol water  
6 pumps shall be commanded off if all associated AHU's and unit heaters are off and the outside air  
7 temperature is above 60° F.

8  
9 Lead / Lag Control: Current status switches, either integral to the VFD and/or discreet devices, shall prove  
10 lead and lag pump operation. If the lead pump is called to run and the current status switch indicates that  
11 the lead pump is not operating for 30 seconds (adj.), an alarm shall be sent to the operator interface and the  
12 DDC system shall start the lag pump. Upon sensing the lead pump is operating, the lag pump shall be  
13 stopped. The DDC system shall index the lag pump to become the lead pump through weekly scheduling  
14 feature of the building automation system.

15  
16 Speed Control: Install a differential pressure sensor across the supply and return piping at the point in the  
17 system with the highest pressure drop as indicated on plans. The DDC system shall control the operating  
18 pump VFD to maintain a setpoint as described below.

19  
20 Constant Differential Pressure Setpoint Control: The operating pump VFD shall be modulated to maintain a  
21 constant setpoint of 10 psig (adj.) at the differential pressure sensor. Final setpoint shall be optimized by  
22 the Balancing Contractor.

### 23 SNOWMELT SYSTEM

24 This system provides snowmelt to areas of exterior pavement.

25  
26  
27 This system consists of:

- 28 • Inline constant volume pump P-7.
- 29 • 3-way modulating mixing valve
- 30 • (4) exterior slab mounted temperature/moisture sensors.
- 31 • Temperature Sensors:
  - 32 ○ Glycol HWS (to exterior slab)
  - 33 ○ Glycol HWR (from exterior slab)
- 34 • Pump pressure switch.

35  
36 On a call for slab heating from any of the (4) moisture sensors, the building automation system shall start  
37 associated pump P-7. The 3-way modulating temperature control valve shall modulate to maintain a  
38 constant snowmelt glycol water supply temperature of 130°F (adj.).

39  
40 During snowmelt operation, the system shall operate to maintain a slab temperature of 36°F (adj.), as  
41 averaged by the (4) sensors.

42  
43 The setpoint shall be 130° F (adj.) at an outside air dry bulb reference temperature of 0° F (adj.) and shall  
44 be reset to 105° F (adj.) at an outside air dry bulb reference temperature of 25° F (adj.).

45  
46 Provide a pressure differential switch to prove pump operation. Should the pump fail to start within 60  
47 seconds of being enabled by the building automation system, send an alarm.

48  
49 If the outside air temperature is -5°F (adj.) or below, the system shall not be permitted to operate.

50  
51 If the outside air temperature is above 40 deg F, the snowmelt system shall not be allowed to operate. If the  
52 slab temperature is above 50 deg F, and no precipitation is falling, the snowmelt system shall not be  
53 allowed to operate.

1 **CHILLED WATER PLANT**

2 This system provides cooling to the building and data room.

3  
4 The central chiller plant consists of:

- 5 • One indoor mounted air cooled screw chiller.
- 6 • One outdoor mounted refrigerant condensing unit.
- 7 • Two primary constant volume inline chilled water pumps (P-10 and P-11)
- 8 • Temperature sensors:
  - 9 ○ CWS (to building).
  - 10 ○ CWR (from building).

11  
12 The primary pumps operate in a 100% standby (lead/lag) arrangement.

13  
14 Chiller Point Integration: The chiller will be integrated into the DDC system through the communication  
15 method specified in the chiller specification. Provide DDC programming to define all chiller input and  
16 output information available through the chiller manufacturer's integration data port.

17  
18 Primary pump system lead/lag selections: One primary pump and one secondary chilled water pumps will  
19 be designated as lead and standby by the chiller unit mounted controls.

20  
21 Chiller Enable: When outside air temperature is greater than 50 °F (adj.), or on a call for cooling by AHU-  
22 1, AHU-2 or AHU-3, the chiller shall be enabled. The chiller unit mounted controls shall start the lead  
23 primary chilled water pump. The chiller unit mounted controls shall monitor its evaporator flow and safety  
24 statuses and shall provide a chiller failure alarm in the event of a flow or safety failure.

25  
26 The chiller unit mounted controls shall modulate chiller capacity to maintain chilled water supply setpoint  
27 temperature 42 °F (adj.)

28  
29 Condensing Unit Control: The chiller unit mounted controls shall control the associated refrigerant  
30 condensing unit.

31  
32 If the lead primary pump is called to run and the current status switch indicates that the lead pump is not  
33 operating for 30 seconds (adj.), an alarm shall be sent from the chiller unit mounted controls to the building  
34 automation system and the chiller unit mounted controls shall start the lag pump. Upon sensing the lead  
35 pump is operating, the lag pump shall be stopped.

36  
37 The chiller mounted controller shall index the lag pump to become the lead pump through weekly  
38 scheduling.

39  
40 **PUMPS P-12 AND P-13**

41 These are secondary chilled water pumps for building and data room cooling.

42  
43 The secondary pumps consist of:

- 44 • Base mounted pump P-12 with associated variable frequency drive (VFD-5).
- 45 • Base mounted Pump P-13 with associated variable frequency drive (VFD-6).
- 46 • System differential pressure sensor.

47  
48 These pumps operate in a 100% standby (lead/lag) arrangement.

49  
50 Secondary Chilled Water Pump Control: Start/Stop: The DDC system shall enable the secondary chilled  
51 water pump when a chiller status is on. The chilled water pump start/stop relays shall utilize normally open  
52 contacts so upon failure of the relay or DDC controller the pump will fail off.

1 Lead / Standby Control: Current status switches, either integral to the VFD and/or discreet devices, shall  
2 prove lead and standby pump operation. If the lead pump is called to run and the current status switch  
3 indicates that the lead pump is not operating for 30 seconds (adj.), an alarm shall be sent to the operator  
4 interface and the DDC system shall start the standby pump. The DDC system shall index the lead pump  
5 through weekly scheduling feature of the building automation system or manually as determined by the  
6 chiller plant operator.

7  
8 System Differential Pressure Control: The secondary chilled water pump shall be started first and shall be  
9 modulated to maintain a differential pressure setpoint at the lowest reading differential pressure sensor.  
10 Final setpoint shall be optimized by the Balancing Contractor. The DDC system shall maintain a  
11 differential pressure setpoint as described below.

12  
13 Constant Differential Pressure Setpoint Control: The operating pump VFD shall be modulated to maintain a  
14 constant setpoint of 10 psig (adj.) at the differential pressure sensor. Final setpoint shall be optimized by  
15 the Balancing Contractor.

16  
17 **IN-FLOOR RADIANT PUMP SYSTEM (P-8)**

18 This system provides radiant floor heating to areas served by AHU-2.

19  
20 This system consists of:

- 21 • Inline variable volume pump P-8 with integral speed control.
- 22 • 3-way modulating mixing valve
- 23 • Temperature Sensors:
  - 24 ○ HWS (to floor slab)
  - 25 ○ HWR (from floor slab)
- 26 • Pump pressure switch.

27  
28 The radiant pump shall be controlled by the BAS and shall operate on a call for heat by any radiant floor  
29 zone. The pump internal variable frequency drive shall modulate pump speed to maintain the system  
30 pressure required to satisfy system flow.

31  
32 The modulating 3-way mixing valve shall maintain 105°F (adjustable) supply water temperature setpoint to  
33 the radiant floor.

34  
35 **IN-FLOOR RADIANT PUMP SYSTEM (P-9)**

36 This system provides radiant floor heating to areas served by AHU-1.

37  
38 This system consists of:

- 39 • Inline variable volume pump P-8 with integral speed control.
- 40 • 3-way modulating mixing valve
- 41 • Temperature Sensors:
  - 42 ○ HWS (to floor slab)
  - 43 ○ HWR (from floor slab)
- 44 • Pump pressure switch.

45  
46 The radiant pump shall be controlled by the BAS and shall operate on a call for heat by any radiant floor  
47 zone. The pump internal variable frequency drive shall modulate pump speed to maintain the system  
48 pressure required to satisfy system flow.

49  
50 The modulating 3-way mixing valve shall maintain 105°F (adjustable) supply water temperature setpoint to  
51 the radiant floor.

1 **ROOFTOP AIR HANDLING UNIT (AHU-1):**

2 This is a rooftop mounted variable air volume air handling system controlled by the BAS.

3  
4 The system consists of:

- 5 • Supply fan with variable frequency drive (VFD-7).
- 6 • Return Fan with variable frequency drive (VFD-8).
- 7 • Motorized modulating outside air damper (fail closed) (damper furnished by 23 73 13, actuator by
- 8 23 09 14).
- 9 • Motorized modulating return air damper (fail open) (damper furnished by 23 73 13, actuator by 23
- 10 09 14).
- 11 • Motorized modulating relief air damper (fail closed) (damper furnished by 23 73 13, actuator by
- 12 23 09 14).
- 13 • Chilled water cooling coil with modulating 2-way temperature control valve (fail closed).
- 14 • Hot water heating coil with modulating 2-way temperature control valve (fail open).
- 15 • Heating coil freeze stat.
- 16 • Return air duct smoke detector.
- 17 • Sensors:
  - 18 ○ Supply duct discharge air temperature sensor.
  - 19 ○ Preheat coil discharge air temperature sensor.
  - 20 ○ Mixed air temperature sensor.
  - 21 ○ Return air temperature sensor.
  - 22 ○ Return air humidity sensor.
  - 23 ○ Supply duct static pressure sensor.
  - 24 ○ Supply duct high static limit sensor.
  - 25 ○ Supply duct low static limit sensor.
  - 26 ○ Return duct static pressure sensor.
  - 27 ○ Return duct high static limit sensor.

28  
29 **FAN CONTROL:**

30 Start/Stop: The DDC system shall start the supply and return fan via the VFD.

31  
32 Current Status Switch: Provide as described under GENERAL, VFD Motor Run Status, in this Section for

33 both the supply and return fans.

34  
35 Supply Fan Speed Control: The purpose of the supply fan control is to maintain a minimum static pressure

36 in the supply ductwork to insure proper terminal air box operation. Install a static pressure sensing probe in

37 the main supply duct located at approximately 3/4" of the way down the main supply duct as shown on the

38 plans and pipe to the differential pressure transmitter that shall be located in the unit temperature control

39 panel. The inputs to the differential pressure transmitter shall be the static pressure inside of the duct and

40 the reference input shall sense the actual space served by the air system located in the ceiling below the

41 duct probe. The DDC system shall modulate the supply fan VFD to maintain the static pressure setpoint as

42 sensed by the static pressure sensor. If multiple supply fans are used, the same speed signal will be sent to

43 all operating fans unless the fan is in start or stop mode as described above. If multiple sensing locations

44 are shown, the DDC system shall maintain the static pressure setpoint at the lowest reading sensor. If the

45 static sensors deviate by more than 0.5 in. w.c. (adj.), an alarm shall be sent through the DDC system.

46 Static pressure setpoint shall be as described in the Static Pressure Reset Control below.

47  
48 Static Pressure Reset Control: Static pressure setpoint shall be reset using Trim & Respond logic within the

49 range 0.15 in. w.c. to 1.3 in. w.c. When the fan is off, the setpoint shall be reset to 0.8 in. w.c. (adj.) and

50 this setpoint shall be used on system start up While the fan is proven on, every two minutes, trim the

51 setpoint by 0.04 in. w.c. if there are two or fewer zone pressure requests. If there are more than two zone

52 pressure requests, respond by increasing the setpoint by 0.06 in. w.c.

53 A zone pressure request is generated when a VAV damper is greater than 95% open until it drops to 80%

54 open. Provide a binary data enable point for each zone to enable/disable the zone damper in the trim and

1 respond algorithm. All setpoints, timers, and zone pressure request threshold for the static pressure reset  
2 shall be adjustable. Tune the reset to prevent cyclic instability after the space is occupied. Provide a trend  
3 graph to show the relative stability of the static pressure setpoint. Final maximum setpoint shall be  
4 determined by the Balancing Contractor to satisfy the worst case zone at maximum design condition.  
5

6 When more than 10% of the air terminals are indexed to occupied and the static pressure setpoint is below  
7 the fan start static setpoint, reset the static pressure to the fan start setpoint and release to trim and respond  
8 control. This is to prevent slow system recovery on scheduled start-up.  
9

10 Return Fan Speed Control: The purpose of the return fan control is to maintain a slightly positive building  
11 pressure. The return fan VFD shall modulate to maintain a constant CFM offset 960 CFM (adj.) from the  
12 supply fan to account for total exhaust from the area in which it serves while maintaining a positive  
13 pressure in relation to AHU-2. The sum of all the air terminal VAV boxes shall be used as the supply CFM  
14 total.  
15

16 Minimum Ventilation Air Flow Control:  
17 Fixed Ventilation Air Flow Setpoint: The AHU outside air ventilation rate shall be maintained at 960  
18 CFM. (The Office Area is to be positive to the Lab Area by 400 CFM)  
19

20 Minimum Ventilation Air Flow Control Using Volume Matching: The minimum outside air damper  
21 position will be reset between a high minimum position and a low minimum position reset from the full  
22 design turndown fan speed and maximum fan speed. The Temperature Control Contractor shall work with  
23 the Balancing Contractor to determine these damper position setpoints to provide an even mixed air static  
24 pressure over the full range of fan turndown.  
25

26 Install a temperature sensor in the supply duct downstream of the supply fan, all water coils and  
27 humidifiers.  
28

29 Discharge Air Temperature Setpoint: Discharge air temperature setpoint shall be 55° F (adj.).  
30

31 Discharge Air Temperature Control: The heating coil and cooling coil shall be controlled to maintain the  
32 discharge air setpoint temperature. At no time shall the heating coil be operating when the chilled water  
33 coil valve is open.  
34

35 Preheat Coil Discharge Air Temperature Control – Normal Operation: The heating control valve (FO) shall  
36 modulate to maintain 55°F (adj.) at probe type sensor located in the supply duct downstream of the AHU.  
37 The preheat coil control valve shall be locked in the closed position whenever outside air temperature is  
38 above 55°F (adj.) for 10 consecutive minutes (adj.)  
39

40 Preheat Coil Discharge Air Temperature Control – AHU- Not Running Operation: The Preheat coil  
41 discharge air temperature control sensor located immediately downstream of preheat coil shall modulate  
42 preheat coil control valve to maintain 52°F (adj.) preheat coil discharge air temperature anytime AHU is  
43 not running and safety low temperature limit control (freezestat) is not in alarm.  
44

45 Cooling Coil Discharge Air Temperature Control: Cooling coil control valve (FC) shall modulate to  
46 maintain unit discharge air temperature of 55°F (adj.) via probe type sensor located in the supply duct  
47 downstream of the unit discharge. In the cooling mode when the outside air temperature is above 50°F  
48 (adj.) as unit discharge air temperature increases, cooling coil control valve shall modulate open to maintain  
49 unit discharge air temperature setpoint. The reverse shall occur as unit discharge air temperature decreases.  
50 Cooling coil control valve shall be locked in the closed position whenever outside air temperature is below  
51 50°F (adj.) for 10 consecutive minutes (adj.) or whenever associated supply fan is not operating.  
52

53 Dehumidification Control: Override the cooling coil valve position open to maintain a return air humidity  
54 of 60% RH (adj.). Lockout this control when outside air is below 55° F.  
55

1 Economizer Control: Provide dry bulb economizer control. Whenever outside air dry bulb temperature  
2 exceeds the return air temperature plus 4°F (adj.), economizer control shall override mixed air control and  
3 modulate AHU-1 outside economizer damper closed.  
4

5 Economizer control shall be released to mixed air control when outside air dry bulb temperature is less than  
6 return air temperature minus 5°F (adj.) for 10 consecutive minutes (adj.)  
7

8 Mixed Air Temperature Control: The unit includes a single modulating outside air damper, modulating  
9 return air damper, and modulating outside air damper. The modulating outside economizer air damper  
10 shall be enabled as determined by the economizer mode sequence stated above. The economizer outside air  
11 damper and the return air damper shall be controlled by the mixed air temperature controller with averaging  
12 type sensor located at the upstream side of the pre-filter to maintain mixed air temperature of 52°F (adj.).  
13 As the mixed air temperature decreases, the outside air damper shall close and the return air damper shall  
14 open to maintain the mixed temperature setpoint. The reverse shall occur as mixed air temperature  
15 increases. The return air damper position may not be proportionally opposite of the outside air damper.  
16 Final test and balancing will need to determine the position of the return air damper in order to keep the  
17 relief air static pressure positive in all scenarios (min/max CFM).  
18

19 Relief Air Damper Control: A static pressure control with its pressure transmitter located in the return duct  
20 at least three feet from the fan discharge and upstream of the control damper, shall modulate the relief air  
21 damper (FC) to maintain initial relief static pressure setpoint of 0.6" WC (adj.). On a drop in return static  
22 pressure below setpoint, as measured by the return system static pressure transmitter, relief damper shall  
23 modulate closed until return static pressure setpoint has been satisfied. On rise in return static pressure  
24 above return system static pressure setpoint, relief damper shall modulate open until return static pressure  
25 setpoint is satisfied. Control contractor shall work in association with test and balance contractor to  
26 determine actual required static pressure setpoint. Setpoint indicated is to be used for initial system startup.  
27 Actual static pressure shall be minimum static pressure required to achieve system design flow.  
28

29 General Safeties Note: All safeties shall be hard wired to the supply and return fan starters or VFD safety  
30 circuits. Starters shall not function in the "Hand" or "Auto" and VFD's shall be disabled if they are  
31 indexed to the "Auto" or "Hand" position in either the VFD or bypass modes.  
32

33 Freezestat: Install an electric freezestat to shut down the unit (see Unit Shutdown for additional  
34 information) if the temperature downstream of the heating coil drops below 35° F (adj.). The electric  
35 freezestat shall act independently of the DDC system via hardwire interlock and shall override the DDC  
36 system control signal to open the heating coil control valve(s) to maintain an 80°F (adj.) preheat coil  
37 discharge air temperature setpoint. The cooling coil control valve shall fully open upon a trip of the  
38 freezestat. A freezestat trip shall notify the DDC system that shall send an alarm to the operator interface.  
39

40 Supply Fan High Pressure Limit: Install a static pressure probe located in the air handling unit main  
41 discharge duct at least six feet or as far as physically possible downstream of the fan and upstream of any  
42 dampers and pipe to a differential pressure switch located in the temperature control panel. Wire in series  
43 with the safety circuit of the supply and return fan. Differential pressure switch shall be a manual reset  
44 type and the DDC system shall monitor the status of the differential pressure switch. Initial setpoint shall  
45 be +4.0" w.c. (adj.)  
46

47 Return Fan High Pressure Limit: Install a static pressure probe located in the discharge duct at least six feet  
48 or as far as physically possible downstream of the fan and upstream of any dampers and pipe to a  
49 differential pressure switch located in the temperature control panel. Wire in series with the safety circuit of  
50 the supply and return fan. Differential pressure switch shall be a manual reset type and the DDC system  
51 shall monitor the status of the differential pressure switch. Initial setpoint shall be +2.0" w.c.  
52

53 Supply Fan Low Pressure Limit: Install a low static suction pressure safety switch between the inlet of the  
54 supply fan and the cooling coil and wire in series with VFD safety circuit to stop the supply fan. The  
55 pressure switch shall be adjusted to -2.0" WC (adj.). The status of the pressure switch shall be wired to the



1 BAS system for alarming. The pressure switch must be manually reset locally before the air handling unit  
2 can be restarted. Low static pressure safety switch shall be functional in VFD mode of operation.  
3

4 Return Fire Alarm Shutdown: Upon a Fire Alarm System alarm, the fire alarm control module provided by  
5 the electrical contractor at the temperature control panel shall change state of its contacts. This shall cause  
6 the unit to be shut down (see Unit Shutdown for additional information). An auxiliary contact shall be  
7 provided to notify the DDC system of a fire alarm shutdown.  
8

9 Unit Shutdown: Whenever the air handling unit is indexed off, the supply and return fans shall stop,  
10 outside air damper shall close, return damper shall fully open, relief damper shall close, chilled water valve  
11 shall close, heating coil valve shall remain under control to maintain a 52°F (adj.) temperature at the  
12 preheat discharge air sensor.  
13

14 If an AHU supply fan failure occurs, as detected by a current switch, or VFD fault indication from VFD  
15 output, the fan shall be stopped and an alarm shall be annunciated at the BAS. This alarm interlock shall be  
16 disabled for 60 seconds (adj.) after the fan is initially commanded to start. Upon failure the following shall  
17 occur:

- 18 • The outside air dampers and relief air dampers shall fully close.
- 19 • The return air damper shall fully open.
- 20 • The return fan shall be commanded to stop.
- 21 • The chilled water control valve shall close
- 22 • The heating coil control valve shall remain under control from the preheat discharge air  
23 temperature sensor to maintain 52°F (adj.)  
24

25 When failed AHU fan is reset through BAS, AHU shall restart as indicated above.  
26

27 If return fan failure occurs, as detected by a current switch, or VFD fault indication from VFD output, the  
28 AHU shall be stopped and an alarm shall be annunciated at the BAS. This alarm interlock shall be disabled  
29 for 60 seconds (adj.) after the fan is initially commanded to start. Upon failure the following shall occur:

- 30 • The outside air dampers and relief air dampers shall fully close.
- 31 • The return air damper shall fully open.
- 32 • The supply fan shall be commanded to stop.
- 33 • The chilled water control valve shall close
- 34 • The heating coil control valve shall remain under control from the preheat discharge air  
35 temperature sensor to maintain 52°F (adj.)  
36

37 When failed AHU fan is reset through BAS, AHU shall restart as indicated above.  
38

39 Unoccupied Control General Note: Occupied/unoccupied schedule shall be set at the DDC operator  
40 interface. When indexed to unoccupied the unit shall shutdown. Where provided, index DDC controlled  
41 heating and cooling terminal units associated with this air handling unit to maintain setback and setup  
42 temperature setpoints unless overridden by occupancy sensor or manual pushbutton.  
43

44 Unoccupied Control - Unit Cycling to Maintain Setback/Setup Temperatures: Cycle the air handling unit  
45 on to maintain the setback and setup temperature zone setpoints to maintain 58 °F (adj.) and 86 °F (adj.)  
46 respectively.  
47

48 Reset supply return fan volume offset for return air fan control to zero. Supply fan shall be limited to the  
49 maximum return fan airflow. In the heating mode, the outside air and relief air dampers shall fully close  
50 and the return air damper shall fully open and heating discharge temperature control shall function as  
51 specified. In the cooling mode, the economizer and chilled water discharge temperature control shall be  
52 allowed to function as specified. Minimum on runtime timer shall be set for 15 minutes (adj.) and the off  
53 timer for 30 minutes (adj.).  
54

1 Monitor and Alarm: Monitor, through BAS, the following points associated with the air handling system  
2 and generate the alarms indicated:

- 3 • Unit discharge air temperature: Generate alarm if temperature exceeds setpoint by +/- 3°F (adj.)  
4 for 10 consecutive minutes (adj.)
- 5 • Preheat coil discharge air temperature: Generate alarm if temperature deviates from setpoint by -  
6 3.0°F (adj.) for 10 consecutive minutes (adj.)
- 7 • Mixed air temperature: Generate alarm if temperature goes below setpoint by 5°F (adj.) for 10  
8 consecutive minutes (adj.)
- 9 • High Return airflow: Generate alarm if airflow exceeds setpoint by +/- 500 CFM (adj.) for 10  
10 consecutive minutes (adj.)
- 11 • Low Limit thermostat (freezestat): Generate alarm and stop AHU
- 12 • Supply fan current switch: Generate alarm if fan status proven by current switch does not match  
13 commanded state.
- 14 • Return fan current switch: Generate alarm if fan status proven by current switch does not match  
15 commanded state.
- 16 • Supply duct static pressure: Generate alarm if pressure exceeds setpoint by +/- 0.5" WC (adj.) for  
17 5 consecutive minutes (adj.)
- 18 • Relief duct static pressure: Generate alarm if pressure goes below 0.0" WC (adj.) for 5 consecutive  
19 minutes (adj.)
- 20 • Supply discharge static pressure safety switch: Generate alarm and stop AHU if pressure exceeds  
21 4.0" WC (adj.)
- 22 • Return discharge static pressure safety switch: Generate alarm and stop AHU if pressure exceeds  
23 2.0" WC (adj.)
- 24 • Return suction static pressure safety switch: Generate alarm and stop AHU if pressure exceeds -  
25 2.0" WC (adj.)
- 26 • Return air smoke detector: Generate alarm and stop AHU.

### 27 **ROOFTOP AIR HANDLING UNIT (AHU-2)**

28 This is a 100% outside air variable air volume air handling system controlled by the BAS.

29 The system consists of:

- 30 • Supply fan with variable frequency drive (VFD-9)
  - 31 ○ Motorized outside air damper (fail closed) (damper by 23 73 13, actuator by 23 09 14).
  - 32 ○ Chilled water cooling coil with modulating 2-way temperature control valve (fail closed).
  - 33 ○ Hot water heating coil with modulating 2-way temperature control valve (fail open).
  - 34 ○ Heating coil freezestat.
  - 35 ○ Supply air smoke detector.
  - 36 ○ Sensors:
    - 37 ○ Supply duct discharge air temperature sensor.
    - 38 ○ Preheat coil discharge air temperature sensor.
    - 39 ○ Supply duct static pressure sensor.
    - 40 ○ Supply duct high static limit sensor.
    - 41 ○ Supply duct low static limit sensor.

### 42 FAN CONTROL:

43 Start/Stop: The DDC system shall start the supply and return fan via the VFD.

44 Current Status Switch: Provide as described under GENERAL, VFD Motor Run Status, in this Section for  
45 both the supply and return fans.

1 Supply Fan Speed Control: The purpose of the supply fan control is to maintain a minimum static pressure  
2 in the supply ductwork to insure proper terminal air box operation. Install a static pressure sensing probe in  
3 the main supply duct located at approximately 3/4" of the way down the main supply duct as shown on the  
4 plans and pipe to the differential pressure transmitter that shall be located in the unit temperature control  
5 panel. The inputs to the differential pressure transmitter shall be the static pressure inside of the duct and  
6 the reference input shall sense the actual space served by the air system located in the ceiling below the  
7 duct probe. The DDC system shall modulate the supply fan VFD to maintain the static pressure setpoint as  
8 sensed by the static pressure sensor. If multiple supply fans are used, the same speed signal will be sent to  
9 all operating fans unless the fan is in start or stop mode as described above. If multiple sensing locations  
10 are shown, the DDC system shall maintain the static pressure setpoint at the lowest reading sensor. If the  
11 static sensors deviate by more than 0.5 in. w.c. (adj.), an alarm shall be sent through the DDC system.  
12 Static pressure setpoint shall be as described in the Static Pressure Reset Control below.  
13

14 Static Pressure Reset Control: Static pressure setpoint shall be reset using Trim & Respond logic within the  
15 range 0.15 in. w.c. to 1.3 in. w.c. When the fan is off, the setpoint shall be reset to 0.8 in. w.c. (adj.) and  
16 this setpoint shall be used on system start up While the fan is proven on, every two minutes, trim the  
17 setpoint by 0.04 in. w.c. if there are two or fewer zone pressure requests. If there are more than two zone  
18 pressure requests, respond by increasing the setpoint by 0.06 in. w.c.  
19

20 A zone pressure request is generated when a VAV damper is greater than 95% open until it drops to 80%  
21 open. Provide a binary data enable point for each zone to enable/disable the zone damper in the trim and  
22 respond algorithm. All setpoints, timers, and zone pressure request threshold for the static pressure reset  
23 shall be adjustable. Tune the reset to prevent cyclic instability after the space is occupied. Provide a trend  
24 graph to show the relative stability of the static pressure setpoint. Final maximum setpoint shall be  
25 determined by the Balancing Contractor to satisfy the worst case zone at maximum design condition.  
26

27 When more than 10% of the air terminals are indexed to occupied and the static pressure setpoint is below  
28 the fan start static setpoint, reset the static pressure to the fan start setpoint and release to trim and respond  
29 control. This is to prevent slow system recovery on scheduled start-up.  
30

31 Ventilation Air Control: The unit is 100% outside air. Outside air damper to open prior to fan starting.  
32

33 Install a temperature sensor in the supply duct downstream of the supply fan and all water coils.  
34

35 Discharge Air Temperature Setpoint: Discharge air temperature setpoint shall be 48° F (adj.).  
36

37 Discharge Air Temperature Control: The heating coil and cooling coil shall be controlled to maintain the  
38 discharge air setpoint temperature. At no time shall the heating coil be operating when the chilled water  
39 coil valve is open.  
40

41 Preheat Coil Discharge Air Temperature Control – Normal Operation: The heating control valve (FO) shall  
42 modulate to maintain 55°F (adj.) at probe type sensor located in the supply duct downstream of the AHU.  
43 The preheat coil control valve shall be locked in the closed position whenever outside air temperature is  
44 above 55°F (adj.) for 10 consecutive minutes (adj.).  
45

46 Preheat Coil Discharge Air Temperature Control – AHU- Not Running Operation: The Preheat coil  
47 discharge air temperature control sensor located immediately downstream of preheat coil shall modulate  
48 preheat coil control valve to maintain 52°F (adj.) preheat coil discharge air temperature anytime AHU is  
49 not running and safety low temperature limit control (freezestat) is not in alarm.  
50

1 Cooling Coil Discharge Air Temperature Control: Cooling coil control valve (FC) shall modulate to  
2 maintain unit discharge air temperature of 48°F (adj.) via probe type sensor located in the supply duct  
3 downstream of the unit discharge. In the cooling mode when the outside air temperature is above 50°F  
4 (adj.) as unit discharge air temperature increases, cooling coil control valve shall modulate open to maintain  
5 unit discharge air temperature setpoint. The reverse shall occur as unit discharge air temperature decreases.  
6 Cooling coil control valve shall be locked in the closed position whenever outside air temperature is below  
7 50°F (adj.) for 10 consecutive minutes (adj.) or whenever associated supply fan is not operating.

8  
9 Dehumidification Control: Override the cooling coil valve position open to maintain a return air humidity  
10 of 50% RH (adj.). Lockout this control when outside air is below 40° F (adj.).

11  
12 General Safeties Note: All safeties shall be hard wired to the supply VFD safety circuit. Starters shall not  
13 function in the “Hand” or “Auto” and VFD’s shall be disabled if they are indexed to the “Auto” or “Hand”  
14 position in either the VFD or bypass modes.

15  
16 Freezestat: Install an electric freezestat to shut down the unit (see Unit Shutdown for additional  
17 information) if the temperature downstream of the heating coil drops below 35° F (adj.). The electric  
18 freezestat shall act independently of the DDC system via hardwire interlock and shall override the DDC  
19 system control signal to open the heating coil control valve(s) to maintain an 80°F (adj.) preheat coil  
20 discharge air temperature setpoint. The cooling coil control valve shall fully open upon a trip of the  
21 freezestat. A freezestat trip shall notify the DDC system that shall send an alarm to the operator interface.

22  
23 Supply Fan High Pressure Limit: Install a static pressure probe located in the air handling unit main  
24 discharge duct at least six feet or as far as physically possible downstream of the fan and upstream of any  
25 dampers and pipe to a differential pressure switch located in the temperature control panel. Wire in series  
26 with the safety circuit of the supply and return fan. Differential pressure switch shall be a manual reset  
27 type and the DDC system shall monitor the status of the differential pressure switch. Initial setpoint shall  
28 be +4.0" w.c. (adj.)

29  
30 Supply Fan Low Pressure Limit: Install a low static suction pressure safety switch between the inlet of the  
31 supply fan and the cooling coil and wire in series with VFD safety circuit to stop the supply fan. The  
32 pressure switch shall be adjusted to -2.0" WC (adj.). The status of the pressure switch shall be wired to the  
33 BAS system for alarming. The pressure switch must be manually reset locally before the air handling unit  
34 can be restarted. Low static pressure safety switch shall be functional in VFD mode of operation.

35  
36 Supply Fire Alarm Shutdown: Upon a Fire Alarm System alarm, the fire alarm control module provided by  
37 the electrical contractor at the temperature control panel shall change state of its contacts. This shall cause  
38 the unit to be shut down (see Unit Shutdown for additional information). An auxiliary contact shall be  
39 provided to notify the DDC system of a fire alarm shutdown.

40  
41 Unit Shutdown: Whenever the air handling unit is indexed off, the supply fan shall stop, outside air  
42 damper shall close, chilled water valve shall close, heating coil valve shall remain under control to maintain  
43 a 52°F (adj.) temperature at the preheat discharge air sensor.

44  
45 If an AHU supply fan failure occurs, as detected by a current switch, or VFD fault indication from VFD  
46 output, the fan shall be stopped and an alarm shall be annunciated at the BAS. This alarm interlock shall be  
47 disabled for 60 seconds (adj.) after the fan is initially commanded to start. Upon failure the following shall  
48 occur:

- 49 • The outside air damper shall fully close.
- 50 • The chilled water control valve shall close
- 51 • The heating coil control valve shall remain under control from the preheat discharge air  
52 temperature sensor to maintain 52°F (adj.)

53  
54 When failed AHU fan is reset through BAS, AHU shall restart as indicated above.

1 When failed AHU fan is reset through BAS, AHU shall restart as indicated above.  
2

3 Unoccupied Control General Note: Occupied/unoccupied schedule shall be set at the DDC operator  
4 interface. When indexed to unoccupied the unit shall shutdown. Where provided, index DDC controlled  
5 heating and cooling terminal units associated with this air handling unit to maintain setback and setup  
6 temperature setpoints unless overridden by occupancy sensor or manual pushbutton.  
7

8 Unoccupied Control - Unit Cycling to Maintain Setback/Setup Temperatures: Cycle the air handling unit  
9 on to maintain the setback and setup temperature zone setpoints to maintain 58 °F (adj.) and 86 °F (adj.)  
10 respectively. Reset supply fan volume to 2770 CFM. In the heating mode, the outside air damper shall  
11 open and heating discharge temperature control shall function as specified. In the cooling mode, the  
12 outside air damper shall open and chilled water discharge temperature control shall be allowed to function  
13 as specified. Minimum on runtime timer shall be set for 15 minutes (adj.) and the off timer for 30 minutes  
14 (adj.).  
15

16 Monitor and Alarm: Monitor, through BAS, the following points associated with the air handling system  
17 and generate the alarms indicated:

- 18 • Unit discharge air temperature: Generate alarm if temperature exceeds setpoint by +/- 3°F (adj.)  
19 for 10 consecutive minutes (adj.)
- 20 • Preheat coil discharge air temperature: Generate alarm if temperature deviates from setpoint by -  
21 3.0°F (adj.) for 10 consecutive minutes (adj.)
- 22 • Low Limit thermostat (freezestat): Generate alarm and stop AHU
- 23 • Supply fan current switch: Generate alarm if fan status proven by current switch does not match  
24 commanded state.
- 25 • Supply duct static pressure: Generate alarm if pressure exceeds setpoint by +/- 0.5" WC (adj.) for  
26 5 consecutive minutes (adj.)
- 27 • Supply discharge static pressure safety switch: Generate alarm and stop AHU if pressure exceeds  
28 4.0" WC (adj.)
- 29 • Supply air smoke detector: Generate alarm and stop AHU.  
30

### 31 **ROOFTOP AIR HANDLING UNIT (AHU-3)**

32 This is a rooftop mounted mixed air variable air volume air handling system controlled by the BAS.  
33

34 The system consists of:

- 35 • Supply fan with variable frequency drive (VFD-10).
- 36 • Return Fan with variable frequency drive (VFD-11).

- 1 • Motorized modulating outside air damper (fail closed) (damper furnished by 23 73 13, actuator by
- 2 23 09 14).
- 3 • Motorized modulating return air damper (fail open) (damper furnished by 23 73 13, actuator by 23
- 4 09 14).
- 5 • Motorized modulating relief air damper (fail closed) (damper furnished by 23 73 13, actuator by
- 6 23 09 14).
- 7 • Chilled water cooling coil with modulating 3-way temperature control valve (fail to bypass coil).
- 8 • Hot water heating coil with modulating 3-way temperature control valve (fail to coil).
- 9 • Heating coil freezestat.
- 10 • Return air duct smoke detector.
- 11 • Sensors:
- 12 ○ Supply duct discharge air temperature sensor.
- 13 ○ Preheat coil discharge air temperature sensor.
- 14 ○ Mixed air temperature sensor.
- 15 ○ Return air temperature sensor.
- 16 ○ Return air humidity sensor.
- 17 ○ Space mounted humiditat.
- 18 ○ High limit humidistat (downstream of distribution tube).

19  
20  
21 **FAN CONTROL:**

22 Start/Stop: The DDC system shall start the supply and return fan via the VFD.

23 Current Status Switch: Provide as described under GENERAL, VFD Motor Run Status, in this Section for  
24 both the supply and return fans.

25  
26 Supply Fan Speed Control: The purpose of the supply fan control is to maintain temperature within the  
27 space. See discharge air temperature control sequence below.

28  
29 Return Fan Speed Control: The purpose of the return fan control is to maintain a slightly positive building  
30 pressure. The return fan VFD shall modulate to maintain a constant CFM offset of 300(adj.) from the  
31 supply fan to account for total exhaust from the area in which it serves while maintaining a slightly positive  
32 pressure. Control contractor shall coordinate with the balancing contractor to optimize this setting.

33  
34 **Minimum Ventilation Air Flow Control:**

35 Fixed Ventilation Air Flow Setpoint: The AHU outside air ventilation rate shall be maintained at 300  
36 CFM. (The Office Area is to be positive to the Lab Area by 400 CFM)

37  
38 Minimum Ventilation Air Flow Control Using Volume Matching: The minimum outside air damper  
39 position will be reset between a high minimum position and a low minimum position reset from the full  
40 design turndown fan speed and maximum fan speed. The Temperature Control Contractor shall work with  
41 the Balancing Contractor to determine these damper position setpoints to provide an even mixed air static  
42 pressure over the full range of fan turndown.

43  
44 Install a temperature sensor in the supply duct downstream of the supply fan, all water coils and  
45 humidifiers.

46  
47 **DISCHARGE AIR TEMPERATURE CONTROL**

48 Discharge Air Temperature Setpoint Reset from Zone Temperature (Heating and Cooling Unit): Reset the  
49 discharge air temperature setpoint based on the zone temperature between 55° F (adj.) and 90° F (adj.) to  
50 maintain a zone heating and economizer setpoint of 72° F (adj.). Mechanical cooling shall maintain a zone  
51 mechanical cooling setpoint of 72° F (adj.). Mechanical cooling shall be locked out below the mechanical  
52 cooling setpoint unless dehumidification control is required.

53

1 Discharge Air Temperature Control: The heating coil and mixed air dampers shall be controlled in  
2 sequence to maintain the discharge air setpoint temperature. At no time shall the heating coil be operating  
3 when the mixed air dampers are economizing or the chilled water coil valve is open. Whenever the  
4 discharge air temperature is above the setpoint, the following shall occur in sequence: The heating coil  
5 control shall modulate closed as sequenced below. When heating is completely off and the economizer  
6 sequence is enabled, the economizer outside air damper, return air damper, and relief damper will be  
7 modulated together in sequence to maintain discharge air temperature setpoint. When the outside air  
8 economizer damper is completely open, or the economizer sequence is not enabled, the chilled water valve  
9 will modulate open to maintain the zone mechanical cooling temperature setpoint as described above.  
10 The cooling control will be limited to the low discharge temperature reset setpoint. When the discharge air  
11 setpoint is below setpoint the reverse shall occur. Cooling coil control shall be locked out below 50° F  
12 (adj.) outside air temperature.  
13

14 Preheat Coil Discharge Air Temperature Control – AHU- Not Running Operation: The Preheat coil  
15 discharge air temperature control sensor located immediately downstream of preheat coil shall modulate  
16 preheat coil control valve to maintain 52°F (adj.) preheat coil discharge air temperature anytime AHU is  
17 not running and safety low temperature limit control (freezestat) is not in alarm.  
18

19 Humidification Control: Control return air humidity sensor to maintain a reset humidity setpoint. The  
20 setpoint shall be 35% RH (adj.) at an outside air dry bulb temperature of 50° F (adj.) and shall be reset to  
21 20% RH (adj.) at an outside air dry bulb temperature of 0° F (adj.). Provide an electronic discharge air  
22 humidity sensor that shall limit the discharge humidity to 90% RH (adj.) by overriding the signal to the  
23 humidifier. Mount the humidity high limit device a minimum of 6 feet or greater if required by  
24 manufacturer.  
25

26 Dehumidification Control: Override the cooling coil valve position open to maintain a return air humidity  
27 of 60% RH (adj.). Lockout this control when outside air is below 55° F.  
28

29 Economizer Control: Provide dry bulb economizer control. Whenever outside air dry bulb temperature  
30 exceeds the return air temperature plus 4°F (adj.), economizer control shall override mixed air control and  
31 modulate AHU-1 outside economizer damper closed.

32 Economizer control shall be released to mixed air control when outside air dry bulb temperature is less than  
33 return air temperature minus 5°F (adj.) for 10 consecutive minutes (adj.)  
34

35 Mixed Air Temperature Control: The unit includes a single modulating outside air damper, modulating  
36 return air damper, and modulating outside air damper. The modulating outside economizer air damper  
37 shall be enabled as determined by the economizer mode sequence stated above. The economizer outside air  
38 damper and the return air damper shall be controlled by the mixed air temperature controller with averaging  
39 type sensor located at the upstream side of the pre-filter to maintain mixed air temperature of 52°F (adj.).  
40 As the mixed air temperature decreases, the outside air damper shall close and the return air damper shall  
41 open to maintain the mixed temperature setpoint. The reverse shall occur as mixed air temperature  
42 increases. The return air damper position may not be proportionally opposite of the outside air damper.  
43 Final test and balancing will need to determine the position of the return air damper in order to keep the  
44 relief air static pressure positive in all scenarios (min/max CFM).  
45

46 Relief Air Damper Control: A static pressure control with its pressure transmitter located in the return duct  
47 at least three feet from the fan discharge and upstream of the control damper, shall modulate the relief air  
48 damper (FC) to maintain initial relief static pressure setpoint of 0.6” WC (adj.). On a drop in return static  
49 pressure below setpoint, as measured by the return system static pressure transmitter, relief damper shall  
50 modulate closed until return static pressure setpoint has been satisfied. On rise in return static pressure  
51 above return system static pressure setpoint, relief damper shall modulate open until return static pressure  
52 setpoint is satisfied. Control contractor shall work in association with test and balance contractor to  
53 determine actual required static pressure setpoint. Setpoint indicated is to be used for initial system startup.  
54 Actual static pressure shall be minimum static pressure required to achieve system design flow.  
55

1 General Safeties Note: All safeties shall be hard wired to the supply and return fan starters or VFD safety  
2 circuits. Starters shall not function in the "Hand" or "Auto" and VFD's shall be disabled if they are  
3 indexed to the "Auto" or "Hand" position in either the VFD or bypass modes.  
4

5 Freezestat: Install an electric freezestat to shut down the unit (see Unit Shutdown for additional  
6 information) if the temperature downstream of the heating coil drops below 35° F (adj.). The electric  
7 freezestat shall act independently of the DDC system via hardwire interlock and shall override the DDC  
8 system control signal to open the heating coil control valve(s) to maintain an 80°F (adj.) preheat coil  
9 discharge air temperature setpoint. The cooling coil control valve shall fully open upon a trip of the  
10 freezestat. A freezestat trip shall notify the DDC system that shall send an alarm to the operator interface.  
11

12 Return Fire Alarm Shutdown: Upon a Fire Alarm System alarm, the fire alarm control module provided by  
13 the electrical contractor at the temperature control panel shall change state of its contacts. This shall cause  
14 the unit to be shut down (see Unit Shutdown for additional information). An auxiliary contact shall be  
15 provided to notify the DDC system of a fire alarm shutdown.  
16

17 Unit Shutdown: Whenever the air handling unit is indexed off, the supply and return fans shall stop,  
18 outside air damper shall close, return damper shall fully open, relief damper shall close, chilled water valve  
19 shall close, heating coil valve shall remain under control to maintain a 52°F (adj.) temperature at the  
20 preheat discharge air sensor.  
21

22 If an AHU supply fan failure occurs, as detected by a current switch, or VFD fault indication from VFD  
23 output, the fan shall be stopped and an alarm shall be annunciated at the BAS. This alarm interlock shall be  
24 disabled for 60 seconds (adj.) after the fan is initially commanded to start. Upon failure the following shall  
25 occur:

- 26 • The outside air dampers and relief air dampers shall fully close.
- 27 • The return air damper shall fully open.
- 28 • The return fan shall be commanded to stop.
- 29 • The chilled water control valve shall close
- 30 • The heating coil control valve shall remain under control from the preheat discharge air  
31 temperature sensor to maintain 52°F (adj.)

32 When failed AHU fan is reset through BAS, AHU shall restart as indicated above.  
33

34 If return fan failure occurs, as detected by a current switch, or VFD fault indication from VFD output, the  
35 AHU shall be stopped and an alarm shall be annunciated at the BAS. This alarm interlock shall be disabled  
36 for 60 seconds (adj.) after the fan is initially commanded to start. Upon failure the following shall occur:

- 37 • The outside air dampers and relief air dampers shall fully close.
- 38 • The return air damper shall fully open.
- 39 • The supply fan shall be commanded to stop.
- 40 • The chilled water control valve shall close
- 41 • The heating coil control valve shall remain under control from the preheat discharge air  
42 temperature sensor to maintain 52°F (adj.)

43  
44 When failed AHU fan is reset through BAS, AHU shall restart as indicated above.  
45

46 Unoccupied Control General Note: Occupied/unoccupied schedule shall be set at the DDC operator  
47 interface. When indexed to unoccupied the unit shall shutdown. Where provided, index DDC controlled  
48 heating and cooling terminal units associated with this air handling unit to maintain setback and setup  
49 temperature setpoints unless overridden by occupancy sensor or manual pushbutton.  
50

51 Unoccupied Control - Unit Cycling to Maintain Setback/Setup Temperatures: Cycle the air handling unit  
52 on to maintain the setback and setup temperature zone setpoints to maintain 58 °F (adj.) and 86 °F (adj.)  
53 respectively.  
54



1 Reset supply return fan volume offset for return air fan control to zero. Supply fan shall be limited to the  
2 maximum return fan airflow. In the heating mode, the outside air and relief air dampers shall fully close  
3 and the return air damper shall fully open and heating discharge temperature control shall function as  
4 specified. In the cooling mode, the economizer and chilled water discharge temperature control shall be  
5 allowed to function as specified. Minimum on runtime timer shall be set for 15 minutes (adj.) and the off  
6 timer for 30 minutes (adj.).

7  
8 Monitor and Alarm: Monitor, through BAS, the following points associated with the air handling system  
9 and generate the alarms indicated:

- 10 • Unit discharge air temperature: Generate alarm if temperature exceeds setpoint by +/- 3°F (adj.)  
11 for 10 consecutive minutes (adj.)
- 12 • Preheat coil discharge air temperature: Generate alarm if temperature deviates from setpoint by -  
13 3.0°F (adj.) for 10 consecutive minutes (adj.)
- 14 • Mixed air temperature: Generate alarm if temperature goes below setpoint by 5°F (adj.) for 10  
15 consecutive minutes (adj.)
- 16 • High Return airflow: Generate alarm if airflow exceeds setpoint by +/- 500 CFM (adj.) for 10  
17 consecutive minutes (adj.)
- 18 • Low Limit thermostat (freezestat): Generate alarm and stop AHU
- 19 • Supply fan current switch: Generate alarm if fan status proven by current switch does not match  
20 commanded state.
- 21 • Return fan current switch: Generate alarm if fan status proven by current switch does not match  
22 commanded state.
- 23 • Return air smoke detector: Generate alarm and stop AHU.

#### 24 25 **AIR HANDLING UNIT AND EXHAUST FAN (AHU-4 AND EF-4)**

26 This is an indoor mounted 100% outside air constant volume air handling system controlled by the BAS

27  
28 This system consists of:

- 29 • AHU-4 supply fan with starter.
- 30 • AHU-4 motorized modulating outside air damper (fail closed) (damper furnished by 23 73 13,  
31 actuator by 23 09 14).
- 32 • AHU-4 hot water heating coil with modulating 3-way temperature control valve (fail to coil).
- 33 • AHU-4 heating coil freezestat.
- 34 • Supply air duct smoke detector.
- 35 • AHU-4 sensors:
  - 36 ○ Supply duct discharge air temperature sensor.
  - 37 ○ Preheat coil discharge air temperature sensor.
- 38 • Exhaust fan EF-4 with starter.
- 39 • Exhaust air damper and motorized actuator (damper furnished by 23 73 13, actuator by 23 09 14).

#### 40 41 FAN CONTROL:

42 Start/Stop: The DDC system shall start and stop AHU-4 and EF-4.

43  
44 Current Status Switch: Provide as described under GENERAL for the supply fan and exhaust fan.

45  
46 The BAS shall operate AHU-4 and EF-4 as follows:

- 47 • For a minimum of 5 hours each day, 7 days per week, 365 days per year.
- 48 • Upon a “low level” (first alarm) alarm signal from the space mounted gas detection system when  
49 the system detects CO, CO2 or Methane (natural gas) levels above the set minimum of the gas  
50 detection system.

51  
52 On a call for AHU-4 and EF-4 to operate, the outside air damper will open 100% and exhaust air damper  
53 will open 100%. Upon proving that both dampers are open, AHU-4 and EF-4 shall start Upon an

1 expiration of the minimum 5 hour run-time, or an all clear signal from the gas detection and monitoring  
2 system the reverse shall occur.

3  
4 Preheat Coil Discharge Air Temperature Control – Normal Operation: The heating control valve (FO) shall  
5 modulate to maintain 55°F (adj.) at probe type sensor located in the supply duct downstream of the AHU.  
6 The preheat coil control valve shall be locked in the closed position whenever outside air temperature is  
7 above 60°F (adj.) for 10 consecutive minutes (adj.)

8  
9 Preheat Coil Discharge Air Temperature Control – AHU- Not Running Operation: The Preheat coil  
10 discharge air temperature control sensor located immediately downstream of preheat coil shall modulate  
11 preheat coil control valve to maintain 52°F (adj.) preheat coil discharge air temperature anytime AHU is  
12 not running and safety low temperature limit control (freezestat) is not in alarm.

13  
14 General Safeties Note: All safeties shall be hard wired to the supply VFD safety circuit. Starters shall not  
15 function in the “Hand” or “Auto” and VFD’s shall be disabled if they are indexed to the “Auto” or “Hand”  
16 position in either the VFD or bypass modes.

17  
18 Freezestat: Install an electric freezestat to shut down the unit (see Unit Shutdown for additional  
19 information) if the temperature downstream of the heating coil drops below 35° F (adj.). The electric  
20 freezestat shall act independently of the DDC system via hardwire interlock and shall override the DDC  
21 system control signal to open the heating coil control valve(s) to maintain an 80°F (adj.) preheat coil  
22 discharge air temperature setpoint. The cooling coil control valve shall fully open upon a trip of the  
23 freezestat. A freezestat trip shall notify the DDC system that shall send an alarm to the operator interface.

24  
25 Supply Fire Alarm Shutdown: Upon a Fire Alarm System alarm, the fire alarm control module provided by  
26 the electrical contractor at the temperature control panel shall change state of its contacts. This shall cause  
27 the unit to be shut down (see Unit Shutdown for additional information). An auxiliary contact shall be  
28 provided to notify the DDC system of a fire alarm shutdown.

29 Unit Shutdown: Whenever the air handling unit is indexed off, the supply fan shall stop, outside air  
30 damper shall close, chilled water valve shall close, heating coil valve shall remain under control to maintain  
31 a 52°F (adj.) temperature at the preheat discharge air sensor.

32  
33 If an AHU supply fan failure occurs, as detected by a current switch, or VFD fault indication from VFD  
34 output, the fan shall be stopped and an alarm shall be annunciated at the BAS. This alarm interlock shall be  
35 disabled for 60 seconds (adj.) after the fan is initially commanded to start. Upon failure the following shall  
36 occur:

- 37 • The outside air damper shall fully close.
- 38 • The chilled water control valve shall close
- 39 • The heating coil control valve shall remain under control from the preheat discharge air  
40 temperature sensor to maintain 52°F (adj.)

41  
42 When failed AHU fan is reset through BAS, AHU shall restart as indicated above.

43  
44 When failed AHU fan is reset through BAS, AHU shall restart as indicated above.

45  
46 Unoccupied Control General Note: Occupied/unoccupied schedule shall be set at the DDC operator  
47 interface. When indexed to unoccupied the unit shall shutdown. Where provided, index DDC controlled  
48 heating and cooling terminal units associated with this air handling unit to maintain setback and setup  
49 temperature setpoints unless overridden by occupancy sensor or manual pushbutton.

50  
51 Unoccupied Control - Unit Cycling to Maintain Setback/Setup Temperatures: Cycle the air handling unit  
52 on to maintain the setback and setup temperature zone setpoints to maintain 58 °F (adj.) and 86 °F (adj.)  
53 respectively. Reset supply fan volume to 2770 CFM. In the heating mode, the outside air damper shall  
54 open and heating discharge temperature control shall function as specified. In the cooling mode, the  
55 outside air damper shall open and chilled water discharge temperature control shall be allowed to function

1 as specified. Minimum on runtime timer shall be set for 15 minutes (adj.) and the off timer for 30 minutes  
2 (adj.).

3  
4 Monitor and Alarm: Monitor, through BAS, the following points associated with the air handling system  
5 and generate the alarms indicated:

- 6 • Unit discharge air temperature: Generate alarm if temperature exceeds setpoint by +/- 3°F (adj.)  
7 for 10 consecutive minutes (adj.)
- 8 • Preheat coil discharge air temperature: Generate alarm if temperature deviates from setpoint by -  
9 3.0°F (adj.) for 10 consecutive minutes (adj.)
- 10 • Low Limit thermostat (freezestat): Generate alarm and stop AHU
- 11 • Supply fan current switch: Generate alarm if fan status proven by current switch does not match  
12 commanded state.
- 13 • Exhaust fan current switch: Generate alarm if fan status proven by current switch does not match  
14 commanded state.
- 15 • Supply air smoke detector: Generate alarm and stop AHU.
- 16 • Gas detection alarm
  - 17 ○ Level “one” alarm.
  - 18 ○ Level “two” alarm.

19  
20 **OFFICE AREA - VAV TERMINAL UNITS WITH REHEAT AND INFLOOR RADIATION**

21 Systems consist of:

- 22 • Variable air volume terminal
- 23 • Hot water reheat coil with 2-way or 3-way temperature control valve (see plans).
- 24 • DDC space sensor.
- 25 • Discharge air temperature sensor.
- 26 • Occupancy sensor (lighting occupancy sensor – provided by EC, wiring from sensor to BAS by 23  
27 09 14) (where indicated).

28  
29 Provide a DDC space temperature sensor to control, in sequence, a modulating electronic control valve for  
30 the hot water reheat coil and actuator for terminal air flow. When space temperature is below setpoint, the  
31 air terminal damper shall modulate toward the cooling minimum flow position. After the air terminal  
32 damper is at its minimum flow, the radiant floor valve shall open to maintain setpoint. If setpoint cannot be  
33 maintained, the reheat coil valve shall modulate open. If the air terminal has a heating airflow, the hot  
34 water reheat control valve and air terminal shall open in parallel to the heating airflow.

35  
36 The reverse shall occur when space temperature is above setpoint. The heating coil valve shall be  
37 commanded closed whenever the associated AHU is off. Provide a discharge air temperature sensor for  
38 monitoring purposes.

39  
40 Each space temperature sensor shall have a manual override button that shall index the space to the  
41 occupied mode for a period of two hours (adj.). If an occupancy sensor is specified, it shall index the  
42 terminal unit DDC controller to occupied mode for a minimum of 30 minutes (adj.).

43  
44 Lighting occupancy sensors are to be interlocked to the terminal unit for signalling occupancy to the  
45 terminal unit zone: When the occupancy sensor signals the zone is unoccupied, the minimum flow setpoint  
46 shall be zero CFM (adj.) and the heating and cooling temperature setpoints will be maintained at either the  
47 occupied or unoccupied heating and cooling setpoints (as determined by the owner). When the occupancy  
48 sensor signals the zone is occupied, the occupied minimum flow setpoint shall be as scheduled and the  
49 occupied heating and cooling temperature setpoints shall be maintained. All programming for the above  
50 sequence shall reside in the terminal unit controller and a supervisory controller shall not be required to  
51 reset any flow or temperature setpoints based on the occupancy sensor.

52  
53 This contractor shall provide all control wiring, including control wiring from occupancy sensor to  
54 controller.

1 Provide separate adjustable cooling and heating setpoints for both the occupied and unoccupied modes.  
2 When the space temperature is between the heating and cooling setpoints, the heating valve shall be closed  
3 and the airflow at heating and cooling minimum flow.  
4

5 When the space is “unoccupied”, the infloor radiation shall be the source of “unoccupied” heating.  
6

7 The radiant floor hot water valve shall be locked out whenever outside air is above 50° F (adj.).  
8

9 **LAB/AUTOPSY AREA – VAV TERMINAL UNIT WITH REHEAT AND IN-FLOOR RADIATION**  
10 **AND EXHAUST VALVE**

11  
12 130 - AUTOPSY

13 System consists of:

- 14 • Supply air variable air volume terminals (VAV-2-1, VAV-2-2 and VAV-2-4) with:
  - 15 ○ Hot water reheat coils and associated 2-way or 3-way modulating TCV.
  - 16 ○ Discharge air temperature sensor.
- 17 • Infloor hot water radiation with:
  - 18 ○ 2-way modulating temperature control valve.
  - 19 ○ In-floor temperature sensor.
- 20 • Exhaust air valves
  - 21 ○ EV-1 – General Autopsy Exhaust
  - 22 ○ EV-2 - General Autopsy Exhaust
  - 23 ○ EV-10 – Janitor / Cart Storage Exhaust
- 24 • DDC Space Thermostat with temperature override button.
- 25 • DDC Space Humidistat
- 26 • Wall Mounted High/Low Ventilation Air Switch
  - 27 ○ Low Ventilation Switch with Amber Pilot Light
  - 28 ○ High Ventilation Switch with Green Pilot Light
  - 29 ○ Red Pilot Light - Alarm

30  
31 This space shall always be at a negative pressure in relation to the adjacent Corridor (1007).  
32

33 The space shall have 4 airflow modes of operation:

- 34 • A1 – Day / Occupied Building – “Inactive” – Low Ventilation.
- 35 • A2 – Day / Occupied Building - “Active” – High Ventilation.
- 36 • B1 – Night / Unoccupied Building – “Inactive” – Low Ventilation.
- 37 • B2 – Night / Unoccupied Building – “Active” – High Ventilation.

38  
39 Wall mounted high/low ventilation switch shall be labelled as follows:

- 40 • High Airflow – Green Pilot Light
- 41 • Low Airflow – Amber Pilot Light
- 42 • Alarm – Red Pilot Light

43  
44 At all times, the pilot lights shall reflect current space airflow (“low” or “high”).  
45

46 Design Intent: During periods where procedures and autopsies are being performed in the space, the  
47 airflow shall be “high”. During periods when the space is inactive, the airflow shall be “low”.  
48

49 Airflow Schedule (Adj.): The schedule shall default to “low” airflow at all times.

- 50 • VAV-2-1, VAV-2-2 and VAV-2-4 shall be at minimum airflow.
- 51 • EV-1, EV-2 and EV-10 shall be at minimum airflow.

1 Temperature Schedule: The temperature schedule shall be as follows (adj.):

- 2 • Building “Occupied”: 6:00am – 6:00pm
  - 3 ○ Heating Setpoint: 68°
  - 4 ○ Cooling Setpoint: 75°
- 5 • Building “Unoccupied”: 6:00pm – 6:00am
  - 6 ○ Heating Setpoint: 65°
  - 7 ○ Cooling Setpoint: 78°
- 8 • Whenever in “high” airflow mode:
  - 9 ○ Heating Setpoint: 68°
  - 10 ○ Cooling Setpoint: 68°

11 “High” Airflow Activation: The system shall be manually indexed to “high” airflow via the wall mounted  
12 ventilation air switch. Once manually activated to “high” airflow, the system shall be timed to operate at  
13 high airflow for 4 hours (adj) before automatically being indexed back to “low” airflow by the building  
14 automation system.

15  
16 Provide a DDC space temperature sensor to control, in sequence, a VAV modulating electronic control  
17 valves (in parallel) for the hot water reheat coil and radiant floor electronic control valve.

18  
19 When space temperature is below setpoint, the hot water radiation floor valve shall modulate open as a first  
20 source of heat to maintain space temperature. On a further drop in space temperature, the reheat coil valves  
21 shall modulate open in parallel. The reverse shall occur when space temperature is above setpoint. Provide  
22 a discharge air temperature sensor for monitoring purposes.

23  
24 When the space temperature rises above setpoint, and the space is at “low” airflow, the supply air terminals  
25 and exhaust air terminals shall modulate open in parallel, maintaining their “offset” to maintain space  
26 temperature setpoint. On a drop in space temperature below setpoint, the reverse shall occur until the  
27 supply air terminals and exhaust air terminals reach their minimum airflows.

28  
29 The radiant floor control valve shall be locked out whenever the outside air is above 50° F (adj.).

30  
31 Space temperature sensor shall have a manual override button that shall index the space to the occupied  
32 mode for a period of two hours (adj.). If an occupancy sensor is specified, it shall index the terminal unit  
33 DDC controller to occupied mode for a minimum of 30 minutes (adj.).

### 34 131 – AUTOPSY VIEWING

35 System consists of:

- 36 • Supply air variable air volume terminals (VAV-2-6) with:
  - 37 ○ Hot water reheat coil and associated 2-way or 3-way modulating TCW.
  - 38 ○ Discharge air temperature sensor.
- 39 • Exhaust air valves
  - 40 ○ EV-4 – General Exhaust
- 41 • DDC Space Thermostat with temperature override button.
- 42 • Occupancy sensor (lighting occupancy sensor – provided by EC, wiring from sensor to BAS by 23  
43 09 14) (where indicated).

44  
45  
46 Provide a DDC space temperature sensor to control, in sequence, a modulating electronic control valve for  
47 the hot water reheat coil and actuator for terminal air flow. When space temperature is below setpoint, the  
48 air terminal damper shall modulate toward the cooling minimum flow position. After the air terminal  
49 damper is at its minimum flow, the radiant floor valve shall open to maintain setpoint. If setpoint cannot be  
50 maintained, the reheat coil valve shall modulate open. If the air terminal has a heating airflow, the hot  
51 water reheat control valve and air terminal shall open in parallel to the heating airflow.

52  
53 The reverse shall occur when space temperature is above setpoint. The heating coil valve shall be  
54 commanded closed whenever the associated AHU is off. Provide a discharge air temperature sensor for  
55 monitoring purposes.

1 Exhaust valve EV-4 shall track VAV-2-6 and maintain offset.

2  
3 Each space temperature sensor shall have a manual override button that shall index the space to the  
4 occupied mode for a period of two hours (adj.). If an occupancy sensor is specified, it shall index the  
5 terminal unit DDC controller to occupied mode for a minimum of 30 minutes (adj.).

6  
7 Lighting occupancy sensors are to be interlocked to the terminal unit for signalling occupancy to the  
8 terminal unit zone: When the occupancy sensor signals the zone is unoccupied, the minimum flow setpoint  
9 shall be zero CFM (adj.) and the heating and cooling temperature setpoints will be maintained at either the  
10 occupied or unoccupied heating and cooling setpoints (as determined by the owner). When the occupancy  
11 sensor signals the zone is occupied, the occupied minimum flow setpoint shall be as scheduled and the  
12 occupied heating and cooling temperature setpoints shall be maintained. All programming for the above  
13 sequence shall reside in the terminal unit controller and a supervisory controller shall not be required to  
14 reset any flow or temperature setpoints based on the occupancy sensor.

15  
16 This contractor shall provide all control wiring, including control wiring from occupancy sensor to  
17 controller.

18  
19 Provide separate adjustable cooling and heating setpoints for both the occupied and unoccupied modes.  
20 When the space temperature is between the heating and cooling setpoints, the heating valve shall be closed  
21 and the airflow at heating and cooling minimum flow.

22  
23 When the space is “unoccupied”, the infloor radiation shall be the source of “unoccupied” heating.

24  
25 The radiant floor hot water valve shall be locked out whenever outside air is above 50° F (adj.).

## 26 27 132 – DECOMPOSITION AUTOPSY

28 System consists of:

- 29 • Supply air variable air volume terminal (VAV-2-3) with:
  - 30 ○ Hot water reheat coil and associated 2-way or 3-way modulating temperature control
  - 31 valve.
  - 32 ○ Discharge air temperature sensor.
- 33 • Infloor hot water radiation with:
  - 34 ○ 2-way modulating temperature control valve.
  - 35 ○ In-floor temperature sensor.
- 36 • Exhaust air valves
  - 37 ○ EV-3 – General Autopsy Exhaust
  - 38 ○ EV-12 - Fume Hood
- 39 • Fume Hood with Occupancy Presence Sensor
- 40 • DDC Space Thermostat with override button
- 41 • Wall Mounted High/Low Ventilation Air Switch
  - 42 ○ Low Ventilation Switch with Amber Pilot Light
  - 43 ○ High Ventilation Switch with Green Pilot Light
  - 44 ○ Red Pilot Light - Alarm

45  
46 This space shall always be at a negative pressure in relation to the adjacent Autopsy Suite.

47  
48 The space shall have 8 airflow modes of operation:

- 49 • A1 – Day / Occupied Building – “Inactive” – Low Ventilation and No Fume Hood Use
- 50 • A2 – Day / Occupied Building – “Inactive” – Low Ventilation with Fume Hood Use
- 51 • A3 – Day / Occupied Building - “Active” – High Ventilation and No Fume Hood Use.
- 52 • A4 – Day / Occupied Building - “Active” – High Ventilation with Fume Hood Use.
- 53 • B1 – Night / Unoccupied Building – “Inactive” – Low Ventilation and No Fume Hood Use
- 54 • B2 – Night / Unoccupied Building – “Inactive” – Low Ventilation with Fume Hood Use

- 1 • B3 – Day / Occupied Building - “Active” – High Ventilation and No Fume Hood Use.
- 2 • B4 – Day / Occupied Building - “Active” – High Ventilation with Fume Hood Use.

3

4 Wall mounted high/low ventilation switch shall be labelled as follows:

- 5 • High Airflow – Green Pilot Light
- 6 • Low Airflow – Amber Pilot Light
- 7 • Alarm – Red Pilot Light

8

9 At all times, the pilot lights shall reflect current space airflow (“low” or “high”).

10

11 Design Intent: During periods where procedures and autopsies are being performed in the space, the  
12 airflow shall be “high”. During periods when the space is inactive, the airflow shall be “low”. The fume  
13 hood airflow shall be controlled via the occupancy presence sensor.

14

15 Airflow Schedule (Adj.): The schedule shall default to “low” airflow at all times.

- 16 • VAV-2-3 shall be at minimum airflow.
- 17 • EV-3 shall be at minimum airflow.
- 18 • EV-12 shall be at minimum airflow (unless activated by the zone presence sensor).

19

20 Temperature Schedule: The temperature schedule shall be as follows (adj.):

- 21 • Building “Occupied”: 6:00am – 6:00pm
  - 22 ○ Heating Setpoint: 68°
  - 23 ○ Cooling Setpoint: 75°
- 24 • Building “Unoccupied”: 6:00pm – 6:00am
  - 25 ○ Heating Setpoint: 65°
  - 26 ○ Cooling Setpoint: 78°
- 27 • Whenever in “high” airflow mode:
  - 28 ○ Heating Setpoint: 68°
  - 29 ○ Cooling Setpoint: 68°

30

31 Fume Hood: When the fume hood is not in use, as sensed by the fume hood presence sensor, the associated  
32 exhaust valve (EV-12) shall be in its minimum position. When the fume hood is in use, as sensed by the  
33 fume hood presence sensor, the associated exhaust valve (EV-12) shall be at its maximum position. If the  
34 fume hood face velocity detects a face velocity less than 78 fpm while “in use” then an alarm shall be  
35 activated.

36

37 “High” Airflow Activation: The system shall be manually indexed to “high” airflow via the wall mounted  
38 ventilation air switch. Once manually activated to “high” airflow, the system shall be timed to operate at  
39 high airflow for 4 hours (adj) before automatically being indexed back to “low” airflow by the building  
40 automation system.

41

42 Provide a DDC space temperature sensor to control, in sequence, a VAV modulating electronic control  
43 valves (in parallel) for the hot water reheat coil and radiant floor electronic control valve.

44

45 When space temperature is below setpoint, the hot water radiation floor valve shall modulate open as a first  
46 source of heat to maintain space temperature. On a further drop in space temperature, the reheat coil valves  
47 shall modulate open in parallel. The reverse shall occur when space temperature is above setpoint. Provide  
48 a discharge air temperature sensor for monitoring purposes.

49

50 When the space temperature rises above setpoint, and the space is at “low” airflow, the supply air terminals  
51 and exhaust air terminals shall modulate open in parallel, maintaining their “offset” to maintain space  
52 temperature setpoint. On a drop in space temperature below setpoint, the reverse shall occur until the  
53 supply air terminals and exhaust air terminals reach their minimum airflows.

54

1 The radiant floor control valve shall be locked out whenever the outside air is above 50° F (adj.).

2  
3 Space temperature sensor shall have a manual override button that shall index the space to the occupied  
4 mode for a period of two hours (adj.). If an occupancy sensor is specified, it shall index the terminal unit  
5 DDC controller to occupied mode for a minimum of 30 minutes (adj.).

6  
7 133 – GENERAL LAB

8 System consists of:

- 9 • Supply air variable air volume terminal (VAV-2-5) with:
  - 10 ○ Hot water reheat coil and associated 2-way or 3-way modulating temperature control
  - 11 valve.
  - 12 ○ Discharge air temperature sensor.
- 13 • Infloor hot water radiation with:
  - 14 ○ 2-way modulating temperature control valve.
  - 15 ○ In-floor temperature sensor.
- 16 • Exhaust air valves
  - 17 ○ EV-6 – General Autopsy Exhaust
  - 18 ○ EV-5 - Fume Hood
- 19 • Fume Hood with Occupancy Presence Sensor
- 20 • DDC Space Thermostat with override button
- 21 • Wall Mounted High/Low Ventilation Air Switch
  - 22 ○ Low Ventilation Switch with Amber Pilot Light
  - 23 ○ High Ventilation Switch with Green Pilot Light
  - 24 ○ Red Pilot Light - Alarm

25  
26 This space shall always be at a negative pressure in relation to the adjacent surrounding spaces.

27  
28 The space shall have 8 airflow modes of operation:

- 29 • A1 – Day / Occupied Building – “Inactive” – Low Ventilation and No Fume Hood Use
- 30 • A2 – Day / Occupied Building – “Inactive” – Low Ventilation with Fume Hood Use
- 31 • A3 – Day / Occupied Building - “Active” – High Ventilation and No Fume Hood Use.
- 32 • A4 – Day / Occupied Building - “Active” – High Ventilation with Fume Hood Use.
- 33 • B1 – Night / Unoccupied Building – “Inactive” – Low Ventilation and No Fume Hood Use
- 34 • B2 – Night / Unoccupied Building – “Inactive” – Low Ventilation with Fume Hood Use
- 35 • B3 – Day / Occupied Building - “Active” – High Ventilation and No Fume Hood Use.
- 36 • B4 – Day / Occupied Building - “Active” – High Ventilation with Fume Hood Use.

37  
38 Wall mounted high/low ventilation switch shall be labelled as follows:

- 39 • High Airflow – Green Pilot Light
- 40 • Low Airflow – Amber Pilot Light
- 41 • Alarm – Red Pilot Light

42  
43 At all times, the pilot lights shall reflect current space airflow (“low” or “high”).

44  
45 Design Intent: During periods when the lab is actively used, the airflow shall be “high”. During periods  
46 when the lab is inactive, the airflow shall be “low”. The fume hood airflow shall be controlled via the  
47 occupancy presence sensor.

48  
49 Airflow Schedule (Adj.): The schedule shall default to “low” airflow at all times.

- 50 • VAV-2-5 shall be at minimum airflow.
- 51 • EV-6 shall be at minimum airflow.
- 52 • EV-5 shall be at minimum airflow (unless activated by the zone presence sensor).



- 1 Temperature Schedule: The temperature schedule shall be as follows (adj.):
- 2 • Building “Occupied”: 6:00am – 6:00pm
  - 3     o Heating Setpoint: 68°
  - 4     o Cooling Setpoint: 75°
  - 5 • Building “Unoccupied”: 6:00pm – 6:00am
  - 6     o Heating Setpoint: 65°
  - 7     o Cooling Setpoint: 78°
  - 8 • Whenever in “high” airflow mode:
  - 9     o Heating Setpoint: 68°
  - 10     o Cooling Setpoint: 72°

11

12 Fume Hood: When the fume hood is not in use, as sensed by the fume hood presence sensor, the associated

13 exhaust valve (EV-5) shall be in its minimum position. When the fume hood is in use, as sensed by the

14 fume hood presence sensor, the associated exhaust valve (EV-5) shall be at its maximum position. If the

15 fume hood face velocity detects a face velocity less than 78 fpm while “in use” then an alarm shall be

16 activated.

17

18 “High” Airflow Activation: The system shall be manually indexed to “high” airflow via the wall mounted

19 ventilation air switch. Once manually activated to “high” airflow, the system shall be timed to operate at

20 high airflow for 4 hours (adj) before automatically being indexed back to “low” airflow by the building

21 automation system.

22

23 Provide a DDC space temperature sensor to control, in sequence, a VAV modulating electronic control

24 valves (in parallel) for the hot water reheat coil and radiant floor electronic control valve.

25

26 When space temperature is below setpoint, the hot water radiation floor valve shall modulate open as a first

27 source of heat to maintain space temperature. On a further drop in space temperature, the reheat coil valves

28 shall modulate open in parallel. The reverse shall occur when space temperature is above setpoint. Provide

29 a discharge air temperature sensor for monitoring purposes.

30

31 When the space temperature rises above setpoint, and the space is at “low” airflow, the supply air terminals

32 and exhaust air terminals shall modulate open in parallel, maintaining their “offset” to maintain space

33 temperature setpoint. On a drop in space temperature below setpoint, the reverse shall occur until the

34 supply air terminals and exhaust air terminals reach their minimum airflows.

35

36 The radiant floor control valve shall be locked out whenever the outside air is above 50° F (adj.).

37

38 Space temperature sensor shall have a manual override button that shall index the space to the occupied

39 mode for a period of two hours (adj.). If an occupancy sensor is specified, it shall index the terminal unit

40 DDC controller to occupied mode for a minimum of 30 minutes (adj.).

41

42 138A/138B – LONG TERM STORAGE AND PROPERTY STORAGE

43 (134 – TISSUE STORAGE & 135/137 TOILETS SIMILAR)

44 Each system consists of:

- 45 • Supply air variable air volume terminal with:
    - 46     o Hot water reheat coil and associated 2-way or 3-way modulating TCV.
    - 47     o Discharge air temperature sensor.
  - 48 • Exhaust air valve
    - 49     o General Exhaust
  - 50 • DDC Space Thermostat with temperature override button.
  - 51 • Infloor hot water radiation with:
    - 52     o 2-way modulating temperature control valve.
    - 53     o In-floor temperature sensor.
- 54

1 Provide a DDC space temperature sensor to control, in sequence, a modulating electronic control valve for  
2 the hot water reheat coil and actuator for terminal air flow. When space temperature is below setpoint the  
3 radiant floor valve shall open to maintain setpoint. If setpoint cannot be maintained, the reheat coil valve  
4 shall modulate open.

5  
6 The reverse shall occur when space temperature is above setpoint. The heating coil valve shall be  
7 commanded closed whenever the associated AHU is off. Provide a discharge air temperature sensor for  
8 monitoring purposes.

9  
10 Exhaust valve maintain offset from VAV terminal.

11  
12 Each space temperature sensor shall have a manual override button that shall index the space to the  
13 occupied mode for a period of two hours (adj.).

14  
15 Provide separate adjustable cooling and heating setpoints for both the occupied and unoccupied modes.  
16 When the space temperature is between the heating and cooling setpoints, the heating valve shall be closed  
17 and the airflow at heating and cooling minimum flow.

18  
19 When the space is “unoccupied”, the infloor radiation shall be the source of “unoccupied” heating.

20  
21 The radiant floor hot water valve shall be locked out whenever outside air is above 50° F (adj.).

#### 22 23 141 – X-RAY

24 System consists of:

- 25 • Supply air variable air volume terminals (VAV-2-10) with:
  - 26 ○ Hot water reheat coil and associated 2-way or 3-way modulating TCV.
  - 27 ○ Discharge air temperature sensor.
- 28 • Infloor hot water radiation with:
  - 29 ○ 2-way modulating temperature control valve.
  - 30 ○ In-floor temperature sensor.
- 31 • Exhaust air valves
  - 32 ○ EV-13 – General Exhaust
- 33 • DDC Space Thermostat with temperature override button.
- 34 • Wall Mounted High/Low Ventilation Air Switch
  - 35 ○ Low Ventilation Switch with Amber Pilot Light
  - 36 ○ High Ventilation Switch with Green Pilot Light
  - 37 ○ Red Pilot Light - Alarm

38  
39 This space shall always be at a negative pressure in relation to the adjacent space.

40  
41 The space shall have 4 airflow modes of operation:

- 42 • A1 – Day / Occupied Building – “Inactive” – Low Ventilation.
- 43 • A2 – Day / Occupied Building - “Active” – High Ventilation.
- 44 • B1 – Night / Unoccupied Building – “Inactive” – Low Ventilation.
- 45 • B2 – Night / Unoccupied Building – “Active” – High Ventilation.

46 Wall mounted high/low ventilation switch shall be labelled as follows:

- 47 • High Airflow – Green Pilot Light
- 48 • Low Airflow – Amber Pilot Light
- 49 • Alarm – Red Pilot Light

50  
51 At all times, the pilot lights shall reflect current space airflow (“low” or “high”).

52  
53 Design Intent: During periods where procedures are being performed in the space, the airflow shall be  
54 “high”. During periods when the space is inactive, the airflow shall be “low”.

1 Airflow Schedule (Adj.): The schedule shall default to “low” airflow at all times.  
2 • VAV-2-10 shall be at minimum airflow.  
3 • EV-13 shall be at minimum airflow.  
4

5 Temperature Schedule: The temperature schedule shall be as follows (adj.):

- 6 • Building “Occupied”: 6:00am – 6:00pm
  - 7 ○ Heating Setpoint: 68°
  - 8 ○ Cooling Setpoint: 75°
- 9 • Building “Unoccupied”: 6:00pm – 6:00am
  - 10 ○ Heating Setpoint: 65°
  - 11 ○ Cooling Setpoint: 78°
- 12 • Whenever in “high” airflow mode:
  - 13 ○ Heating Setpoint: 68°
  - 14 ○ Cooling Setpoint: 68°

15  
16 “High” Airflow Activation: The system shall be manually indexed to “high” airflow via the wall mounted  
17 ventilation air switch. Once manually activated to “high” airflow, the system shall be timed to operate at  
18 high airflow for 4 hours (adj) before automatically being indexed back to “low” airflow by the building  
19 automation system.  
20

21 Provide a DDC space temperature sensor to control, in sequence, a VAV modulating electronic control  
22 valves (in parallel) for the hot water reheat coil and radiant floor electronic control valve.  
23

24 When space temperature is below setpoint, the hot water radiation floor valve shall modulate open as a first  
25 source of heat to maintain space temperature. On a further drop in space temperature, the reheat coil valves  
26 shall modulate open in parallel. The reverse shall occur when space temperature is above setpoint. Provide  
27 a discharge air temperature sensor for monitoring purposes.  
28

29 When the space temperature rises above setpoint, and the space is at “low” airflow, the supply air terminals  
30 and exhaust air terminals shall modulate open in parallel, maintaining their “offset” to maintain space  
31 temperature setpoint. On a drop in space temperature below setpoint, the reverse shall occur until the  
32 supply air terminals and exhaust air terminals reach their minimum airflows.  
33

34 The radiant floor control valve shall be locked out whenever the outside air is above 50° F (adj.).  
35

36 Space temperature sensor shall have a manual override button that shall index the space to the occupied  
37 mode for a period of two hours (adj.). If an occupancy sensor is specified, it shall index the terminal unit  
38 DDC controller to occupied mode for a minimum of 30 minutes (adj.).  
39

#### 40 144 – BODY RECEIVING / PROCESSING & 144A & 144B – CART WASH AND LAUNDRY

41 System consists of:

- 42 • Supply air variable air volume terminals (VAV-2-11) with:
  - 43 ○ Hot water reheat coil and associated 2-way or 3-way modulating TCV.
  - 44 ○ Discharge air temperature sensor.
- 45 • Infloor hot water radiation with:
  - 46 ○ 2-way modulating temperature control valve.
  - 47 ○ In-floor temperature sensor.
- 48 • Exhaust air valves
  - 49 ○ EV-14 – General Exhaust
- 50 • DDC Space Thermostat with temperature override button.

51  
52 This space shall always be at a negative pressure in relation to the adjacent space.  
53  
54

1 Airflow Schedule (Adj.): The schedule shall default to “low” airflow at all times.

- 2 • VAV-2-10 shall be at minimum airflow.
- 3 • EV-13 shall be at minimum airflow.

4  
5 Temperature Schedule: The temperature schedule shall be as follows (adj.):

- 6 • Building “Occupied”: 6:00am – 6:00pm
  - 7 ○ Heating Setpoint: 68°
  - 8 ○ Cooling Setpoint: 75°
- 9 • Building “Unoccupied”: 6:00pm – 6:00am
  - 10 ○ Heating Setpoint: 65°
  - 11 ○ Cooling Setpoint: 78°
- 12 • Whenever in “high” airflow mode:
  - 13 ○ Heating Setpoint: 68°
  - 14 ○ Cooling Setpoint: 68°

15  
16 Provide a DDC space temperature sensor to control, in sequence, a VAV modulating electronic control  
17 valves (in parallel) for the hot water reheat coil and radiant floor electronic control valve.

18  
19 When space temperature is below setpoint, the hot water radiation floor valve shall modulate open as a first  
20 source of heat to maintain space temperature. On a further drop in space temperature, the reheat coil valves  
21 shall modulate open in parallel. The reverse shall occur when space temperature is above setpoint. Provide  
22 a discharge air temperature sensor for monitoring purposes.

23  
24 When the space temperature rises above setpoint, and the space is at “low” airflow, the supply air terminals  
25 and exhaust air terminals shall modulate open in parallel, maintaining their “offset” to maintain space  
26 temperature setpoint. On a drop in space temperature below setpoint, the reverse shall occur until the  
27 supply air terminals and exhaust air terminals reach their minimum airflows.

28  
29 The radiant floor control valve shall be locked out whenever the outside air is above 50° F (adj.).

30  
31 Space temperature sensor shall have a manual override button that shall index the space to the occupied  
32 mode for a period of two hours (adj.). If an occupancy sensor is specified, it shall index the terminal unit  
33 DDC controller to occupied mode for a minimum of 30 minutes (adj.).

#### 34 35 144C – MORGUE TECH

36 System consists of:

- 37 • Supply air variable air volume terminal with:
  - 38 ○ Hot water reheat coil and associated 2-way or 3-way modulating TCV.
  - 39 ○ Discharge air temperature sensor.
- 40 • Infloor hot water radiation with:
  - 41 ○ 2-way modulating temperature control valve.
  - 42 ○ In-floor temperature sensor.
- 43 • DDC Space Thermostat with temperature override button.

44 Provide a DDC space temperature sensor to control, in sequence, a modulating electronic control valve for  
45 the hot water reheat coil and actuator for terminal air flow. When space temperature is below setpoint the  
46 radiant floor valve shall open to maintain setpoint. If setpoint cannot be maintained, the reheat coil valve  
47 shall modulate open.

48  
49 The reverse shall occur when space temperature is above setpoint. The heating coil valve shall be  
50 commanded closed whenever the associated AHU is off. Provide a discharge air temperature sensor for  
51 monitoring purposes.

52  
53 Airflow shall remain constant for pressurization.

1 Each space temperature sensor shall have a manual override button that shall index the space to the  
2 occupied mode for a period of two hours (adj.).

3  
4 Provide separate adjustable cooling and heating setpoints for both the occupied and unoccupied modes.  
5 When the space temperature is between the heating and cooling setpoints, the heating valve shall be closed  
6 and the airflow at heating and cooling minimum flow.

7  
8 The radiant floor hot water valve shall be locked out whenever outside air is above 50° F (adj.).  
9

#### 10 144D – TISSUE RECOVERY

11 System consists of:

- 12 • Supply air variable air volume terminals (VAV-2-12) with:
  - 13 ○ Hot water reheat coil and associated 2-way or 3-way modulating TCV.
  - 14 ○ Discharge air temperature sensor.
- 15 • Infloor hot water radiation with:
  - 16 ○ 2-way modulating temperature control valve.
  - 17 ○ In-floor temperature sensor.
- 18 • Exhaust air valves
  - 19 ○ EV-11 – General Exhaust
- 20 • DDC Space Thermostat with temperature override button.
- 21 • DDC Space Humidistat
- 22 • Wall Mounted High/Low Ventilation Air Switch
  - 23 ○ Low Ventilation Switch with Amber Pilot Light
  - 24 ○ High Ventilation Switch with Green Pilot Light
  - 25 ○ Red Pilot Light – Alarm
- 26  
27 • Wall Mounted Pressure Switch
  - 28 ○ Negative Ventilation Switch with Red Pilot Light
  - 29 ○ Positive Ventilation Switch with Green Pilot Light

30  
31 Design Intent: This space shall primarily function as a positively pressurized space in relation to the  
32 adjacent space. When activated by the wall mounted pressure switch, the space will change from positive  
33 pressure to negative pressure in related to the adjacent space.

34  
35 During periods where procedures being performed in the space, the airflow shall be “high”. During periods  
36 when the space is inactive, the airflow shall be “low”.

37  
38 During periods where tissue recovery is being performed in the space, the space shall be at a positive  
39 pressure in relation to the adjacent spaces.

40  
41 During periods where the space is being used as an autopsy room, the space shall be at a negative pressure  
42 in relation to the adjacent space.

43  
44 When the space is positively pressurized, 200 cfm shall transfer out of the space.

45  
46 When the space is negatively pressurized, 525 cfm shall transfer into the space.

47  
48 The space shall have 4 airflow modes of operation:

- 49 • A1 – Day / Occupied Building – “Inactive” – Low Ventilation – Positive Pressure
- 50 • A2 – Day / Occupied Building – “Active” – High Ventilation – Positive Pressure.
- 51 • A3 – Day / Occupied Building – “Active” – High Ventilation – Negative Pressure.
- 52 • B1 – Night / Unoccupied Building – “Inactive” – Low Ventilation. – Positive Pressure
- 53 • B2 – Night / Unoccupied Building – “Active” – High Ventilation – Positive Pressure.
- 54 • B3 – Night / Unoccupied Building – “Active” – High Ventilation – Negative Pressure.

1 Wall mounted high/low ventilation switch shall be labelled as follows:

- 2 • “High Airflow” – Green Pilot Light
- 3 • “Low Airflow” – Amber Pilot Light
- 4 • “Alarm” – Red Pilot Light

5  
6 At all times, the pilot lights shall reflect current space airflow (“low” or “high”).

7  
8 Wall mounted pressure switch shall be labelled as follows:

- 9 • “Negative Pressure” – Red Pilot Light
- 10 • “Positive Pressure” – Green Pilot Light

11  
12 At all times, the pilot lights shall reflect current space pressure (“negative” or “positive”).

13  
14 Airflow Schedule (Adj.): The schedule shall default to “low” airflow and positive pressure at all times.

- 15 • VAV-2-12 shall be at minimum airflow.
- 16 • EV-11 shall be at minimum airflow.

17  
18 Temperature Schedule: The temperature schedule shall be as follows (adj.):

- 19 • Building “Occupied”: 6:00am – 6:00pm
  - 20 ○ Heating Setpoint: 68°
  - 21 ○ Cooling Setpoint: 75°
- 22 • Building “Unoccupied”: 6:00pm – 6:00am
  - 23 ○ Heating Setpoint: 65°
  - 24 ○ Cooling Setpoint: 78°
- 25 • Whenever in “high” airflow mode:
  - 26 ○ Heating Setpoint: 68°
  - 27 ○ Cooling Setpoint: 72°

28  
29 “High” Airflow Positive Pressure Activation: The system shall be manually indexed to “high” airflow and positive pressure via the wall mounted ventilation and air pressure switches. Once manually activated to “high” airflow, the system shall be timed to operate at high airflow and positive pressure for 4 hours (adj) before automatically being indexed back to “low” airflow and positive pressure by the building automation system.

30  
31  
32  
33  
34  
35 “High” Airflow Negative Pressure Activation: The system shall be manually indexed to “high” airflow and negative pressure via the wall mounted ventilation and air pressure switches. Once manually activated to “high” airflow, the system shall be timed to operate at high airflow and positive pressure for 4 hours (adj) before automatically being indexed back to “low” airflow and positive pressure by the building automation system.

36  
37  
38  
39  
40  
41 Provide a DDC space temperature sensor to control, in sequence, a VAV modulating electronic control valves (in parallel) for the hot water reheat coil and radiant floor electronic control valve.

42  
43  
44 When space temperature is below setpoint, the hot water radiation floor valve shall modulate open as a first source of heat to maintain space temperature. On a further drop in space temperature, the reheat coil valves shall modulate open in parallel. The reverse shall occur when space temperature is above setpoint. Provide a discharge air temperature sensor for monitoring purposes.

45  
46  
47  
48  
49 When the space temperature rises above setpoint, and the space is at “low” airflow, the supply air terminals and exhaust air terminals shall modulate open in parallel, maintaining their “offset” to maintain space temperature setpoint. On a drop in space temperature below setpoint, the reverse shall occur until the supply air terminals and exhaust air terminals reach their minimum airflows.

50  
51  
52  
53  
54 The radiant floor control valve shall be locked out whenever the outside air is above 50° F (adj.).

1 Space temperature sensor shall have a manual override button that shall index the space to the occupied  
2 mode for a period of two hours (adj.). If an occupancy sensor is specified, it shall index the terminal unit  
3 DDC controller to occupied mode for a minimum of 30 minutes (adj.).  
4

#### 5 **CHILLER ROOM VENTILATION (EF-5 and UH-9)**

6 The ventilation system consists of:

- 7 • Variable volume exhaust fan with motorized damper and variable frequency drive VFD-12  
8 (motorized damper by 23 34 00).
- 9 • Motorized 2 position outside air intake damper (damper by Section 23 09 14).
- 10 • Hot water unit heater.
- 11 • 2-way, 2 position low voltage control valve for UH-9 by 23 09 14.
- 12 • Strap on thermostat for unit heater.
- 13 • DDC temperature sensors for EF-5 / UH-9.
- 14 • Refrigeration detection and monitoring system.

15  
16 When the space temperature rises above setpoint (85°F adj.), the motorized outside air damper shall open,  
17 the exhaust fan motorized damper shall open and the fan shall be energized at its lowest fan speed. On a  
18 continued rise in space temperature above setpoint, the fan speed shall increase proportionally until the  
19 variable speed drive is at 100%. At all times UH-9 shall be off and control valve closed.  
20

21 On a drop in space setpoint temperature, the reverse shall occur until the exhaust fan is “off”, exhaust fan  
22 motorized damper is closed and outside air damper is closed.  
23

24 On a further drop below space temperature setpoint (65°F adj.), and hot water is available, the hot water  
25 unit heater control valve shall open and the unit heater fan shall cycle on. The reverse shall occur on a rise  
26 in space temperature above setpoint.

27 When the refrigerant detection and monitoring system senses a refrigerant leak, three different levels of  
28 alarm will be initiated by the refrigerant detection and monitoring system.

- 29 • Level 1 Alarm: The refrigeration and detection system will notify the BAS. The BAS will initiate  
30 an alarm.
- 31 • Level 2 Alarm: The refrigeration and detection system will notify the BAS. The BAS will initiate  
32 an alarm. The outside air damper shall open, the exhaust fan motorized damper shall open and the  
33 exhaust fan shall be energized at its maximum speed. Upon the alarm being “cleared”, the exhaust  
34 fan shall turn “off”, the exhaust fan motorized damper shall close and the outside air damper shall  
35 close.
- 36 • Level 3 Alarm: The refrigeration and detection system will notify the BAS. The BAS will initiate  
37 an alarm. The outside air damper shall open, the exhaust fan motorized damper shall open and the  
38 exhaust fan shall be energized at its maximum speed. Upon the alarm being “cleared”, the exhaust  
39 fan shall turn “off”, the exhaust fan motorized damper shall close and the outside air damper shall  
40 close.  
41

#### 42 **EXHAUST FAN (EF-1)**

43 System consists of:

- 44 • Roof mounted exhaust fan.
- 45 • Motorized backdraft damper (normally closed)

46  
47 The exhaust fan shall be interlocked with AHU-1. When AHU-1 is in the “occupied” mode, EF-1  
48 motorized damper shall open and fan shall energize.  
49

50 When AHU-1 is in the “unoccupied” mode, EF-1 shall turn “off” and motorized damper shall close.  
51

1 EXHAUST FAN (EF-2)

2 This is a variable air volume exhaust system serves laboratory exhaust.

3  
4 System consists of:

- 5 • Two exhaust fans with variable frequency drives.
- 6 • Two isolation air dampers (dampers by 23 34 00, actuators by 23 09 14).
- 7 • Two outside air bleed dampers (dampers by 23 34 00, actuators by 23 09 14).
- 8 • Sensors:
  - 9 ○ Exhaust duct static pressure sensor.
  - 10 ○ Exhaust duct high static limit sensor.

11  
12 FAN CONTROL:

13 Current Status Switch: Provide for all exhaust fans and set up as described under GENERAL, Current  
14 Switch Setup, in this Section.

15  
16 Start/Stop: The DDC system shall start the exhaust fans via their VFD's. One exhaust fan shall operate and  
17 second fan will be a standby fan that shall only run if required by a failure of first fan.

18  
19 Lead Fan Selection: There will be one fan designated lead and one standby fan. Lead fan selection shall be  
20 based on rotational sequencing. Provide a single software point that shall designate the lead fan.

21  
22 Shutdown Service Switch: Provide a software point and hardware switch located inside the control panel  
23 for each fan to be taken out of service that will initiate the shutdown sequence for the fan. If the lag fan is  
24 available, it's start sequence shall be initiated and come into control before the shutdown sequence for the  
25 fan being taken out of service is stopped.

26  
27 Exhaust Fan Start/Stop Sequencing: Sequence fans on based on exhaust fan flow and outside air bleed  
28 damper position in the order designated by the Lead Fan Selection sequence. If a fan has failed or has been  
29 designated "out of service" per the sequence below, the next fan in sequence will initiate its start sequence  
30 without delay.

31  
32 Minimum exhaust fan speed shall maintain minimum exhaust ejection velocity by maintaining a minimum  
33 flow of 6875 CFM. The DDC controller shall prevent the exhaust fan from falling below this minimum  
34 speed to prevent the ejection velocity from falling below design.

35  
36 When starting a fan, command the fan to start and run at minimum speed set in the VFD. When fan status  
37 is proven on, command the isolation damper open and release the fan to control. If a fan status does not  
38 prove on or the isolation damper end switch does not prove open within 2 minutes (adj.) of the fan start or  
39 damper open commands, command the exhaust fan off and the isolation damper closed, latch out this  
40 exhaust fan, and send an exhaust fan failure alarm through the DDC system. Provide a manual push-button  
41 switch located in the control panel and a software point to reset the shutdown latch out of the fan.

42  
43 When stopping a lag fan, command the damper to close and ramp the fan down to minimum speed at the  
44 same rate as the damper actuator stroke time (typically 90 seconds). After the fan is at minimum speed and  
45 the damper end switch indicates the damper is closed, command the fan off.

46  
47 When switching lead fans and stopping a lag fan, prove operation of the new lead fan and allow 2 minutes  
48 (adj.) for the fan to come up to speed before initiating the stop fan sequence. Provide a software point for  
49 each fan to be taken out of service that will initiate the shutdown sequence for the fan. If there is a lag fan  
50 that is available, the fan start sequence shall be initiated and come into control before the shutdown  
51 sequence for the fan being taken out of service is stopped.

52  
53 The above sequences may need to be modified to prevent static pressure variances as specified General,  
54 Parallel Fan Bumpless Transfer sequence. This may entail adjusting minimum speeds and/or ramping  
55 dampers or fans at different rates than specified above.



1     **STATIC PRESSURE CONTROL:**

2     Exhaust Fan Speed Control: The purpose of the exhaust fan control is to maintain a minimum static  
3     pressure in the exhaust ductwork to insure proper terminal air box operation. Install a static pressure  
4     sensing probe(s) in the main exhaust duct located at approximately  $\frac{3}{4}$  of the way down the main exhaust  
5     duct and the reference input shall sense the actual space served by the air system located in the ceiling  
6     below the duct probe. Pipe to the differential pressure transmitter that shall be located in the unit  
7     temperature control panel. The DDC system shall modulate the exhaust fan VFD's and outside air bleed  
8     dampers in sequence to maintain the static pressure setpoint as sensed by the static pressure probe(s). As  
9     exhaust airflow requirements decrease and the static pressure becomes more negative than setpoint,  
10    decrease the exhaust fans VFD speed signals simultaneously and in parallel to maintain the static pressure  
11    setpoint until the minimum fan flow setpoint is reached. If the static pressure continues to fall, modulate  
12    open the outside air bleed dampers (in parallel, if more than one) to maintain the static pressure setpoint. If  
13    static pressure continues to fall below setpoint, stage off a lag exhaust fan as described in the Exhaust Fan  
14    Start/Stop Sequencing.

15  
16    As exhaust airflow requirements increase and duct static pressure becomes less negative than setpoint, the  
17    fans will continue to operate at their minimum fan flow setpoints and the outside air bleed dampers shall be  
18    modulated closed to maintain duct static setpoint. When the outside air bleed dampers are fully closed, the  
19    exhaust fans will then be modulated up in speed to maintain static. If exhaust airflow requirements  
20    continue to increase and duct static pressure cannot be maintained, initiate the start sequence for the next  
21    lag fan as described in the Exhaust Fan Start/Stop Sequencing.

22  
23    If multiple sensors are used, the DDC system shall maintain the static pressure setpoint at the lowest  
24    reading sensor. If the static sensors deviate by more than 0.5 in. w.c. (adj.), an alarm shall be sent through  
25    the DDC system. Static pressure setpoint shall be as described in the Static Pressure Setpoint Control  
26    below.

27  
28    Constant Static Pressure Setpoint Control: The duct static pressure shall be controlled to maintain a  
29    negative 1.0 in. w.c. Final setpoint shall be determined by the Balancing Contractor to satisfy the worst  
30    case zone at maximum design condition.

31    Static Pressure Setpoint Reset Control: Static pressure setpoint shall be reset using Trim & Respond logic  
32    within the range of negative 0.6 in. w.c. to 1.3 in. w.c. When the fan is off, the setpoint shall be reset to 1.0  
33    in. w.c. (adj.) and this setpoint shall be used on system start up. While the fan is proven on, every two  
34    minutes, trim the setpoint by raising the setpoint 0.04 in. w.c. if there are two or fewer zone pressure  
35    requests. If there are more than two zone pressure requests, respond by lowering the setpoint by 0.06 in.  
36    w.c.

37  
38    A zone pressure request is generated when an exhaust VAV damper is greater than 95% open until it drops  
39    to 80% open. Provide a binary data enable point for each zone to enable/disable the zone damper in the  
40    trim and respond algorithm. All setpoints, timers, and zone pressure request threshold for the static  
41    pressure reset shall be adjustable. Tune the reset to prevent cyclic instability after the space is occupied.  
42    Provide a trend graph to show the relative stability of the static pressure setpoint. Final maximum setpoint  
43    shall be determined by the Balancing Contractor to satisfy the worst case zone at maximum design  
44    condition.

45  
46    Exhaust Plenum High Static Pressure Control: Install a static pressure probe located in the exhaust fan  
47    plenum or common exhaust ductwork between the fan isolation dampers and the heat reclaim coil outlet  
48    isolation dampers and pipe to a differential pressure sensor located in the temperature control panel. This  
49    sensor shall override the speed signal to exhaust fan VFD's to limit the static pressure to negative 6" w.c.  
50    (adj.) (this setpoint should be set to the pressure class of the ductwork). This override control shall reduce  
51    the speed below the minimum exhaust fan minimum flow setpoints if necessary. If this control is invoked,  
52    send an exhaust plenum low pressure alarm to the DDC system.

53

1 Exhaust System Low Pressure Limit: Install a static pressure probe located in the exhaust fan plenum or  
2 common exhaust ductwork between the fan isolation dampers and the heat reclaim coil outlet isolation  
3 damper and pipe to a differential pressure switch located in the temperature control panel. Wire in series  
4 with the safety circuit of the exhaust fans VFD's. Differential pressure switch shall be a manual reset type  
5 and the DDC system shall monitor the status of the differential pressure switch. Initial setpoint shall be -  
6 negative 8.0" w.c. (adj.) (this setpoint should be set to two inches more negative than the pressure class of  
7 the ductwork).

8  
9 **EXHAUST FAN (EF-3)**

10 System consists of:

- 11 • Indoor mounted in-line exhaust fan.
- 12 • Motorized backdraft damper (normally closed)

13  
14 The exhaust fan shall operate continuously 24 hrs day / 7 days week / 365 days year.

15  
16 When the fan is "on", the motorized damper shall be open. When the fan is "off", the motorized damper  
17 shall be closed.

18  
19 **EXHAUST FAN (EF-6)**

20 System consists of:

- 21 • Roof mounted exhaust fan.
- 22 • Motorized backdraft damper (normally closed)

23  
24 The exhaust fan shall be interlocked with AHU-3. When AHU-3 is in the "occupied" mode, EF-6  
25 motorized damper shall open and fan shall energize.

26  
27 When AHU-3 is in the "unoccupied" mode, EF-6 shall turn "off" and motorized damper shall close.

28  
29 **EXHAUST FAN (EF-7)**

30 This system serves the electrical room.

31  
32 System consists of:

- 33 • Roof mounted exhaust fan.
- 34 • Motorized backdraft damper (normally closed)
- 35 • Motorized outside air damper (normally closed).
- 36 • DDC Space Thermostat.

37  
38 Fan shall be normally "off", fan motorized damper closed and outside air damper closed.

39  
40 When the space temperature rises above setpoint (85°F adj.), the motorized outside air damper shall open,  
41 the exhaust fan motorized damper shall open and the fan shall be energized. At all times UH-10 shall be  
42 off and control valve closed.

43  
44 On a drop in space setpoint temperature, the reverse shall occur until the exhaust fan is "off", exhaust fan  
45 motorized damper is closed and outside air damper is closed.

46  
47 **CABINET UNIT HEATERS (CUH-1 and CUH-2):**

48 Each system consists of:

- 49 • DDC space thermostat by 23 09 14.
- 50 • 2-way, 2 position low voltage control valve by 23 09 14.
- 51 • Strap on pipe thermostat.

52  
53 Cabinet unit heaters shall be controlled thru the BAS.

1 On a drop below space temperature setpoint (65°F adj.), and hot water is available, the control valve shall  
2 open and the fan shall cycle on. The reverse shall occur on a rise in space temperature above setpoint.

3  
4 The strap on thermostat shall be mounted on the hot water return line, set at 100° F (adj.). The unit fan  
5 shall not be permitted to run unless the hot water temperature is above strap on thermostat setpoint.

6  
7 **HOT WATER UNIT HEATERS (UH-1 thru UH-8 and UH-10)**

8 Each system consists of:

- 9 • Hot water unit heater.
- 10 • DDC space thermostat by 23 09 14.
- 11 • 2-way, 2 position low voltage control valve by 23 09 14.
- 12 • Strap on pipe thermostat.

13  
14 Unit heaters shall be controlled thru the BAS.

15  
16 Cabinet unit heaters shall be controlled thru the BAS.

17  
18 On a drop below space temperature setpoint (60°F adj.), and hot water is available, the control valve shall  
19 open and the fan shall cycle on. The reverse shall occur on a rise in space temperature above setpoint.

20  
21 The strap on thermostat shall be mounted on the hot water return line, set at 100° F (adj.). The unit fan  
22 shall not be permitted to run unless the hot water temperature is above strap on thermostat setpoint.

23  
24 Unit heaters shall be locked out and not operate at outside air temperatures above 60° F (adj.).

25  
26 **CONVECTORS (C-1 and C-2):**

27 Each system consists of:

- 28 • DDC space thermostat by 23 09 14.
- 29 • 2-way, 2 position low voltage control valve by 23 09 14.

30  
31 Convectors shall be controlled thru the BAS.

32  
33 On a drop below space temperature setpoint (65°F adj.), the control valve shall open. The reverse shall  
34 occur on a rise in space temperature above setpoint.

35  
36 **EMERGENCY GENERATOR STAGING / OPERATION:**

37 When the emergency generator is indicted to be in operation, as sensed by the state of the emergency  
38 generator transfer switch, the building automation system shall stage “on” HVAC equipment as follows:

39  
40 Group 1

- 41 • All exhaust fans, supply fans and air handlers.

42  
43 Group 2

- 44 • All CRAC units and associated condensing units.

45  
46 Group 3

- 47 • All heating pumps and boilers.

48  
49 Group 4

- 50 • Chiller, associated condensing units and all chilled water pumps.

51  
52 Group 5

- 53 • All other HVAC motors and equipment.

1 Coordinate all time delays between groups and motor groups with generator manufacturer and electrical  
2 contractor.

3

4

END OF SECTION

1  
2  
SECTION 23 57 00  
HEAT EXCHANGERS FOR HVAC

PART 1 - GENERAL

SCOPE

This section includes specifications for shell and tube heat exchangers and plate heat exchangers. Included are the following topics:

PART 1 - GENERAL

- Scope
- Related Work
- Reference
- Reference Standards
- Quality Assurance
- Submittals
- Operation and Maintenance Data

PART 2 - PRODUCTS

- Plate Heat Exchangers

PART 3 - EXECUTION

- Installation
- Plate Heat Exchangers

RELATED WORK

- Section 01 91 01 – Commissioning Process
- Section 23 21 13 - Hydronic Piping

REFERENCE

Applicable provisions of Division 1 govern work under this section.

REFERENCE STANDARDS

ASME Boiler and Pressure Vessel Code VIII - Rules for Construction of Pressure Vessels-Latest Edition.

QUALITY ASSURANCE

Refer to division 1, General Conditions, Equals and Substitutions

SUBMITTALS

Refer to division 1, General Conditions, Submittals.

Include data concerning dimensions, capacities, and material of construction.

OPERATION AND MAINTENANCE DATA

All operations and maintenance data shall comply with the submission and content requirements specified under section GENERAL REQUIREMENTS.

PART 2 - PRODUCTS

PLATE HEAT EXCHANGERS

Manufactures: Alfa Laval, Bell & Gossett, Graham, ITT Standard, Taco or approved equal.

1 Plate and frame type with gasketed heat transfer channel plates mounted on carrying bars and held between  
2 a stationary frame plate and a moveable pressure plate. Design pressure of 150 psig at 230 degrees F in  
3 each circuit with no pressure in the other circuit. Heat exchangers shall be constructed and stamped in  
4 accordance with the latest ASME Pressure Vessel Code Section VIII.

5  
6 316 stainless steel corrugated channel plates with one piece Nitrile or EPDM gaskets (whichever material  
7 suitable for the fluids used). Gaskets may be glued or non-glued type. Provide relieving grooves on  
8 gaskets to prevent cross contamination between fluids. Provide OSHA compliant aluminum splashguard  
9 over channel plate rack.

10  
11 Carbon steel pressure plates with enamel paint or epoxy coating. Plates shall not require additional  
12 stiffeners for support. Carbon steel carrying bars with zinc yellow chromate finish or epoxy coated finish.

13  
14 Studded port type pipe connections to accept ANSI flanges for 3" and larger. Carbon steel NPT tapings or  
15 stainless steel NPT nozzles for connections 2" and smaller. Factory seal all connections prior to shipment to  
16 prevent entrance of foreign material.

17  
18 Provide heat exchangers with capacities and operating characteristics indicated on drawings.  
19  
20

## 21 PART 3 - EXECUTION

### 22 INSTALLATION

23  
24 Install units as shown on plans, as detailed, and according to manufacturer's installation instructions.  
25 Provide clearance around units as shown on the drawings and as recommended by the manufacturer for  
26 service access. Provide elbows, flanges and unions on piping to allow for servicing heat exchangers.

### 27 PLATE HEAT EXCHANGERS

28  
29 Bolt to concrete pad. Apply grease to the threaded surfaces of the compression bolts and cover with plastic  
30 sleeving.

31  
32 END OF SECTION

SECTION 23 84 13  
HUMIDIFIERS

PART 1 - GENERAL

SCOPE

This section includes specifications for humidifiers. Included are the following topics:

PART 1 - GENERAL

- Scope
- Related Work
- Reference
- Quality Assurance
- Submittals
- Operation and Maintenance Data

PART 2 - PRODUCTS

- Short Absorption Dispersion Grids
- Electric Steam Humidifiers (Electrode Type)
- Electric Steam Humidifiers (Resistive Element Type)

PART 3 - EXECUTION

- Short Absorption Dispersion Grids
- Evaporative Humidifiers

RELATED WORK

- Section 01 91 01 – Commissioning Process
- Section 23 09 14 - Pneumatic and Electric Instrumentation and Control Devices for HVAC

REFERENCE

Applicable provisions of Division 1 govern work under this Section.

QUALITY ASSURANCE

Refer to division 1, General Conditions, Equals and Substitutions.

SUBMITTALS

Refer to division 1, General Conditions, Submittals.

Include data concerning dimensions, capacities, materials of construction, ratings, weights, wiring diagrams, and appropriate identification.

OPERATION AND MAINTENANCE DATA

All operations and maintenance data shall comply with the submission and content requirements specified under section GENERAL REQUIREMENTS.

PART 2 - PRODUCTS

SHORT ABSORPTION DISPERSION GRIDS

Manufacturers: Armstrong, Dri-Steem, Nortec, Pure Humidifier or approved equal.

1 Factory-assembled steam dispersion unit shall include the following components:

- 2 1. Steam supply header/separator.
- 3 2. Condensate collection header.
- 4 3. Steam dispersion tubes spanning distance between two headers.

5  
6 Each dispersion tube shall be fitted with steam discharge nozzles inserted into tube wall. Each nozzle shall  
7 be metallic or thermoplastic material designed for high steam temperatures. Two rows of nozzles in each  
8 dispersion tube shall discharge steam in diametrically opposite directions, perpendicular to airflow.

9  
10 Each nozzle shall extend through wall of and into center of dispersion tube and contain steam orifice sized  
11 for its required steam capacity.

12  
13 Furnish unit complete with normally closed [pneumatic, electric] control valve, inlet strainer, float and  
14 thermostatic trap sized in accordance with manufacturer's recommendations.

15  
16 Each packaged humidifier panel assembly of tubes and headers shall be contained within galvanized metal  
17 casing to allow duct mounting, or to facilitate stacking of and/or end-to-end mounting of multiple  
18 humidifier panels in ducts or air handling unit casings.

19  
20 Tubes and headers shall be 304 stainless steel and be welded.

## 21 ELECTRIC STEAM HUMIDIFIERS

22 Manufacturers: Dri-Steem, Armstrong, Nortec, Carel, Pure Humidifier Co. or approved equal.

23  
24  
25 Unit shall be self contained, electric steam generating humidification system. Steam shall be generated by  
26 boiling off [softened water][purified RO/DI water].

27  
28 Unit shall be completely pre-wired and include built-in transformer to provide 24 volt supply for control  
29 circuit. Provide fused disconnect switch.

30  
31 Vaporizing chamber, cover and fittings shall be constructed of series 300 stainless steel with welded seams  
32 and fitted for quick access for cleaning. Immersion Heaters shall be INCOLOY alloy-sheathed resistance  
33 type designed for no more than 80 watts per square inch. A single element shall be provided for each  
34 electrical phase.

35  
36 Electronic water level control system shall provide for automatic refill, low water cut off and skimmer  
37 bleed-off functions. System shall consist of:

- 38 1. Water level sensing unit comprised of three Teflon-coated stainless steel probes screwed into  
39 threaded probe head.
- 40 2. A solenoid operated fill valve factory mounted on front of the humidifier.
- 41 3. Microprocessor controls.
- 42 4. Heater Protection:
  - 43 a. First step shall be low water probe. In the event of failure, second step shall be a manual  
44 reset over-temperature switch factory installed on the humidifier.]

45  
46 Surface water skimmer system shall be furnished to provide for optimum precipitated mineral removal with  
47 minimum water waste.

48  
49 Control cabinet shall be UL-and CUL-listed JIC enclosure. Control devices shall be mounted on sub-panel  
50 within enclosure isolated from vaporizing chamber. Control devices shall include microprocessor,  
51 magnetic contactor for each heater group, control circuit transformer, fuses for each heater, numbered  
52 terminal strip and all internal wiring. As-built wiring diagram is to be included.

53  
54 Microprocessor controls shall be factory mounted and wired in humidifier control panel. Mounting  
55 instructions and wiring diagram shall be included. The following features and functions shall be provided:



- 1 1. LED fault indicator. Performs software self diagnosis at every start-up.
- 2 2. Water make-up valve control and low-water safety shut down.
- 3 3. Auto drain valve and drain/flush sequence whereby microprocessor accumulates actual
- 4 humidifying "on" time, and activates auto drain/flush sequence.
- 5 4. End of season drain.
- 6 5. Switch on microprocessor board for, "AUTO", "STANDBY", "DRAIN", "TEST".
- 7 6. Airflow proven switch.
- 8 7. 100% solid state, power controller shall be mounted and wired in control cabinet. A compatible
- 9 humidity sensor shall be shipped loose for field installation in return duct. System shall modulate
- 10 humidifier output from 0% to 100% of maximum capacity.
- 11 8. A two position high limit humidistat shall be shipped loose for field installation. Humidistat shall
- 12 sense humidity level within duct and protect against saturation of air stream.
- 13

14 Unit shall communicate with building automation system using BACnet communication protocol.

15 Furnish associated steam distribution tube.

16 Furnish unit with condensate after cooler.

17

18

19

20

21

22

### PART 3 - EXECUTION

#### 23 SHORT ABSORPTION DISPERSION GRIDS

24 Mount units in air handling units or ductwork as indicated on the drawings. Provide additional duct  
25 reinforcing or support required for the humidifier body and/or distribution manifold(s). Install piping  
26 specialties and controls as detailed and in accordance with manufacturer's instructions.

27

28 Install steam and condensate branch lines with a minimum of three elbows to allow for expansion and  
29 contraction. Use pipe size indicated on drawings or recommended by the manufacturer, whichever is  
30 larger. Ream pipe and blow out at full steam pressure before making final connection to humidifier.

31

32 Mount units in air handling units or ductwork with sufficient elevation to drain condensate by non-  
33 pressurized gravity condensate lines. Condensate from this type of dispersion grid shall not be wasted to  
34 drain. Install condensate piping and specialties as detailed and in accordance with manufacturer's  
35 instructions.

36

#### 37 ELECTRIC STEAM HUMIDIFIERS

38 Mount manifold(s) in air handling units or ductwork as indicated on the drawings with proper pitch for  
39 condensate drainage. Mount steam generating cylinder assembly and control panel on wall or angle iron  
40 stand where indicated. Provide duct reinforcing or support required for the humidifier body and/or  
41 distribution manifold(s) as required. Install piping specialties and controls as detailed and in accordance  
42 with manufacturer's instructions. Install make-up water line with solenoid control and shutoff valves,  
43 coordinating final connection point with the Plumbing Contractor. Install drain line to nearest drain  
44 location or as indicated on the drawings.

45

46

47

END OF SECTION

Page Intentionally Left Blank

SECTION 27 60 00

RADIO REINFORCEMENT

PART 1 - GENERAL

1.01 SCOPE

- A. Conditions of the Contract and portions of Division One of this Project Manual apply to this Section as though repeated herein.

1.02 GENERAL REQUIREMENTS

- A. Provide a complete operating VHF radio reinforcement system as herein specified.
- B. The radio reinforcement system shall provide access to the DaneCom radio communications system at a level of -95dBm throughout 95% of the building.
- C. The installation will comply with all FCC requirements.

1.03 SUBMITTALS

- A. Submit product data:

- 1. Bidirectional amplifiers (BDA)
- 2. Distributed Antenna devices
- 3. Coaxial Cable (plenum)
- 4. Splitters and directional couplers
- 5. Other components necessary to complete the system

- B. Submit the following information:

- 1. Maintenance agreements
- 2. Qualifications
- 3. Proposed installation schedule
- 4. Wiring diagram with wiring requirements indicated
- 5. Floor plans indicating locations of distributed antennas, splitters, routing of cables, and locations of donor antenna and BDA. Overlay coverage radii indicating -95dBm signal strength.
- 6. Wall elevation showing equipment to be mounted on telephone backboard in IT Room.
- 7. Detail of antenna grounding and surge suppression.
- 8. Detail of antenna mounting.

1.04 GENERAL

- A. All products provided by Contractor shall be new and unused, and shall be of manufacturer's current and standard production.
- B. Where two or more equipment items of the same kind are provided, all shall be identical and provided by the same manufacturer.
- C. Specifications indicate major system components and does not show every component, connector, module or accessory that may be required to support the operation specified. Contractor shall provide all components needed for complete and satisfactory operation.

1.05 REGULATIONS

- A. Codes, regulations and standards referenced in the Section are:

- 1. NFPA 70- The National Electrical Code
- 2. 47 CFR Part 90.219-2007 Private Land Mobile Radio Services-Use of Signal Boosters

3. FCC's OET 65 Standards "Guidelines for Human Exposure to Radio Frequency Electromagnetic Fields".
4. FCC Rules Part 22, Part 90 and Part 101.

#### 1.06 QUALIFICATIONS

- A. Contractor: Company specializing in installing products as specified in this section with a minimum of five (5) years documented experience. Provide a list of installations of similar size with bid documents.
- B. Contractor shall prove their ability to install and maintain similar systems.
- C. Contractor shall show evidence that they can provide the necessary maintenance support for the proposed system. This should include:
  1. Identification of adequate staffing to meet stated response time to minimize system down time.
  2. List recent customer references that have had similar systems installed in a similar environment.
  3. Specify which office(s) shall be responsible for maintaining the system.
  4. Identify the number of technicians in the supporting office who have been factory trained on installation and maintenance.
- D. The contractor/installer of the selected system is solely responsible for all equipment, software, etc., and third-party contractors used in any and all capacities, as they relate to meeting all codes, OSHA requirements, compatibility, etc. The installer shall assume all responsibilities in meeting these requirements, laws, compatibility needs, etc.
- E. Certain products specified may only be available through factory-authorized dealers and distributors. Contractor shall verify his ability to procure the products specified prior to submitting a proposal.
- F. Obtain radio system components from a single source who assumes responsibility for compatibility of system components.

#### 1.07 COORDINATION

- A. Coordinate work with all other trades at site.
- B. Coordinate with City of Madison Radio Shop. Contact Dave Nachreiner at 608-266-4150.

#### 1.08 INTEGRATOR

- A. Materials and layout assistance is available from:

General Communications  
2880 Commerce Park Drive  
Madison, Wisconsin 53719  
Contact Rick Krasnowski (phone 608-310-7114)

#### 1.09 DEFINITIONS

- A. Delivered Audio Quality Definitions (DAQ): this is a universal standard often cited in system designs and specifications.
  1. DAQ 1: Unusable, speech present but unreadable.
  2. DAQ 2: Understandable with considerable effort. Frequent repetition due to noise/distortion.
  3. DAQ 3: Speech understandable with slight effort. Occasional repetition required due to noise/distortion.
  4. DAQ 3.5: Speech understandable with repetition only rarely required. Some noise/distortion.
  5. DAQ 4: Speech easily understood. Occasional noise/distortion.
  6. DAQ 4.5: Speech easily understood. Infrequent noise distortion.

1           7.     DAQ 5: Speech easily understood. Coupled Bonding Conductor (CBC) – The term “Coupled  
2           Bonding Conductor”: shall mean a bonding conductor placed, e.g. strapped, on the outside of  
3           any technology cable, used to suppress transient noise.

4     B.     FCC: Federal Communications Commission

5     C.     OET 65 Standards: FCC’s Bulletin 65 provides Guidelines for Human Exposure to Radio Frequency  
6           Electromagnetic Fields.

7     1.10   WARRANTY

8     A.     Contractor warrants that all work furnished (material and labor) under this contract will be of good  
9           quality, free from faults and defects, and in conformance with the Project Drawings and Specifications.

10    B.     Contractor shall provide a parts and labor guarantee on all work. Unless otherwise specified herein,  
11           Contractor’s guarantee shall be for a period of two years from date of acceptance, except where any  
12           specific guarantees from a supplier or equipment manufacturer extends for a longer time.

13    C.     Contractor’s guarantee shall cover all costs associated with troubleshooting, repair and replacement of  
14           defective work, including costs of labor, transportation, lodging, materials and equipment.

15    D.     Guarantee shall not cover any damage to material or equipment caused by accident, misuse, unauthorized  
16           modification or repair by Client or acts of God.

17    E.     Contractor shall promptly respond to Client’s requests for service during the guaranteed period.  
18           Contractor shall repair service as soon as reasonably possible upon request from client.

19    PART 2 - PRODUCTS

20    2.01   AMPLIFIER

21    A.     Bi-Directional Amplifier

22	Manufacture:	EMR
23	Model #:	840622/1SC-10
24	Down Link Frequency:	154.0925 -155.8575 MHZ
25	Up Link Frequency:	158.745 - 159.3075 MHZ
26	Frequency Range:	150-174 MHz
27	Gain:	60 dB
28	Composite Power Uplink:	31 dBm
29	RF Connectors:	N Female
30	Composite Power Downlink:	31 dBm
31	Maximum Passband:	1.5
32	Passband Separation (MHz):	3.5
33	Noise Figure (U/L, D/L):	4dB
34	Item Height:	7.25 in
35	Item Width:	12 in
36	Item Length:	16 in
37	Temperature Range:	-30-60 deg C
38	Item Weight:	52 lb

39    2.02   DOOR ANTENNA

40    A.     Outside Donor Antenna:

41	Manufacture:	PCTEL
42	Model #:	MYA1503K

43    B.     Provide 2” Rigid Conduit stubbed out 48” above the roof from the IT room with a 2” weather head. This  
44           will be used to route donor antenna cable and will be used to mount the antenna.

- 1 C. Specific Frequency: 150-174 MHz
- 2 D. Gain dBi: 9.2 dBi
- 3 E. Gain dBd: 7.1 dBd
- 4 F. Polarization: Linear
- 5 G. Vertical Beamwidth: 57 deg
- 6 H. Horizontal Beamwidth: 72 deg
- 7 I. Maximum VSWR: 1.5:1
- 8 J. Maximum Power: 250 W
- 9 K. Lightning Protection: DC Ground
- 10 L. RF Connectors: N Female
- 11 M. Jumper Included: No
- 12 N. Type of Hardware Included: MYK1 Mount
- 13 O. Maximum Rated Wind Velocity: 100 mile/h
- 14 P. Item Length: 42 in
- 15 Q. Item Weight: 3 lb

16 2.03 DISTRIBUTED ANTENNA DEVICES

- 17 A. Through –hole ceiling mount
- 18 B. Omnidirectional 360° horizontal
- 19 C. Beamwidth 80 degrees vertical, nominal
- 20 D. Impedance: 50 ohm
- 21 E. With plenum rated pigtail cable
- 22 F. Regulatory compliance: RoHS 2002/95/EC
- 23 G. VSWR: less than 1.8:1.

24 2.04 AIR DIELECTRIC, PLENUM RATED CABLE:  
25

- 26 A. Material Characteristics:
  - 27 1. Jacket: Halogenated, Fire-Retardant
  - 28 2. Outer Conductor Material: Corrugated Aluminum or Corrugated Copper
  - 29 3. Inner Conductor Material: Copper-Clad Aluminum Wire
  - 30

- 1 B. Electrical Characteristics:
- 2 1. Impedance:  $50 \pm 2.0 \Omega$
- 3 2. Frequency Band: 1 - 8800 MHz
- 4 3. Peak Power Rating:  $\geq 40.0 \text{ kW}$

- 5 C. Mechanical Characteristics:
- 6 1. Diameter Over Jacket:  $\leq .627 \text{ in}$
- 7 2. Minimum Bending Radius:  $\leq 5 \text{ in}$
- 8 3. One Time Minimum Bending Radius:  $\leq 3 \text{ in}$

- 9 D. Attenuation Characteristics:

Frequency (MHz)	Attenuation (dB/100ft)
150	$\leq 0.848$
450	$\leq 1.53$
800	$\leq 2.105$
2000	$\leq 3.564$

11 Standard Conditions: VSWR 1.0, ambient temperature 20 °C (68 °F)

12

13 2.05 FOAM DIELECTRIC CABLE:

- 14 A. Material Characteristics:

- 15
- 16 1. Jacket: Non-halogenated, Fire-Retardant Ployolefin
- 17 2. Outer Conductor Material: Corrugated Copper
- 18 3. Inner Conductor Material: Copper-Clad Aluminum Wire or Copper Tube

- 19 B. Electrical Characteristics:

- 20 1. Impedance:  $50 \pm 1.0 \Omega$
- 21 2. Frequency Band: 1/2" Nominal: 1 - 8800 MHz, 7/8" Nominal: 1 - 5000 MHz
- 22 3. Peak Power Rating:  $\geq 40.0 \text{ kW}$

- 23 C. Mechanical Characteristics:

- 24 1. Diameter Over Jacket: 1/2" Nominal:  $\leq .630 \text{ in}$ , 7/8" Nominal:  $\leq 1.1 \text{ in}$
- 25 2. Minimum Bending Radius: 1/2" Nominal:  $\leq 5 \text{ in}$ , 7/8" Nominal:  $\leq 10 \text{ in}$
- 26 3. One Time Minimum Bending Radius: 1/2" Nominal:  $\leq 2 \text{ in}$ , 7/8" Nominal:  $\leq 5 \text{ in}$

- 27 D. Attenuation Characteristics: 1/2" Nominal

Frequency (MHz)	Attenuation (dB/100ft)
150	$\leq 0.815$
450	$\leq 1.447$
800	$\leq 1.968$
2000	$\leq 3.251$

28

29 Standard Conditions: VSWR 1.0, ambient temperature 20 °C (68 °F)

1 E. Attenuation Characteristics: 7/8" Nominal:

2

Frequency (MHz)	Attenuation (dB/100ft)
150	≤ 0.417
450	≤ .744
800	≤ 1.014
2000	≤ 1.683

3  
4

Standard Conditions: VSWR 1.0, ambient temperature 20 °C (68 °F)

5 2.06 SPLITTERS, COMBINERS, COUPLERS, COAX JUMPERS AND CONNECTORS:

6 A. As required.

7 PART 3 - EXECUTION

8 3.01 SYSTEM STARTUP

9 A. Power shall only be applied to the system after re-checking for proper grounding of the system and  
10 measuring all loops for lack of shorts, grounds, and open circuits.

11 B. System supplier shall be responsible for coordinating all programming of the system with the Owner.

12 3.02 OWNER'S INSTRUCTIONS

13 A. Contractor shall closely schedule and coordinate his activities with the Owner's Project Representative.

14 B. Coordinate with the owner all operating, and monitoring functions which shall be included within the  
15 programming.

16 3.03 COMMISSIONING

17 A. After all work is completed and prior to requesting acceptance test, Contractor shall conduct a final  
18 inspection and pre-test all equipment and system features. Contractor shall correct any deficiencies  
19 discovered as the result of the inspection and pre-test of all contractor installed equipment and materials.

20 B. Contractor shall submit a request for the acceptance test in writing to the Owner's Project Representative  
21 no less than fourteen days prior to the requested test date. The request for acceptance test shall be  
22 accompanied by a certification from Contractor that all work is complete and has been pre-tested, and  
23 that all corrections have been made.

24 C. During acceptance test, Contractor shall demonstrate all equipment and system features to the Owner's  
25 Project Representative. Contractor shall remove covers, open wiring connections, operate equipment,  
26 and perform other reasonable work as requested by the Owner's Project Representative.

27 D. Any portions of the work found to be deficient or not in compliance with the Project Drawing and  
28 Specifications will be rejected. The Project Representative will prepare a list of any such deficiencies  
29 observed during the acceptance test. Contractor shall promptly correct all deficiencies. Upon correction  
30 of deficiencies, Contractor shall submit a request in writing to the Project Representative for another  
31 acceptance test.

32 E. Before final approval is issued, the Radio Reinforcement System shall be subject to a formal Acceptance  
33 Test Plan (ATP) of all components and the system as a whole: said plan to be developed to the  
34 satisfaction of Dane County. The ATP shall ensure that two-way coverage on each floor of the building  
35 meets the coverage requirements of these specifications.



1 The ATP shall consist of the following items:

2 1. RSSI-Radio Signal Strength Index

3 2. DAQ-Delivered Audio Quality

4 3.04 PREPARATION

5 A. Contractor shall order all required parts and equipment upon notification of award of the work.

6 B. Contractor shall verify power where required.

7 3.05 INSTALLATION

8 A. All components shall be securely mounted.

9 B. Contractor shall carefully follow the instructions in the manufacturers' Installation Manual to insure all  
10 steps have been taken to provide a reliable, easy to operate system.

11 C. Perform all work as indicated in the drawings and specifications.

12 3.06 WORKMANSHIP

13 A. Perform work with persons experienced and qualified to produce workmanship specified.

14 B. Comply with highest industry standards, except when specified requirements indicate more rigid  
15 standards or more precise workmanship.

16 C. Maintain quality control over suppliers and Subcontractors.

17 D. Quality of workmanship is considered important. The Project Representative will have the authority to  
18 reject work that does not conform to the Drawings and Specifications.

19 3.07 EQUIPMENT PRE-TEST

20 A. All equipment shall be bench tested prior to delivery to job site and prior to installation. Bench test per  
21 manufacturers installation instructions.

22 3.08 GROUNDING

23 A. Provide grounding of equipment as required by equipment manufacturer.

24 3.09 SPARE PARTS

25 A. Not included in the scope of this contract.

26

27


28

END OF SECTION 27 60 00


Page Intentionally Left Blank

LUDS LANE (DESIGN BY DANE COUNTY)

LUDS LANE

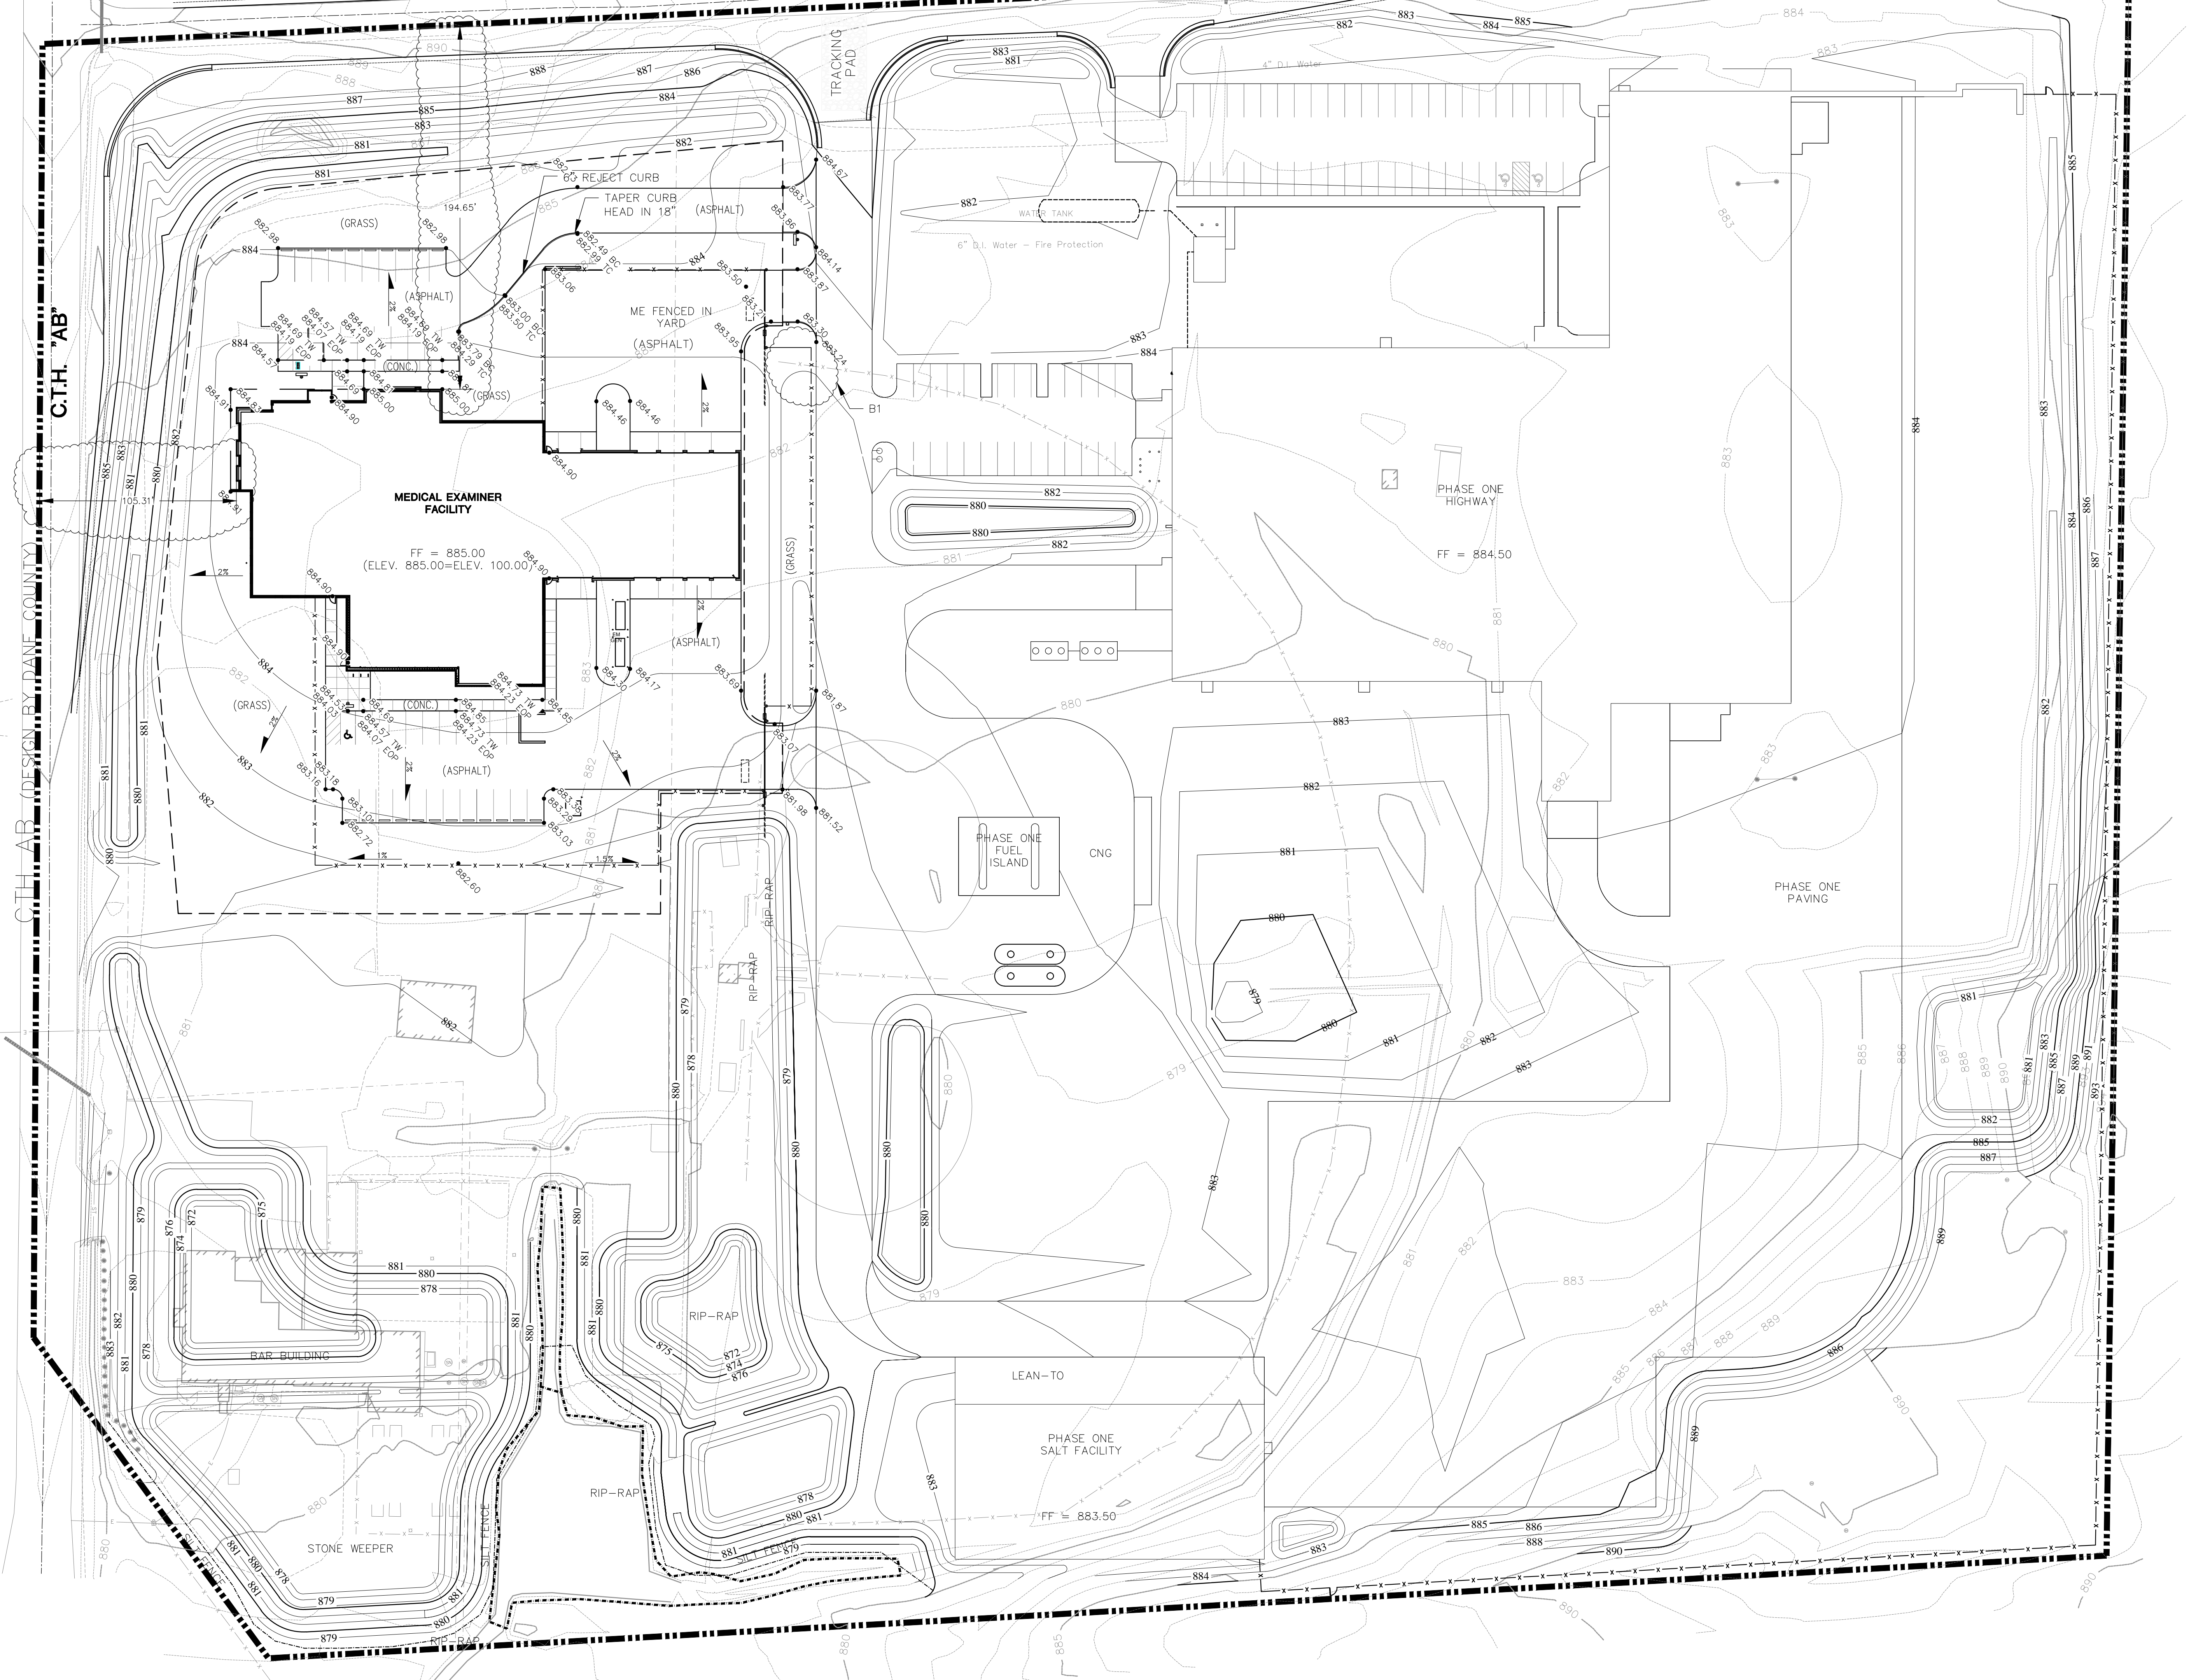

- LEGEND
- PROPERTY LINE
  - - - RIGHT-OF-WAY
  - - - EXISTING EASEMENT
  - EXISTING GRADE (5' CONTOUR)
  - EXISTING GRADE (1' CONTOUR)
  - EXISTING PAVED ROAD
  - EXISTING UNPAVED ROAD
  - EXISTING FENCE
  - - - LIMITS OF CONSTRUCTION
  - 883 PROPOSED GRADE (1' CONTOUR)
  - 880 PROPOSED GRADE (5' CONTOUR)
  - 884.30 PROPOSED SPOT ELEVATION
  - - - PROPOSED FENCE
  - EOP EDGE OF PAVEMENT
  - TW TOP OF WALK
  - TC TOP OF CURB
  - BC BOTTOM OF CURB

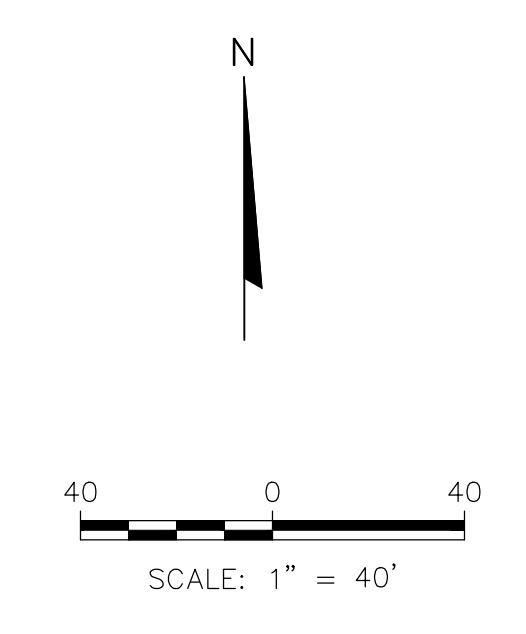

INFORMATIONAL BID PACKAGE B SCOPE OF WORK:  
 BID PACKAGE B INCLUDES THE AREA OF SITE GRADING DEFINED ON C100. BID PACKAGE A SCOPE IS SHOWN FOR REFERENCE. NOTE BID PACKAGE A INCLUDES THE CLEARING AND ROUGH GRADING WITHIN THIS BOUNDARY.

- GENERAL NOTES:
1. EXISTING CONDITIONS BASED ON PLAT OF SURVEY MAP PREPARED BY WISCONSIN MAPPING, LLC., DEERFIELD, WISCONSIN. DATE OF SURVEY IS MAY 5, 2013.
  2. DRAWING IS REFERENCED TO THE DANE COUNTY COORDINATE SYSTEM.
  3. PROPOSED GRADES ARE FINISH GRADE.
  4. REFER TO LANDSCAPE PLAN FOR VEGETATED RESTORATION.

C.T.H. "AB"

U.S.H. 12 & 18

**PROJECT**  
 MEDICAL EXAMINER  
 OFFICE BUILDING  
 (BID PACKAGE B)  
 3562 COUNTY HIGHWAY  
 AB  
 MC FARLAND, WI 53558  
**BID NO.**  
 313083

**DRAWING**  
 SITE GRADING PLAN


**DATE**  
 02.11.15

LUDS LANE (DESIGN BY DANE COUNTY)

LUDS LANE

C.T.H. "AB"

C.T.H. AB (DESIGN BY DANE COUNTY)

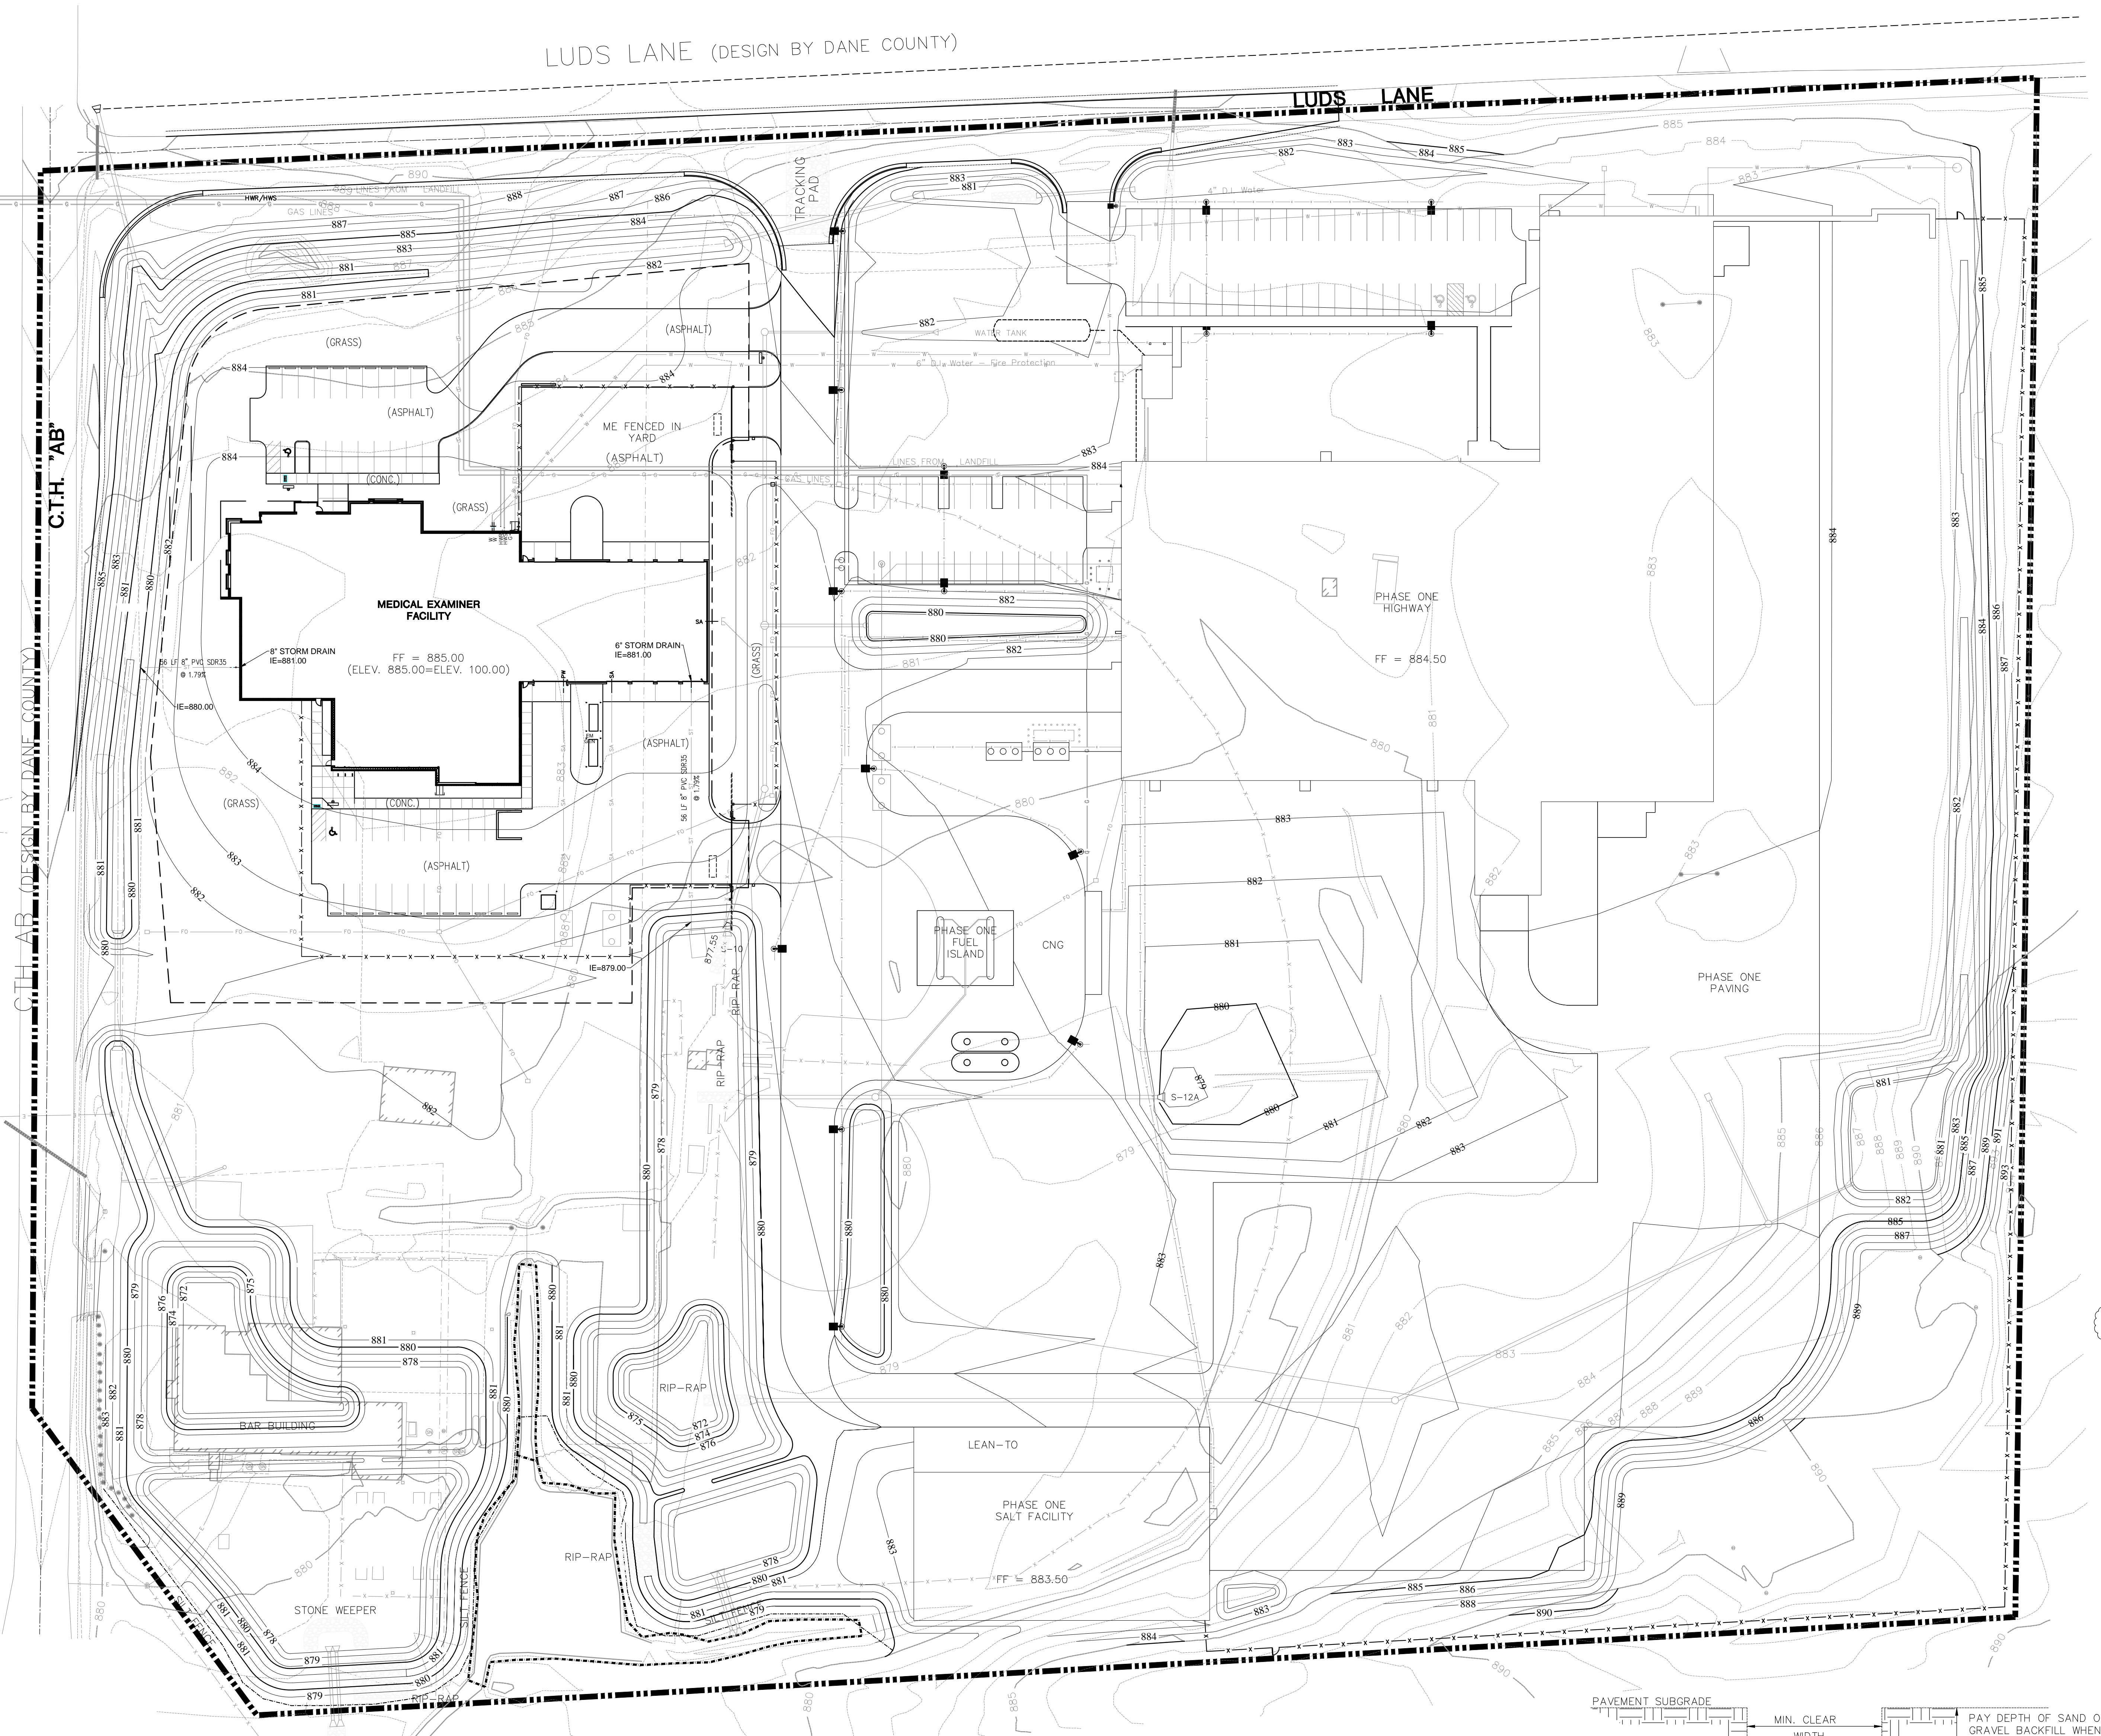


LEGEND


- PROPERTY LINE
- ADJACENT PARCEL LINE
- RIGHT-OF-WAY
- EXISTING EASEMENT
- EXISTING GRADE (5' CONTOUR)
- EXISTING GRADE (1' CONTOUR)
- EXISTING PAVED ROAD
- EXISTING UNPAVED ROAD
- FENCE
- ELECTRIC LINE
- STORM SEWER/CULVERT
- PROPOSED ELECTRIC
- PROPOSED FIBER OPTIC
- PROPOSED GAS
- PROPOSED SANITARY
- PROPOSED STORM
- PROPOSED WATER
- PROPOSED GLYCOL
- PROPOSED PROCESSED MEDICAL WASTE

INFORMATIONAL BID PACKAGE B SCOPE OF WORK:  
 BID PACKAGE B INCLUDES UTILITIES WITH 5'0" OF THE MEDICAL EXAMINER'S BUILDING; REFER TO BID PACKAGE A FOR CONTINUATION OF UTILITIES BEYOND THIS POINT. BID PACKAGE A UTILITIES ARE SHOWN FOR REFERENCE.

- NOTES:
- EXISTING CONDITIONS BASED ON PLAT OF SURVEY MAP PREPARED BY WISCONSIN MAPPING, LLC., SHEFFIELD, WISCONSIN, DATE OF SURVEY IS MAY 5, 2013.
  - DRAWING IS REFERENCED TO THE DANE COUNTY COORDINATE SYSTEM.
  - REFER TO ELECTRIC, PLUMBING AND MECHANICAL DRAWINGS FOR DETAILED UTILITY INFORMATION.

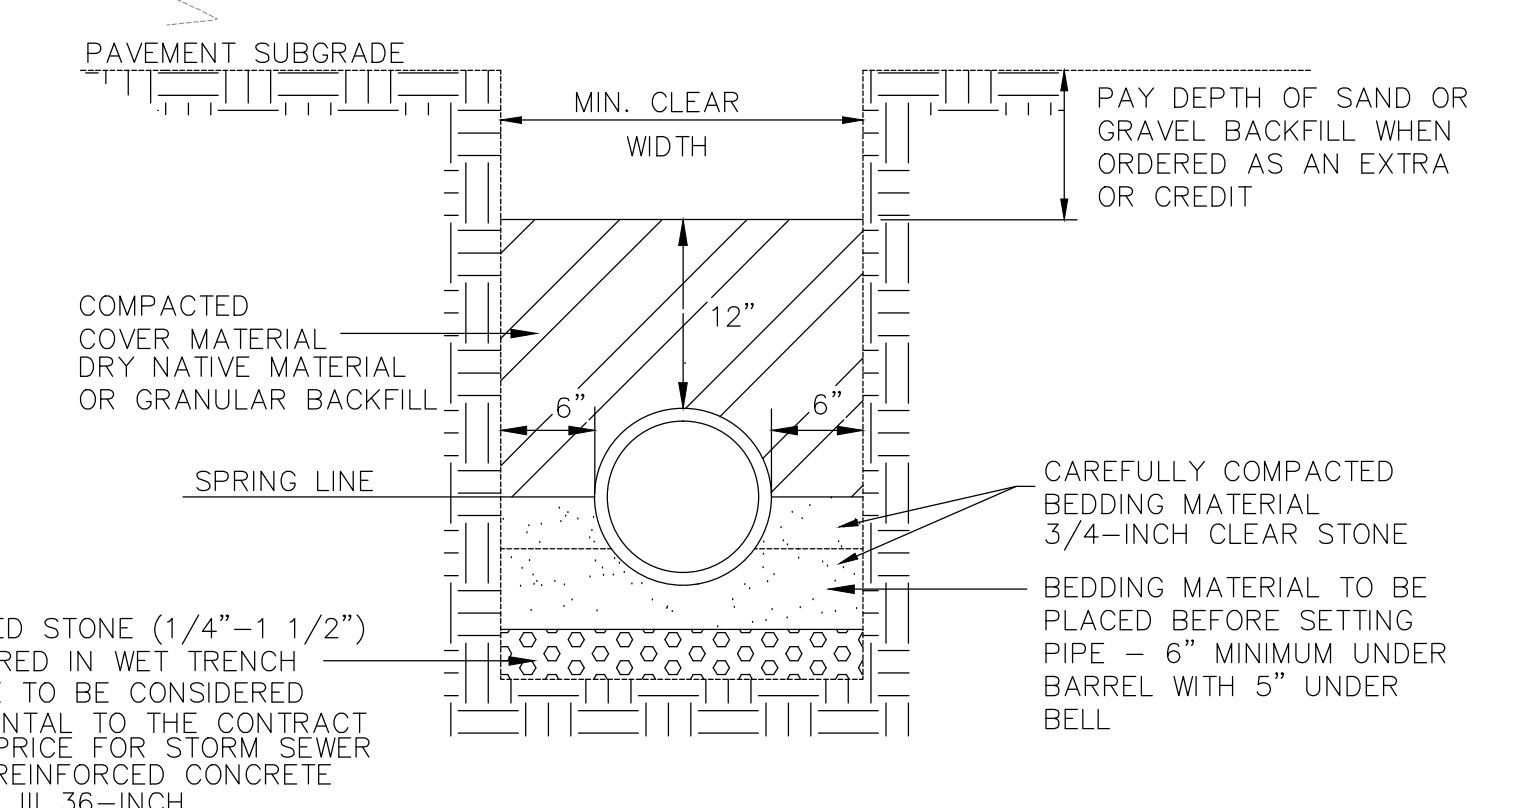

STORM SEWER PIPE BEDDING

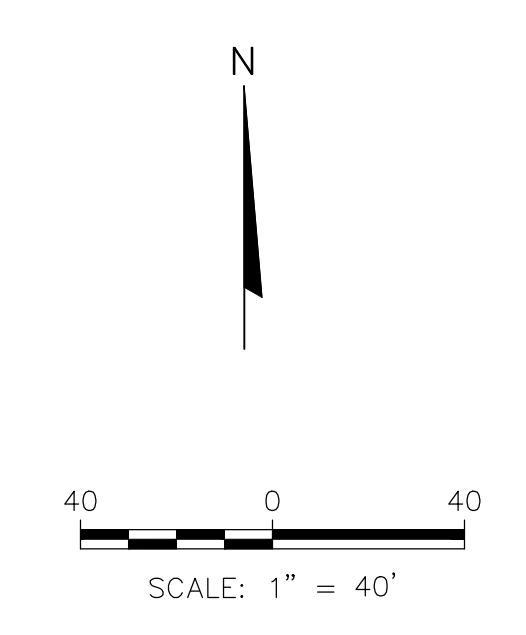


U.S. 12 & 18

**PROJECT**  
 MEDICAL EXAMINER  
 OFFICE BUILDING  
 (BID PACKAGE B)  
 3562 COUNTY HIGHWAY  
 AB  
 MC FARLAND, WI 53558  
**BID NO.**  
 313083


**DRAWING**  
SITE UTILITIES

**DATE**  
02.11.15

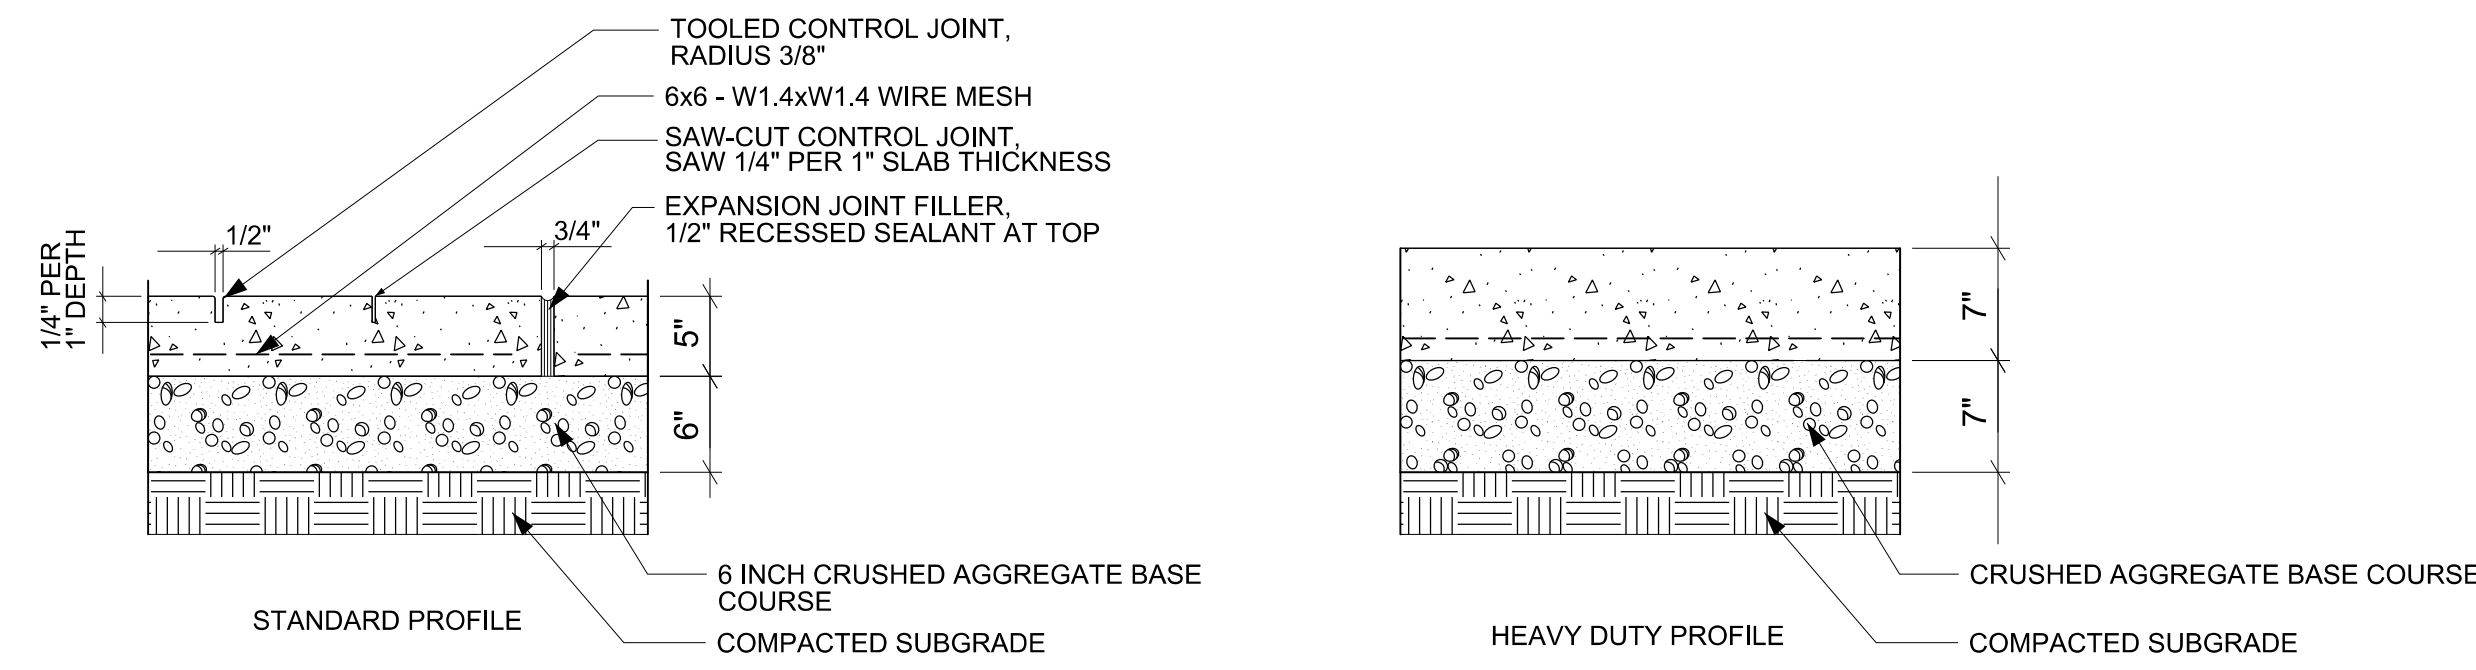


NOTE:  
1. MEDIUM BROOM FINISH PERPENDICULAR TO DIRECTION OF TRAVEL  
2. SEE LAYOUT PLAN FOR EXPANSION AND CONTROL JOINT SPACING AND PAVING PATTERN.  
3. PROVIDE EXPANSION JOINTS AT CONNECTIONS TO EXISTING SIDEWALK, CURB RAMPS, AT EITHER END OF FLUSH SIDEWALK FOR ACCESSIBLE STALLS, ALONG CURBS, STAIR LANDINGS, OR OTHER FIXED OBJECTS AND AT 30' MAX. SPACING.  
4. SEE 1/M601 FOR HEATED EXTERIOR SLAB DETAIL.


**1** CONCRETE PAVEMENT  
SCALE: 1"=1'-0"

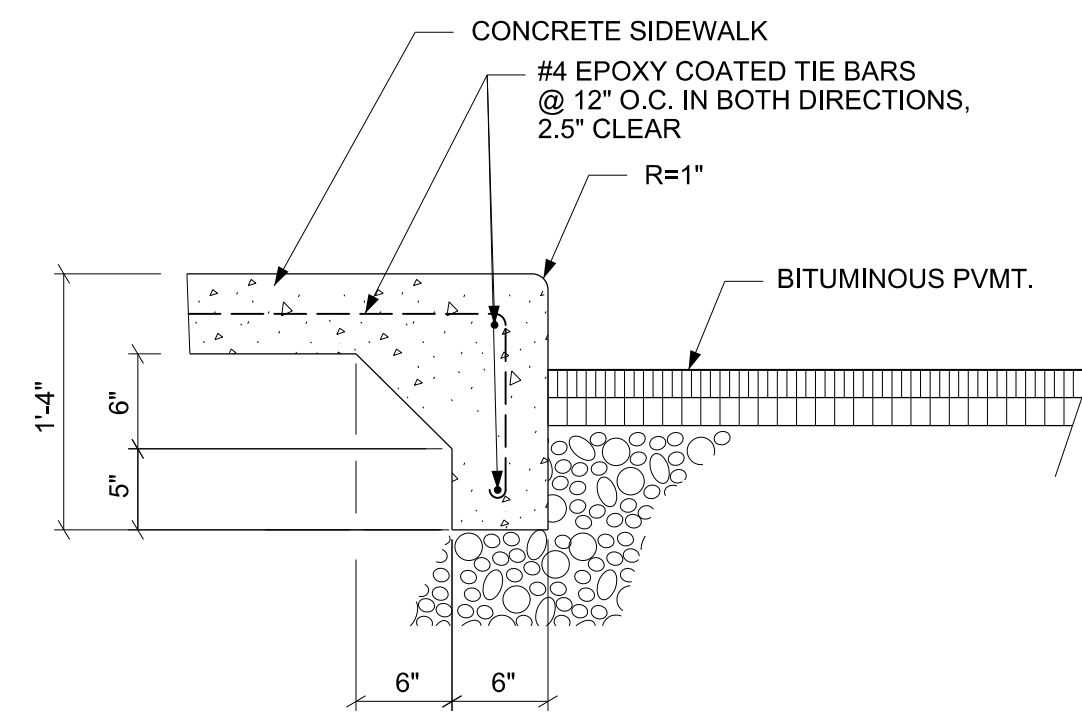


**2** THICKENED EDGE CONCRETE PAVEMENT  
SCALE: 1"=1'-0"

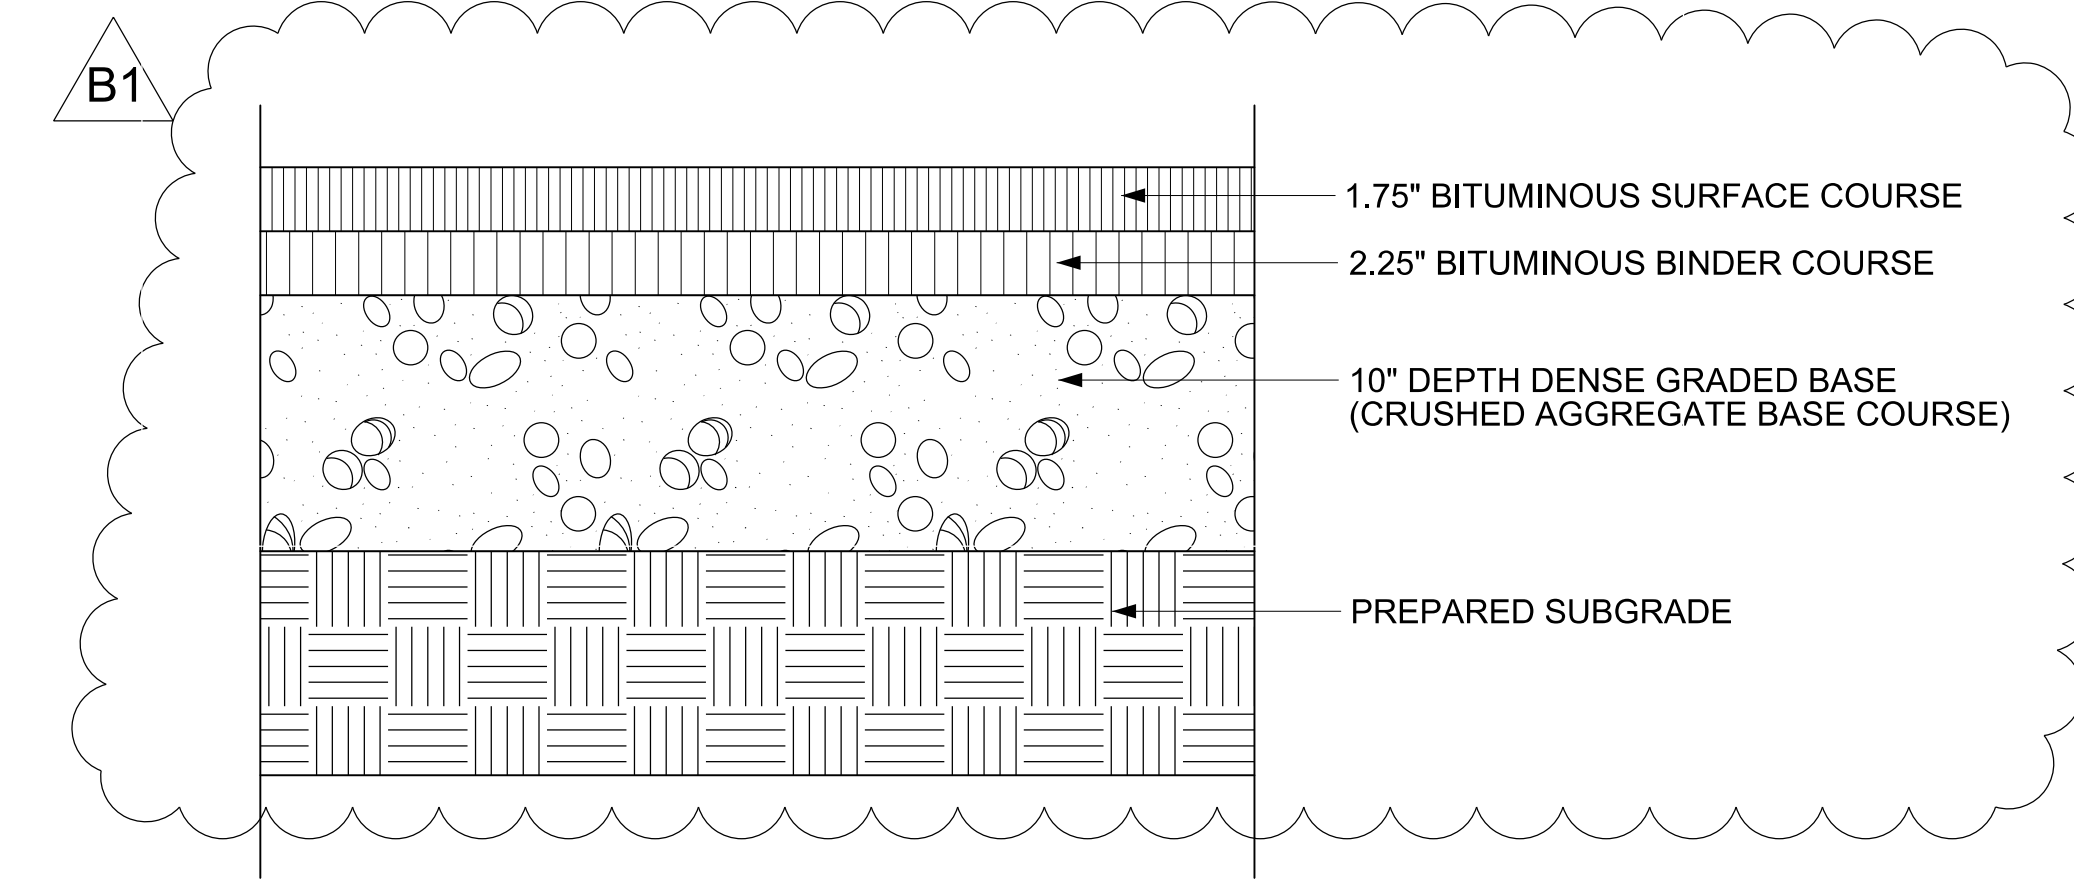


**3** ASPHALT PAVEMENT  
NTS

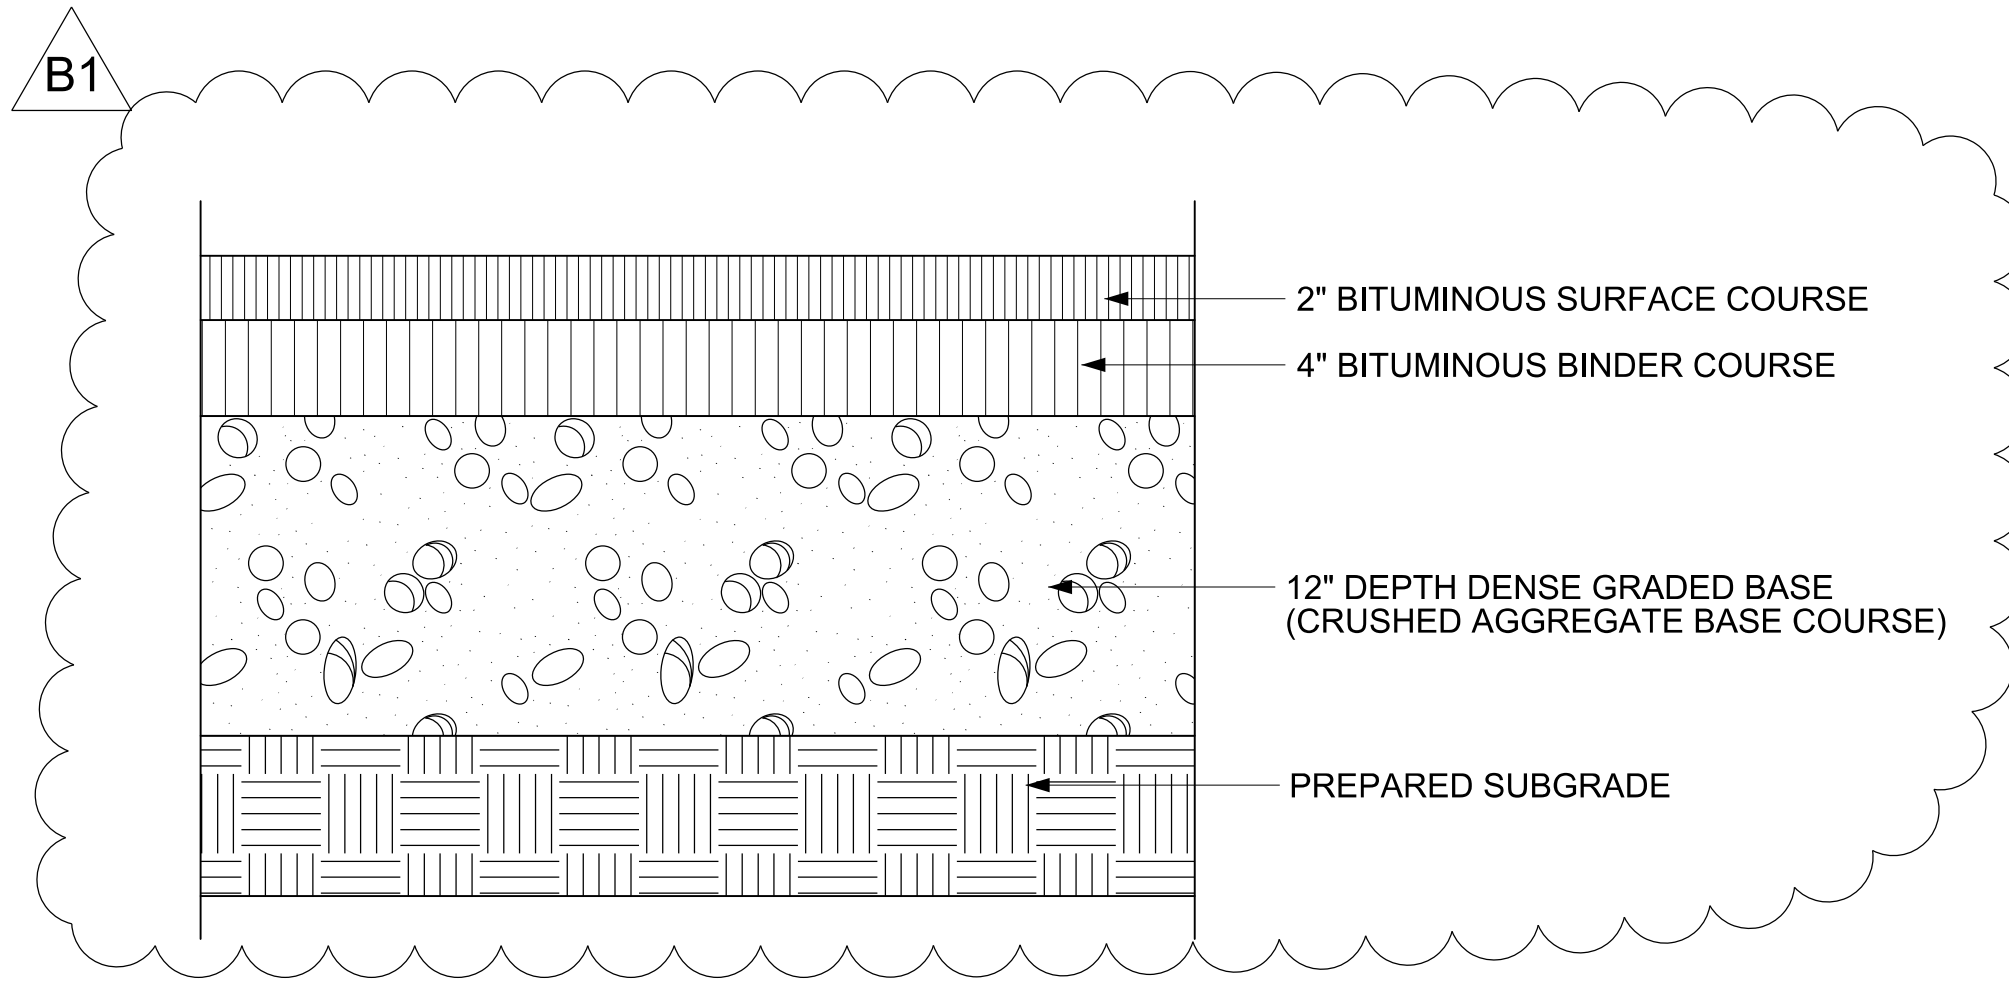


**4** HEAVY DUTY ASPHALT PAVEMENT  
NTS

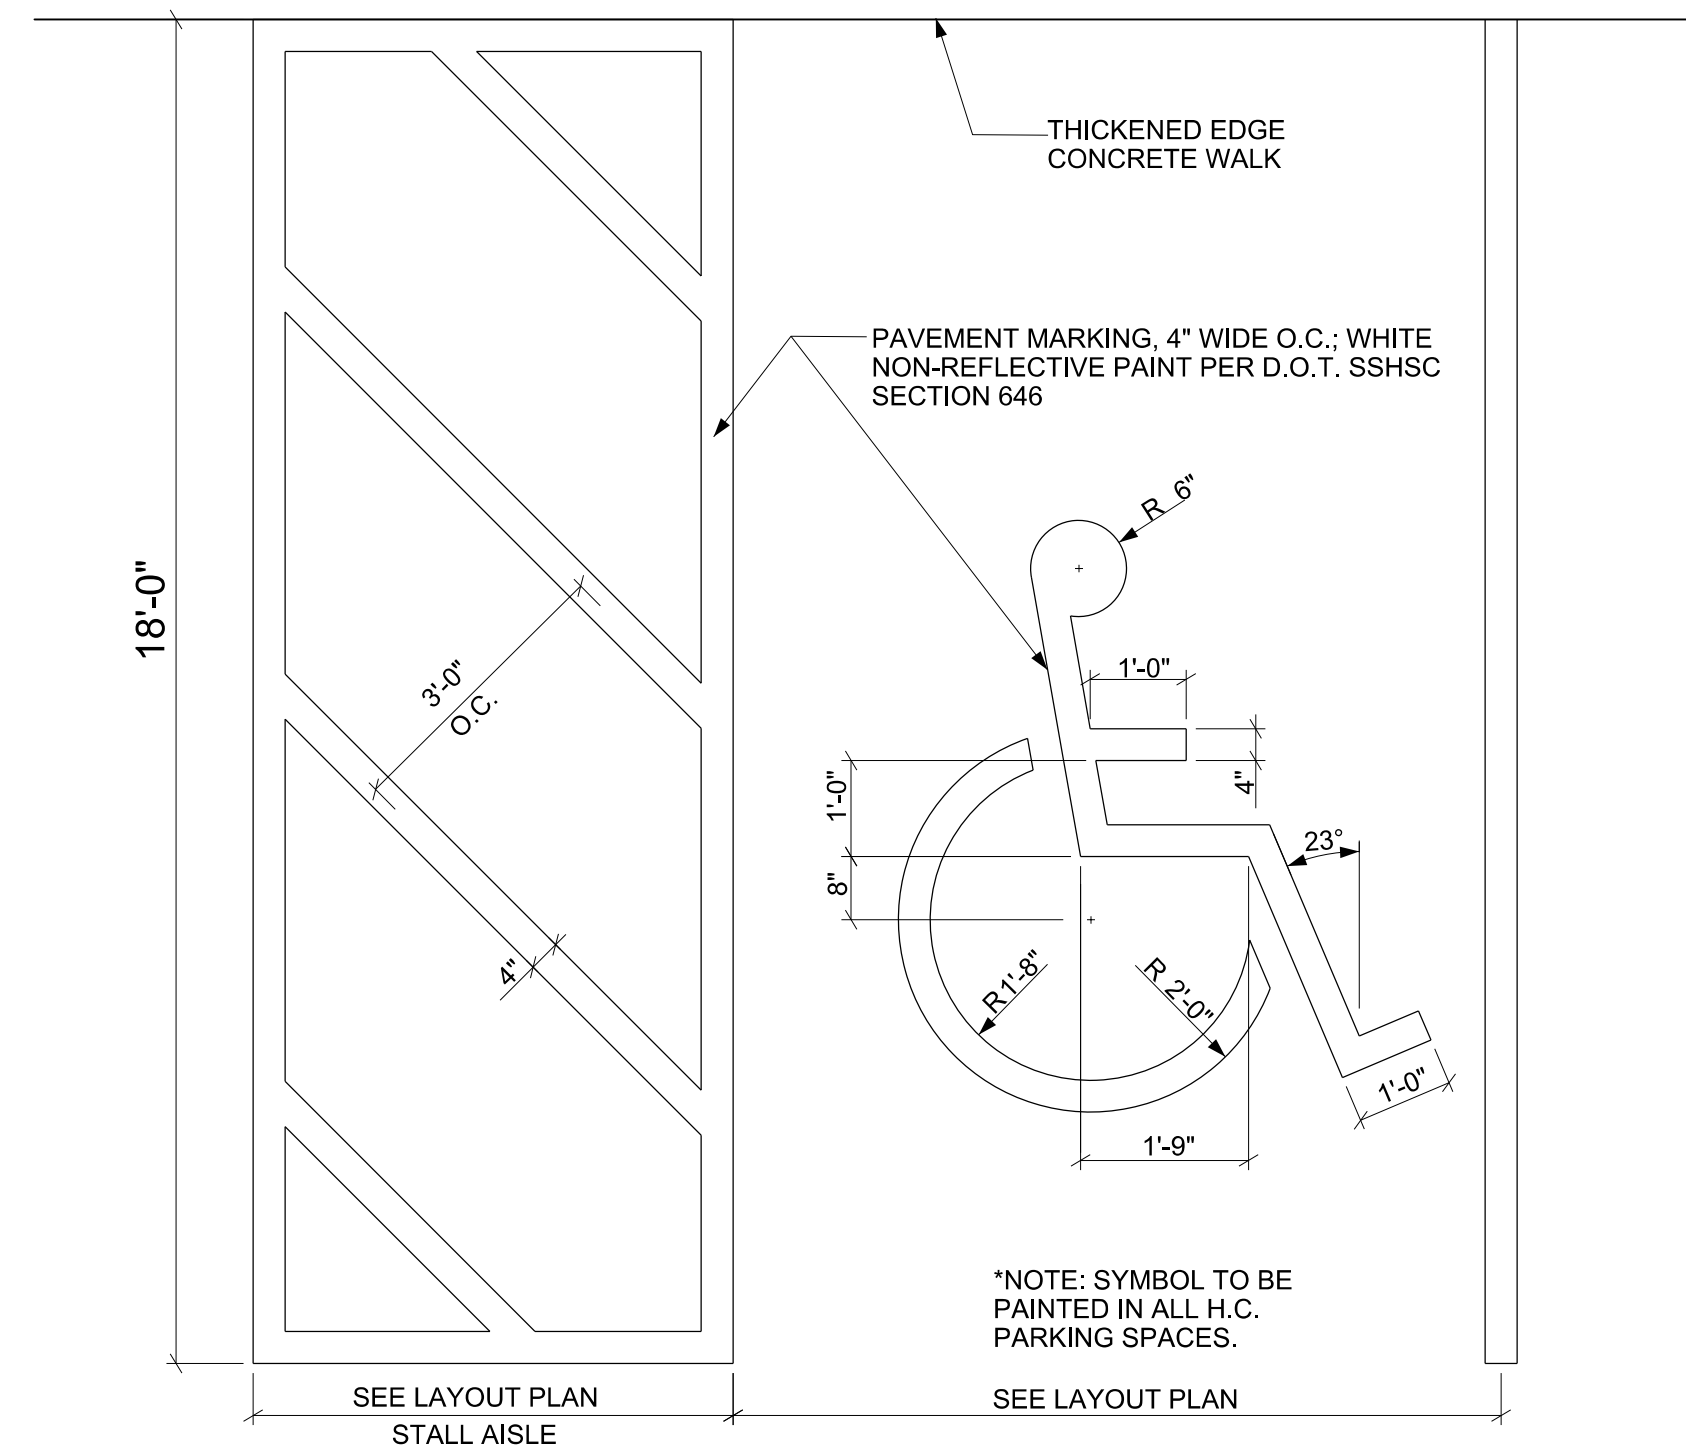


**5** ACCESSIBLE STALL LAYOUT  
SCALE: 1/2"=1'-0"

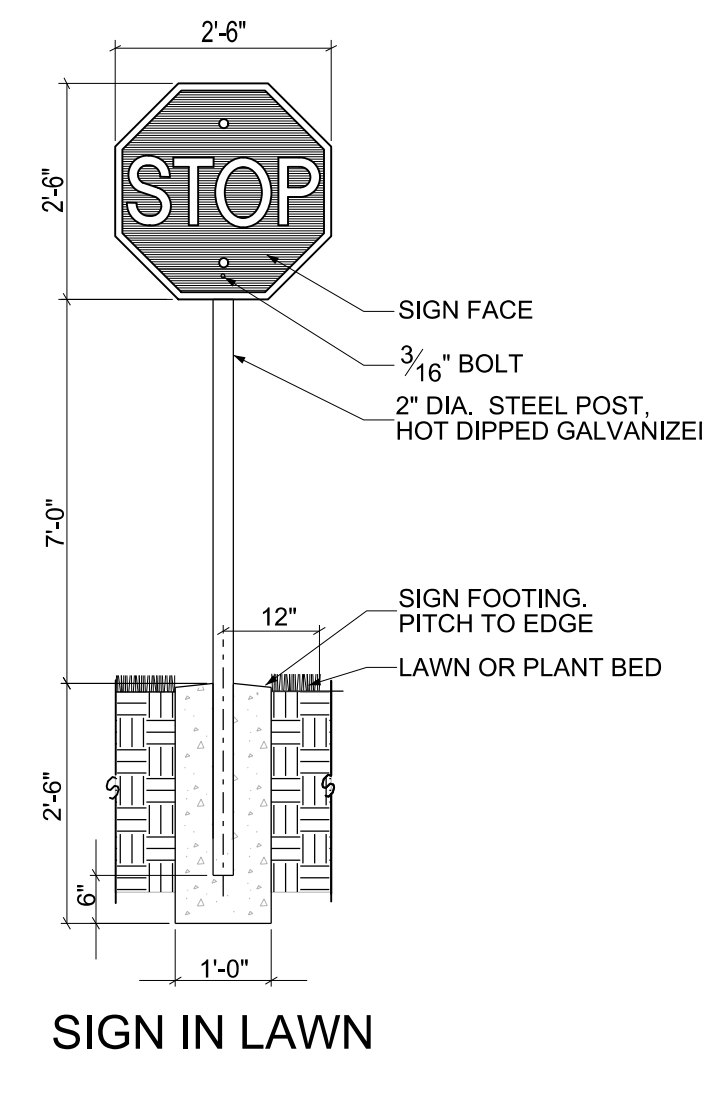


**6** POLE-MOUNTED SIGNS  
SCALE: 1/2"=1'-0"

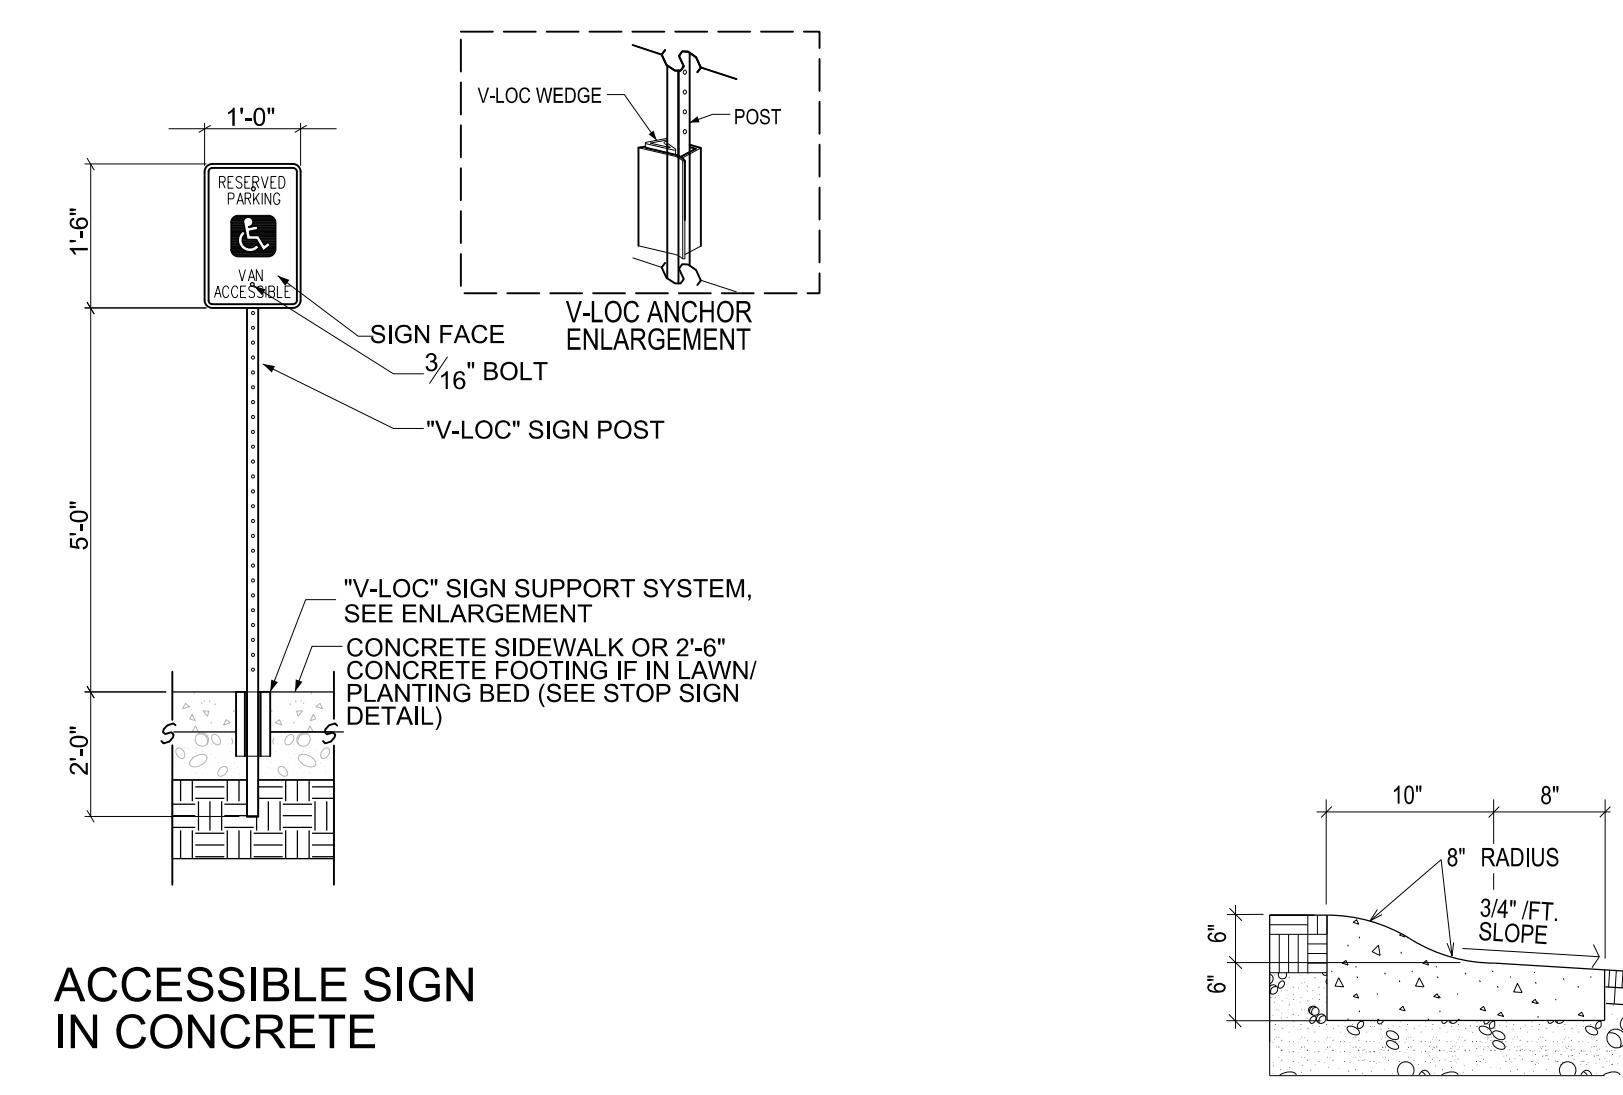


**7** REJECT CURB & GUTTER  
NTS

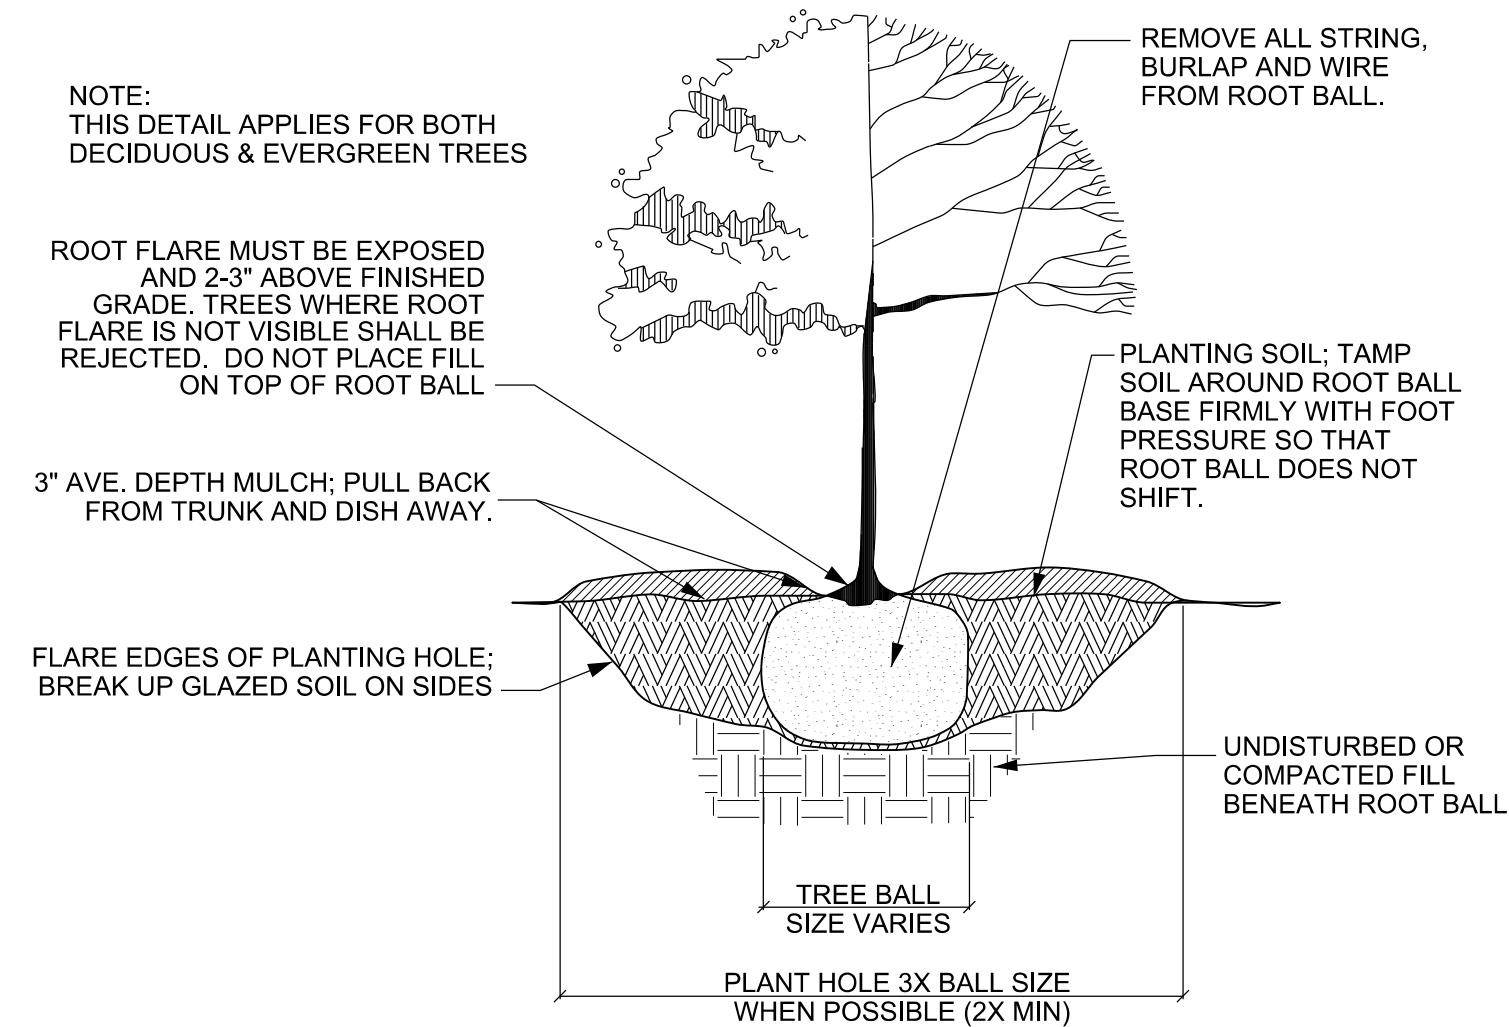


**8** TREE PLANTING  
SCALE: NTS

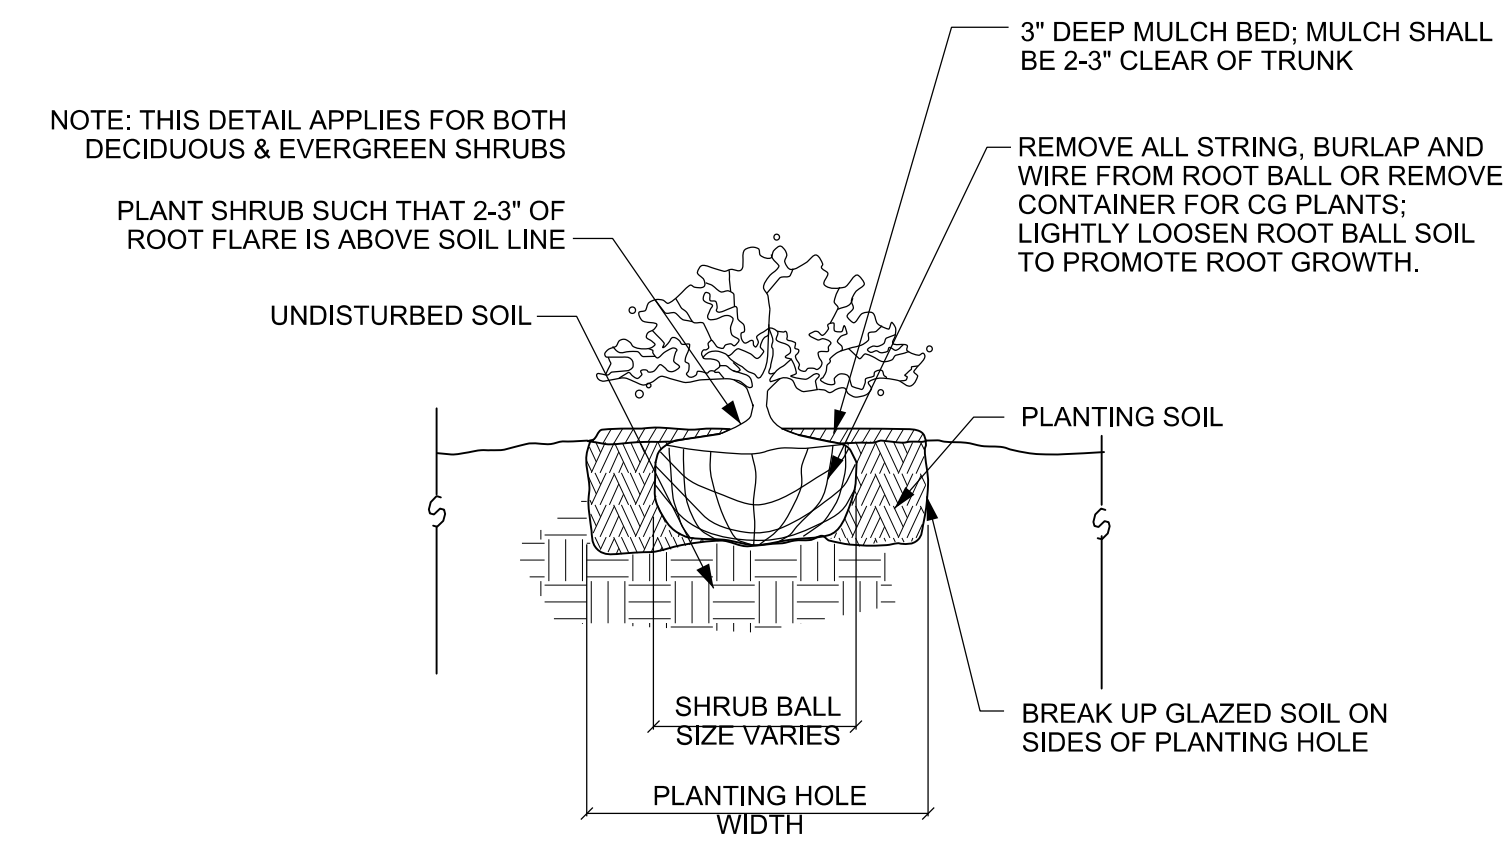


**9** SHRUB PLANTING  
SCALE: NTS

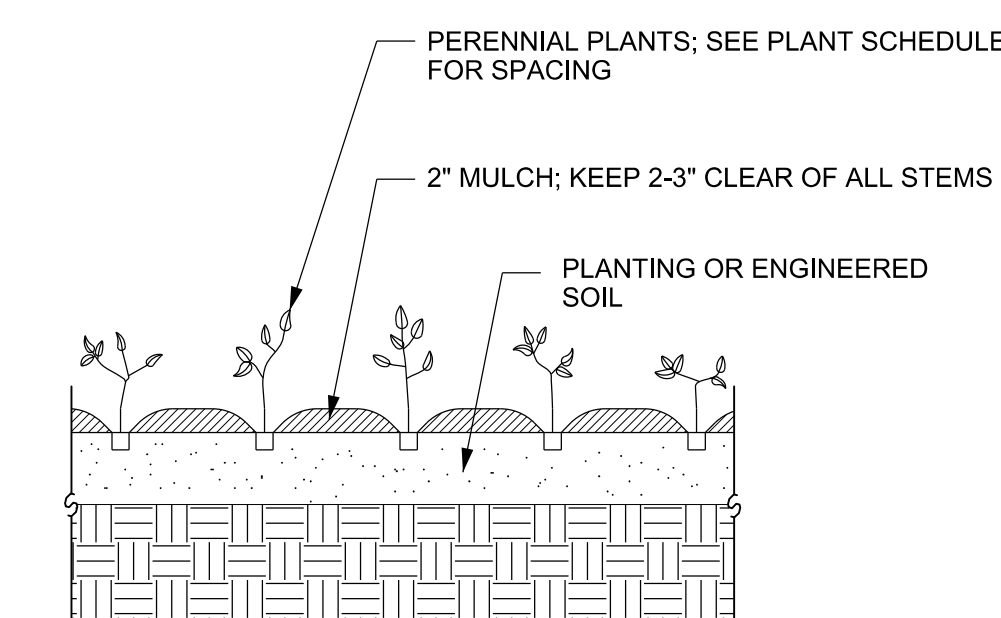

**10** PERENNIAL PLANTING  
SCALE: NTS

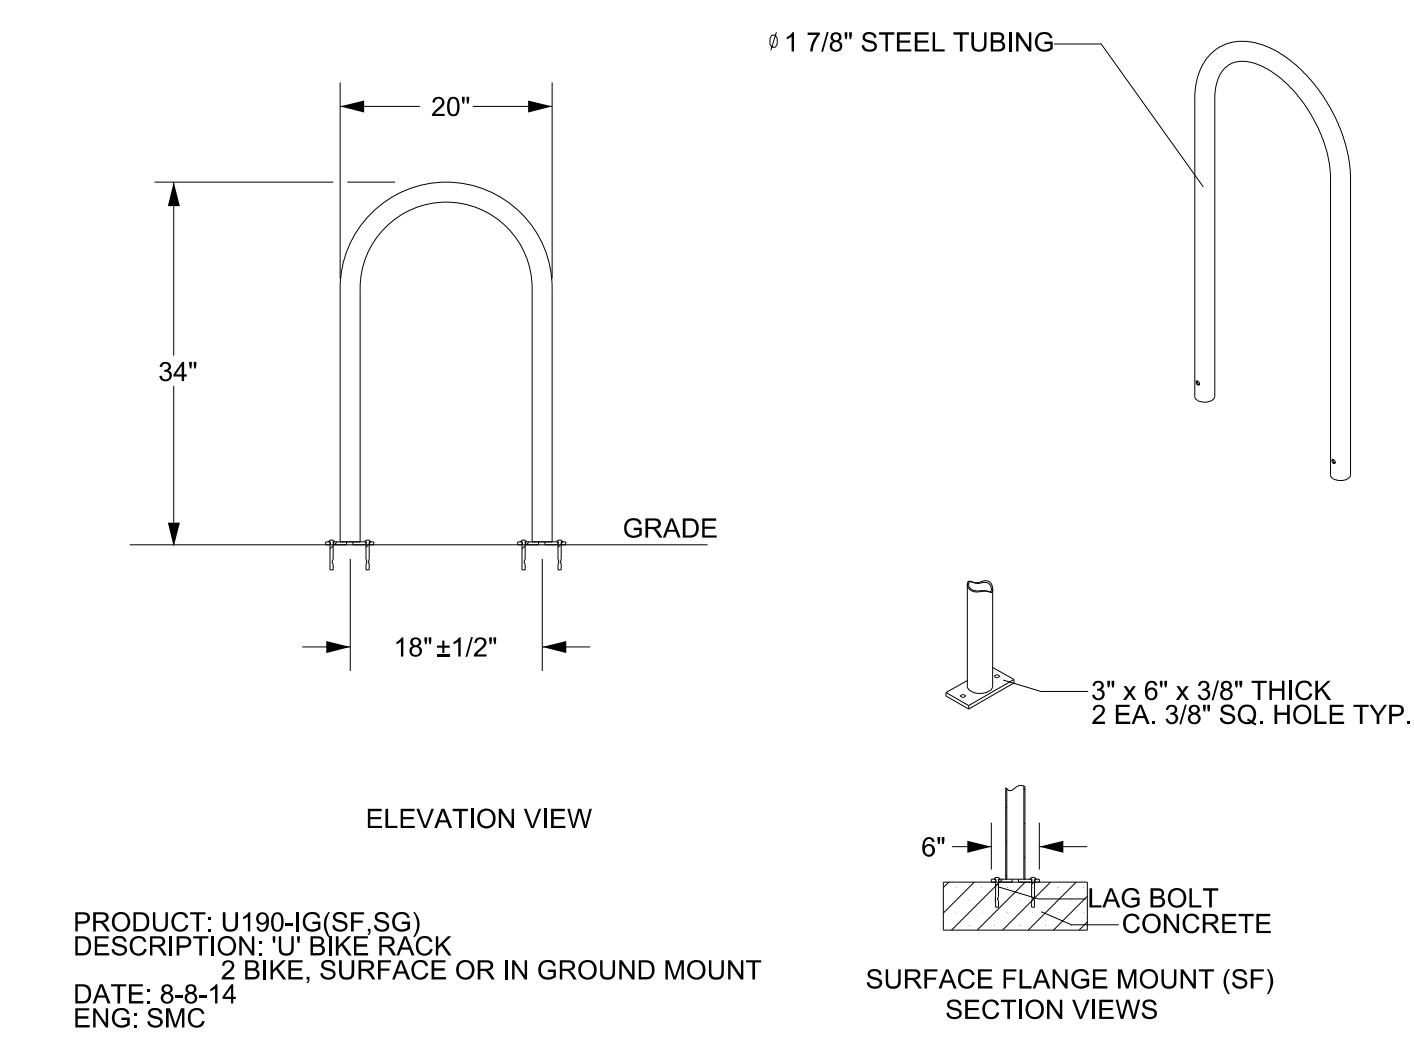

**11** BIKE RACKS  
SCALE: 1"=1'-0"

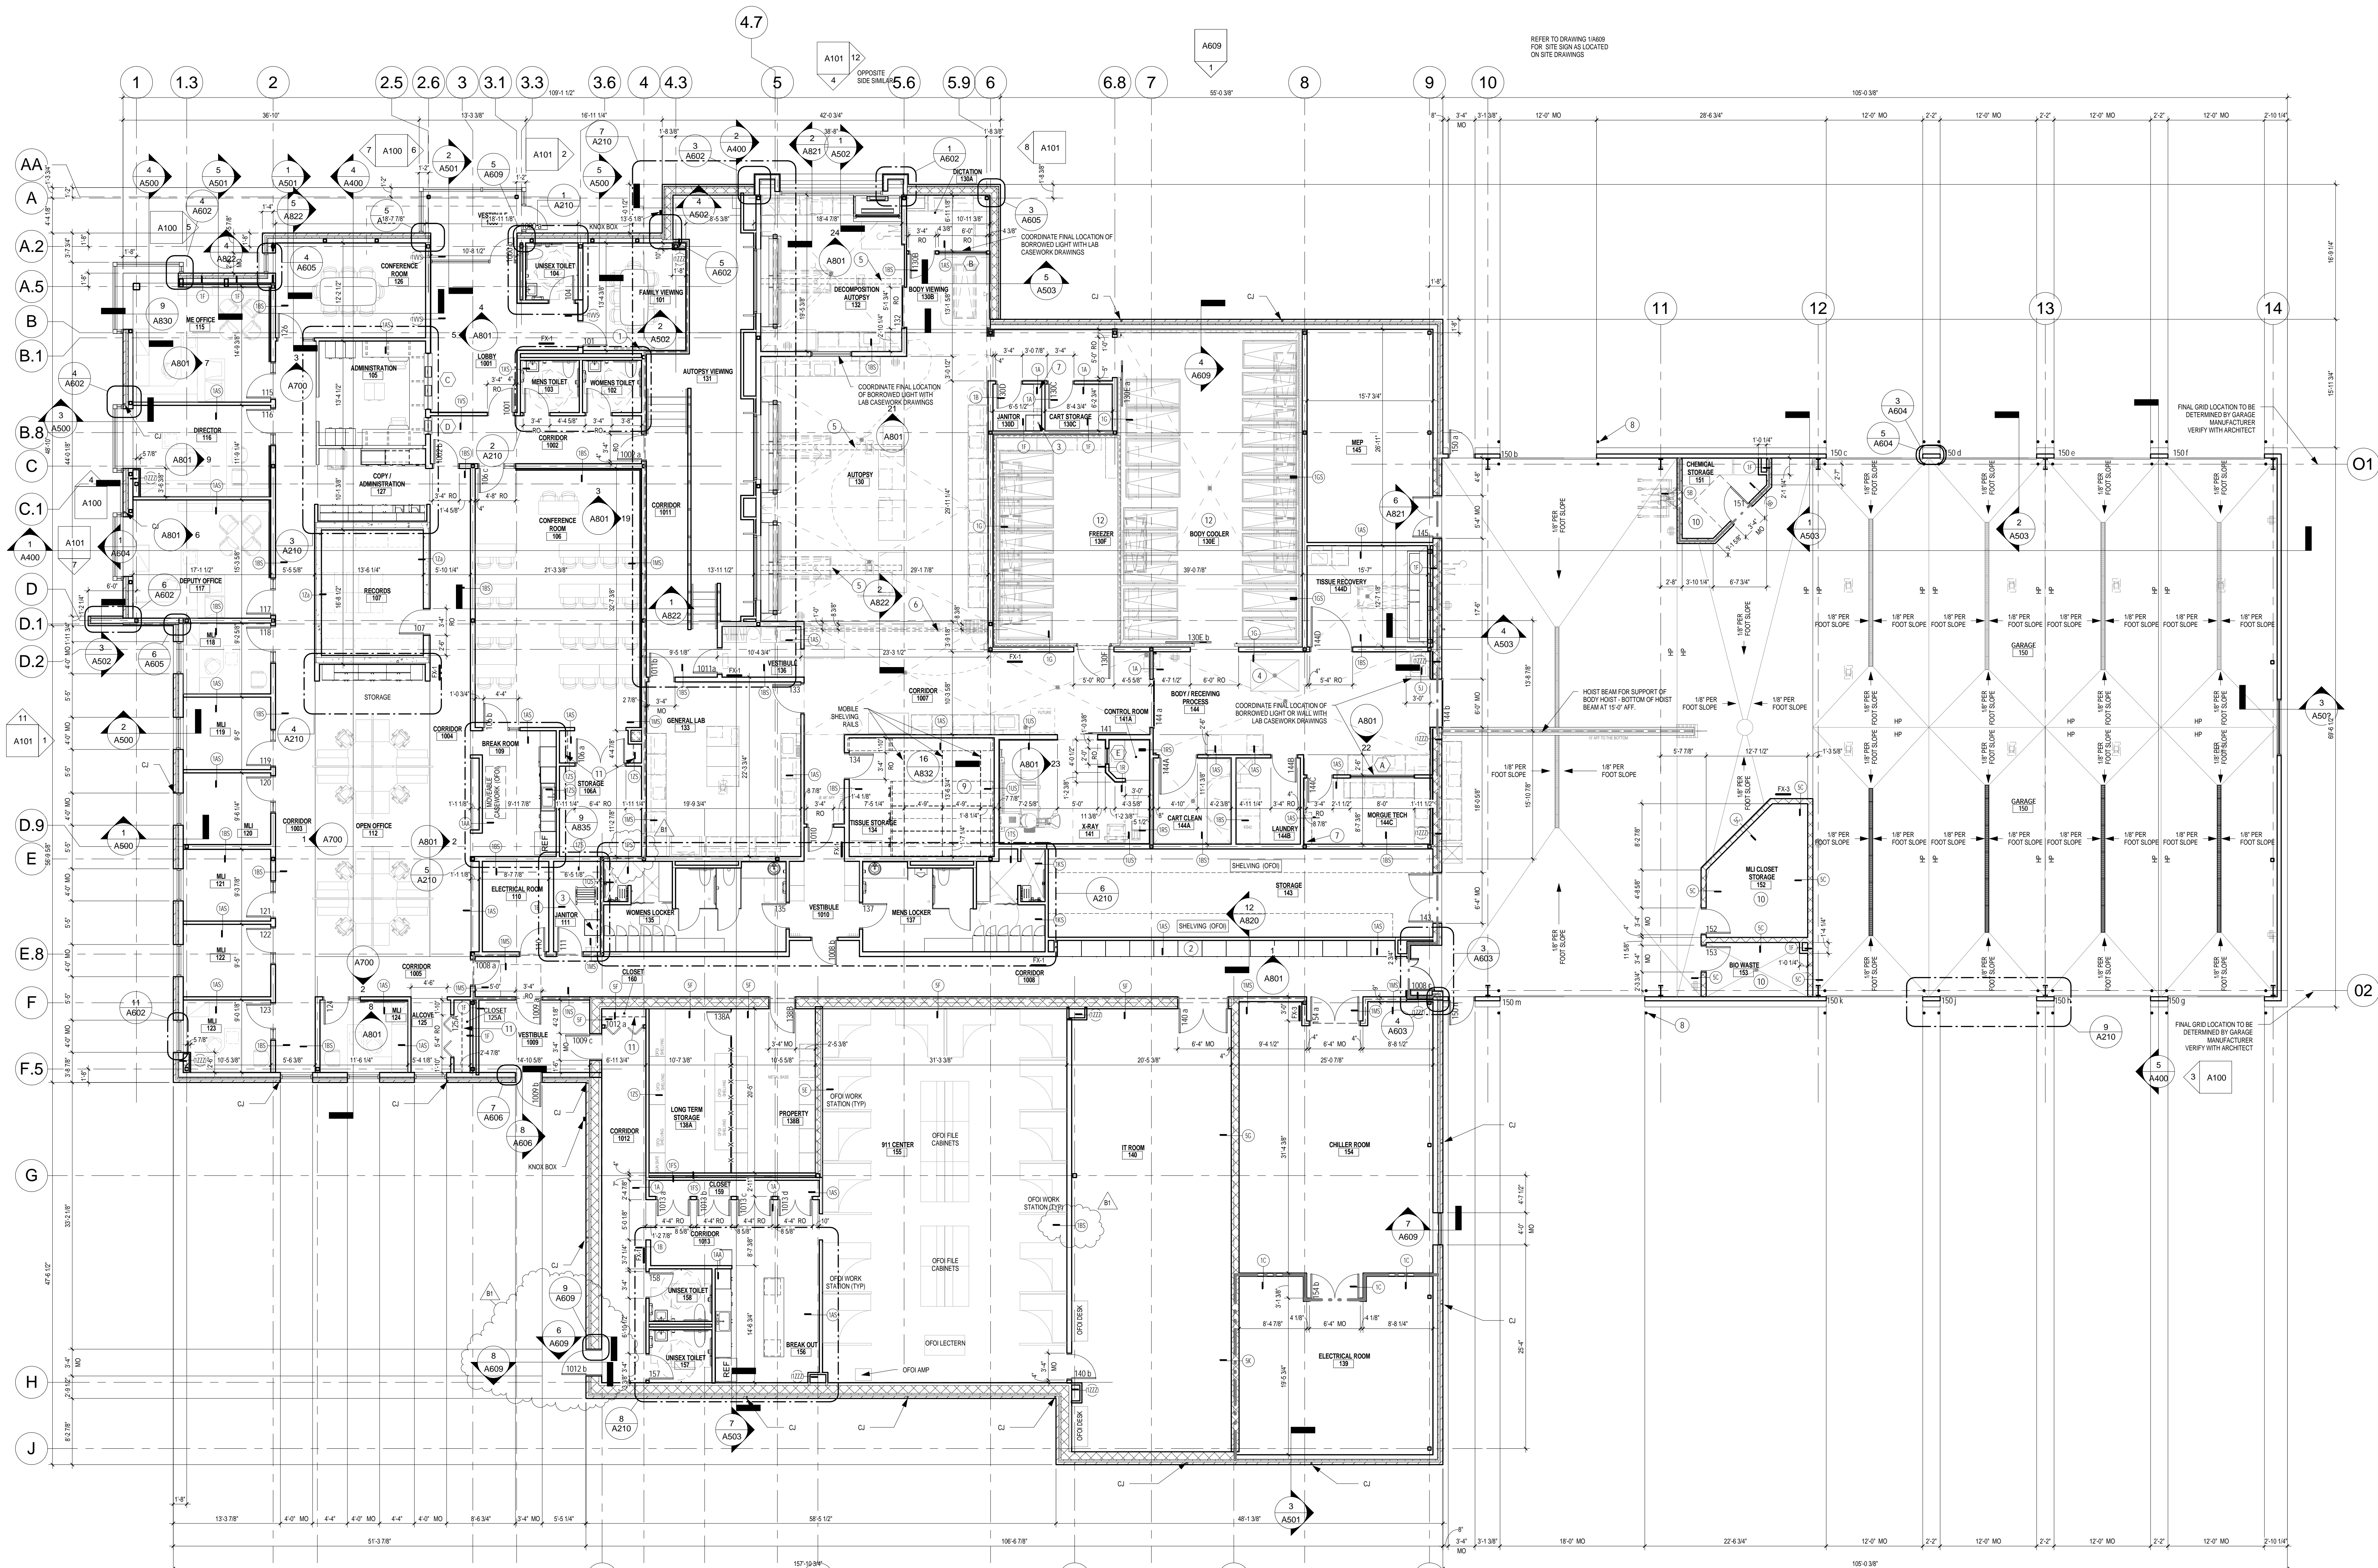

REFER TO DRAWING 1A09  
FOR SITE SIGN AS LOCATED  
ON SITE DRAWINGS


**FIRST FLOOR PLAN**  
1/8" = 1'-0"

**FLOOR PLAN GENERAL NOTES**

- SEE SHEET A850 FOR PARTITION TYPES.
- SEE SHEET A710 FOR BORROWED LIGHT ELEVATIONS. SEE SHEET A701 FOR DOOR AND FRAME ELEVATIONS AND DOOR SCHEDULE. SEE SHEET A702 FOR DOOR AND WINDOW FRAME DETAILS.
- DIMENSIONS ARE TO FACE OF PAINTED SURFACE UNLESS NOTED OTHERWISE.
- SEE SHEETS Q000 THRU Q010 FOR AUTOPSY SUITE PLANS AND DETAILS.
- SEE FINISH PLANS FOR ROOM FINISH INFORMATION.
- MECHANICAL AND ELECTRICAL EQUIPMENT SHOWN HERE FOR REFERENCE ONLY. SEE MEP FOR ADDITIONAL INFORMATION.
- SEE ENLARGED PLANS FOR DIMENSIONS OF TOILET ROOMS, LOCKER ROOMS, ADMINISTRATIVE AREAS, AND AUTOPSY VIEWING AREA.
- CJ - REFER TO 3A06 FOR CONTROL JOINT AND CORNER CAVITY CLOSURE DETAIL. REFER TO BUILDING ELEVATIONS A100 & A101 FOR CORNER JOINT LOCATIONS.
- SEE SHEETS Q000 THRU Q010 FOR EXTENT AND DETAILS OF WALL PROTECTION SYSTEM.
- ALL CONCRETE FLOORS IN GARAGE TO SLOPE AT 1/8" PER FOOT MAXIMUM TOWARDS FLOOR DRAINS.
- ALL FLOORS IN LOCKERS AND SHOWERS TO SLOPE TOWARD FLOOR DRAIN. SEE ARCHITECTURAL PLANS FOR FLOOR DRAIN LOCATIONS.
- SEAL ALL DUCT AND STRUCTURAL PENETRATIONS INTO THE AUTOPSY SUITE FOR ODOR AND PRESSURIZATION.

**FLOOR PLAN KEY NOTES**

- WALL MOUNTED MONITOR - PROVIDE BLOCKING IN WALL AS REQUIRED.
- TYPE 1 LOCKERS - LOCKER SUPPLIER TO PROVIDE COORDINATION DRAWINGS PRIOR TO POURING CONCRETE FLOOR.
- 24" x 24" FLOOR MOUNTED MOP SINK.
- RECESSED BODY SCALE - SEE A210 FOR BRGS AND DETAILS.
- TUBE STEEL OVERHEAD FOR MOUNTING AUTOPSY LIGHTS - BOTTOM OF TUBE AT 10'-0" AFF - SEE STRUCTURAL DRAWINGS FOR TUBE SIZE. SEE 3A01 FOR LOCATIONS.
- HOST BEAM TO SUPPORT BODY LIFT - BOTTOM OF BEAM AT 10'-2 5/8" AFF - SEE 151 FOR DETAILS - SEE STRUCTURAL FOR BEAM SIZE.
- 12" WIDE OVERHEAD SHELF.
- 4" DIAMETER CONCRETE FILLED BOLLARDS SEE 11/02 FOR DETAILS.
- MOBILE SHELVING SYSTEM WITH RECESSED RAIL - MOBILE SHELVING SUPPLIER TO PROVIDE COORDINATION DRAWINGS PRIOR TO POURING CONCRETE.
- STORAGE ROOM TO HAVE 4" TOTAL THICKNESS CONCRETE SLAB ABOVE. TOP OF SLAB AT 10'-4" AFF. SEE STRUCTURAL DRAWINGS FOR SUPPORT FRAMING AND DETAILS.
- COAT HANGER ROD AND SHELF.
- REFER TO "C" SERIES SHEETS FOR LAYOUT AND DETAILS OF BODY COOLER AND FREEZER.

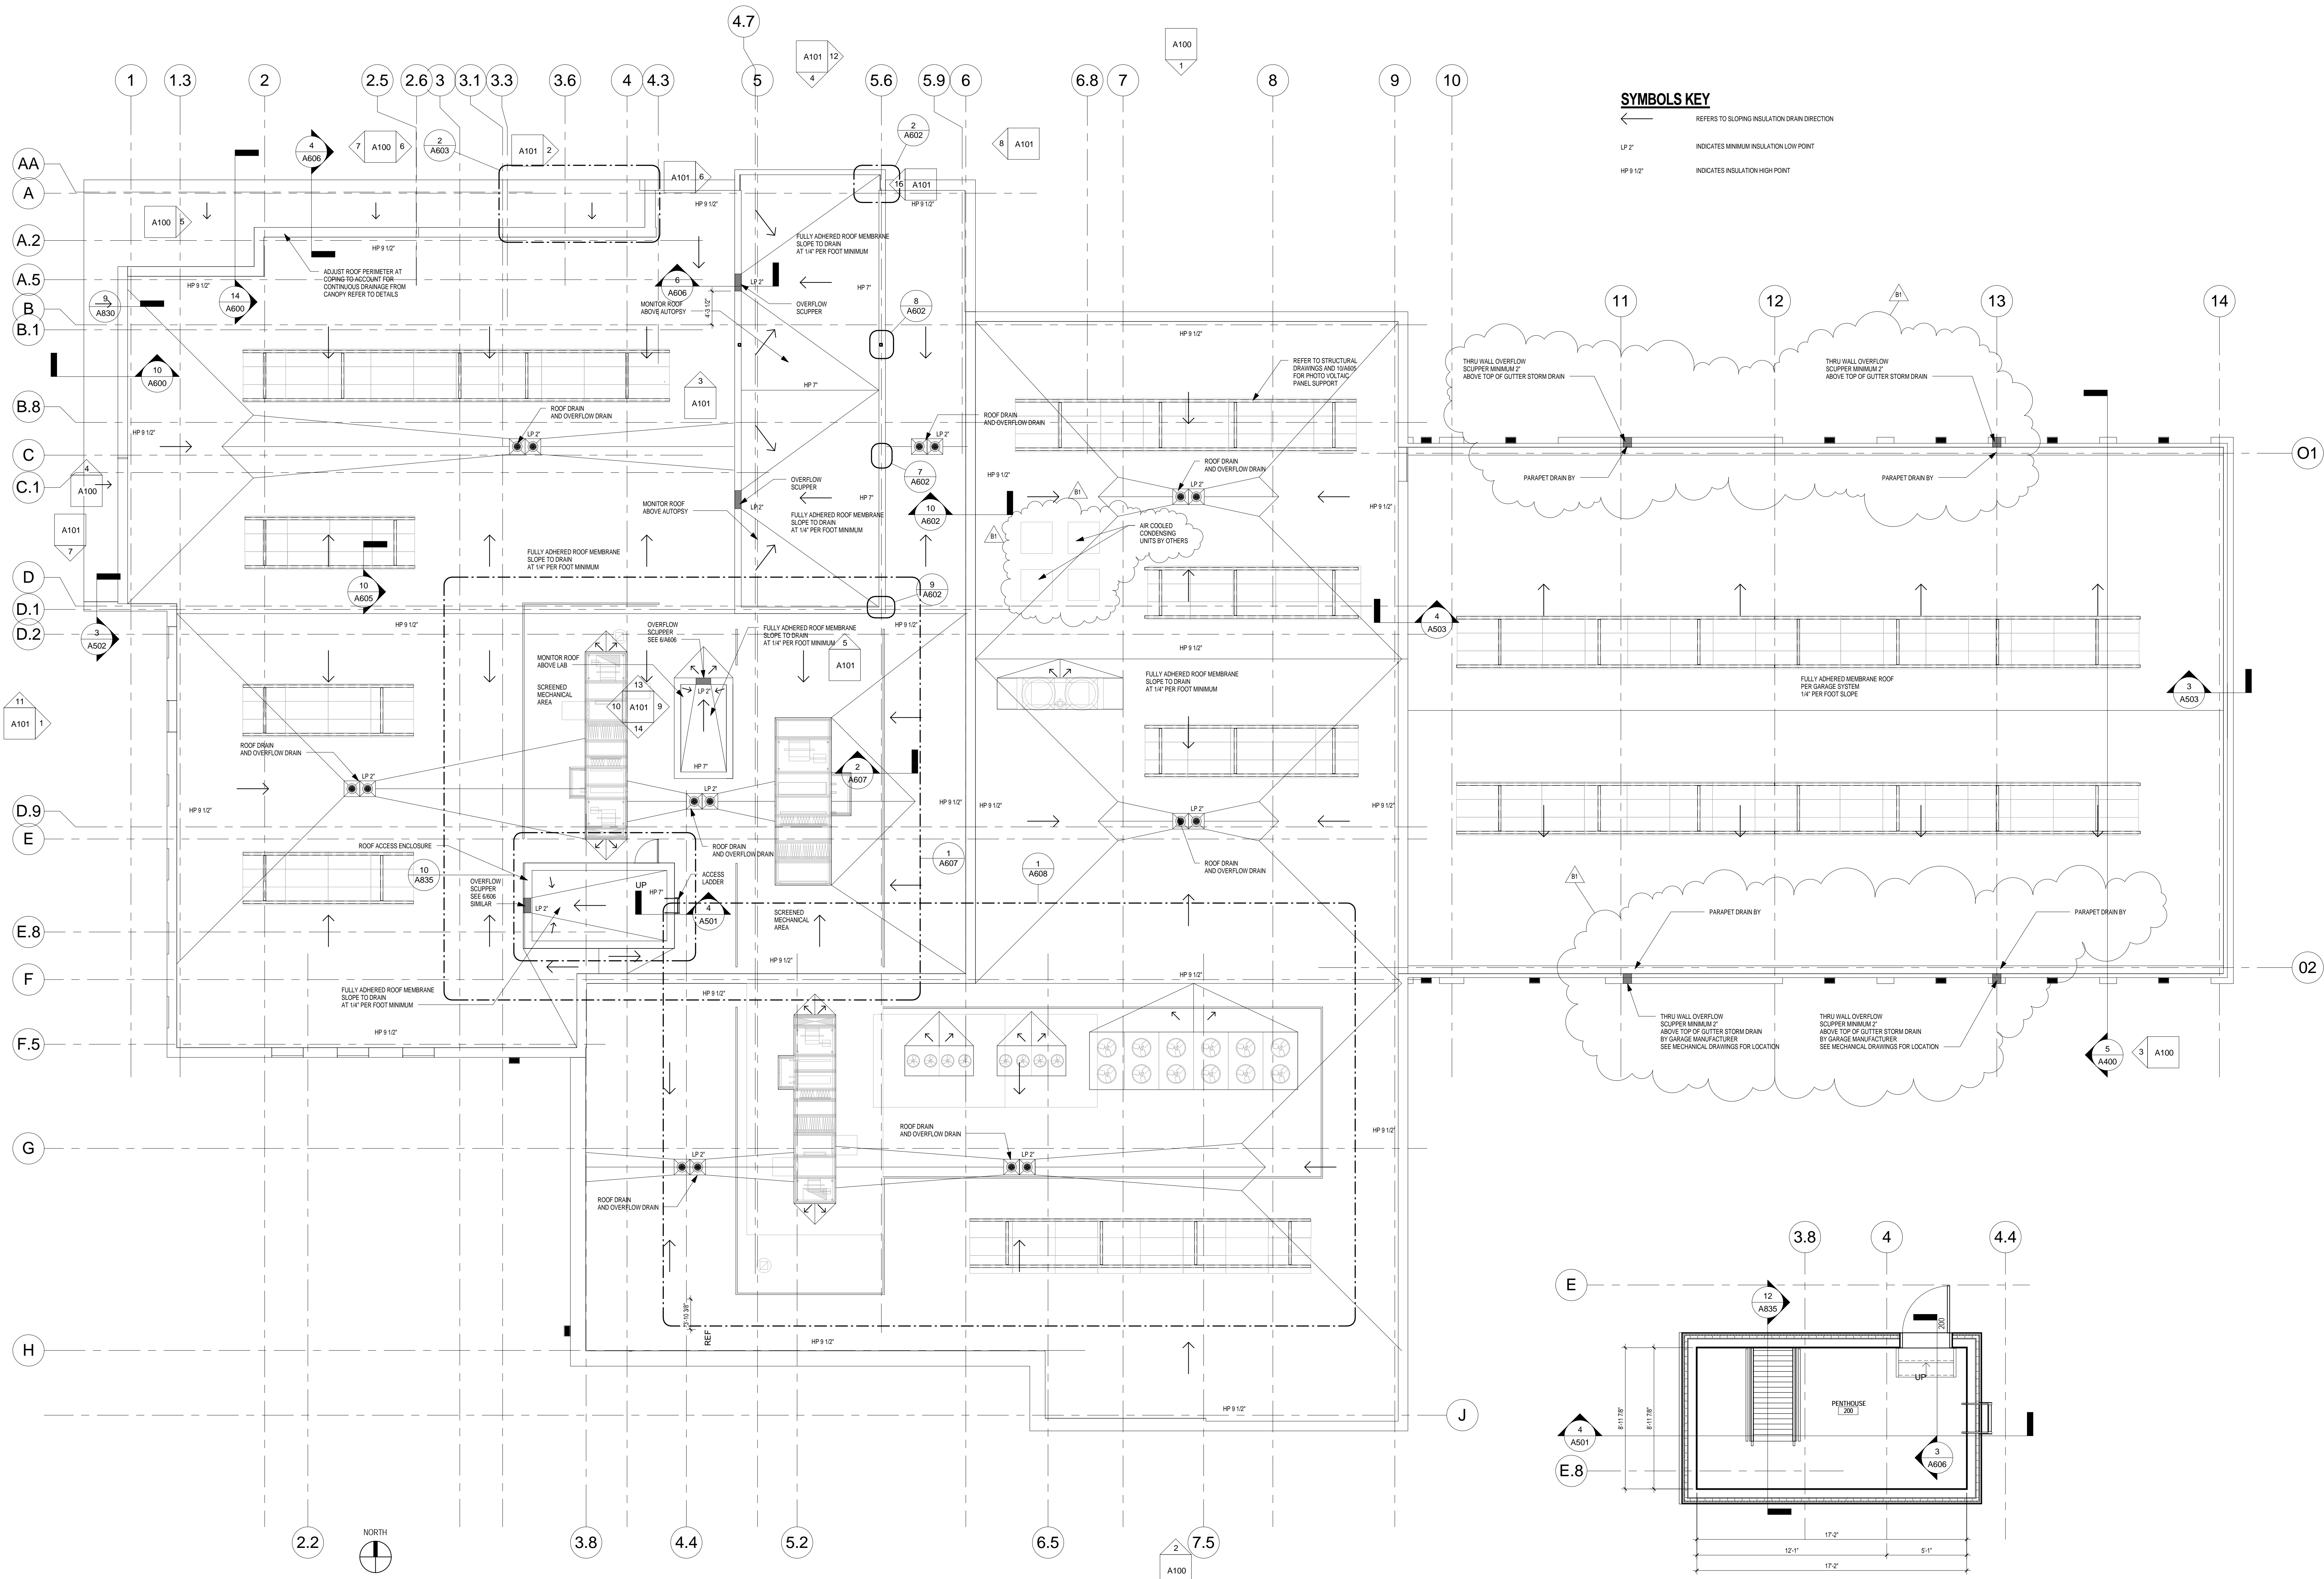

1 ROOF PLAN  
1/8" = 1'-0"



2 PENTHOUSE FLOOR PLAN  
1/4" = 1'-0"

**FLOOR PLAN GENERAL NOTES**


- SEE SHEET AB80 FOR PARTITION TYPES.
- SEE SHEET A700 FOR BORROWED LIGHT ELEVATIONS. SEE SHEET A701 FOR DOOR AND FRAME ELEVATIONS AND DOOR SCHEDULE. SEE SHEET A702 FOR DOOR AND WINDOW FRAME DETAILS.
- DIMENSIONS ARE TO FACE OF PAINTED SURFACE UNLESS NOTED OTHERWISE.
- SEE SHEETS 0300 THRU 0311 FOR AUTOPISTY SUITE PLANS AND DETAILS.
- SEE FINISH PLANS FOR ROOM FINISH INFORMATION AND EXTENT OF WALL PROTECTION SYSTEMS.
- MECHANICAL AND ELECTRICAL EQUIPMENT SHOWN HERE FOR REFERENCE ONLY. SEE MEP DRAWINGS FOR ADDITIONAL INFORMATION.
- SEE ENLARGED PLANS FOR DIMENSIONS OF TOILET ROOMS, LOCKER ROOMS, ADMINISTRATIVE AREAS, AND AUTOPISTY VIEWING AREA.
- CJ - REFER TO 3/4" DRAW FOR CONTROL JOINT AND CORNER CAVITY CLOSURE DETAIL. REFER TO BUILDING ELEVATIONS A100 & A101 FOR CORNER JOINT LOCATIONS.
- SLOPE ALL FLOORS IN LOCKER ROOMS AND BATHROOMS TO FLOOR DRAINS SHOWN.

**FLOOR PLAN KEY NOTES**


- TYPE 2 LOCKERS - LOCKER SUPPLIER TO PROVIDE COORDINATION DRAWINGS PRIOR TO POURING CONCRETE PADS.
- 72" LONG X 20" WIDE WALL MOUNTED BENCH.
- 60" LONG X 20" WIDE WALL MOUNTED BENCH.

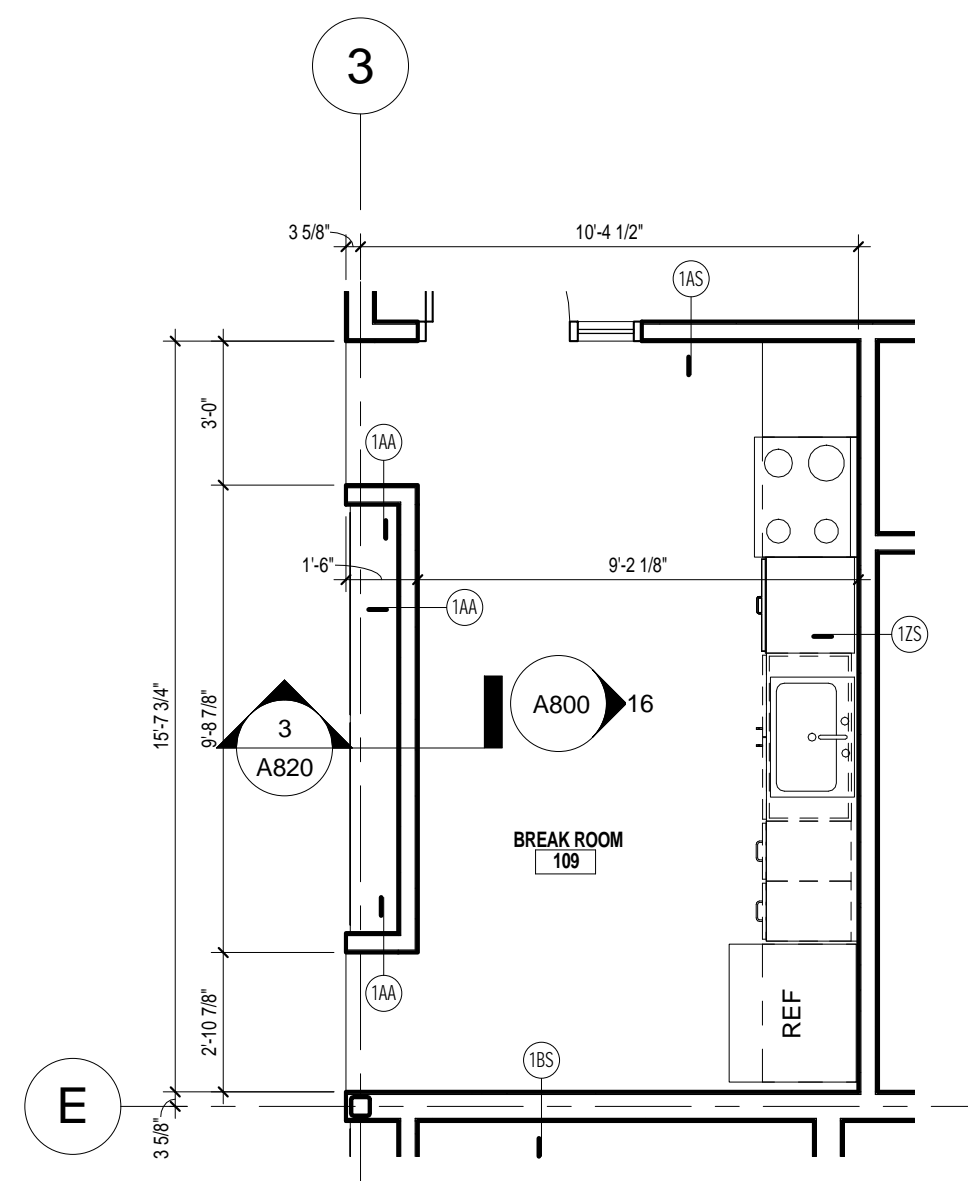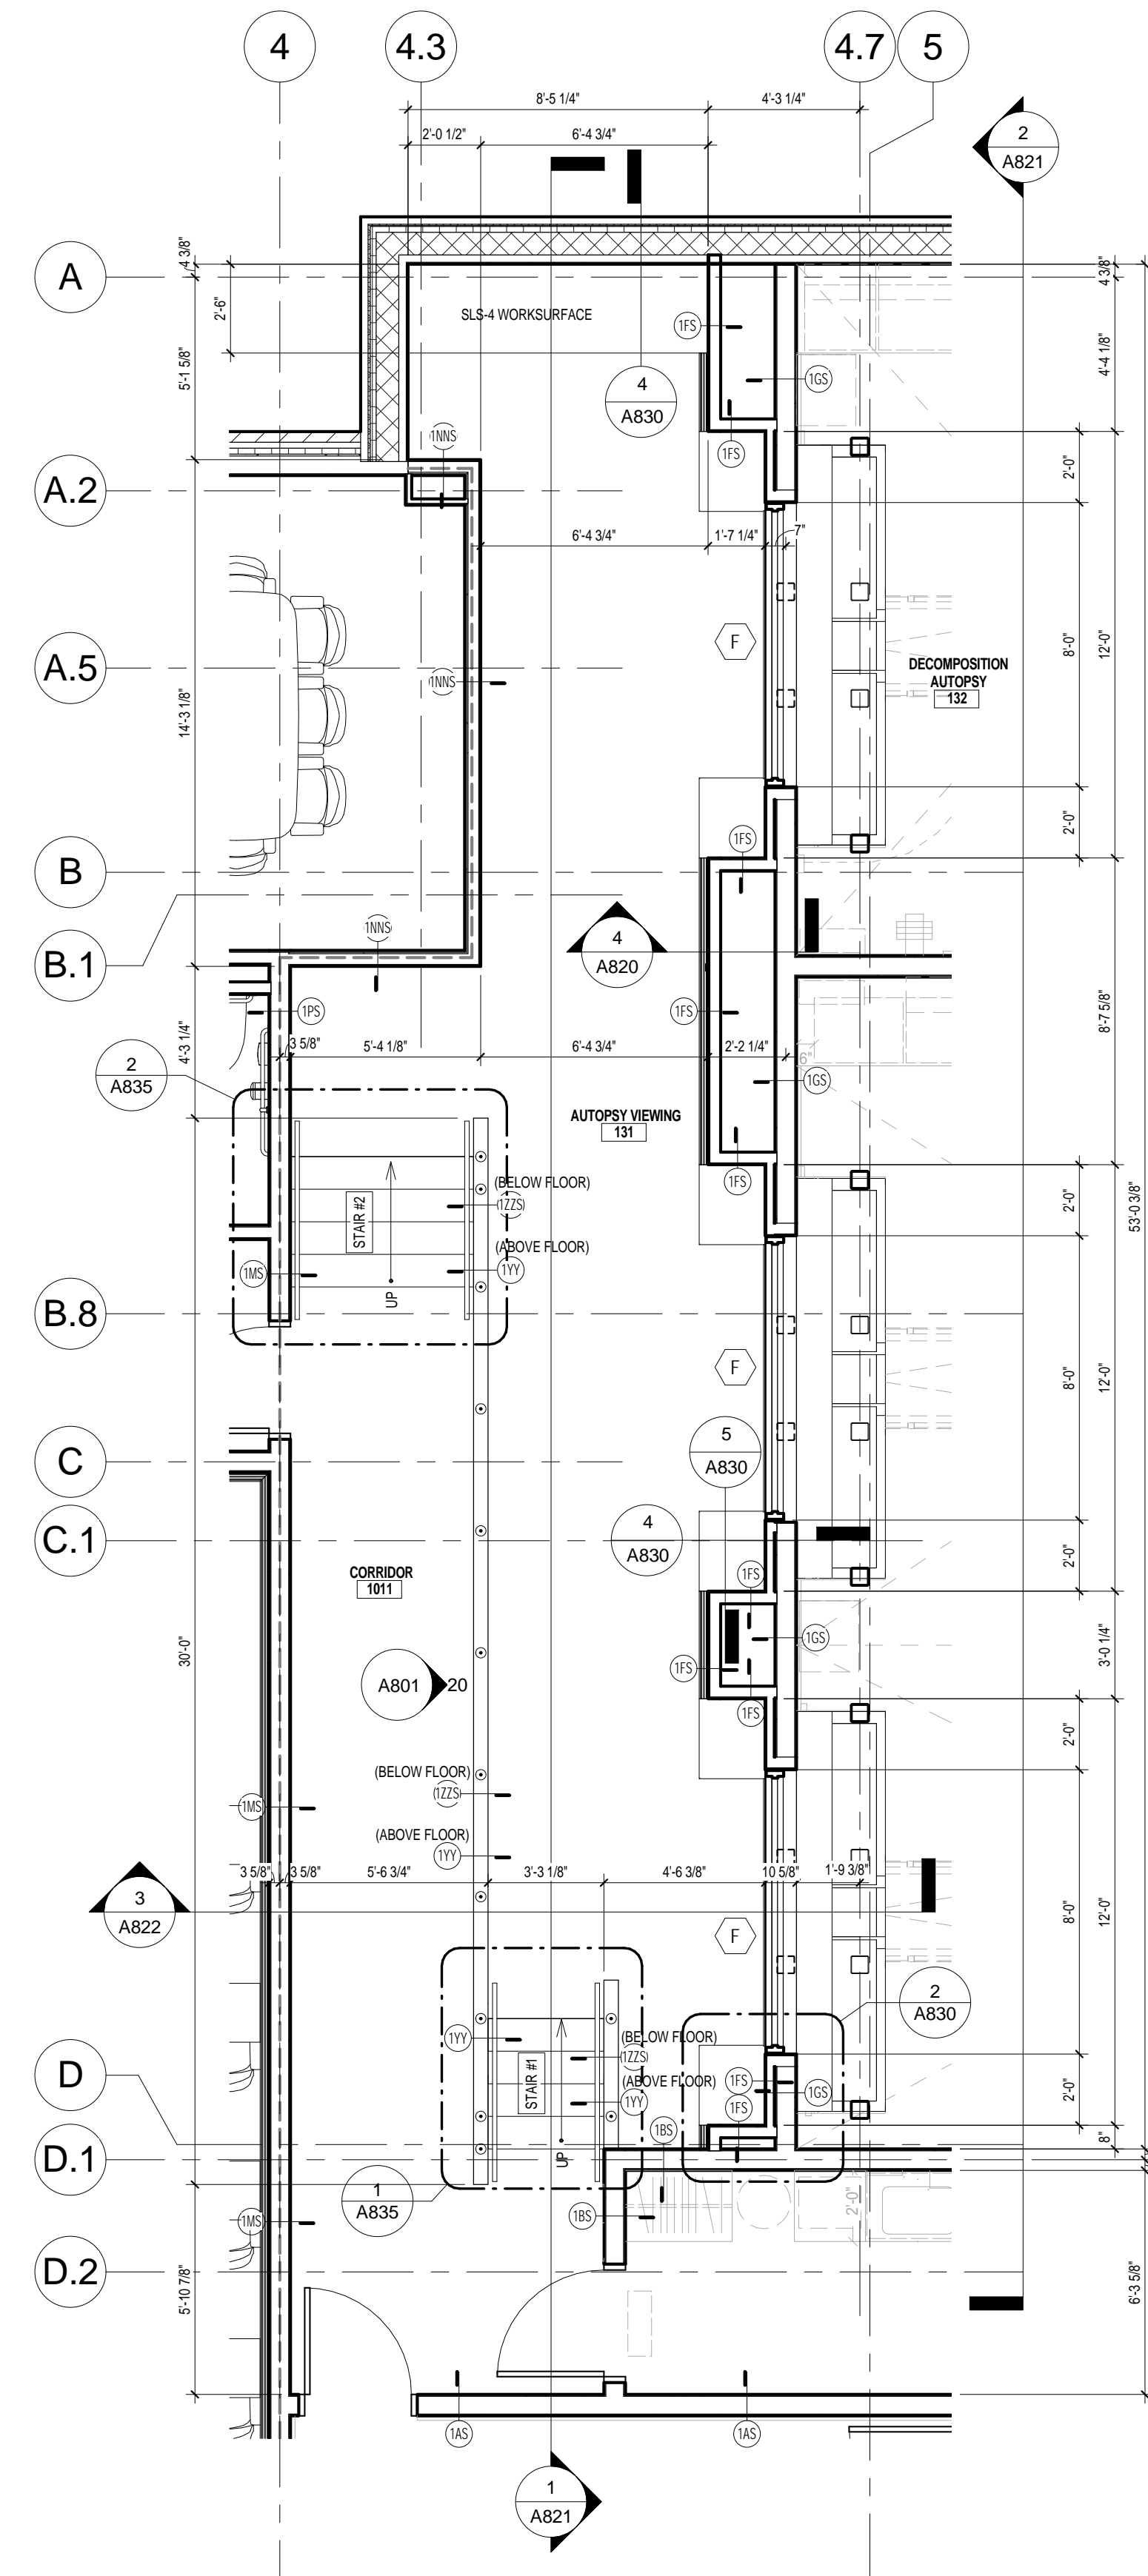


1/4" = 1'-0"

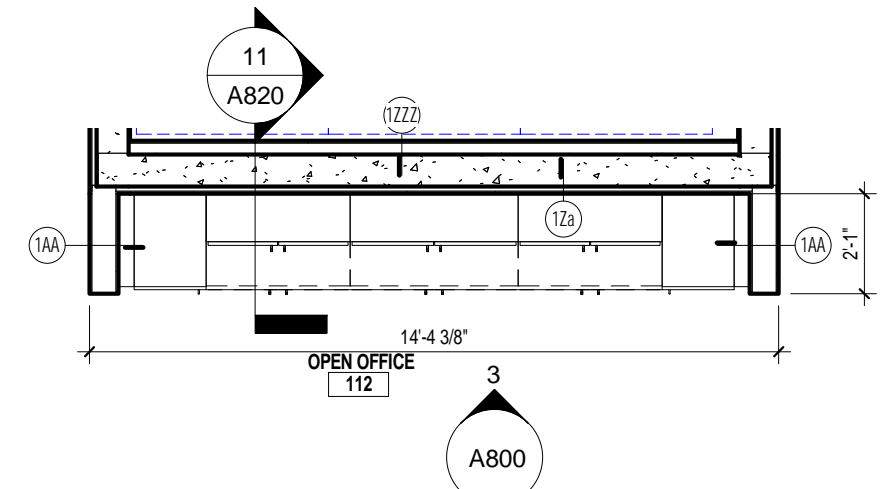


**4 ENLARGED PLAN - ADMIN AREA**  
1/4" = 1'-0"

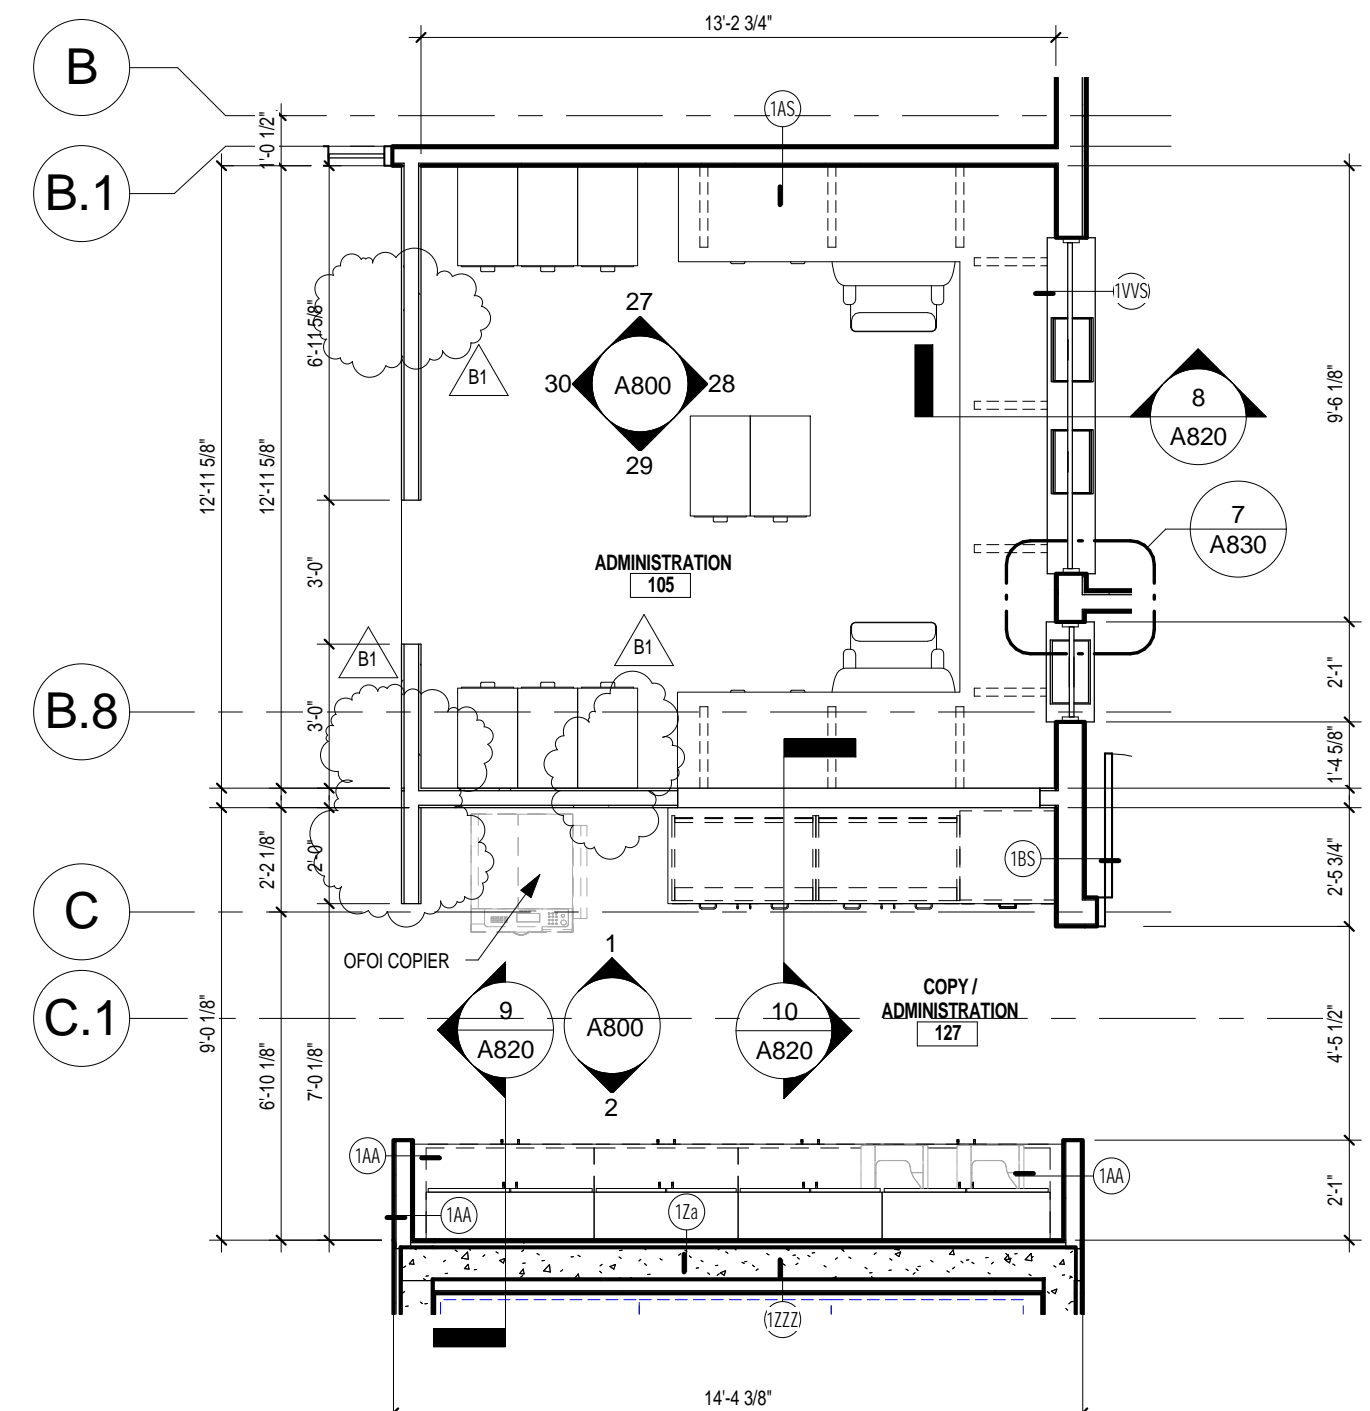


**3 COPY / ADMINISTRATIVE**  
1/4" = 1'-0"

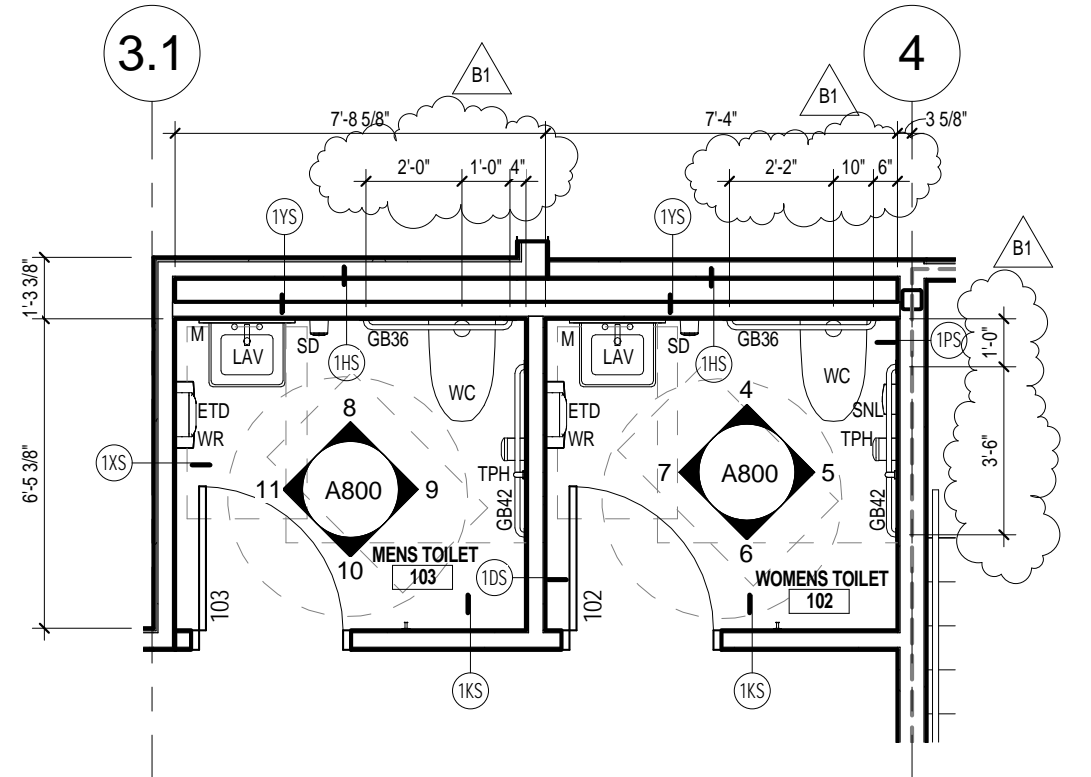


**2 TOILET ROOMS**  
1/4" = 1'-0"

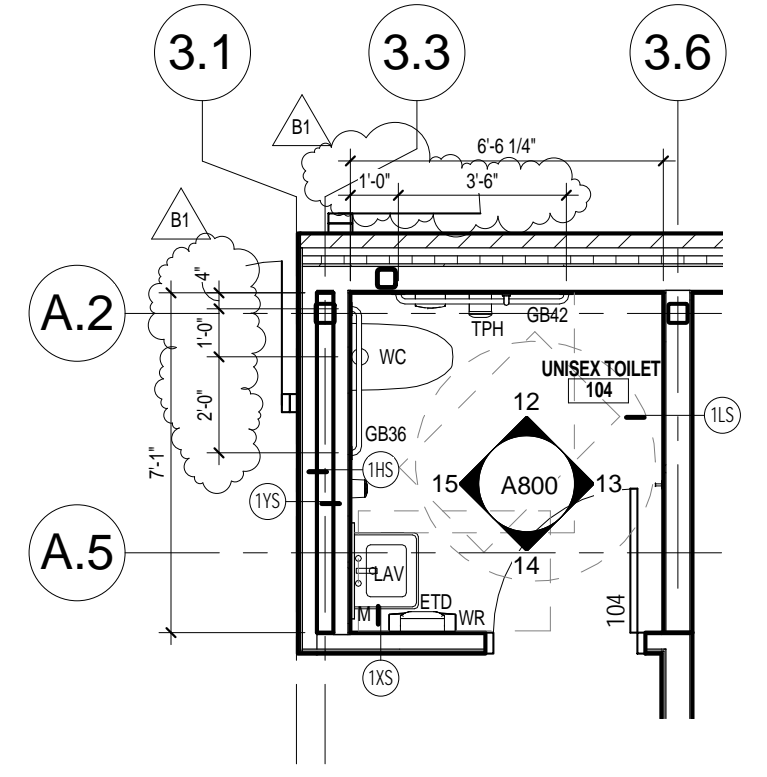


**1 UNISEX TOILET**  
1/4" = 1'-0"

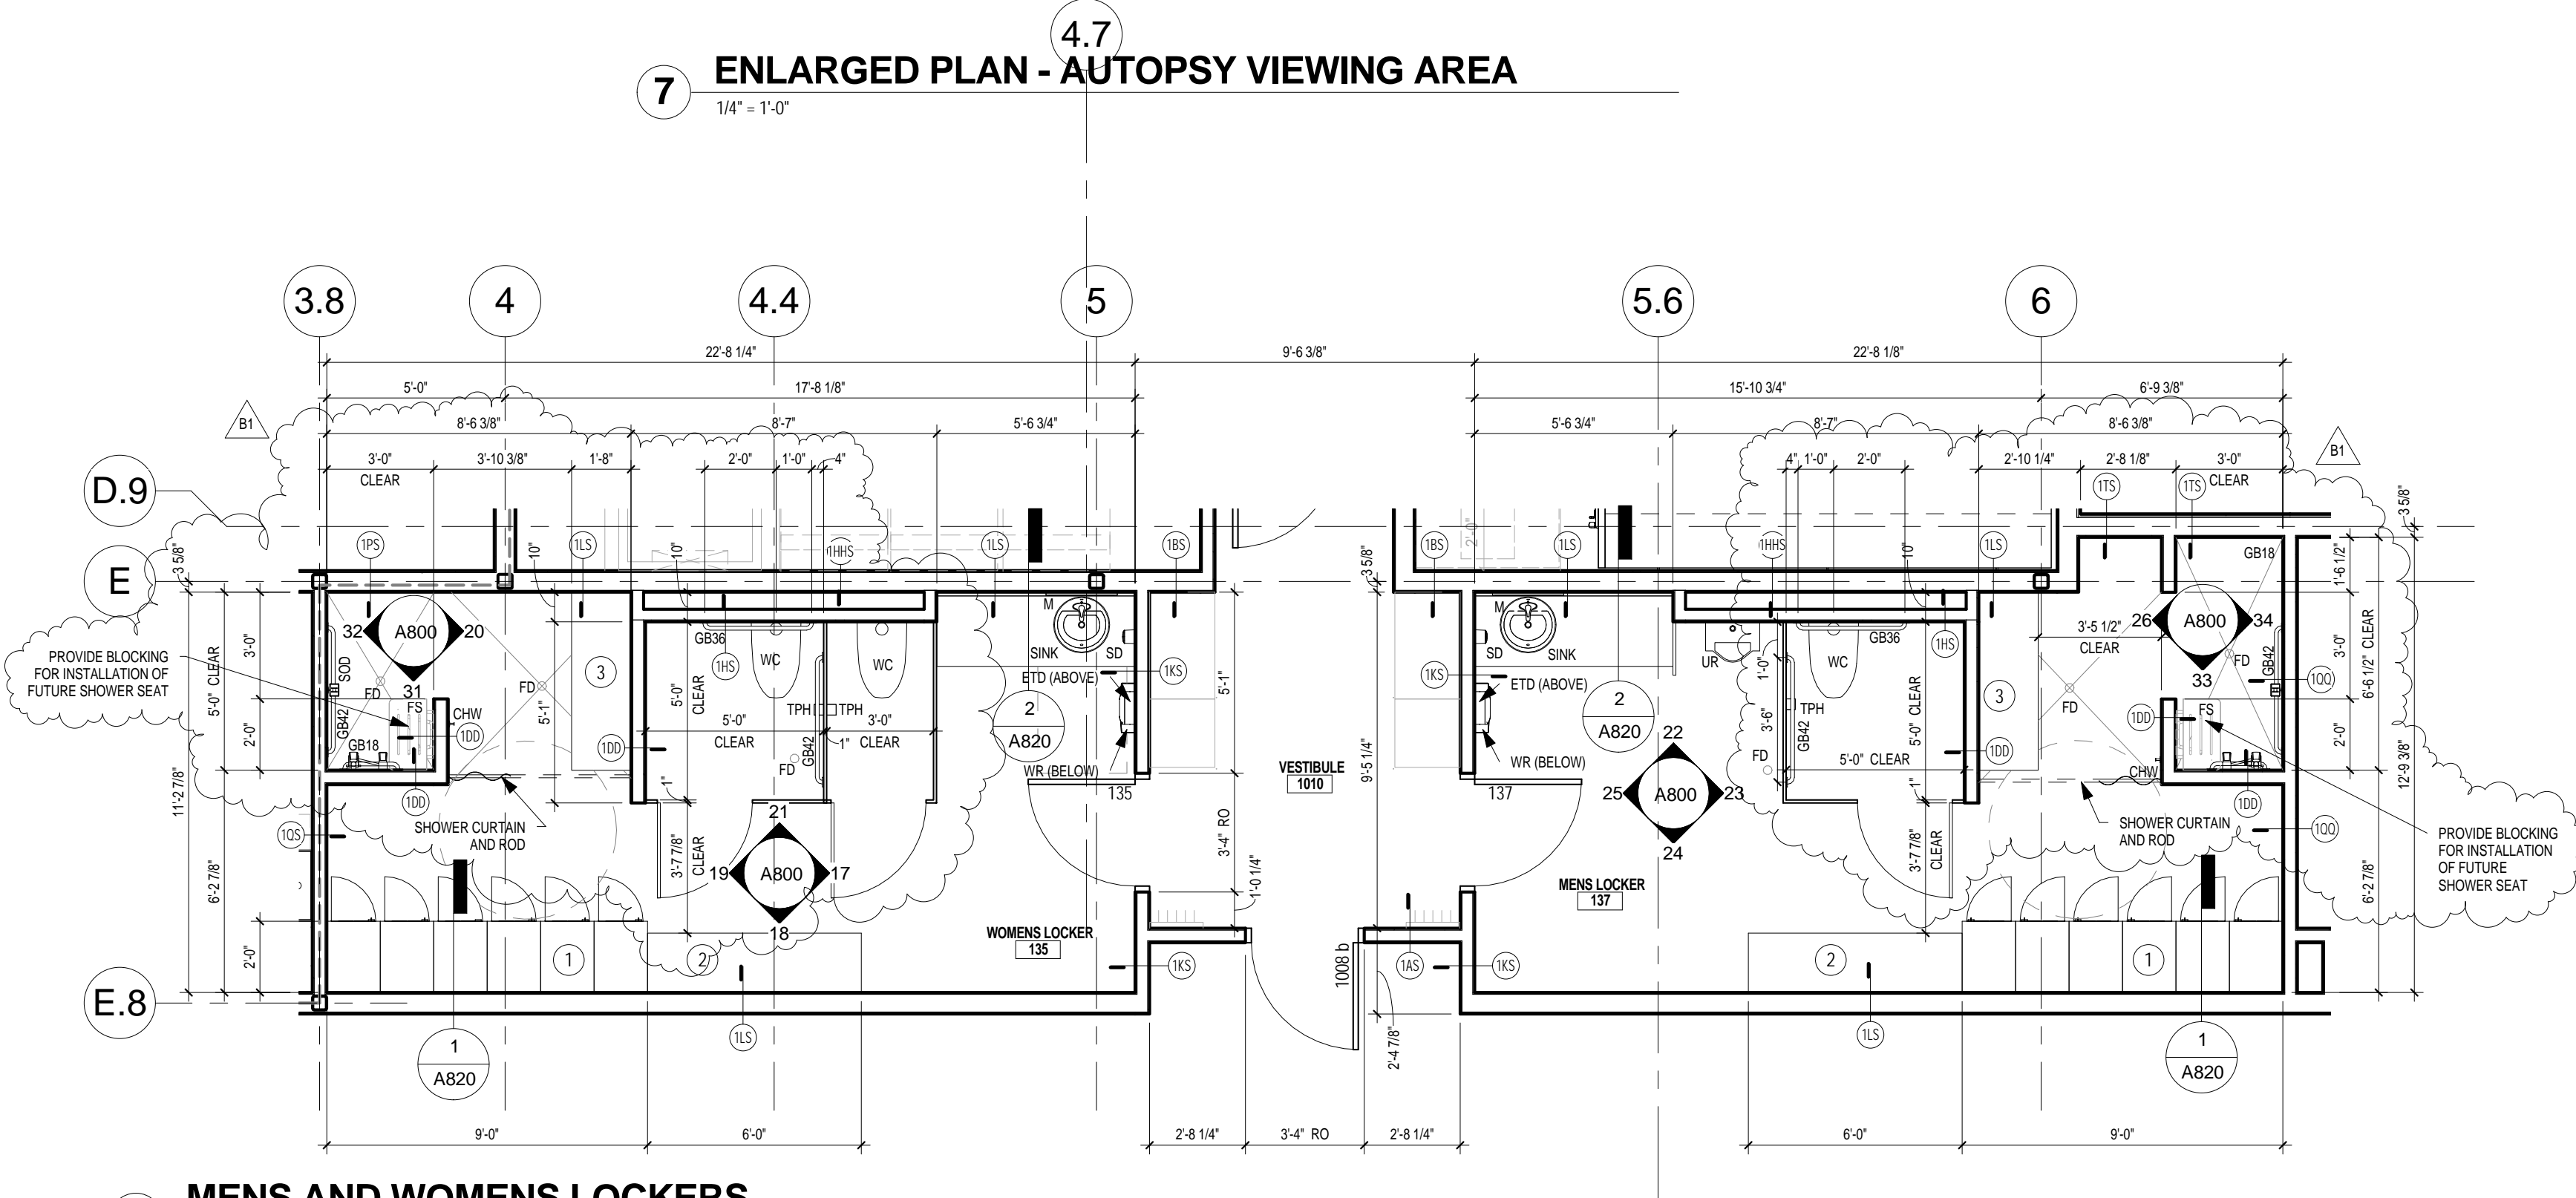

**6 MENS AND WOMENS LOCKERS**  
1/4" = 1'-0"

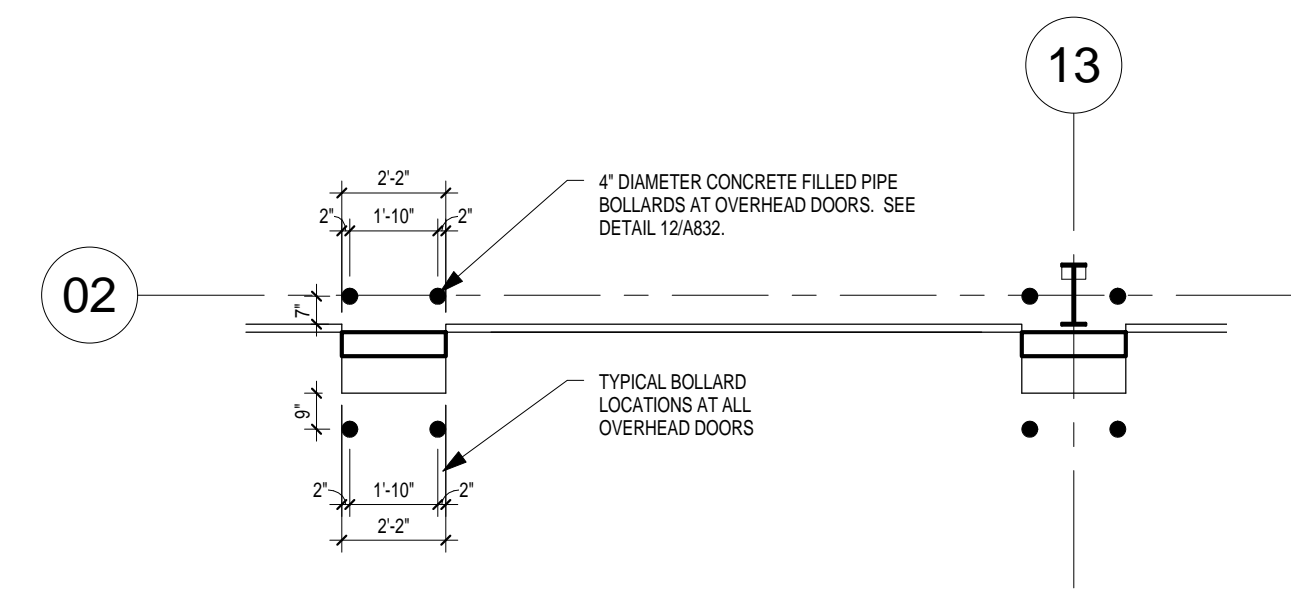


**9 TYPICAL BOLLARD LOCATIONS**  
1/4" = 1'-0"

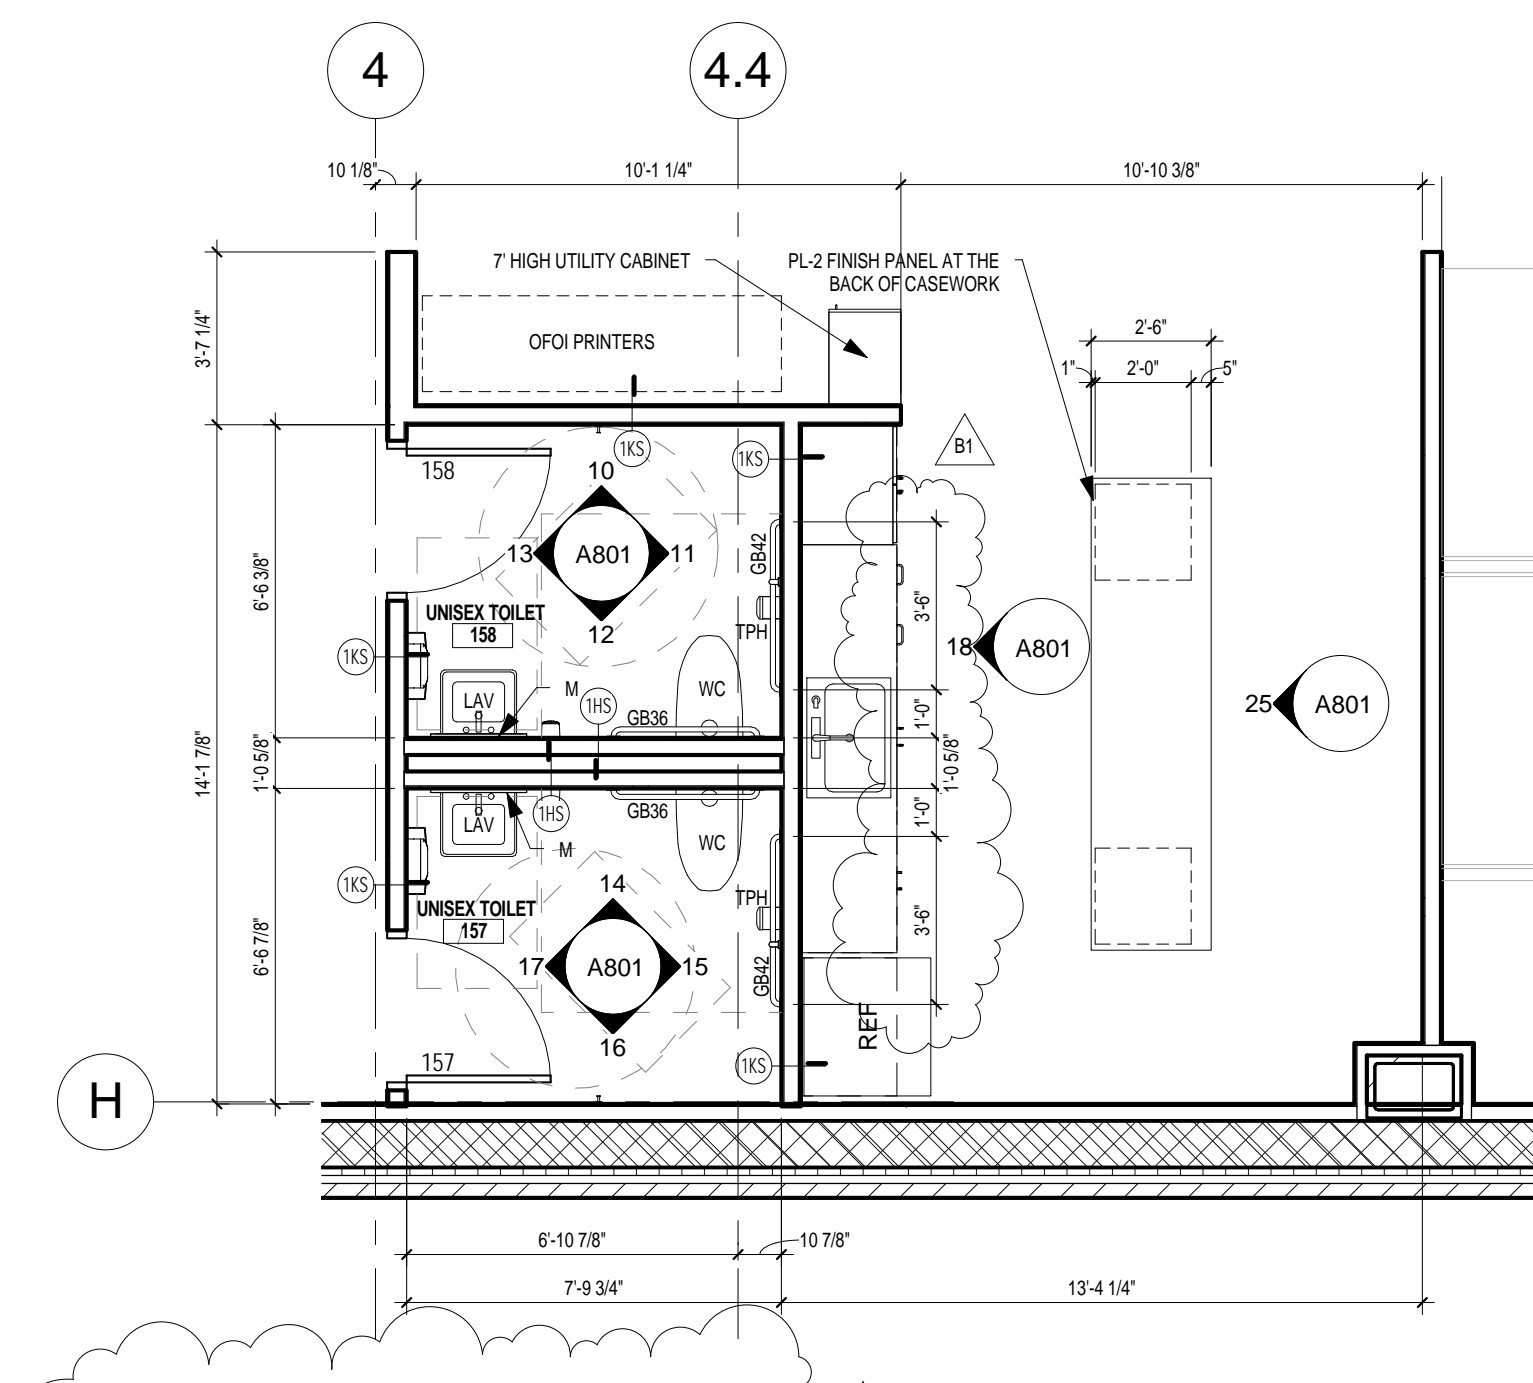


**8 UNISEX TOILETS**  
1/4" = 1'-0"

**7 ENLARGED PLAN - AUTOPISTY VIEWING AREA**  
1/4" = 1'-0"



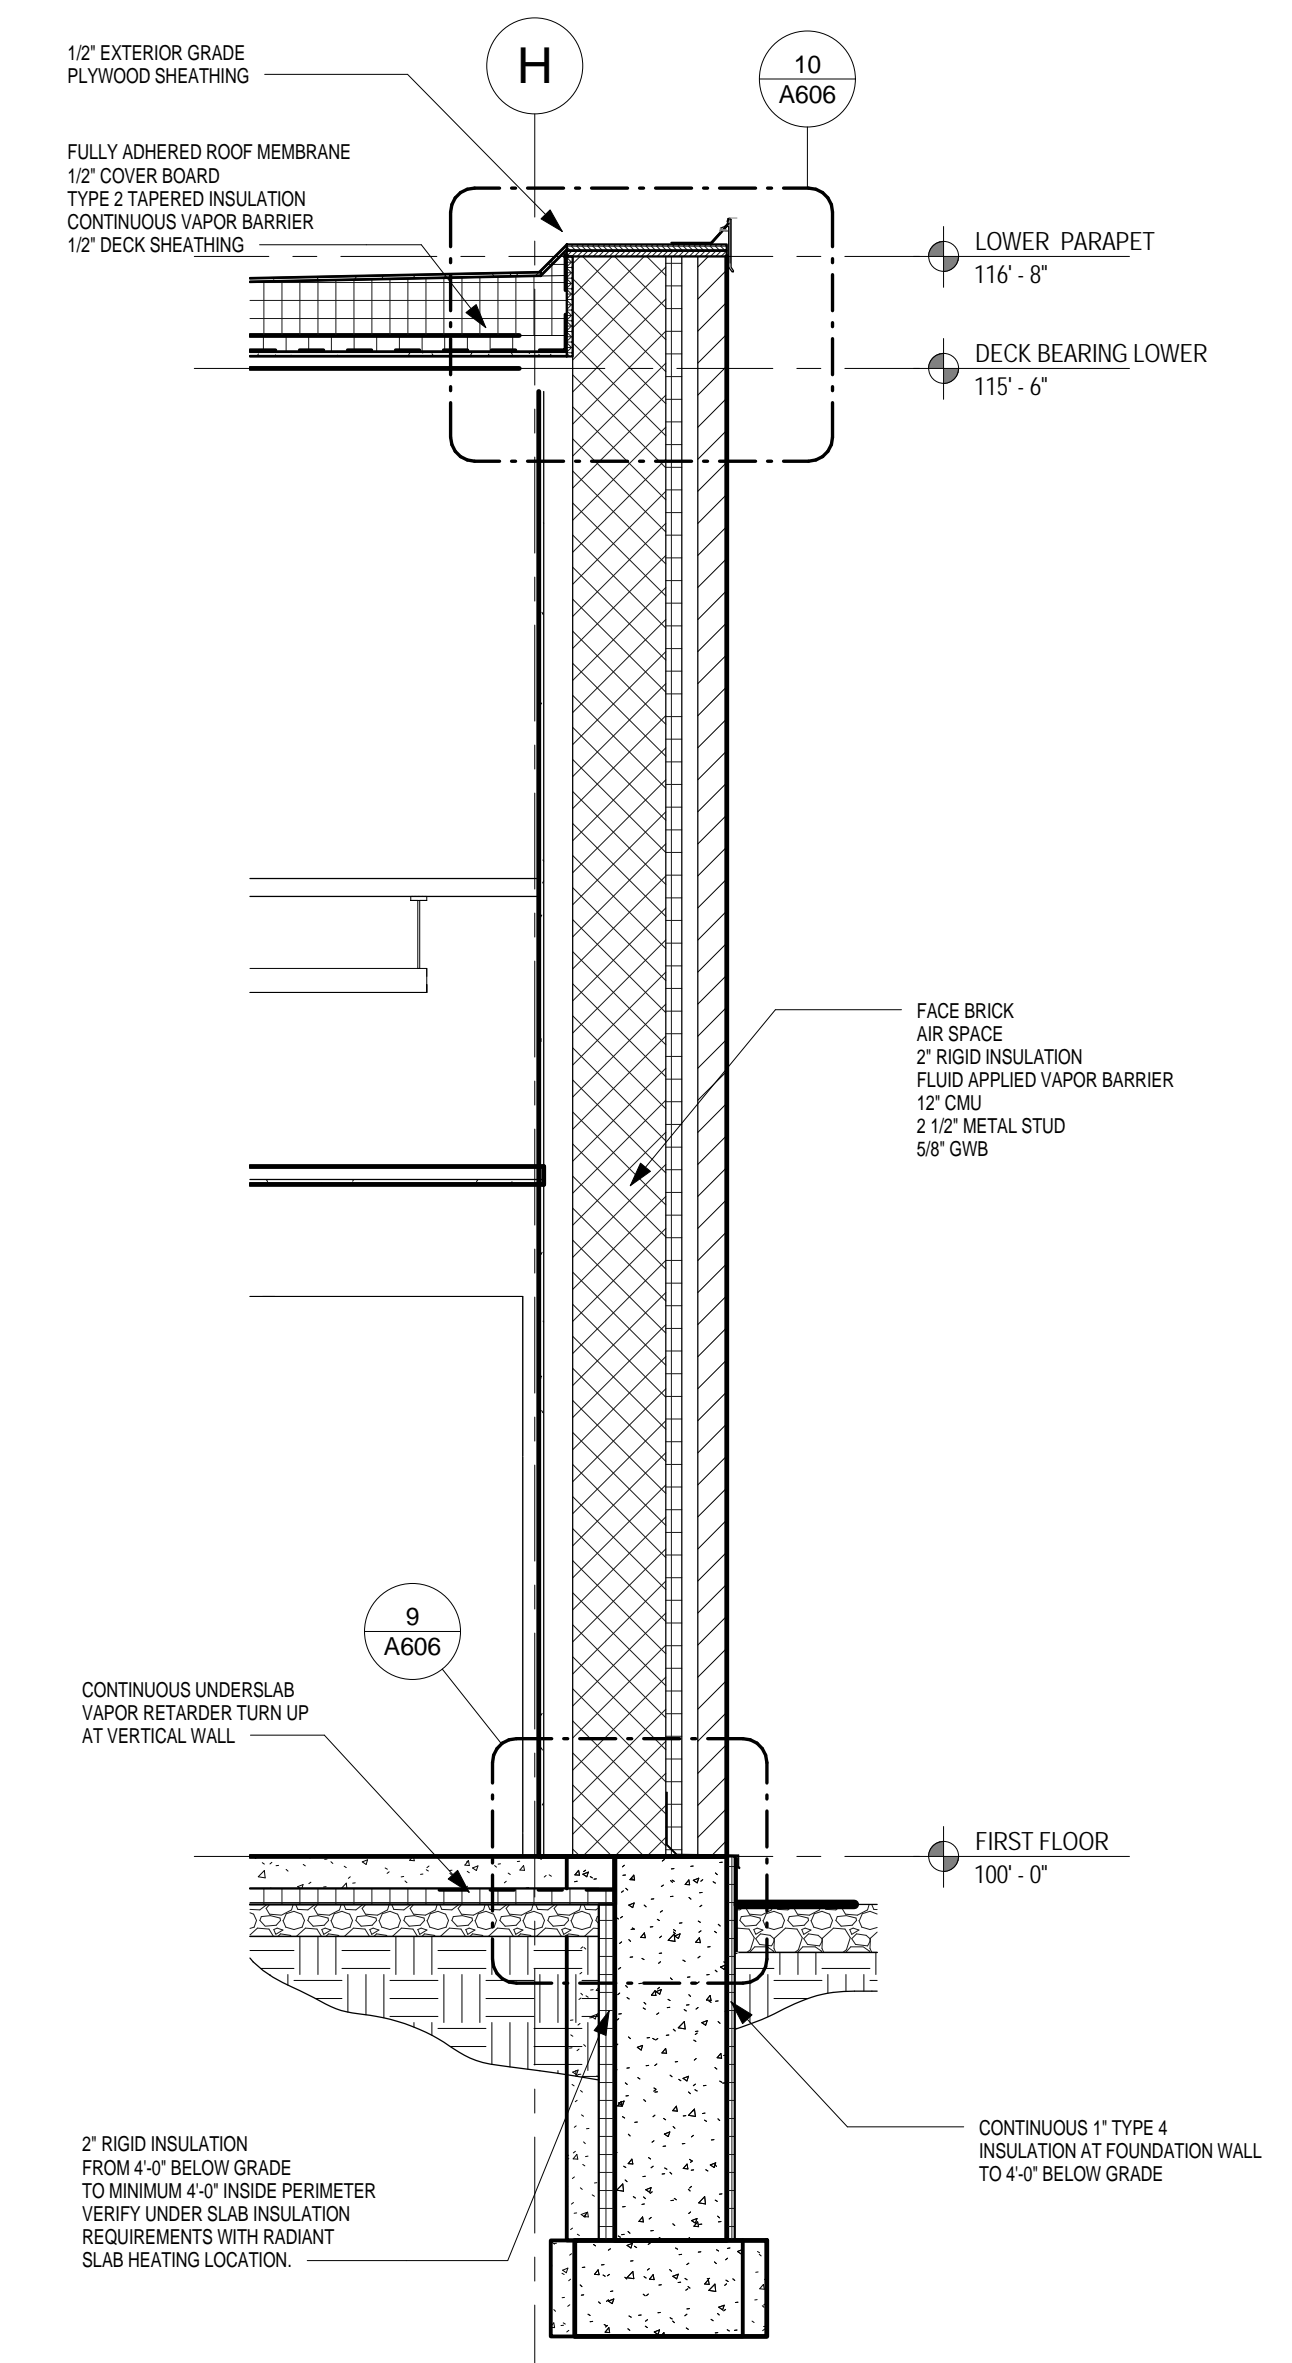


**7 WALL SECTION**  
1/2" = 1'-0"

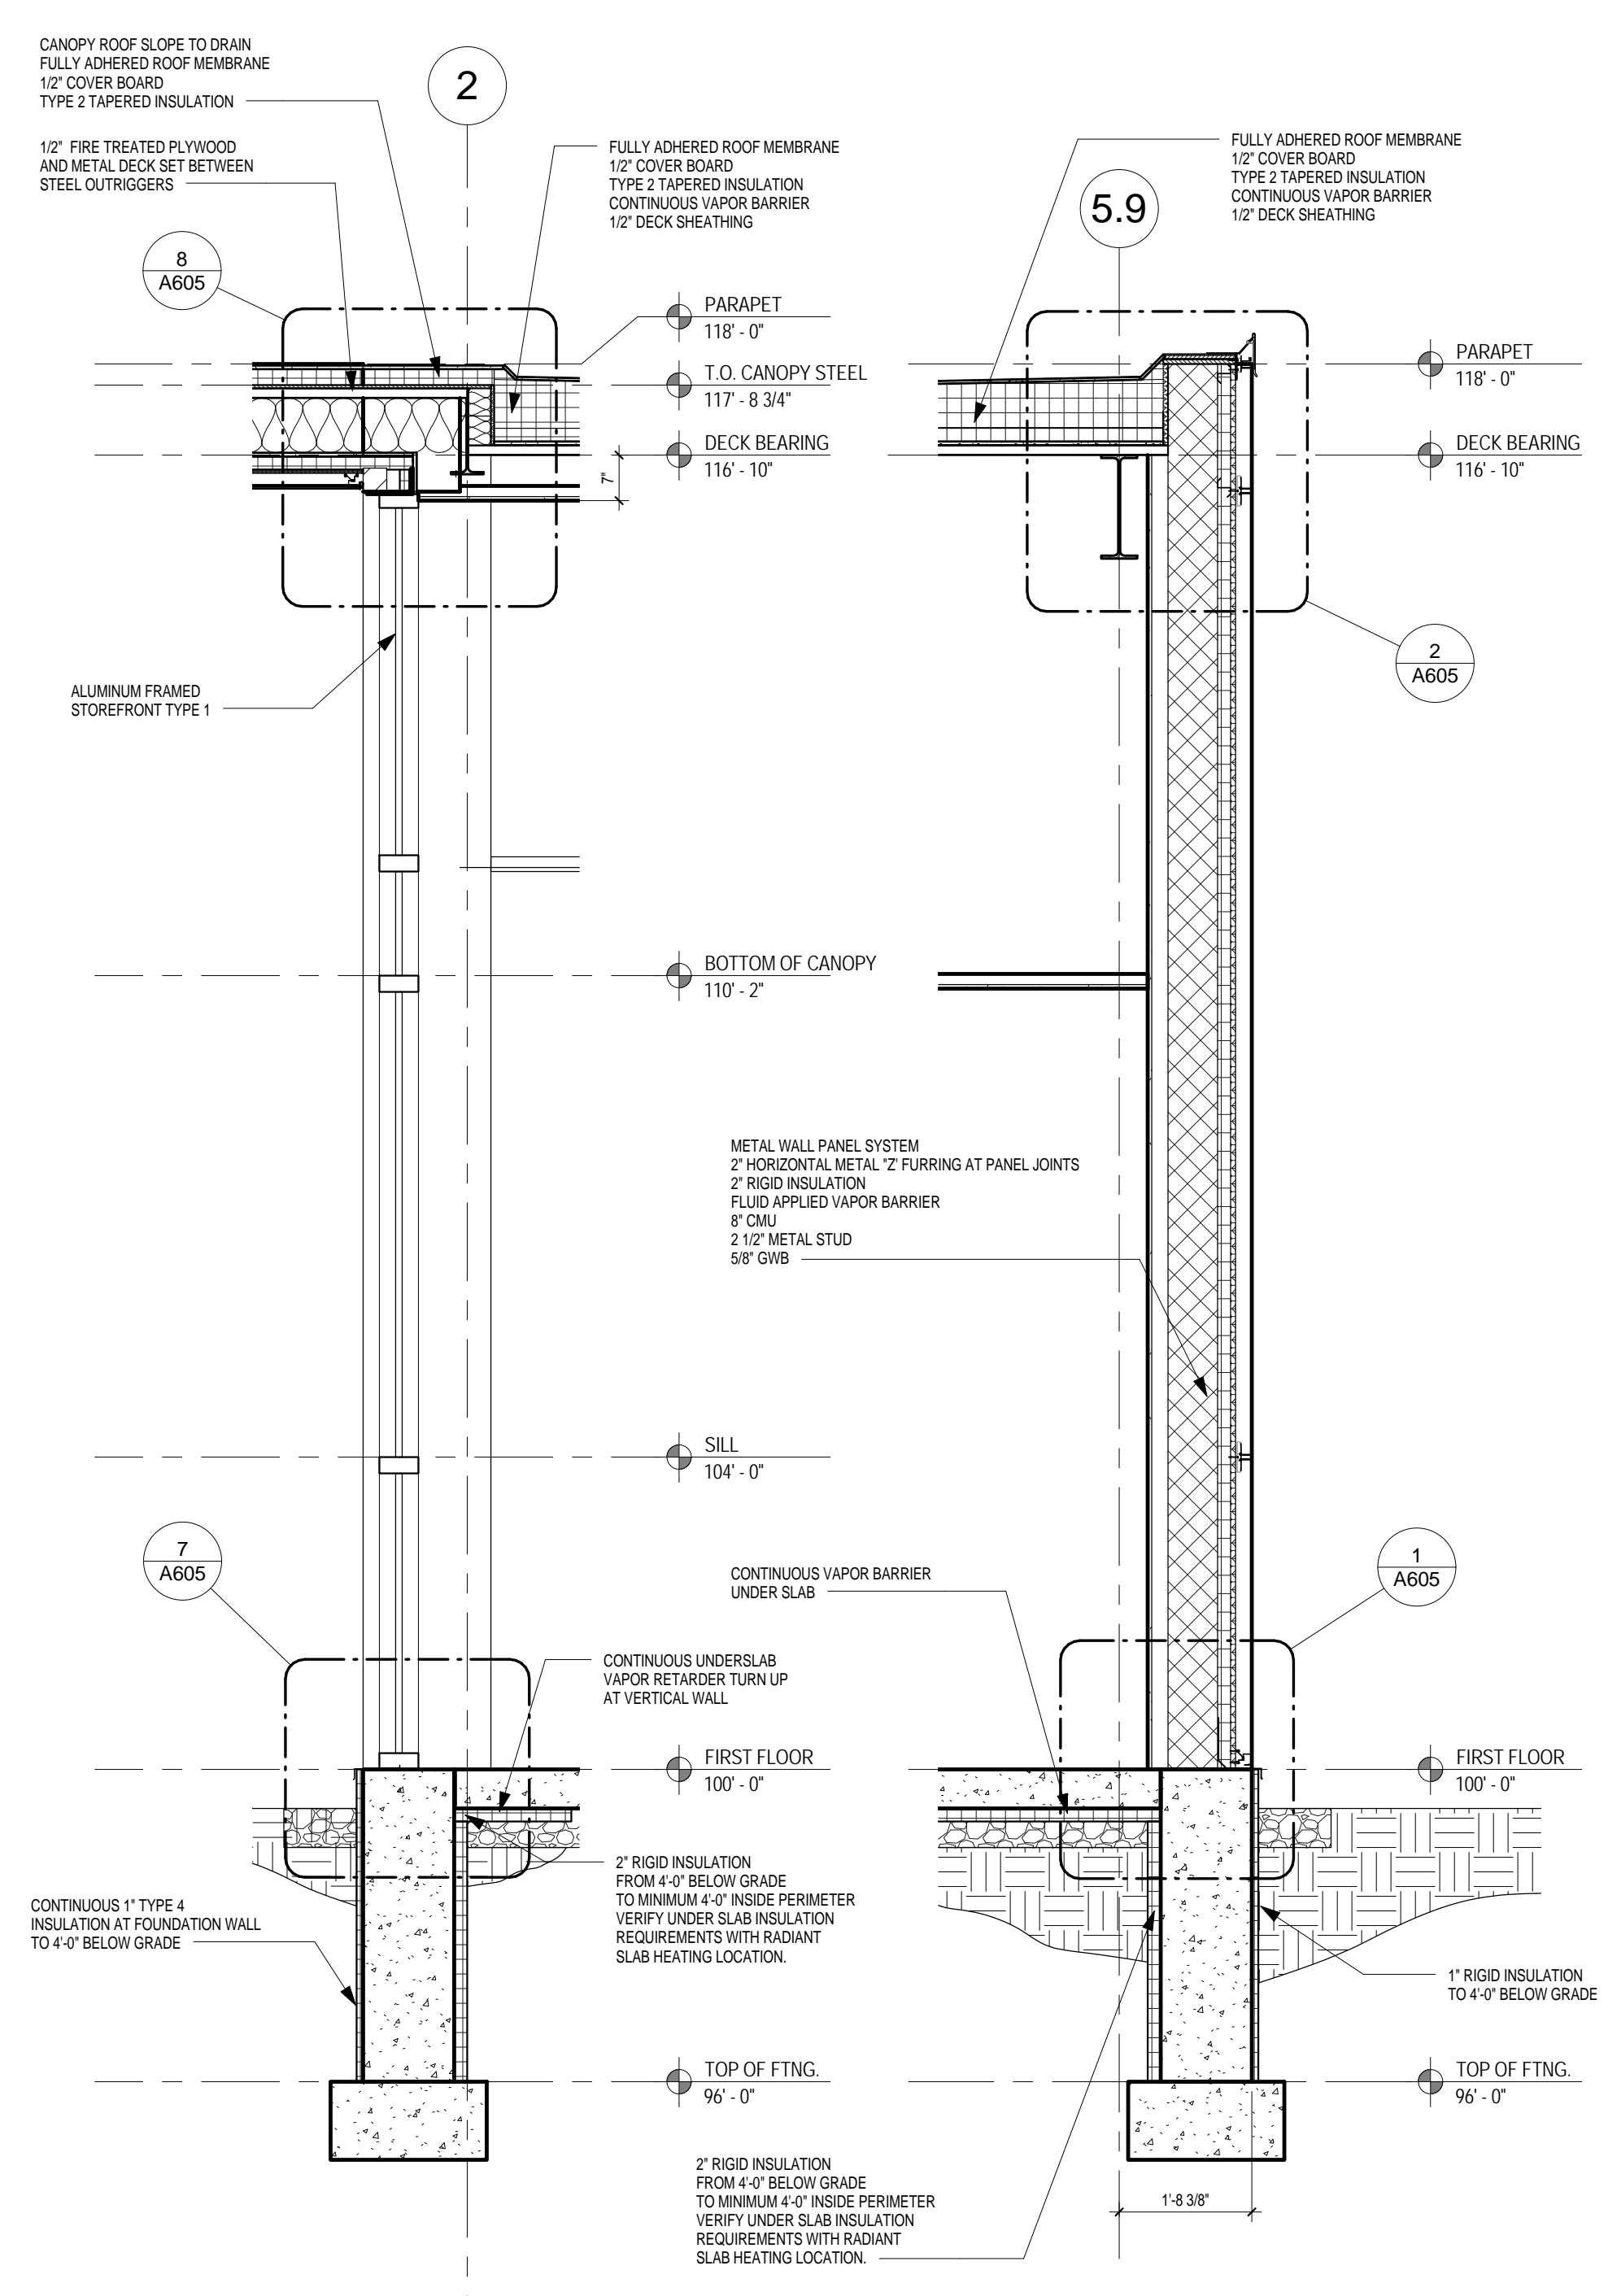


**6 WALL SECTION**  
1/2" = 1'-0"


**5 WALL SECTION**  
1/2" = 1'-0"

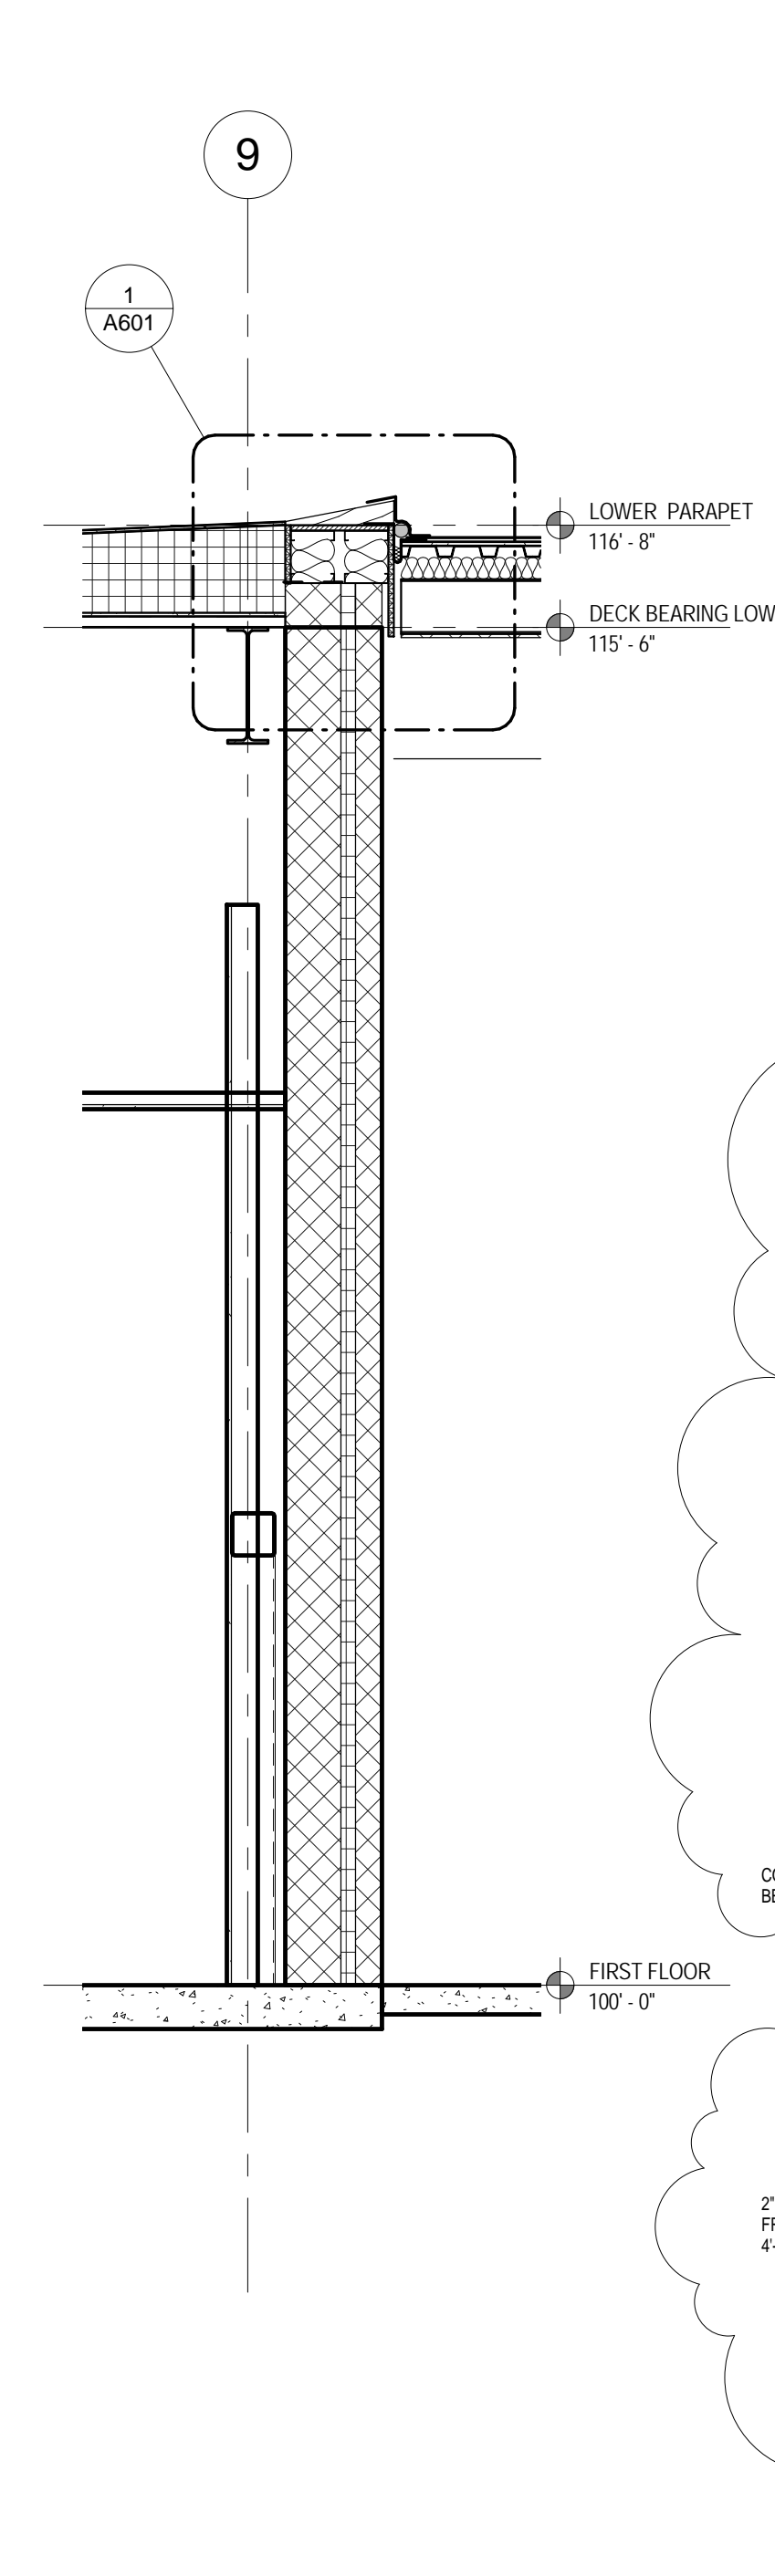


**4 WALL SECTION**  
1/2" = 1'-0"

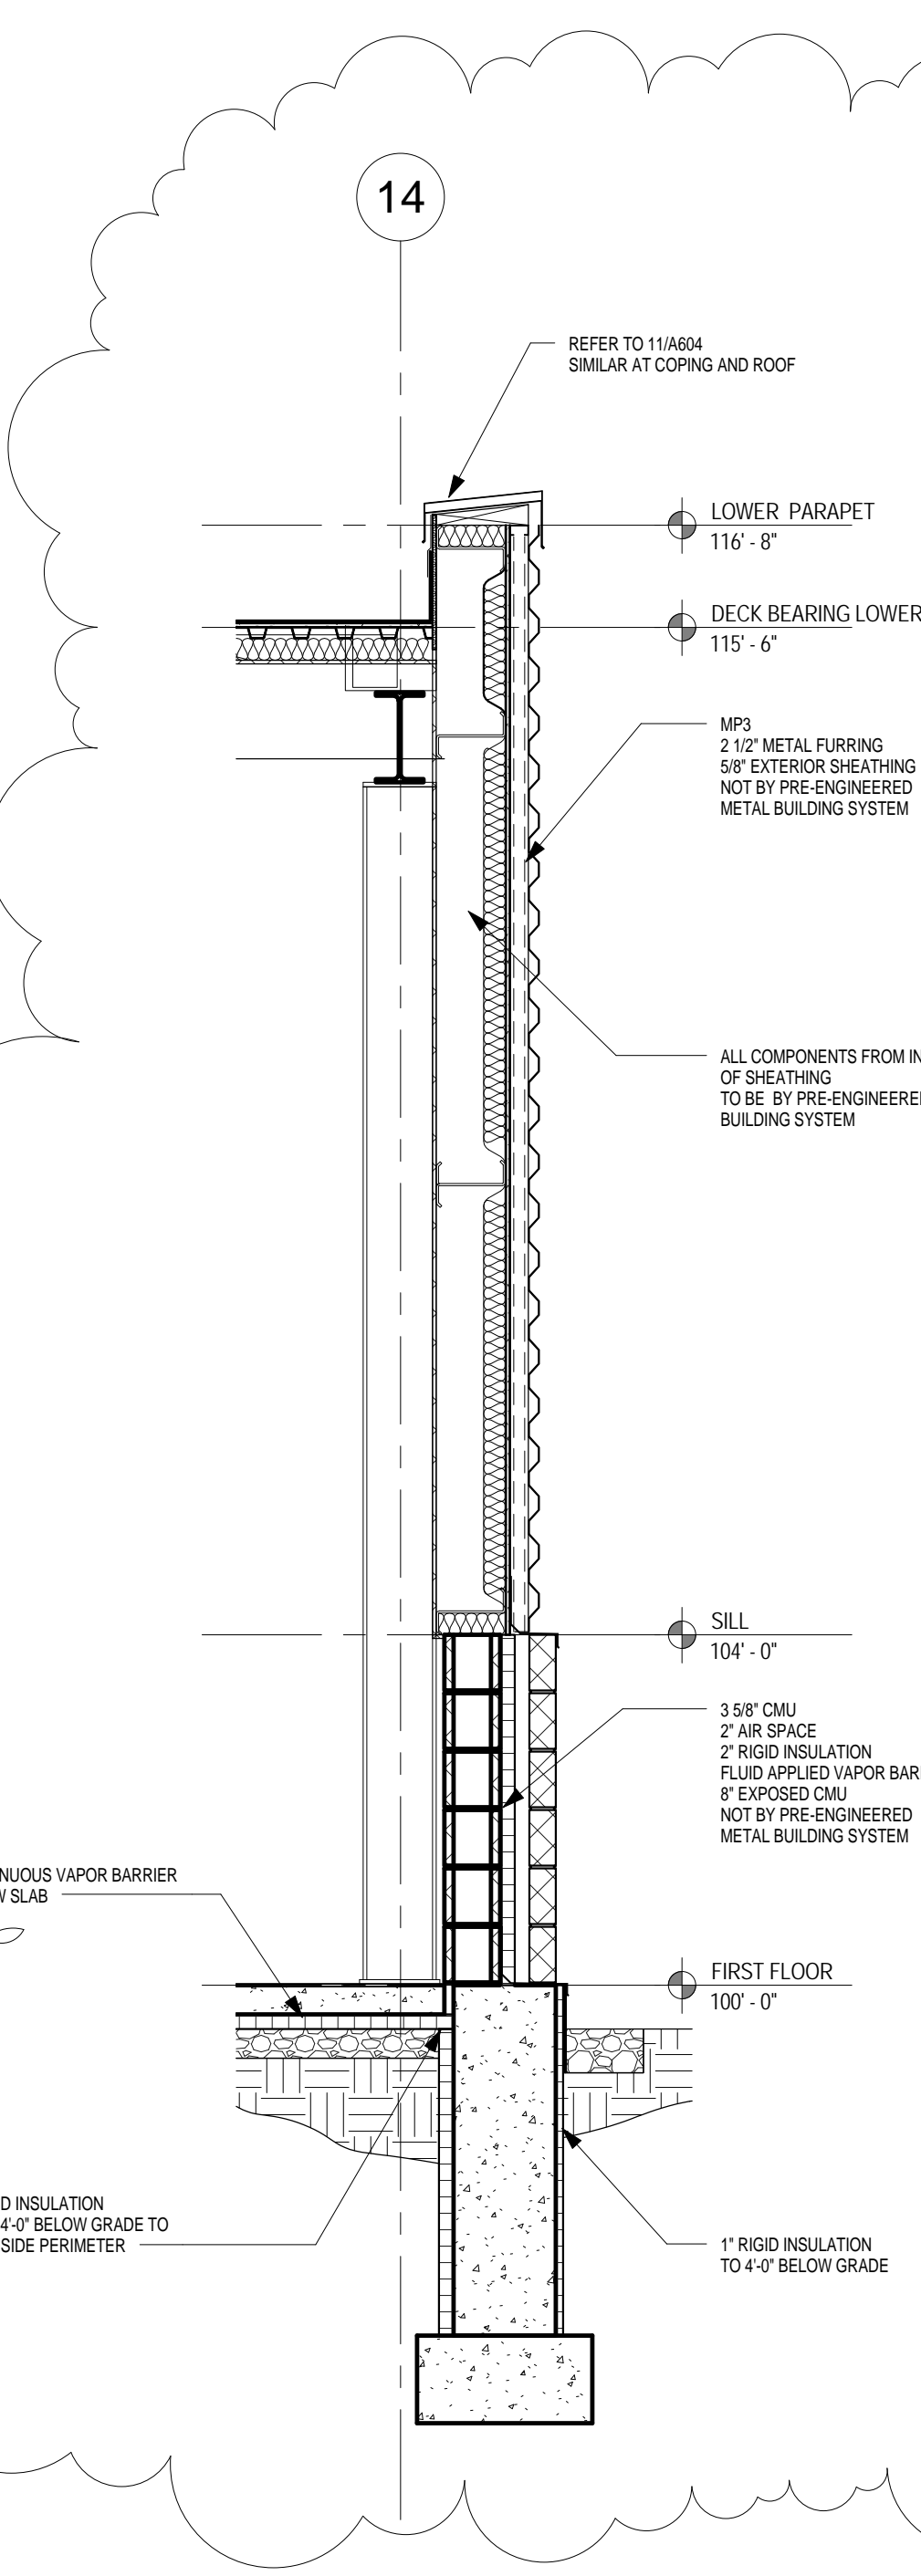

**3 WALL SECTION**  
1/2" = 1'-0"

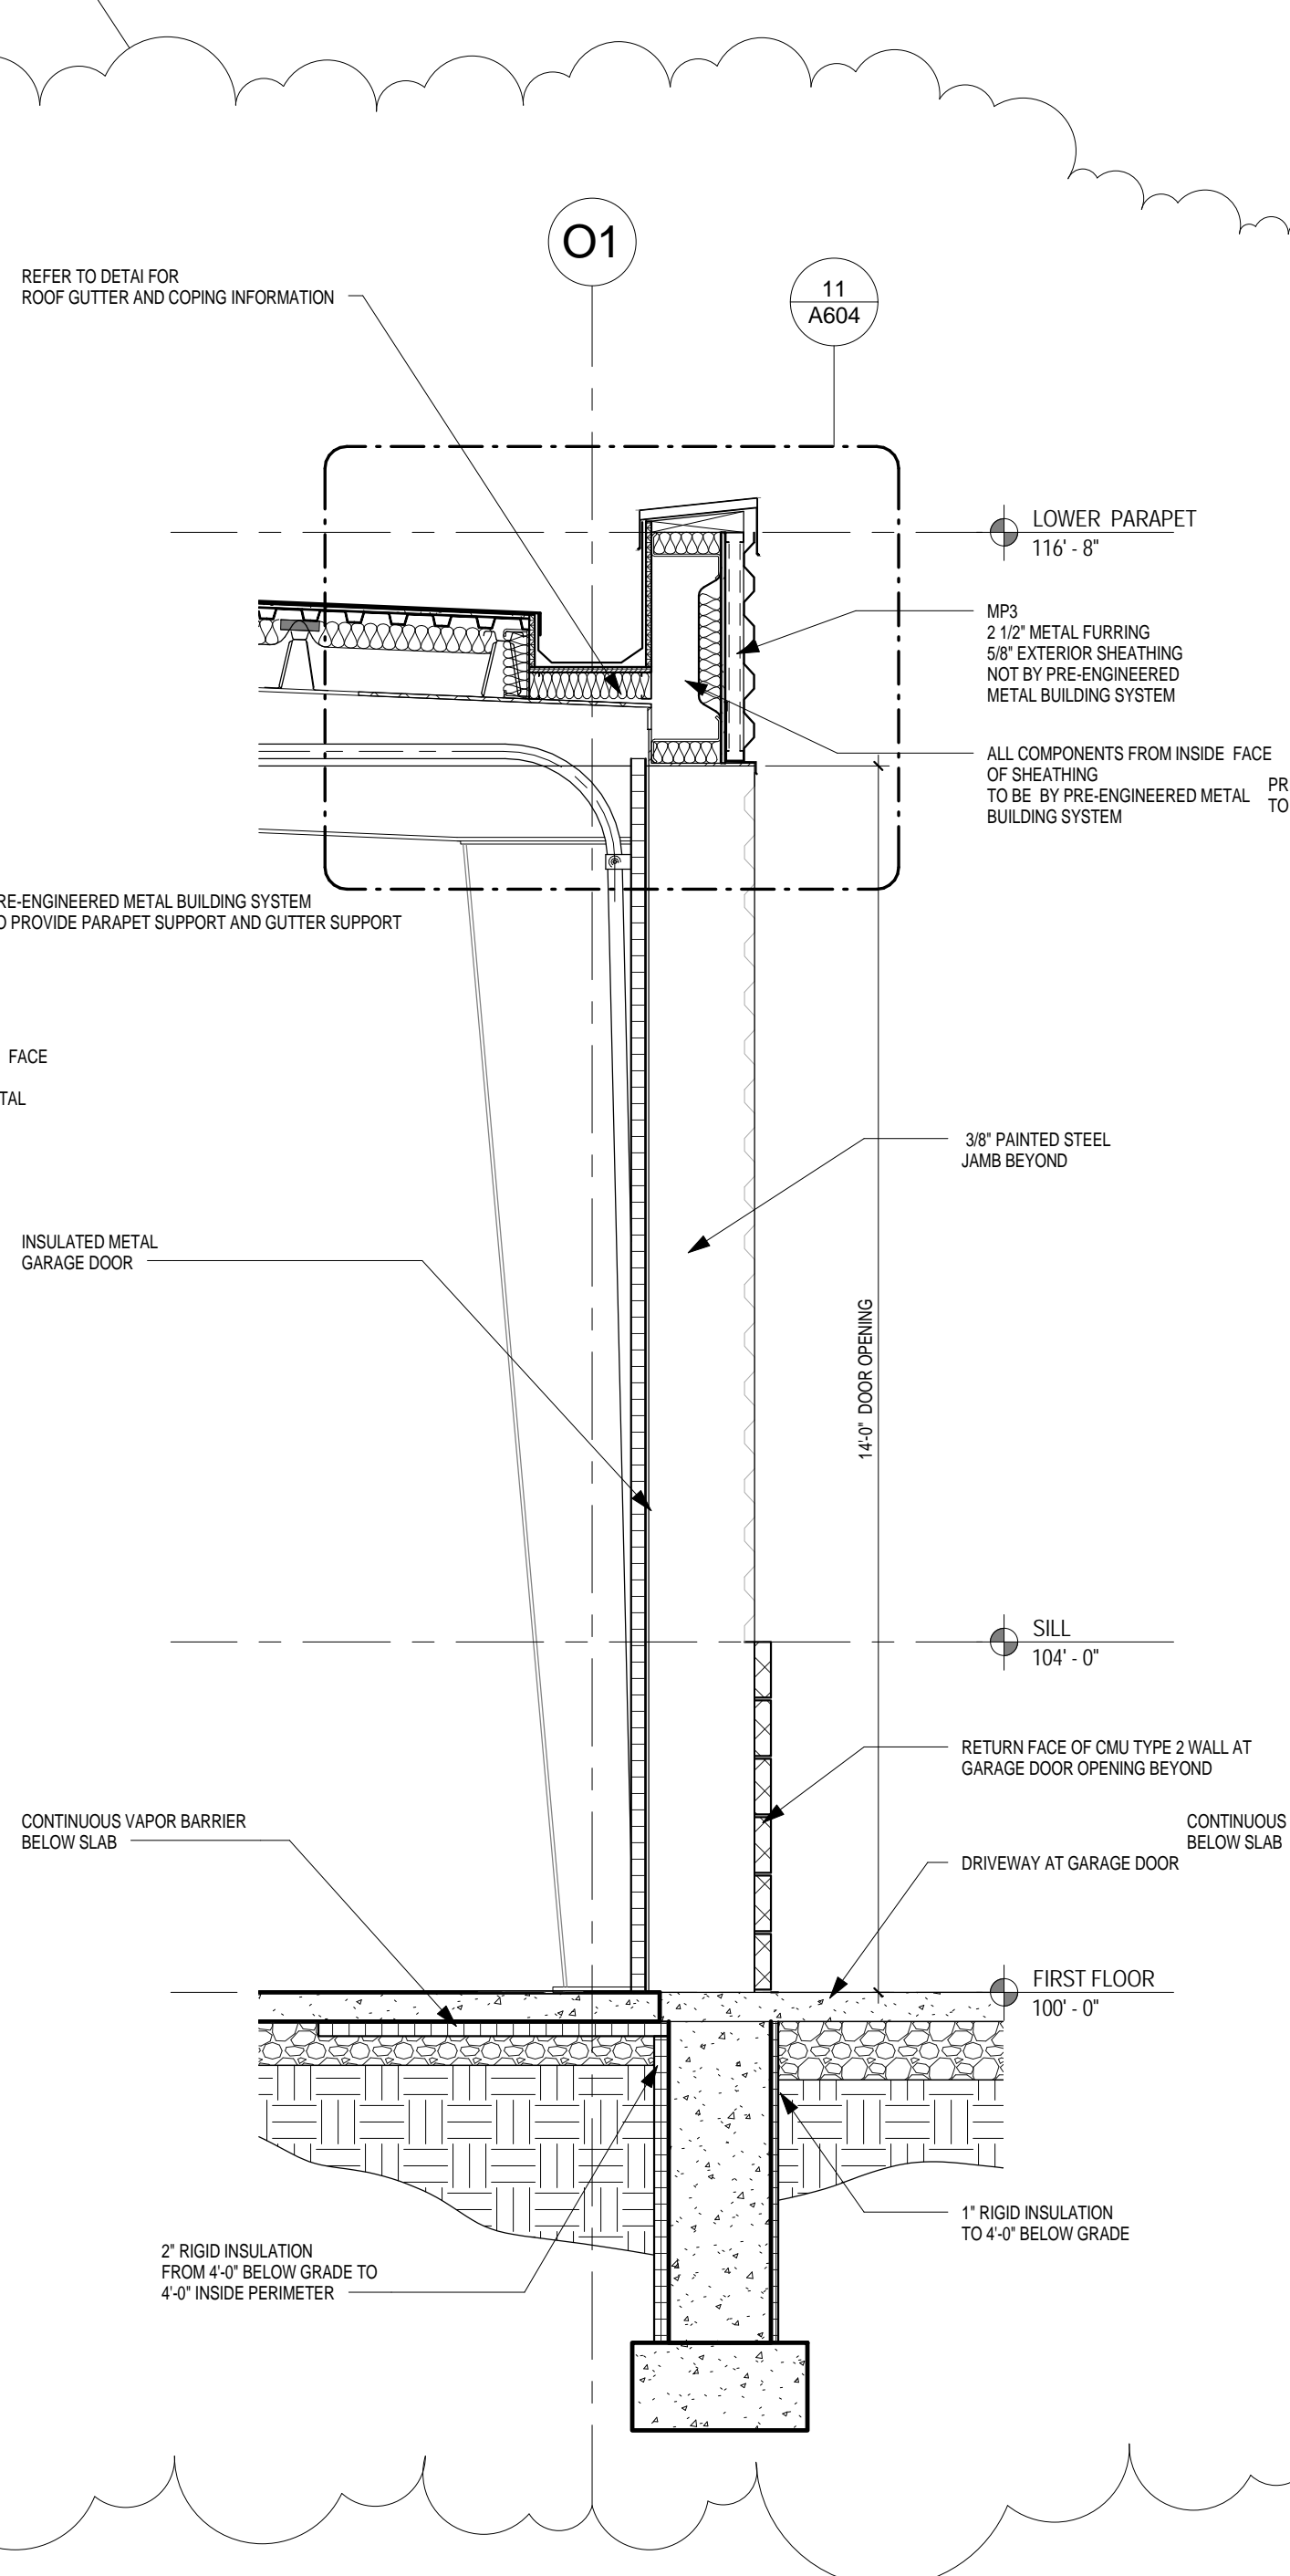


**2 WALL SECTION**  
1/2" = 1'-0"

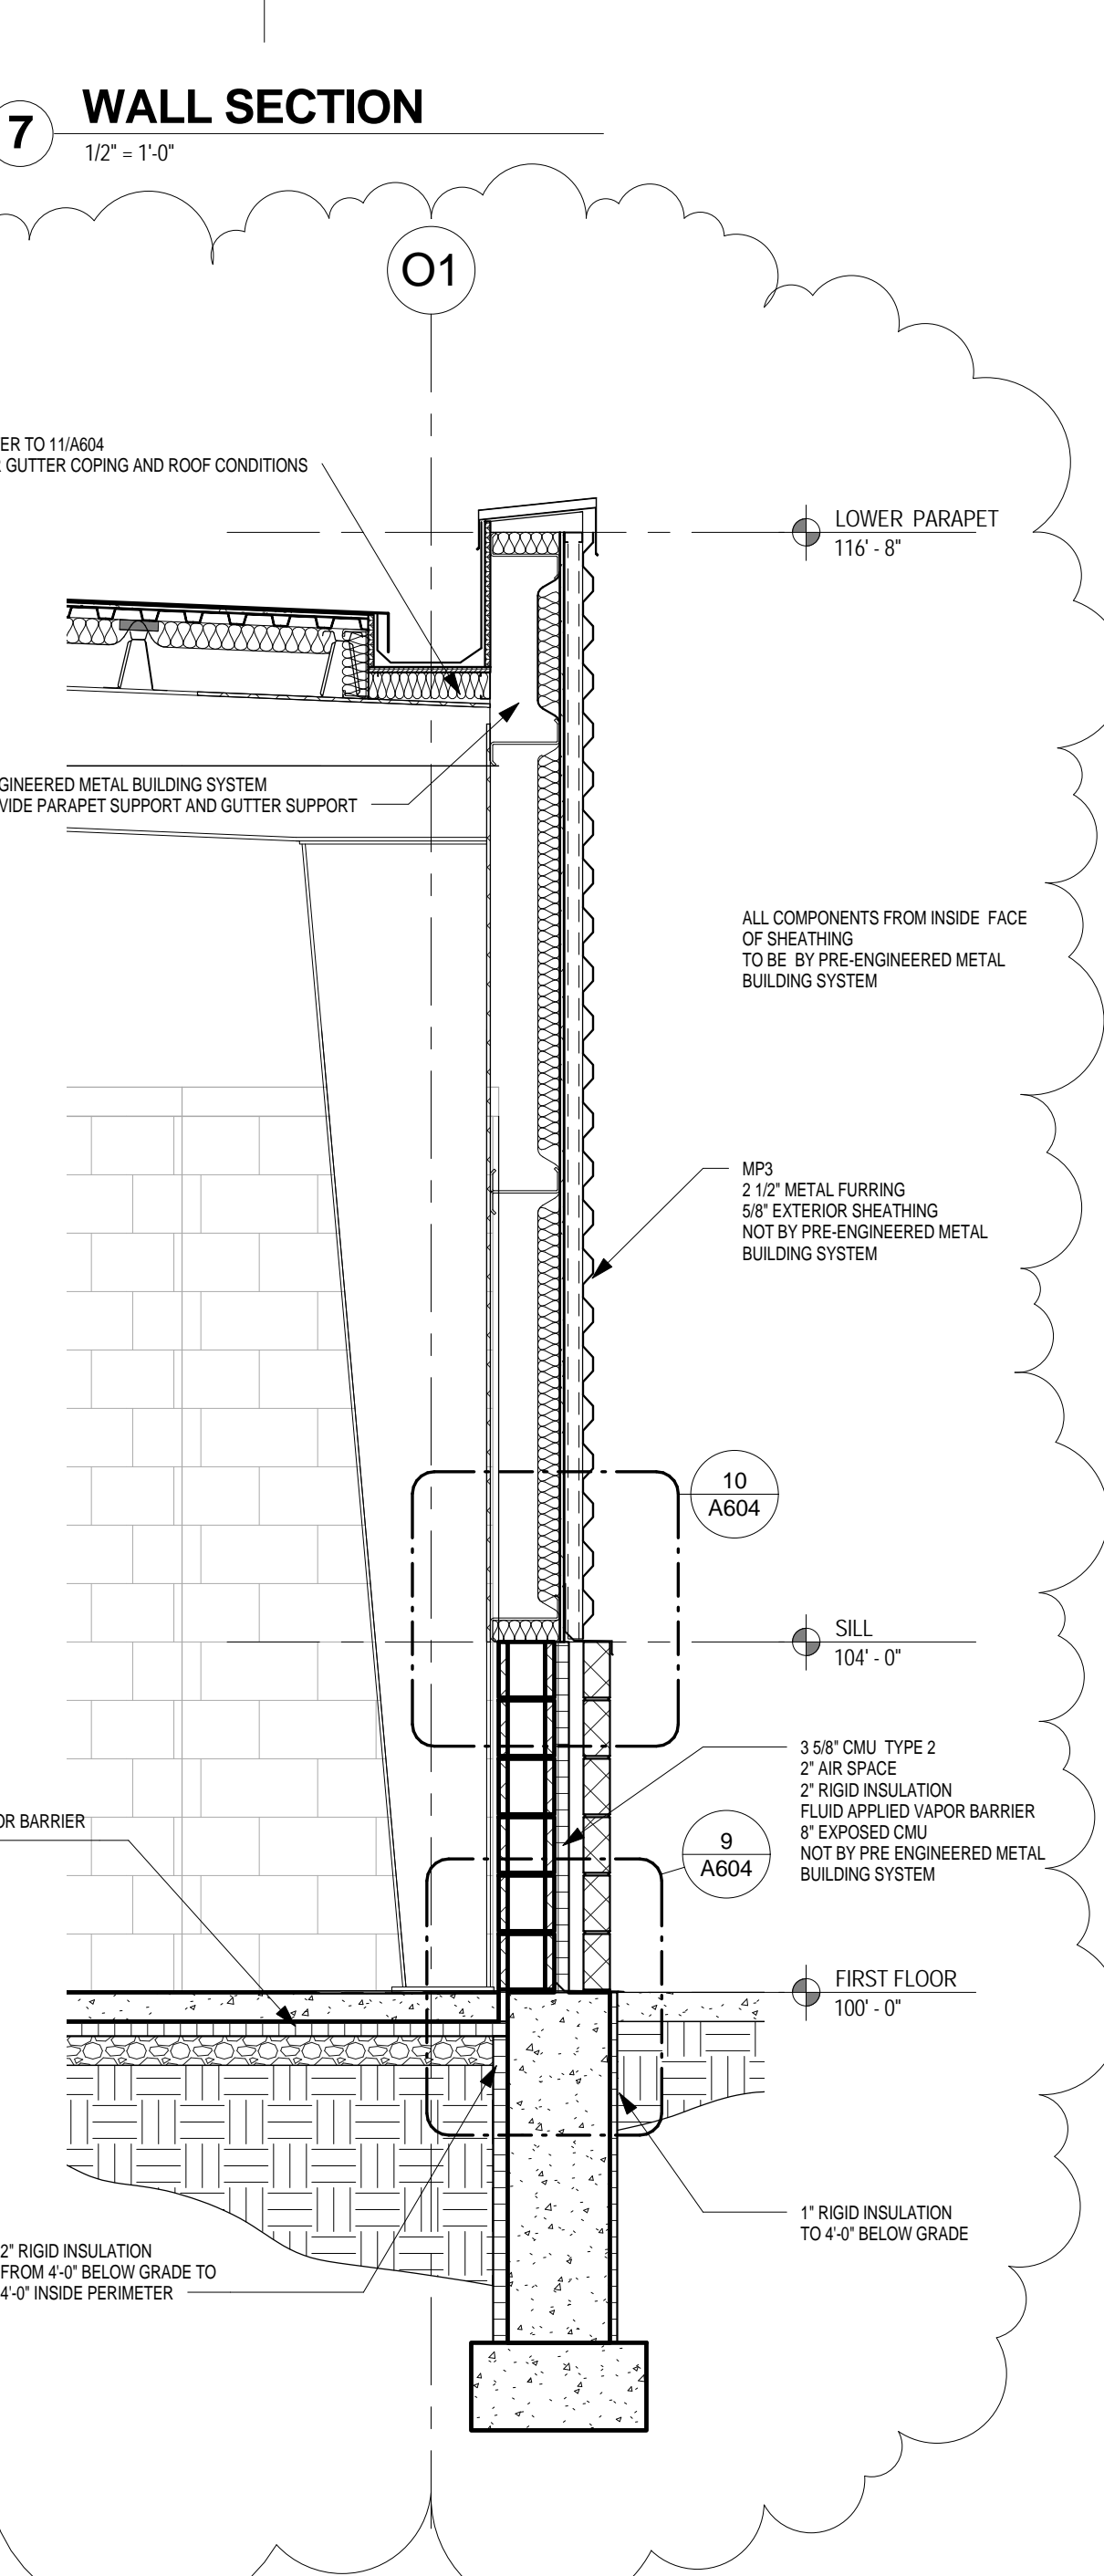


**1 WALL SECTION**  
1/2" = 1'-0"




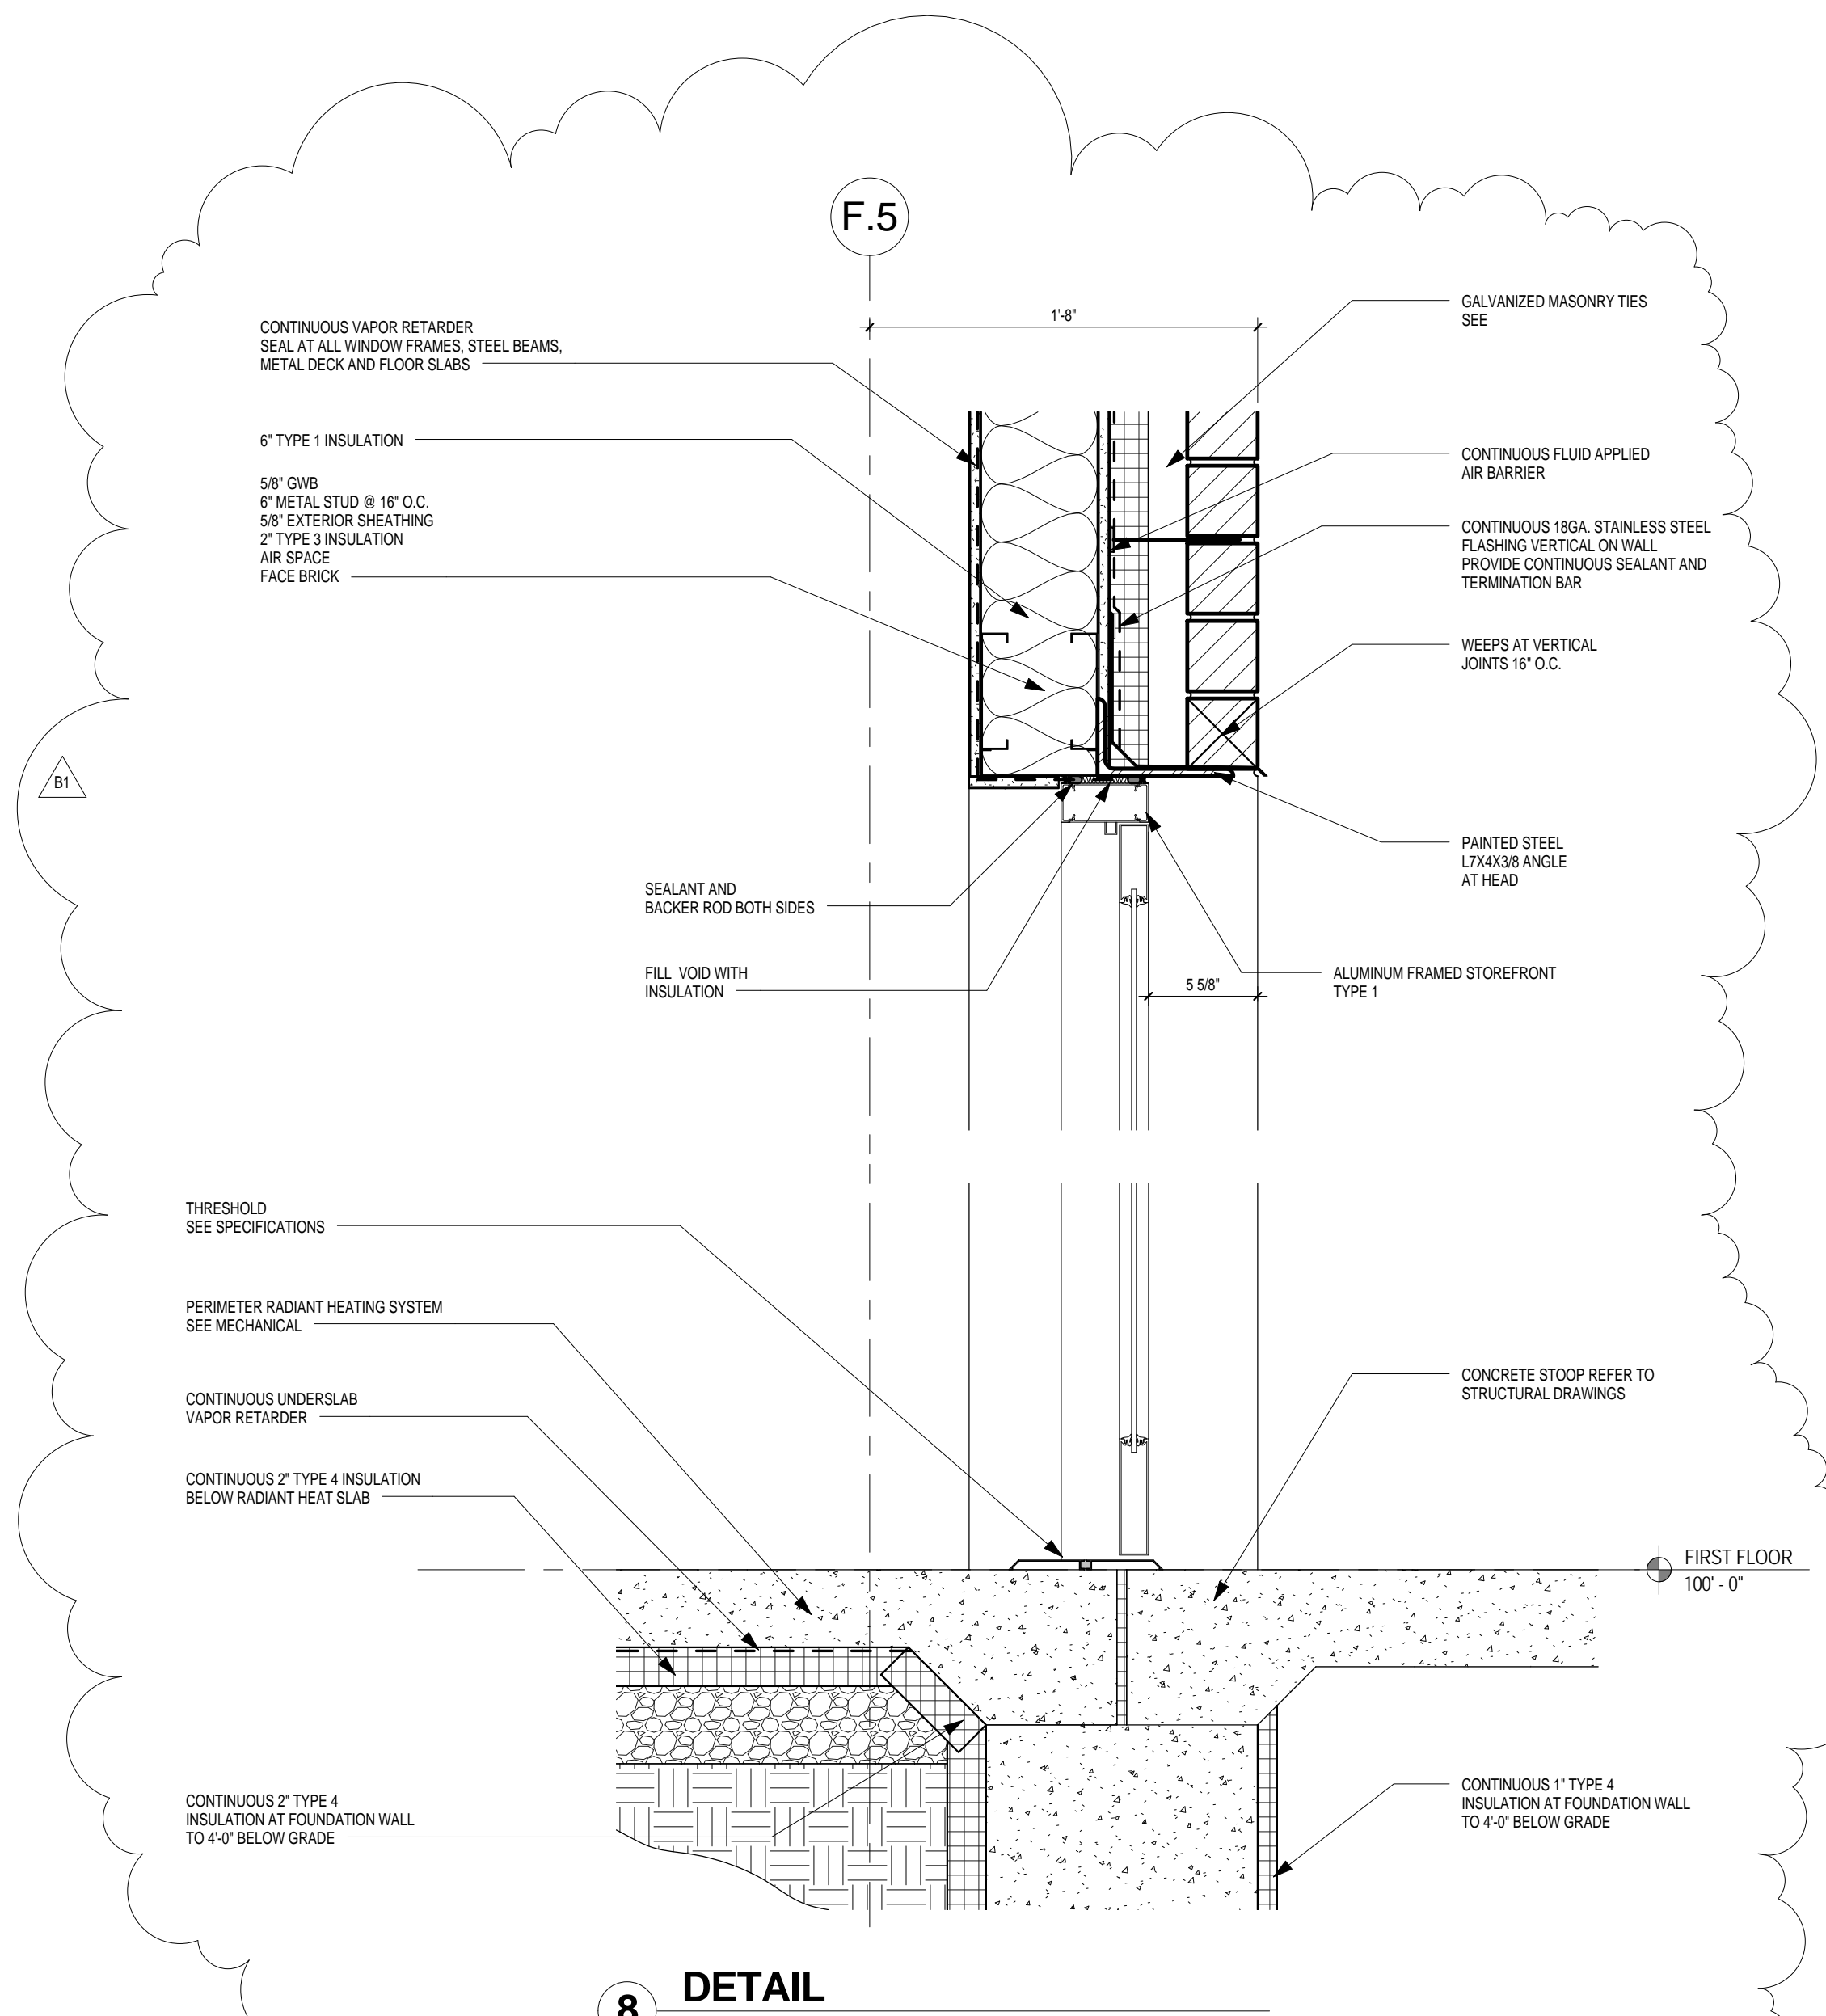


8 DETAIL  
1 1/2" = 1'-0"

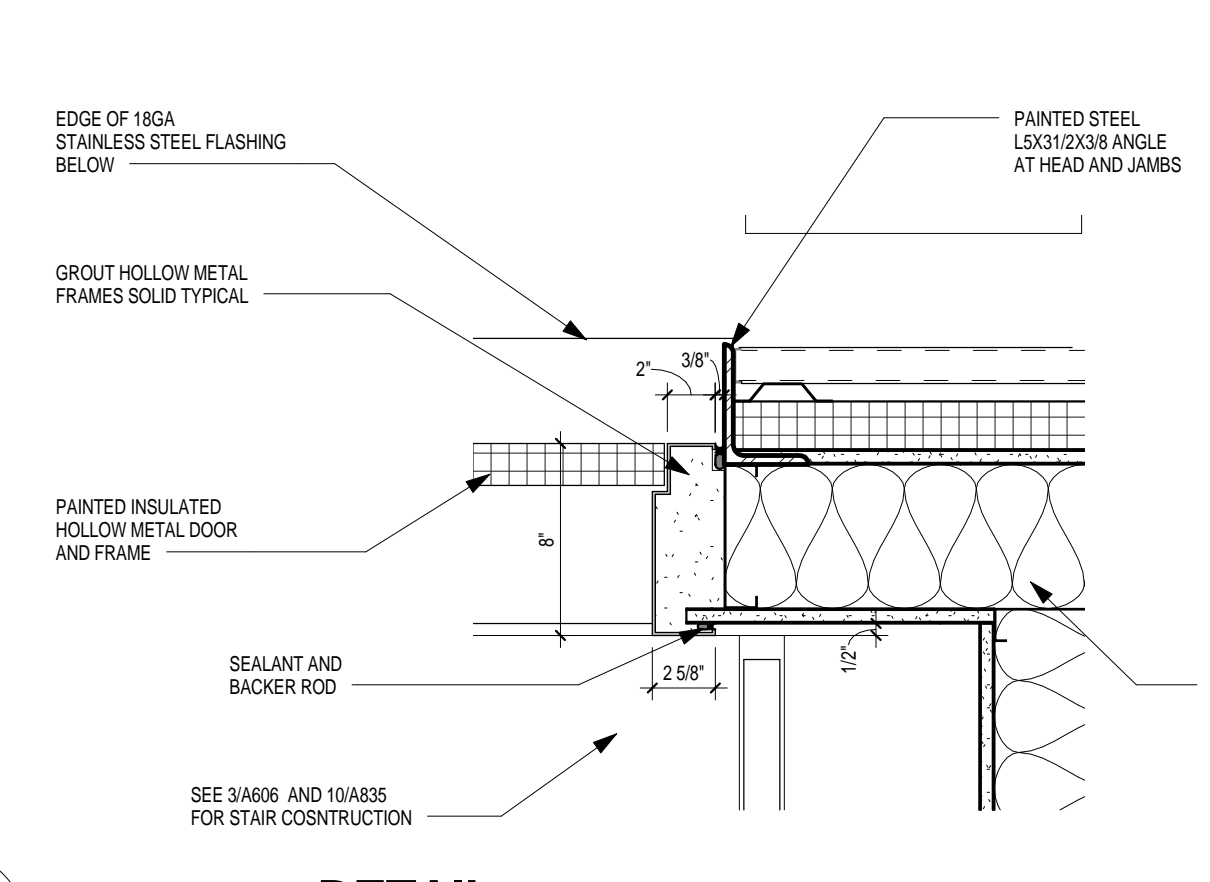


5 DETAIL  
1 1/2" = 1'-0"

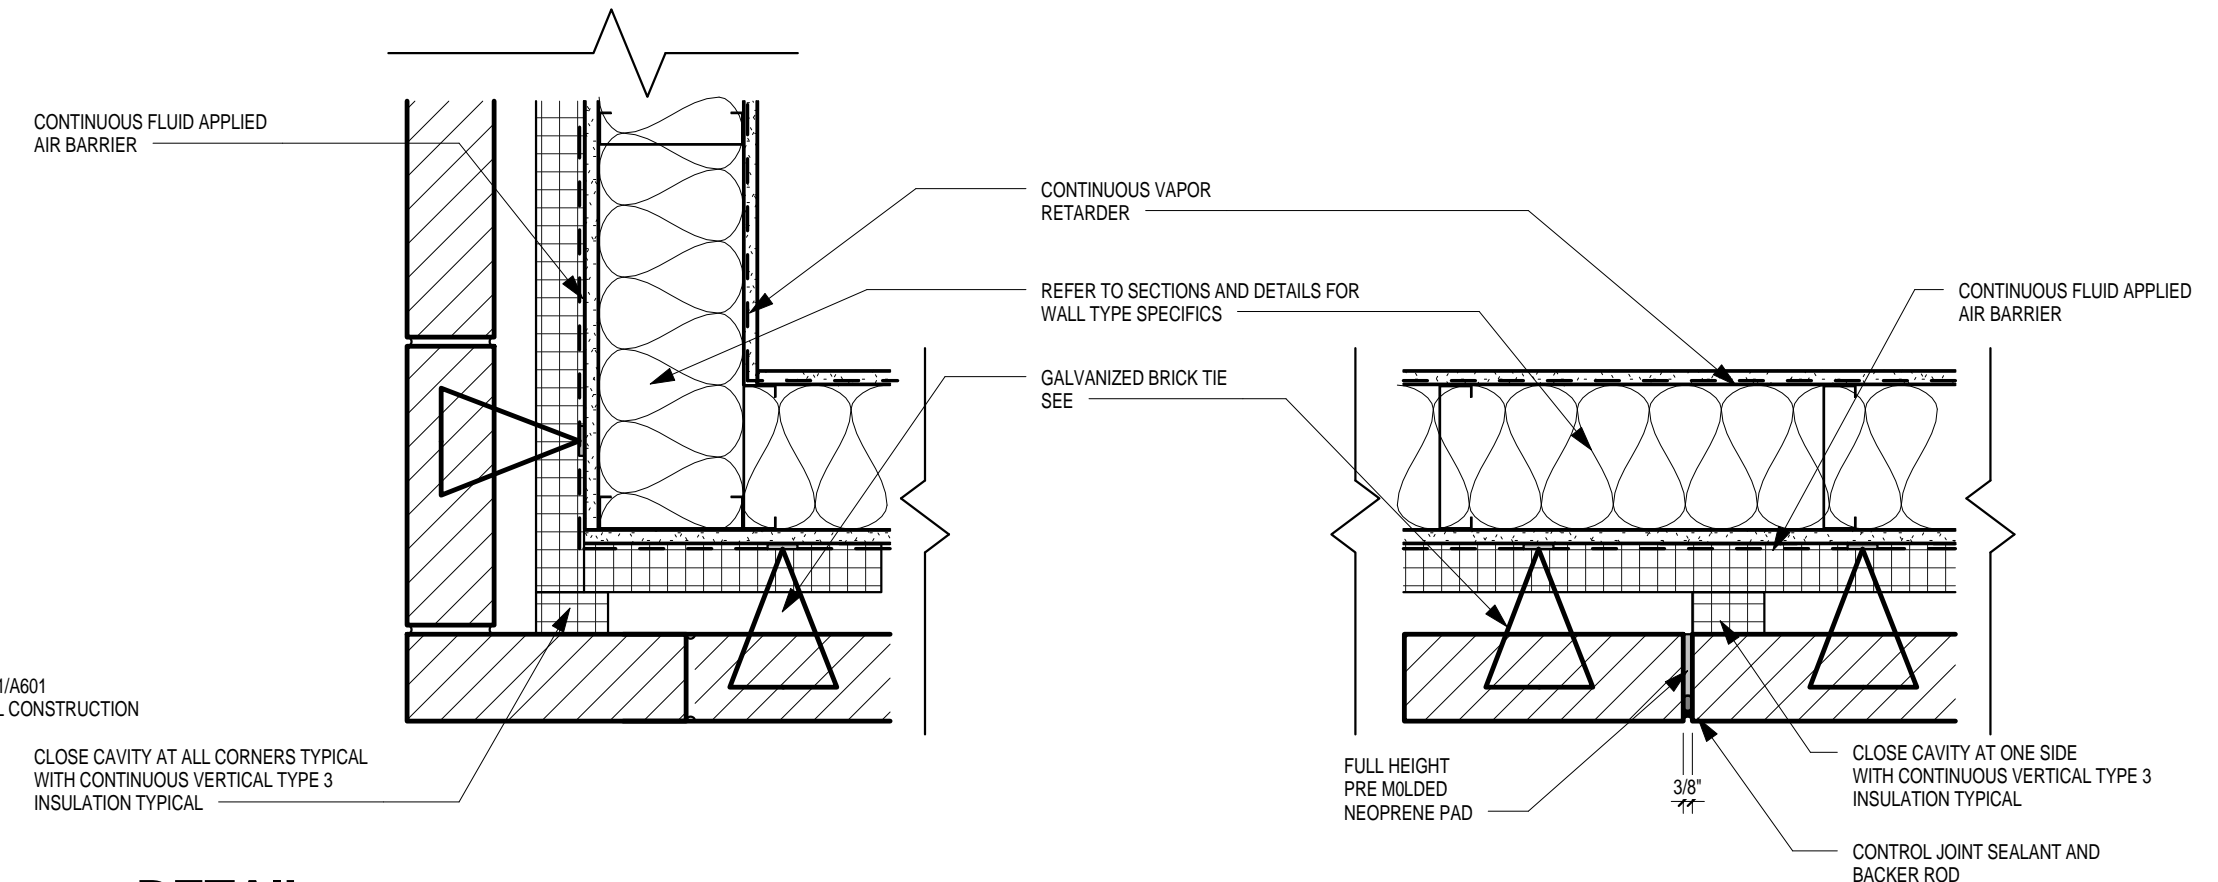


2 DETAIL  
1 1/2" = 1'-0"

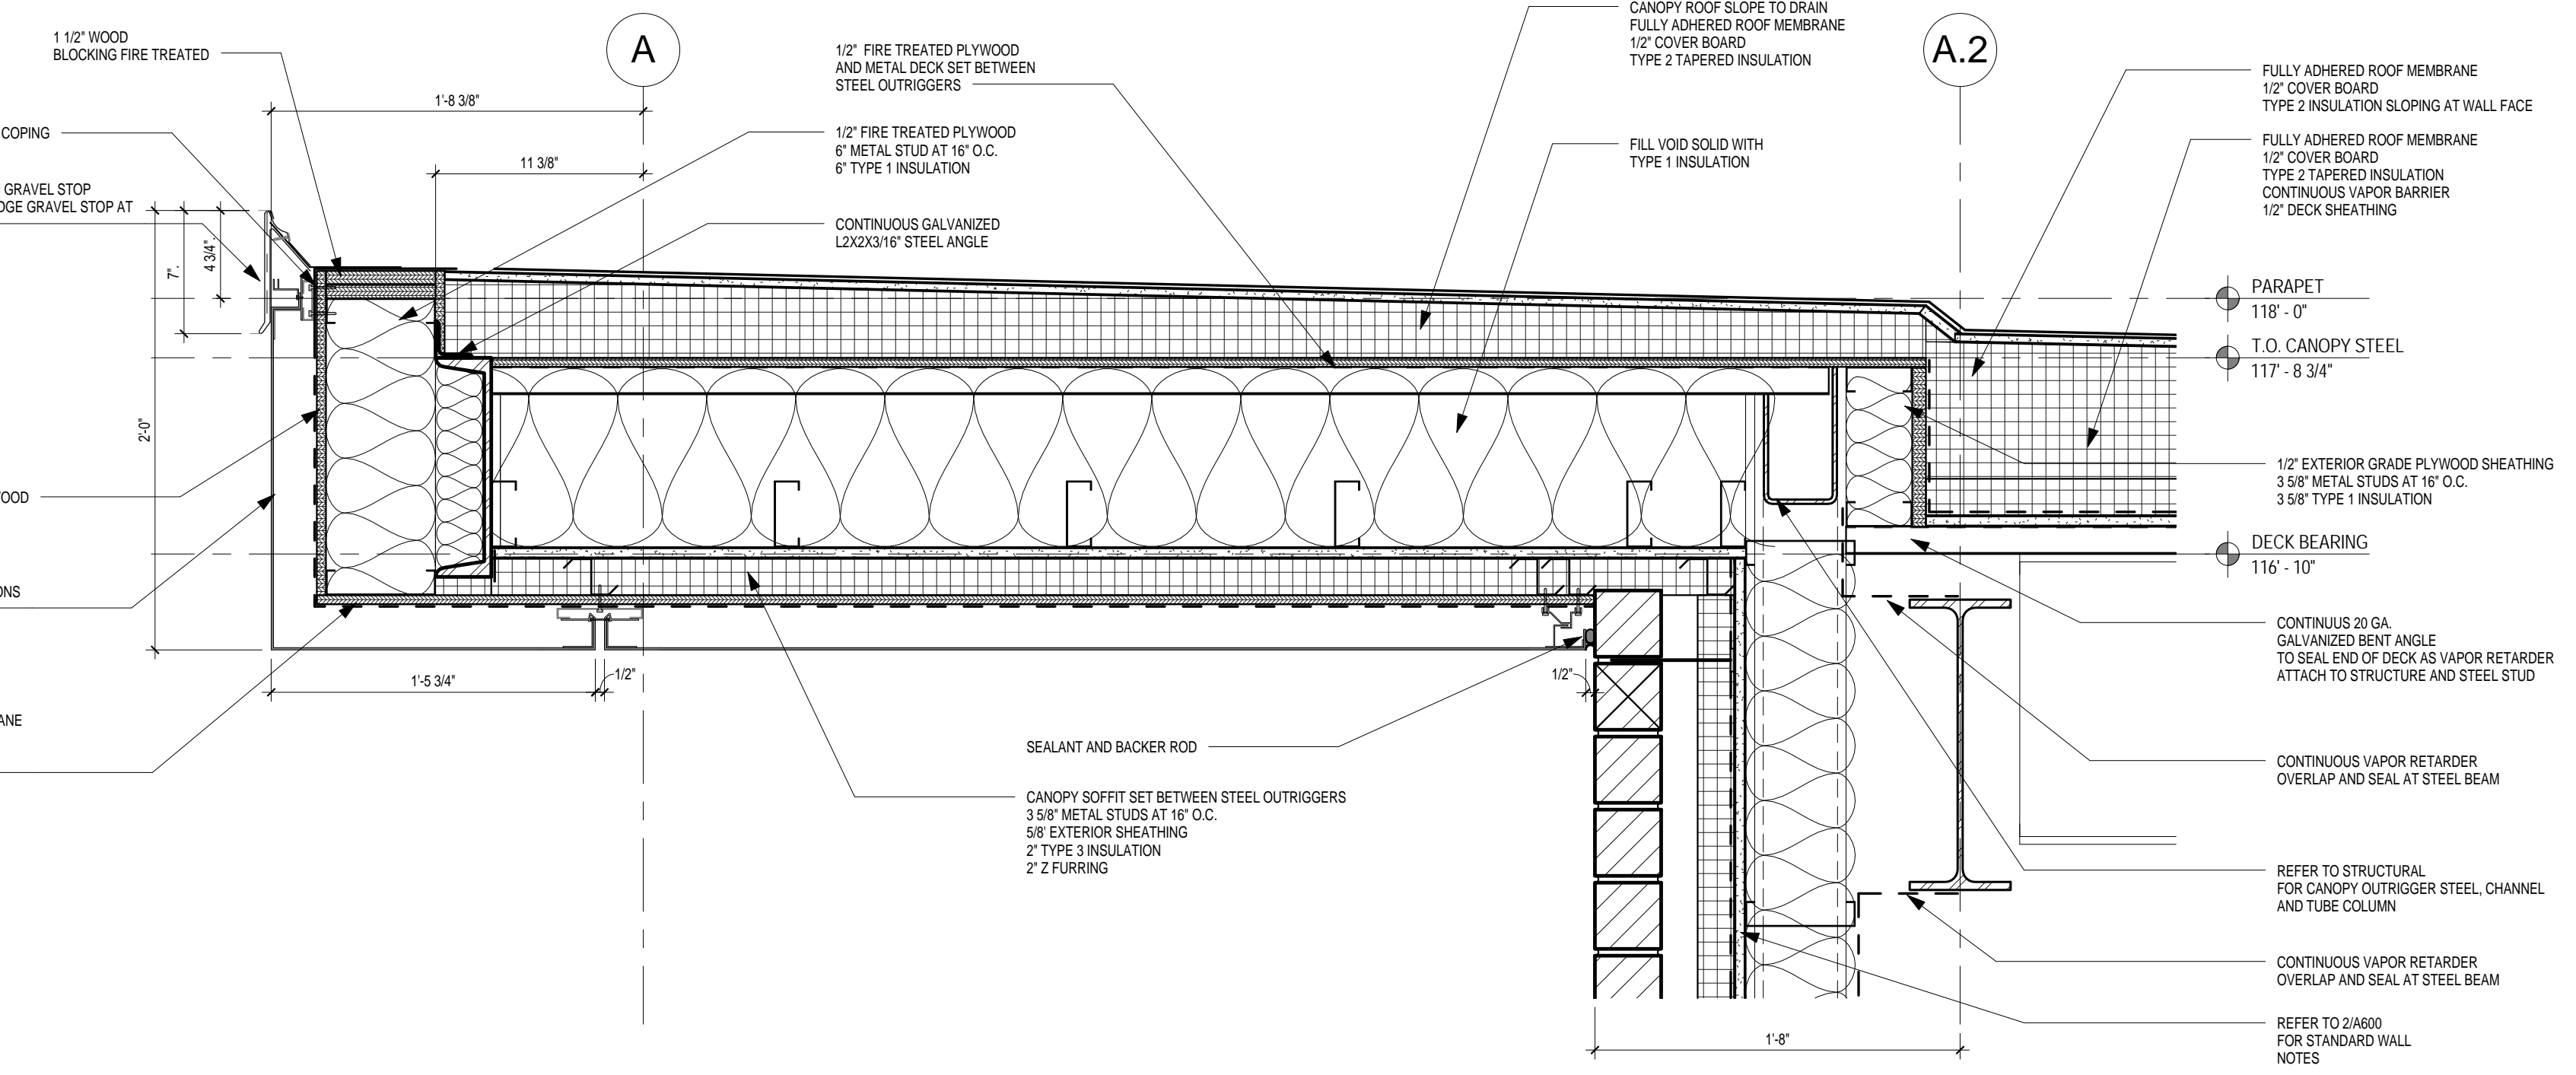


4 DETAIL  
1 1/2" = 1'-0"

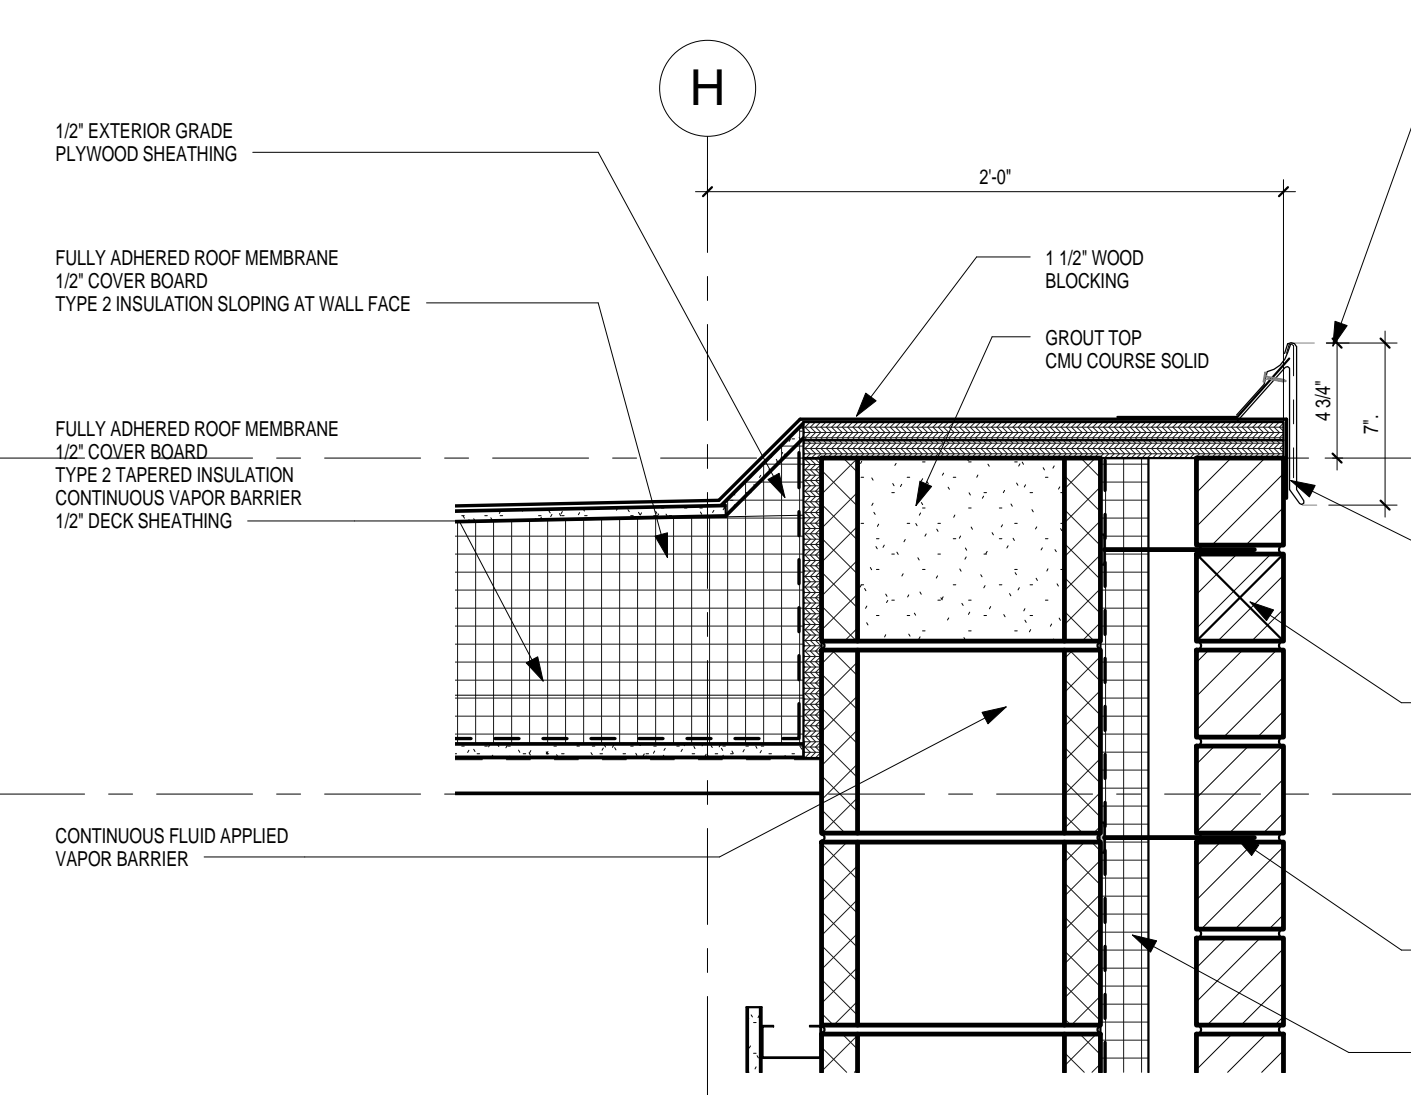


10 DETAIL  
1 1/2" = 1'-0"

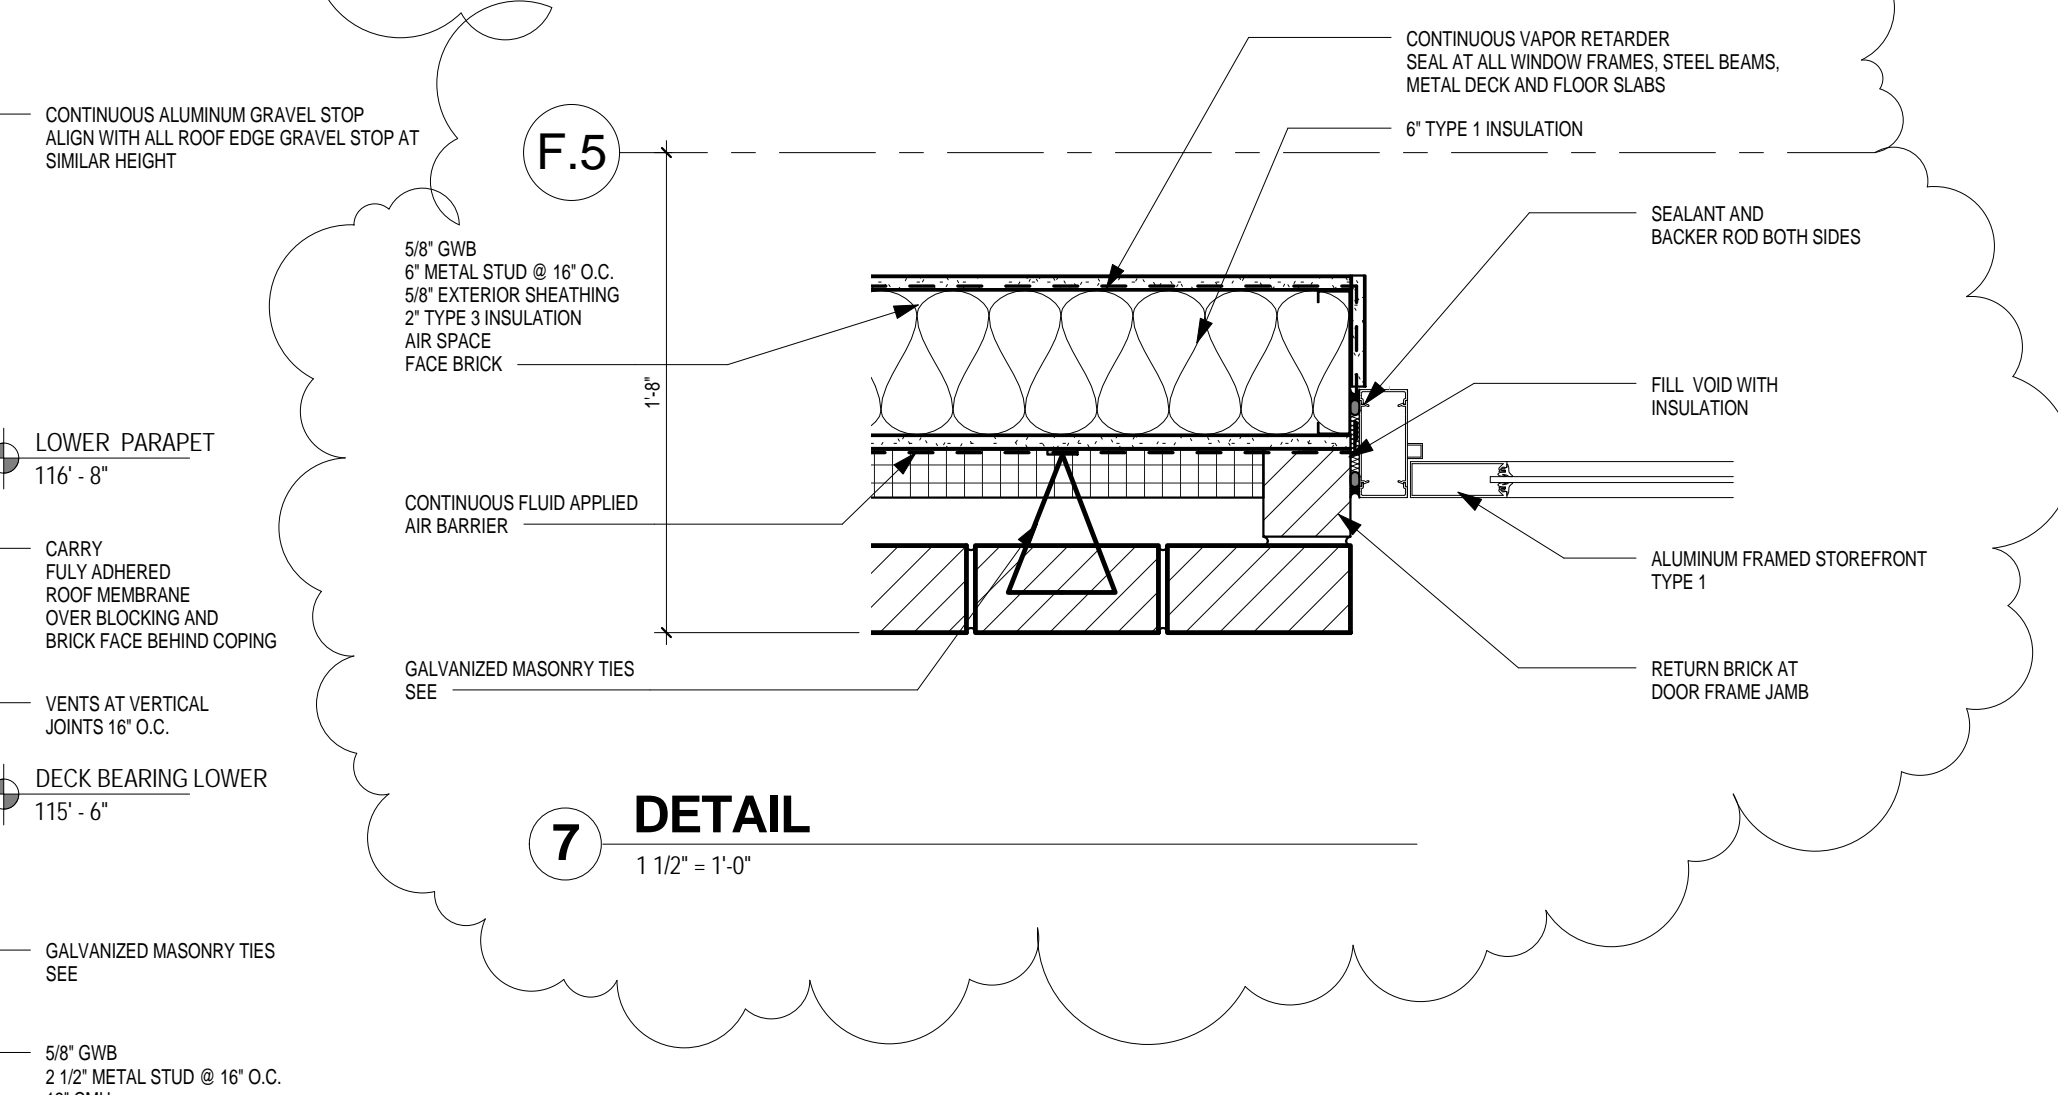


7 DETAIL  
1 1/2" = 1'-0"

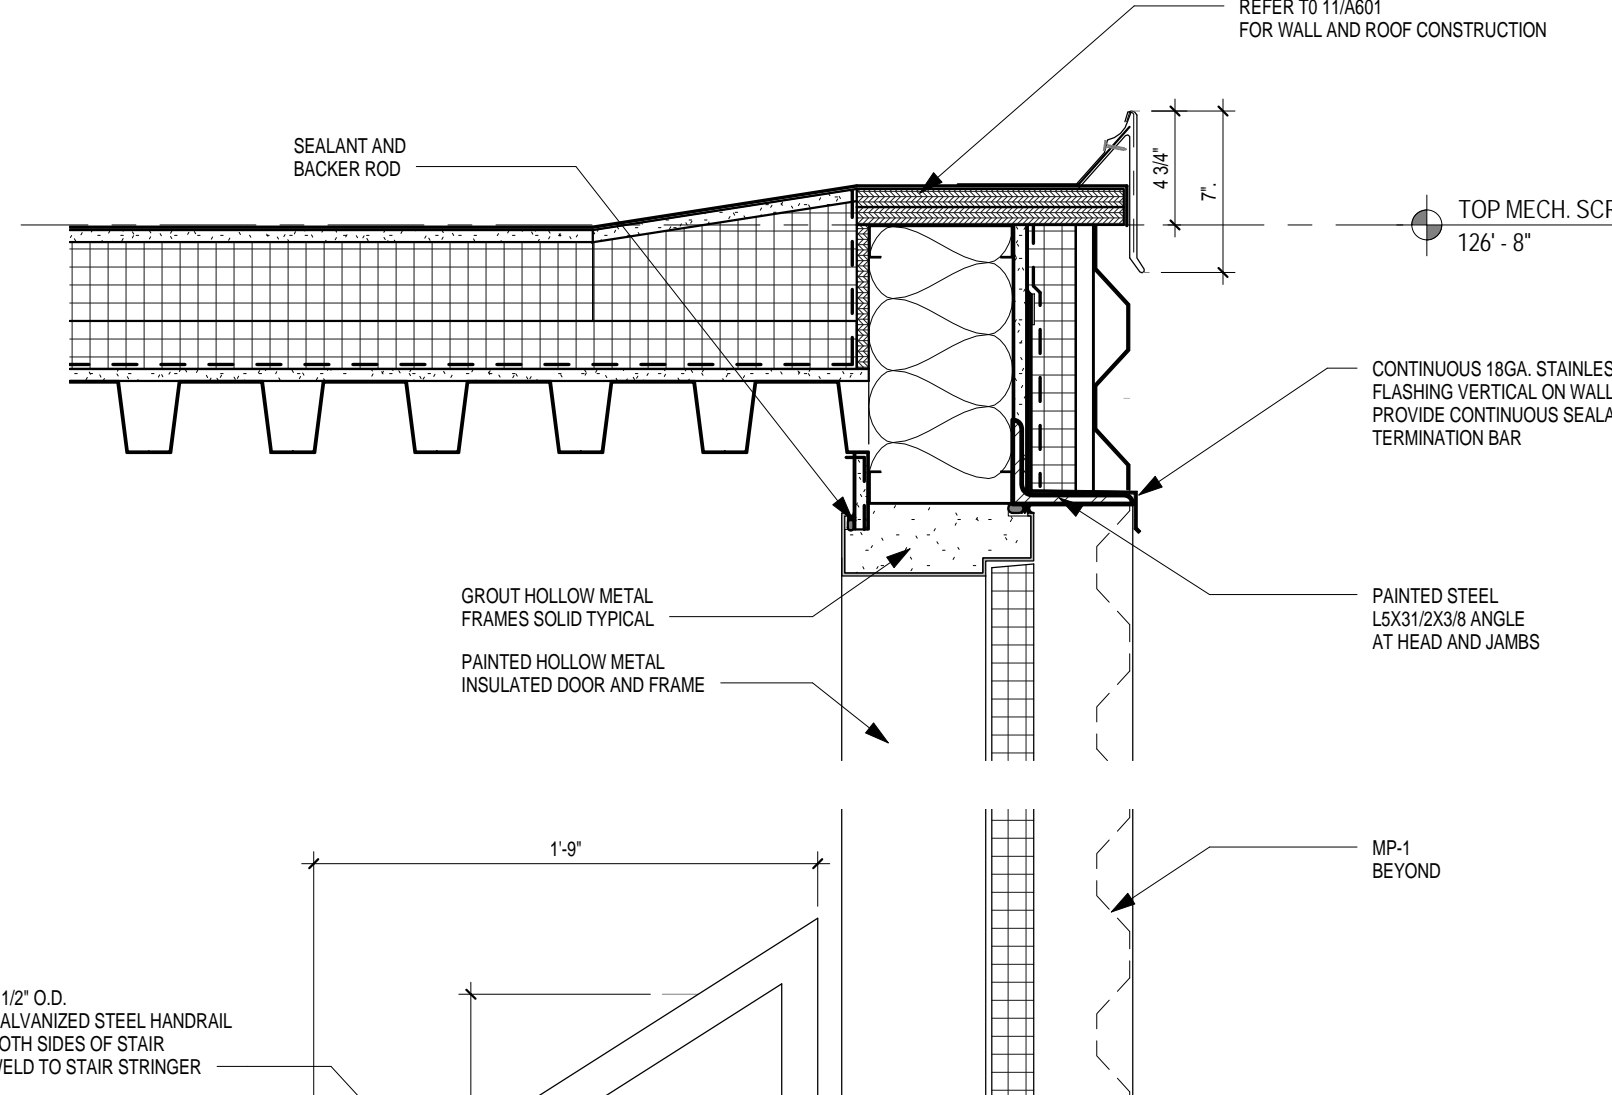


9 DETAIL  
1 1/2" = 1'-0"

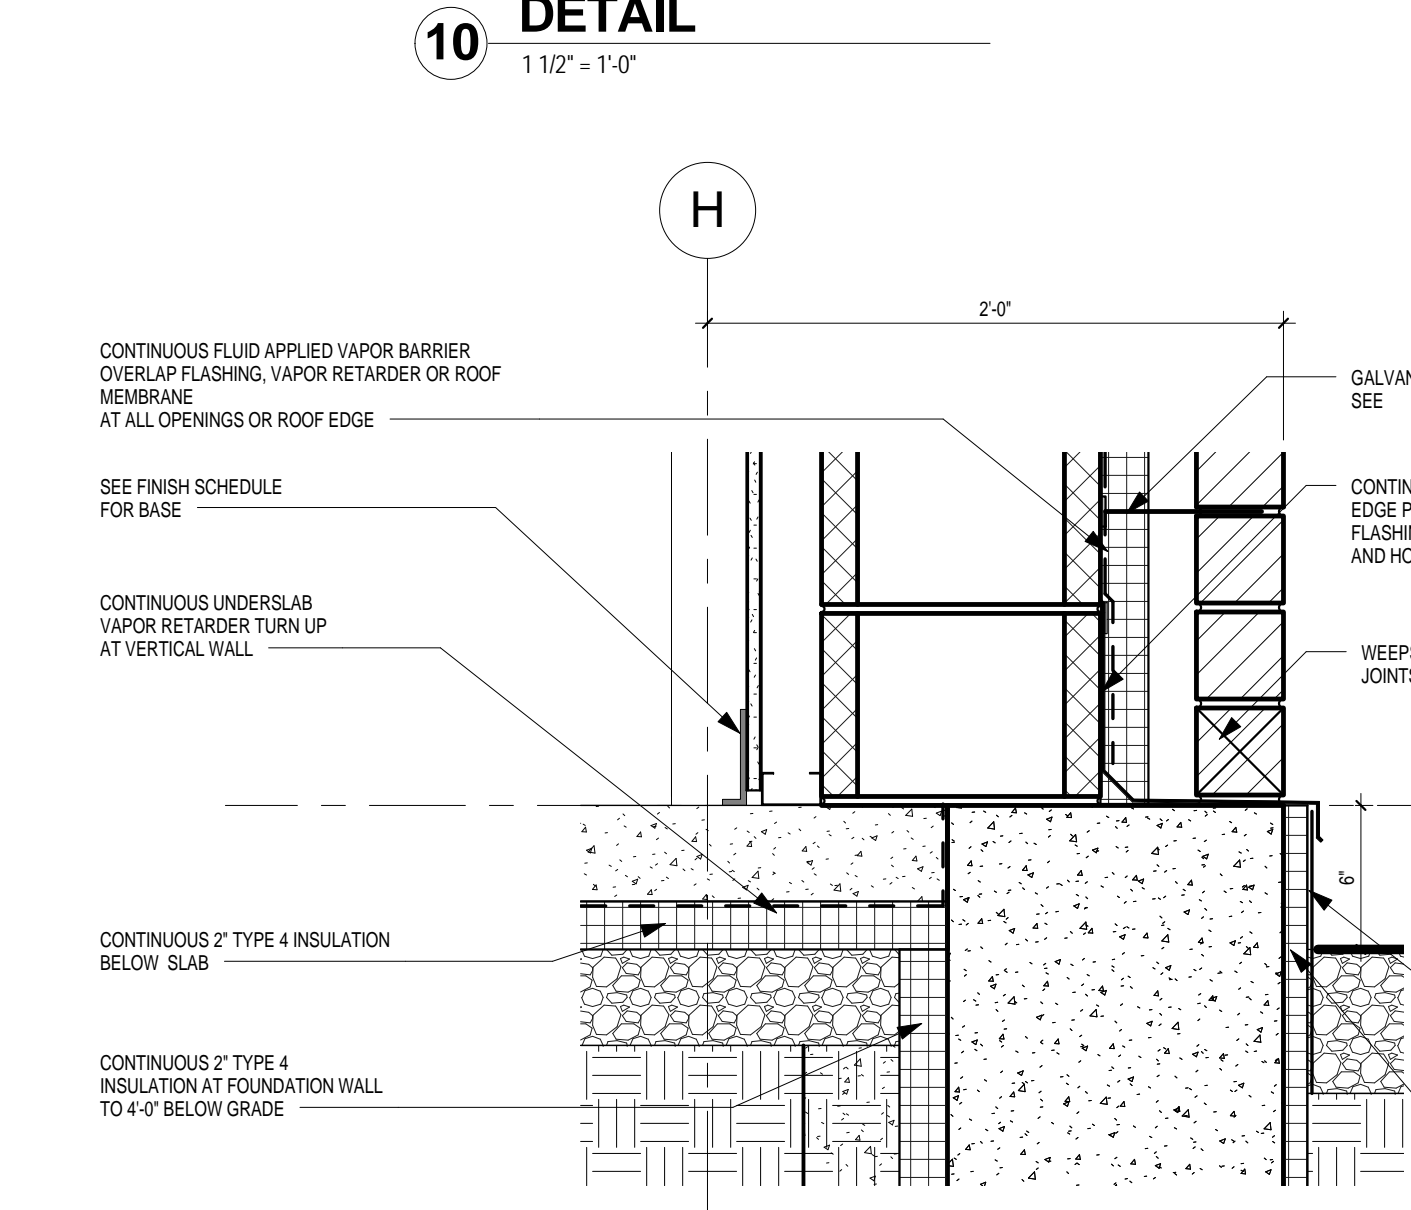


9 DETAIL  
1 1/2" = 1'-0"

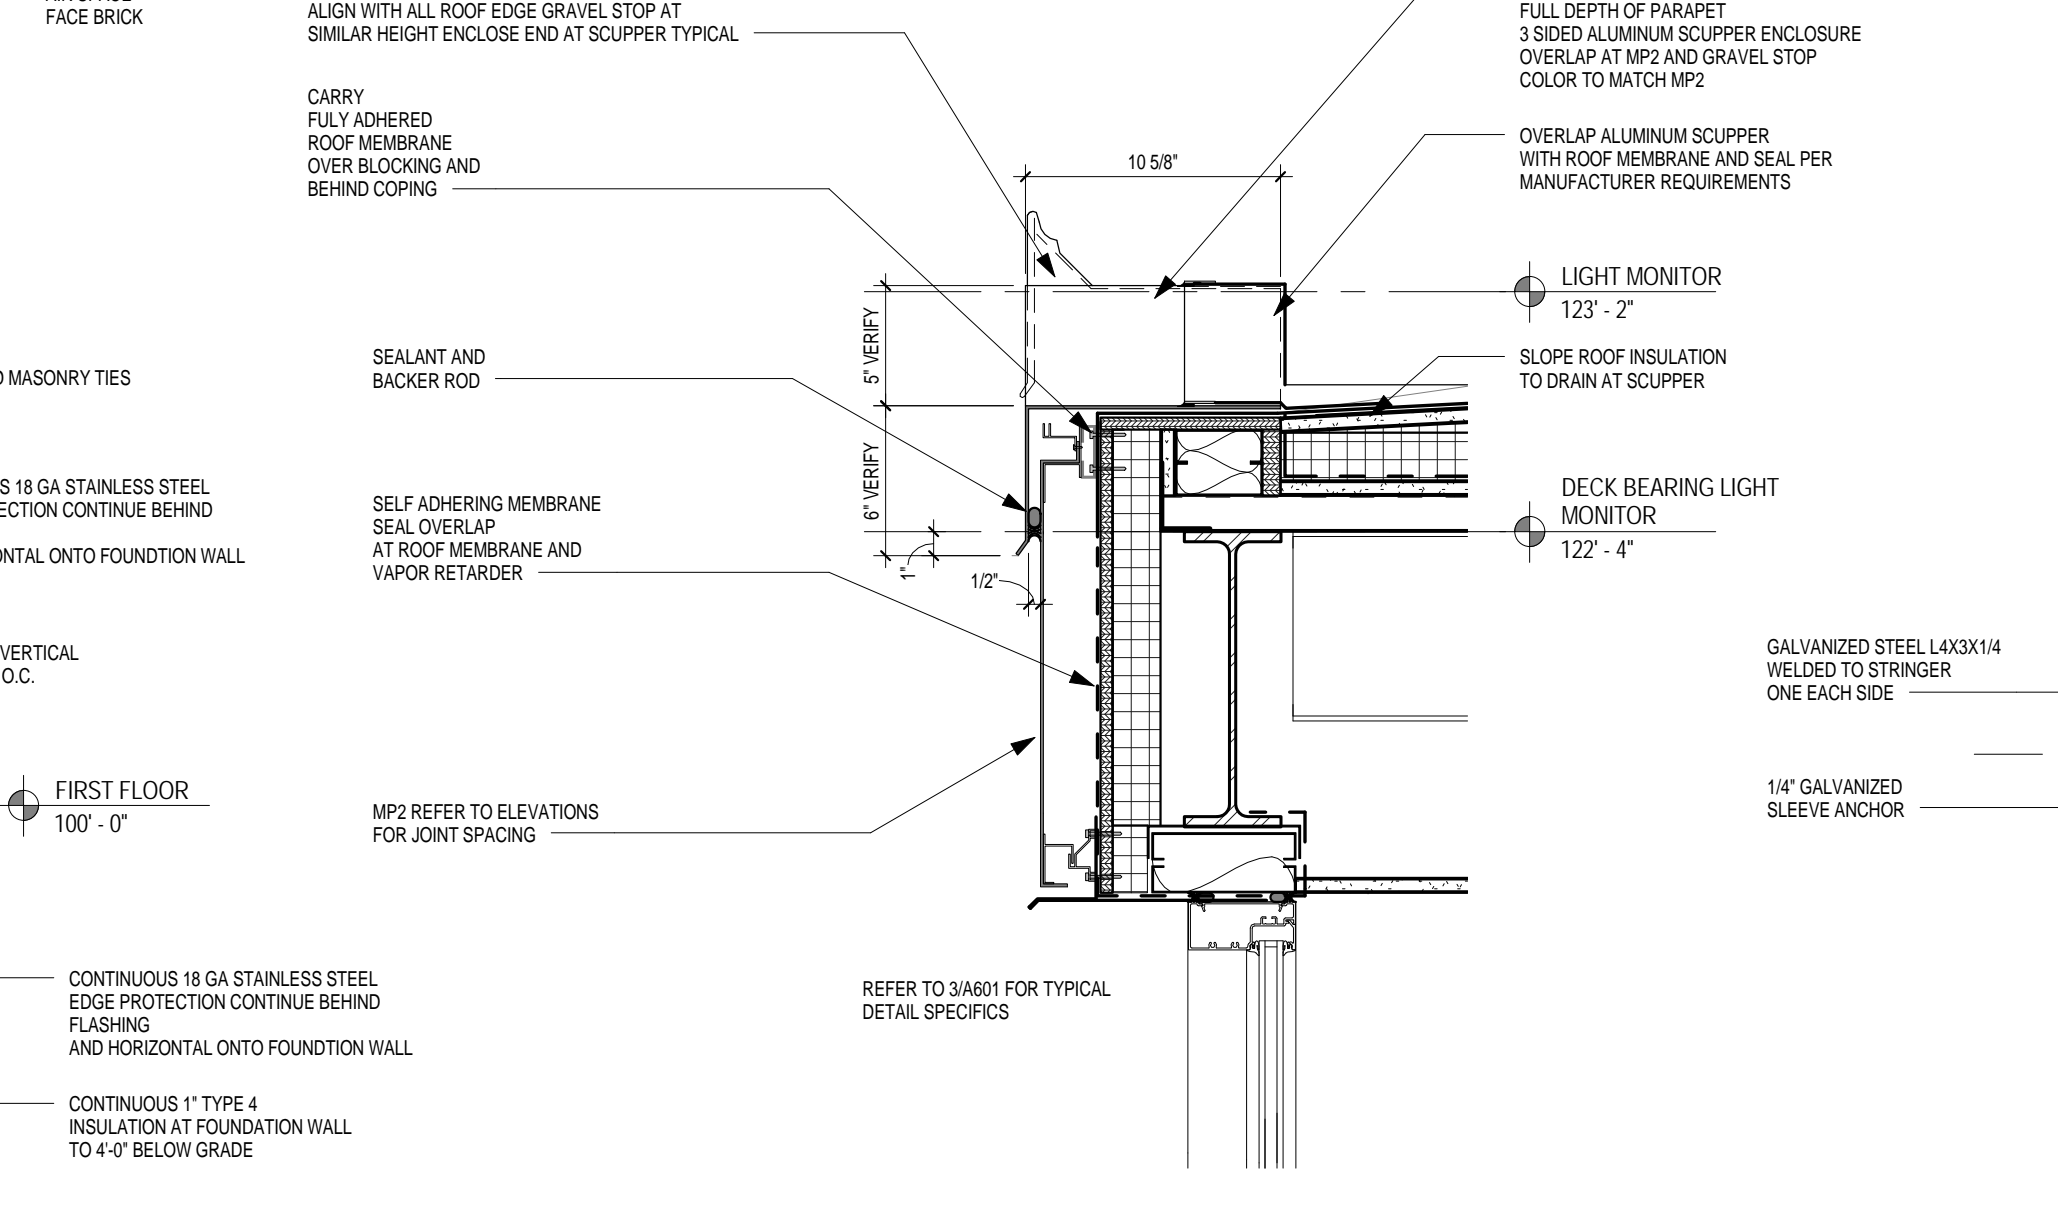


6 DETAIL  
1 1/2" = 1'-0"

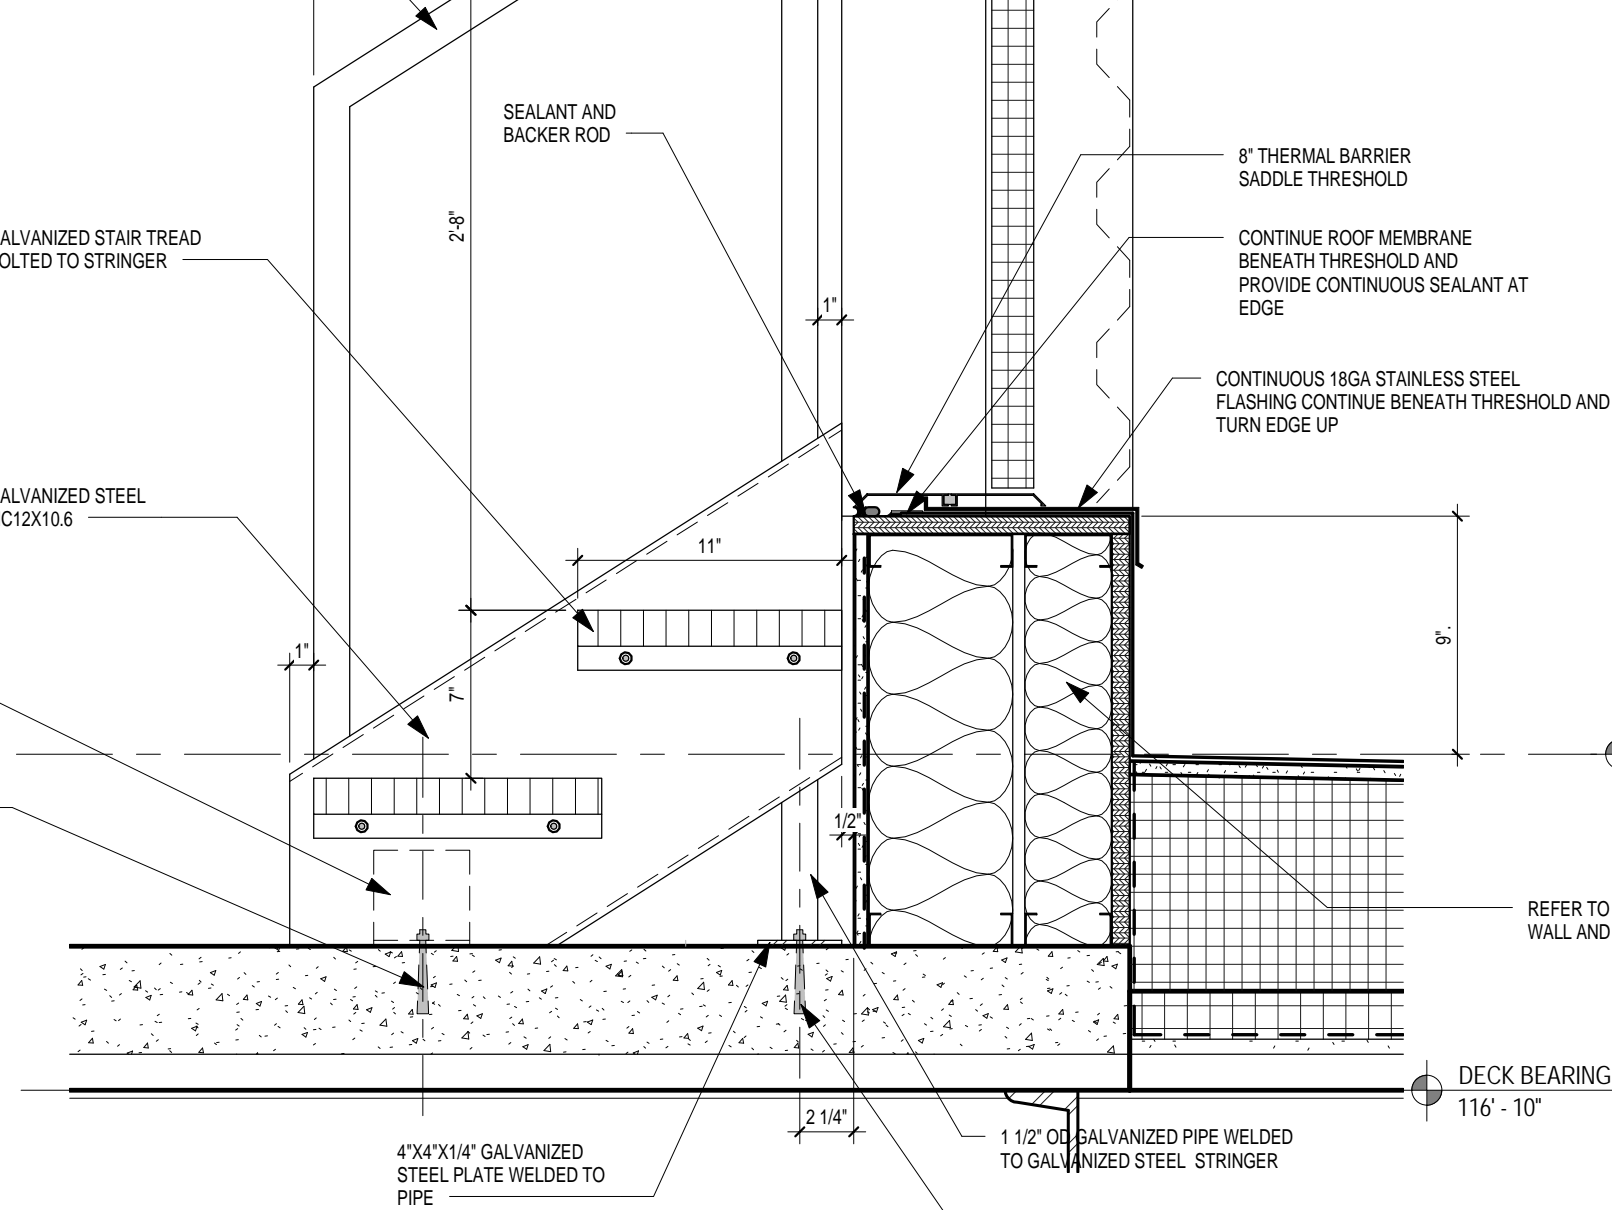

3 DETAIL  
1 1/2" = 1'-0"

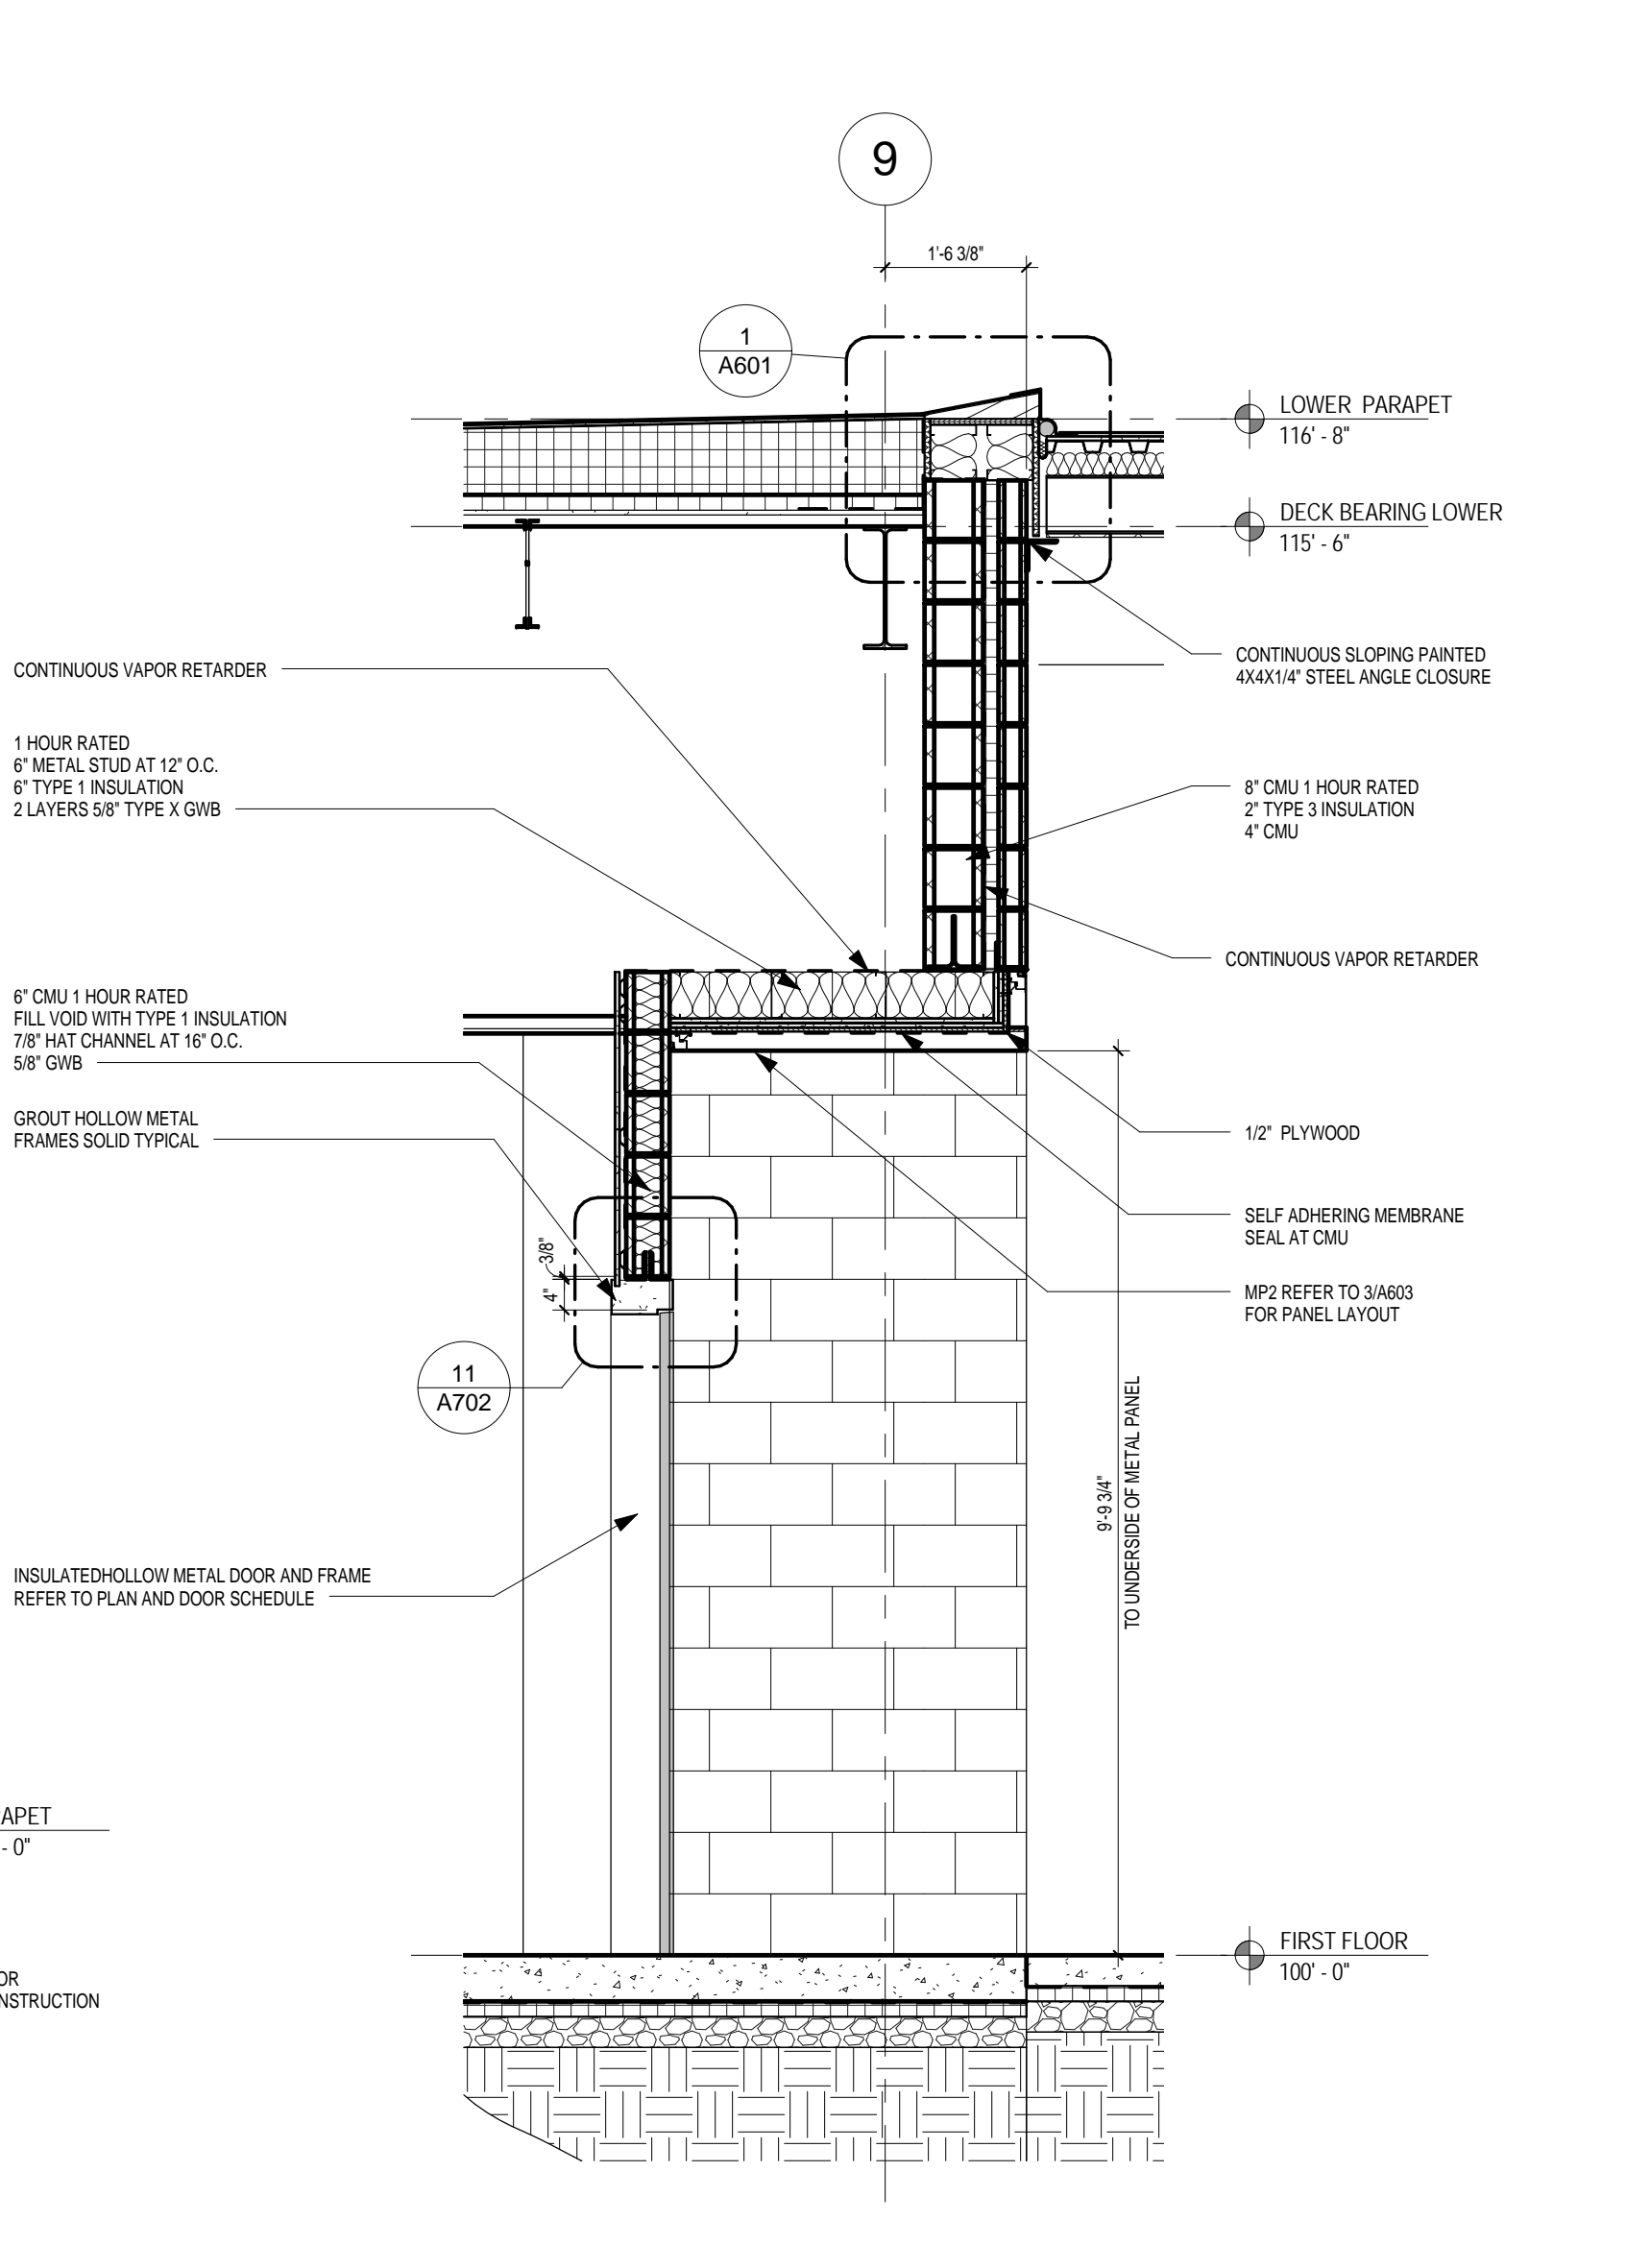

1 WALL SECTION DETAIL  
1 1/2" = 1'-0"

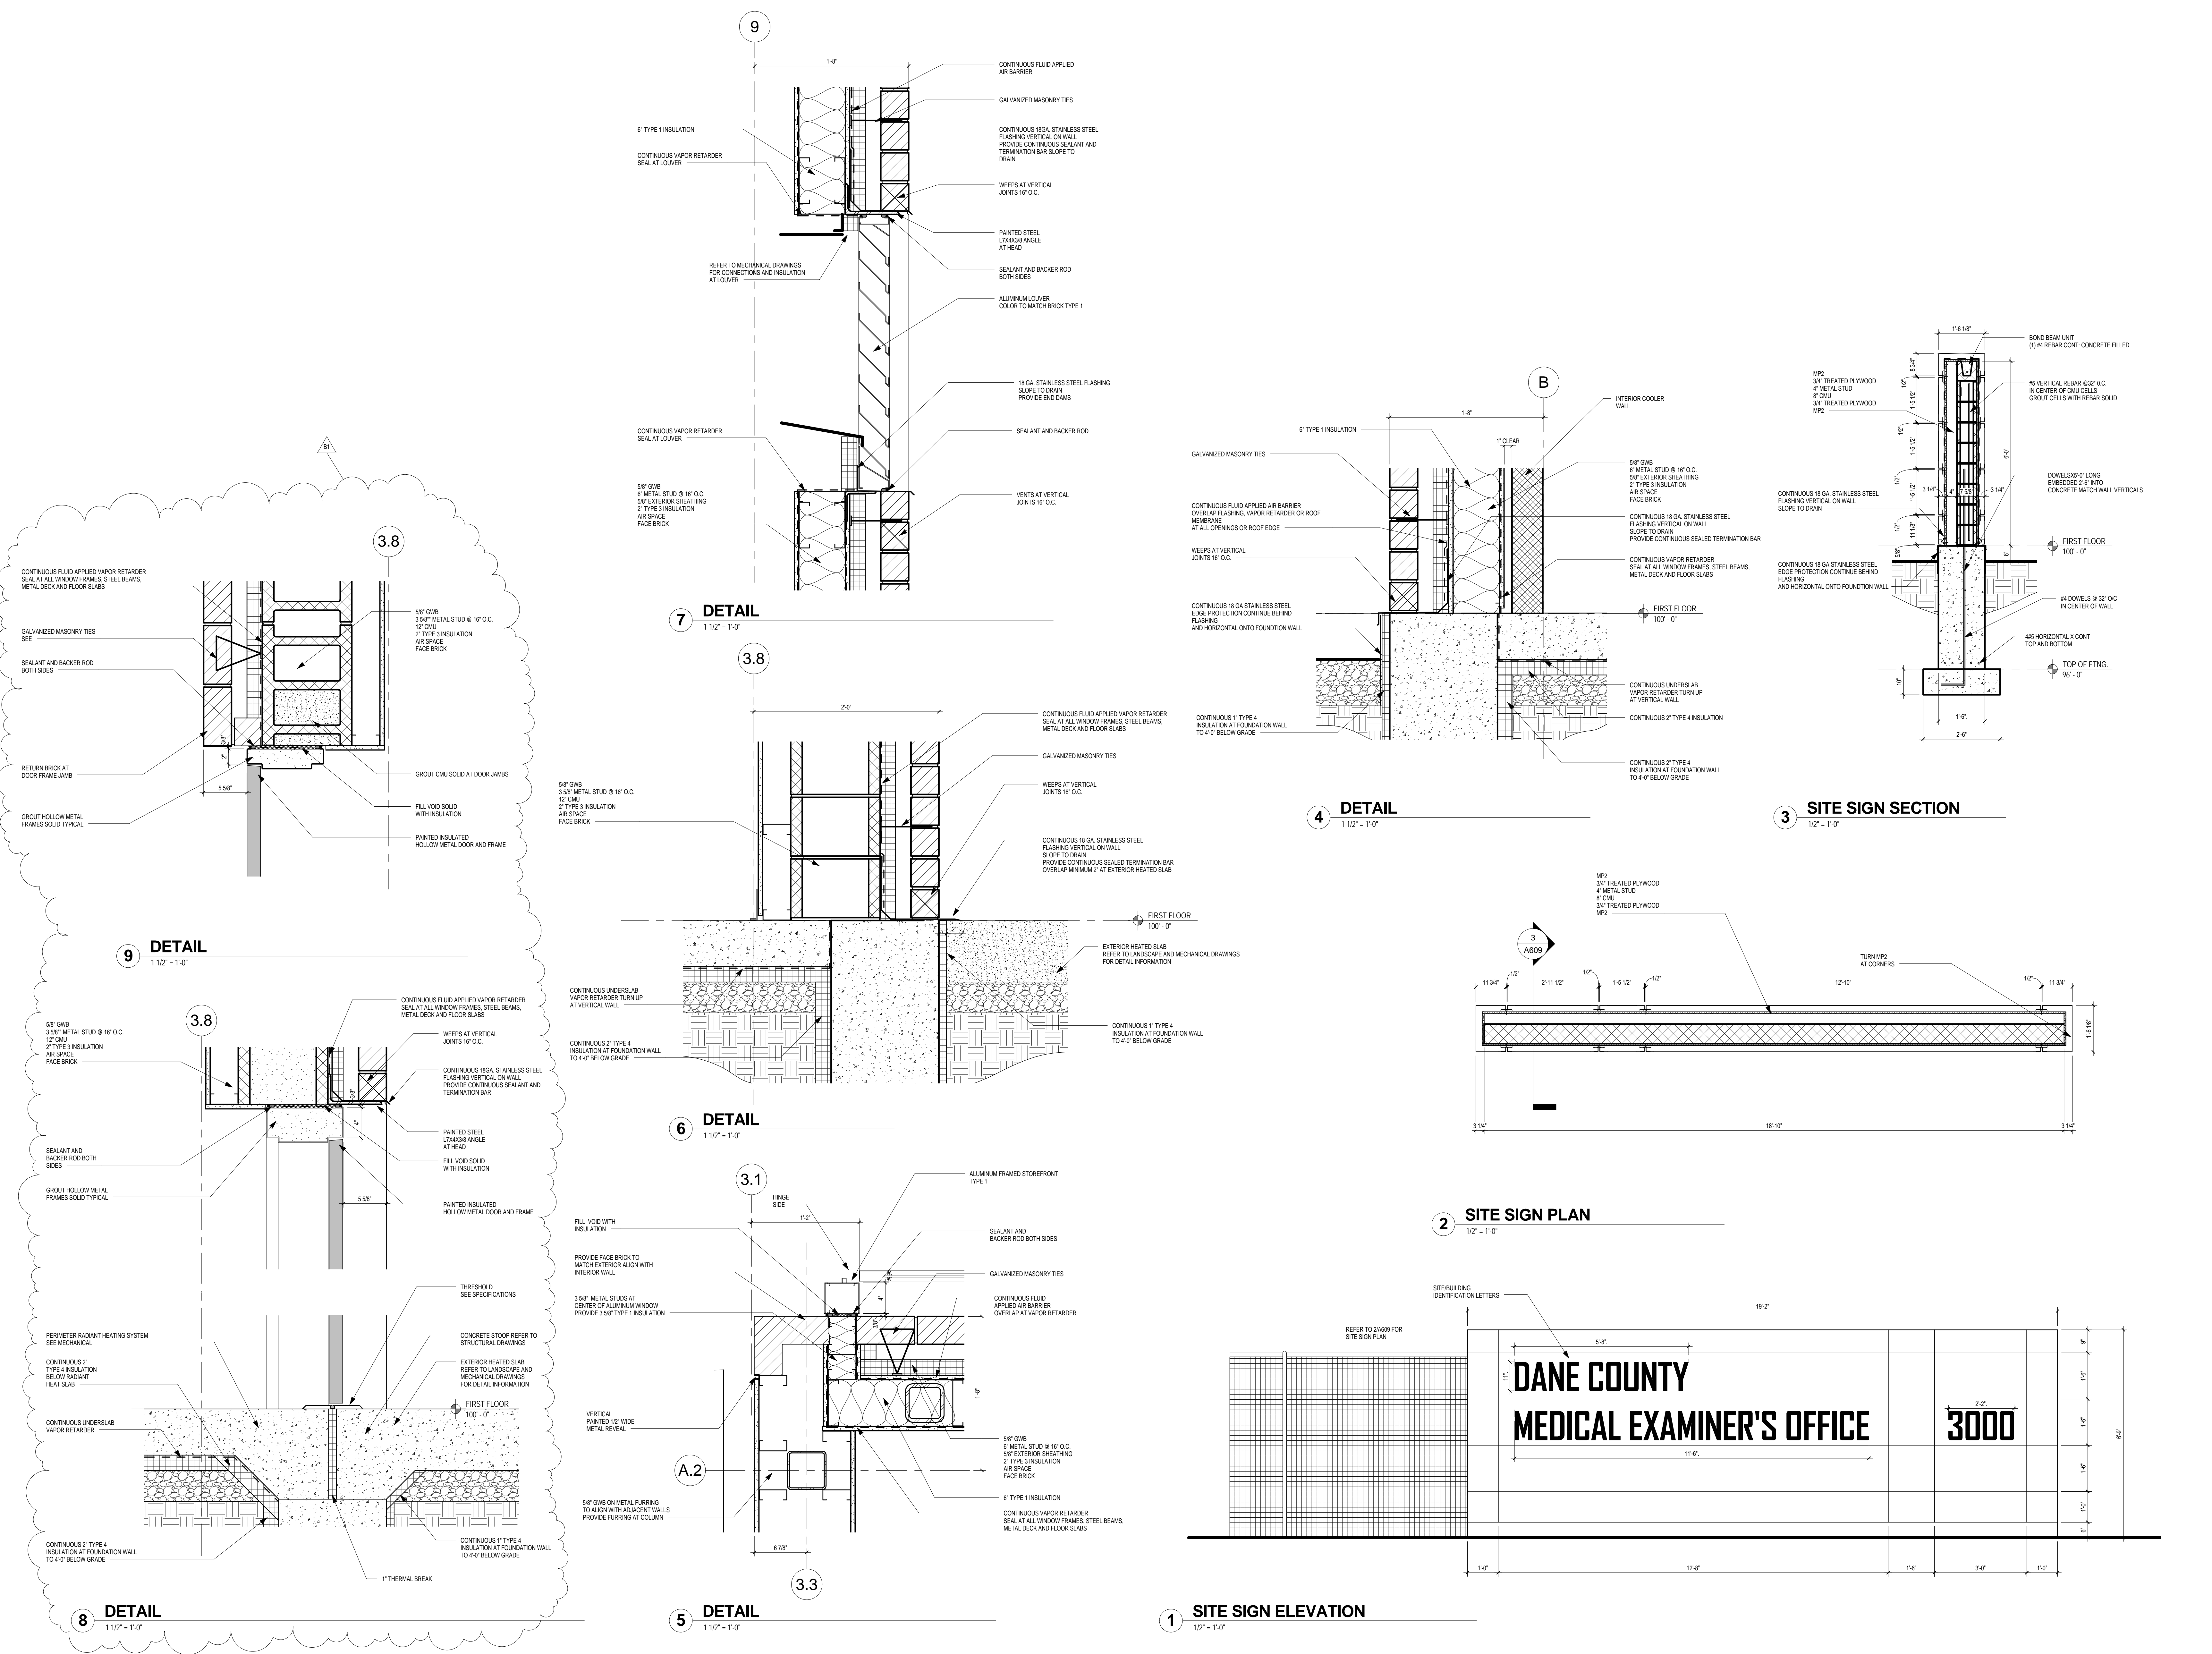

**9 DETAIL**  
1 1/2" = 1'-0"

**7 DETAIL**  
1 1/2" = 1'-0"

**4 DETAIL**  
1 1/2" = 1'-0"

**3 SITE SIGN SECTION**  
1/2" = 1'-0"

**8 DETAIL**  
1 1/2" = 1'-0"

**5 DETAIL**  
1 1/2" = 1'-0"

**1 SITE SIGN ELEVATION**  
1/2" = 1'-0"

**2 SITE SIGN PLAN**  
1/2" = 1'-0"

**6 DETAIL**  
1 1/2" = 1'-0"

**3.1**

**3.3**

**3.8**


**3.8**

**3.8**


**A.2**

**3**


**9**

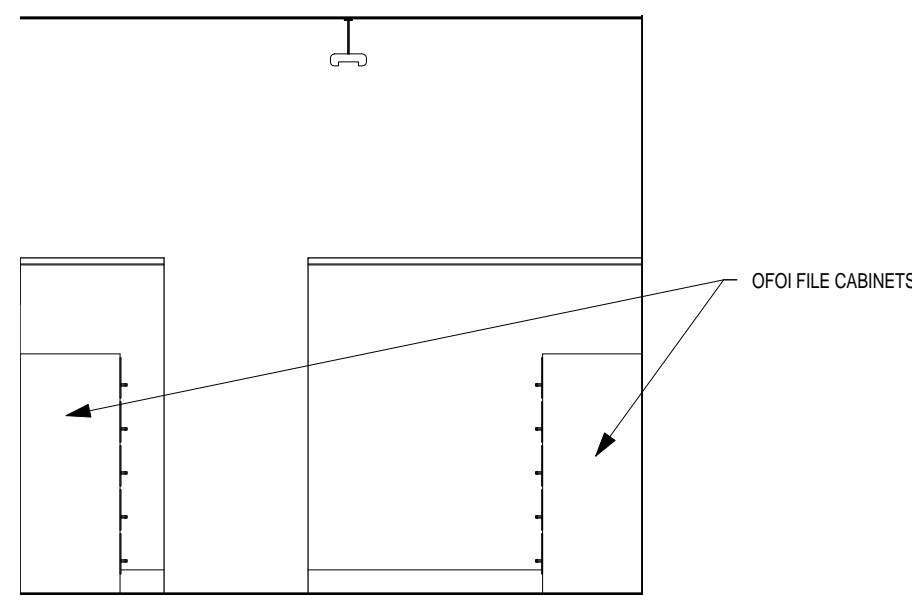


30 COPY / ADMINISTRATIVE  
1/4" = 1'-0"

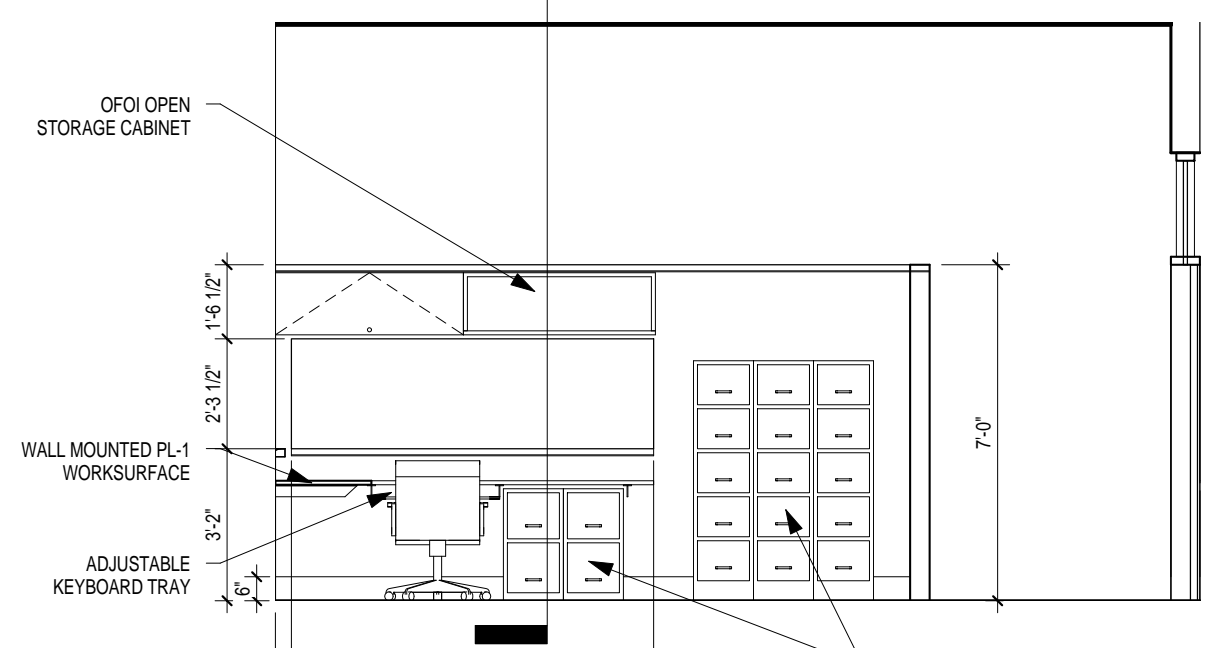


29 COPY / ADMINISTRATIVE  
1/4" = 1'-0"

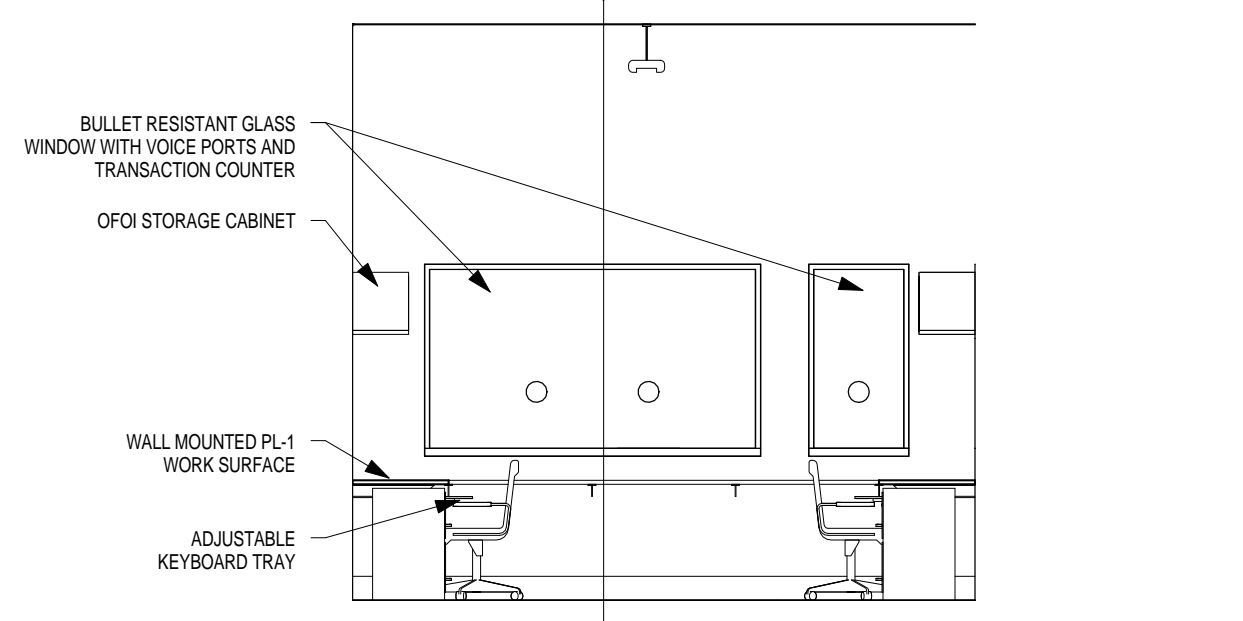


28 COPY / ADMINISTRATIVE  
1/4" = 1'-0"

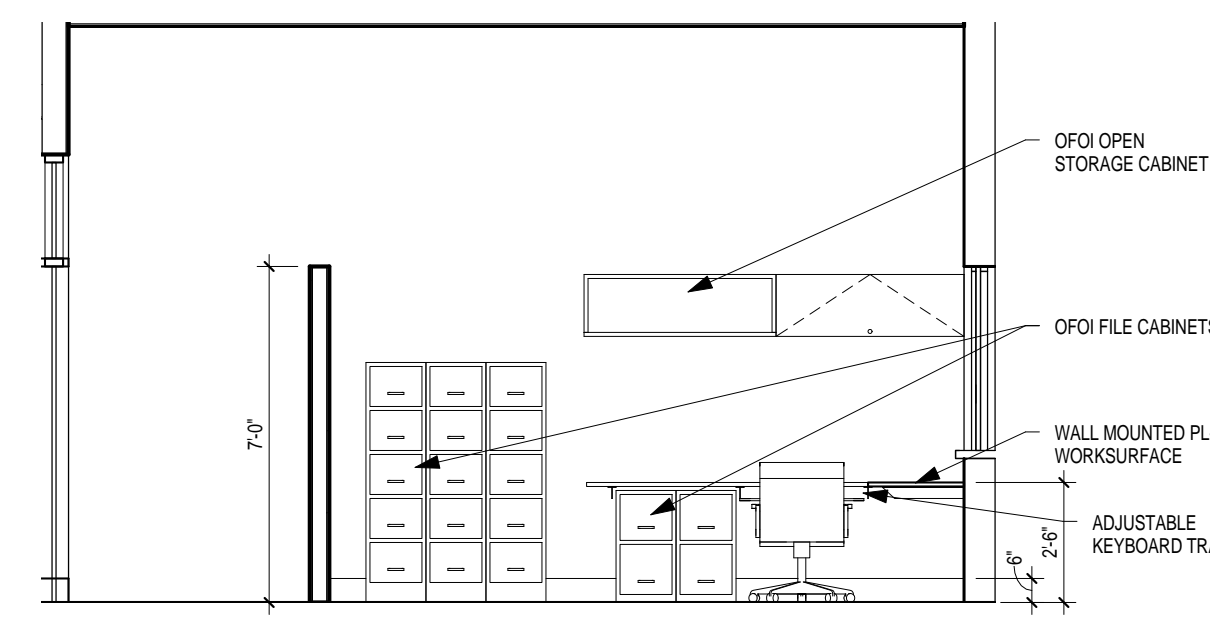


27 COPY / ADMINISTRATIVE  
1/4" = 1'-0"

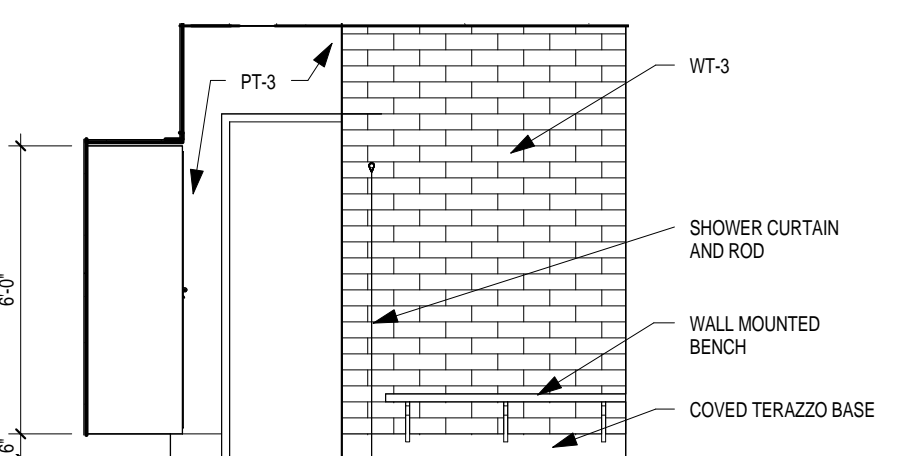


26 MENS LOCKER  
1/4" = 1'-0"

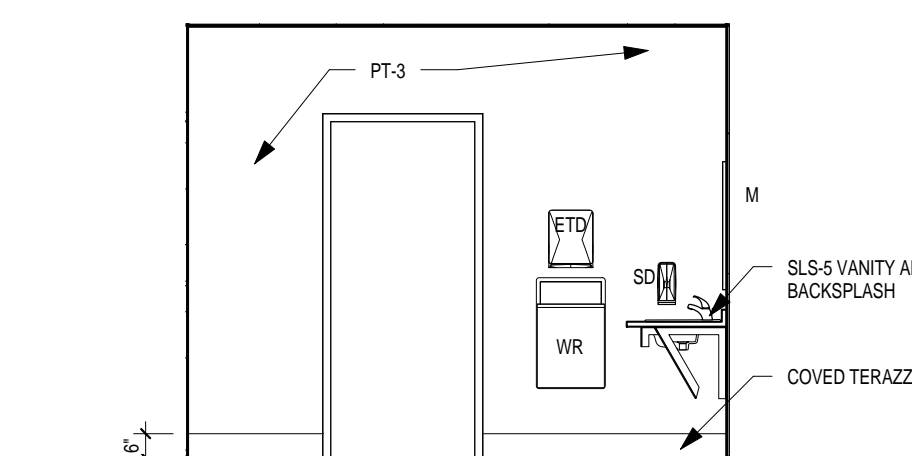


25 MENS LOCKER  
1/4" = 1'-0"

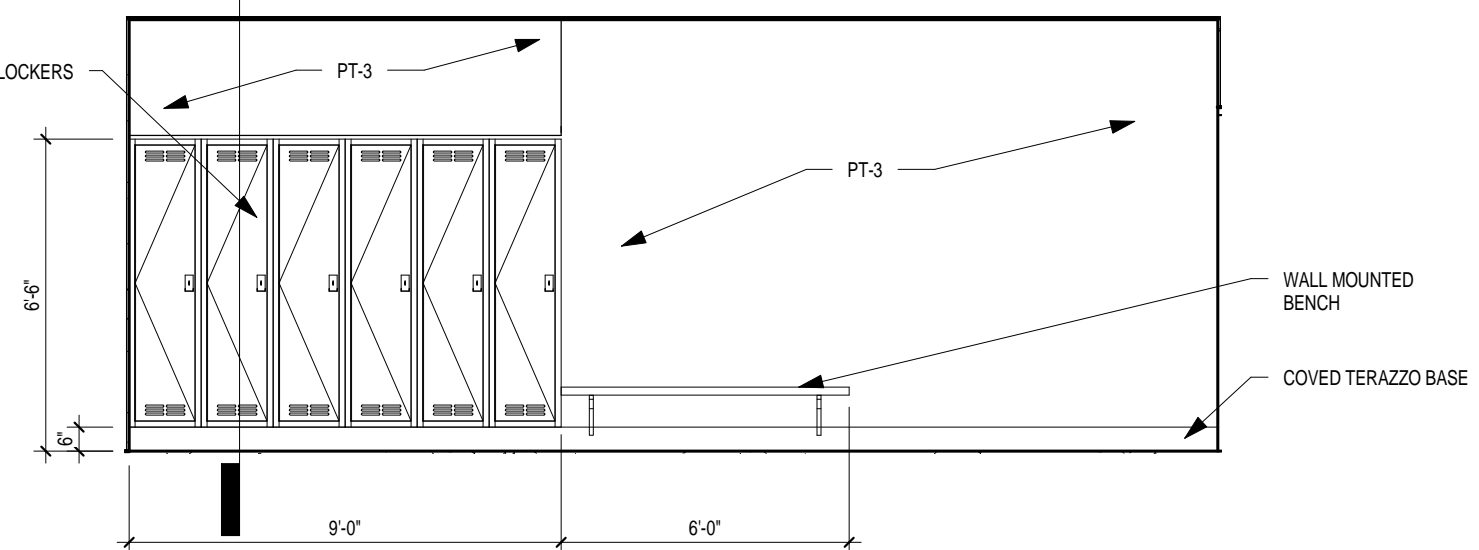


24 MENS LOCKER  
1/4" = 1'-0"

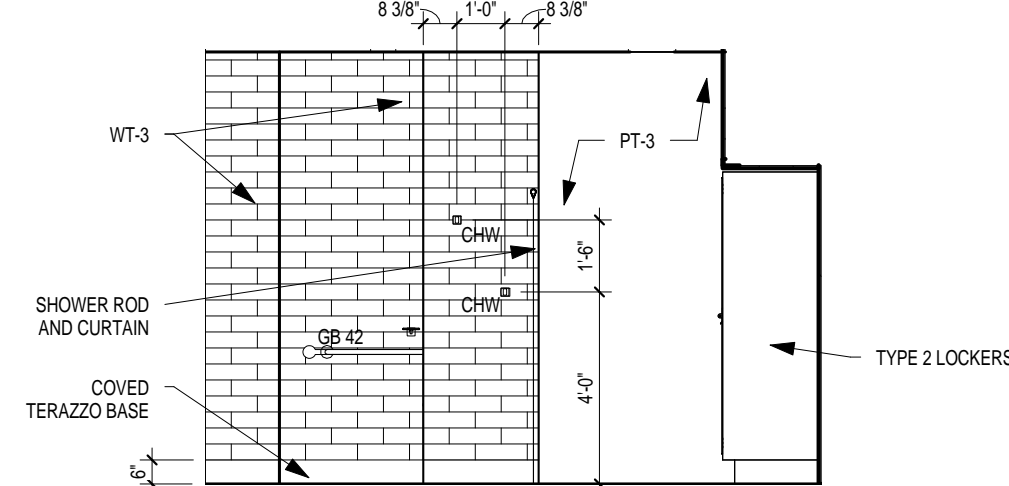


23 MENS LOCKER  
1/4" = 1'-0"

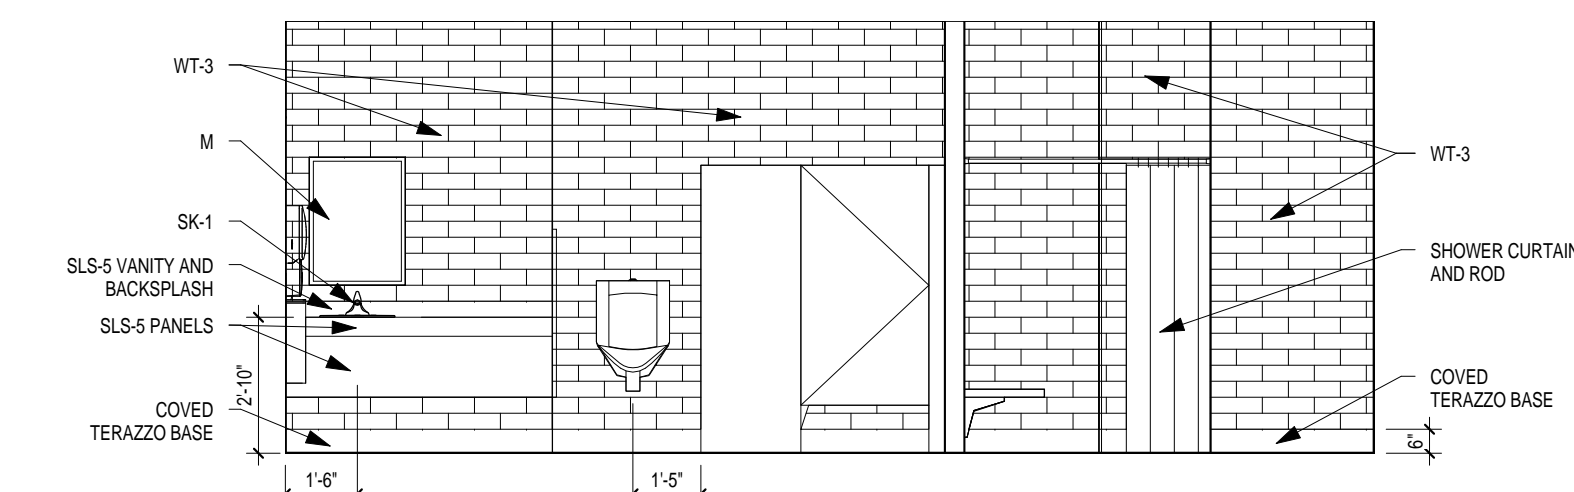


22 MENS LOCKER  
1/4" = 1'-0"

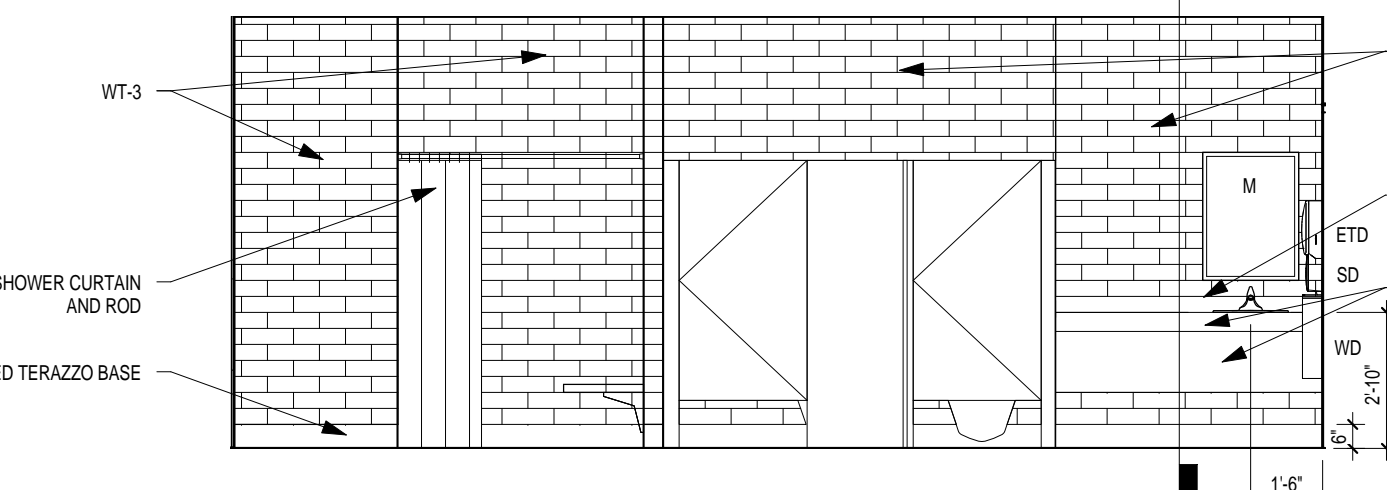


21 WOMENS LOCKER  
1/4" = 1'-0"

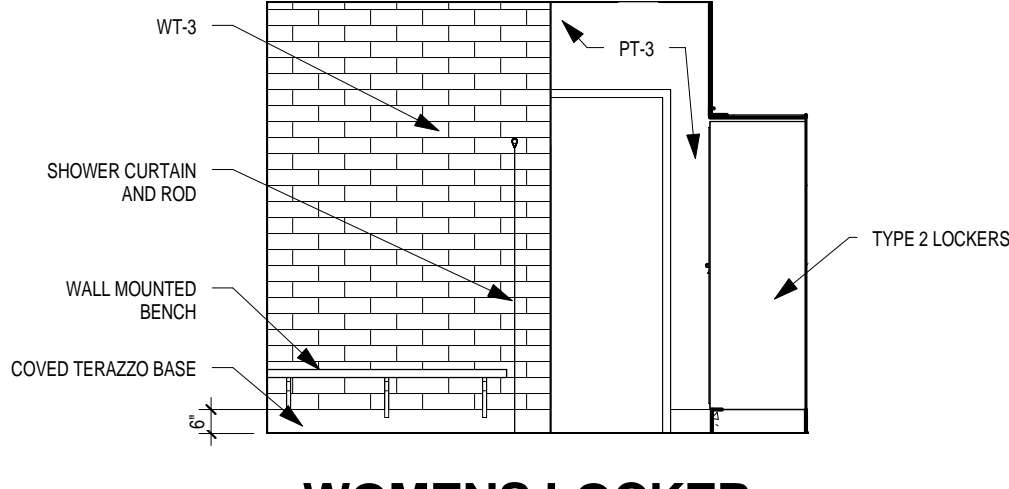


20 WOMENS LOCKER  
1/4" = 1'-0"

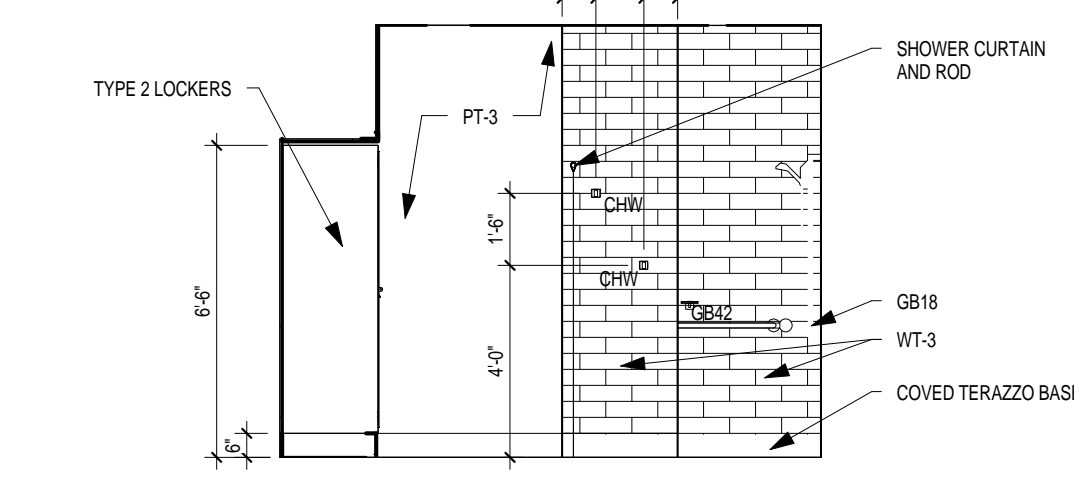


19 WOMENS LOCKER  
1/4" = 1'-0"

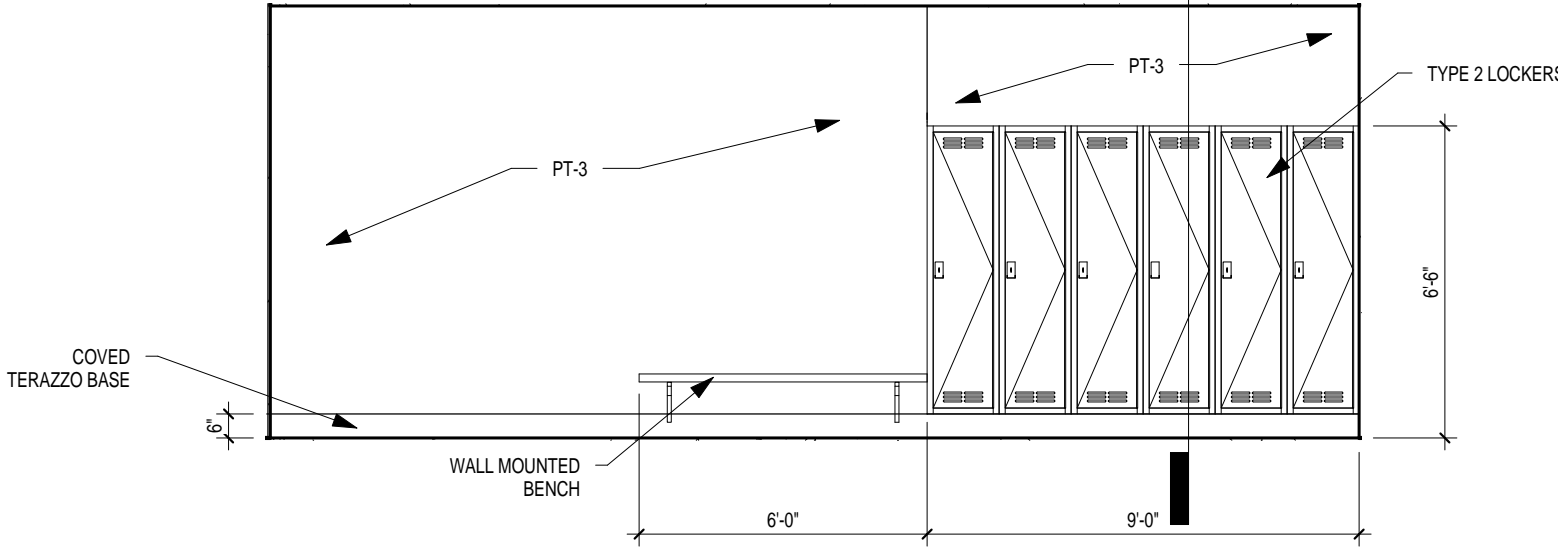


18 WOMENS LOCKER  
1/4" = 1'-0"

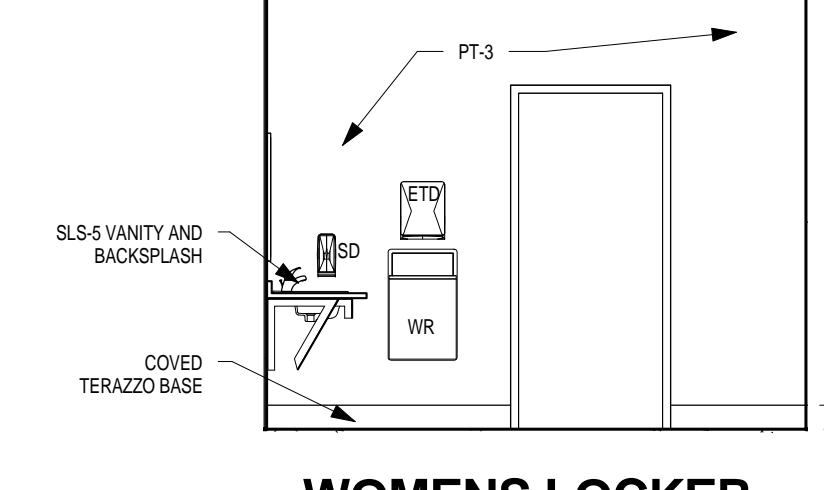


17 WOMENS LOCKER  
1/4" = 1'-0"

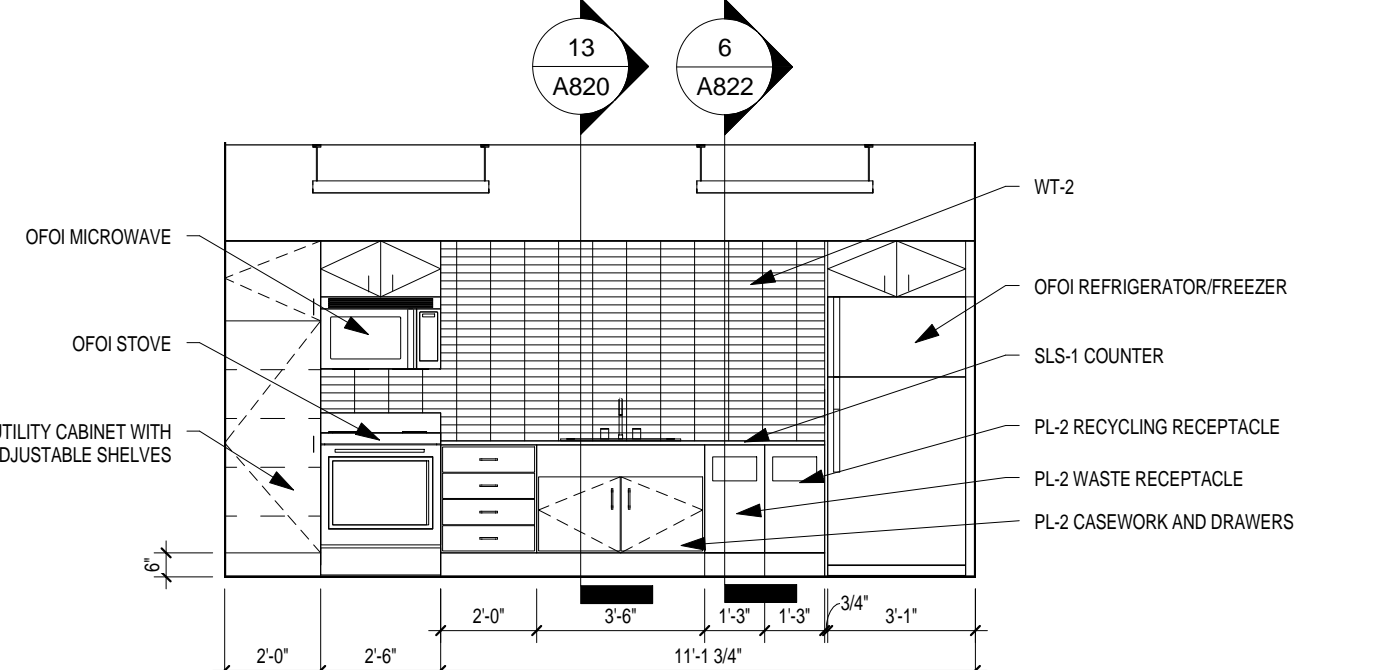


16 BREAK ROOM  
1/4" = 1'-0"

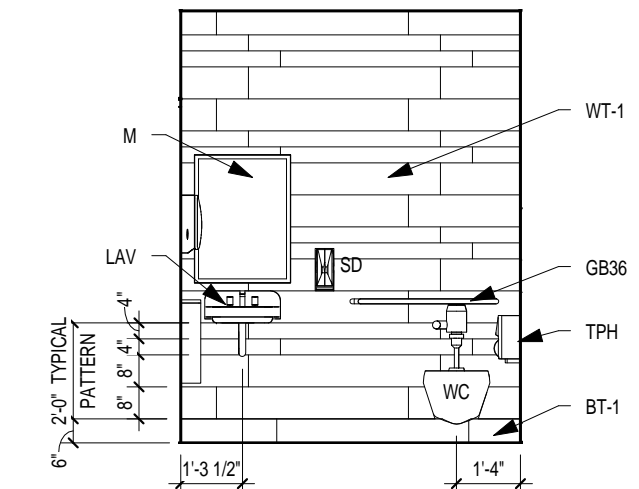


15 UNISEX TOILET  
1/4" = 1'-0"

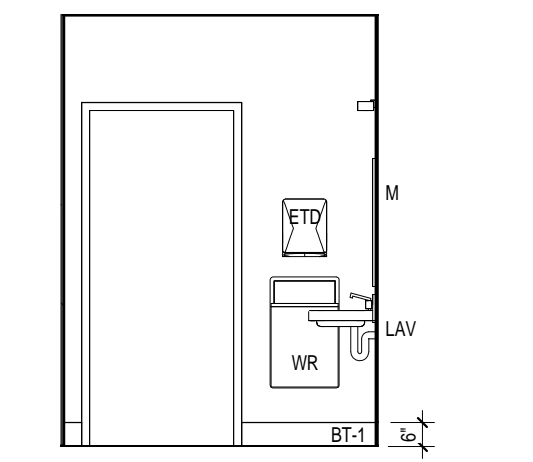


14 UNISEX TOILET  
1/4" = 1'-0"

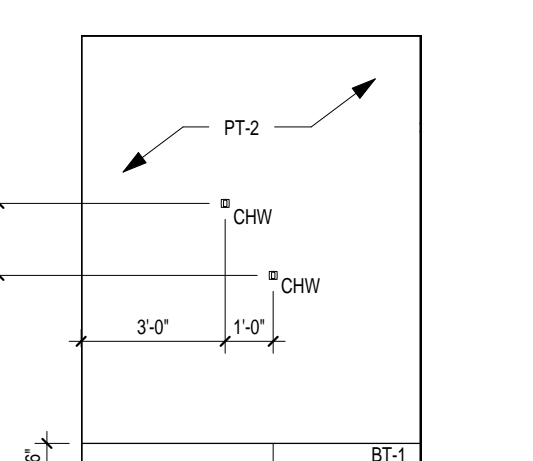


13 UNISEX TOILET  
1/4" = 1'-0"

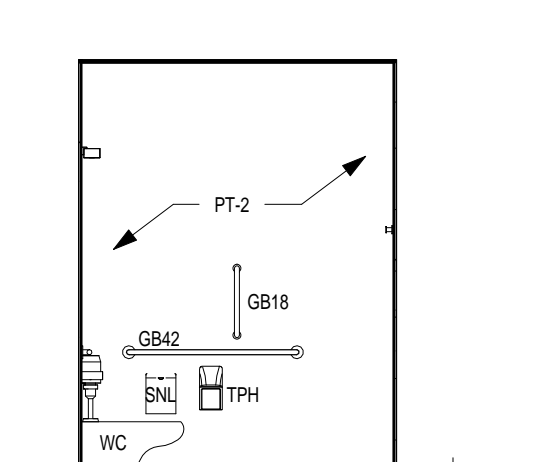


12 UNISEX TOILET  
1/4" = 1'-0"

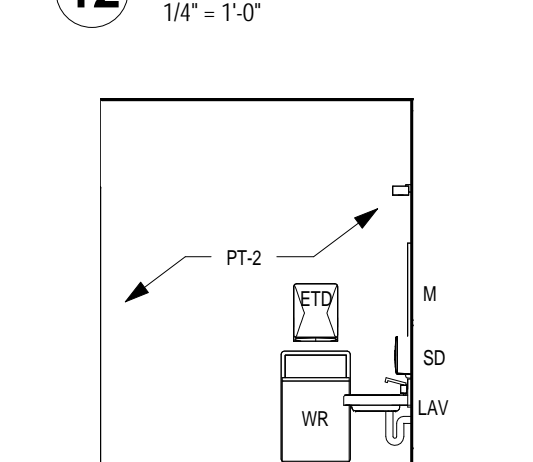


11 MENS TOILET  
1/4" = 1'-0"

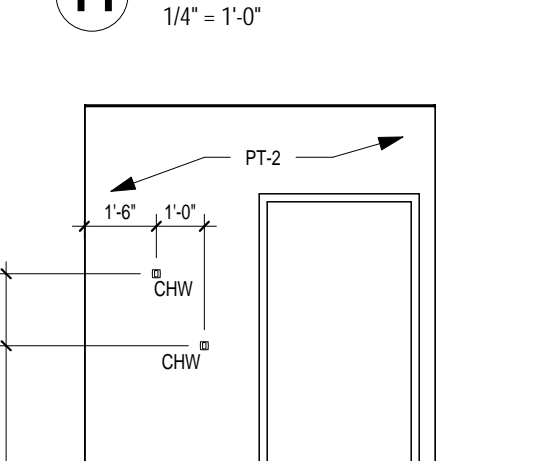


10 MENS TOILET  
1/4" = 1'-0"

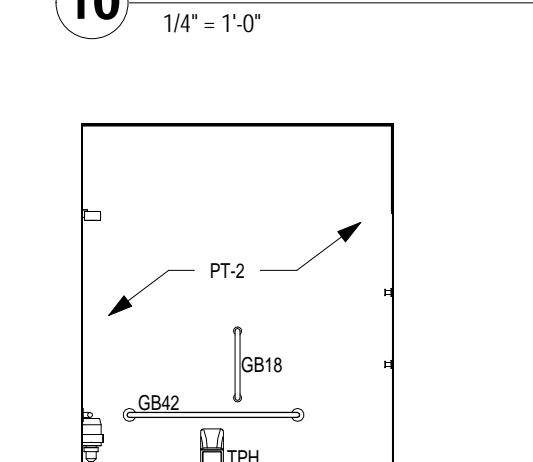


9 MENS TOILET  
1/4" = 1'-0"

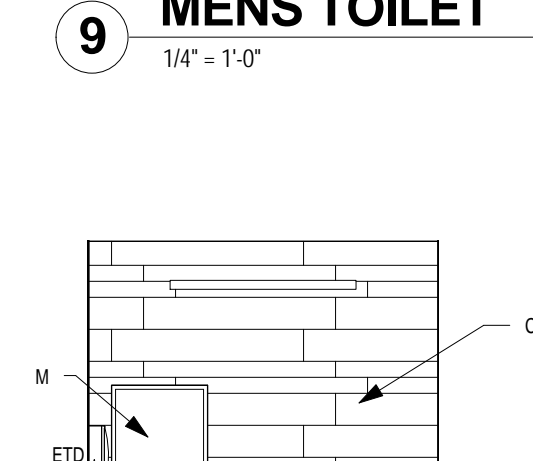


8 MENS TOILET  
1/4" = 1'-0"

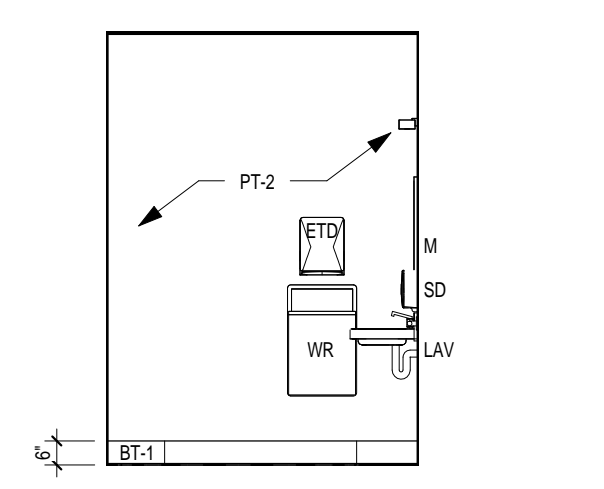


7 WOMENS TOILET  
1/4" = 1'-0"

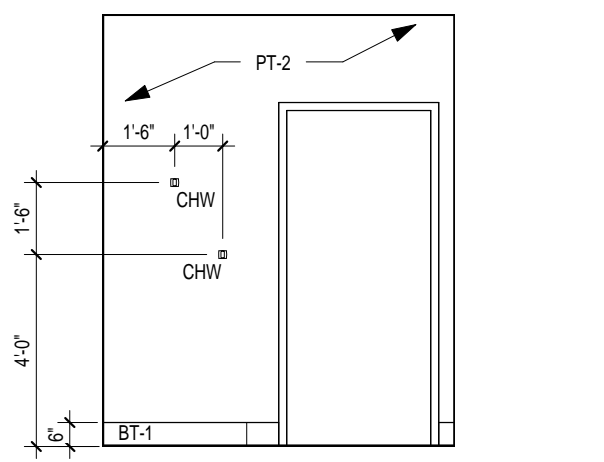


6 WOMENS TOILET  
1/4" = 1'-0"

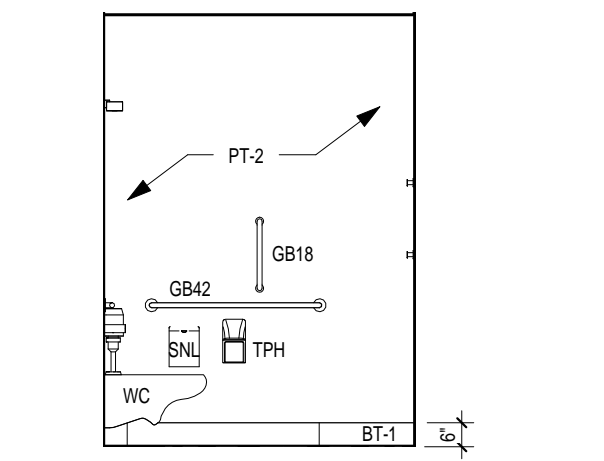


5 WOMENS TOILET  
1/4" = 1'-0"

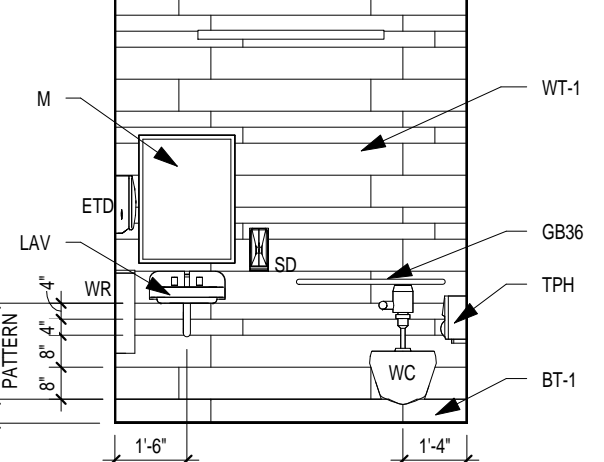


4 WOMENS TOILET  
1/4" = 1'-0"

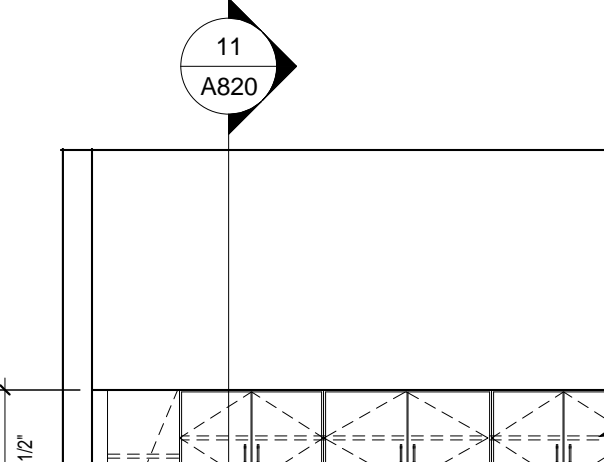


3 STORAGE AREA  
1/4" = 1'-0"

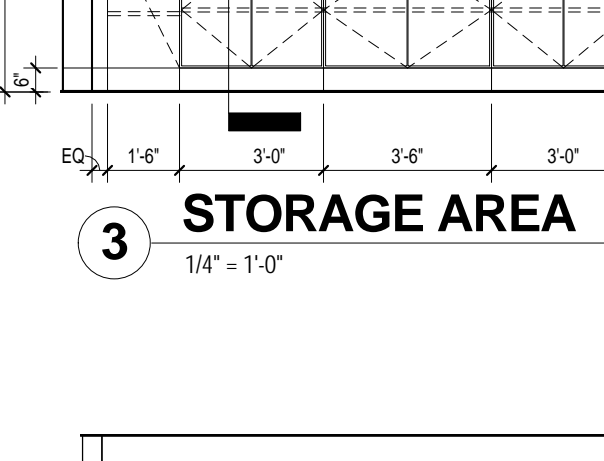


2 COPY AREA  
1/4" = 1'-0"

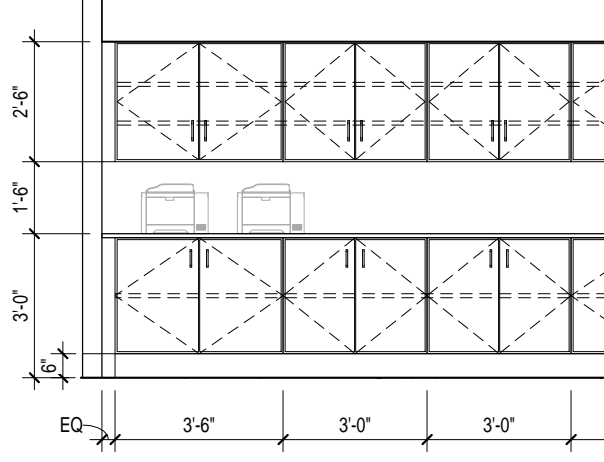


1 COPY AREA  
1/4" = 1'-0"

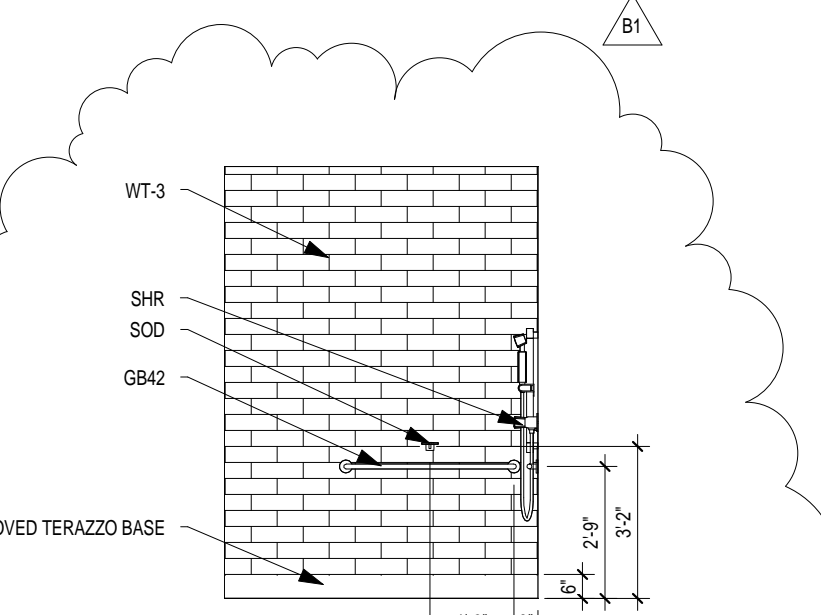


34 MENS LOCKER  
1/4" = 1'-0"

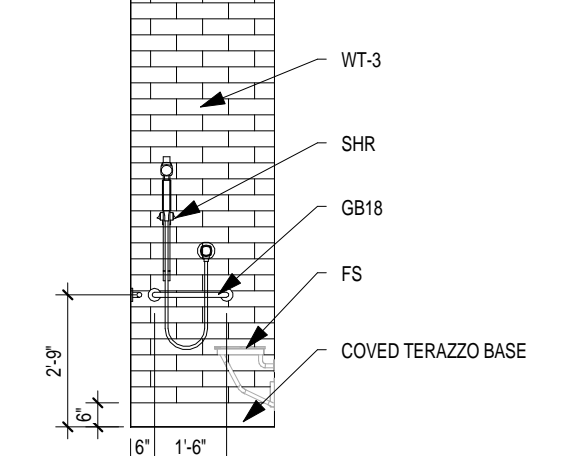

33 MENS LOCKER  
1/4" = 1'-0"

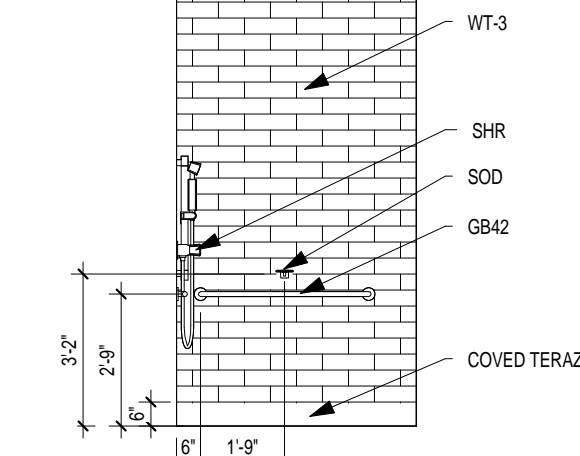

32 WOMENS LOCKER  
1/4" = 1'-0"

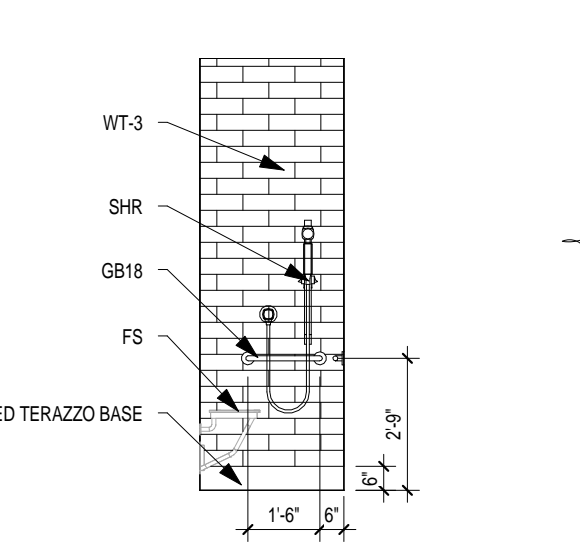


31 WOMENS LOCKER  
1/4" = 1'-0"



McClaren, Wilson &  
Lawrie, Inc.  
1798 North Lakeside  
Parkway  
Ashland, VA 23005  
(804)228.7455  
www.mwlarchitects.com

- KEY SYMBOLS**
- (L) LOCKING
  - (M) MONITOR TO BMS
  - (DN) DECK MOUNTED DRENCH HOSE EYEWASH FIXTURE
  - (X) MARINE EDGE COUNTER ELEVATION IN INCHES
  - (N) NON-MARINE EDGE COUNTER ELEVATION IN INCHES
  - (X) KEY NOTES
  - (XX) EQUIPMENT
  - (XXX) ROOM NUMBERS
- ABBREVIATIONS**
- CCHD - COOLER CONDENSATE HD
  - HD - HUB DRAIN
  - FD - FLOOR DRAIN
  - FFD - FLUSHABLE FLOOR DRAIN
  - SS - STAINLESS STEEL
- KEY NOTES**
- 1) PAPER TOWEL DISPENSER - BY DIV. 10.
  - 2) COAT HOOKS MOUNTED AT 60" U.O.-SPEC. 116000
  - 3) SAFETY CABINET-SPEC. 116000
  - 4) SPILL CART-SPEC. 116000
  - 5) BUG ZAPPER MOUNTED @ +8" A.F.F.-BY DIV 26
  - 6) EPOXY DRYING RACK - 18"x36" - SPEC. 123450
  - 7) FILLER PANEL - MATCH CASEWORK MATERIAL
  - 8) COAT RACK & SHELF-SPEC 116000
  - 9) SS SHELVING-SPEC. 116000
  - 10) DIGITAL READ OUT FOR SCALE @ 48" A.F.F.-SPEC. 117810
  - 11) BOLLARD- REFER TO ARCHITECTURAL DETAILS
  - 12) S.S. CORNER GUARD - REFER TO DET. 9/0821
  - 13) GALVANIZED FENCE WITH MANUAL SLIDE GATE INSIDE BODY COOLER BY COOLER MFR.
  - 14) S.S. WALL GUARD - REFER TO DET. 10/0821. S.S. WALL GUARDS IN ROOMS 130E AND 130F ARE TO BE BY COOLER MFR.
  - 15) HIGH DENSITY SHELVING- BY DIV. 10
  - 16) COOLER CONTROL PANEL-(SEM-RECESSED)
  - 17) HOT & COLD WATER MIXING STATION-BY DIV. 22
  - 18) POWER BY DIVISION 26
  - 19) ELECTRICAL RACKWAY TYPICAL-REFER TO ELECTRICAL DRAWINGS
  - 20) SPRAY HOSE ASSEMBLY - 2 PER STATION, TYP. SPEC. 117810
  - 21) FLUSHING FLOOR DRAIN PUSH BUTTONS-BY DIV. 22
  - 22) STEEL STRUCTURE TO SUPPORT DISSECTING STATIONS CONCEALED IN WALL - REFER TO STRUCTURAL
  - 23) LIMS SYSTEM (NIC)
  - 24) BODY VIEWING CAMERA BY DIV. 26
  - 25) NOT USED B1
  - 26) DATA BY DIVISION 26
  - 27) FLAT PANEL DIGITAL MONITOR w/ ARTICULATING ARM-OFCI
  - 28) HYDRO ASPIRATOR HOSE - SPEC. 117810
  - 29) GLOVE BOX - BY DIV. 123450 REFER TO DETAIL 15/0820
  - 30) APPROXIMATE LOCATION OF EVAPORATING UNITS IN COLD ROOMS MOUNTED NEAR CEILING
  - 31) LOW ELEVATION EXHAUST-REFER TO MECHANICAL
  - 32) OPEN TO FINISH WALL SURFACE
  - 33) COOLER CONDENSATE HUB FLOOR DRAIN -BY DIV. 22
  - 34) 6" WALL BASE-REFER TO FINISH SCHEDULE.
  - 35) SS UTILITY SINK-BY DIV. 22
  - 36) NOT USED B1
  - 37) CLOTHING HAMPER (NIC)
  - 38) COLD WATER HOSE 8/8 MOUNTED @48" A.F.F.-BY DIV. 22
  - 39) NOT USED B1
  - 40) ARTICULATING WHITE BOARD-SPEC 116000
  - 41) FLUSHABLE FLOOR DRAIN, BY DIV. 22
  - 42) 2" CONDUIT TO ABOVE CEILING AND LIGHT REFER TO ELEVATION 1/0800
  - 43) S.S. SHELF - 8 1/2" X 11"-BY AUTOPSY TABLE MFR
  - 44) TRASH CAN- (NIC)
  - 45) ULTIMATE 1000 LB BODY LIFT- SPEC 117810
  - 46) X-RAY ROOM TO BE SHIELDED PER QUALIFIED PHYSICIST CONSULTANT PRIOR TO CONSTRUCTION. COORDINATE WITH COUNTY.
  - 47) MOP AND BROOM HOLDER RACK-SPEC. 116000
  - 48) EXHAUST DUCT TO TACD-36- BY DIV. 23
  - 49) BODY HOIST BEAM BY STRUCTURAL
  - 50) NOT USED B1
  - 51) SCALE POLE BRACKET
  - 52) INSTRUMENT DRAWER
  - 53) DISPOSAL SWITCH
  - 54) GFCI OUTLET w/ WEATHERPROOF COVER
  - 55) 2 HP DISPOSAL- SPEC. 117810
  - 56) END RINSE CONTROL VALVE
  - 57) GOOSENECK HW & CW FAUCET
  - 58) EXHAUST VENTS BY DISSECTING STATION MFR. (6"x28") -COORDINATE DUCTWORK WITH DIV. 23
  - 59) HUB DRAIN FOR DRYING CABINET
  - 60) RECESSED GUN LOCKERS MT @ 54" C AFF- SPEC 123450
  - 61) INTEGRAL COUNTERTOP SIDE SPLASH
  - 62) NOT USED B1
  - 63) EXHAUST VENTS BY DISSECTING STATION MFR. (6"x22") -COORDINATE DUCTWORK WITH DIV. 23
  - 64) NOT USED B1
  - 65) SWING ARM WASH DOWN- BY DIV. 22
  - 66) UNDER COUNTER WASHER AND DRYER. BENCH HEIGHT TO BE DETERMINED BY OWNER FURNISHED EQUIPMENT
  - 67) 31LX120 METAL SHELF MOUNTED AT 60" AFF-BY CASEWORK MFR. REFER TO ELECTRICAL DRAWINGS FOR ASSOCIATED ELECTRICAL RECEPTACLES
  - 68) FORMALIN SPLICOT
  - 69) FORMALIN CONTAINER AND DISPENSING PUMP ON 18" DEEP SHELF
  - 70) PUMP CONTROL FOR FORMALIN DISPENSER
  - 71) DISSECTING STATION IN TISSUE RECOVERY 144D WILL BE THE TYPICAL STATION LAYOUT EXCEPT: NO FORMALIN DISPENSER, NO CUTTING BOARDS AND NO SCALE POLE, BUT INCLUDE SCALE POLE BRACKET
  - 72) SUPPORT APRON- REFER TO DETAIL 12/0820
  - 73) EXHAUST DUCT-BY DIV. 23
  - 74) CASE-SPEC BY DIV. 22
  - 75) NOT USED B1
  - 76) 30" HIGH KNEE SHANE REDUCE SUPPORT RAIL HEIGHTS TO 3" TO ALLOW FOR ADEQUATE KNEE SPACE.
  - 77) BODY VIEWING CURTAIN AND TRACK-BY DIV. 10
  - 78) CONDUIT TO AUTOPSY AUDIO EQUIPMENT
  - 79) COOLER DEHUMIDIFICATION UNIT- REFER TO MEP DRAWINGS FOR EXACT LOCATION. LOCATE WITHIN 25 FEET OF THE COLD ROOM.

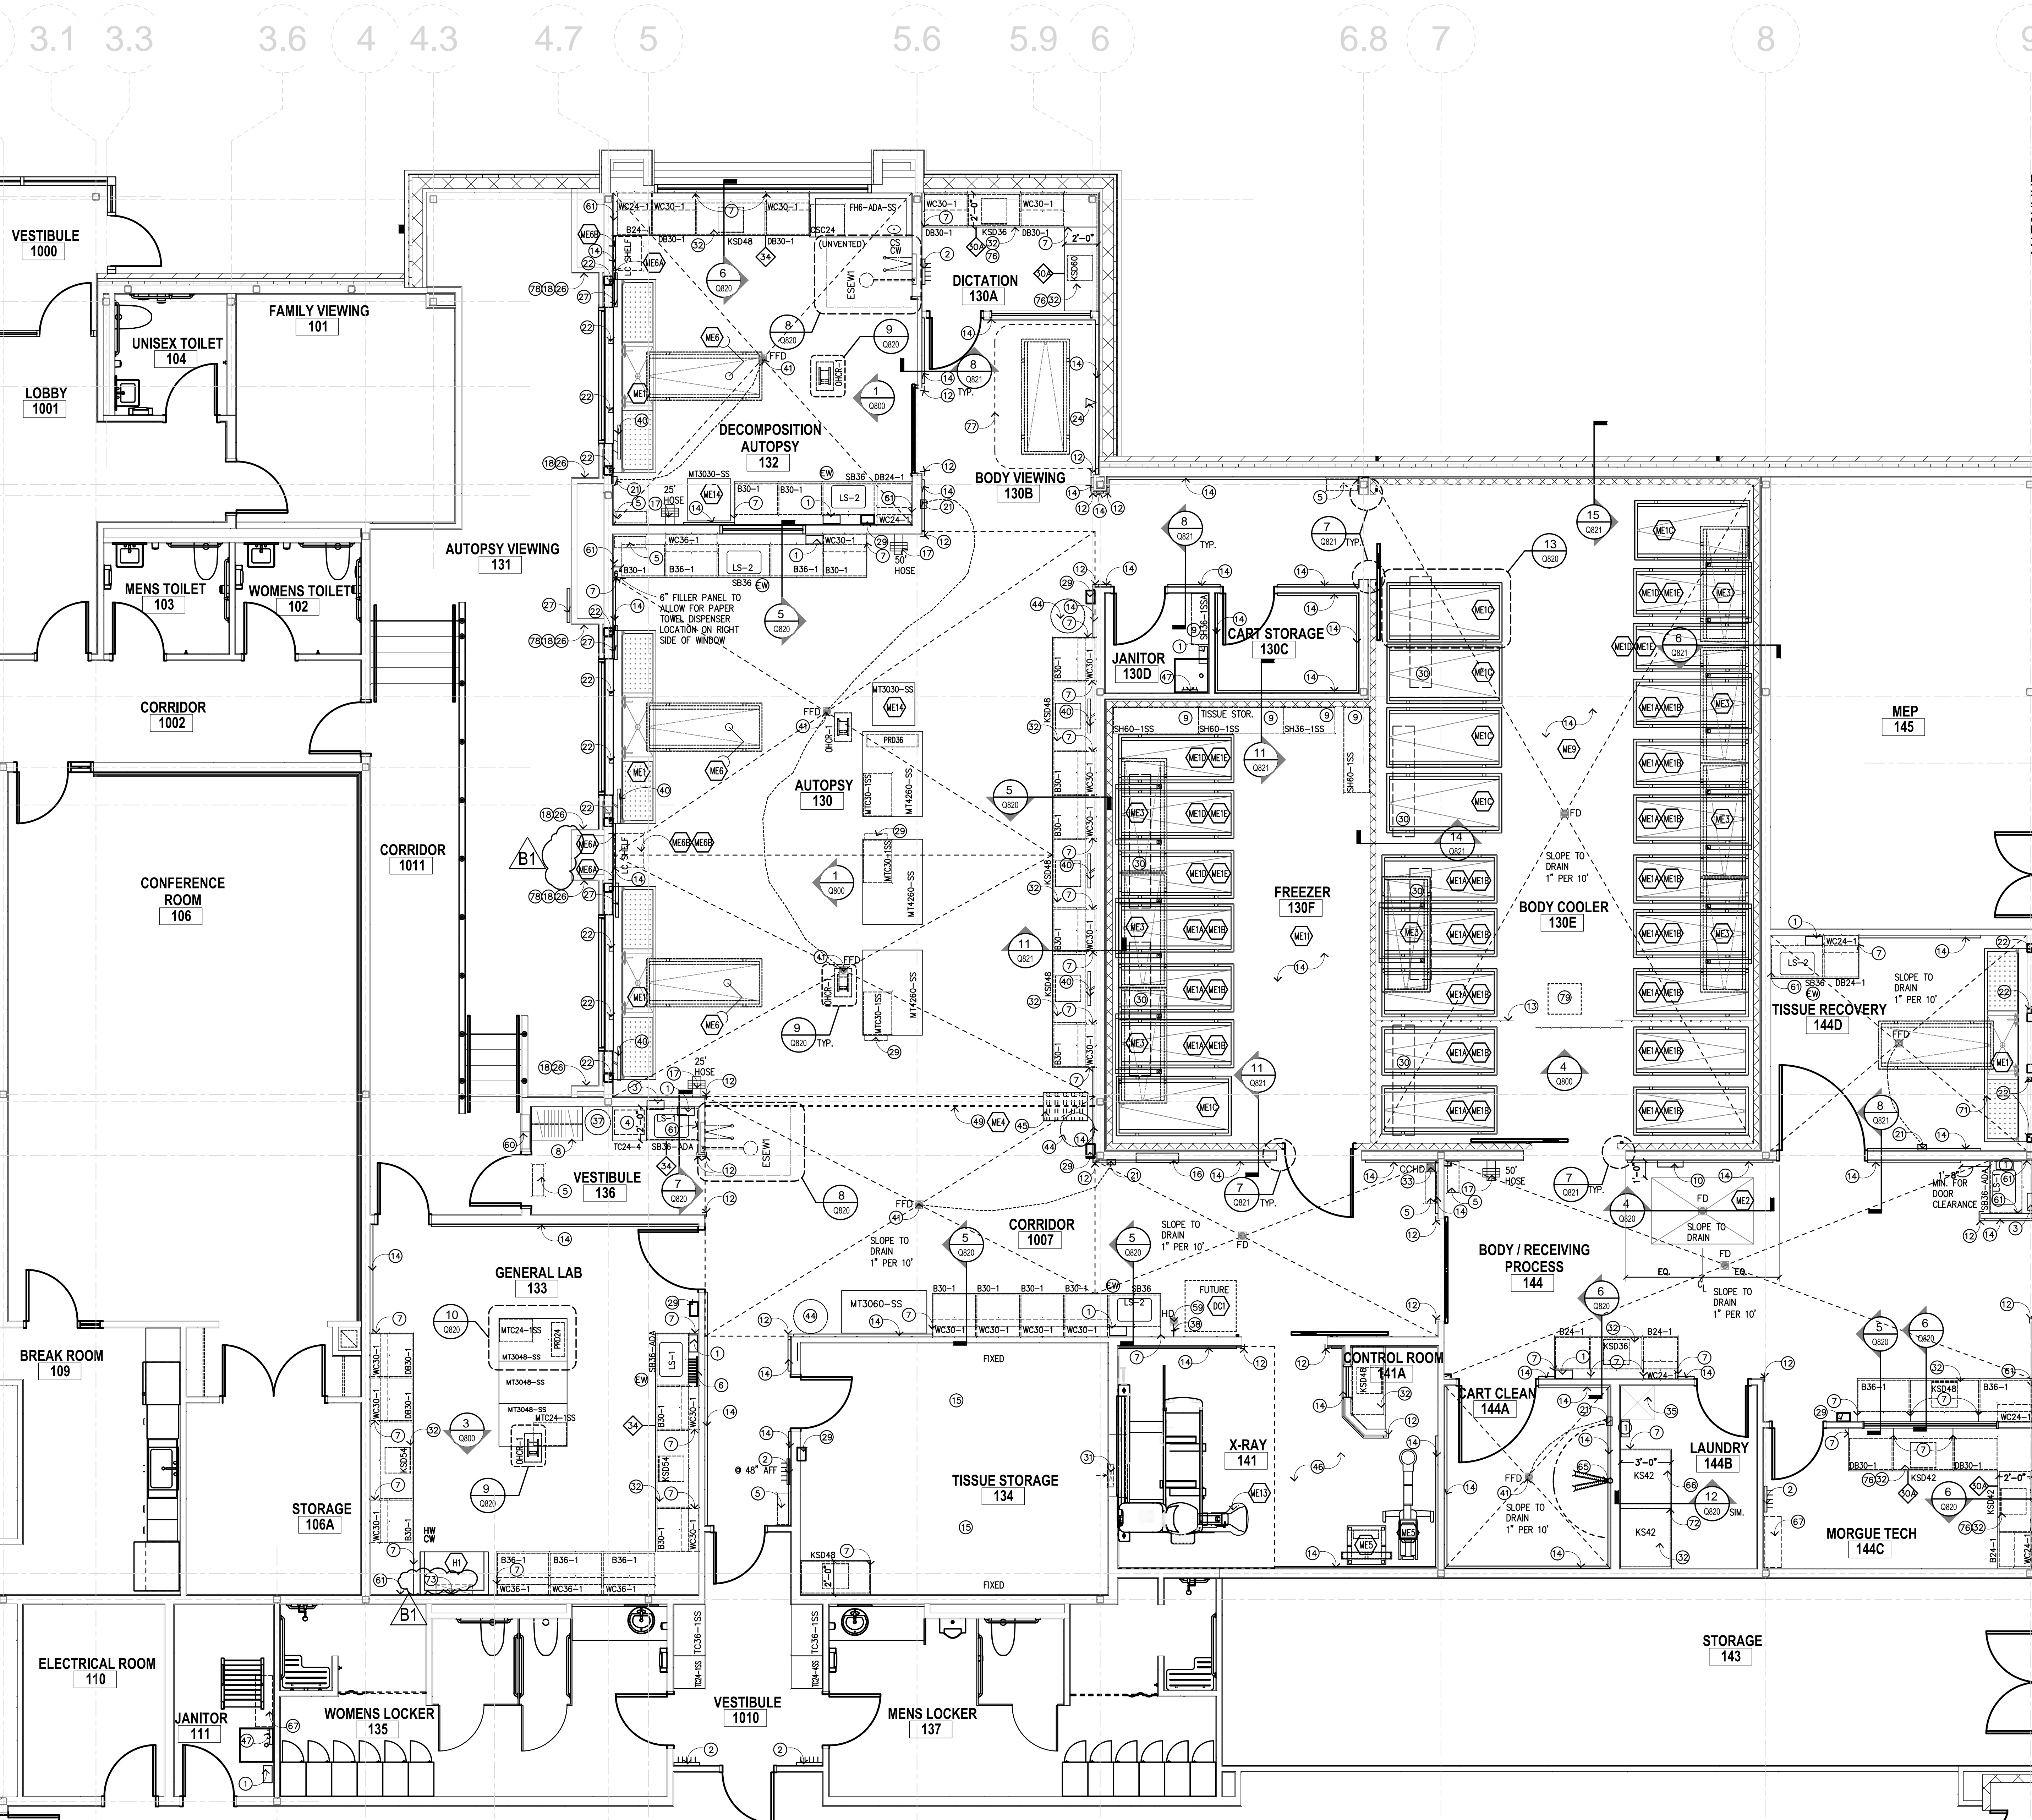

ENLARGED LAB PLAN  
SCALE: 1/4" = 1'-0"

KEYPLAN  
NTS



McClaren, Wilson &  
Lawrie, Inc.  
1798 North Lakeside  
Parkway  
Ashland, Va 23005  
(804)228.7465  
www.mwlarchitects.com

<p>NOTE: DESIGN ALL COOLER AND FREEZER CEILING PANELS TO SUPPORT A LIVE LOAD OF 50 PSF.</p>			
<p>1 SUSPENDED COOLER CEILING 1-1/2" = 1'-0"</p>	<p>2 COOLER DOOR ELEVATION - INTERIOR 1/2" = 1'-0"</p>	<p>3 COOLER DOOR ELEVATION 1/2" = 1'-0"</p>	<p>4 COOLER CEILING HANGER 3" = 1'-0"</p>
<p>5 COOLER FLOOR DRAIN DETAIL NTS</p>	<p>6 COOLER WALL TO SLAB DETAIL 1-1/2" = 1'-0"</p>	<p>7 DOOR COOLER JAMB &amp; HEADER 3" = 1'-0"</p>	<p>8 FLOOR SYSTEM SECTION 1/2" = 1'-0"</p>
<p>9 TYPICAL S.S. CORNER GUARD DETAIL 3" = 1'-0"</p>	<p>10 TYPICAL S.S. WALL GUARD DETAIL 1 1/2" = 1'-0"</p>	<p>11 FREEZER SLAB DETAIL 1 1/2" = 1'-0"</p>	<p>12 CUSTOM SS BODY SUPPORT 1 1/2" = 1'-0"</p>
<p>13 SURFACE MOUNTED CORD REEL 3" = 1'-0"</p>	<p>14 FREEZER AND COOLER DETAIL 1 1/2" = 1'-0"</p>	<p>15 COOLER WALL TO SLAB AT EXTERIOR 1 1/2" = 1'-0"</p>	


NOTES FOR FOUNDATION OF PRE-ENGINEERED METAL BUILDING AT GARAGE

- 1. BASE PLATE AND ANCHORS SIZES WILL NOT BE AVAILABLE UNTIL A SUPPLIER IS CHOSEN FOR THE METAL BUILDING... 2. FOR BID PURPOSES, THE ANCHOR BOLTS SHALL BE B10 AS (4) 1/2" x 2' 0" LONG w/ NUTS AND WASHERS FOR EACH COLUMN... 3. PIER SIZES AND REINFORCING IS DETAILED FOR BID PURPOSES... 4. FRAME OUT OPENING IN WALL FOR LOUVERS. SEE ARCH DRAWINGS FOR LOCATIONS.

Architecture Planning

Dorschner/Associates, Inc. 849 E. Washington Ave., Ste. 112 Madison, Wisconsin 53703 Phone: 608.204.0777 Fax: 608.204.0778

ISSUE 01.12.15 CONSTRUCTION DOCUMENTS 02.12.15 ADDENDUM B1

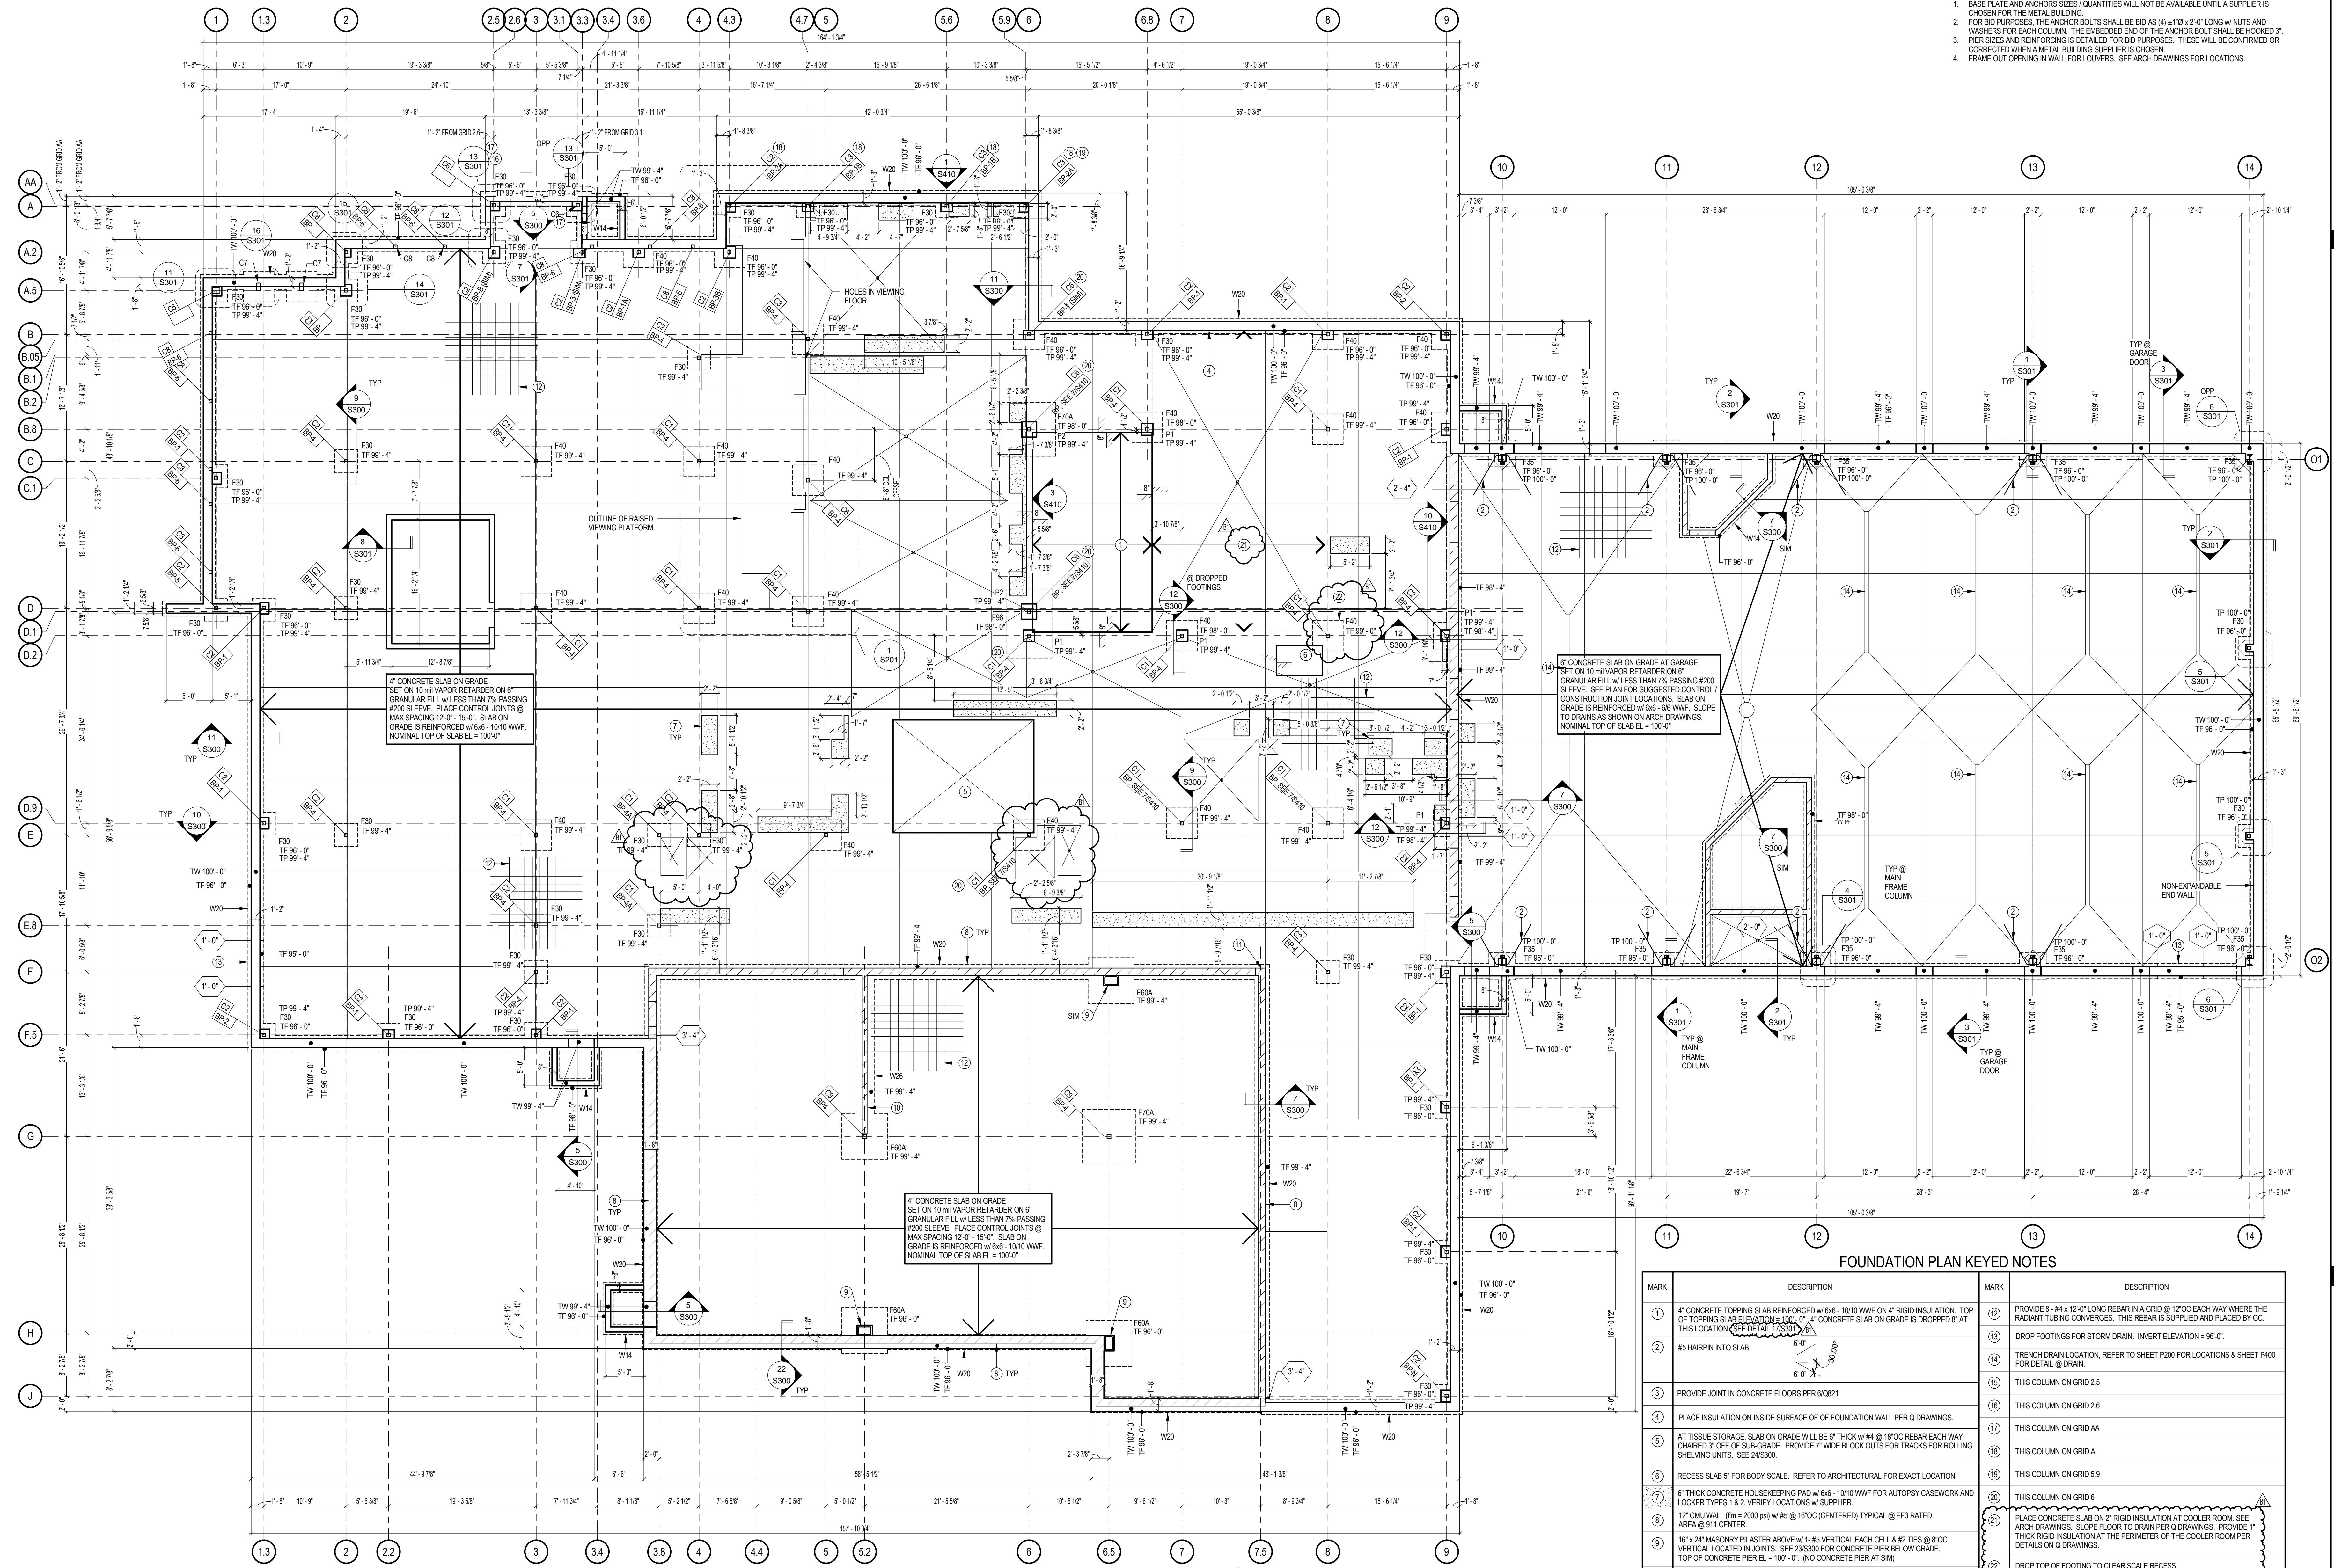

4" CONCRETE SLAB ON GRADE SET ON 10 mil VAPOR RETARDER ON 6" GRANULAR FILL w/ LESS THAN 7% PASSING #200 SLEEVE. PLACE CONTROL JOINTS @ MAX SPACING 12'-0" - 15'-0". SLAB ON GRADE IS REINFORCED w/ 6#6 - 10'10" WWF. NOMINAL TOP OF SLAB EL. = 100'-0"

6" CONCRETE SLAB ON GRADE AT GARAGE SET ON 10 mil VAPOR RETARDER ON 6" GRANULAR FILL w/ LESS THAN 7% PASSING #200 SLEEVE. SEE PLAN FOR SUGGESTED CONTROL JOINT LOCATIONS. SLAB ON GRADE IS REINFORCED w/ 6#6 - 06 WWF. SLOPE TO DRAINS AS SHOWN ON ARCH DRAWINGS. NOMINAL TOP OF SLAB EL. = 100'-0"

4" CONCRETE SLAB ON GRADE SET ON 10 mil VAPOR RETARDER ON 6" GRANULAR FILL w/ LESS THAN 7% PASSING #200 SLEEVE. PLACE CONTROL JOINTS @ MAX SPACING 12'-0" - 15'-0". SLAB ON GRADE IS REINFORCED w/ 6#6 - 10'10" WWF. NOMINAL TOP OF SLAB EL. = 100'-0"



FOUNDATION PLAN KEYED NOTES

Table with 4 columns: MARK, DESCRIPTION, MARK, DESCRIPTION. Contains 22 numbered notes detailing foundation specifications, such as rebar placement, concrete grades, and column locations.

FOUNDATION PLAN

SCALE: 1/8" = 1'-0"

- NOTES: 1. SEE SHEET S301 FOR ALL STRUCTURAL NOTES & SCHEDULES. 2. SEE SHEET S300 FOR TYPICAL FOUNDATION DETAILS NOT NECESSARILY CUT ON PLAN. 3. THE SLAB ON GRADE AND STOOPS WILL CONTAIN RADIANT HEAT TUBES AND UNDER SLAB INSULATION WHERE SHOWN ON MECHANICAL DRAWINGS. REFER TO SHEET M301 FOR LOCATION AND TO DETAIL S500 FOR DETAILS OF CONSTRUCTION. SUPPLY WIRE MESH IN SHEETS, NOT ROLLS TO PROVIDE ACCURATE PLACEMENT OF RADIANT TUBING. CONTROL JOINT DEPTH 1 1/4" TO MISS RADIANT TUBING.

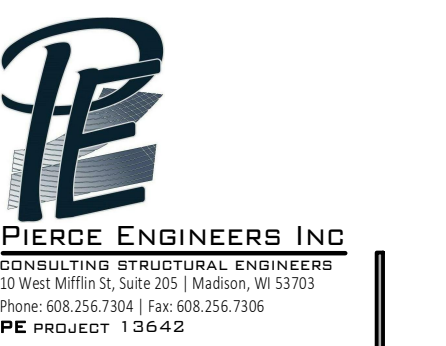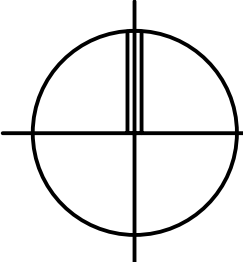

PROJECT MEDICAL EXAMINER OFFICE BUILDING (BID PACKAGE B) 3562 COUNTY HIGHWAY AB MC FARLAND, WI 53558

BID NO. 313083


DRAWING FOUNDATION PLAN

DATE 01.12.15




NOTES FOR FRAMING OF  
PRE-ENGINEERED METAL BUILDING GARAGE

- USE 5/8" COLLATERAL LOADING TO PURLINS AND MAIN FRAMES.
- END WALL FRAME IS NOT EXPANDABLE.
- THERE IS AN EXPANSION JOINT ALONG GRID 9 BETWEEN THE METAL BUILDING AND THE MAIN BUILDING. METAL BUILDING CONSTRUCTION WILL NOT RELY ON CMU WALL FOR VERTICAL OR LATERAL SUPPORT.
- THE MAXIMUM ALLOWED POOR IN SPACING SHALL BE 3" BASED ON THE METAL DECK SPECIFIED. THE SPACING IS MEASURED ALONG THE SLOPE OF THE ROOF.

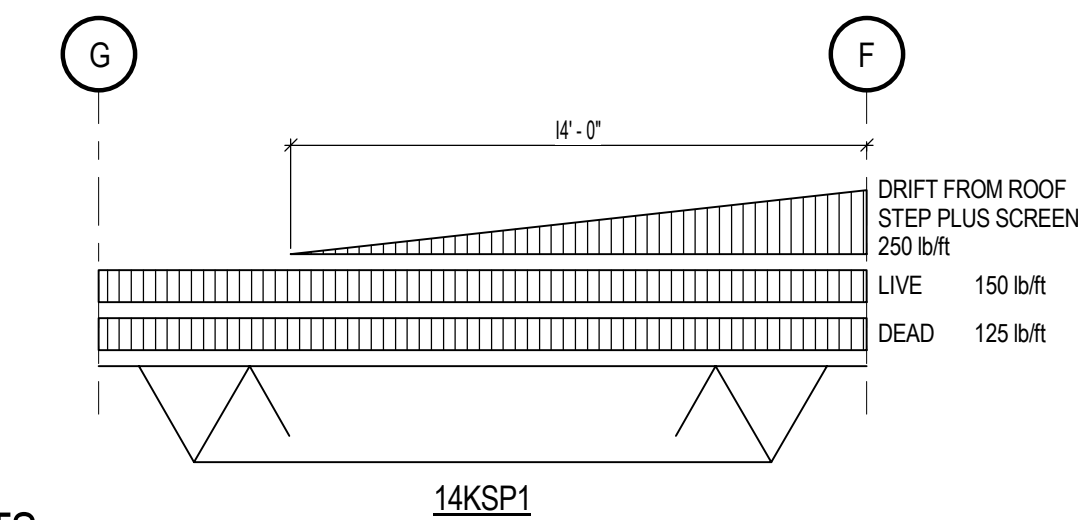


- SPECIAL JOIST NOTES:
- LIVE LOAD DEFLECTION INDEX L360.
  - CHECK FOR 12 PSI NET UPLIFT.
  - ALL LOADS ARE WORKING.

2 SPECIAL JOISTS  
SCALE: NTS

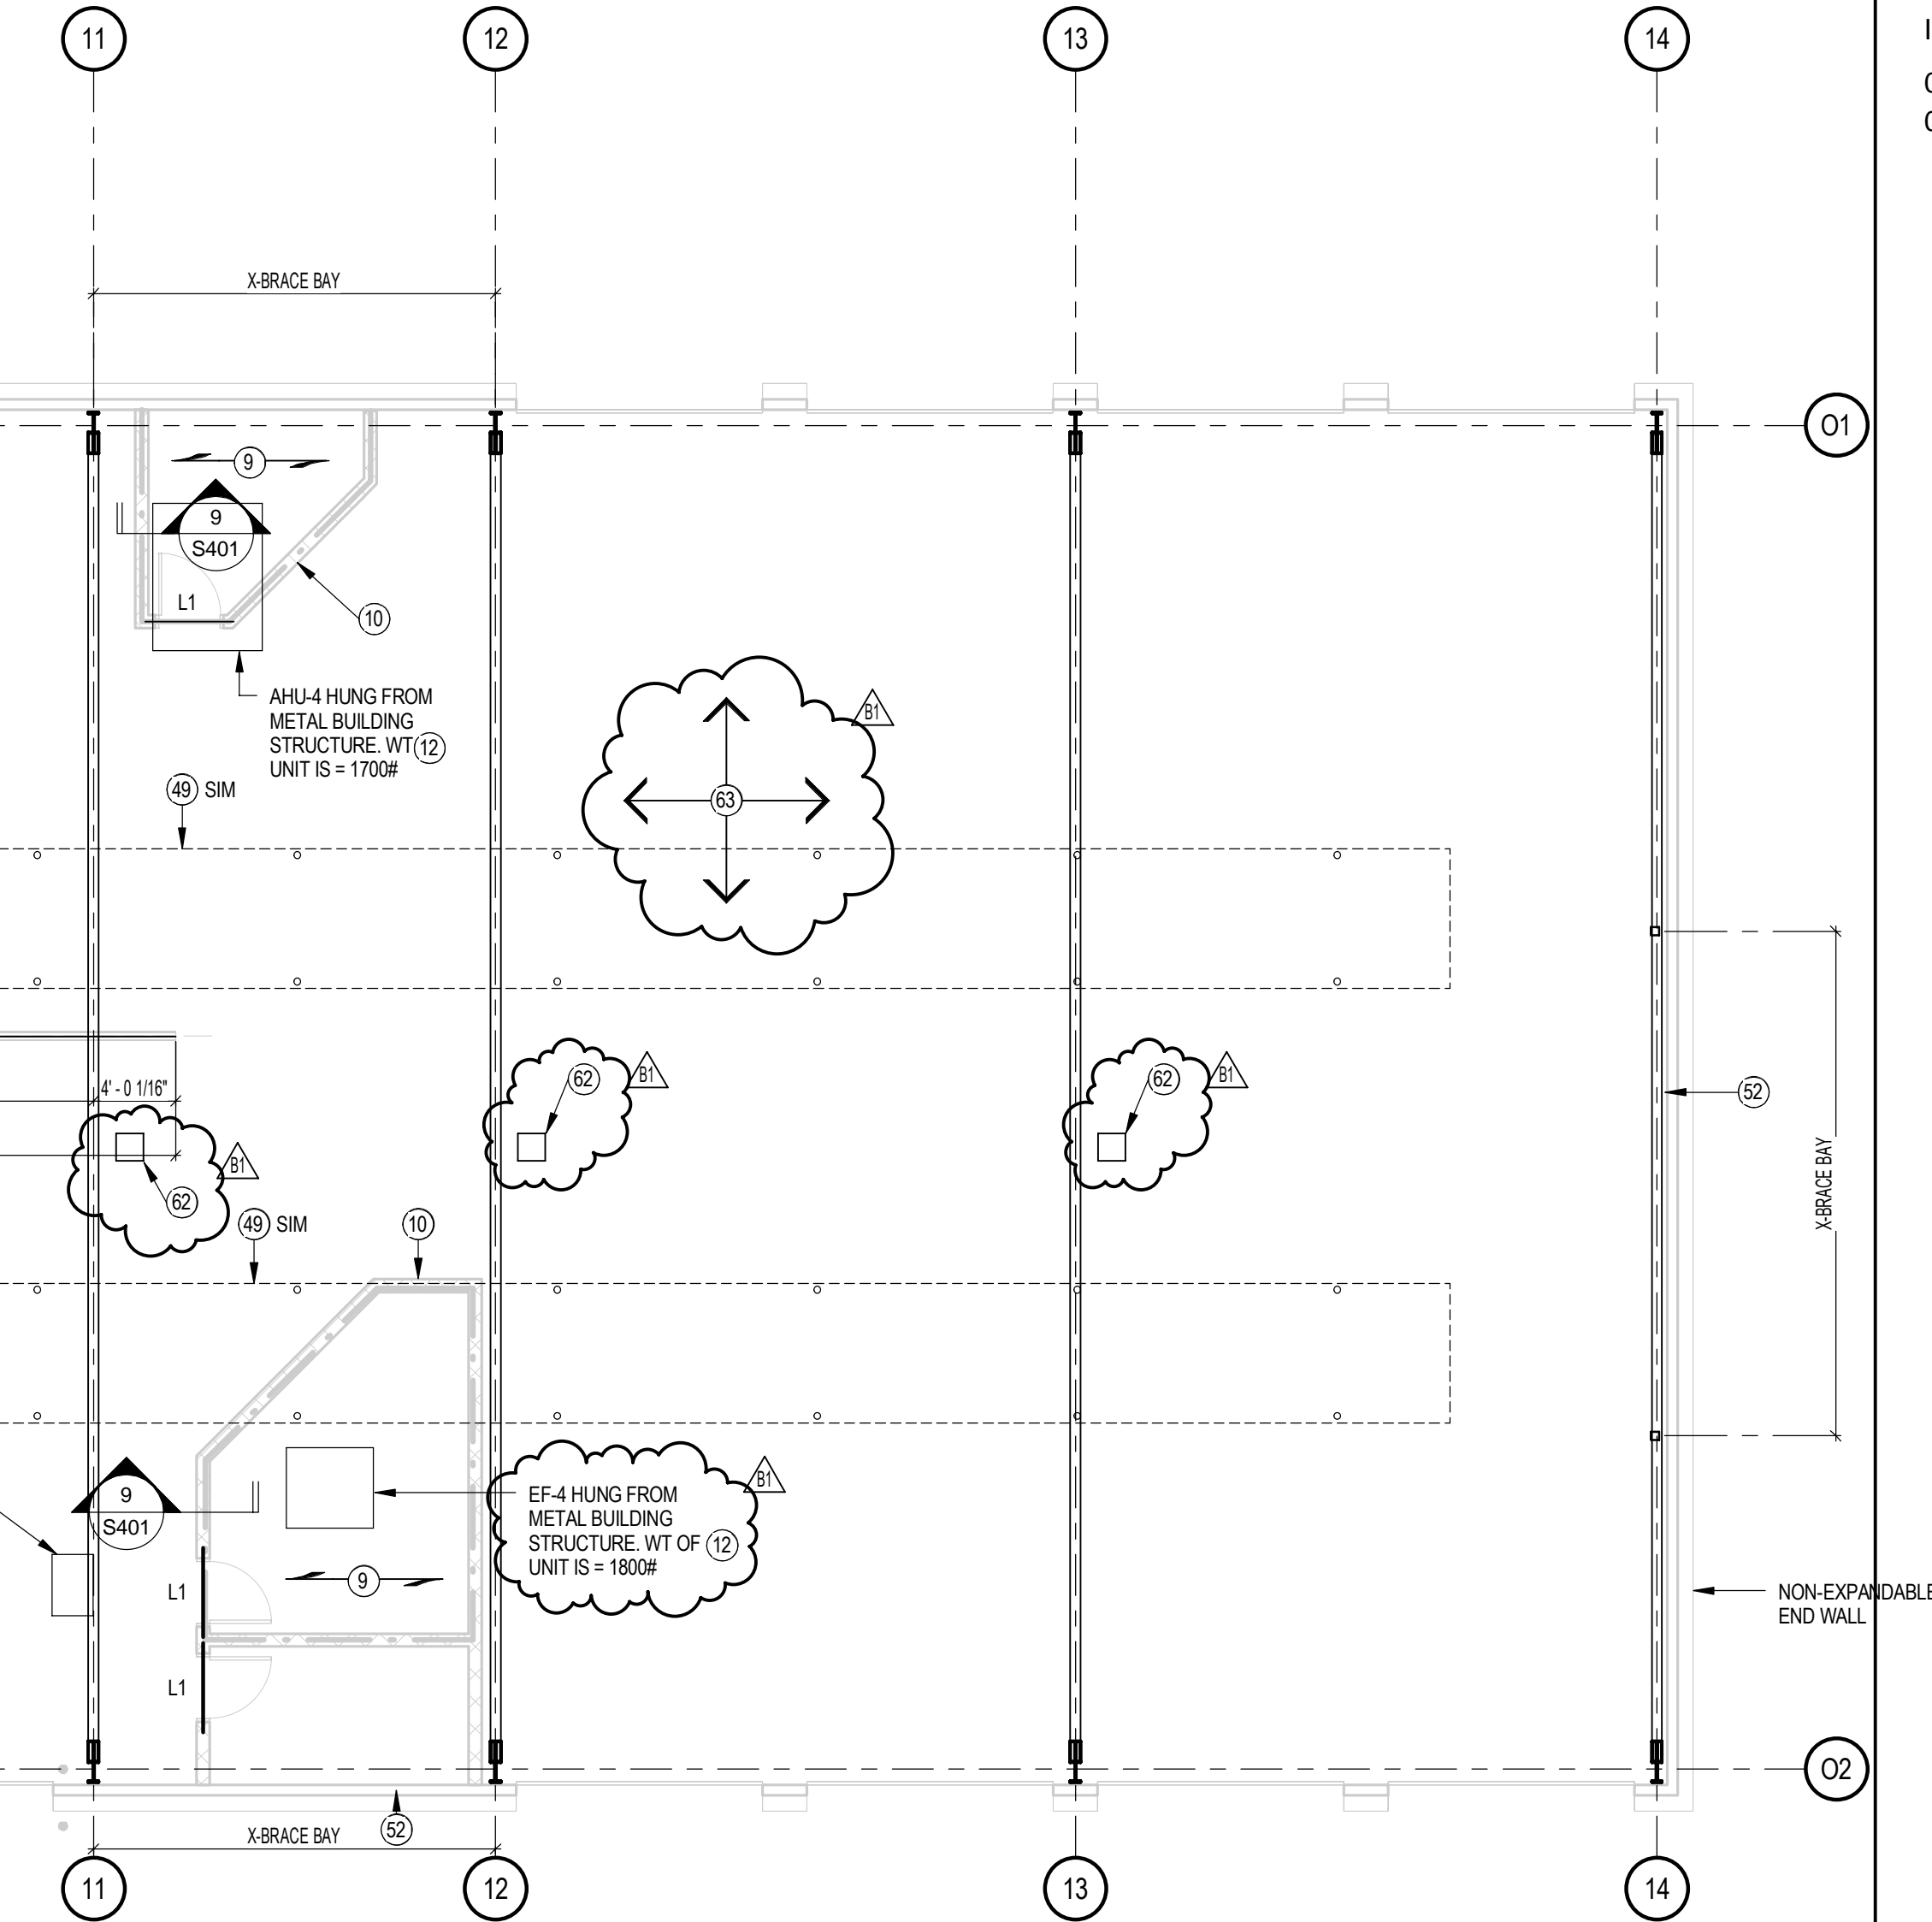

ROOF FRAMING PLAN KEYED NOTES

MARK	DESCRIPTION	MARK	DESCRIPTION
1	PROVIDE HSS4x4x1/4 OUTRIGGERS ON A DIAGONAL OFF BUILDING COLUMN FOR OUTBOARD WINDOW SUPPORT.	34	EF-2 WEIGHT = 12,000#. FRAME OUT OPENINGS PER 2/S400.
2	BEAM COPED FOR 2 1/2" DEEP BEARING SEAT. SEE DETAIL 10/S400.	35	ACC UNITS WEIGHT = 350#
3	ROOF SCREEN, SEE 1/S402, 2/S402, 3/S402 & 4/S402 FOR FRAMING.	36	EF-1 WEIGHT 200#. FRAME OUT OPENING PER 2/S400.
4	CONCRETE TOPPING ON TYPICAL METAL ROOF DECK FLOORING SYSTEM. CONCRETE SLAB SHALL BE 4" TOTAL THICKNESS (2 1/2" OVER THE DECK). REINFORCE SLAB W/ 6x6-66. TOP OF SLAB ELEVATION = 115'-4". ROOF DECK REBAR W/ 6x6-66. TOP OF DECK IS 115'-4".	37	CHANNELS ON TOP OF DECK FOR LIFT LESS PER 1/S400.
5	SEE 11/S400 FOR WINDOW BUMP-OUT FRAMING.	38	HSS6x4x1/4 FOR LIGHT SUPPORT. SEE DETAIL 9/S402.
6	1 1/2" x 18 GA GALVANIZED WIDE RIB METAL DECK @ CANOPIES. TOP OF DECK IS DROPPED TO BE 1/2" BELOW THE TOP OF TUBE SUPPORTS. TYP. THIS IS TO ALLOW THE 1/2" PLYWOOD TO FLUSH OUT WITH THE TUBE SUPPORTS.	39	MULTI W/ THE WALL PER ARCH DRAWINGS. THE 0" CMU BACK UP WILL BE GROUDED AND REINFORCED W/ #4 REBAR AT 48"OC VERTICALLY IN THE CENTER OF THE 8" WALL. LAP SPlice 2'-0" ON THE REBAR. THIS WILL OCCUR THE FULL LENGTH OF THE WALL.
7	STEEL BEAM FRAMES INTO SIDE OF CONCRETE SHELTER PER DETAIL 1/S401.	40	VERIFY W/ OPENING DIMENSION REQUIRED.
8	CONCRETE CAP OF SHELTER CONSTRUCTION. SEE DETAIL 8/S301.	41	FRAME OUT FOR STAIR OPENINGS.
9	4" TOTAL THICKNESS CONC. SLAB ON 1 1/2"x22 GA GALV. METAL FORMED DECK. REINFORCED W/ 6x6-66 W/W. TYP. SLAB ELEVATION = 110'-4". SUPPORT FOR AHU UNIT. NOT USED FOR STORAGE SUPPORT. SLAB ON 8/20/200-97 @ 24"OC COLD-FORMED JOISTS. BRIDGE @ MIDSPAN.	42	FRAME OUT FOR ROOF MONITOR. SEE 3/S201.
10	8" CMU BELOW.	43	ONE SIDE CONNECTION DUE TO FRAMING OFFSET. USE 1-L43 1/2x6 1/2 x 1/2 W/ 5-7/8" A325 BOLTS IN FIELD CONNECTION.
11	W10x26 TROLLEY SUPPORT BEAM. TROLLEY BEAM AND SUPPORTS BY METAL BUILDING SUPPLIER. DESIGN LIFT CAPACITY IS 2000# W/ IMPACT. THE TROLLEY SUPPORT BEAM SHALL BE SUPPORTED VERTICALLY AND Laterally ON BOTH AXIS AT THE MAIN FRAME SUPPORTS. PROVIDE L3x3x1/4 EACH END TO SERVE AS TROLLEY STOPS. BOTTOM OF TROLLEY BEAM ELEVATION = 112'-4". VERIFY W/ ARCH DWS.	44	HSS8x4x1/4 (117'-8 3/4") ON COLUMN CENTERLINE W/ DECK SUPPORT ANGLE. SEE 7/S401 (SIM).
12	METAL BUILDING SUPPLIER TO PROVIDE SUPPORT FOR EQUIPMENT.	45	W10x22 (116'-10") AROUND PERIMETER OF POP-UP ROOF.
13	DOUBLE JOIST OF TYPICAL SIZE FOR SNOW DRIFT.	46	TROLLEY SUPPORT BEAM W10x26. BOTTOM OF BEAM EL. = 110'-2 5/8". BEAM SIZED FOR 1000 # LIFT. SEE ARCH FOR POSITION. SEE 1/S403 FOR SUPPORT DETAIL @ COLUMNS D.1-4.7.
14	HSS8x4x1/4 W/ DECK BRG ANGLE ALONG WALL. (117'-8 3/4") TO FLUSH W/ TOP OF PLYWOOD.	47	1/4" x 1/4" PROVIDE L3x3x1/4 SHIP WELDED ANGLE @ EACH END AS TROLLEY STOP.
15	HSS10x10x5/8 COLUMN. THIS COLUMN IS OFF GRID.	48	DECK SPAN DIRECTION @ CANOPY.
16	CAMBER UP STEEL @ CORNER 1'.	49	THIS SCREEN WALL COLUMN WILL STRADDLE THE BEAM JOINT.
17	HSS12x6x1/2 COLUMN / OUTRIGGER ASSEMBLY.	50	ROOF MOUNTED PV CELLS. REFER TO SHEET S202 & DETAILS 9/S403 & 10/S403 FOR ATTACHMENT. PROVIDE HSS 4.0 x 2.0 @ POST LOCATIONS SHOWN. REFER TO 1/S403 FOR TYP. FRAMING OF RACK SUPPORTS. (SUPPORTED ON METAL BLDG ROOF MEMBERS @ SIM).
18	HSS6x4x1/2 COLUMN W/ HSS12x6x1/2 OUTRIGGER (HIGH) (117'-8 3/4") AND HSS10x4x1/4 OUTRIGGER (LOW) (111'-3 1/2"). PROVIDE TYPICAL RECESSED METAL DECK AT BOTH LEVELS.	51	RTU. SEE PLAN FOR WEIGHTS.
19	HSS6x4x1/2 COLUMN / HSS12x6x1/2 OUTRIGGER (117'-8 3/4") ASSEMBLY.	52	ROOF OPENING. VERIFY SIZE & LOCATION W/ MECH DWGS. REFER TO 2/S400.
20	HSS12x6x1/2 (LSV) OUTRIGGER (117'-8 3/4").	53	COORDINATE X-BRACES W/ LOUVER OPENINGS IN WALLS.
21	ODOR LINE INDICATED W/ HATCHING.	54	W14x22 (116'-10") ON CMU WALL CENTERLINE.
22	DECK BEARING ANGLE PER 8/S301.	55	3/8" x 1/4" SQUARE BEARING PLATE W/ 2-1/2" x 4" HEADED STUDS BELOW. BEAR ON SOLID GROUDED CMU DOWN 3- COURSES.
23	POSITION JOIST IN ALIGNMENT W/ INSIDE FACE OF CONCRETE WALL.	56	DIAGONAL BRACES @ EQUIPMENT SCREEN COLUMN.
24	C8x11.5	57	DOUBLE COLUMNS @ EQUIPMENT SCREEN. SPACE @ 10'OC. NO HORIZONTAL MEMBERS BETWEEN. THIS GAP TO ALLOW EXPANSION/CONTRACTION DUE TO TEMPERATURE CHANGES.
25	ANCHOR STEEL COLUMN TO CMU WALL W/ ADJUSTABLE STRAP ANCHORS @ 16'OC.	58	COPE BEAM ENDS PER 12/S400.
26	HSS12x6x1/2 COLUMN / HSS12x4x1/2 OUTRIGGER ASSEMBLY. TOP OF OUTRIGGER ASSEMBLY = 117'-8 3/4".	59	L3x3x1/4 DECK BEARING ANGLE. ANCHOR TO GROUT FILLED CMU W/ 1/2" x 4" SIMPSON TITEN HD (OR EQUAL) @ 24"OC.
27	PROVIDE WINDOW OUTRIGGER TUBES AT THIS CANOPY COLUMN PER 11/S400.	60	MCS20 (116'-10"), NORTH & SOUTH SIDE OF OPENING.
28	OFFSET W2x12 TO NORTH 1/2" FROM COLUMN CENTERLINE. (THUS 4 5/8" SOUTH OF GRID D.)	61	OPENING IN PRECAST PLAN FOR LIFT DUCT. VERIFY SIZE & LOCATION W/ MECH DRAWINGS. PRECAST TO DESIGN AND SUPPLY STEEL BEAM.
29	MCS20 BETWEEN ROOF JOISTS (116'-10") TO SUPPORT POP UP ROOF WALLS.	62	ROOF TOP ACCU UNIT. WEIGHT = 500#(14) THIS. PROVIDE INTERNAL JOIST REINFORCING PER DETAIL 1/S400.
30	HSS6x4x1/2 COLUMNS AT ALL FOUR CORNERS. SEE DETAIL 22/S401.	63	STR. STEEL SUPPLIERS SHALL SUPPLY LOOSE ANGLE SIM TO DETAIL 18/S301 FOR SUPPORT OF CORD REELS. METAL BUILDING SUPPLIER SHALL NOTE EXISTENCE OF CORD REELS.
31	AHJ-2 WEIGHT = 8,500#	64	METAL ROOF DECK OVER THE GARAGE AREA SHALL BE SUPPLIED AND CREATED UNDER SPEC SECTION 052100. DECK SHALL BE AS DEFINED UNDER GENERAL NOTE 3 ON THIS PAGE AND ANCHORED PER THE STEEL DECK NOTES NUMBER 7.
32	HSS6x4x1/4 TUBES @ AUTOPEY ROOM. REFER TO 10/S410, 2/S421 AND 6/S421.	65	4'-6" WIDE OPENING IN ROOF FOR HV. VERIFY SIZE.
33	4'-6" WIDE OPENING IN ROOF FOR HV. VERIFY SIZE.		

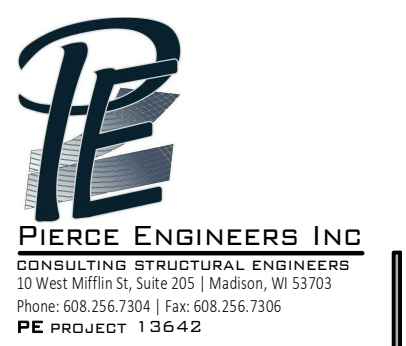


PIERCE ENGINEERS INC  

PROJECT  
MEDICAL EXAMINER OFFICE  
BUILDING (BID PACKAGE B)  
3562 COUNTY HIGHWAY AB  
MC FARLAND, WI 53558

BID NO.  
313083

DRAWING  
ROOF FRAMING PLAN

DATE  
01.12.15

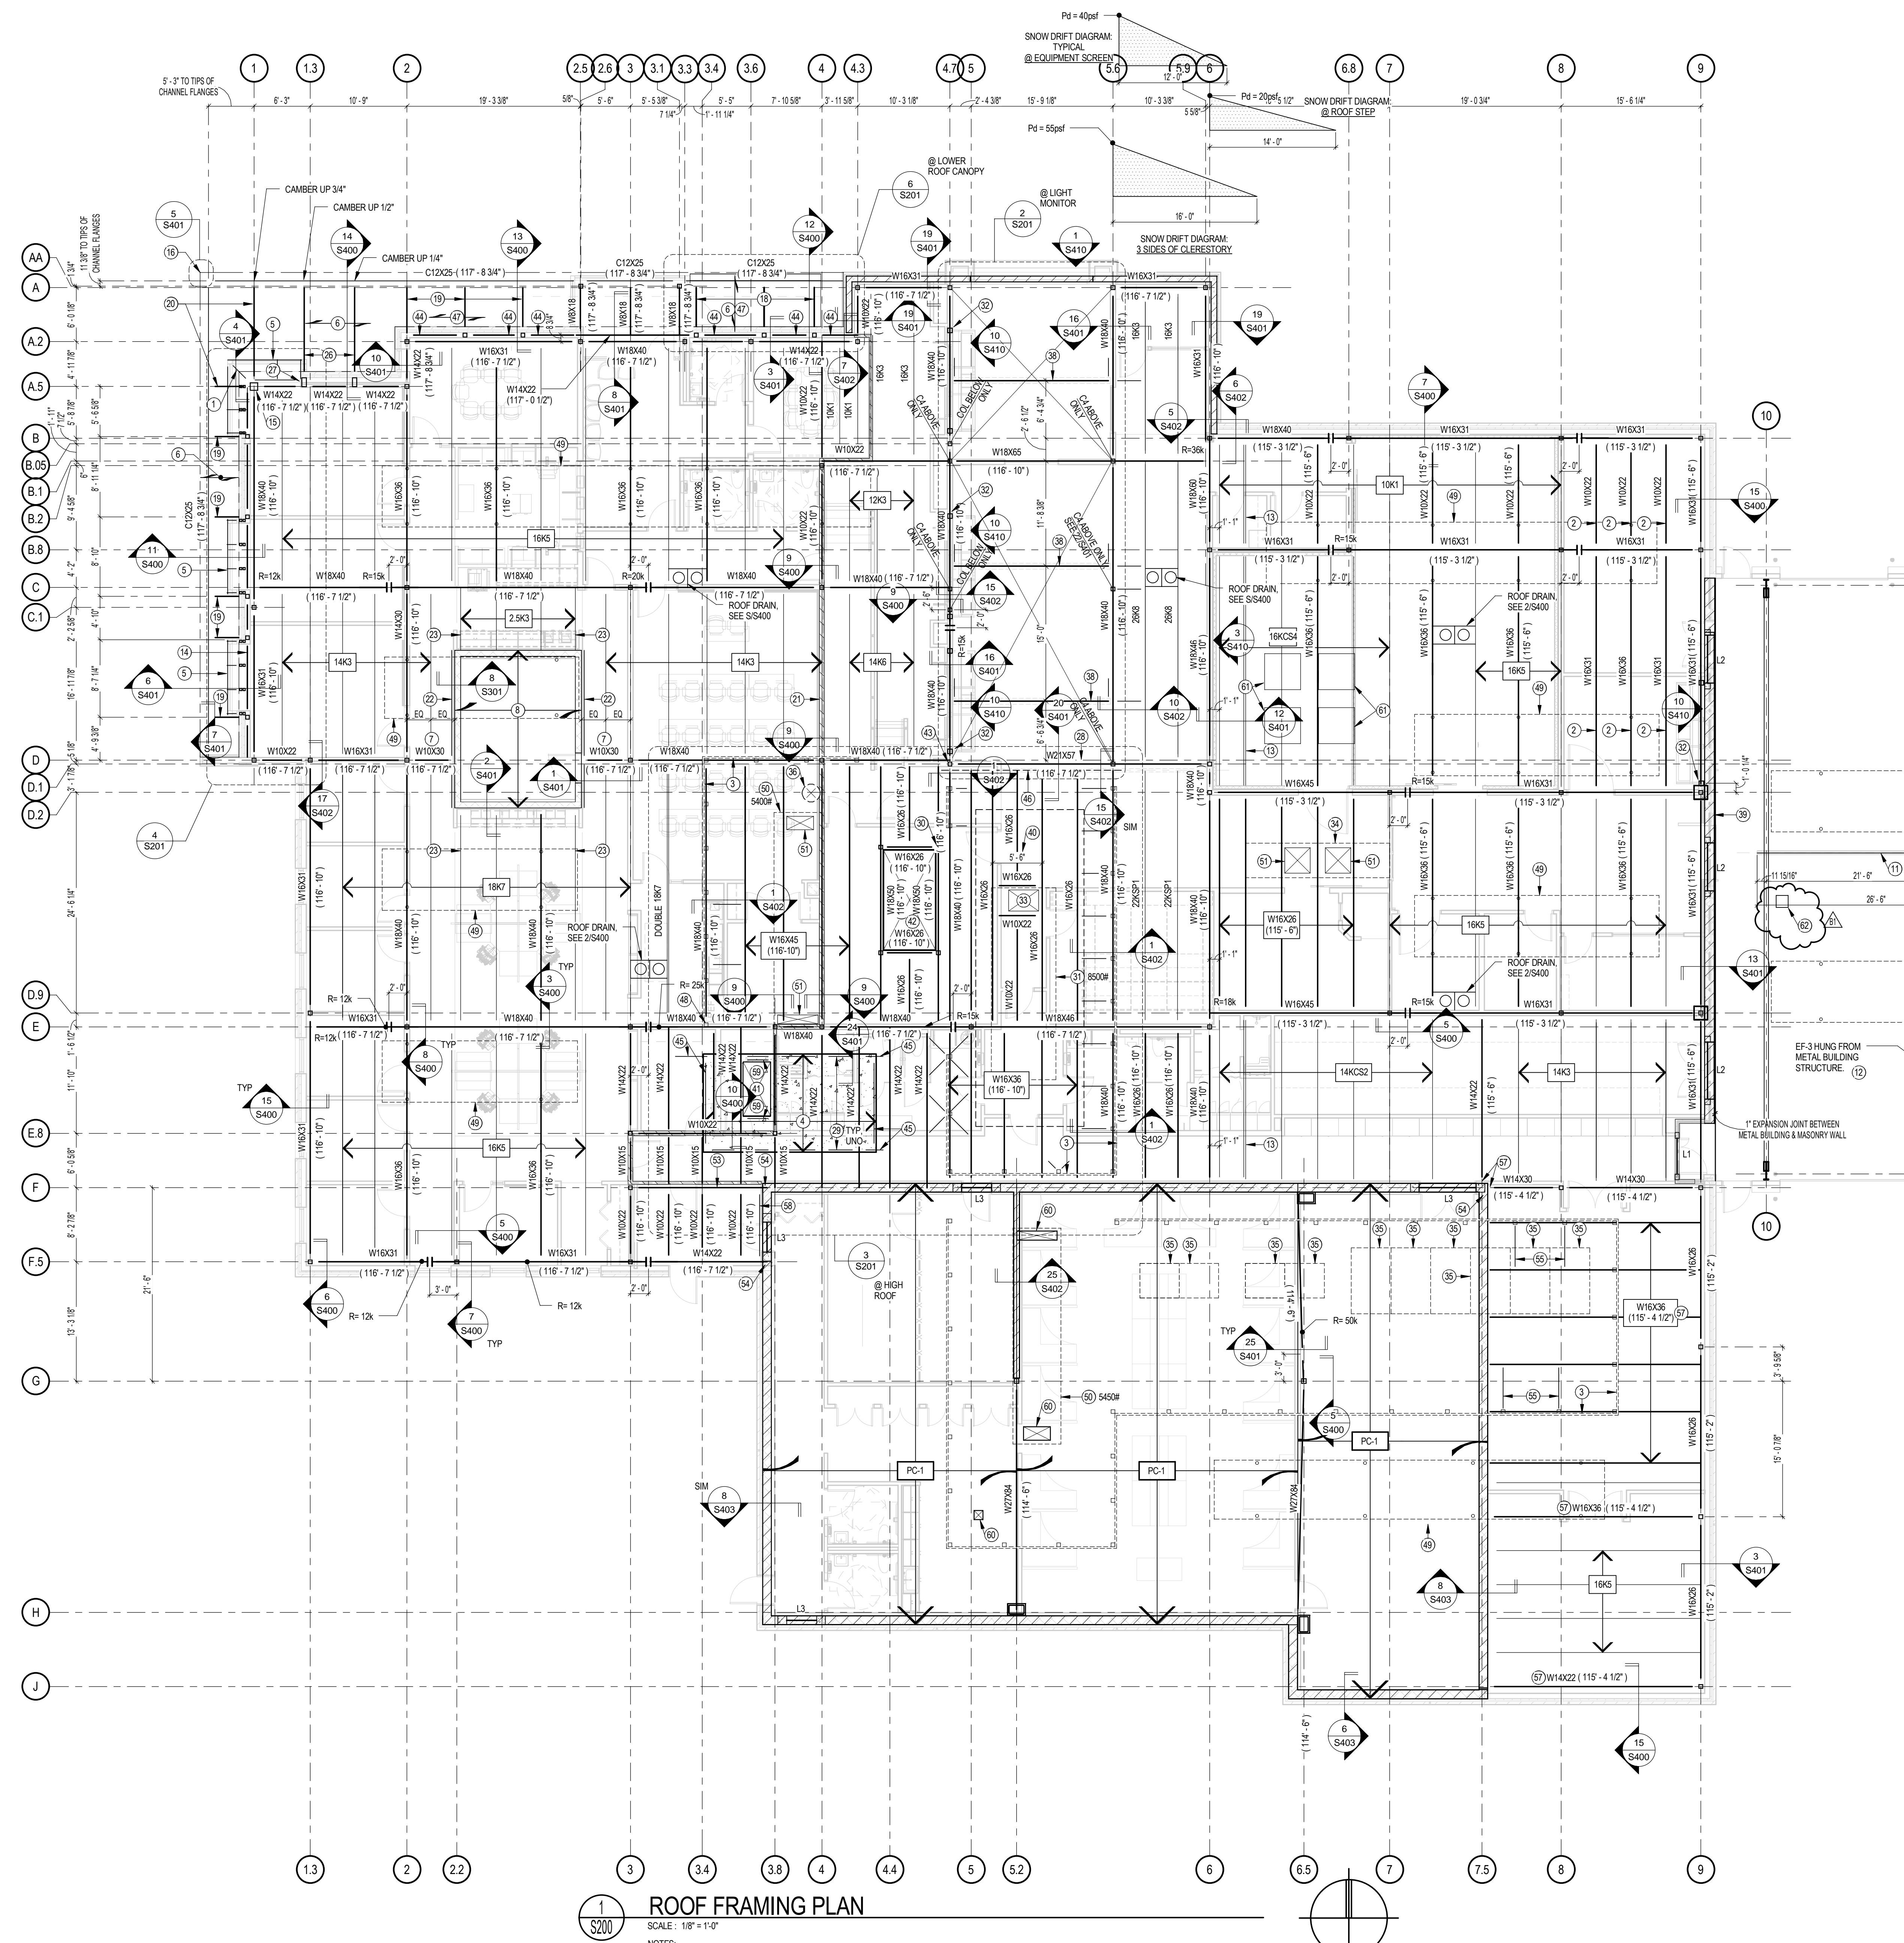

1 ROOF FRAMING PLAN  
SCALE: 1/8" = 1'-0"


- NOTES:
- SEE SHEET S201 FOR ALL STRUCTURAL NOTES & SCHEDULES.
  - TOP OF STEEL ELEVATION = JOIST BEARING ELEVATION + 116'-7 1/2", UNLESS NOTED OTHERWISE, I.E. RELATIVE (2 1/2") OR ACTUAL (117'-8 3/4"). AT LOW ROOF. TOP OF STEEL ELEVATION = JOIST BEARING ELEVATION + 115'-3 1/2", UNLESS NOTED OTHERWISE, I.E. RELATIVE (2 1/2") OR ACTUAL (117'-8 3/4").
  - ROOF DECK SHALL BE 1 1/2" x 22 GA GALVANIZED WIDE RIB METAL DECK. ERECT (3) SPANS OR (4) SUPPORTS (MIN.) ANCHOR PER S200.

MISC. FRAMING PLAN KEYED NOTES


MARK	DESCRIPTION
1	BUILDING COLUMN.
2	WINDOW FRAME COLUMN.
3	HSS4x4x1/4 (104'-0").
4	LOW OUTRIGGERS CONCEALED BY A BUILT-IN BENCH.
5	L4x4x1/4 x CONT. FOR WINDOW SUPPORT / STABILIZATION @ 104'-0".
6	1 1/2" x 22 GA PAINTED WIDE RIB METAL ROOF DECK. ERECT 3- SPANS OR 4- SUPPORTS (MIN) ANCHOR PER S300.
7	TOP OF COLUMN = TOP OF METAL DECK. PLACE 20 GA x 2'-0" SQUARE COVER PLATE ON DECK.
8	SECTION OF W12x22 SHOP WELDED TO COLUMN AS AN OUTRIGGER.
9	HSS4x4x1/4 (104'-0").
10	HSS10x4x1/4 (111'-3 1/2").
11	HSS6x3x3/8 LSV (115'-6").
12	L4x3x1/4 LH FOR WINDOW SUPPORT / STABILIZATION.
13	HSS3x3x1/4 OUTRIGGERS (115'-3").
14	CORD REEL BELOW, SEE 11S401 FOR SUPPORT DETAIL.

VIEWING PLATFORM FRAMING NOTES


1. EXTEND CONCRETE SLAB ON GRADE UNDER RAISED VIEWING AREA.
2. PROVIDE METAL STUD WALLS AROUND ENTIRE PERIMETER OF RAISED VIEWING PLATFORM AND AT MAX 3'-0" OC INTERNALLY.
3. PROVIDE DIAGONAL X BRACE PANELS WHERE SHOWN ON PLAN. USE 2"x14ga STRAP ON EACH SIDE OF WALL PLACED IN AN X SHAPE. SEE DETAIL 22S402.
4. RAISED FLOOR SYSTEM IS 4 1/2" TOTAL THICKNESS CONCRETE SLAB ON 1 1/2" x 22ga GALVANIZED METAL FORM DECK INSTALLED WIDE FLUTES UP. REINFORCE w/ 6x6 - 68 WWF.

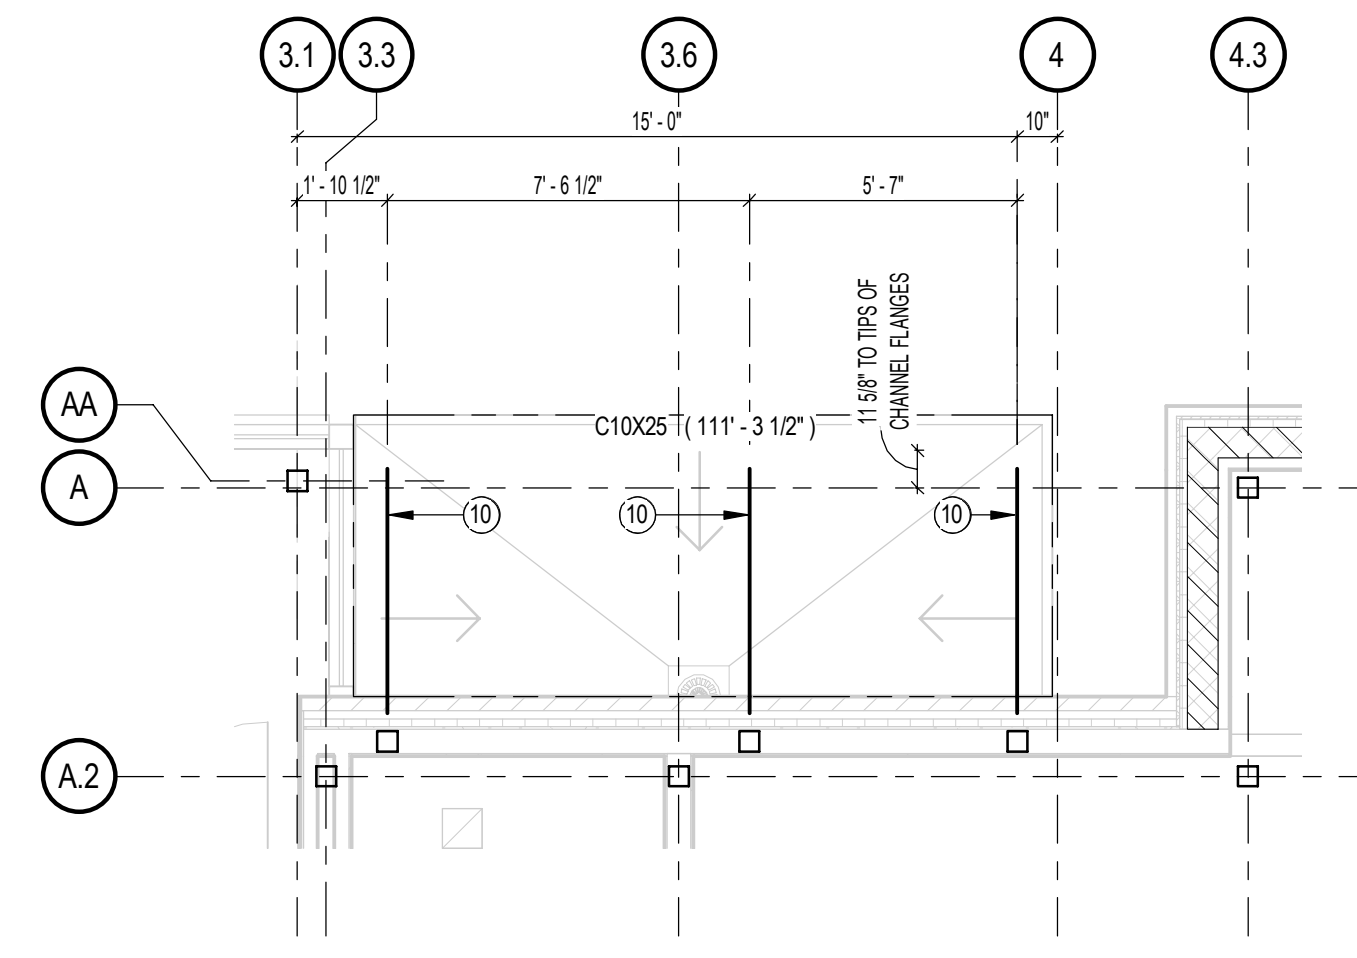


6 LOWER CANOPY FRAMING PLAN  
SCALE: 1/4" = 1'-0"

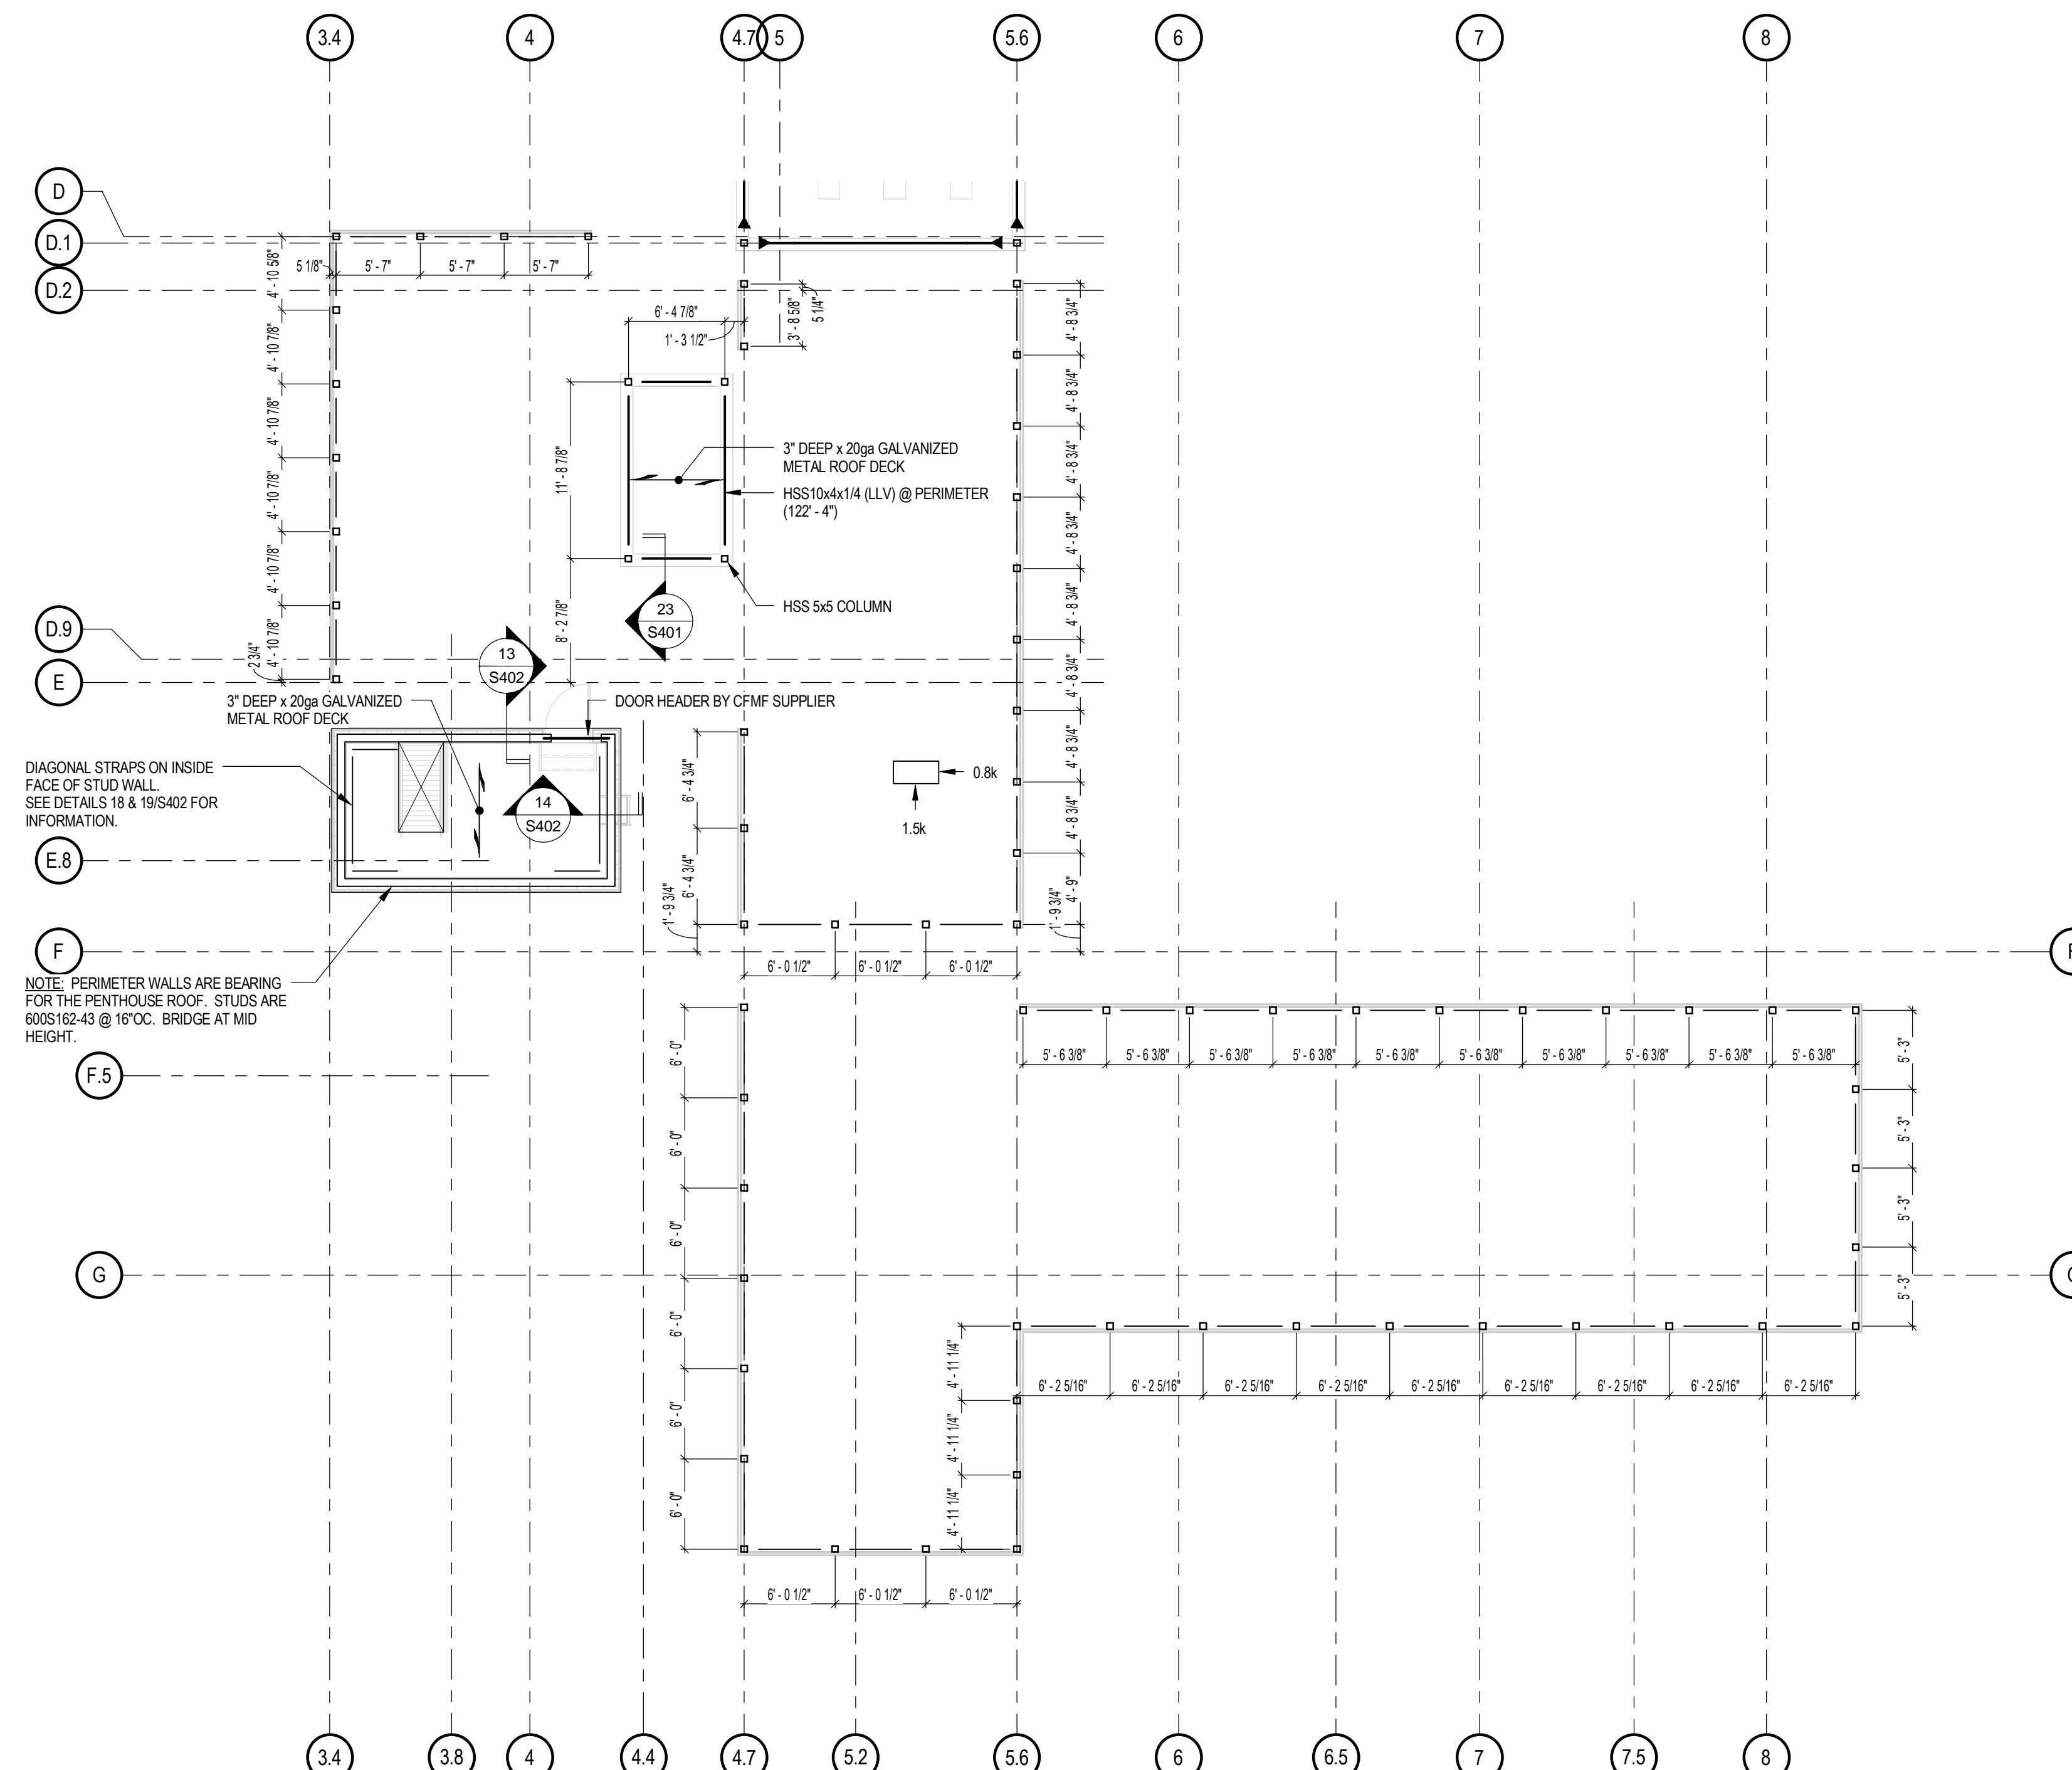


3 HIGH ROOF FRAMING PLAN  
SCALE: NTS

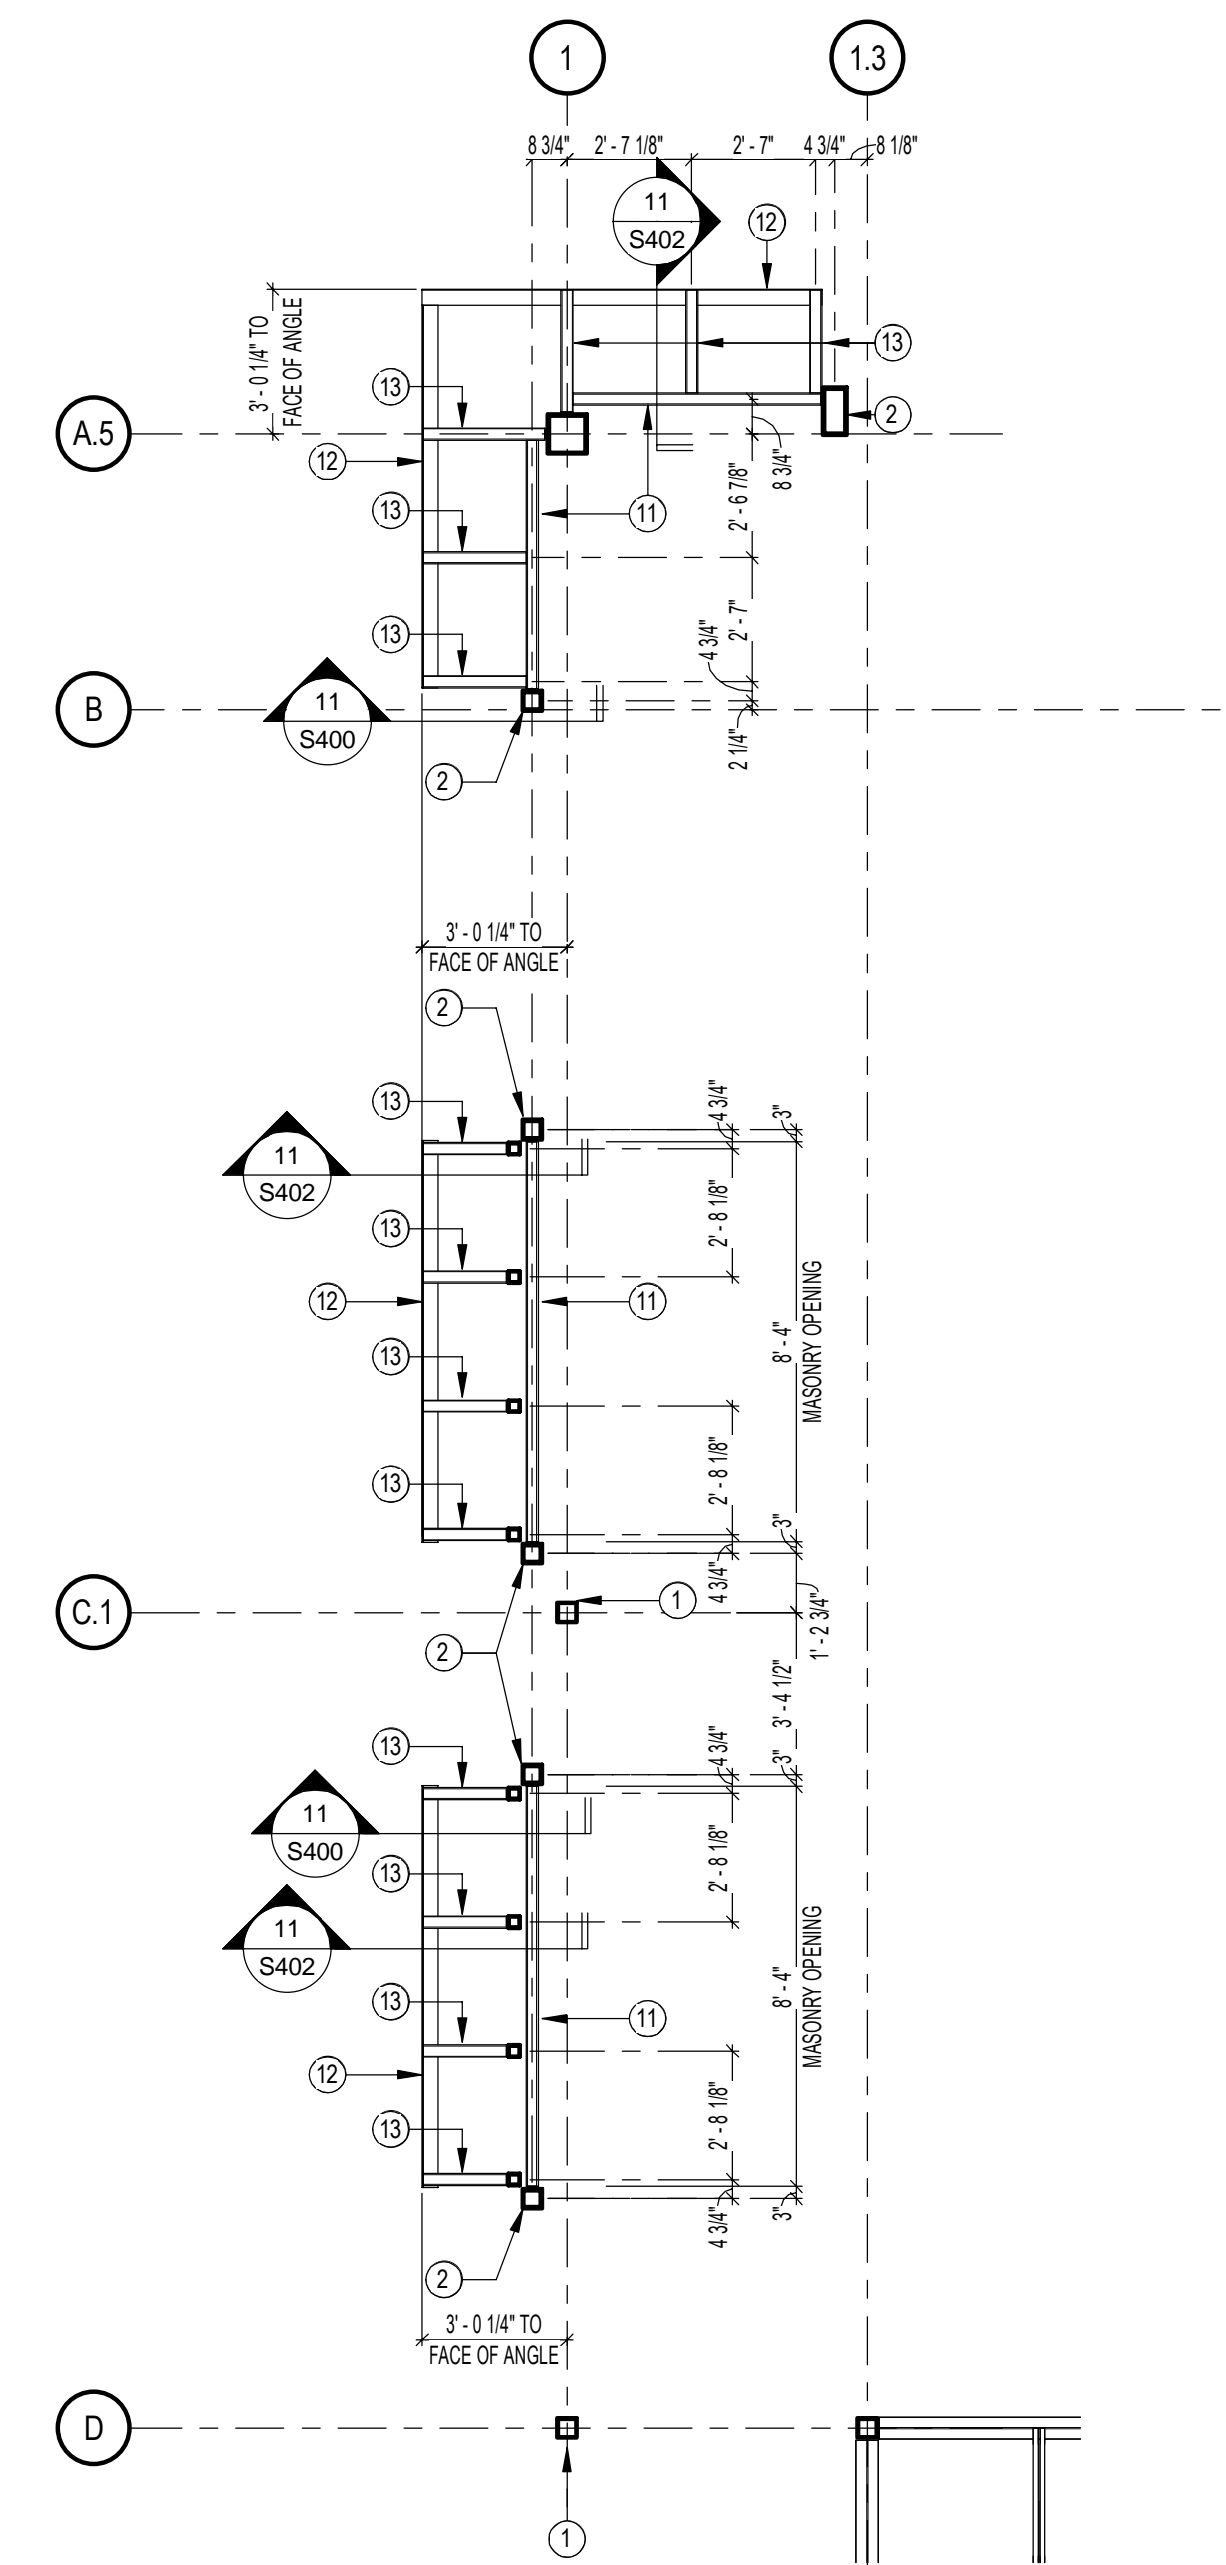


5 WINDOW LEVEL FRAMING (HIGH)  
SCALE: 1/4" = 1'-0"

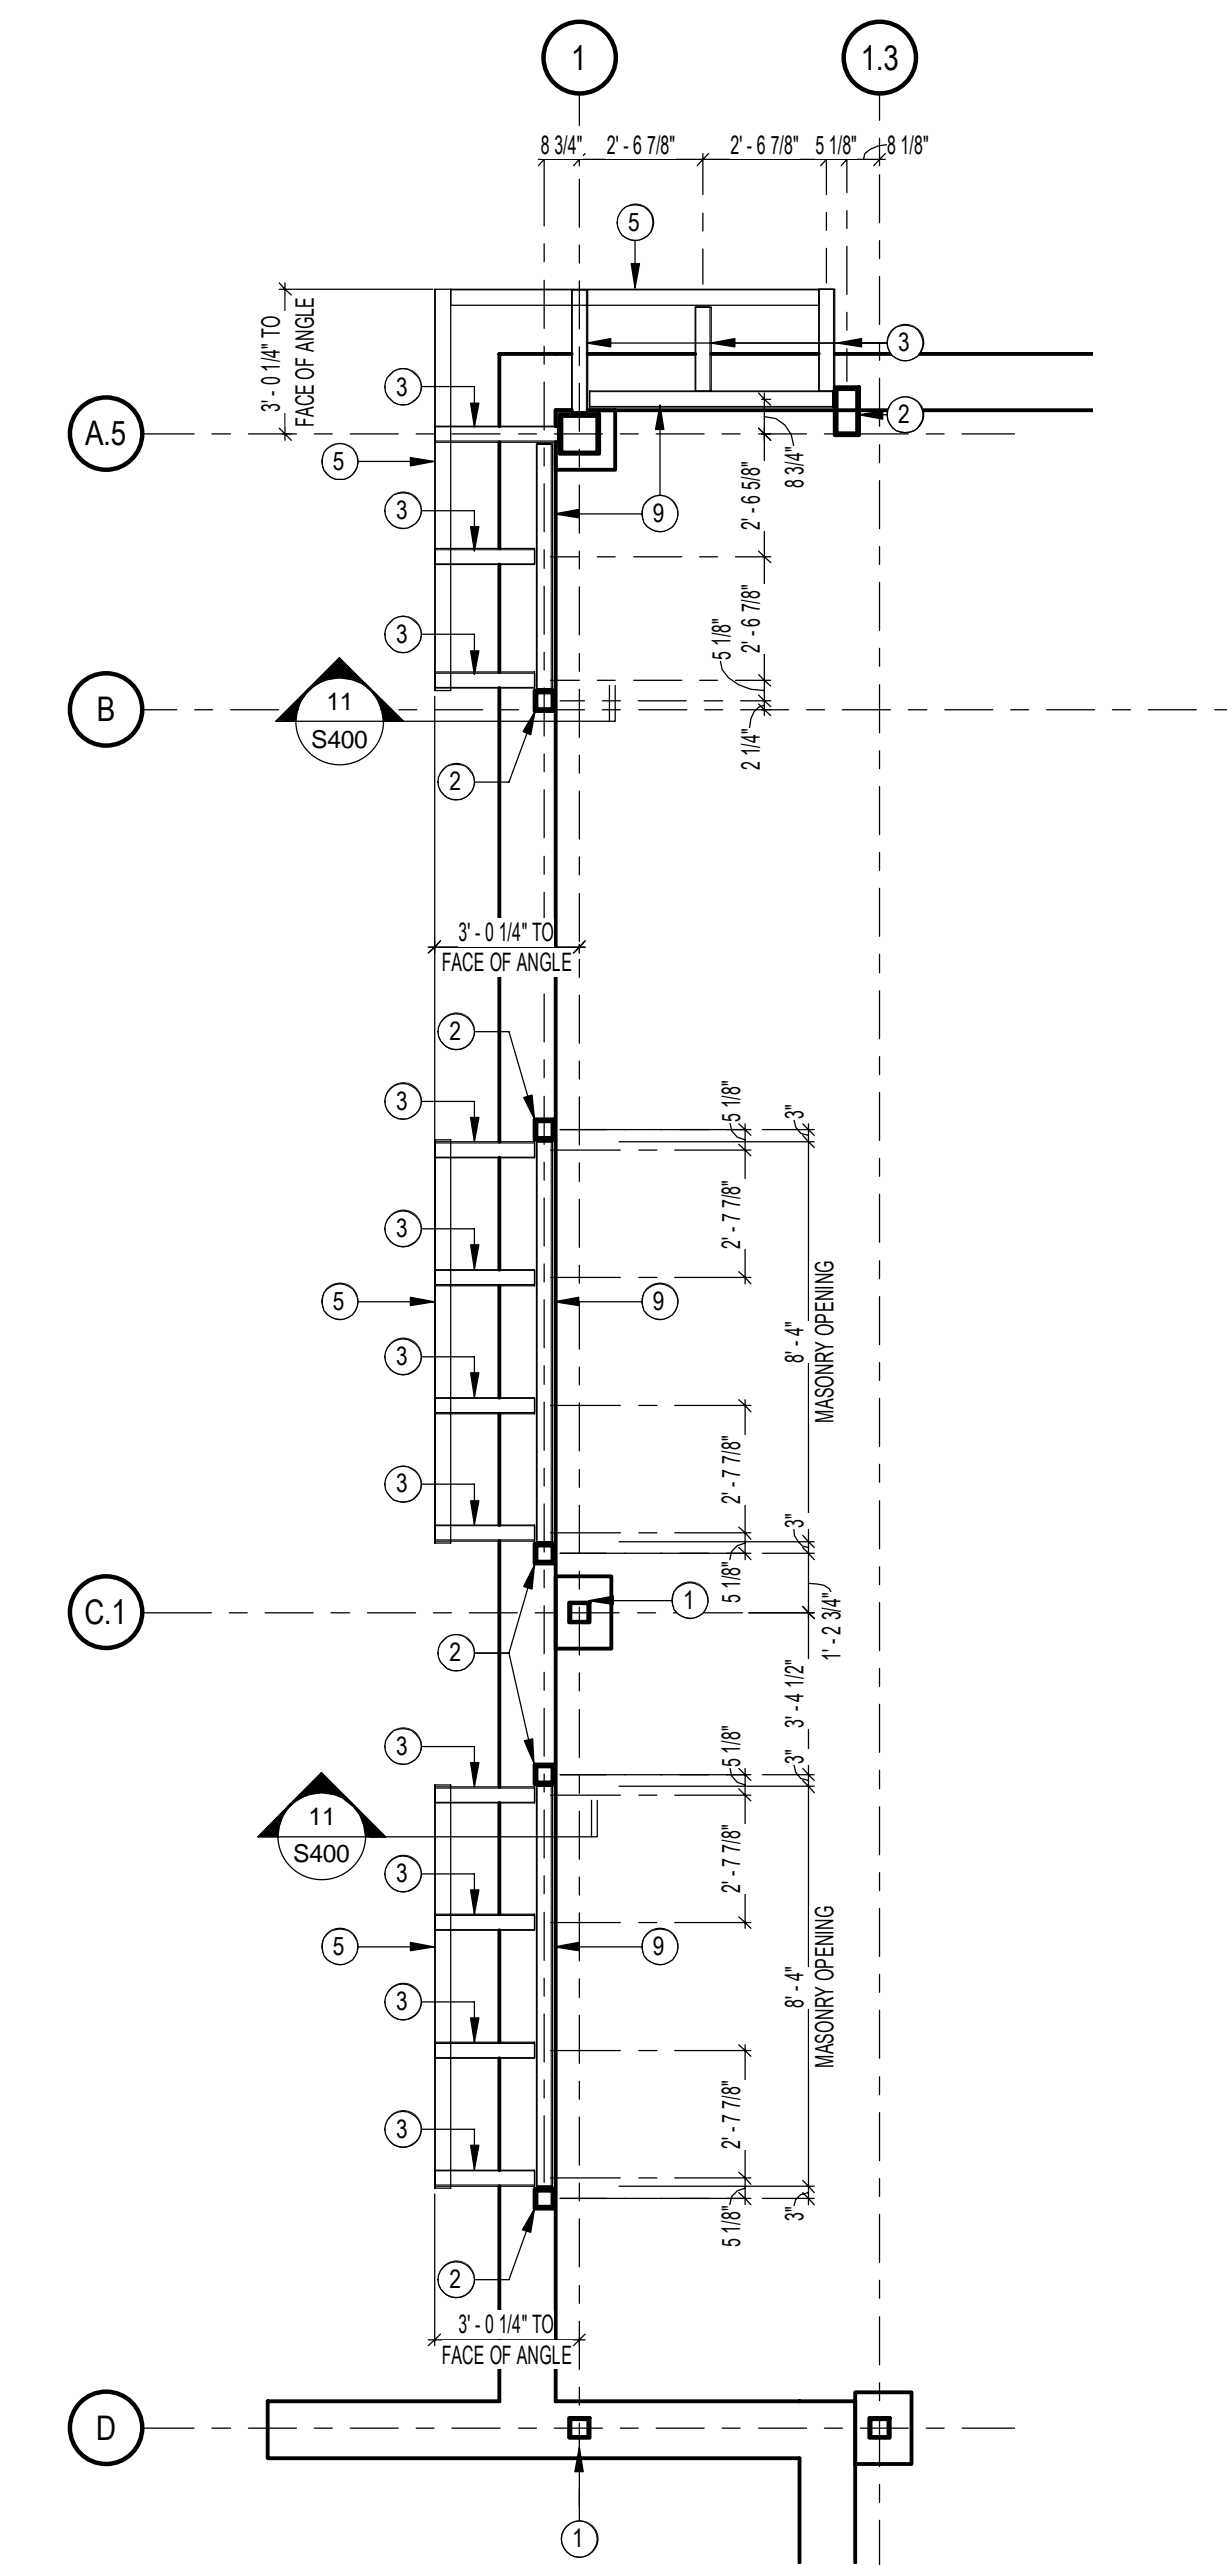

4 WINDOW LEVEL FRAMING (LOW)  
SCALE: 1/4" = 1'-0"

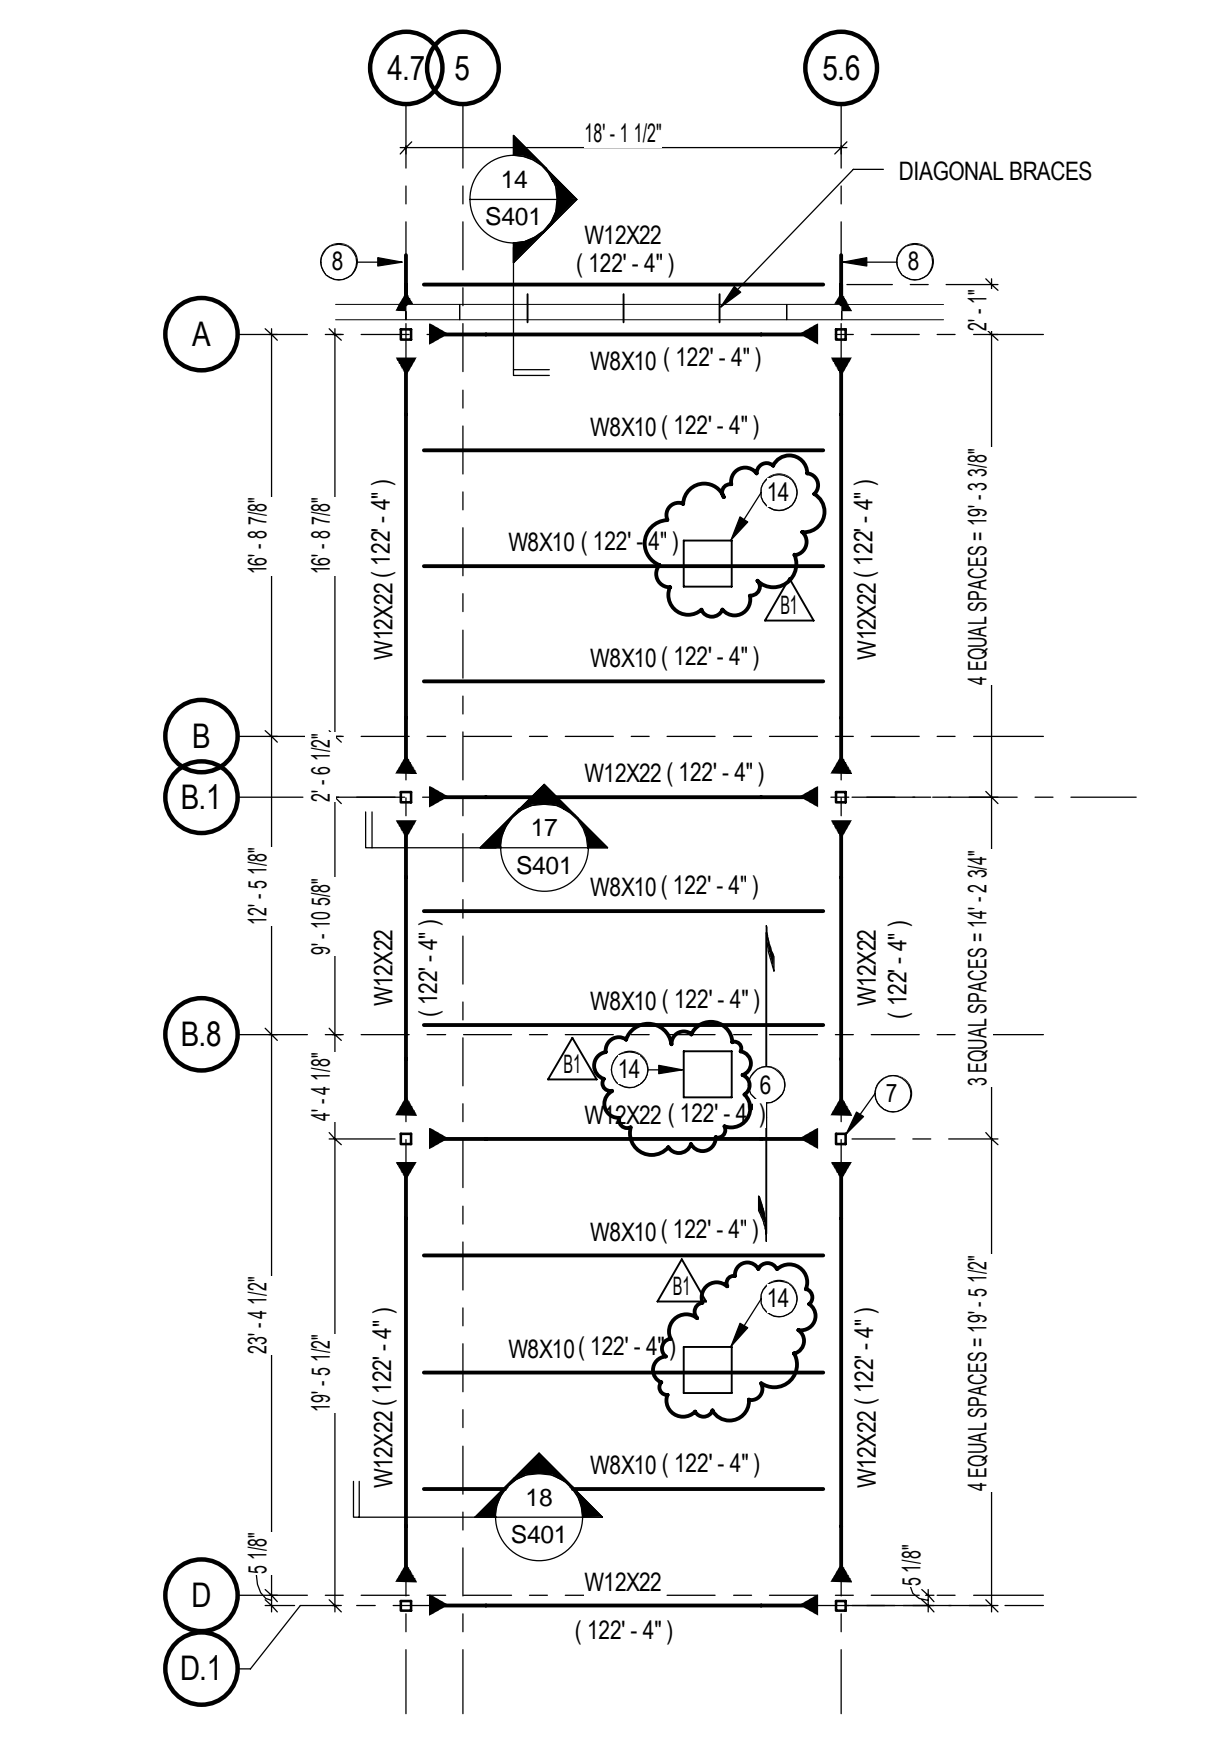

2 LIGHT MONITOR ROOF FRAMING PLAN  
SCALE: 1/8" = 1'-0"

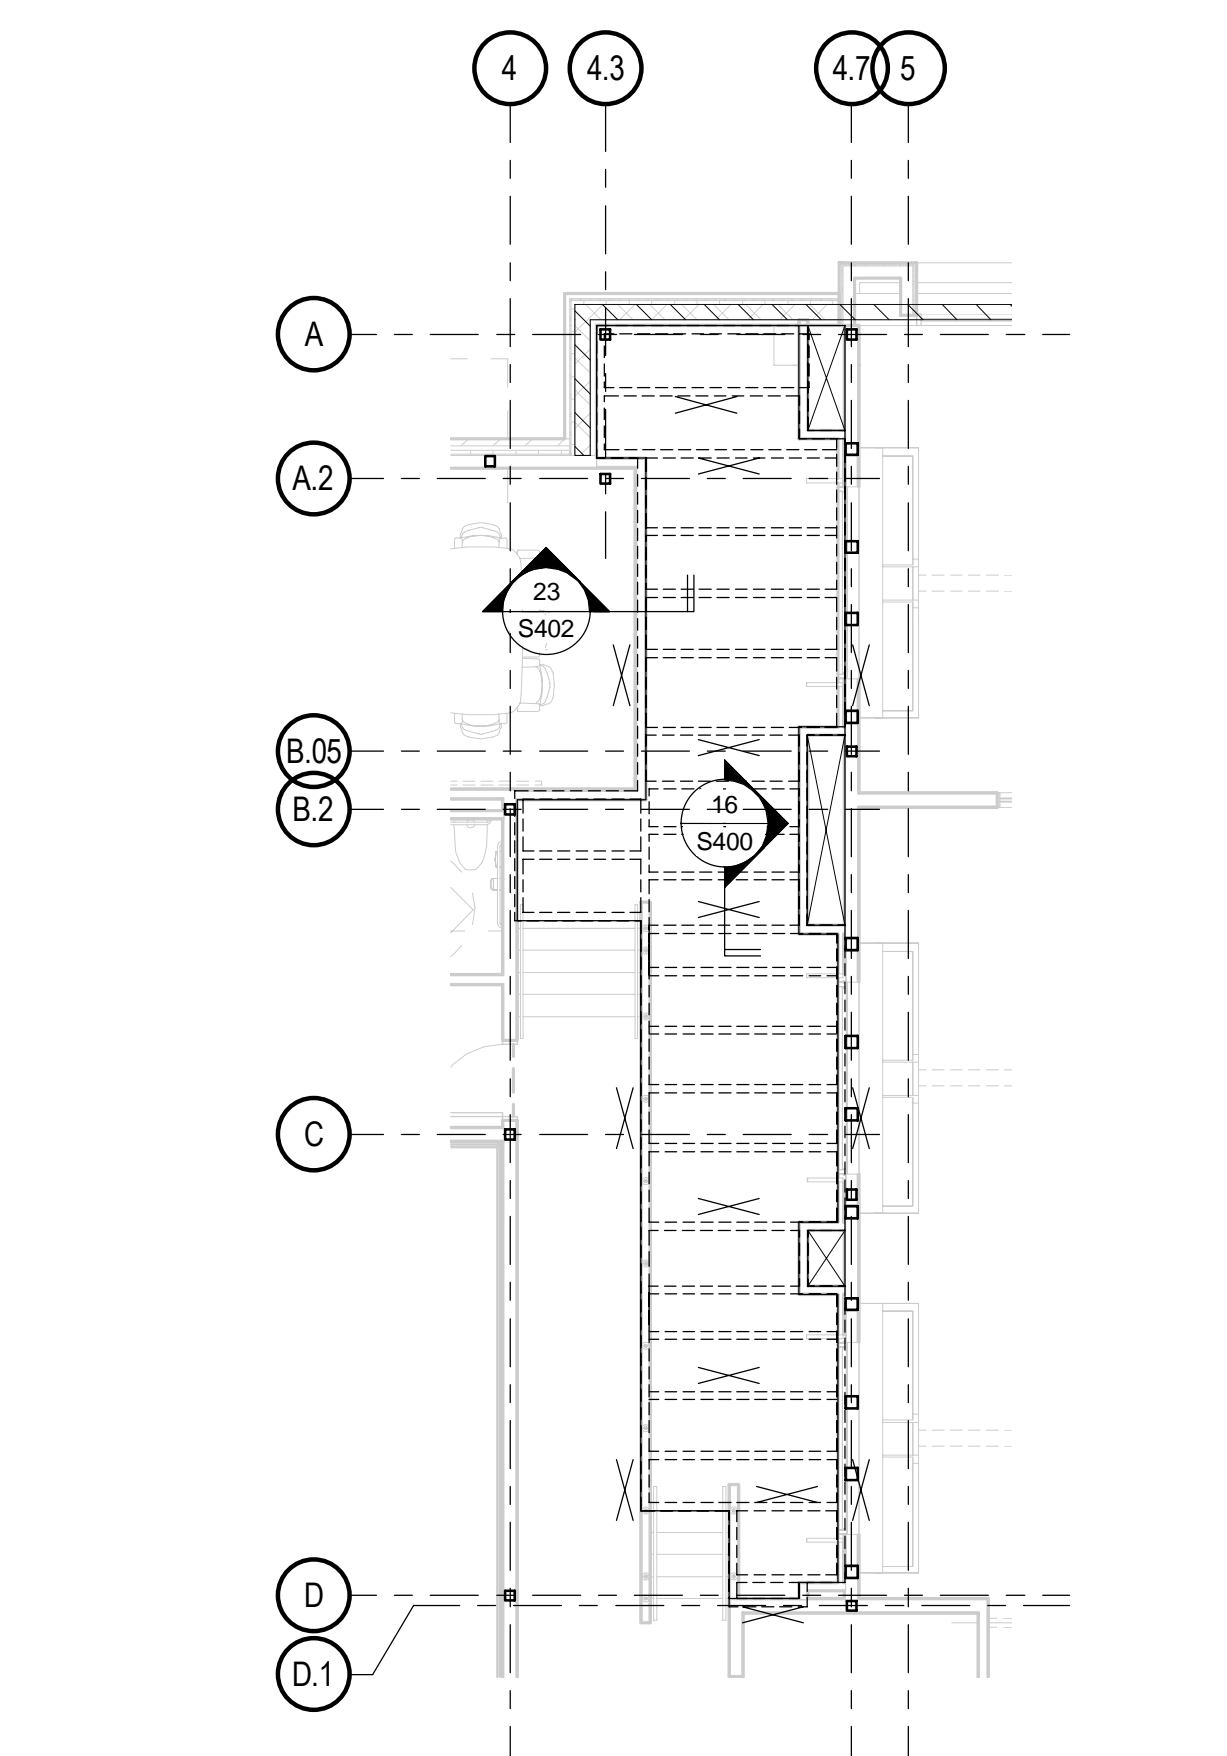

1 VIEWING PLATFORM FRAMING PLAN  
SCALE: 1/8" = 1'-0"





























PIECE ENGINEERS INC.  
PE PROJECT 136-42


















PROJECT  
MEDICAL EXAMINER OFFICE  
BUILDING (BID PACKAGE B)  
3562 COUNTY HIGHWAY AB  
MC FARLAND, WI 53558


BID NO.  
313083

DRAWING  
MISC FRAMING PLANS


DATE  
01.12.15

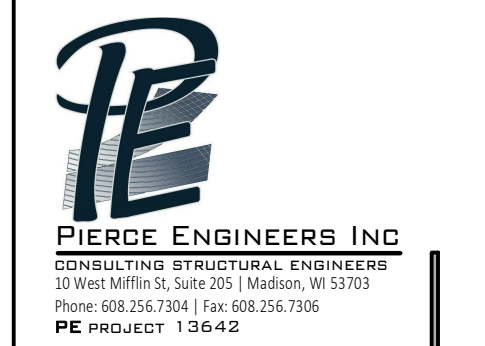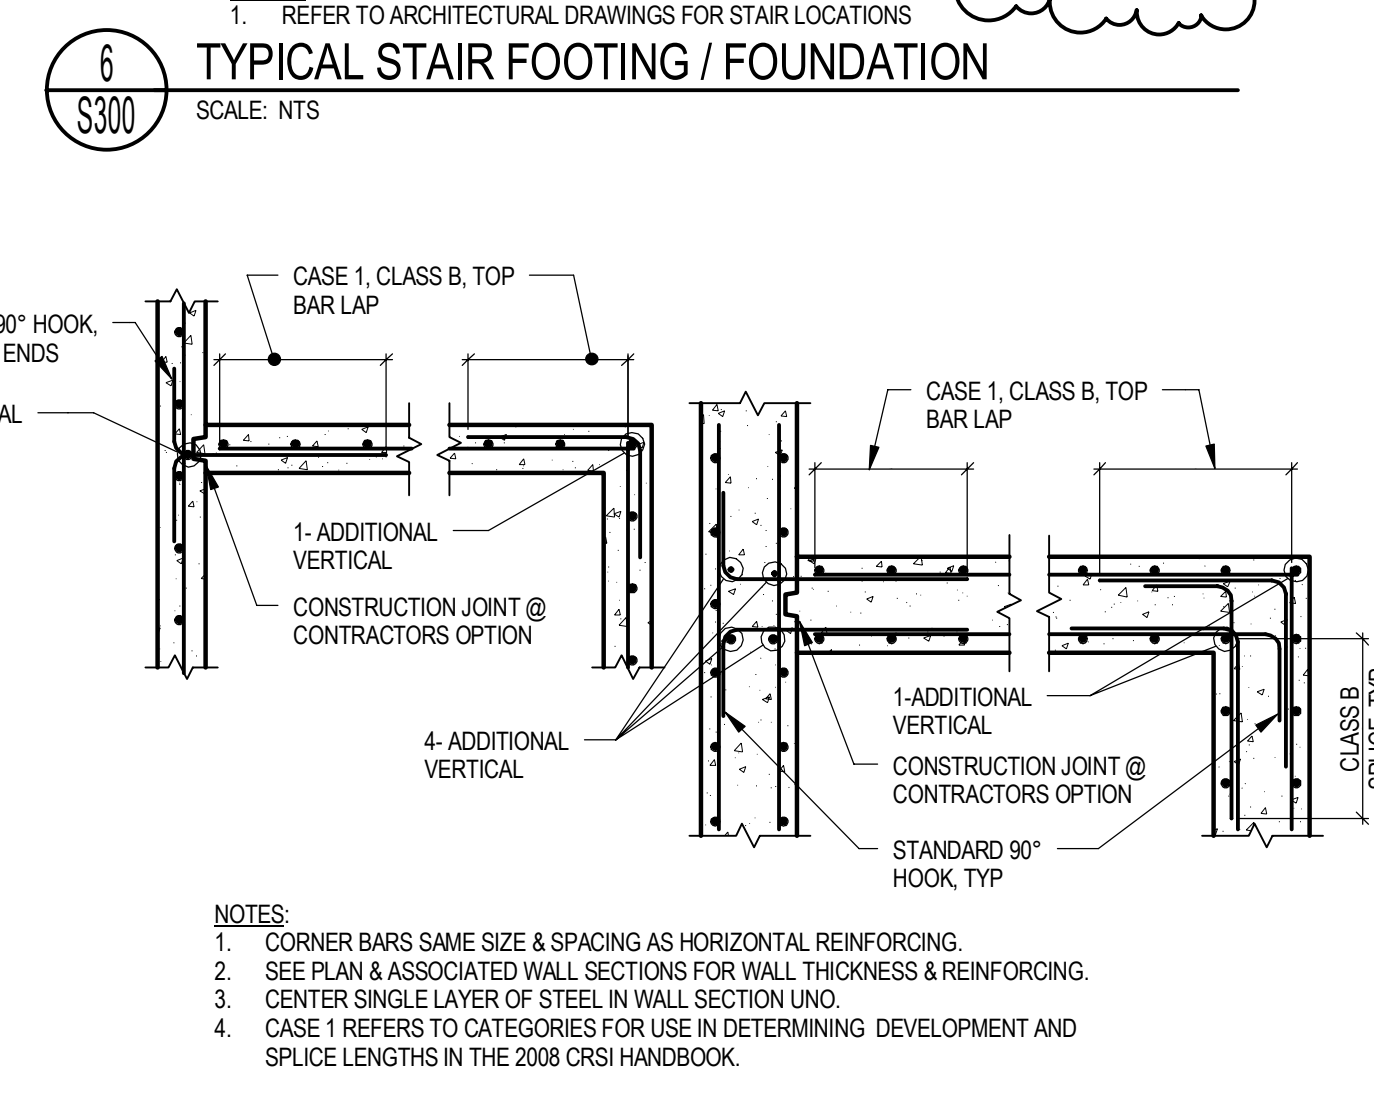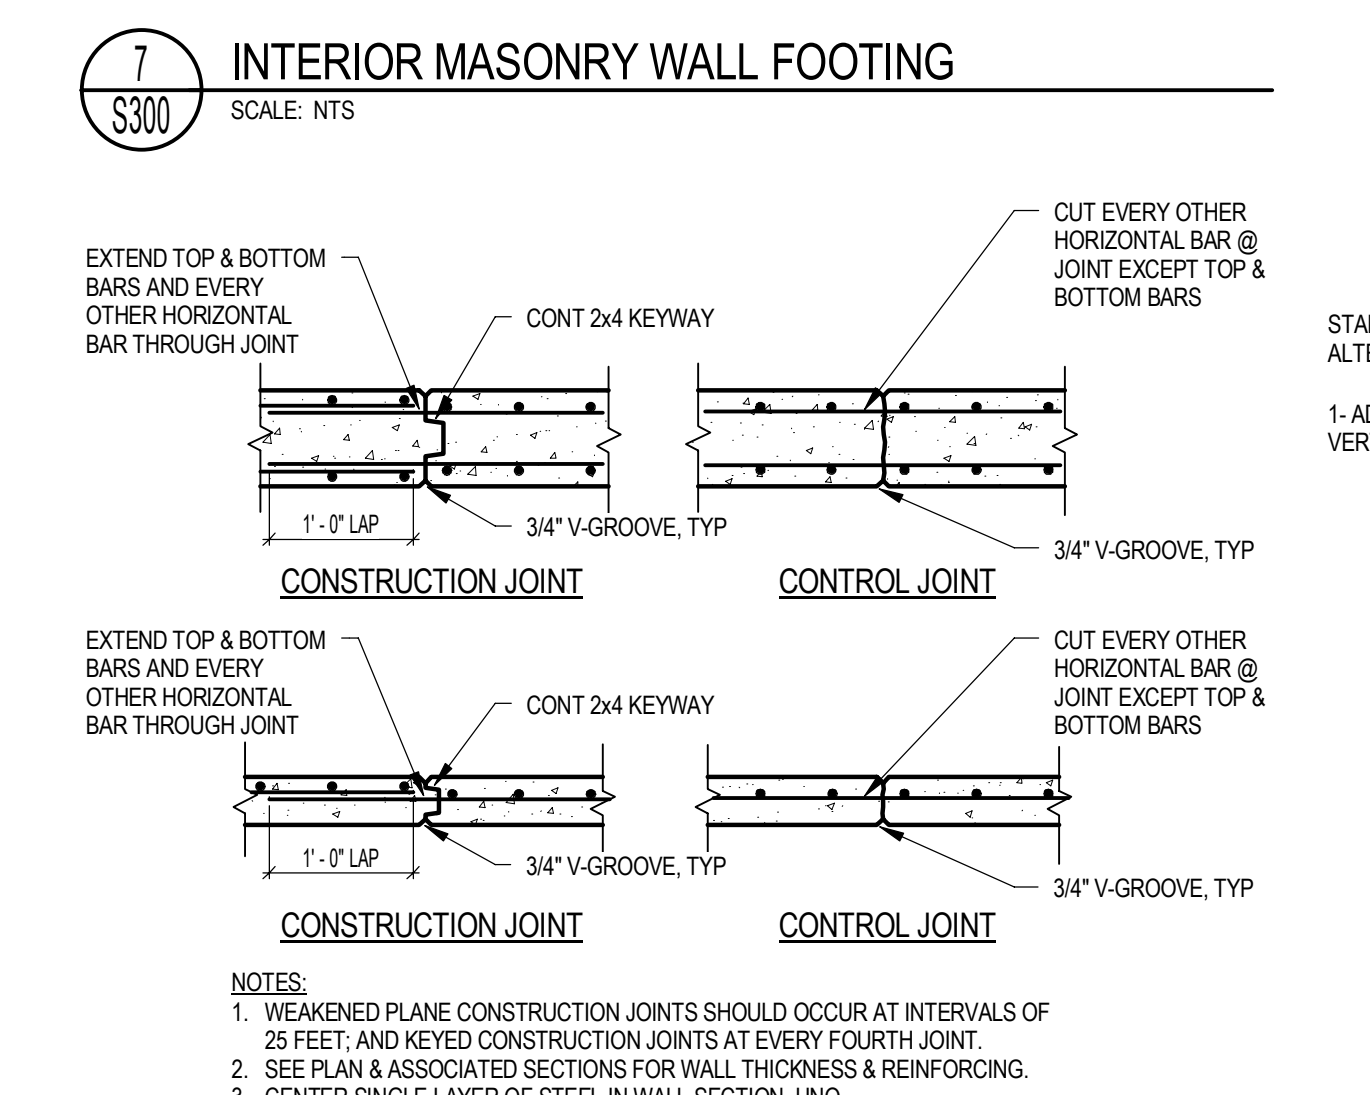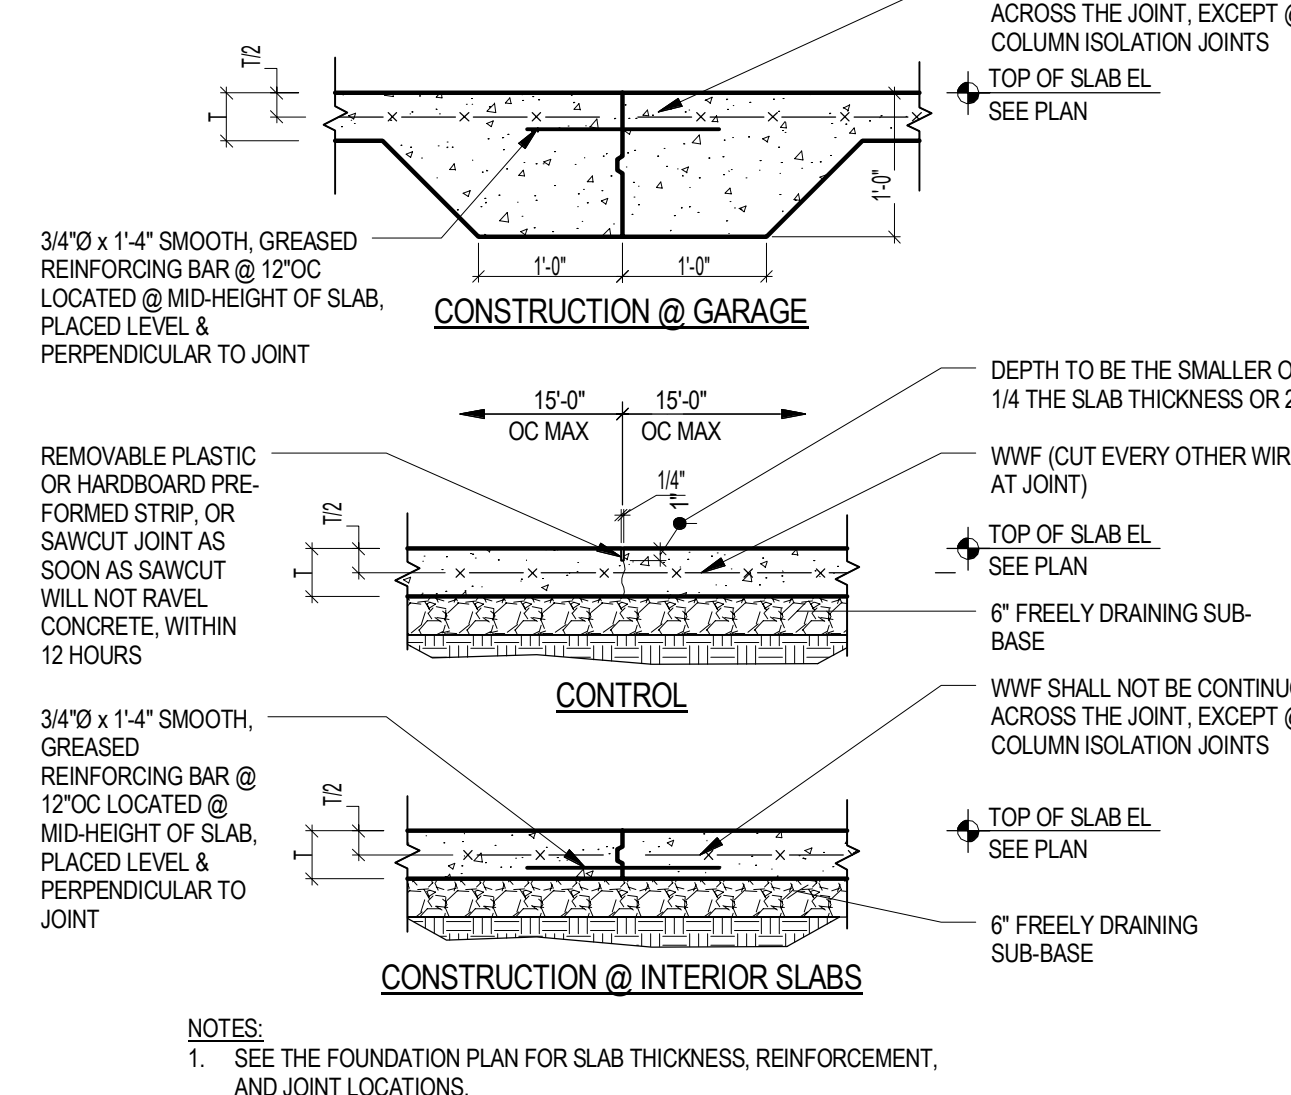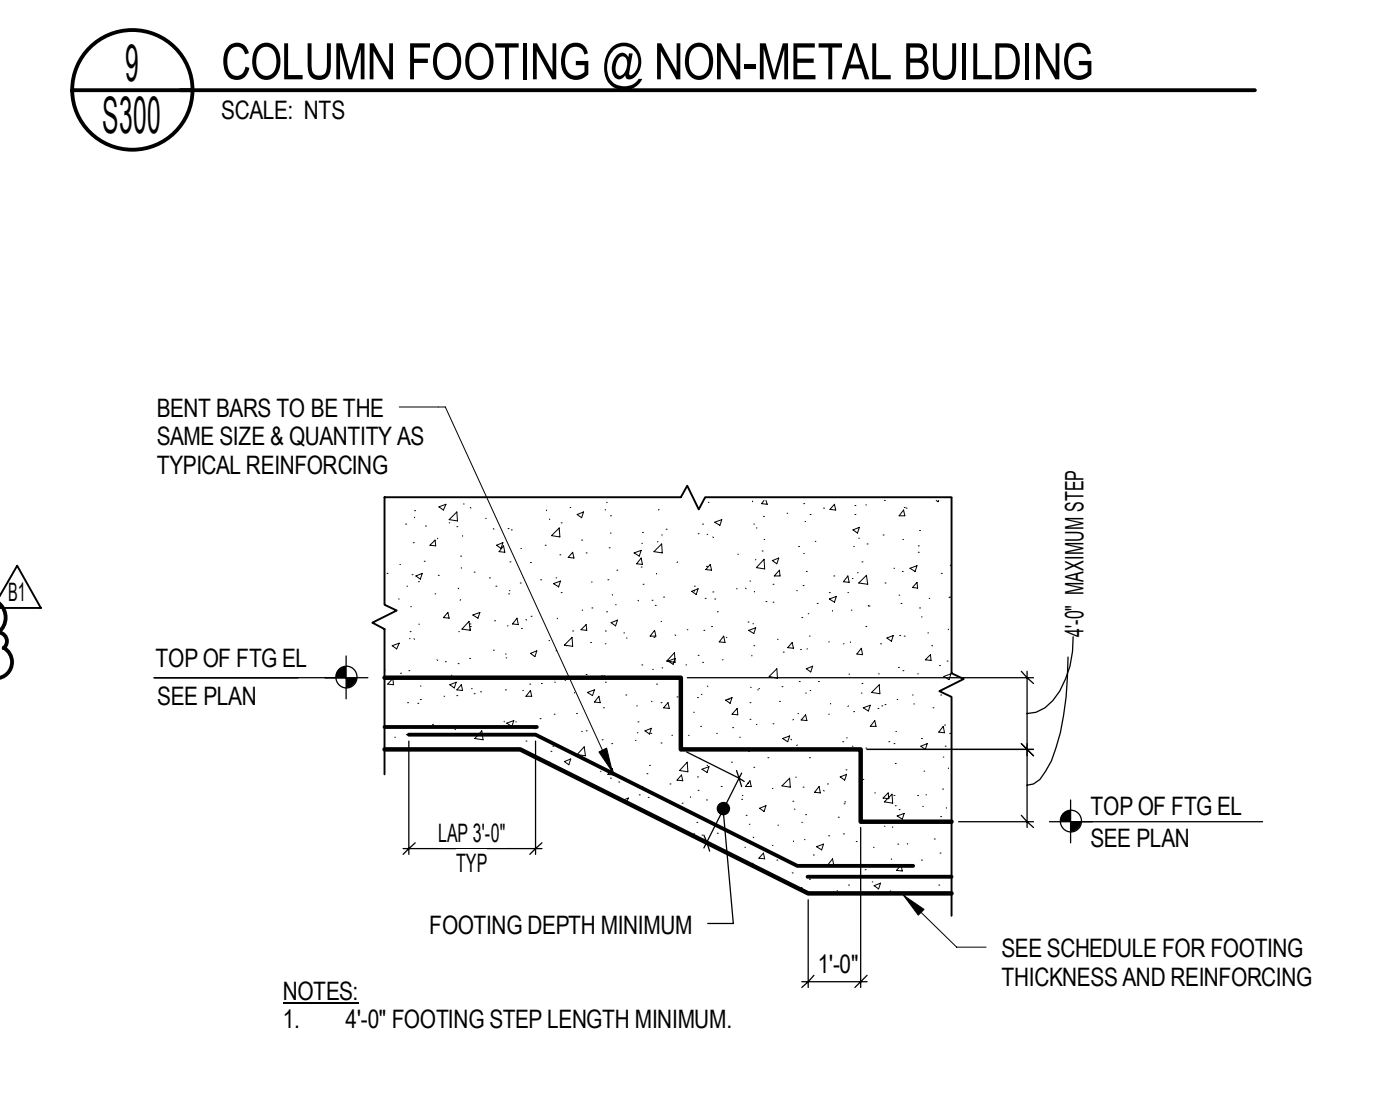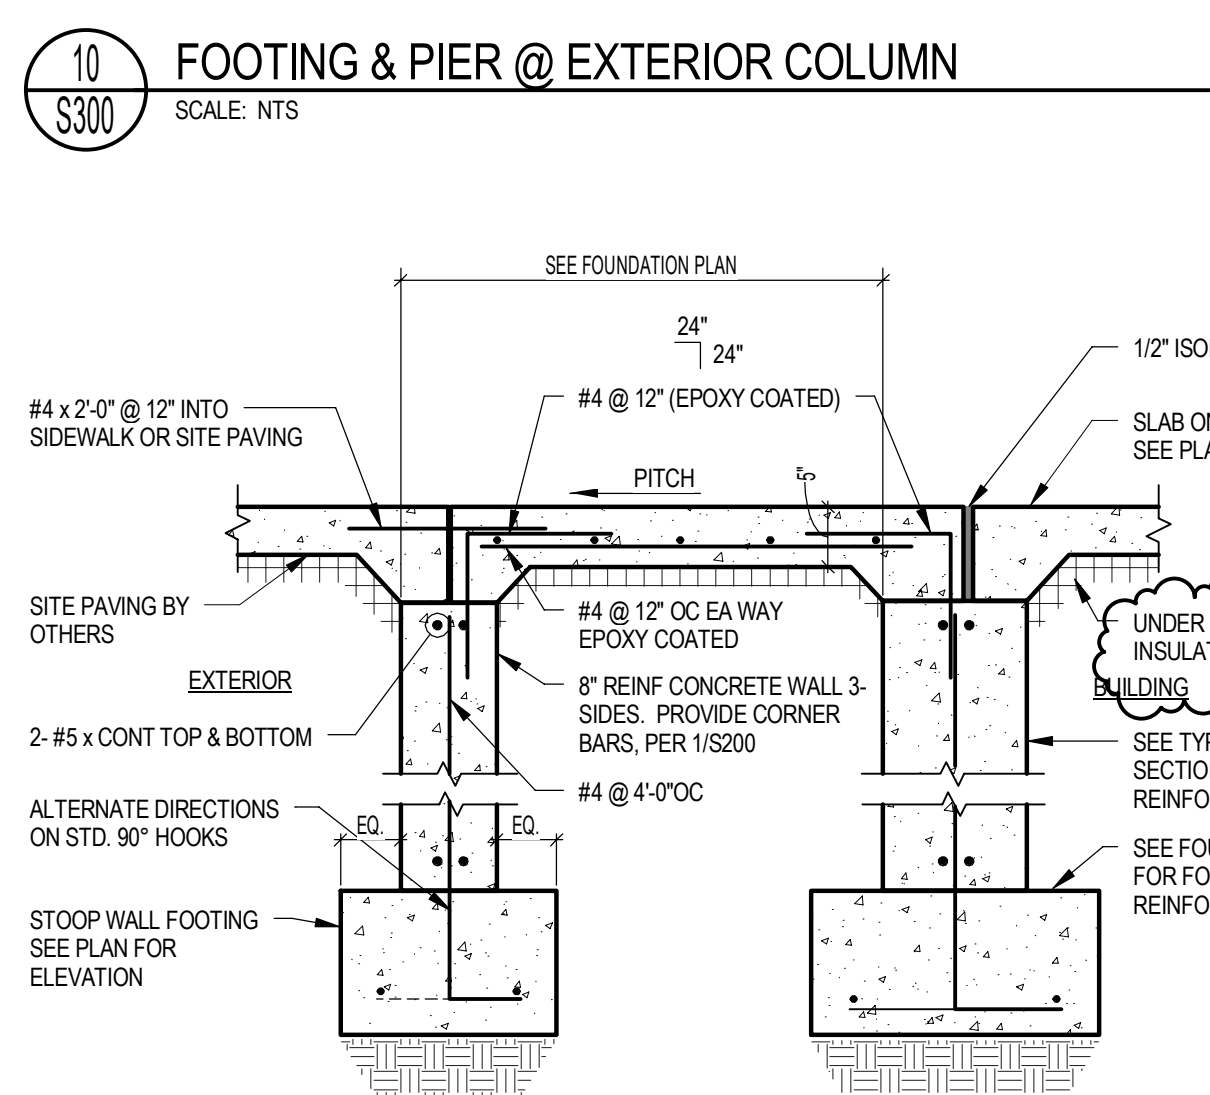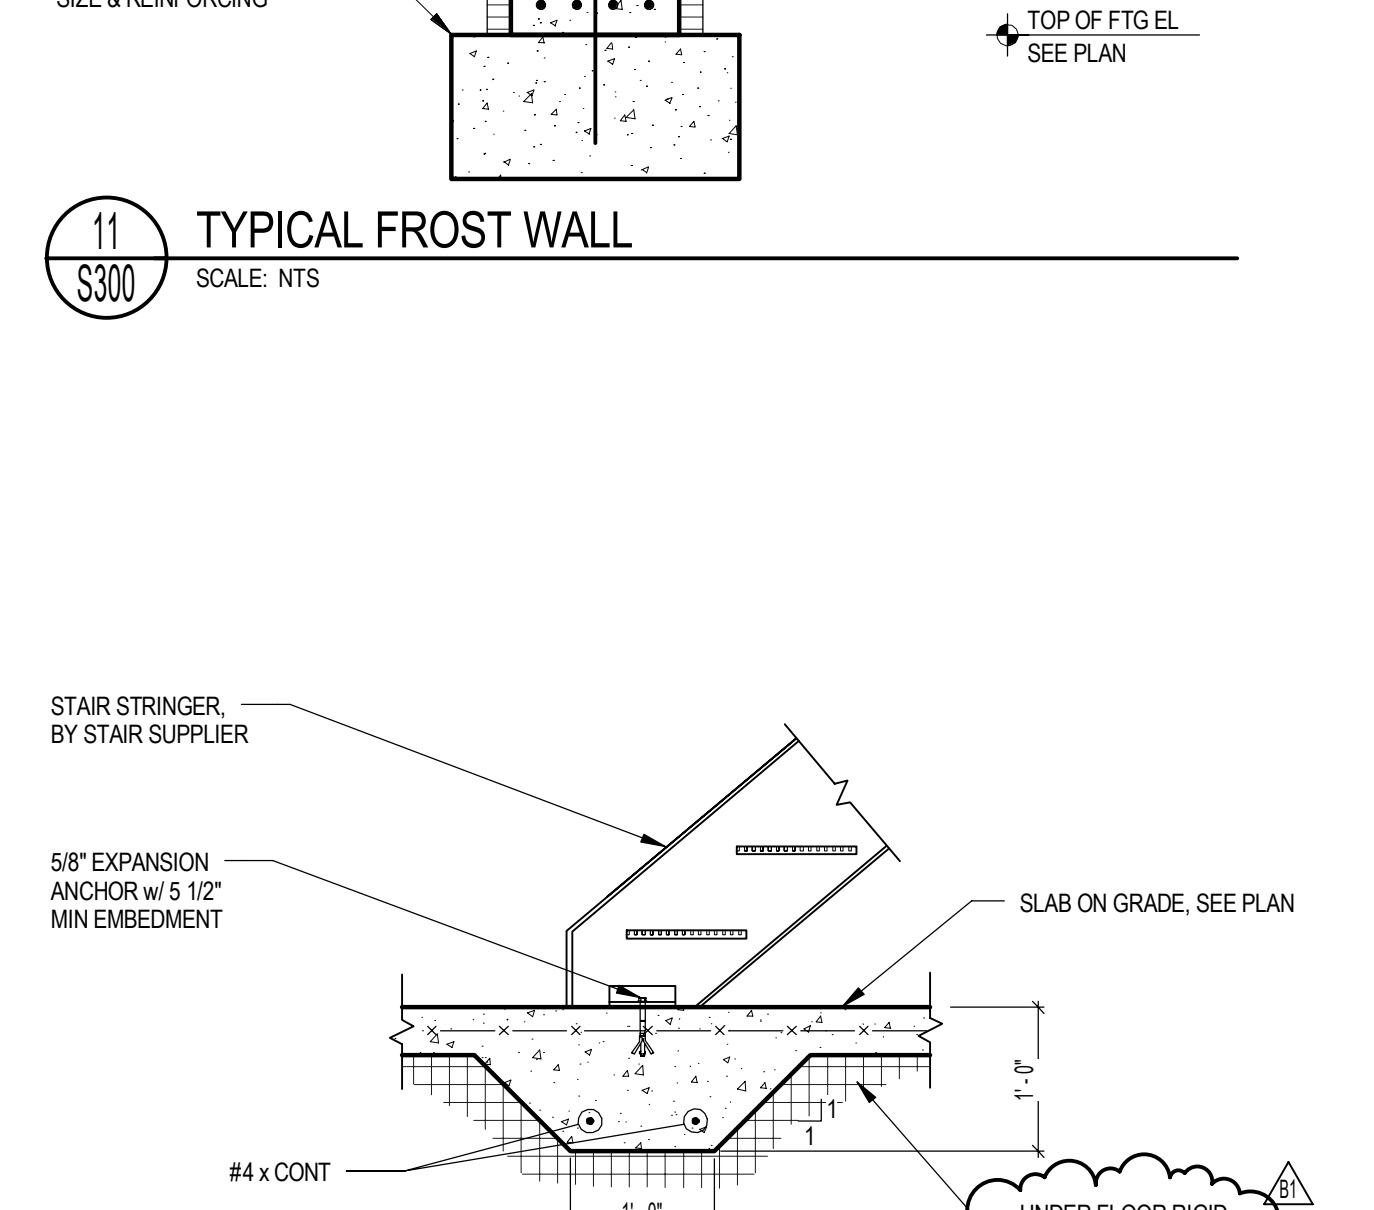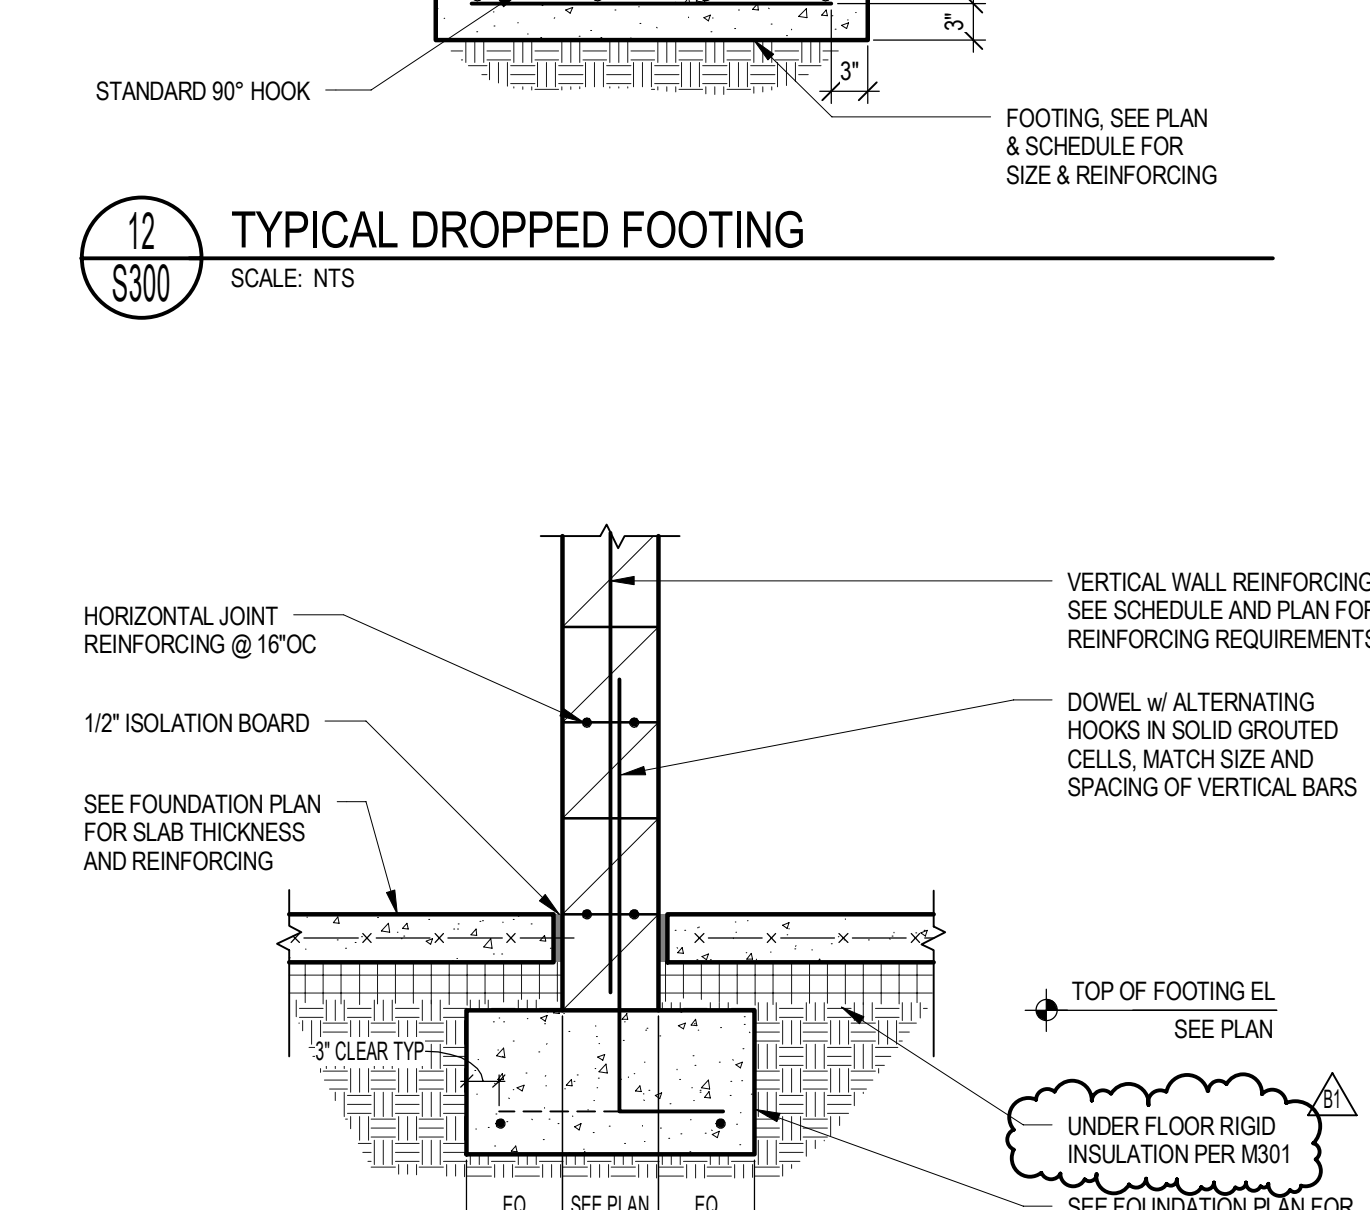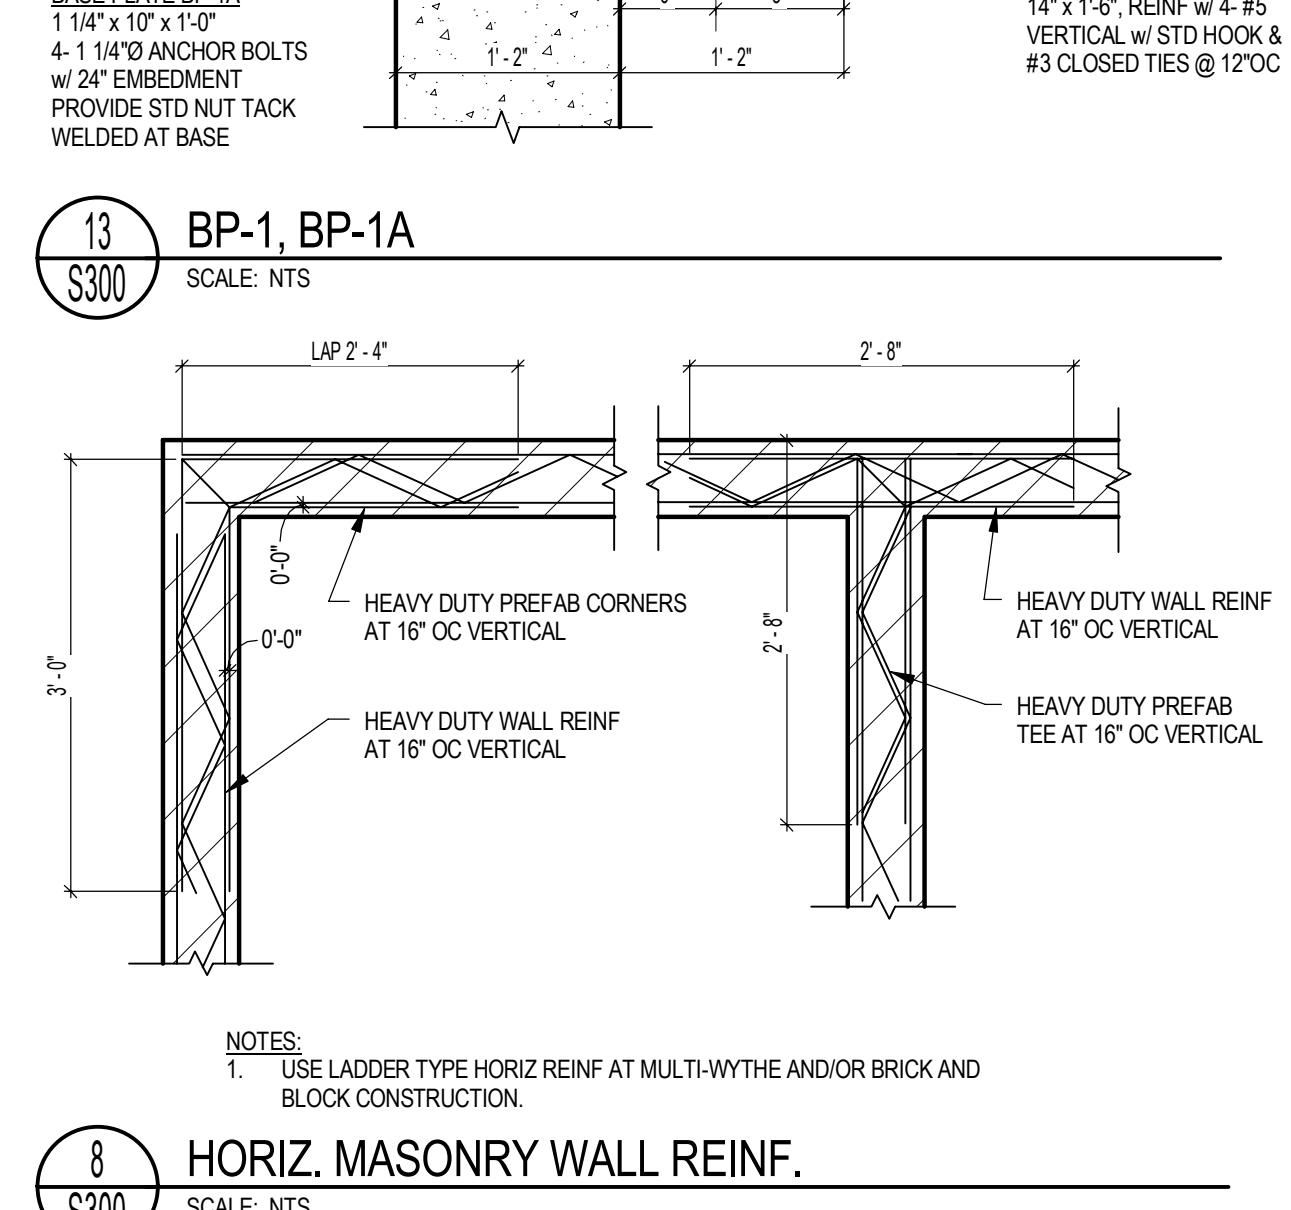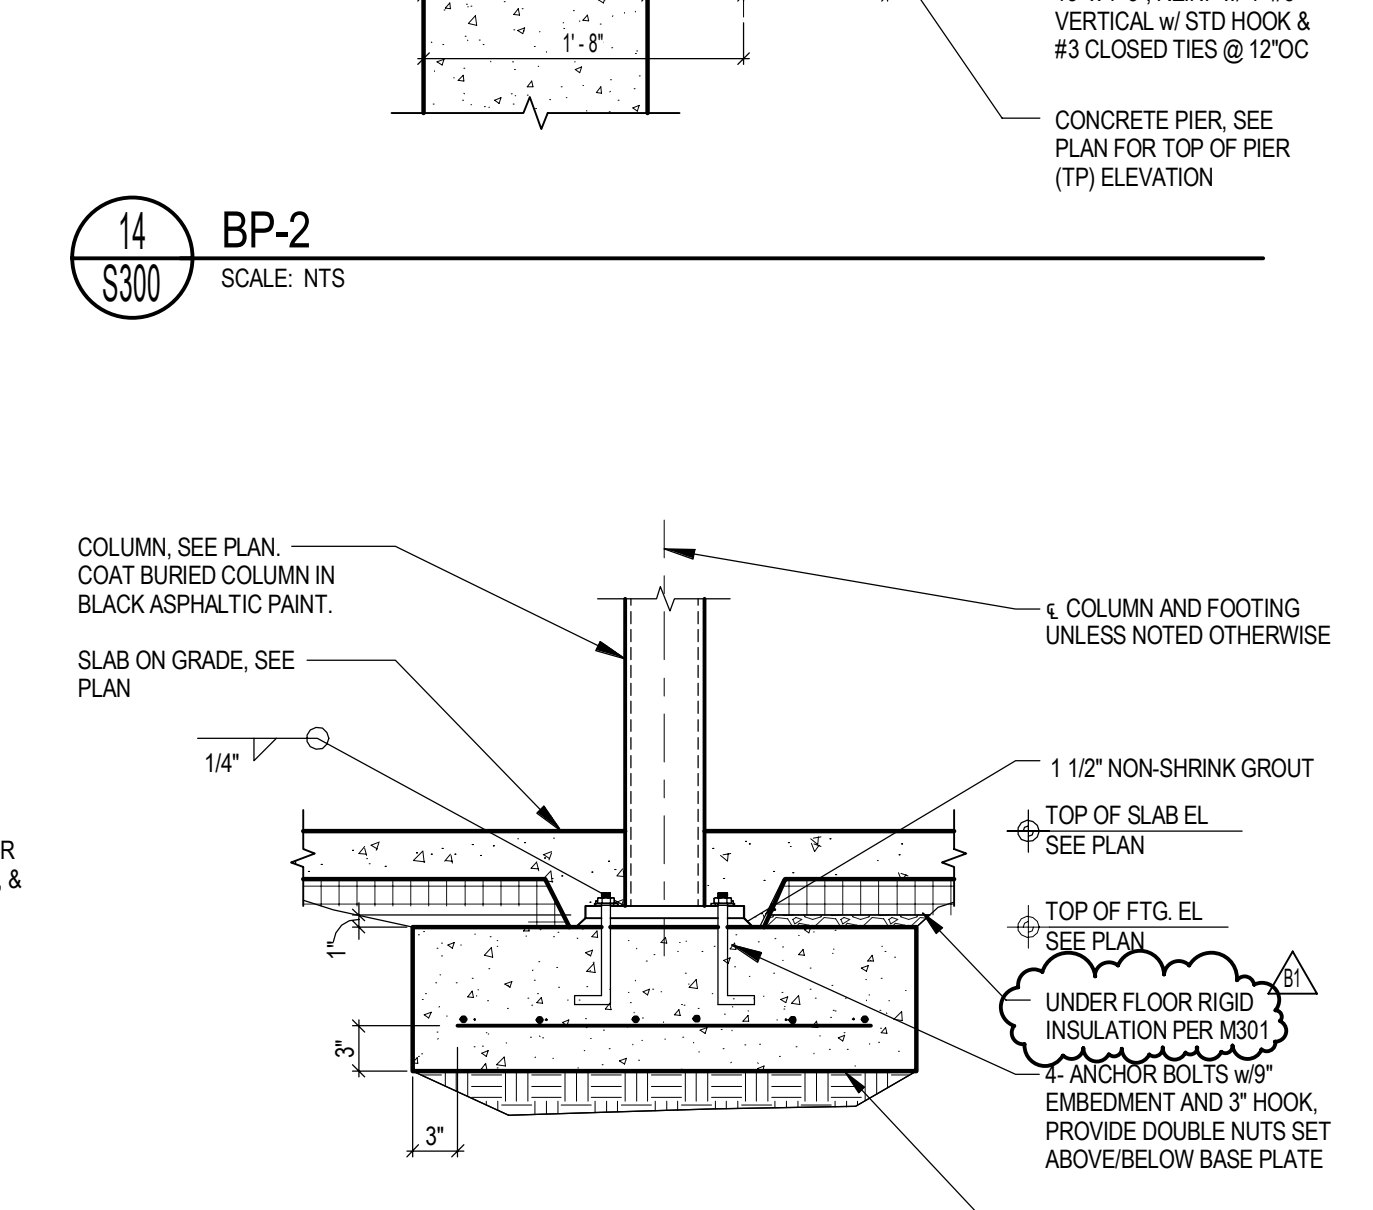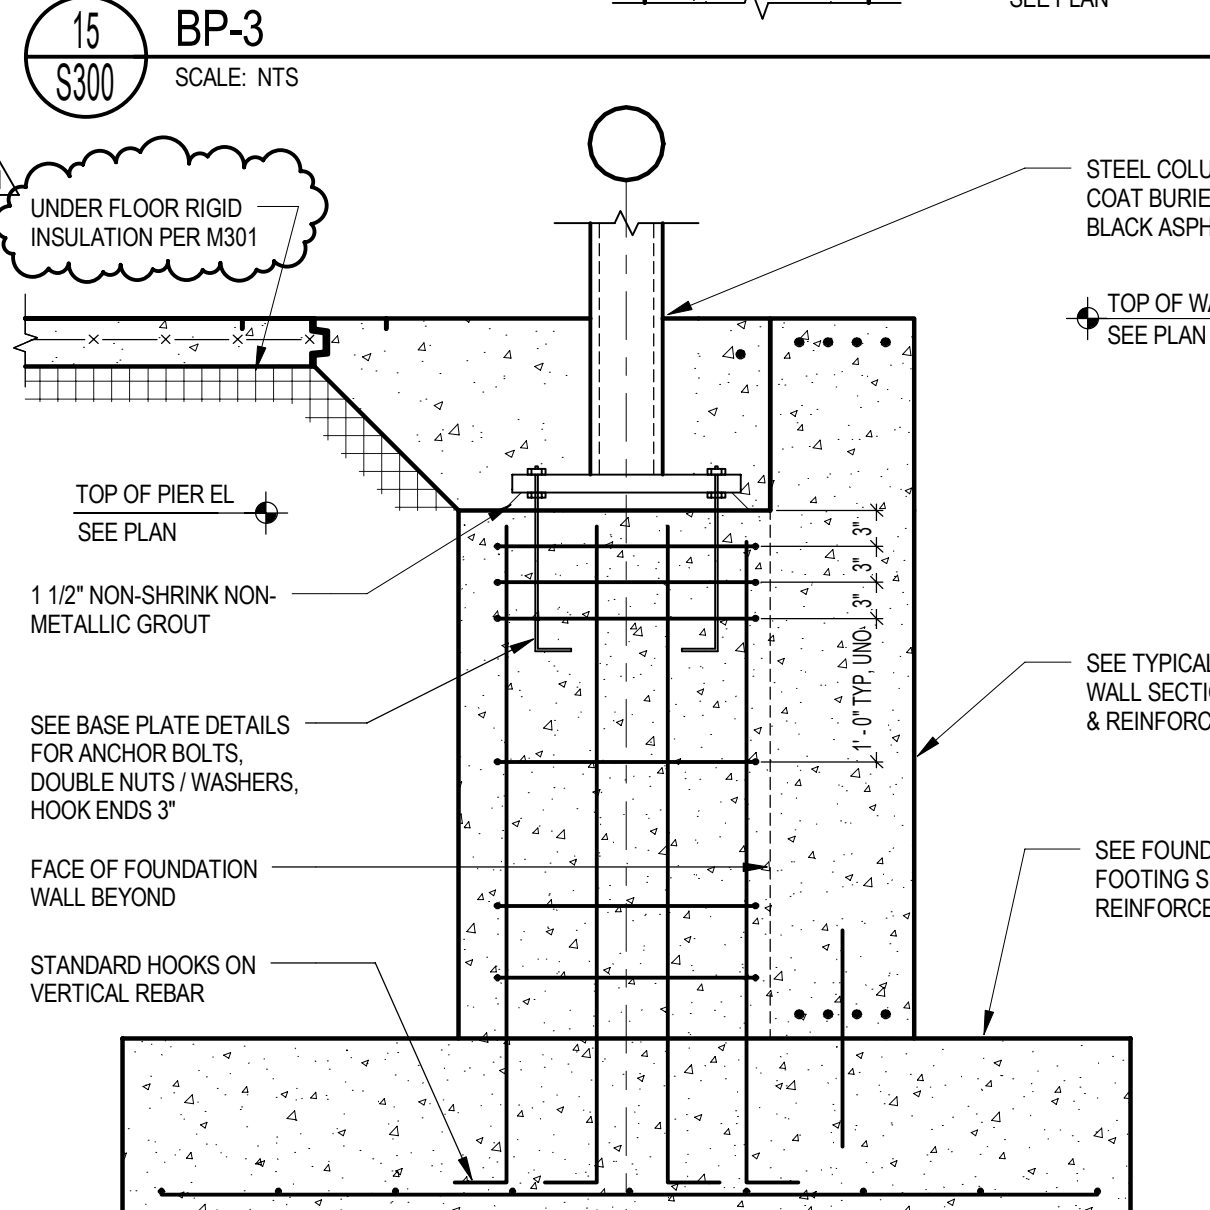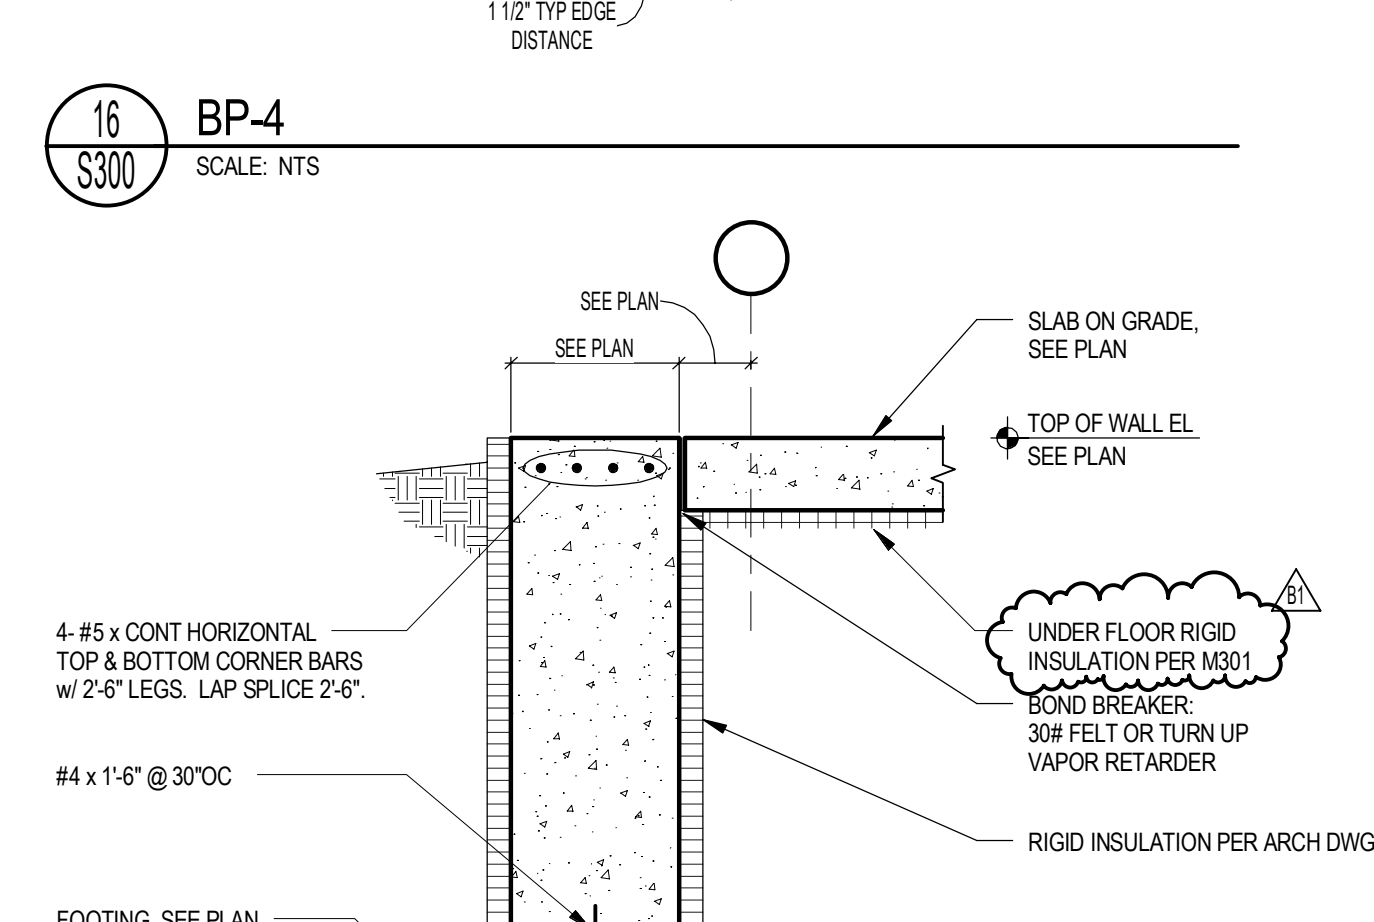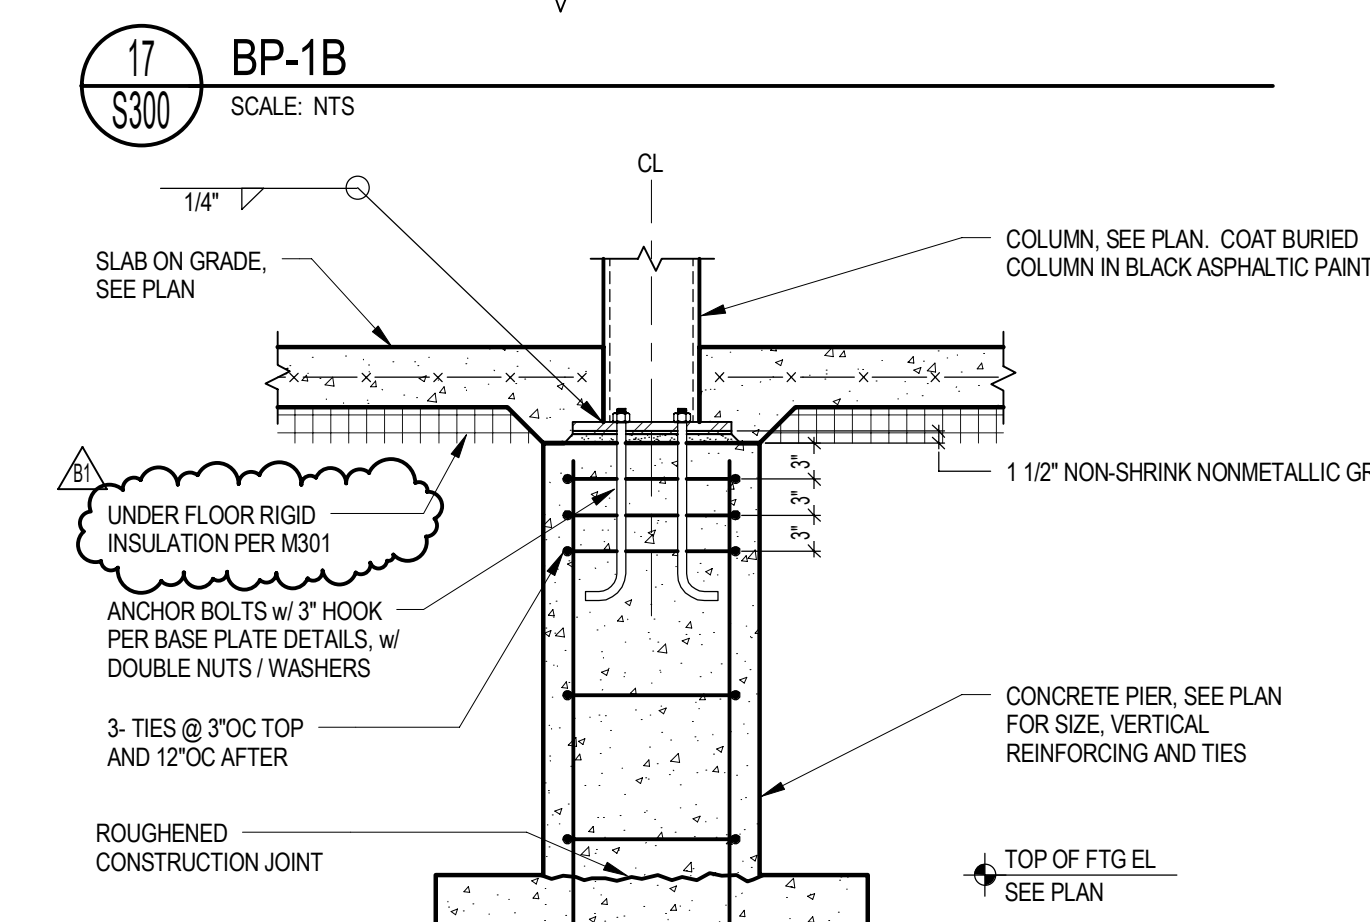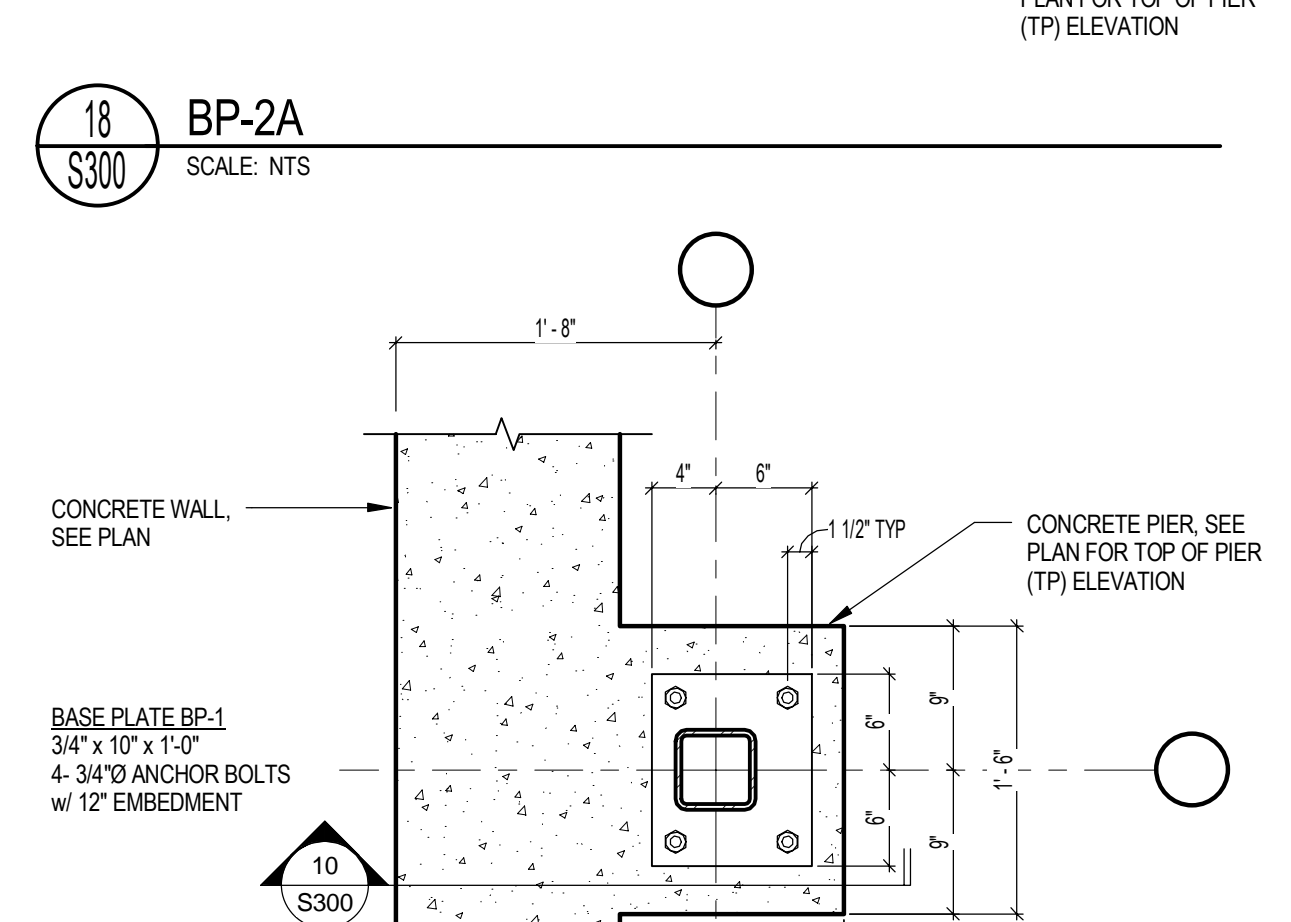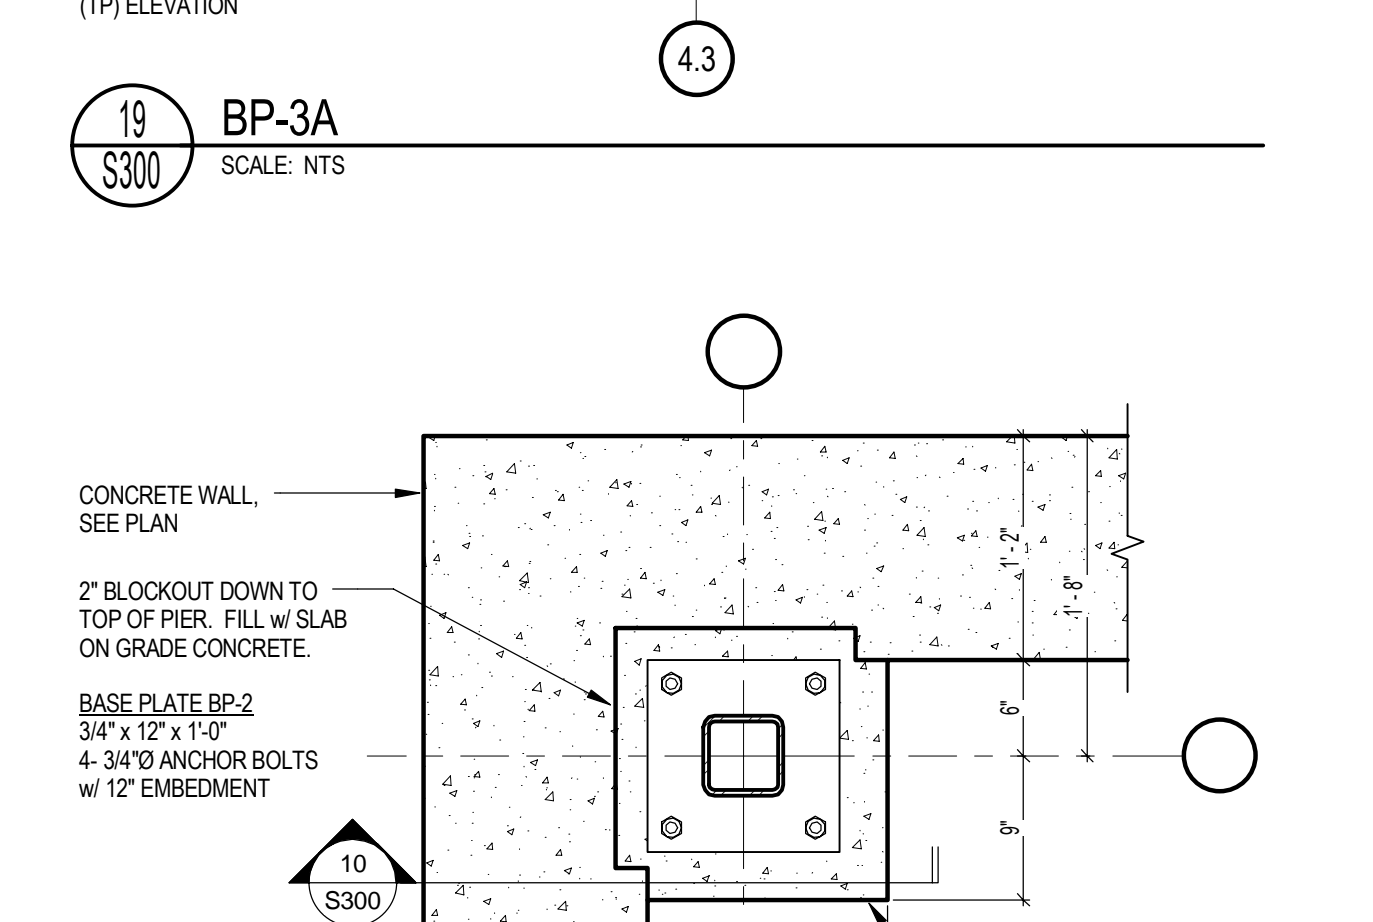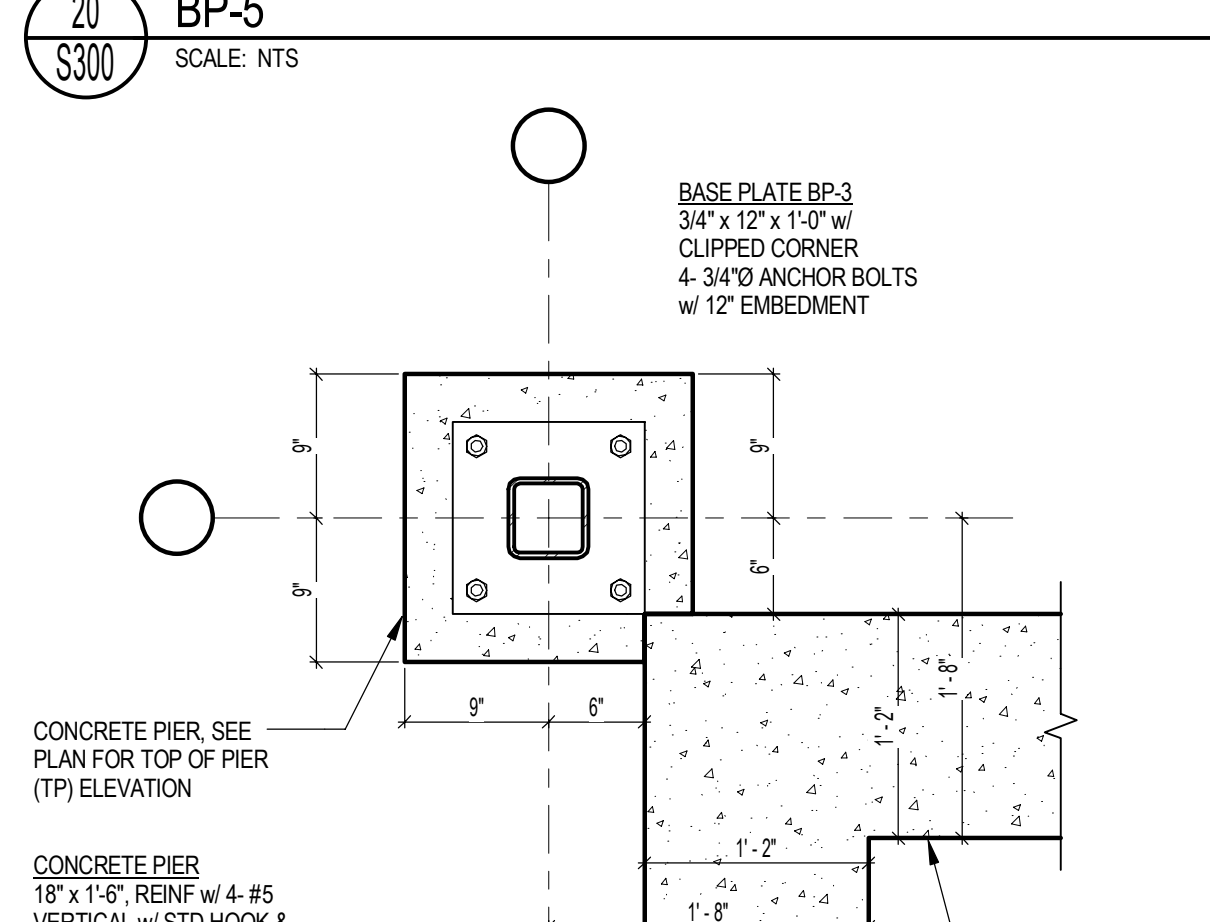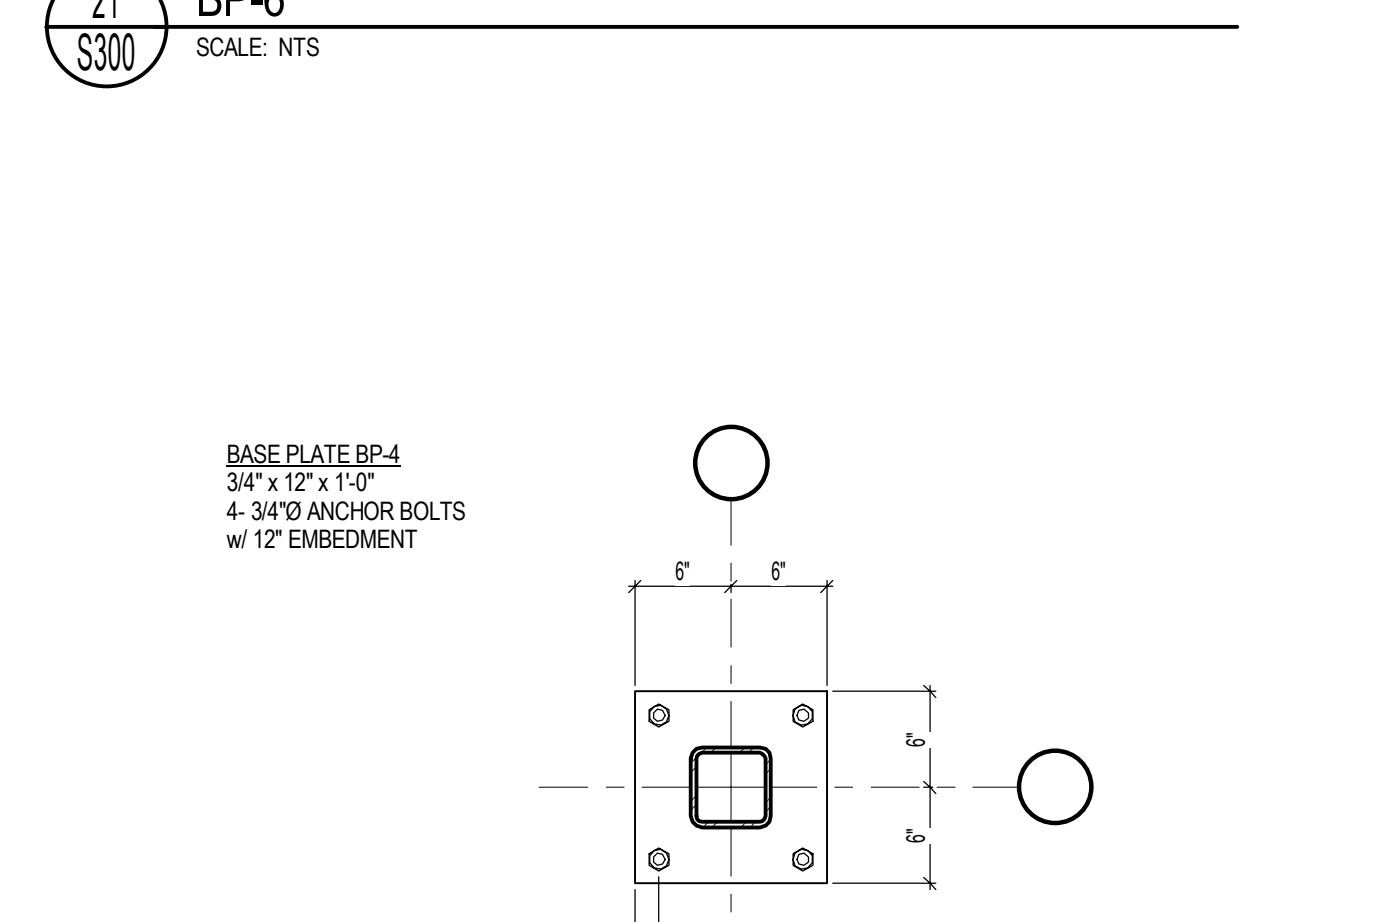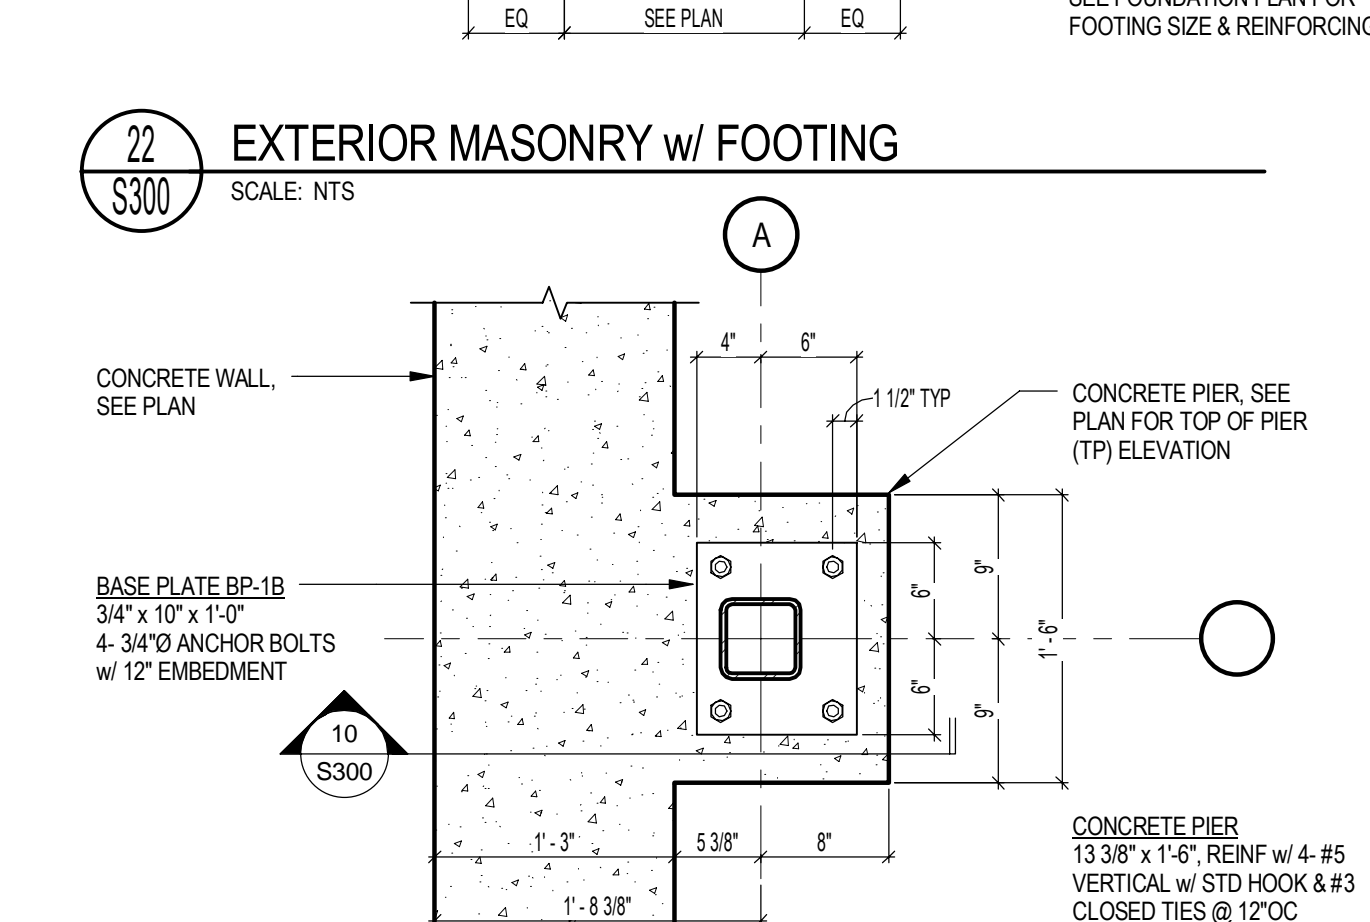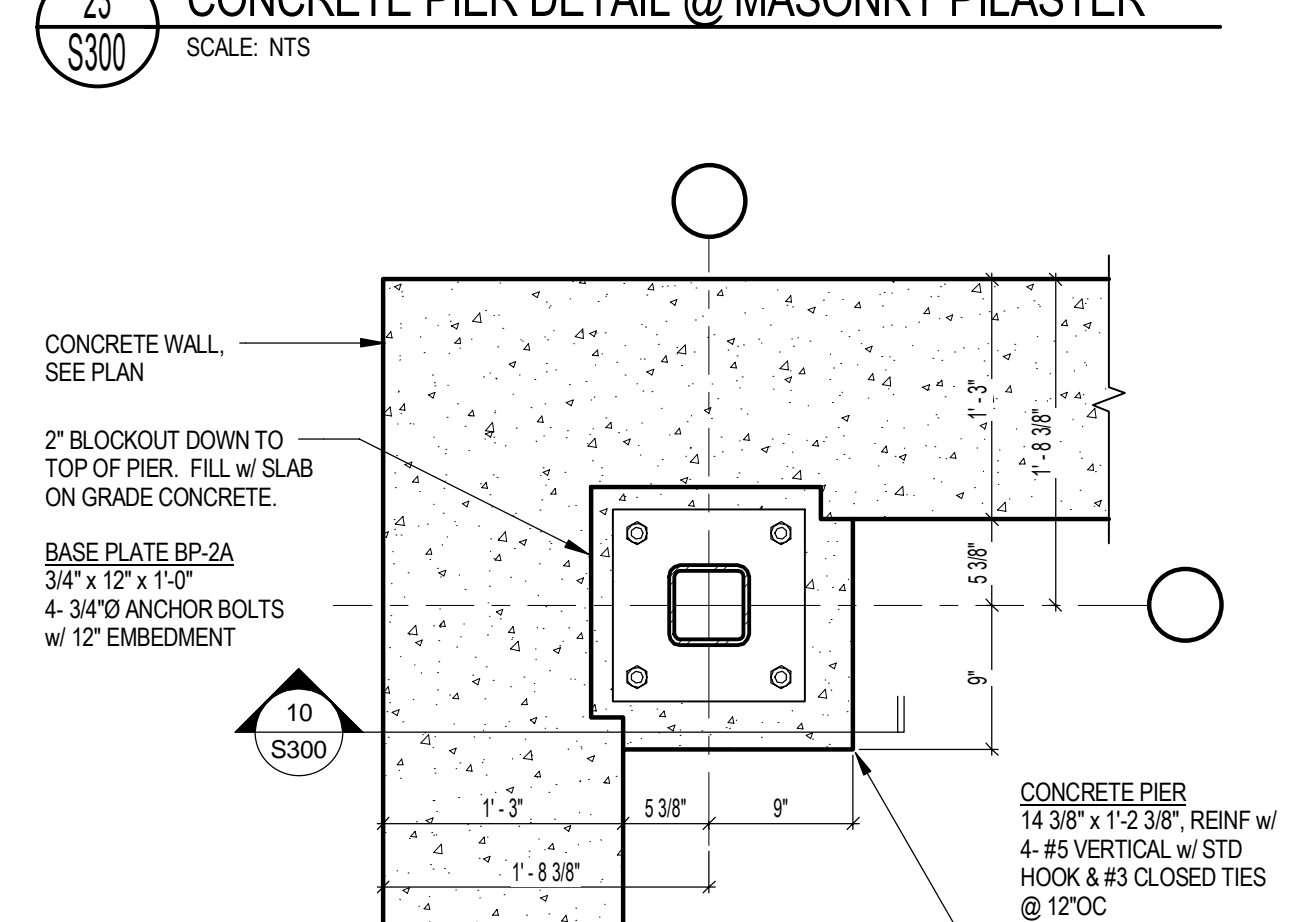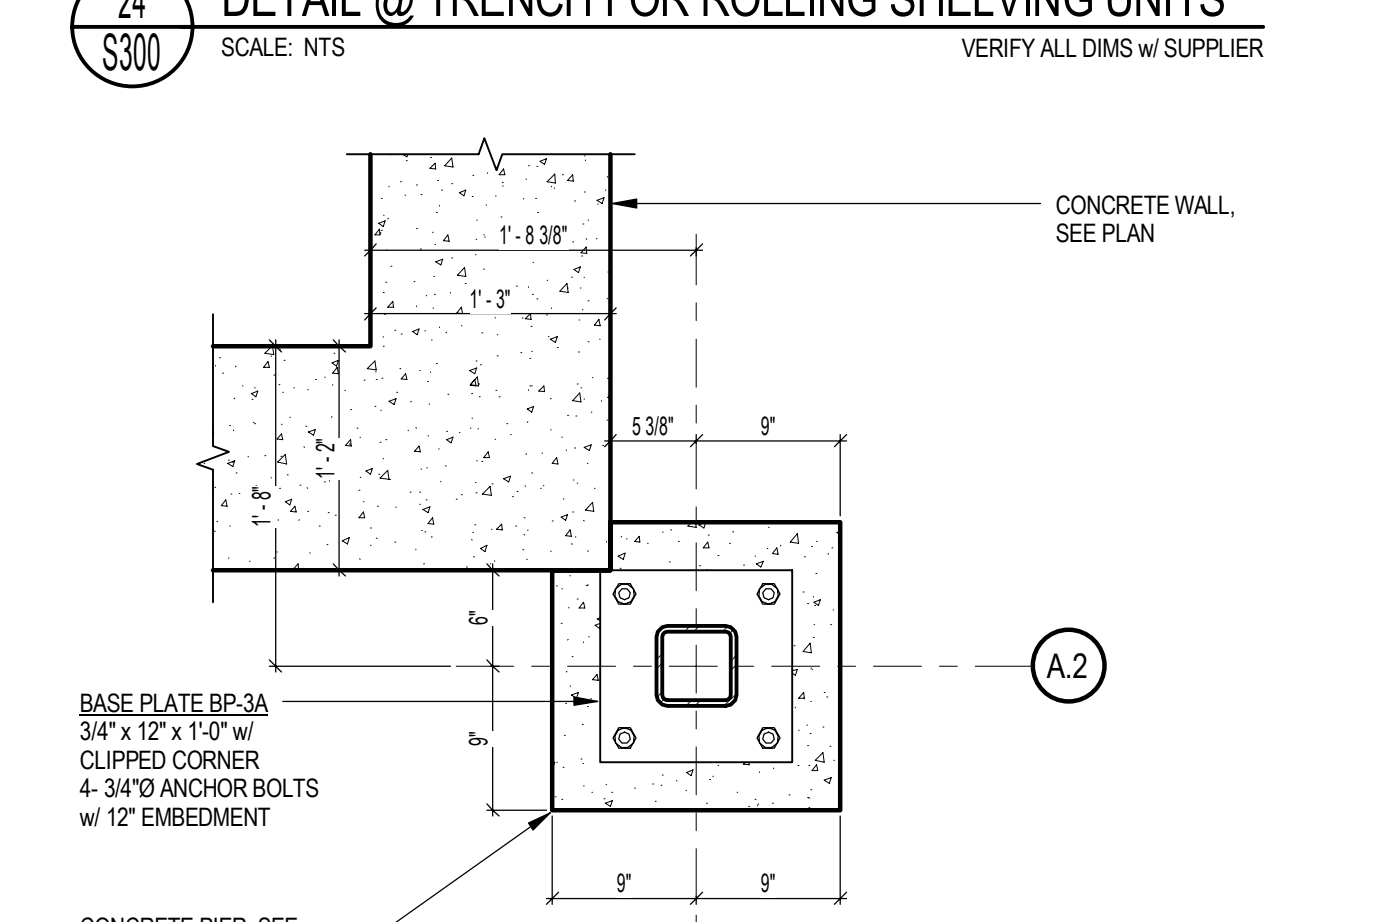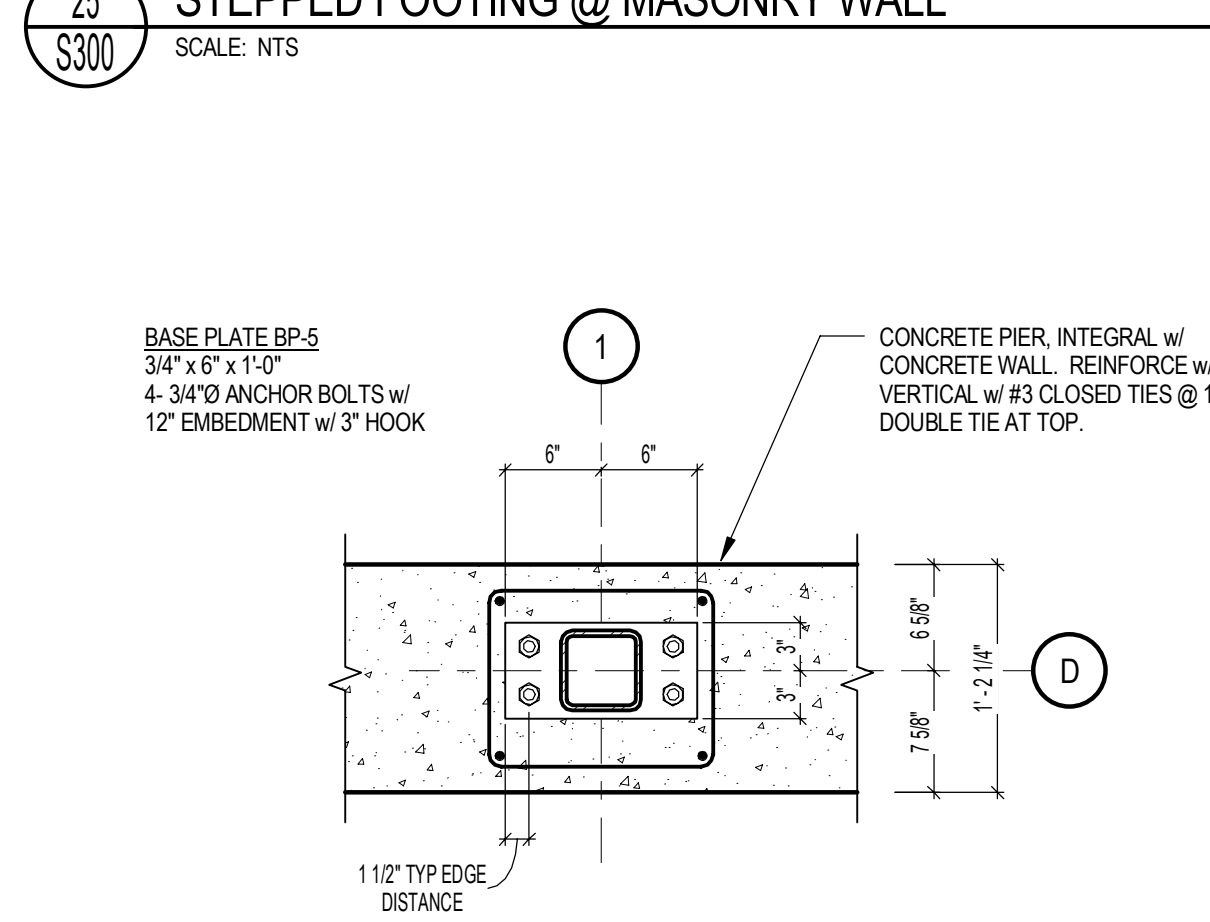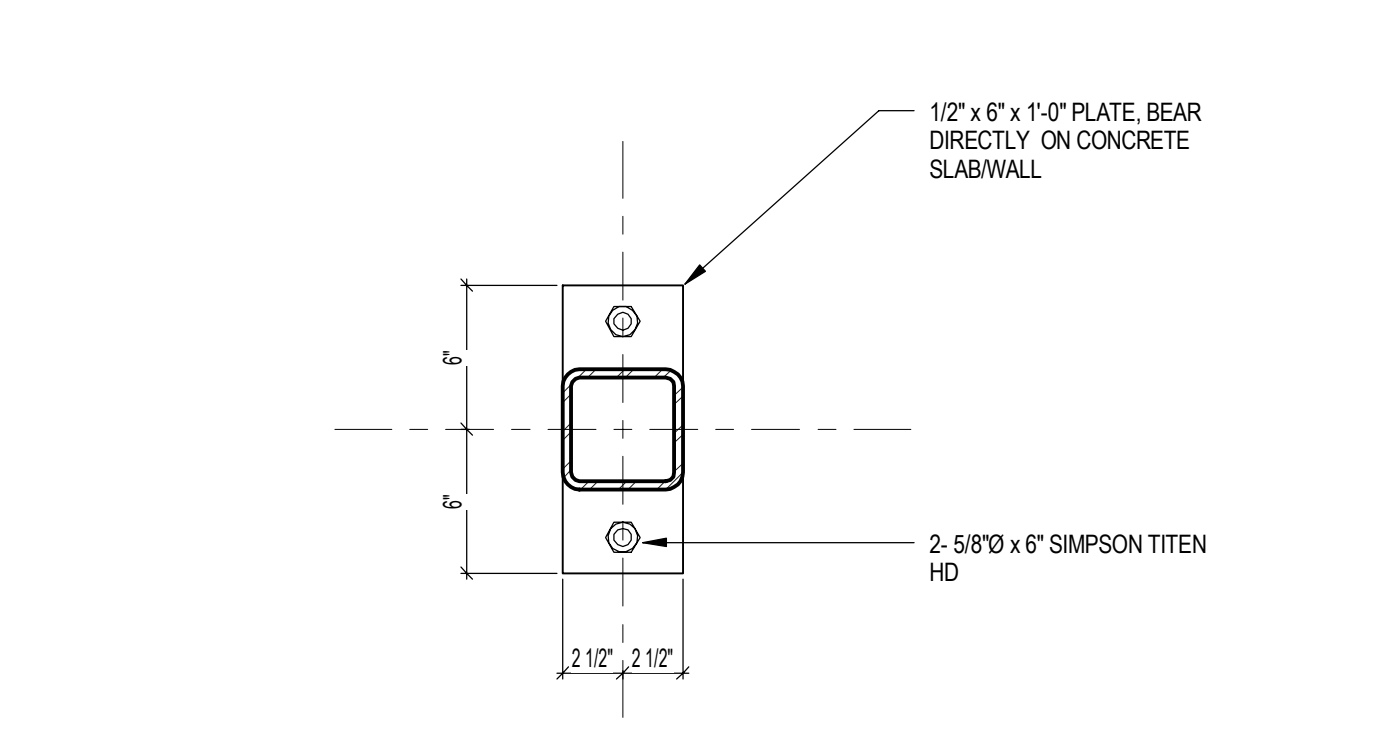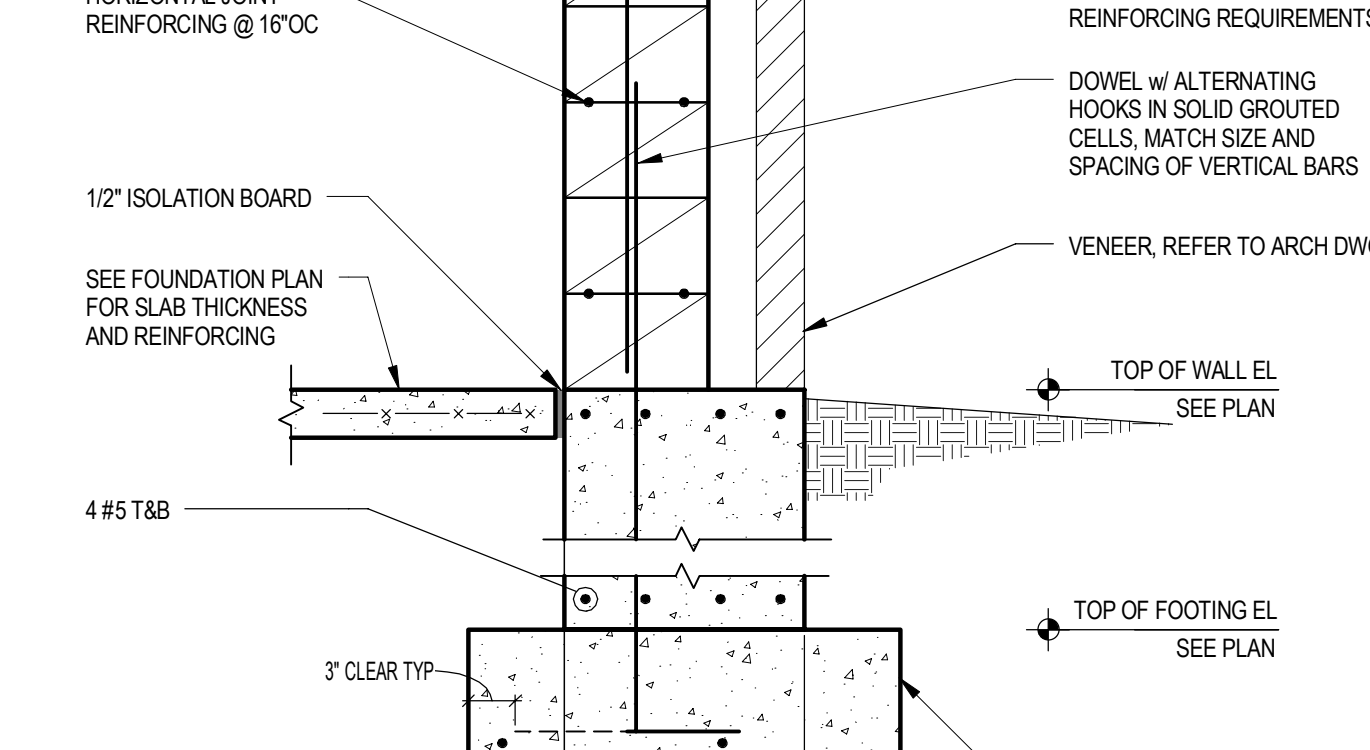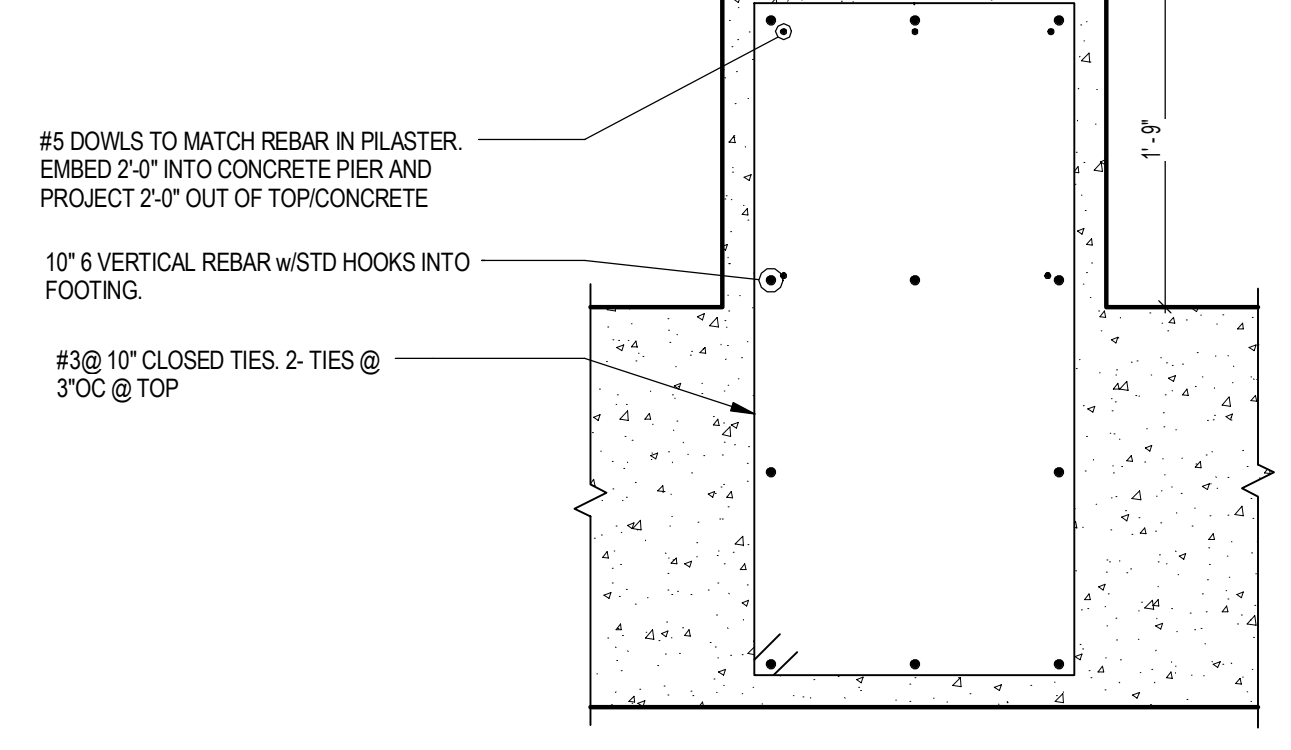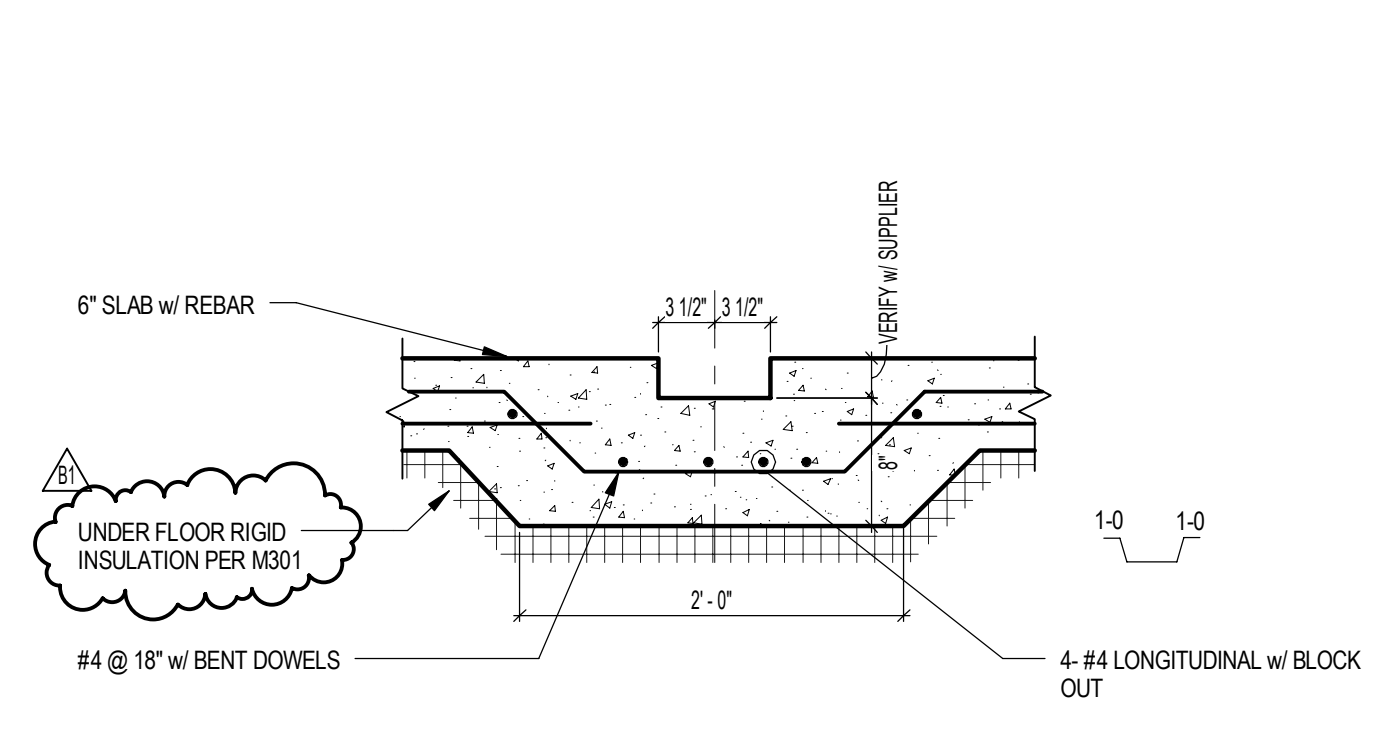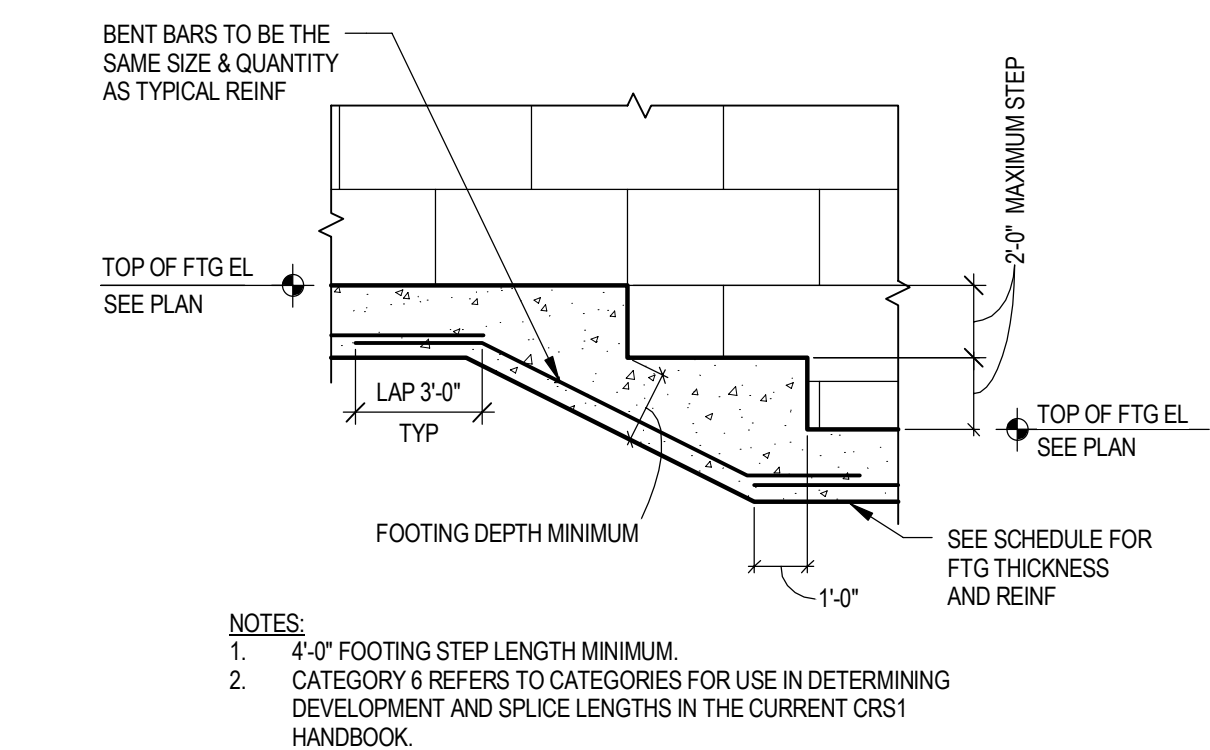

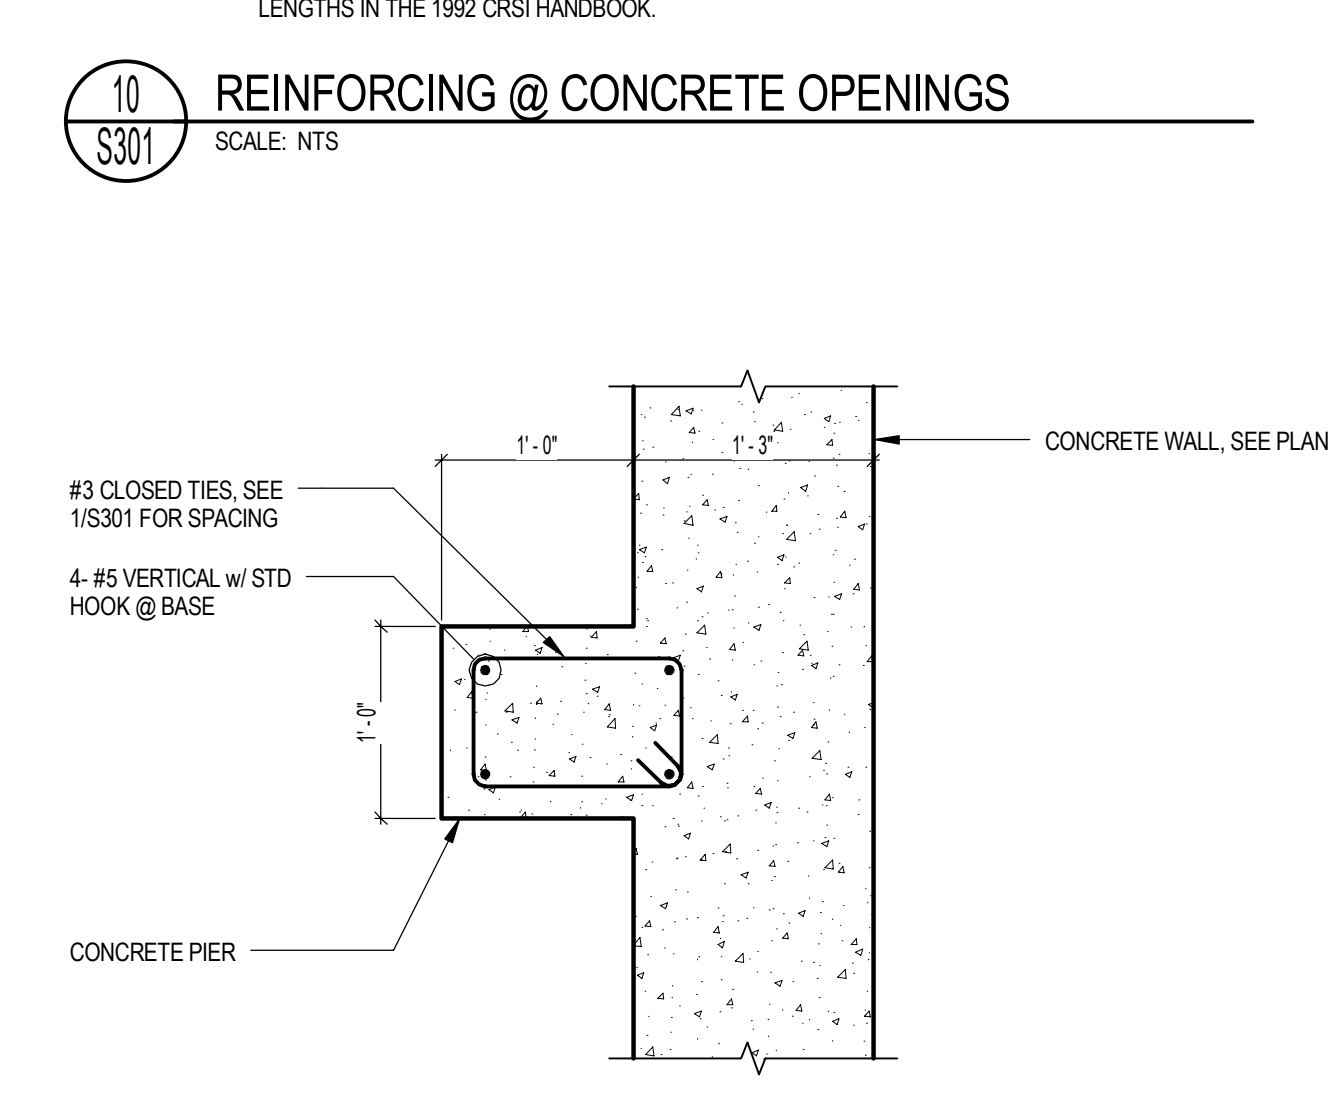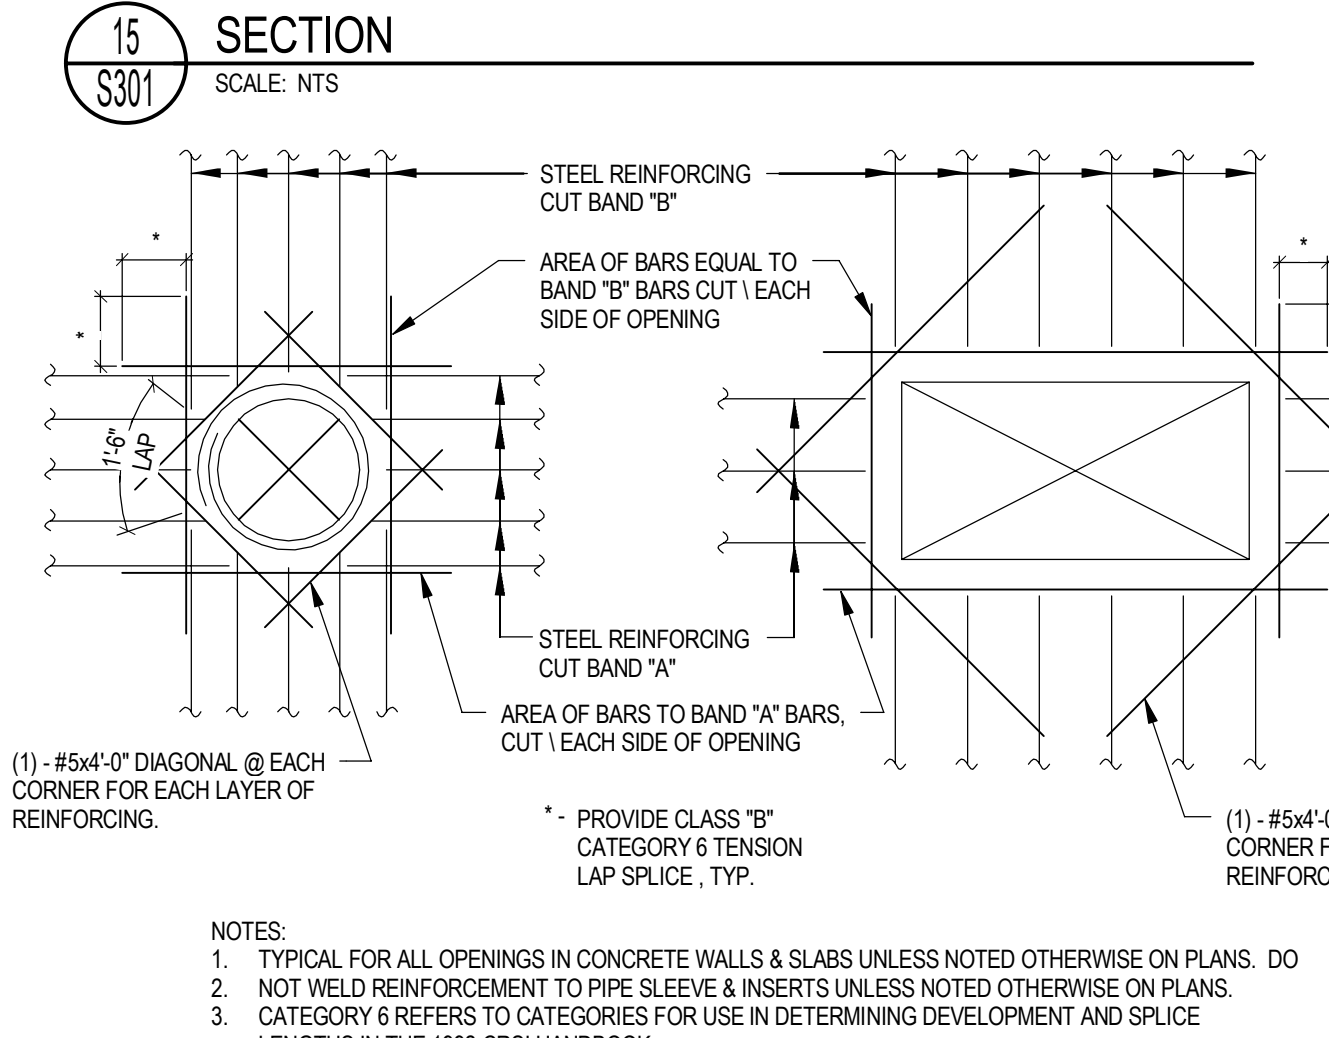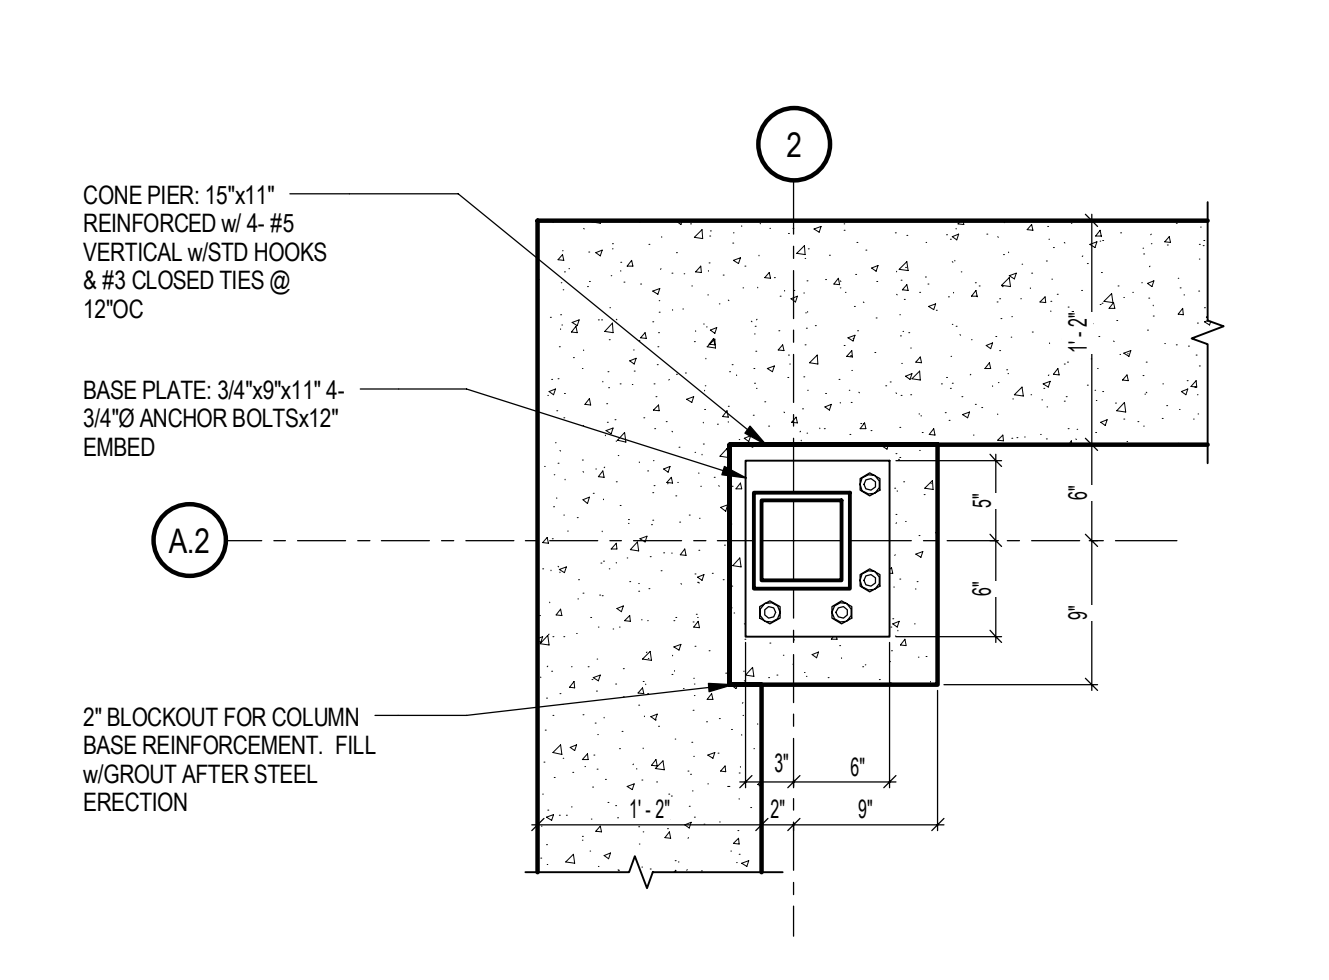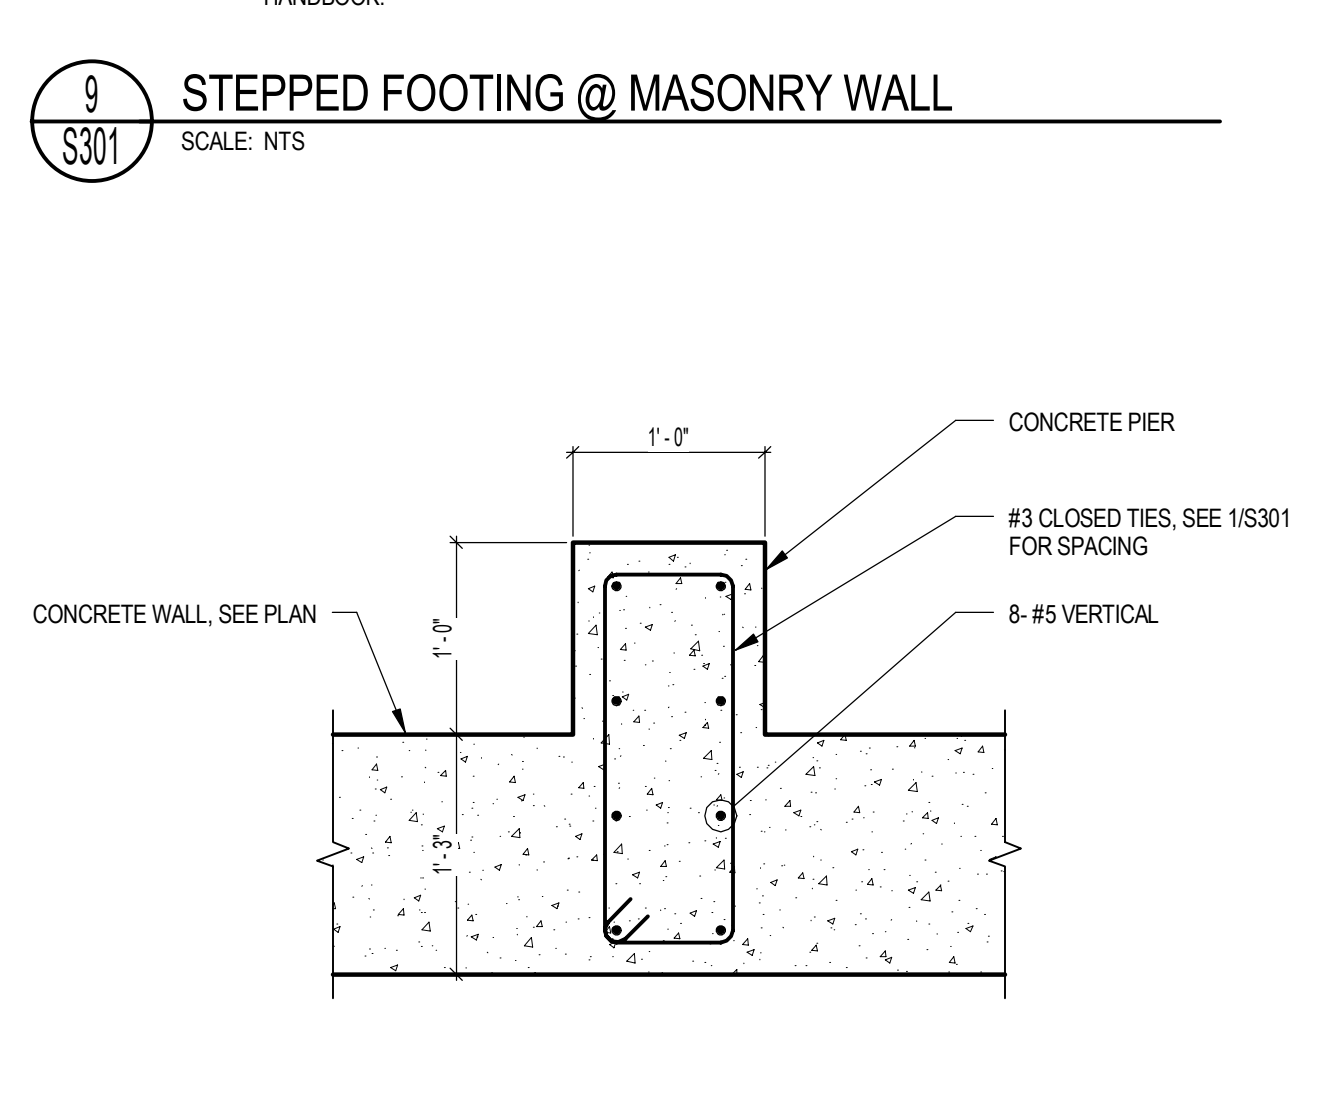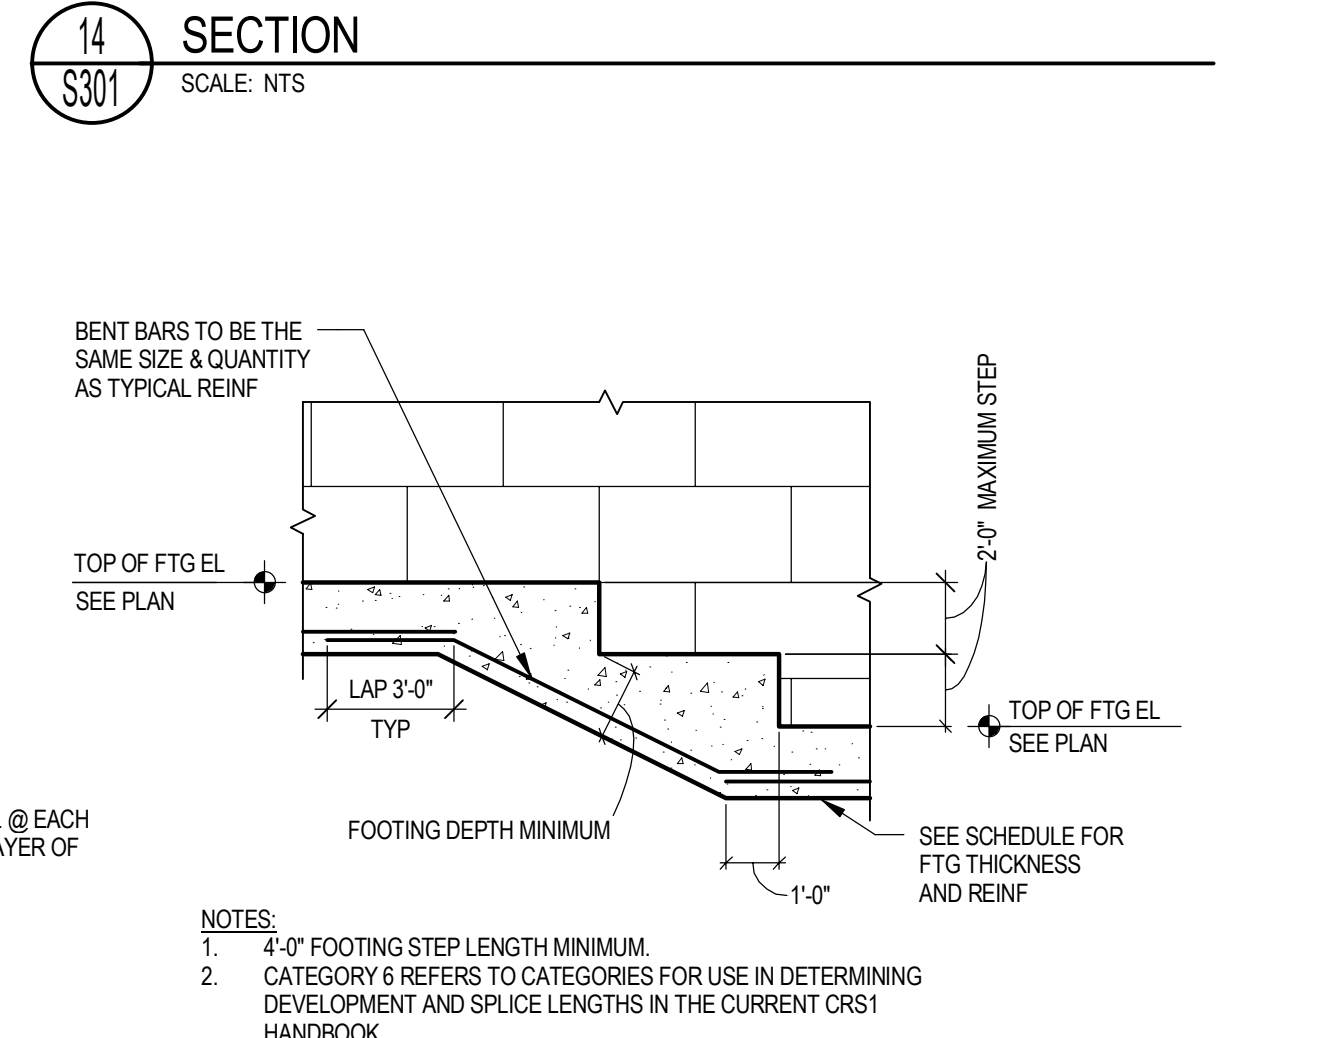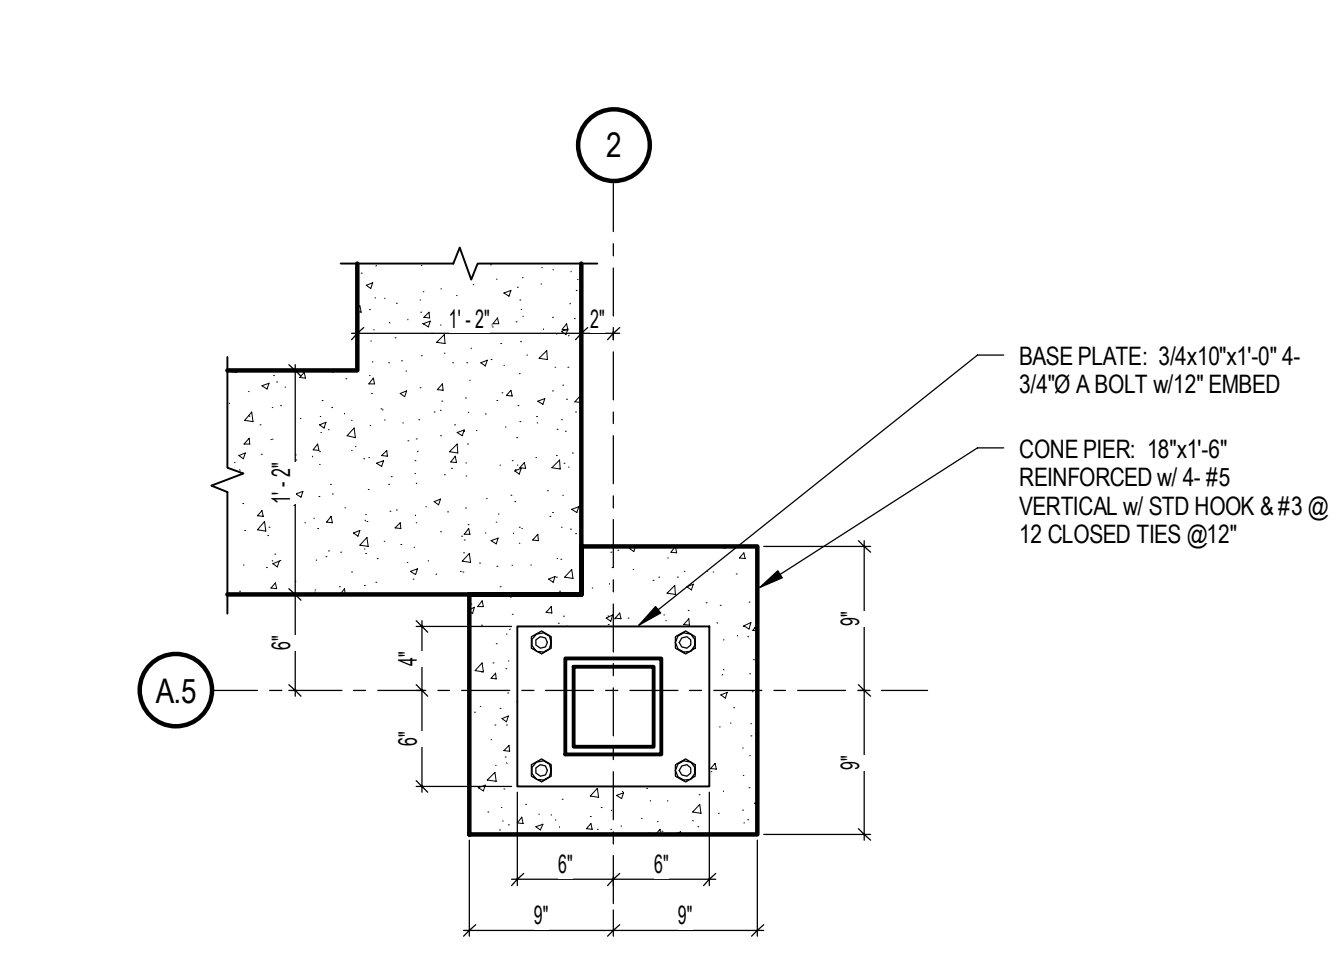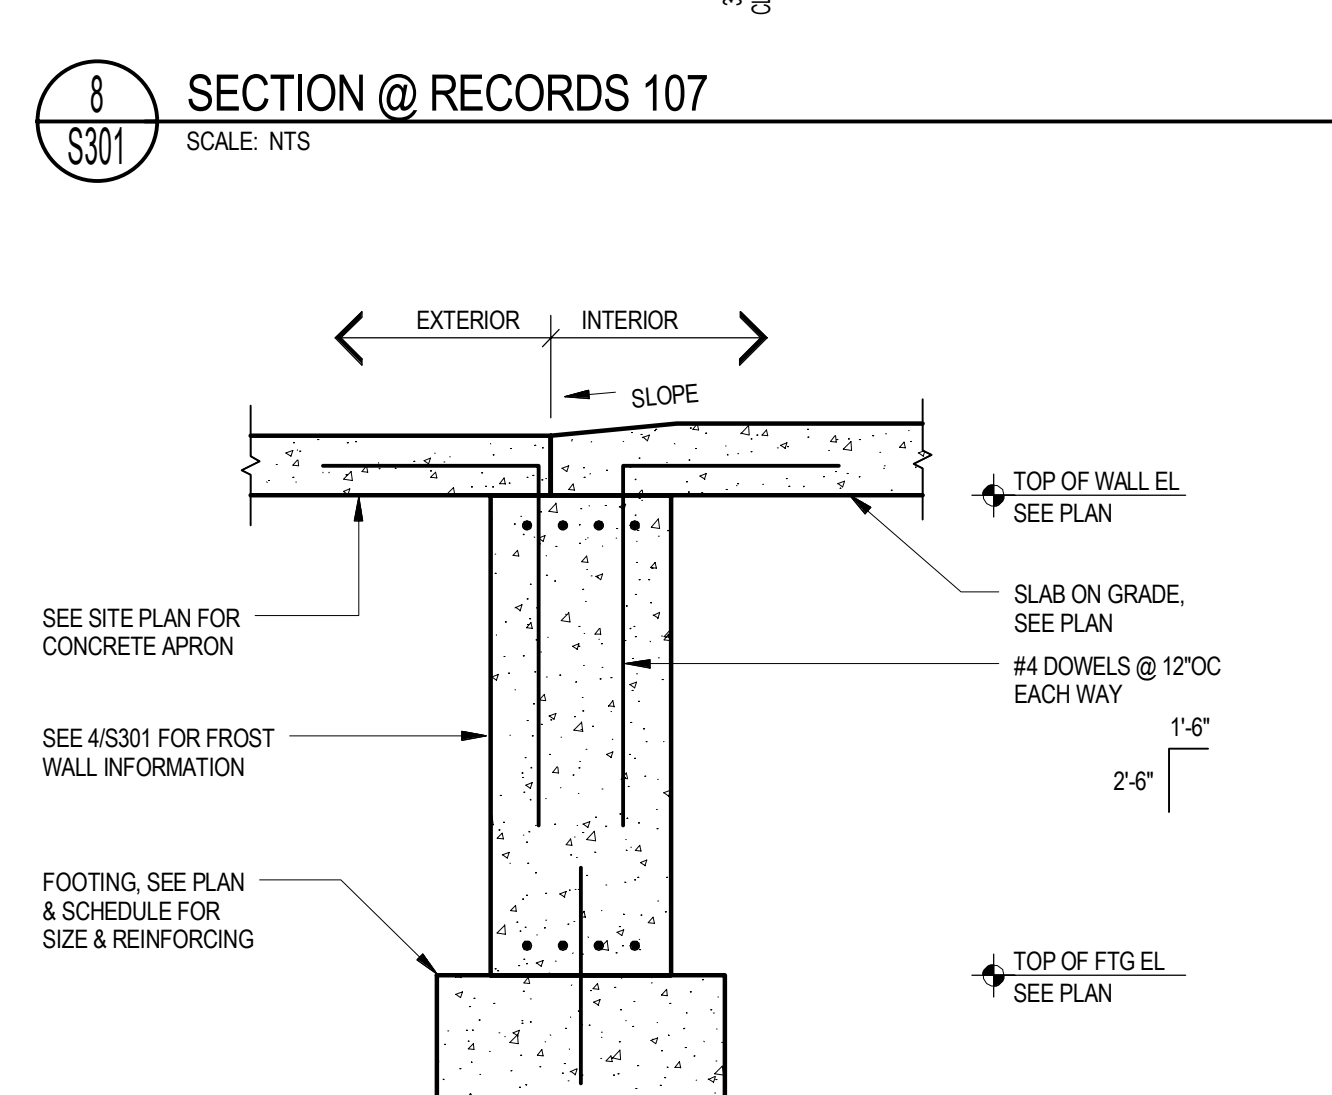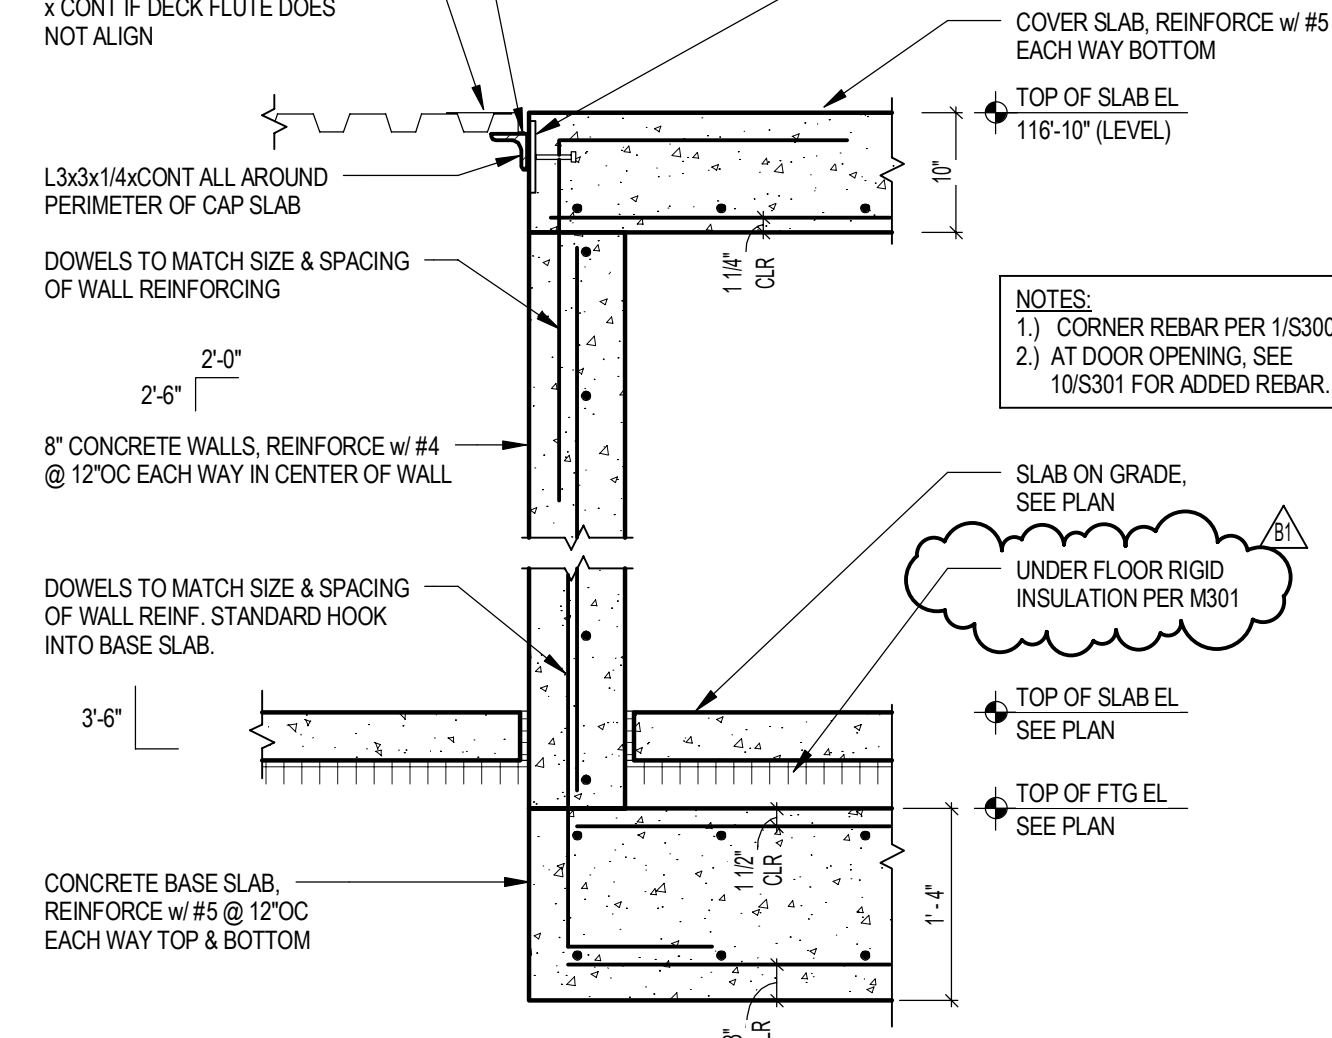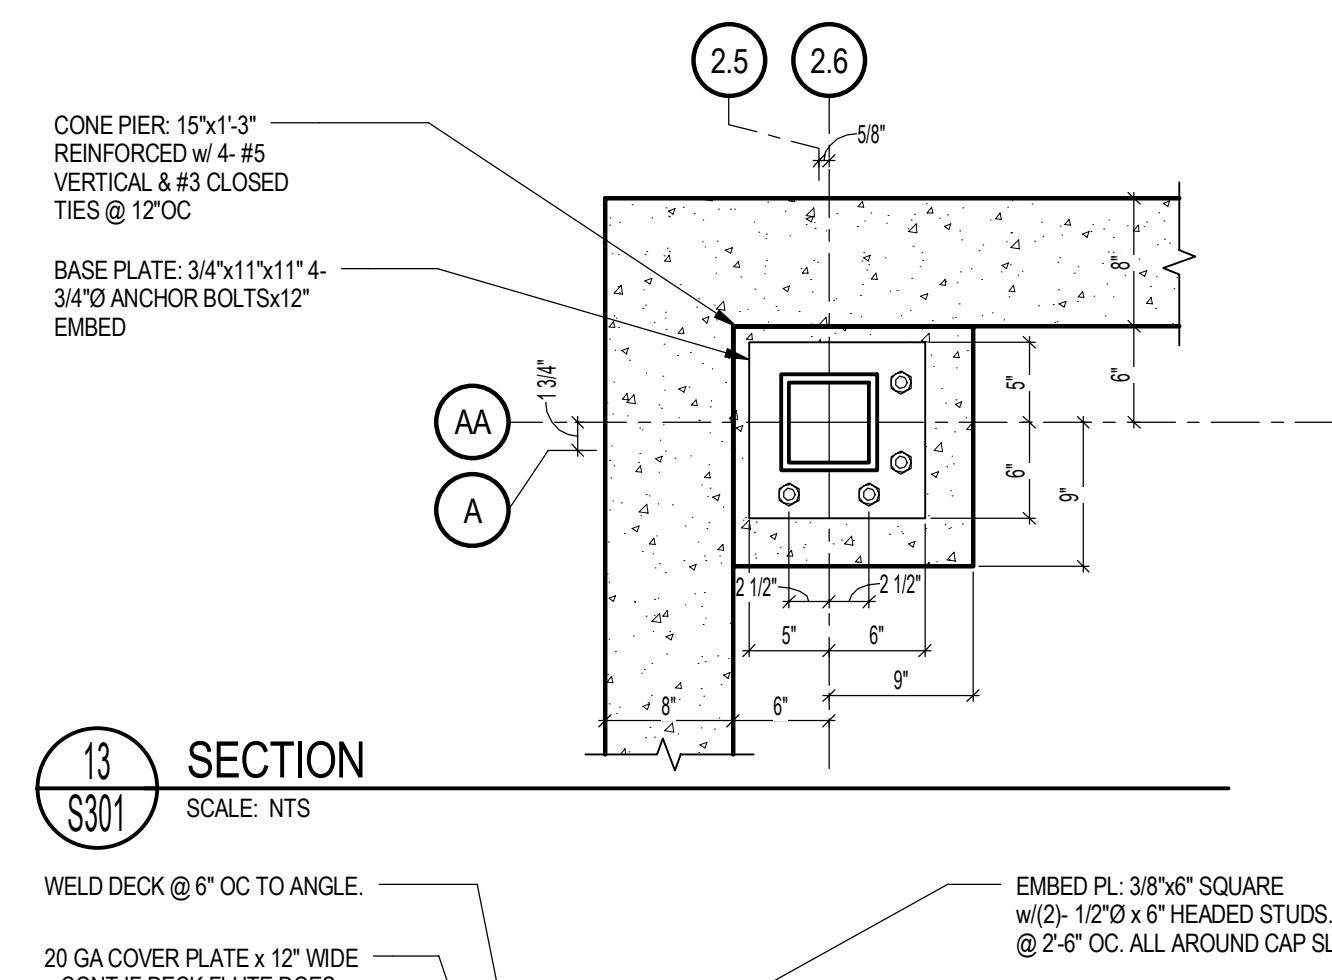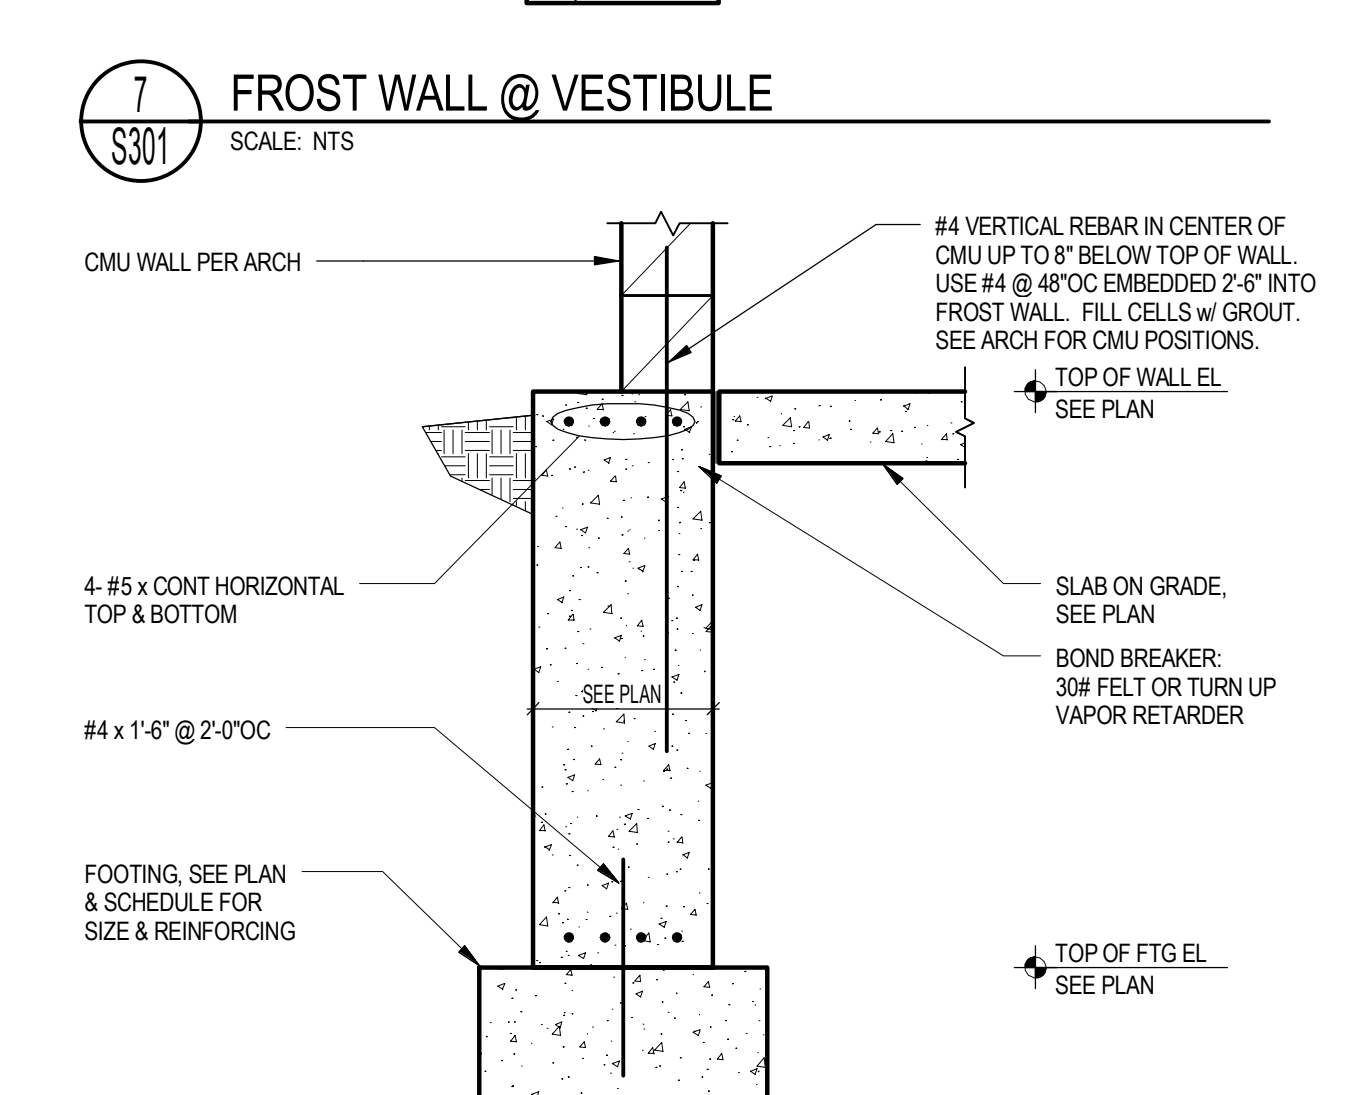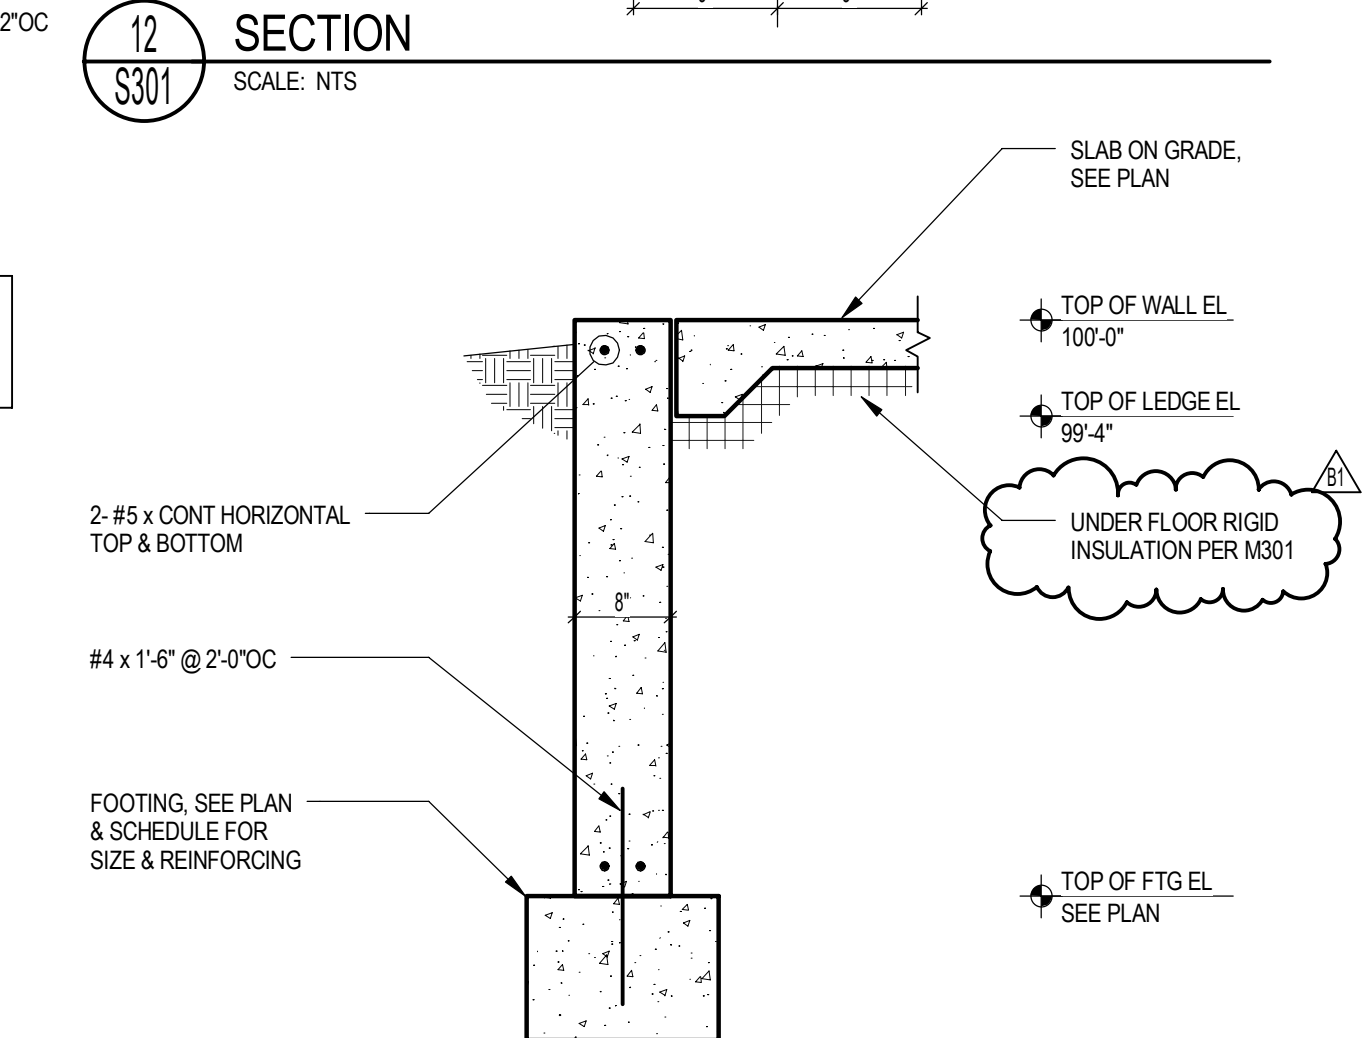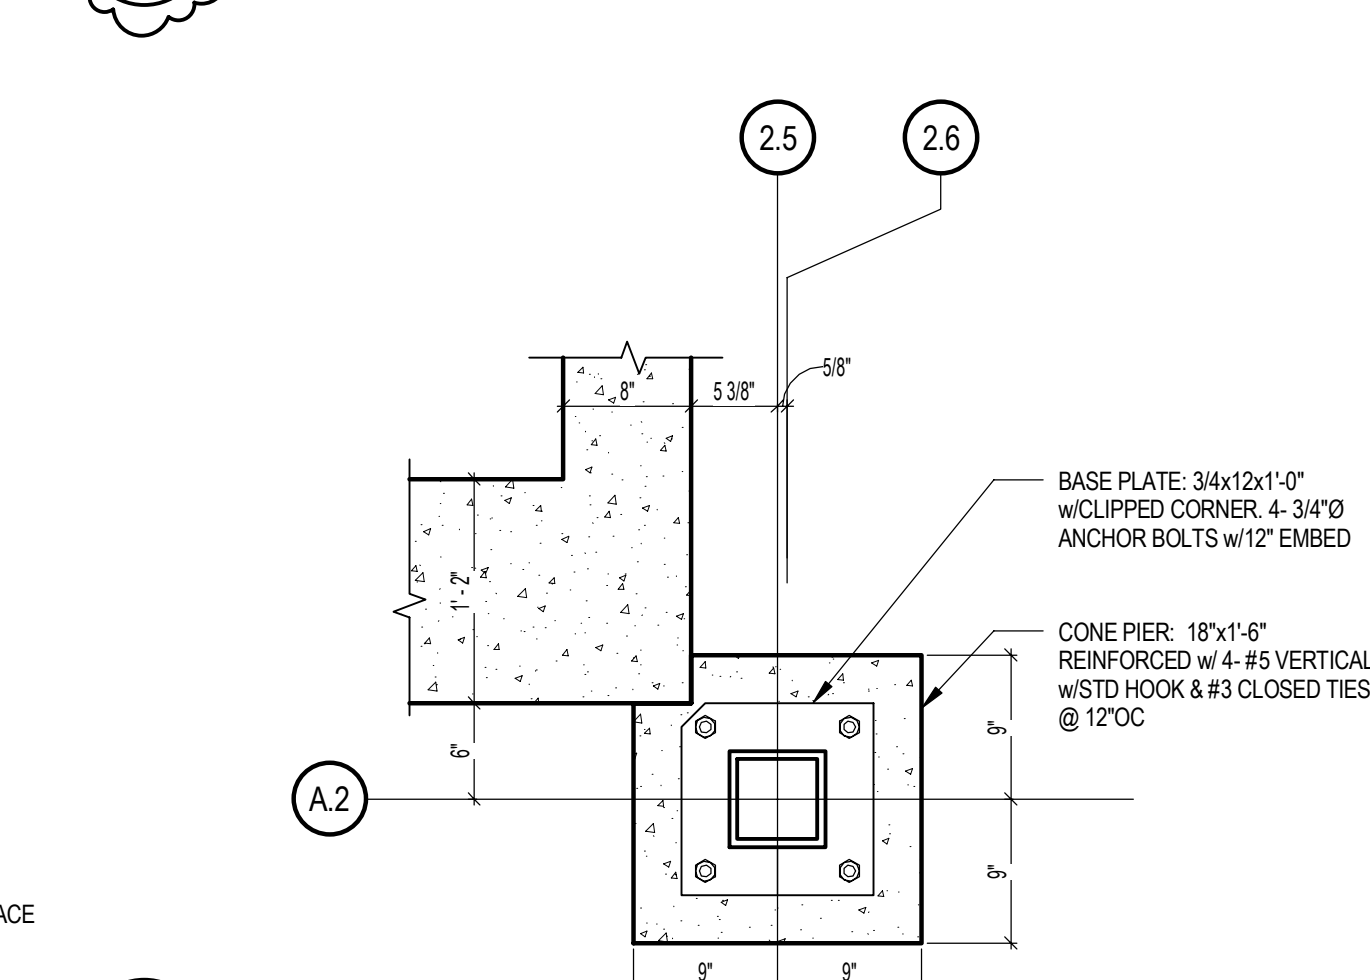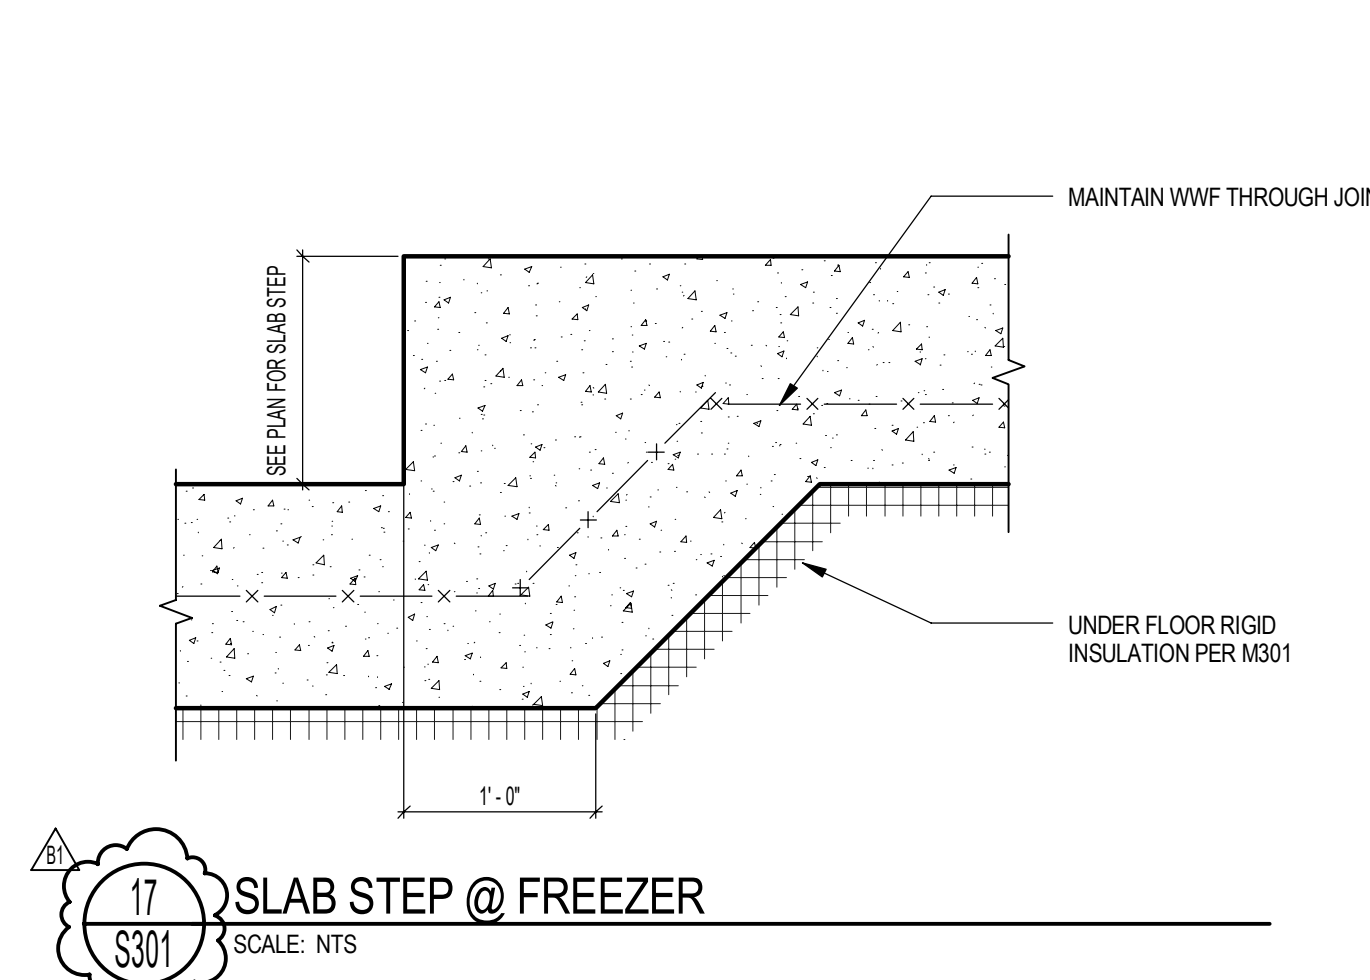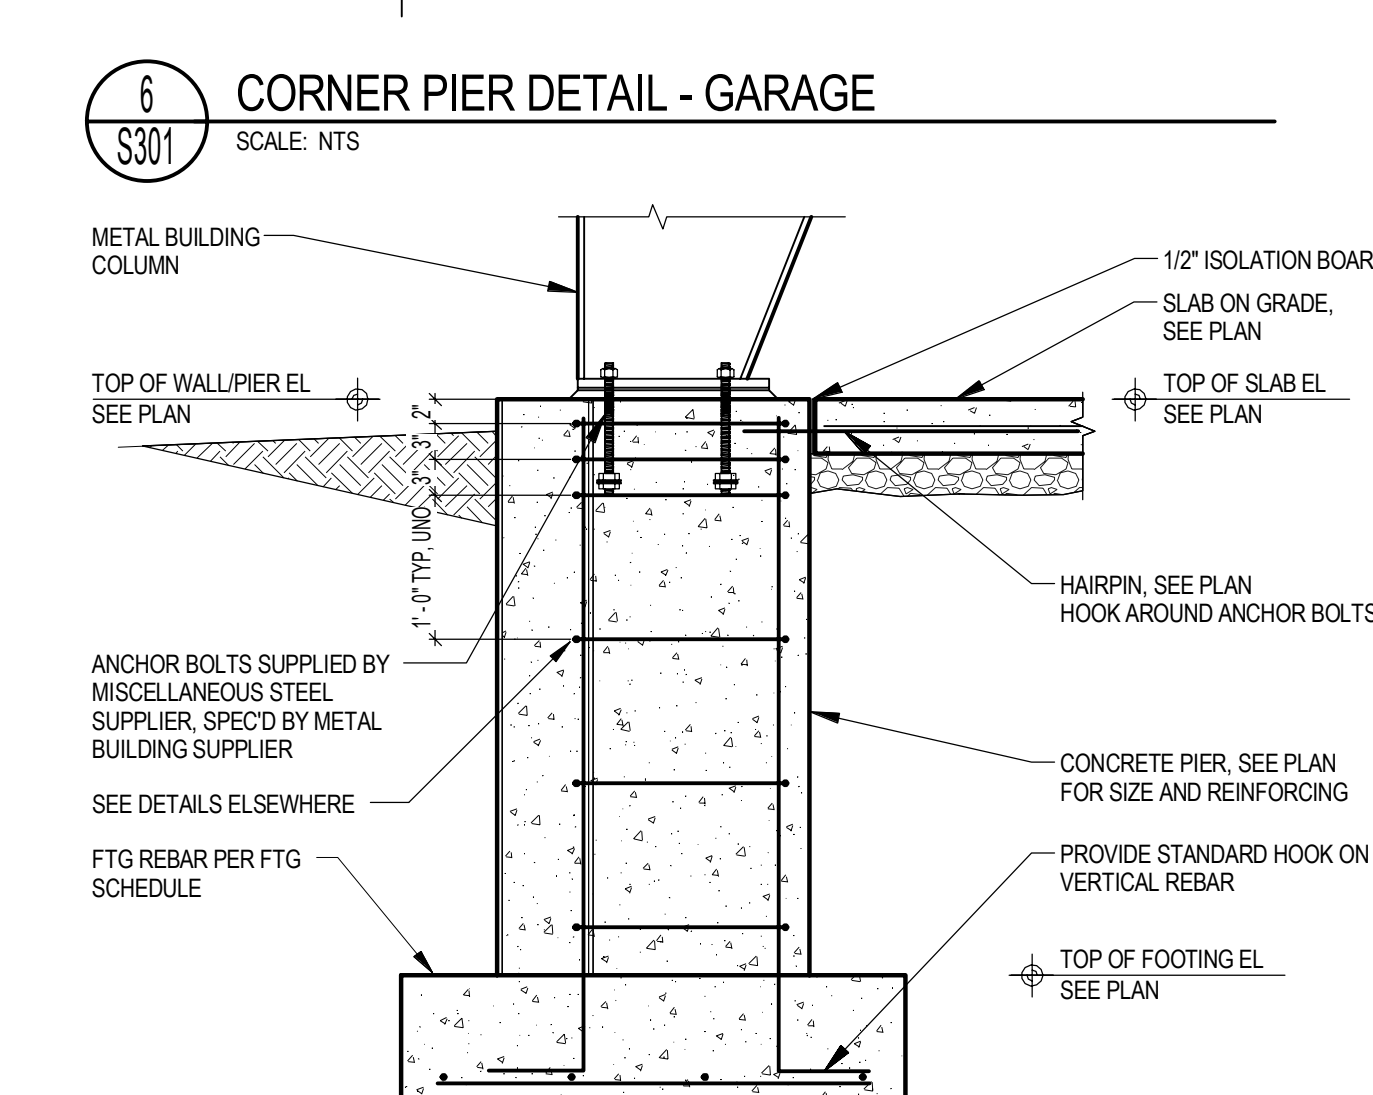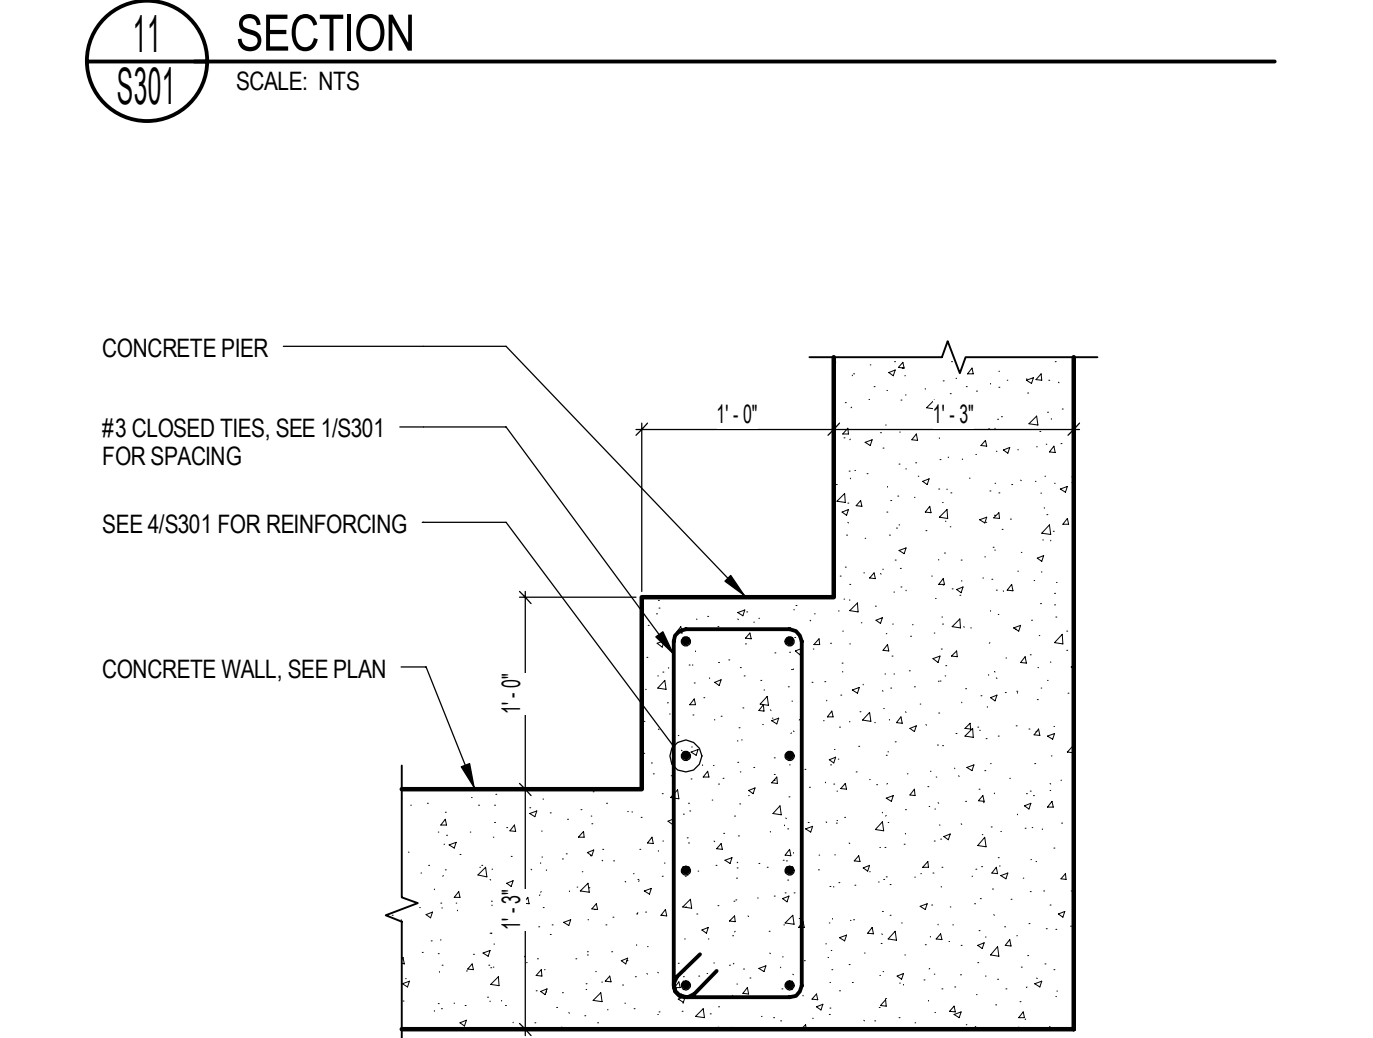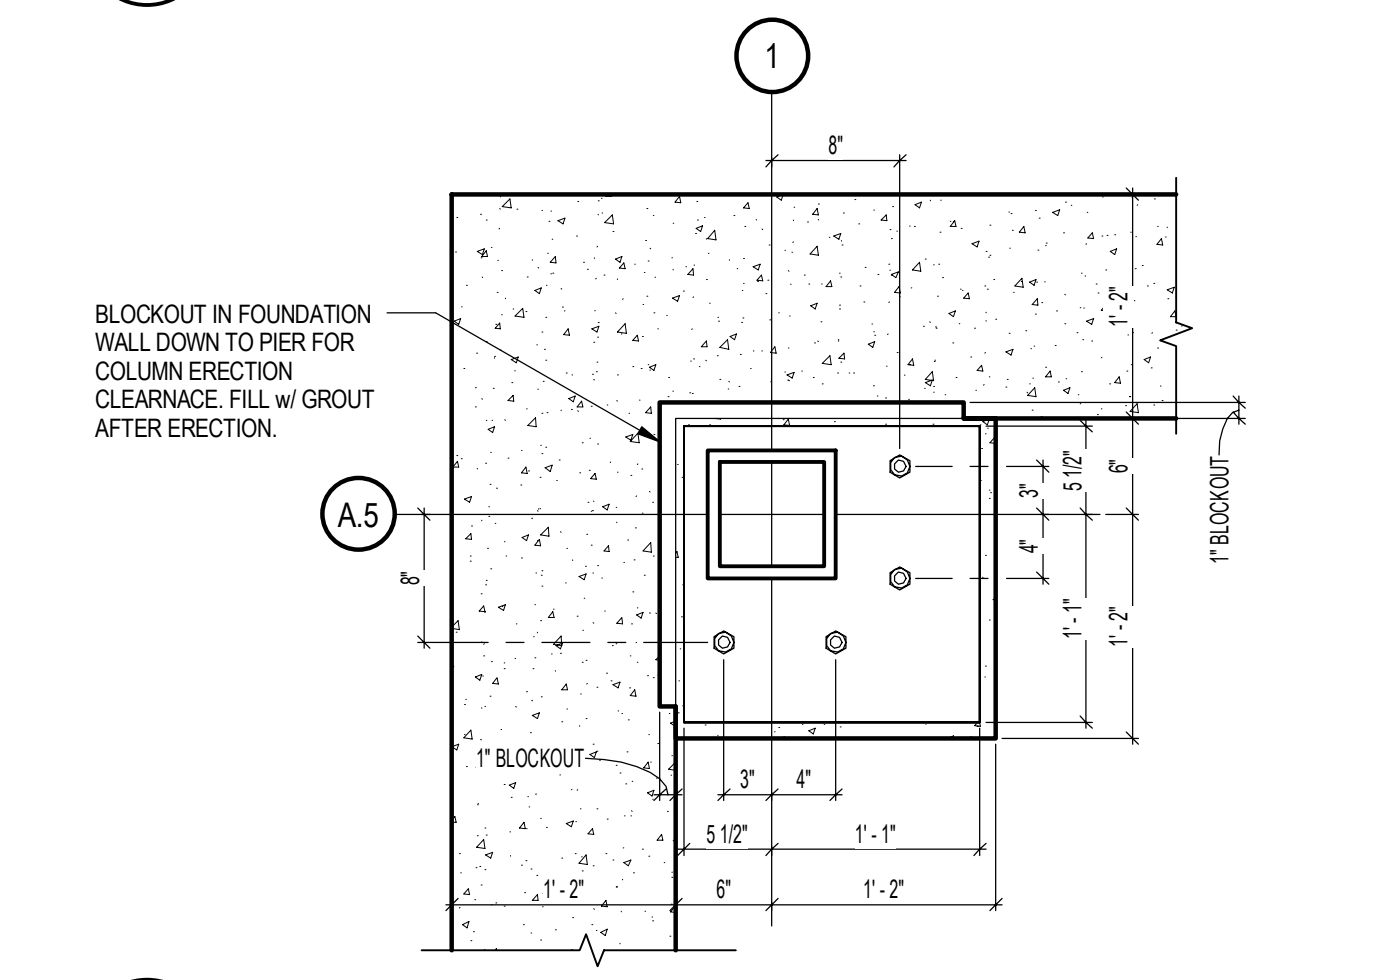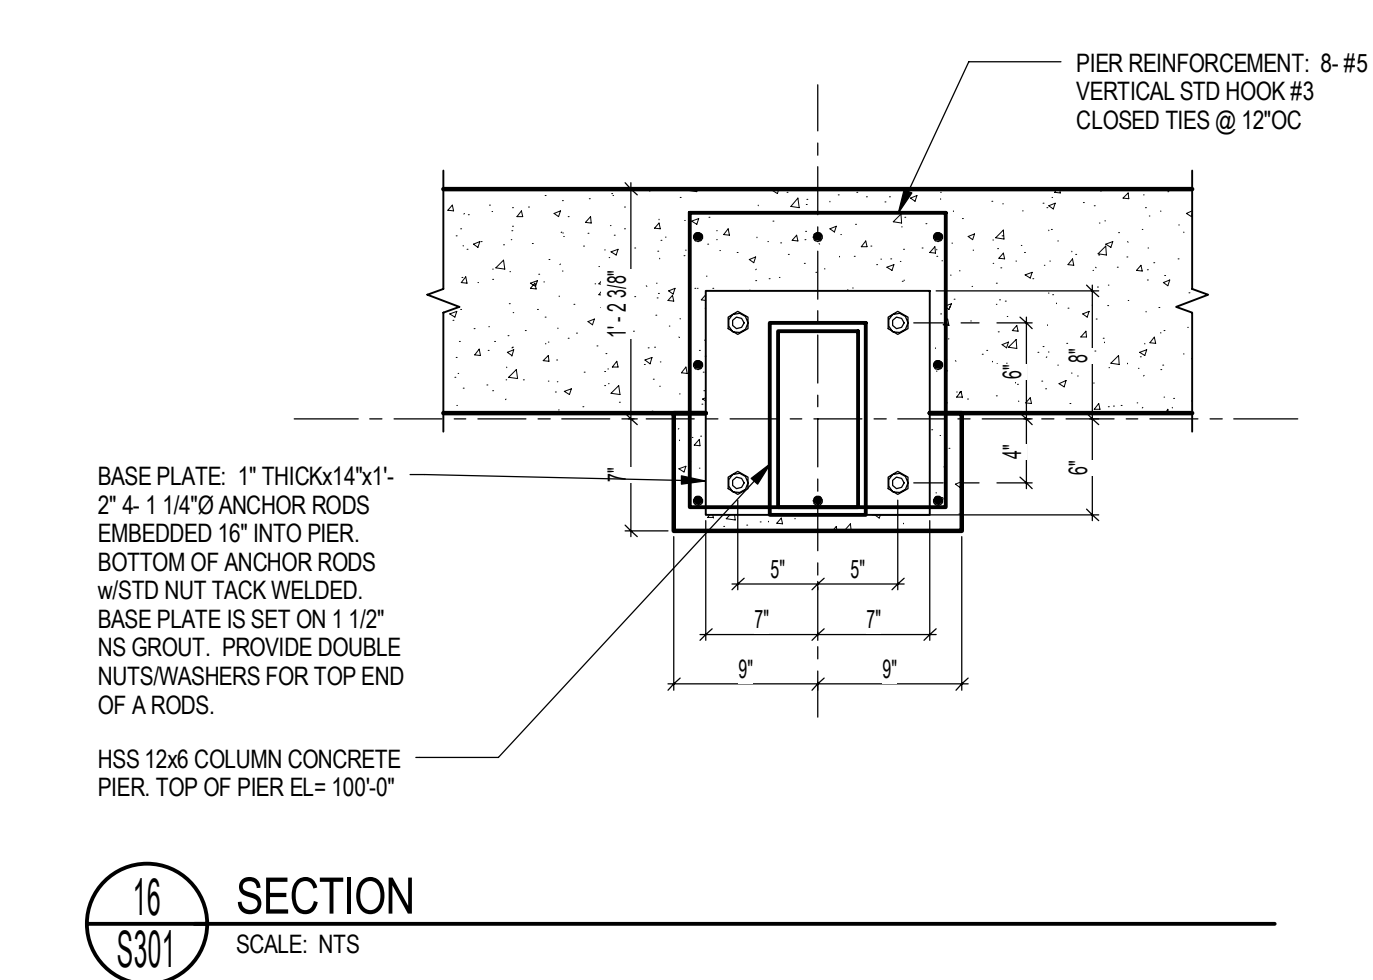


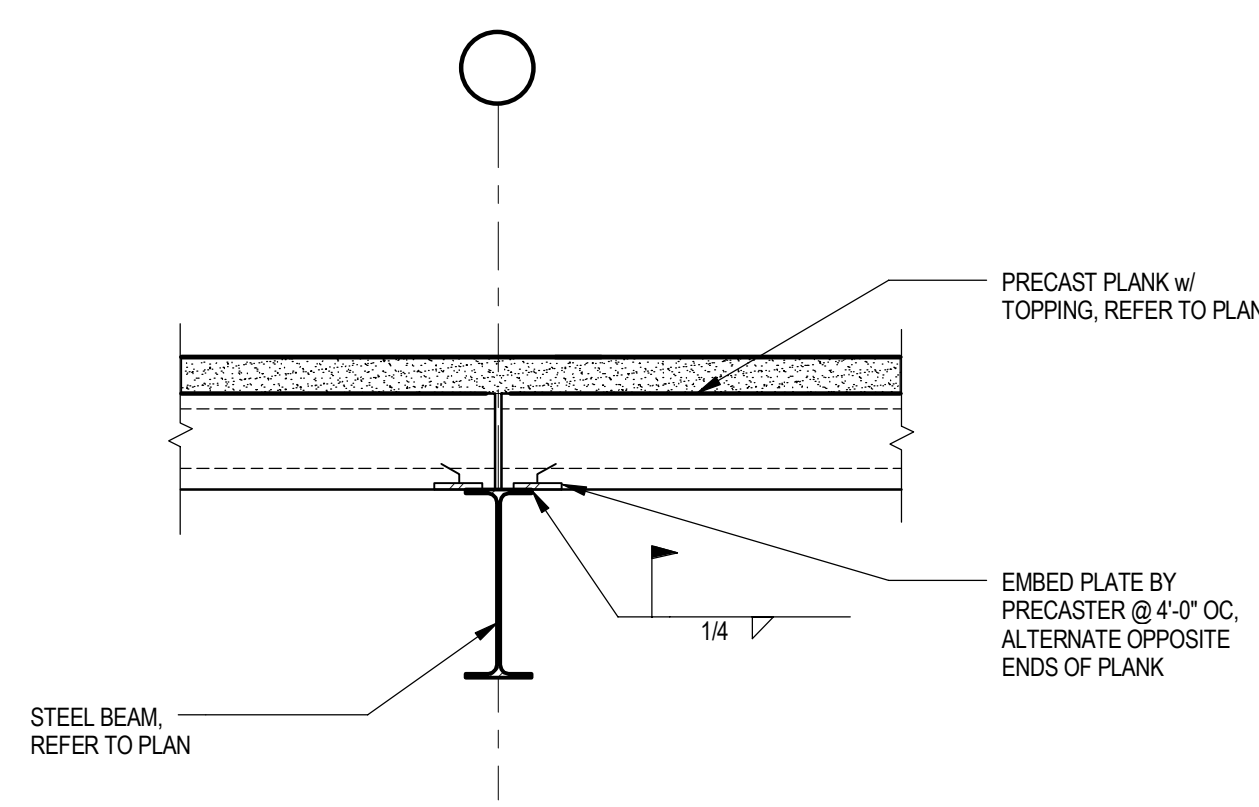


25 SECTION  
S401 SCALE: NTS

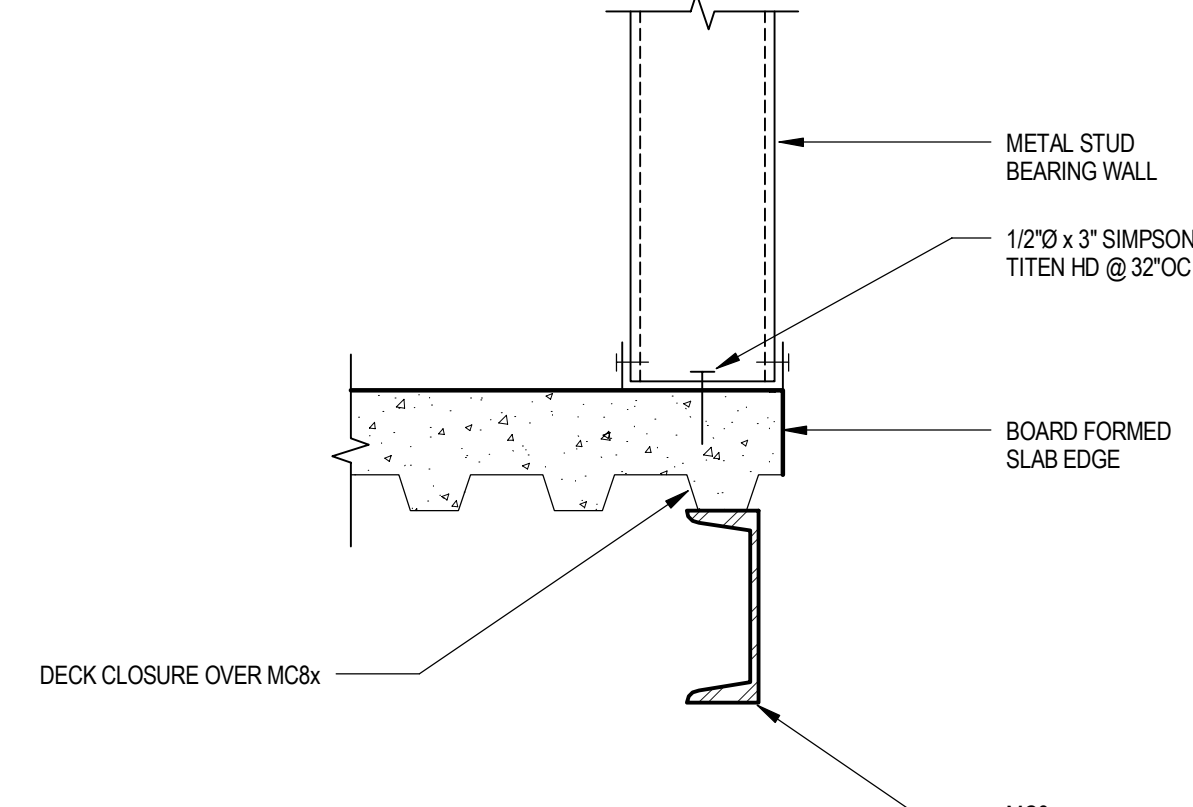


24 SECTION  
S401 SCALE: NTS

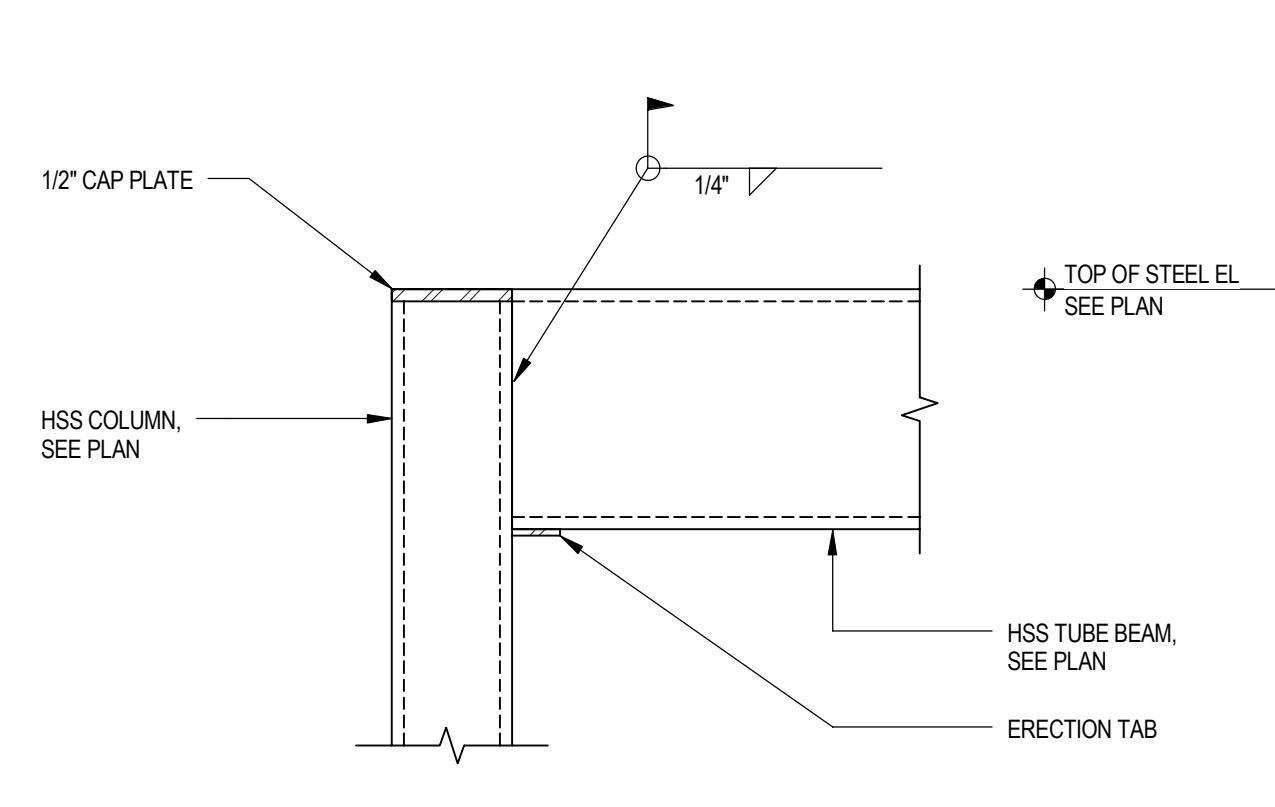


23 SECTION  
S401 SCALE: NTS

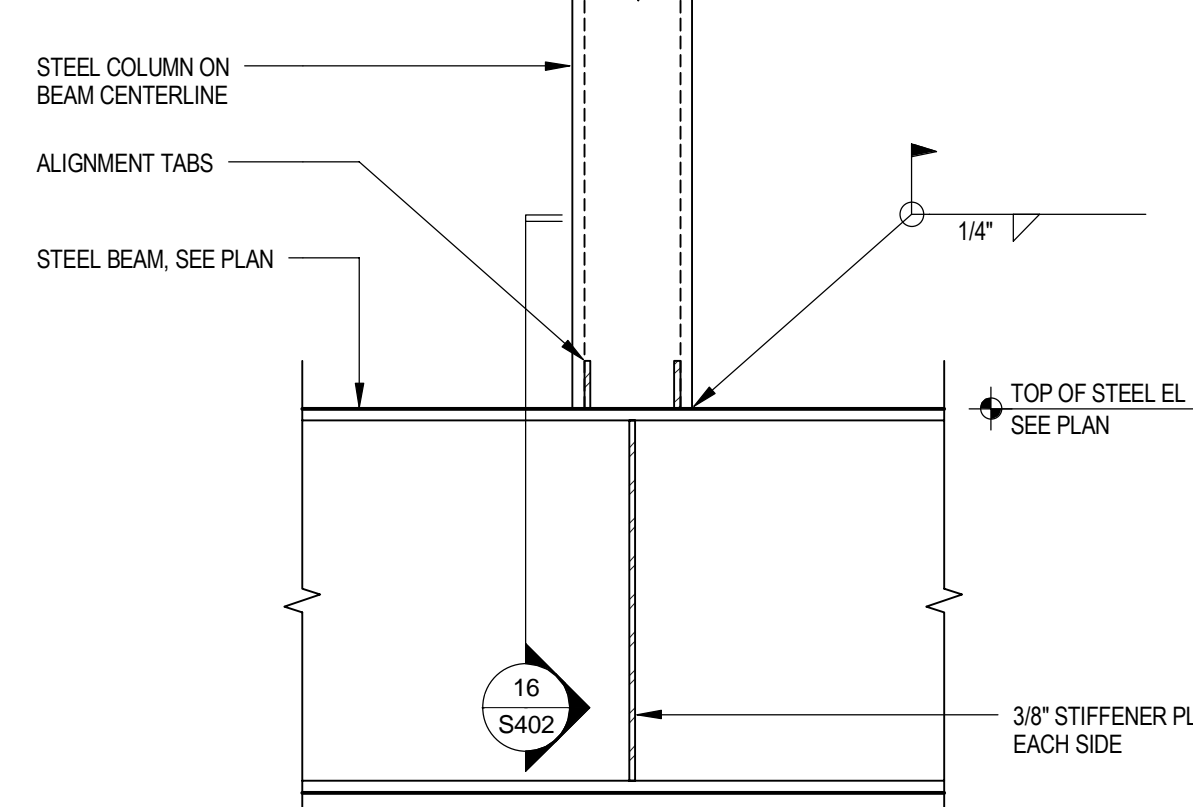


22 SECTION  
S401 SCALE: NTS

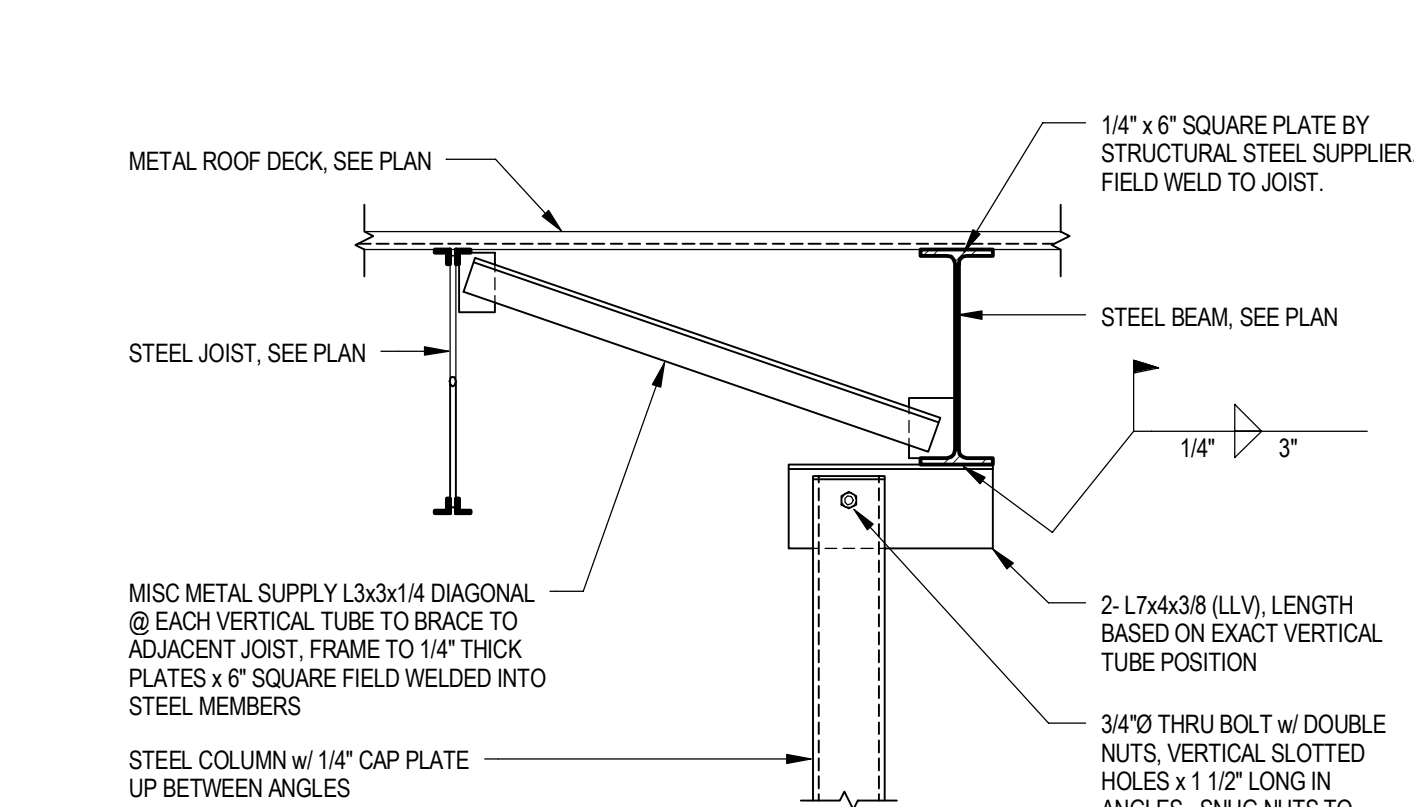


21 SECTION  
S401 SCALE: NTS

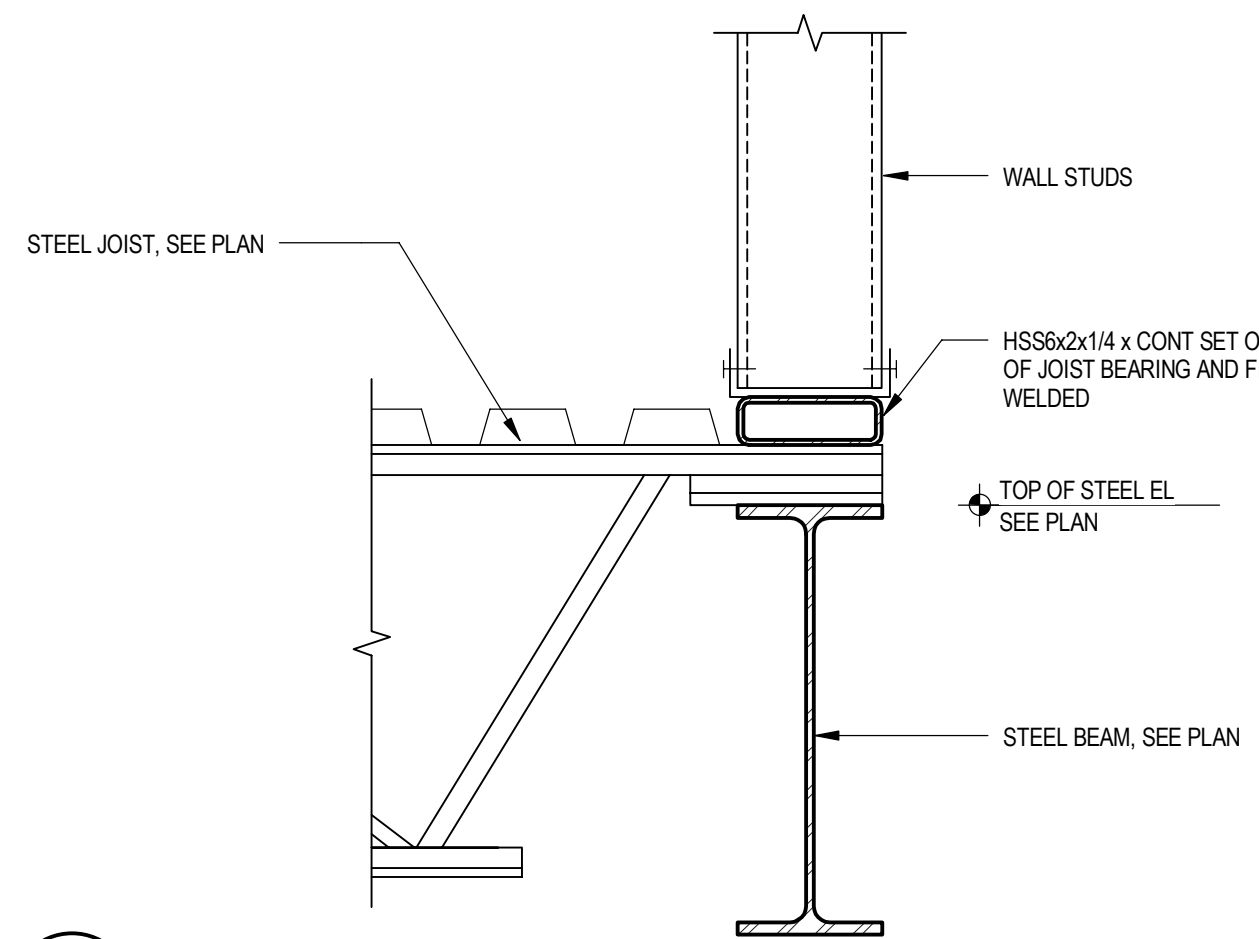


20 SECTION  
S401 SCALE: NTS

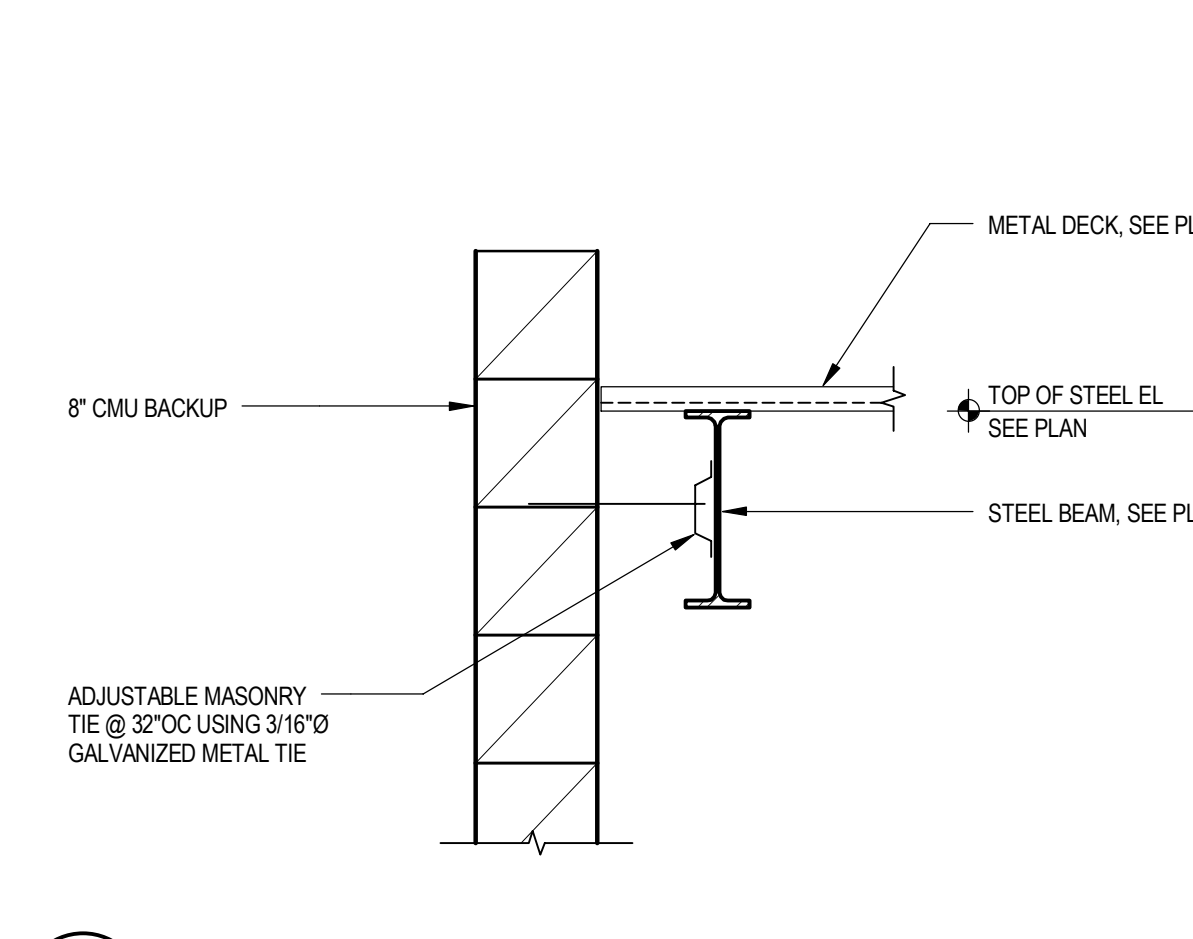


19 MASONRY WALL ANCHORAGE, TYP @ CMU BACKUP  
S401 SCALE: NTS

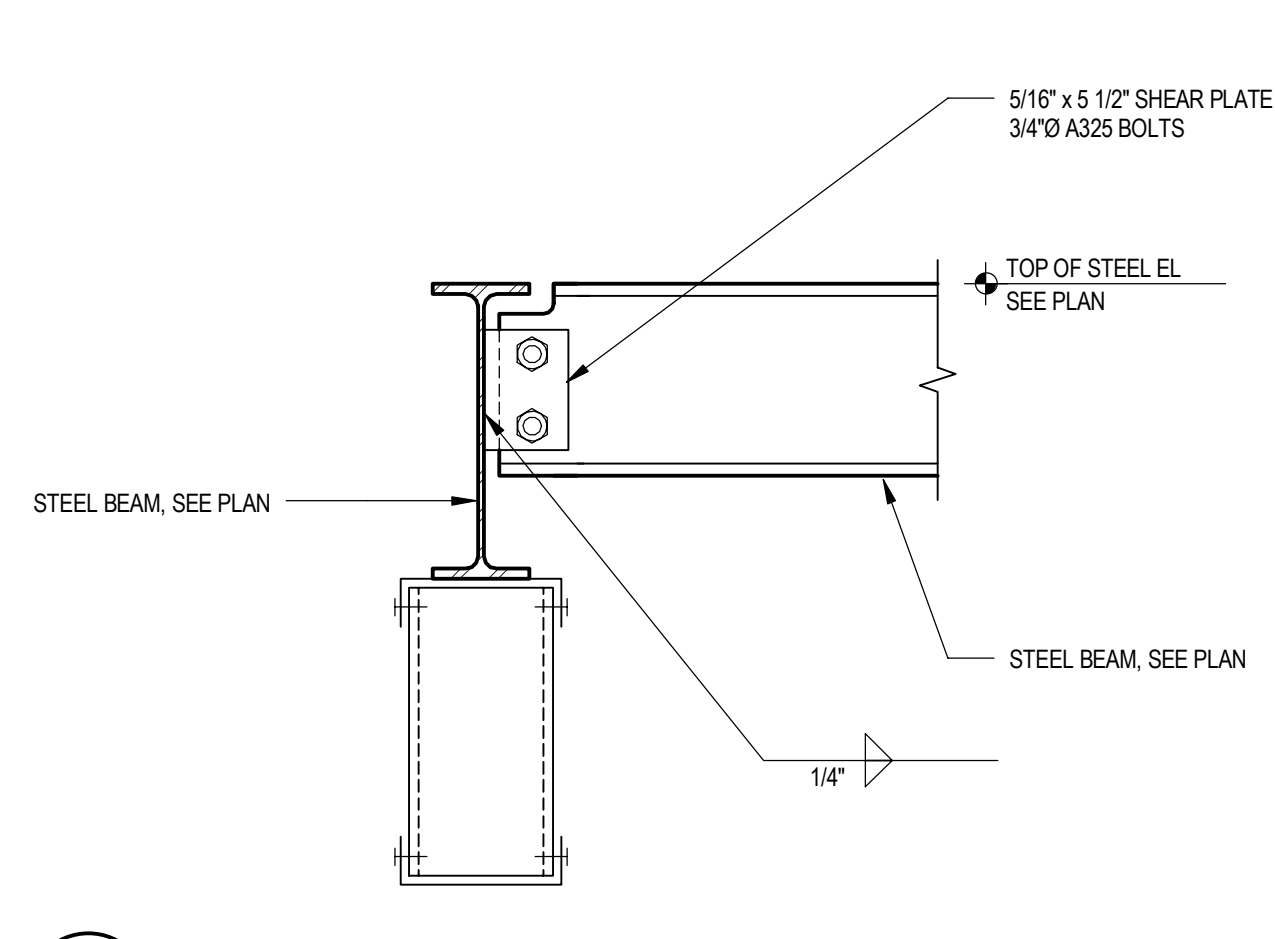


18 SECTION  
S401 SCALE: NTS

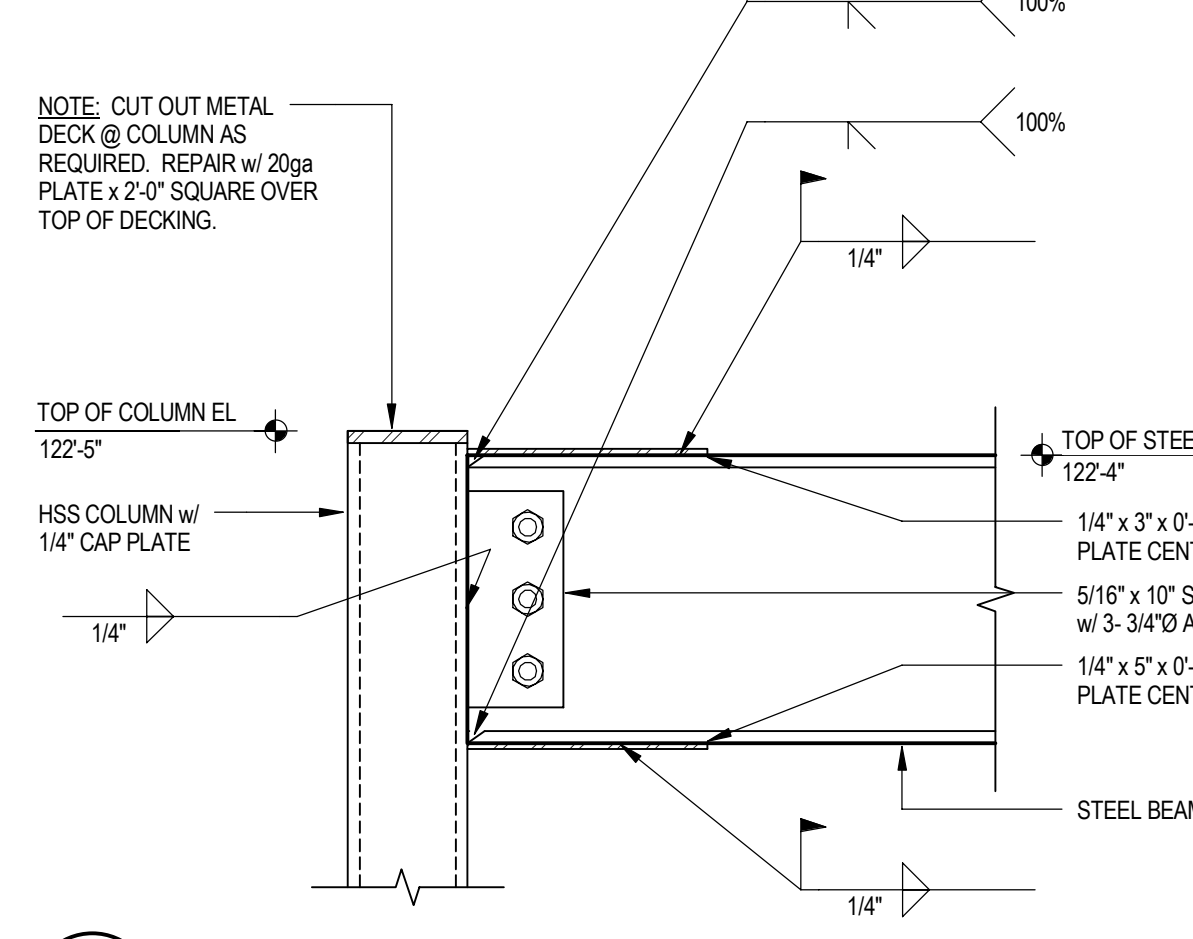


17 MOMENT CONNECTION AT MONITOR ROOF  
S401 SCALE: NTS

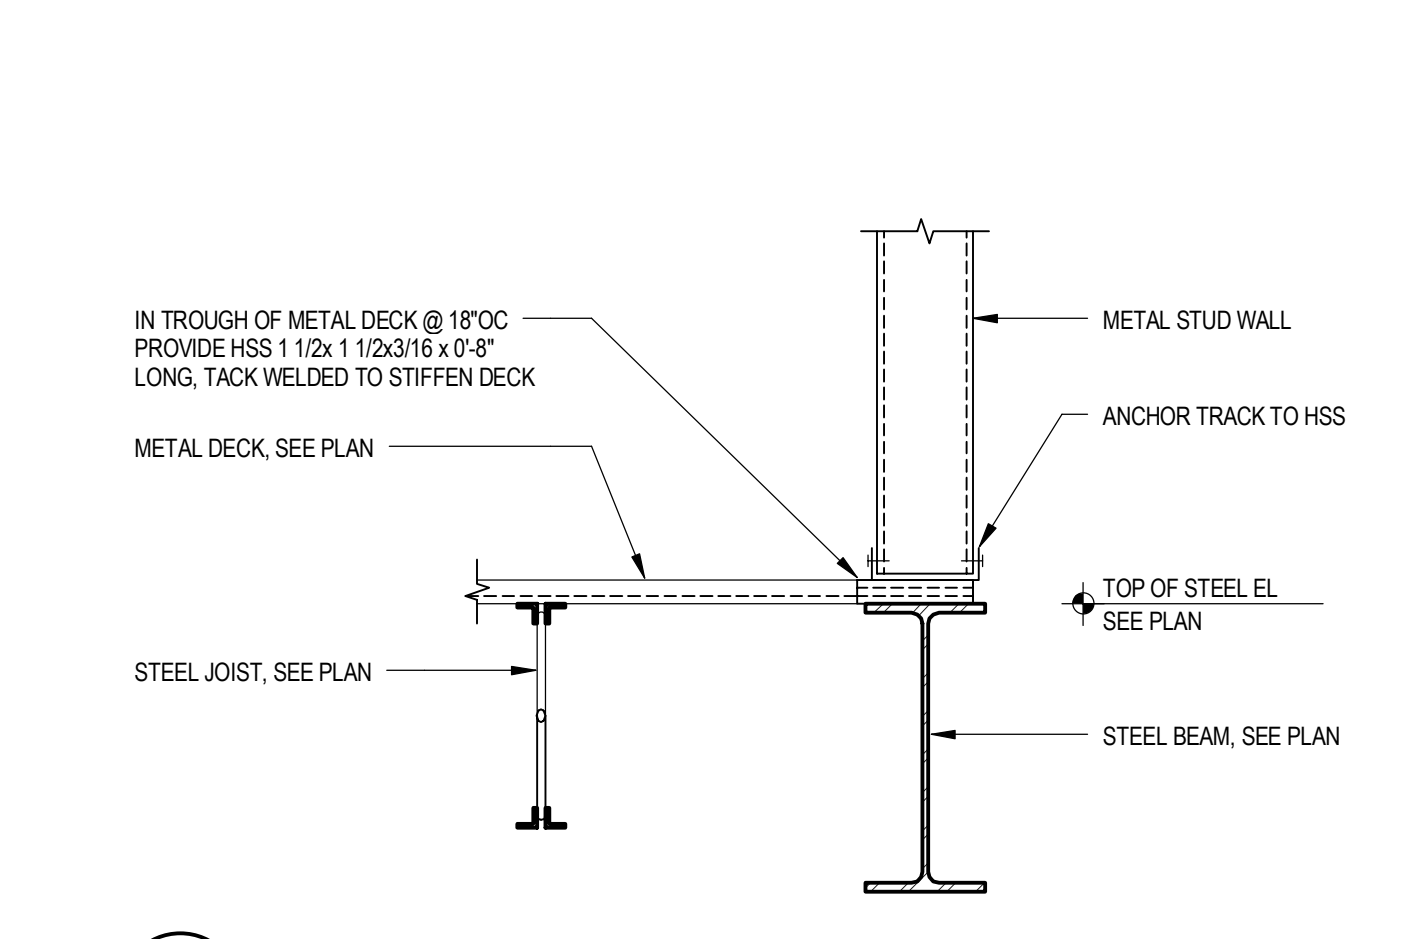


16 SECTION  
S401 SCALE: NTS

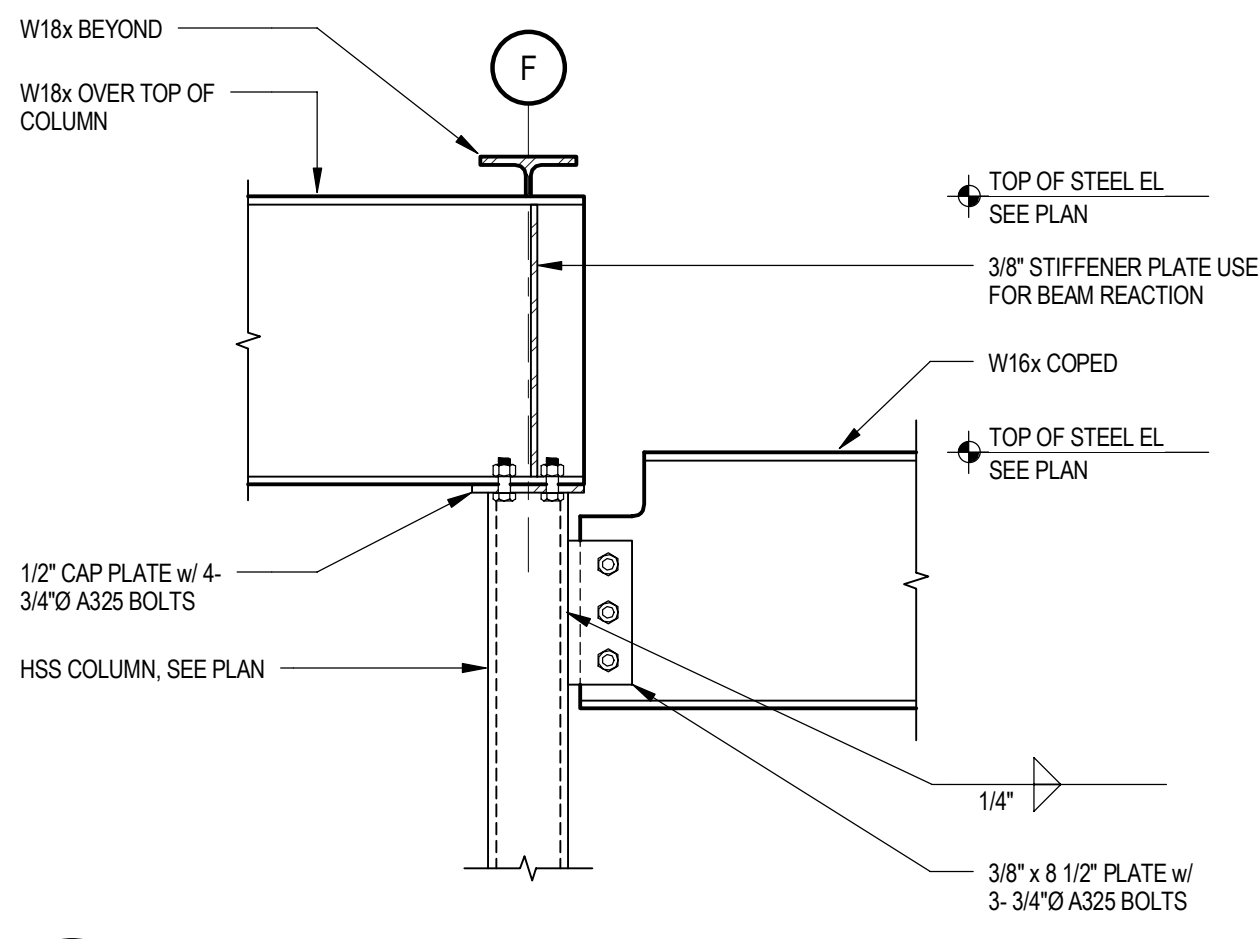


15 SECTION AT HIGH / LOW ROOF  
S401 SCALE: NTS

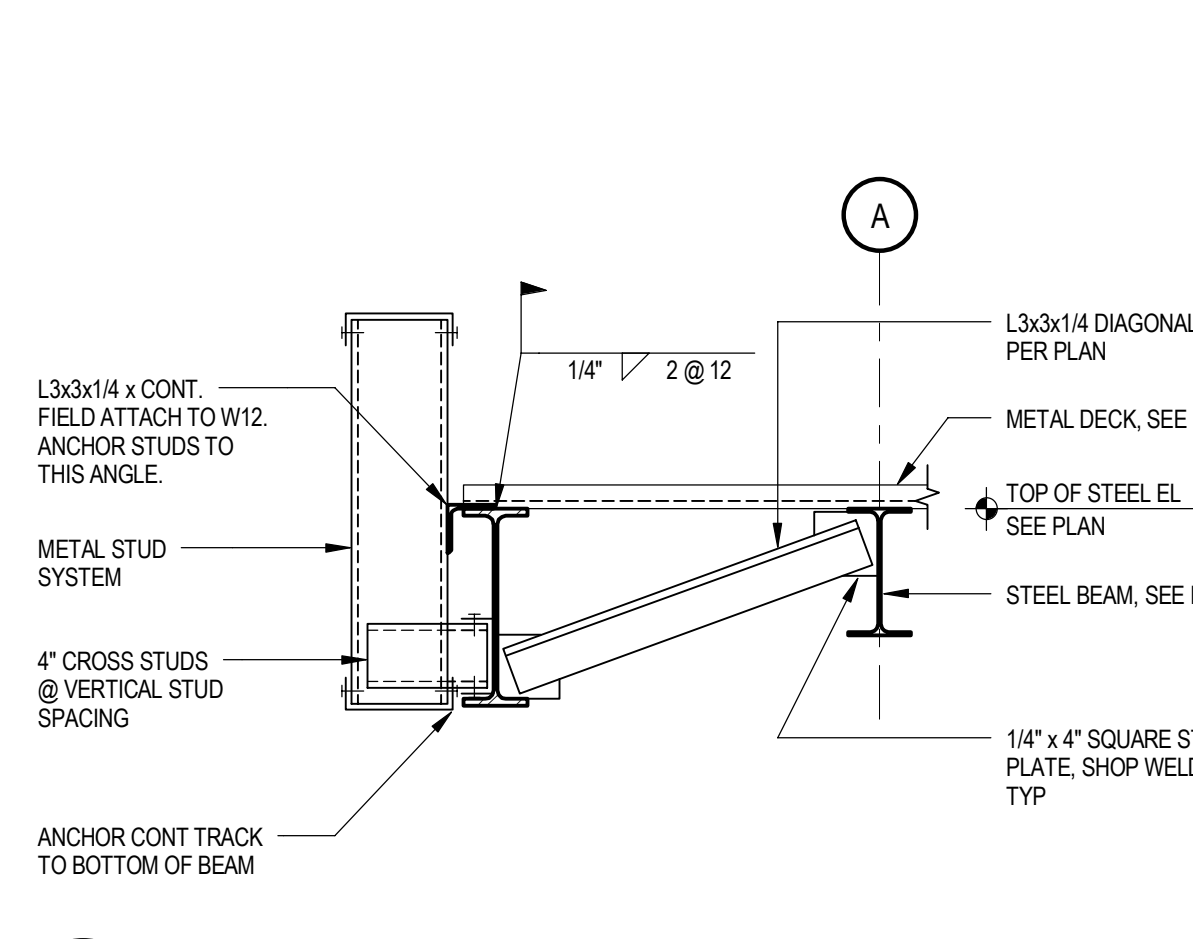


14 SECTION AT ROOF EDGE  
S401 SCALE: NTS

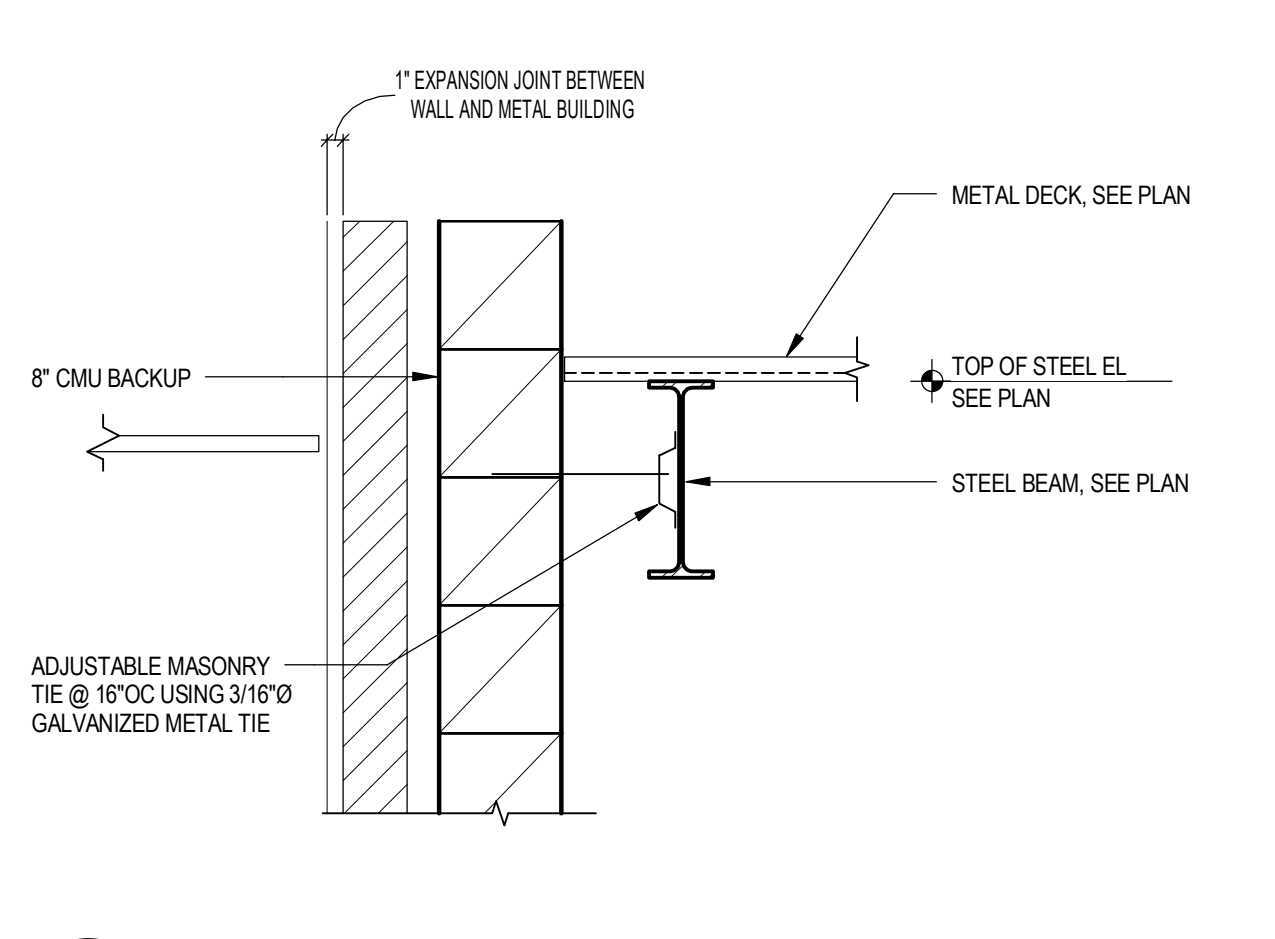


13 ROOF EDGE  
S401 SCALE: NTS

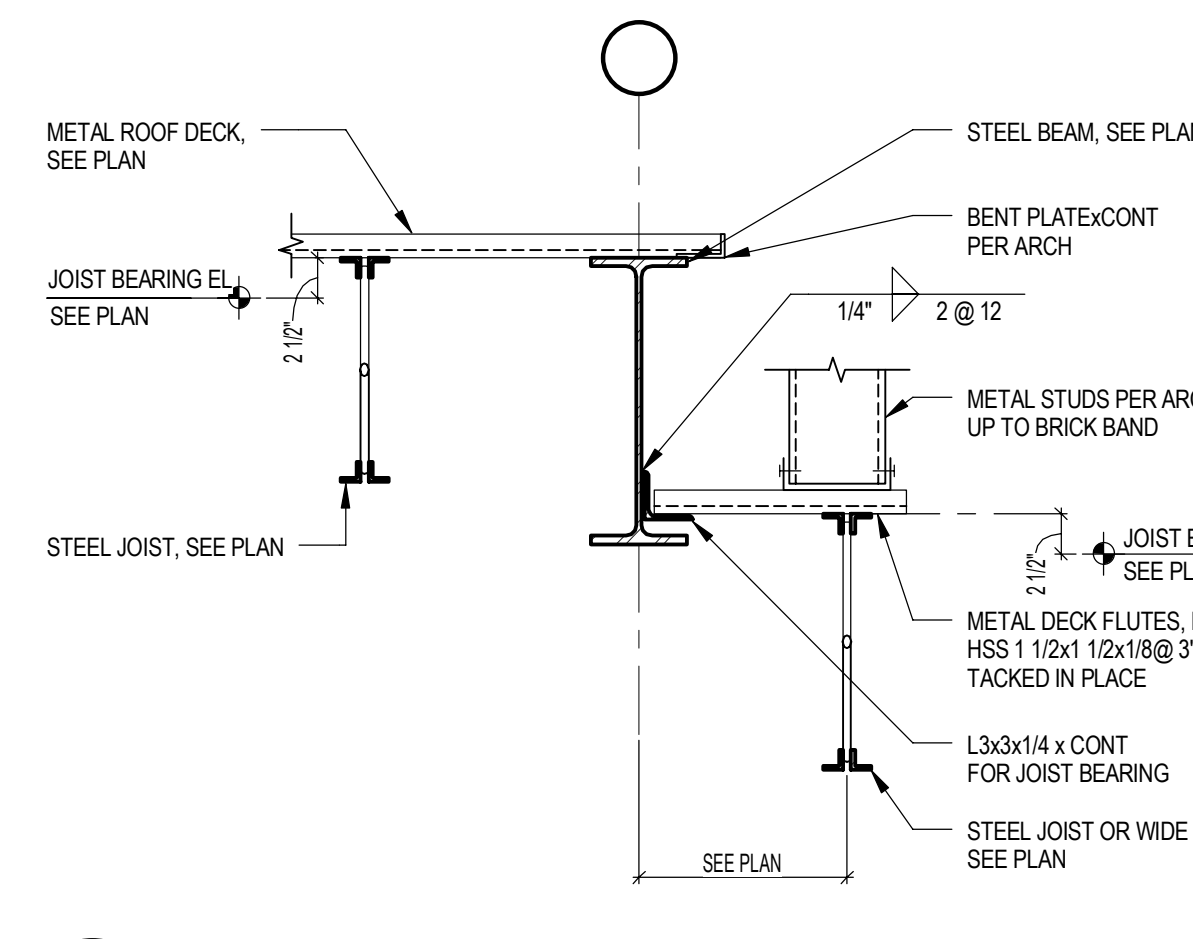


12 SECTION AT HIGH/LOW ROOF CONDITION  
S401 SCALE: NTS

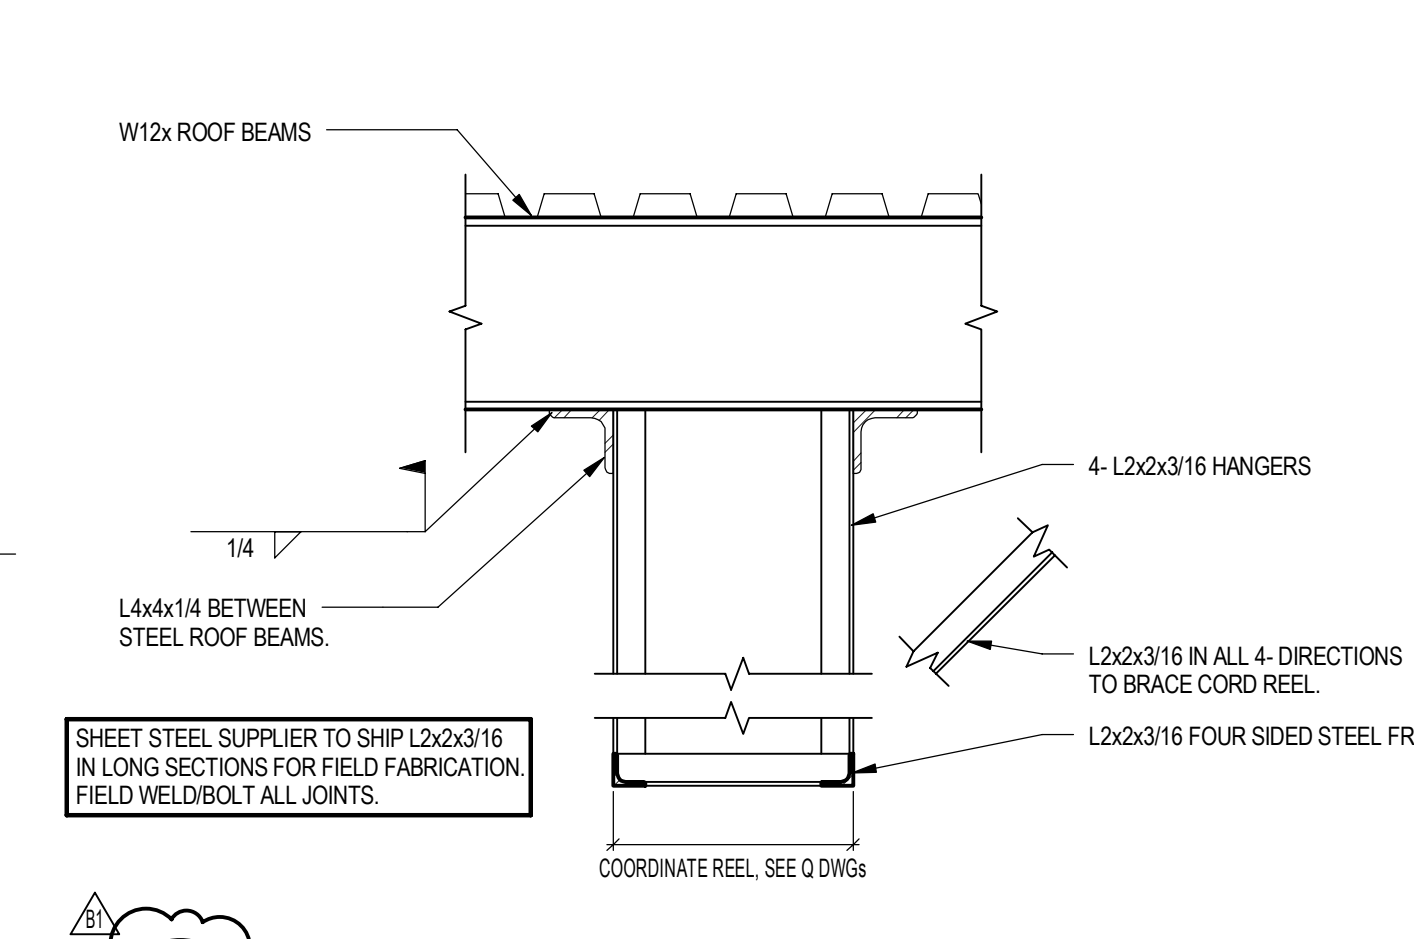


11 CORD REEL SUPPORT @ AUTOPSY 132  
S401 SCALE: NTS

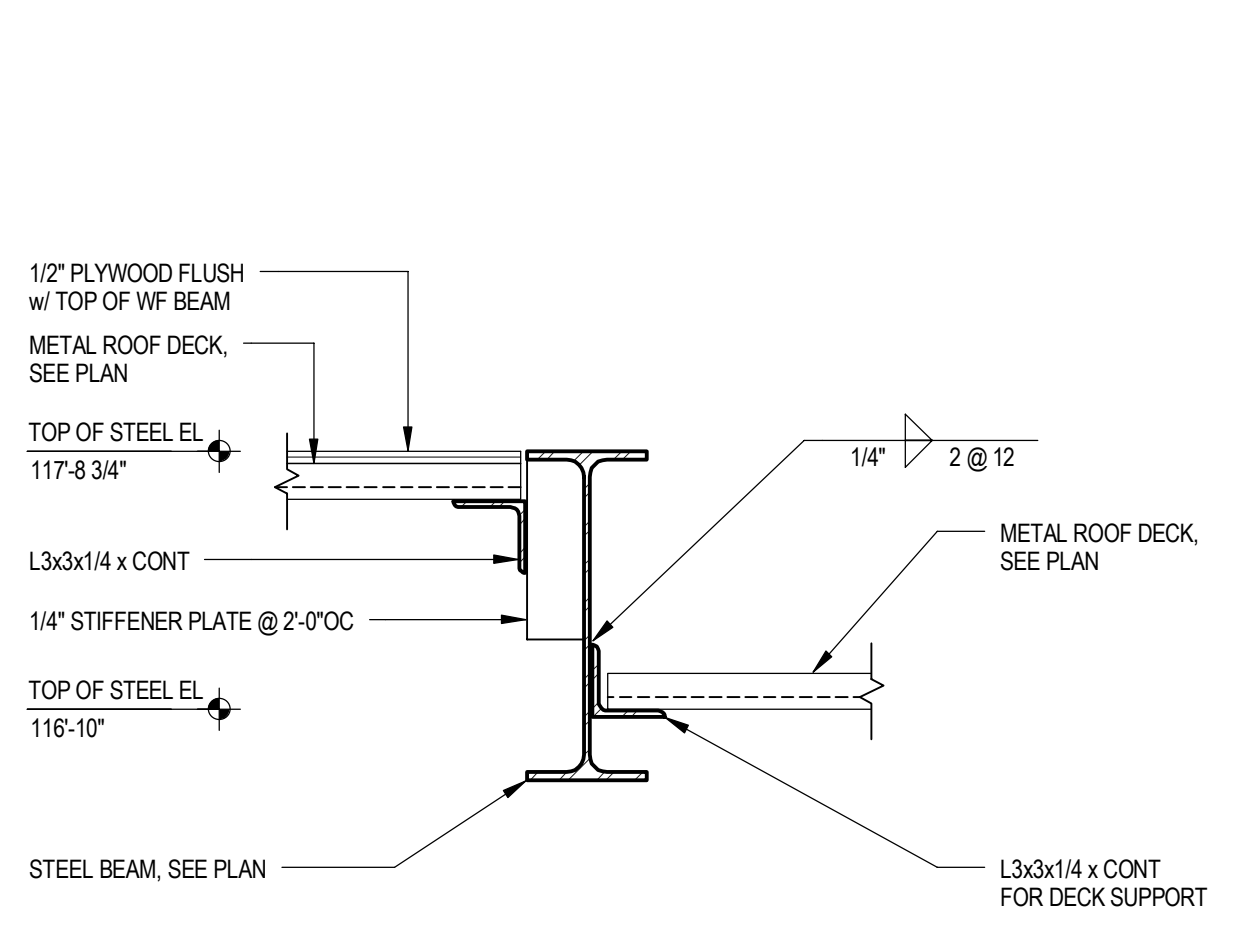


10 SECTION  
S401 SCALE: NTS

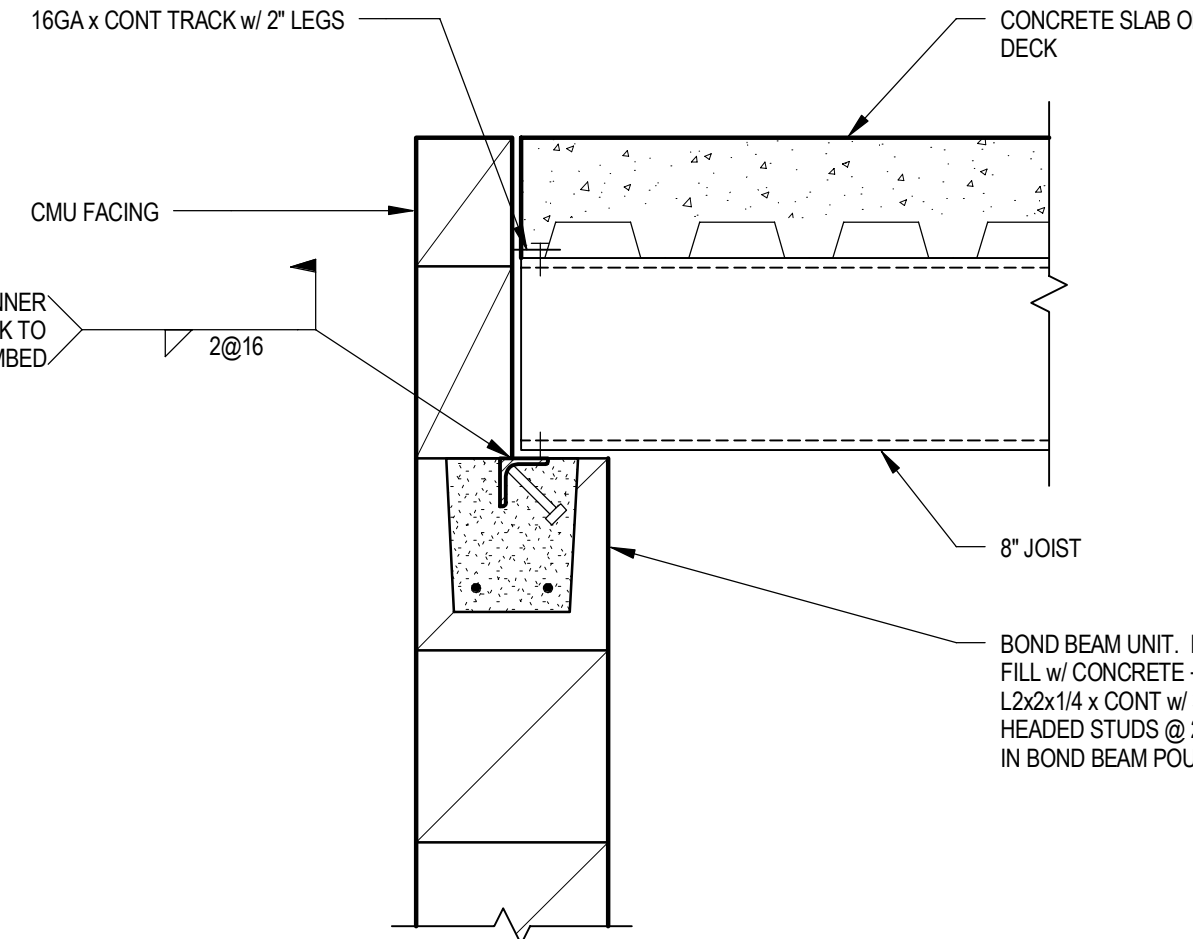


9 METAL JOIST BEARING  
S401 SCALE: NTS

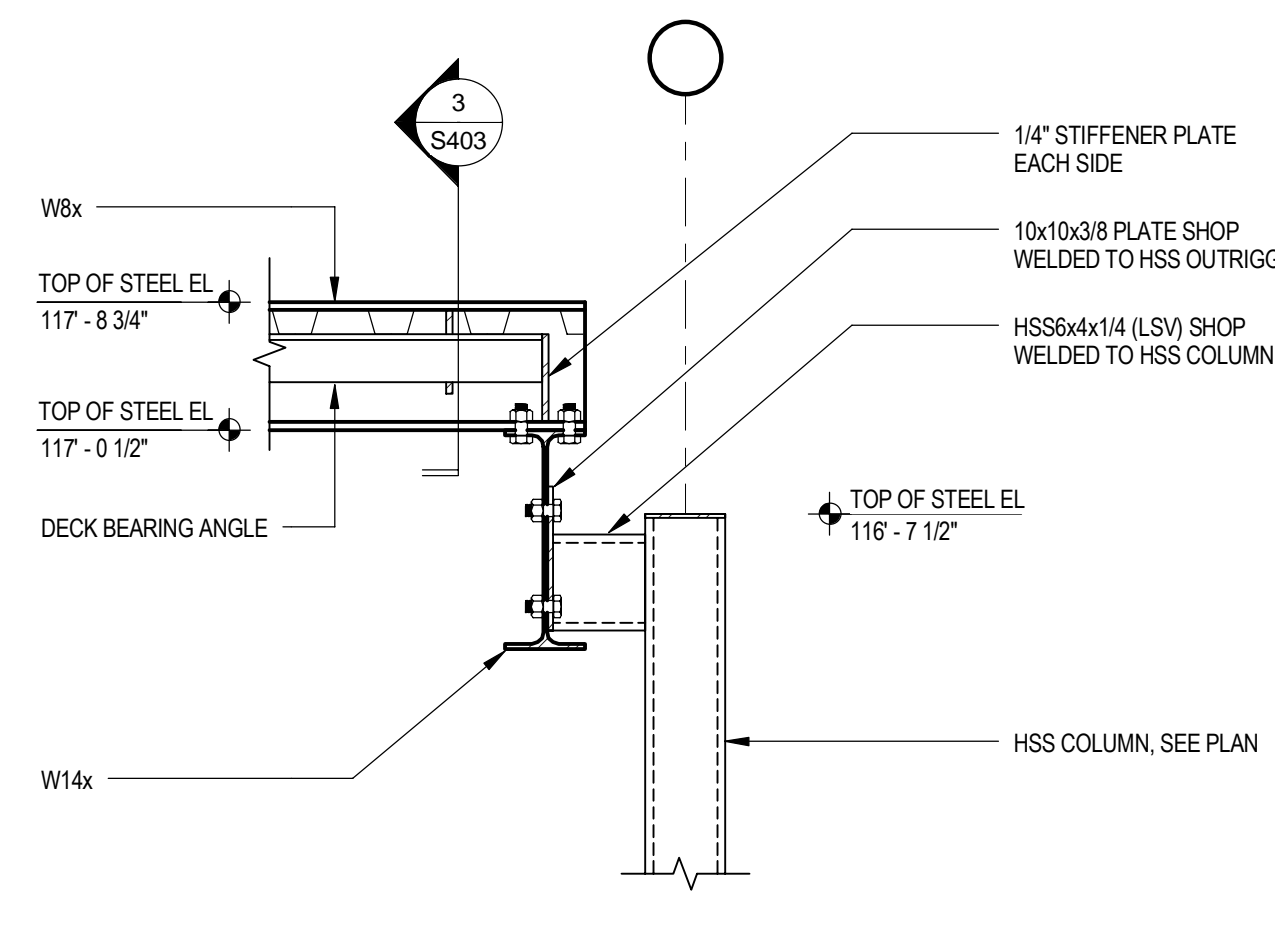


8 SECTION  
S401 SCALE: NTS

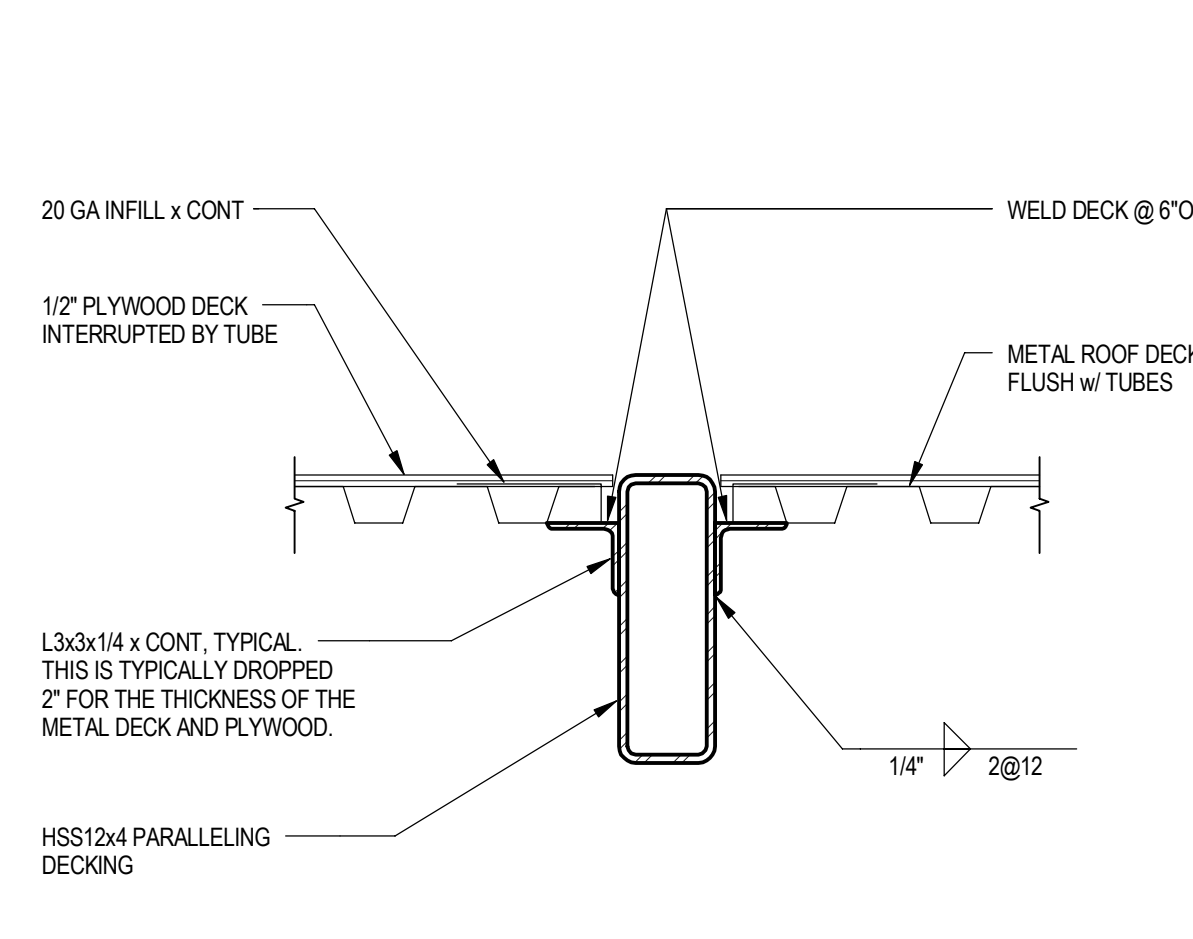


7 SECTION AT OUTRIGGER  
S401 SCALE: NTS

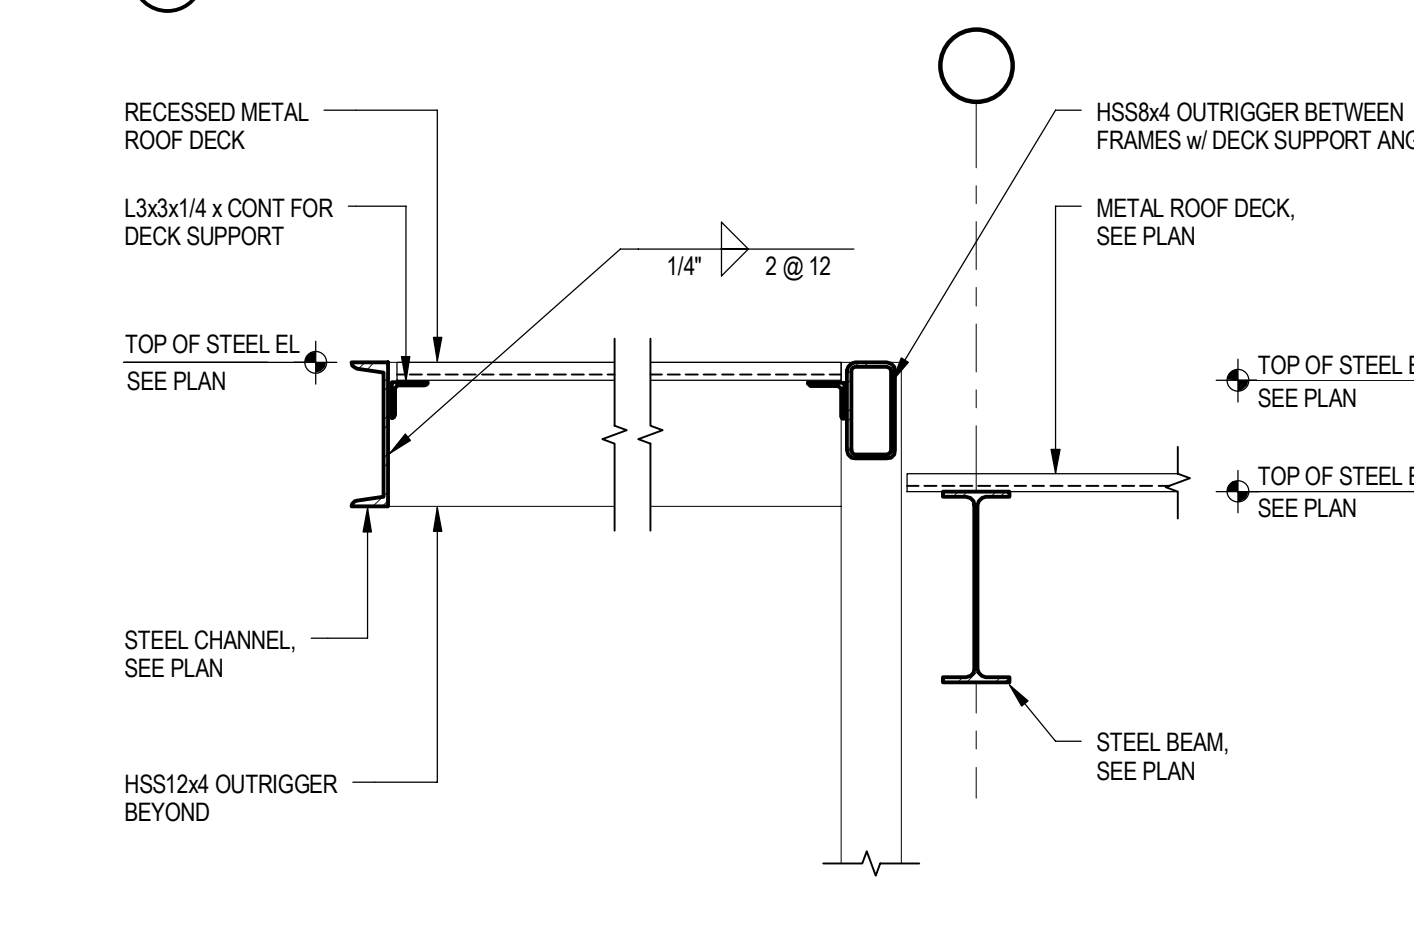


6 DETAIL AT WEST CANOPY BETWEEN FRAMES  
S401 SCALE: NTS

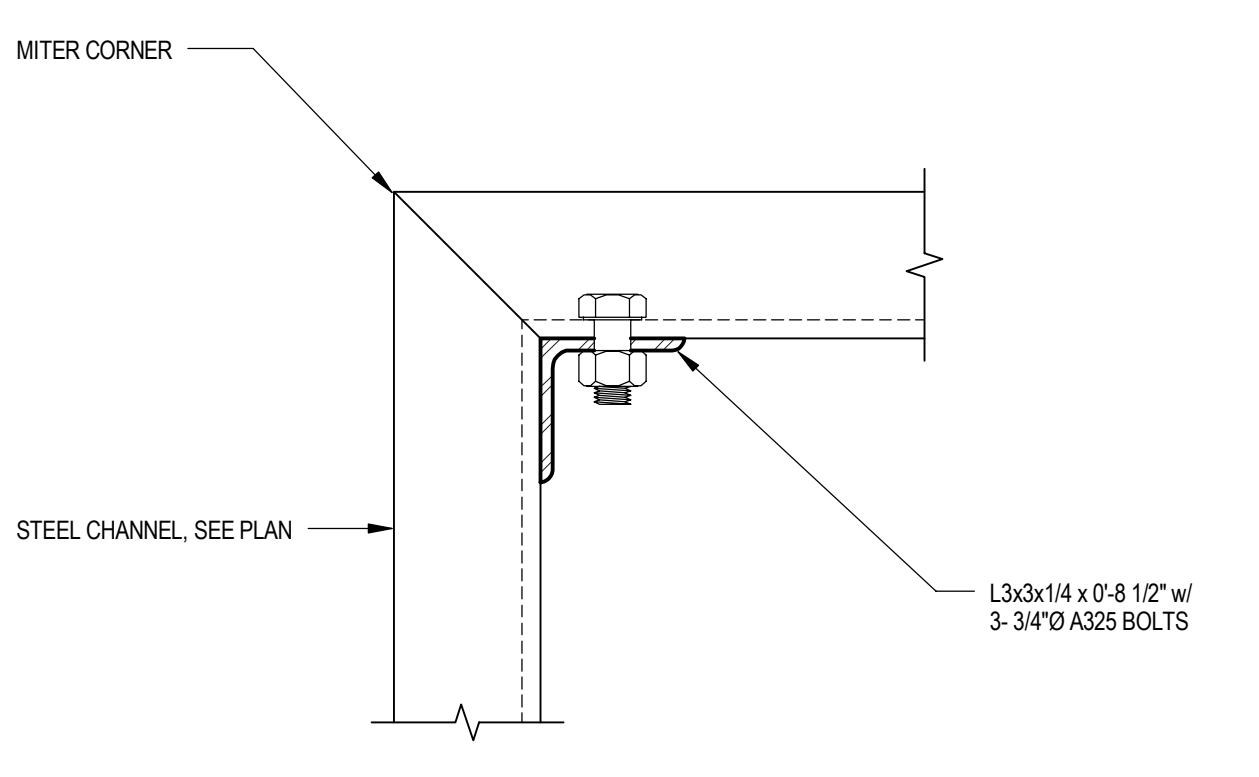


5 CORNER DETAIL  
S401 SCALE: NTS

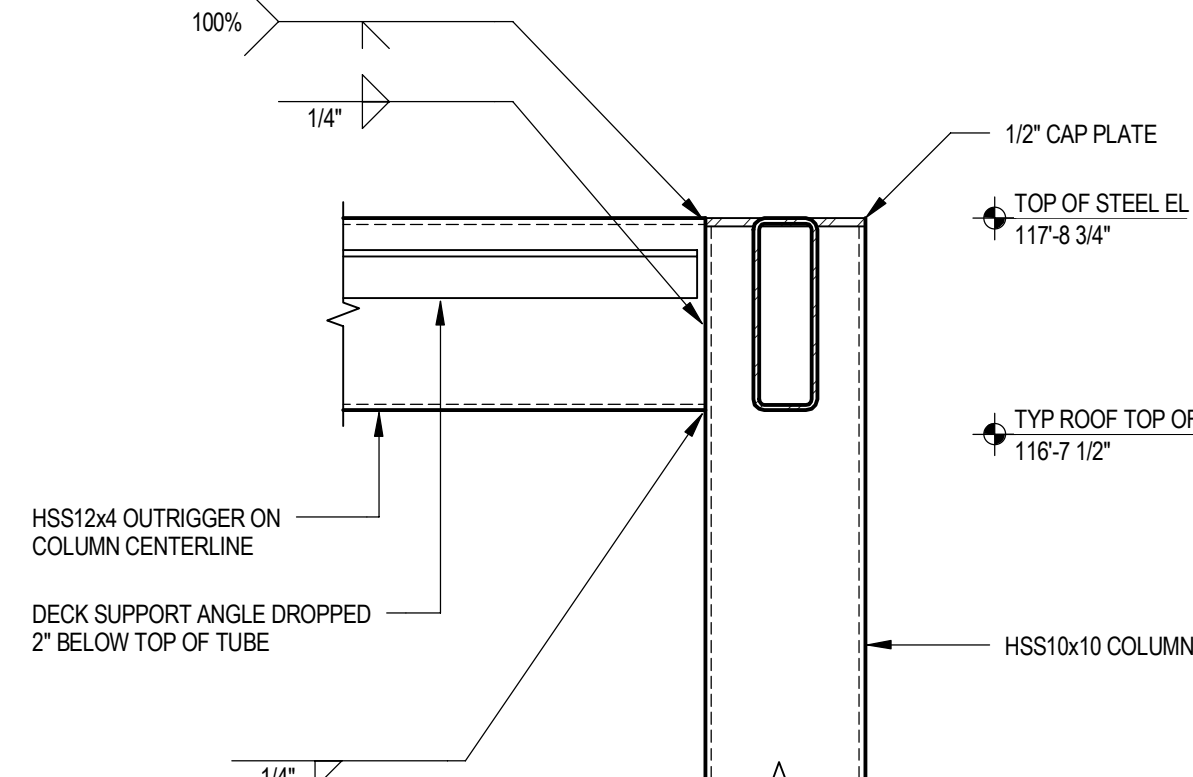


4 SECTION  
S401 SCALE: NTS

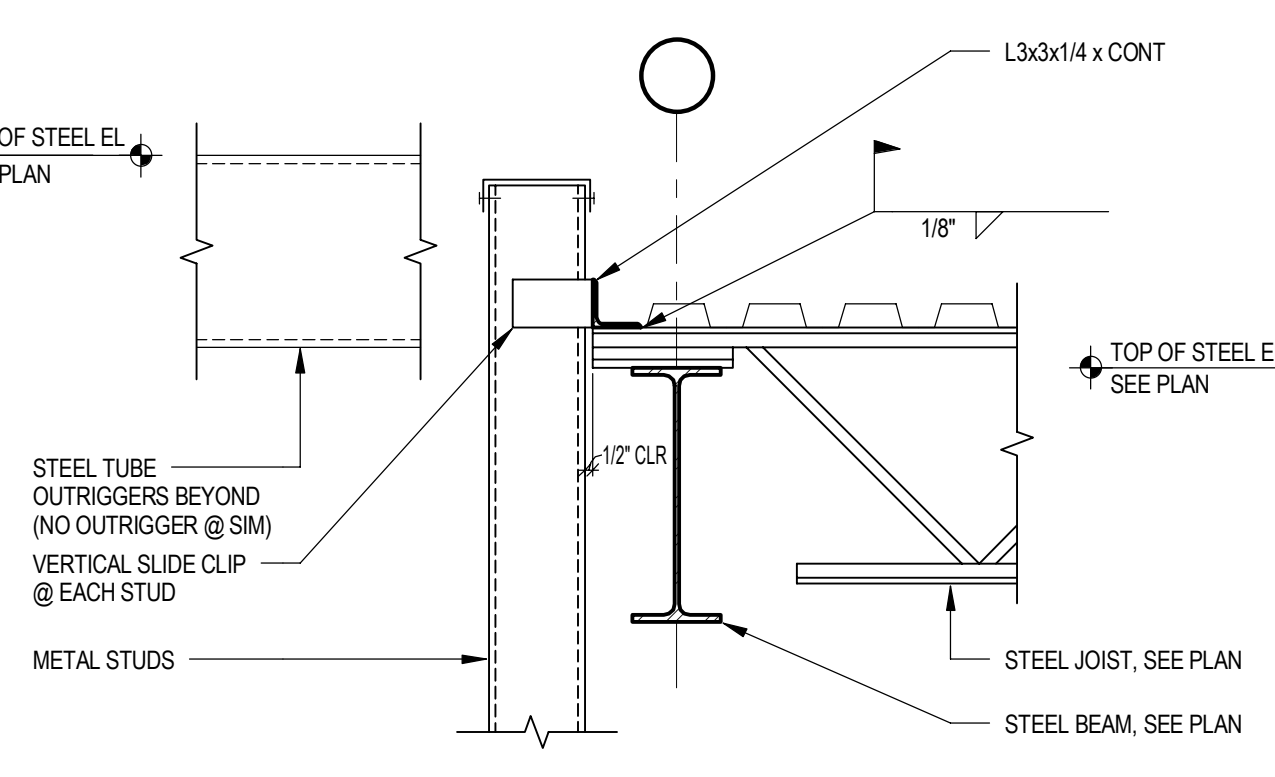


3 SECTION  
S401 SCALE: NTS

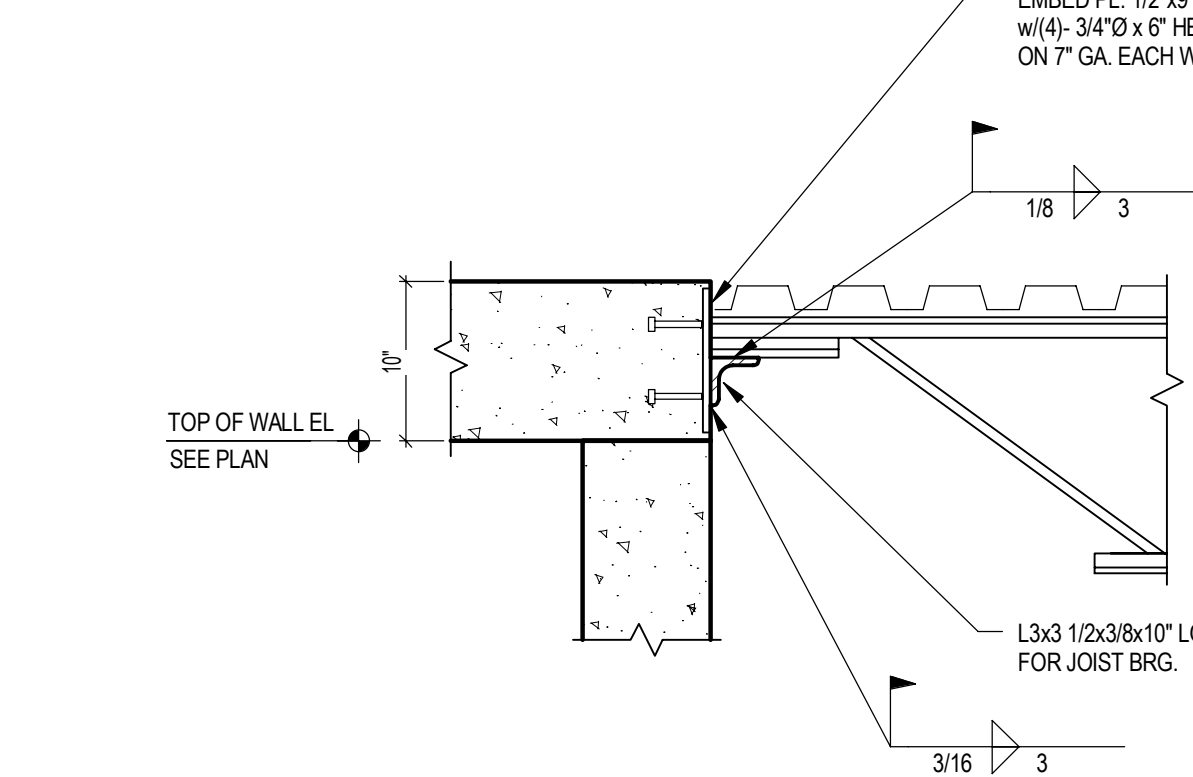


2 SECTION @ RECORDS 107  
S401 SCALE: NTS

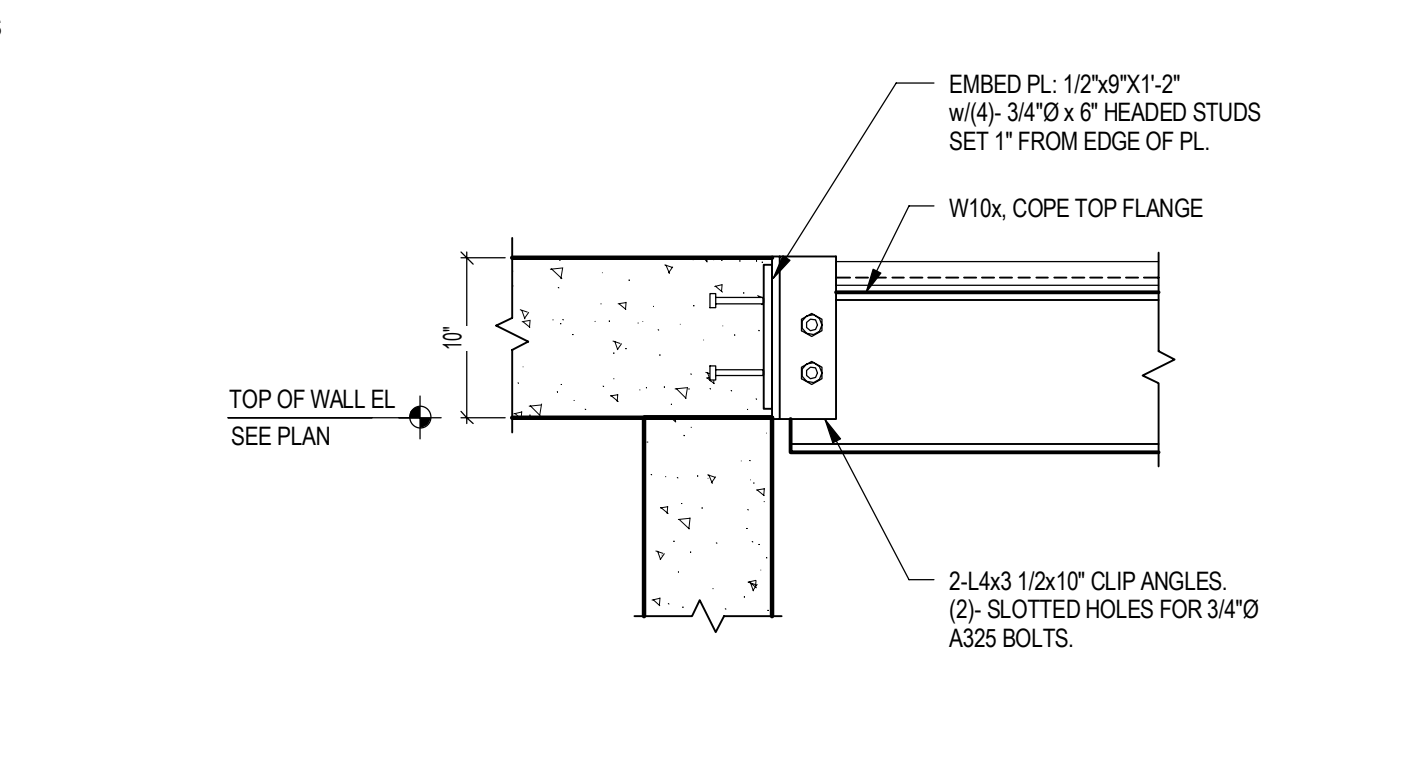

1 SECTION @ RECORDS 107  
S401 SCALE: NTS

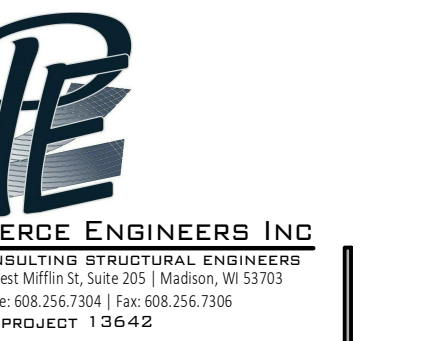

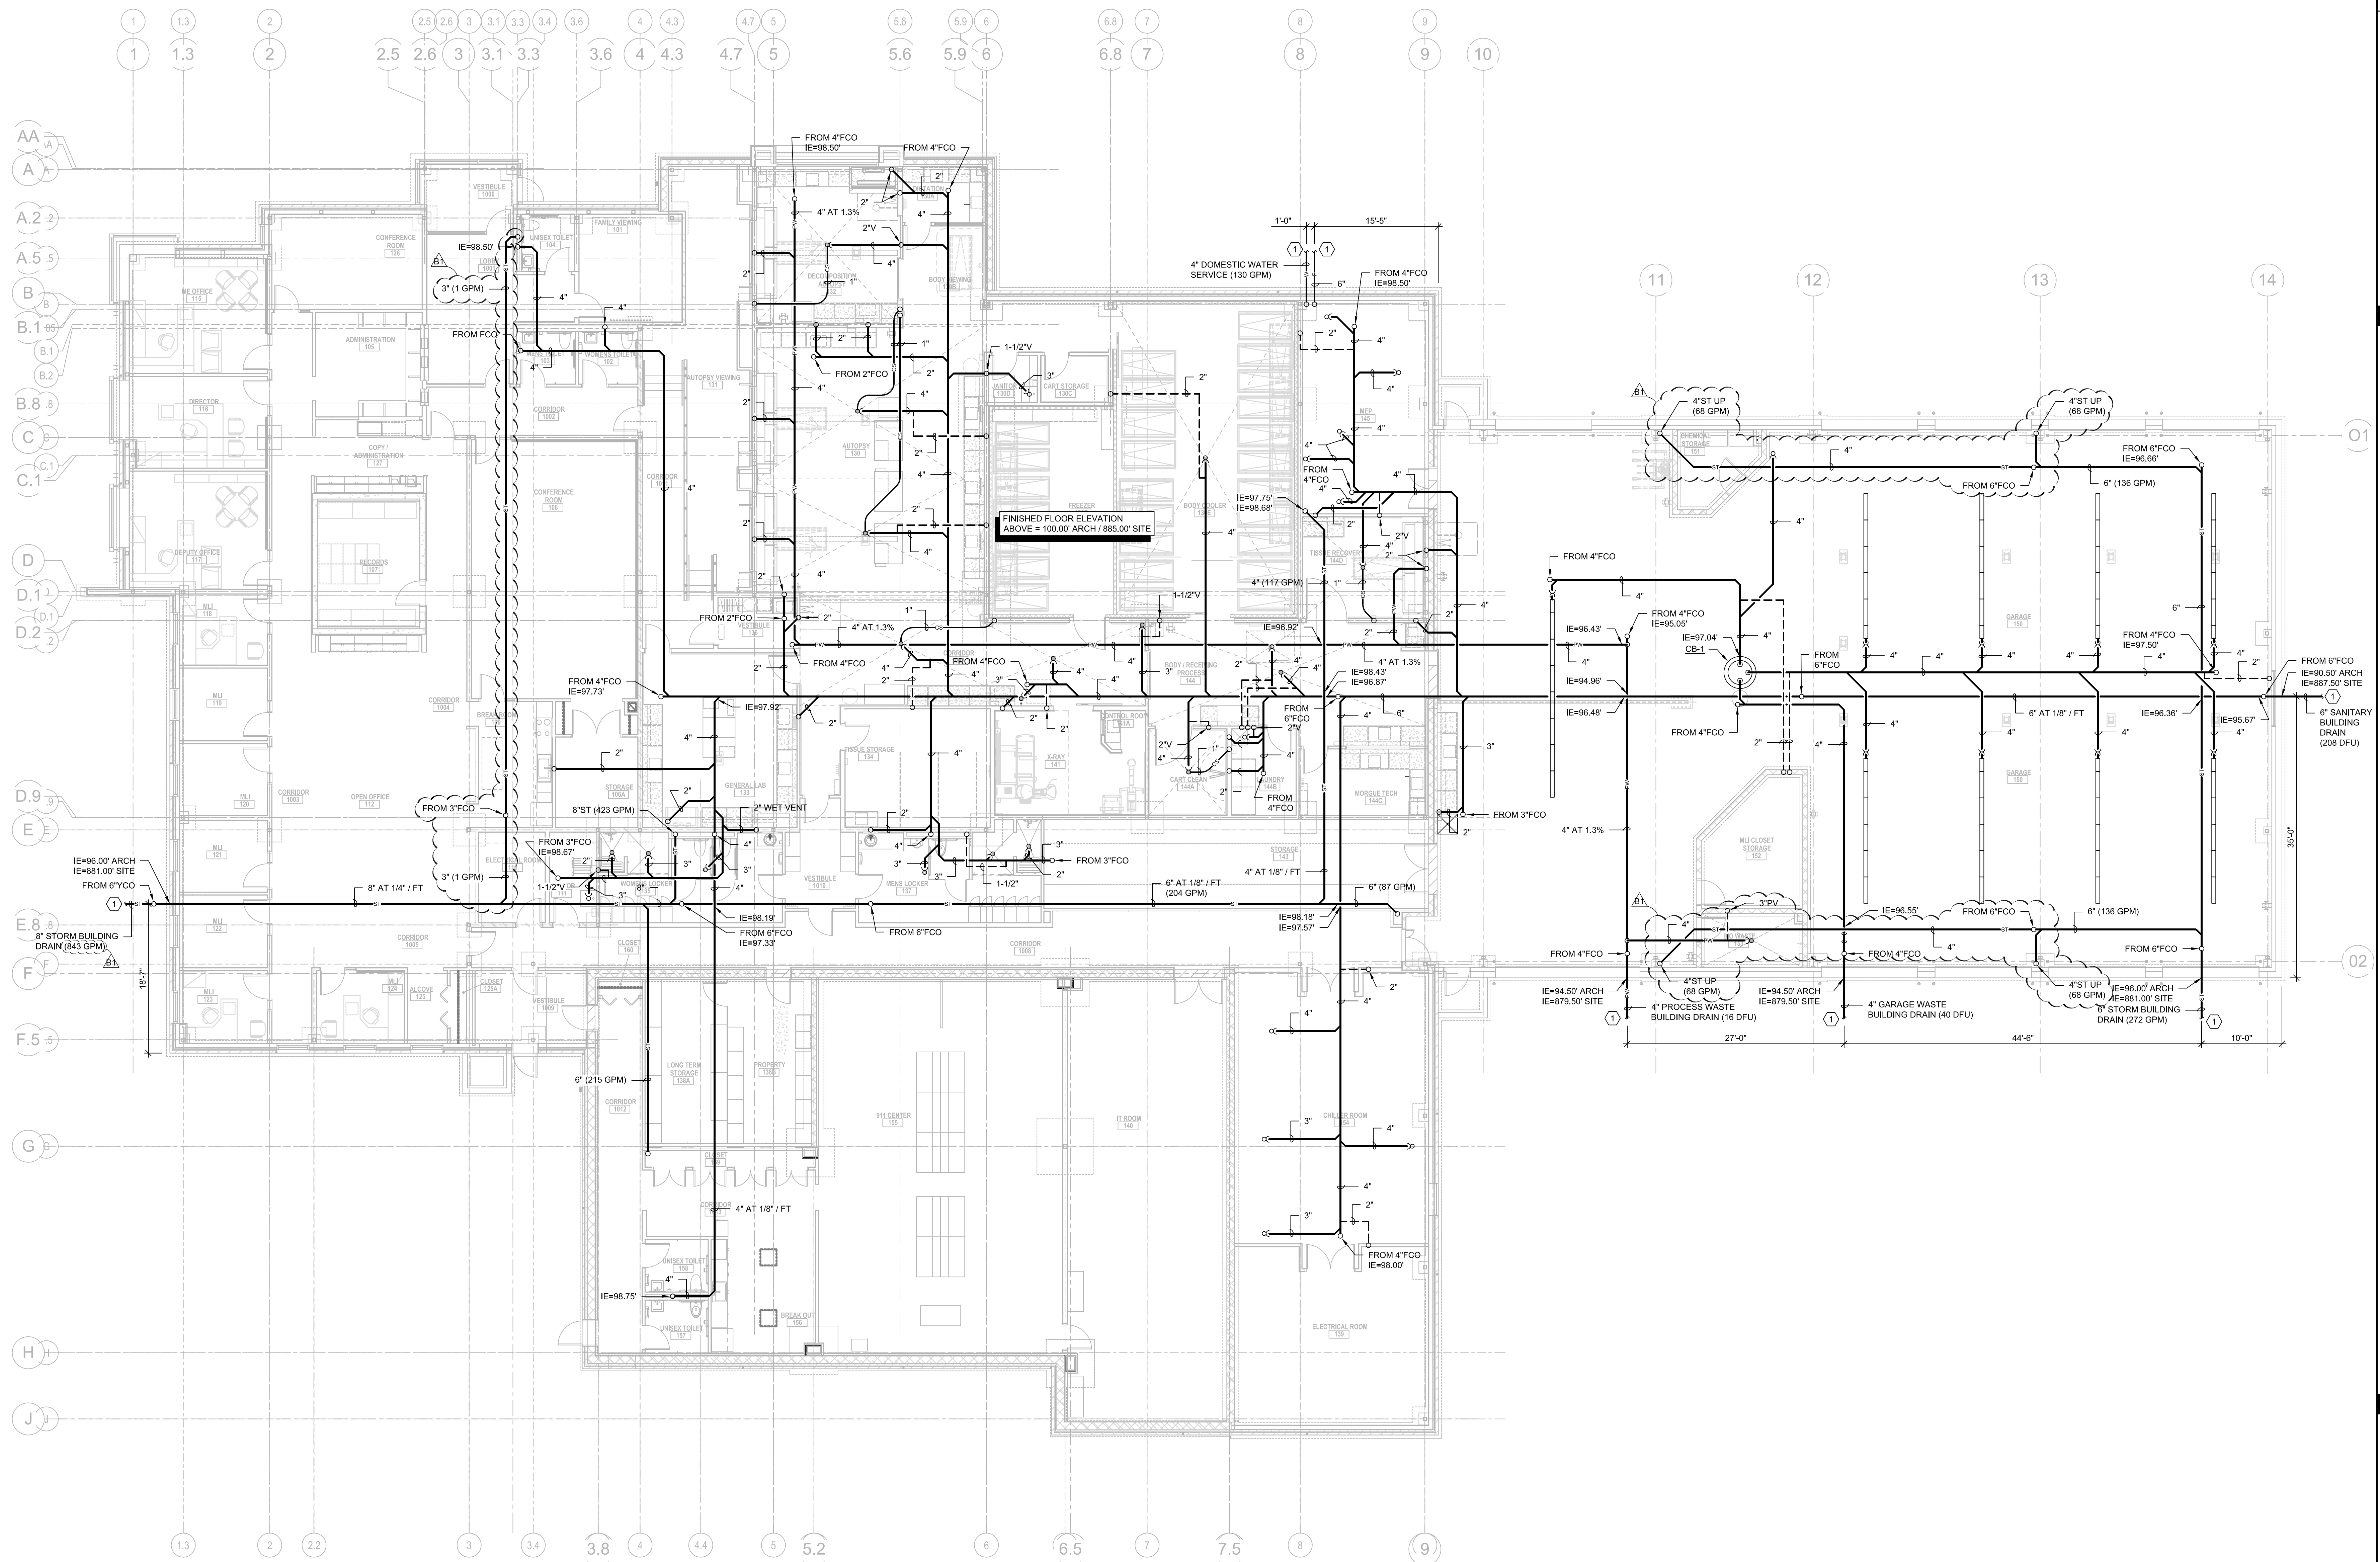

**1** PLUMBING UNDERFLOOR PLAN  
P100 SCALE: 1/8"=1'-0"  
NORTH

**GENERAL NOTES:**  
1. ALL PROCESS WASTE (PW) PIPING UP TO 2" SHALL BE PITCHED AT 1/4" PER FOOT SLOPE, AND PW PIPING 3" AND OVER SHALL BE PITCHED AT 1.3% SLOPE.


**KEYED NOTES:**  
1. PC SHALL ROUTE SERVICE TO 5'-0" OUTSIDE BUILDING STRUCTURE, CONTINUATION BY SITE UTILITY CONTRACTOR. COORDINATE EXACT LOCATION AND DEPTH WITH SITE UTILITY CONTRACTOR.

**PROJECT**  
MEDICAL EXAMINER OFFICE  
BUILDING (BID PACKAGE B)  
3562 COUNTY HIGHWAY AB  
MC FARLAND, WI 53558

**BID NO.**  
313083

**DRAWING**  
PLUMBING  
UNDERFLOOR PLAN

**DATE**  
01.12.15

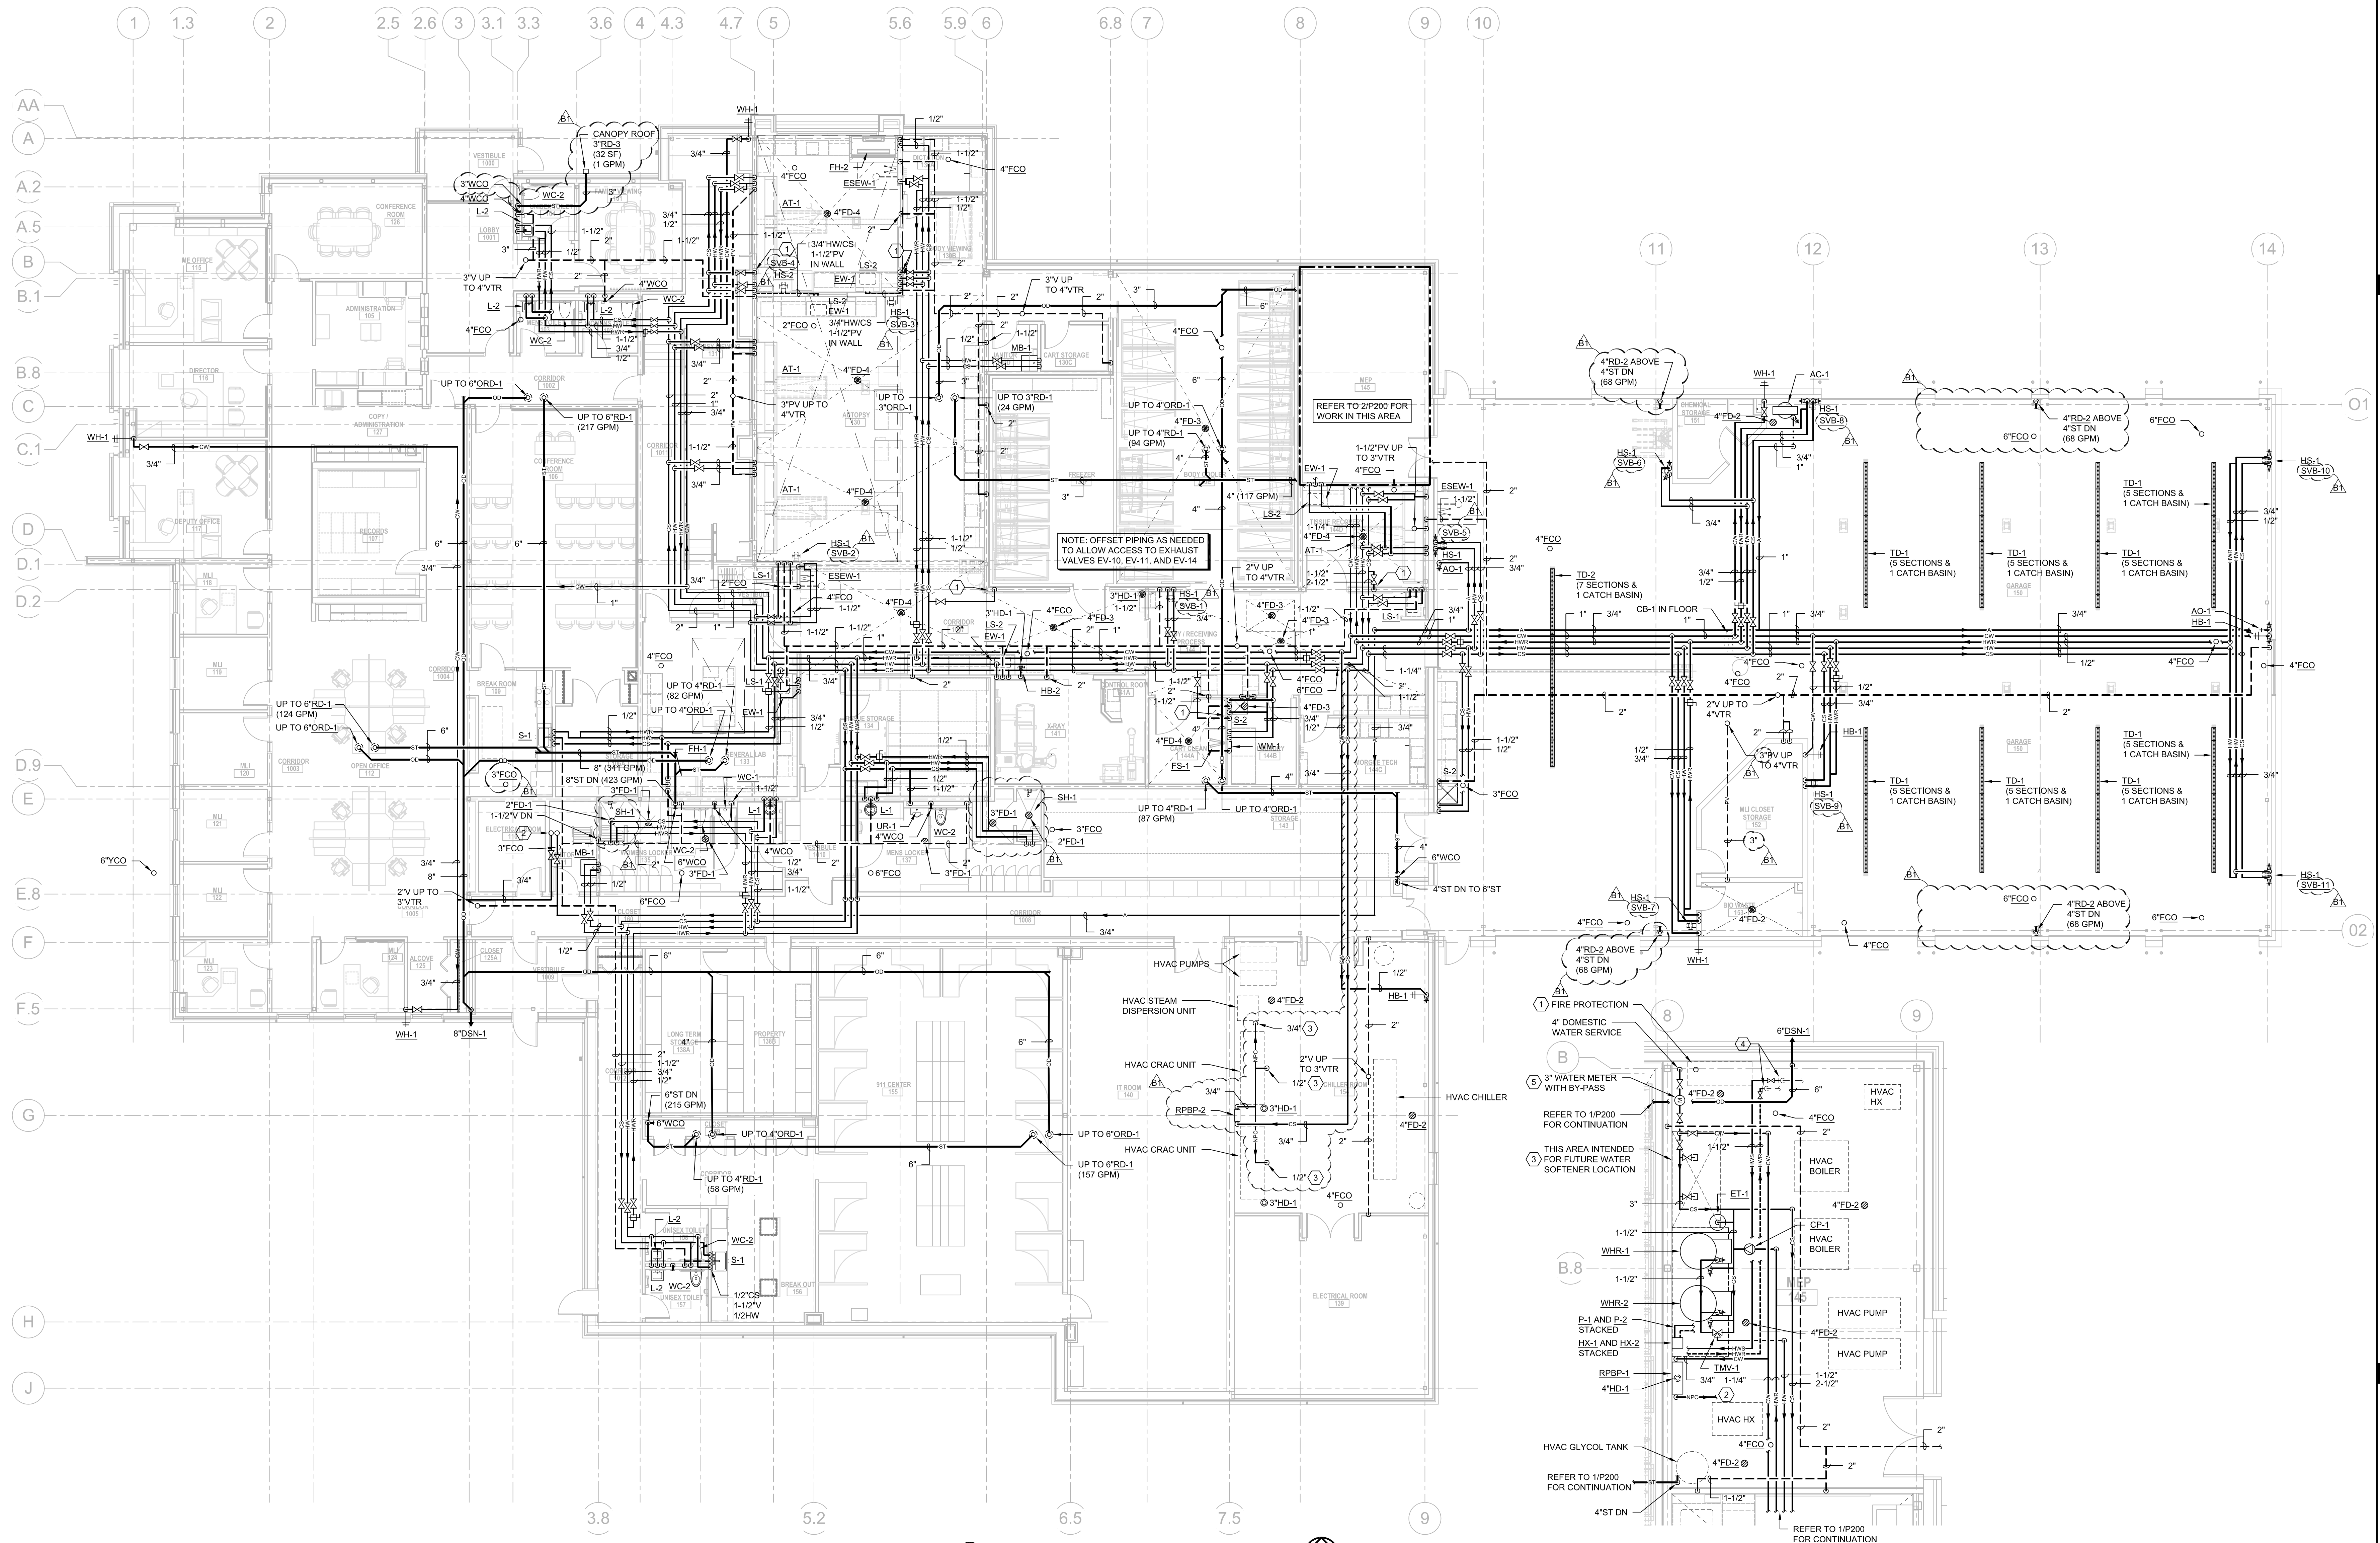

**PLENUM NOTE:**  
RETURN AIR CEILING PLENUMS ARE UTILIZED ON THIS PROJECT IN THE OFFICE AREA OF THE FACILITY. DURING THE COURSE OF CONSTRUCTION, THE CONTRACTOR SHALL ASCERTAIN THAT ALL ROOMS TO WHICH AIR IS SUPPLIED, HAVE RETURN AIR PATHS BACK TO AND THRU THE CEILING PLENUM. ANY SPACES OBSERVED WHICH DO NOT HAVE SUCH OPENINGS SHALL BE REPORTED TO A/E IMMEDIATELY FOR RESOLUTION. PIPING AND DUCTWORK SHALL BE INSTALLED IN SUCH A MANNER SO AS NOT TO BLOCK THE RETURN AIR PATH. RETURN AIR OPENINGS TO SHAFTS & INTAKE DUCTWORK, ALL MATERIALS IN PLENUMS SHALL BE PLENUM RATED NON-COMBUSTIBLE MATERIALS.

**1 PLUMBING FIRST FLOOR PLAN**  
SCALE: 1/8"=1'-0"  
NORTH


- GENERAL NOTES:**
- REFER TO M400 SERIES DRAWINGS FOR BUILDING SECTIONS. COORDINATE ALL PLUMBING PIPING WITH OTHER TRADES.
  - REFER TO LABORATORY DRAWINGS AND SPECIFICATIONS FOR PLUMBING CONNECTIONS TO LAB AND/OR AUTOPSY EQUIPMENT AND FIXTURES. ALL PLUMBING RELATED CONNECTIONS BY PC.
- KEYED NOTES:**
- FLUSH VALVE LOCATION FOR FLUSHING FLOOR DRAIN FD-4.
  - INSTALL 3/4" CW AND 3/4" UP TO PENTHOUSE. PENETRATE EXTERIOR WALL OF PENTHOUSE, AND INSTALL WH-1 AND ΔD-1 THRU WALL FOR EQUIPMENT MAINTENANCE ON ROOF.
  - COORDINATE NPC CONNECTION TO HVAC EQUIPMENT WITH HC.

**2 ENLARGED MECHANICAL ROOM - PLUMBING**  
SCALE: 1/4"=1'-0"  
NORTH

- KEYED NOTES:**
- PROVIDE 6" BLIND FLANGE FOR FIRE PROTECTION SERVICE. CONTINUATION BY FPC.
  - PROVIDE 3/4" NPC FOR BOILER MAKE-UP WATER. COORDINATE WITH HC.
  - DOMESTIC WATER CAMPUS SYSTEM SOFTENED BY COUNTY INFRASTRUCTURE PROJECT. THIS AREA IS DESIGNATED FOR FUTURE SOFTENERS IN THE EVENT THE CAMPUS WATER SYSTEM IS NO LONGER SOFTENED.
  - PC SHALL CONNECT TO 1-1/2" TAPS ON HEATING HOT WATER SUPPLY AND RETURN PIPES (HWS AND HWR). HWS/HWR MAINS AND TAPS INSTALLED BY HC. COORDINATE CONNECTIONS WITH HC.
  - PC SHALL PROVIDE 3" BADGER RECORDALL WATER METER FOR BUILDING DOMESTIC WATER SERVICE AND THE IN TO BUILDING AUTOMATION SYSTEM. COORDINATE WITH HCBAS CONTRACTOR.

ISSUE

01.12.15 CONSTRUCTION DOCUMENTS  
02.12.15 ADDENDUM B1

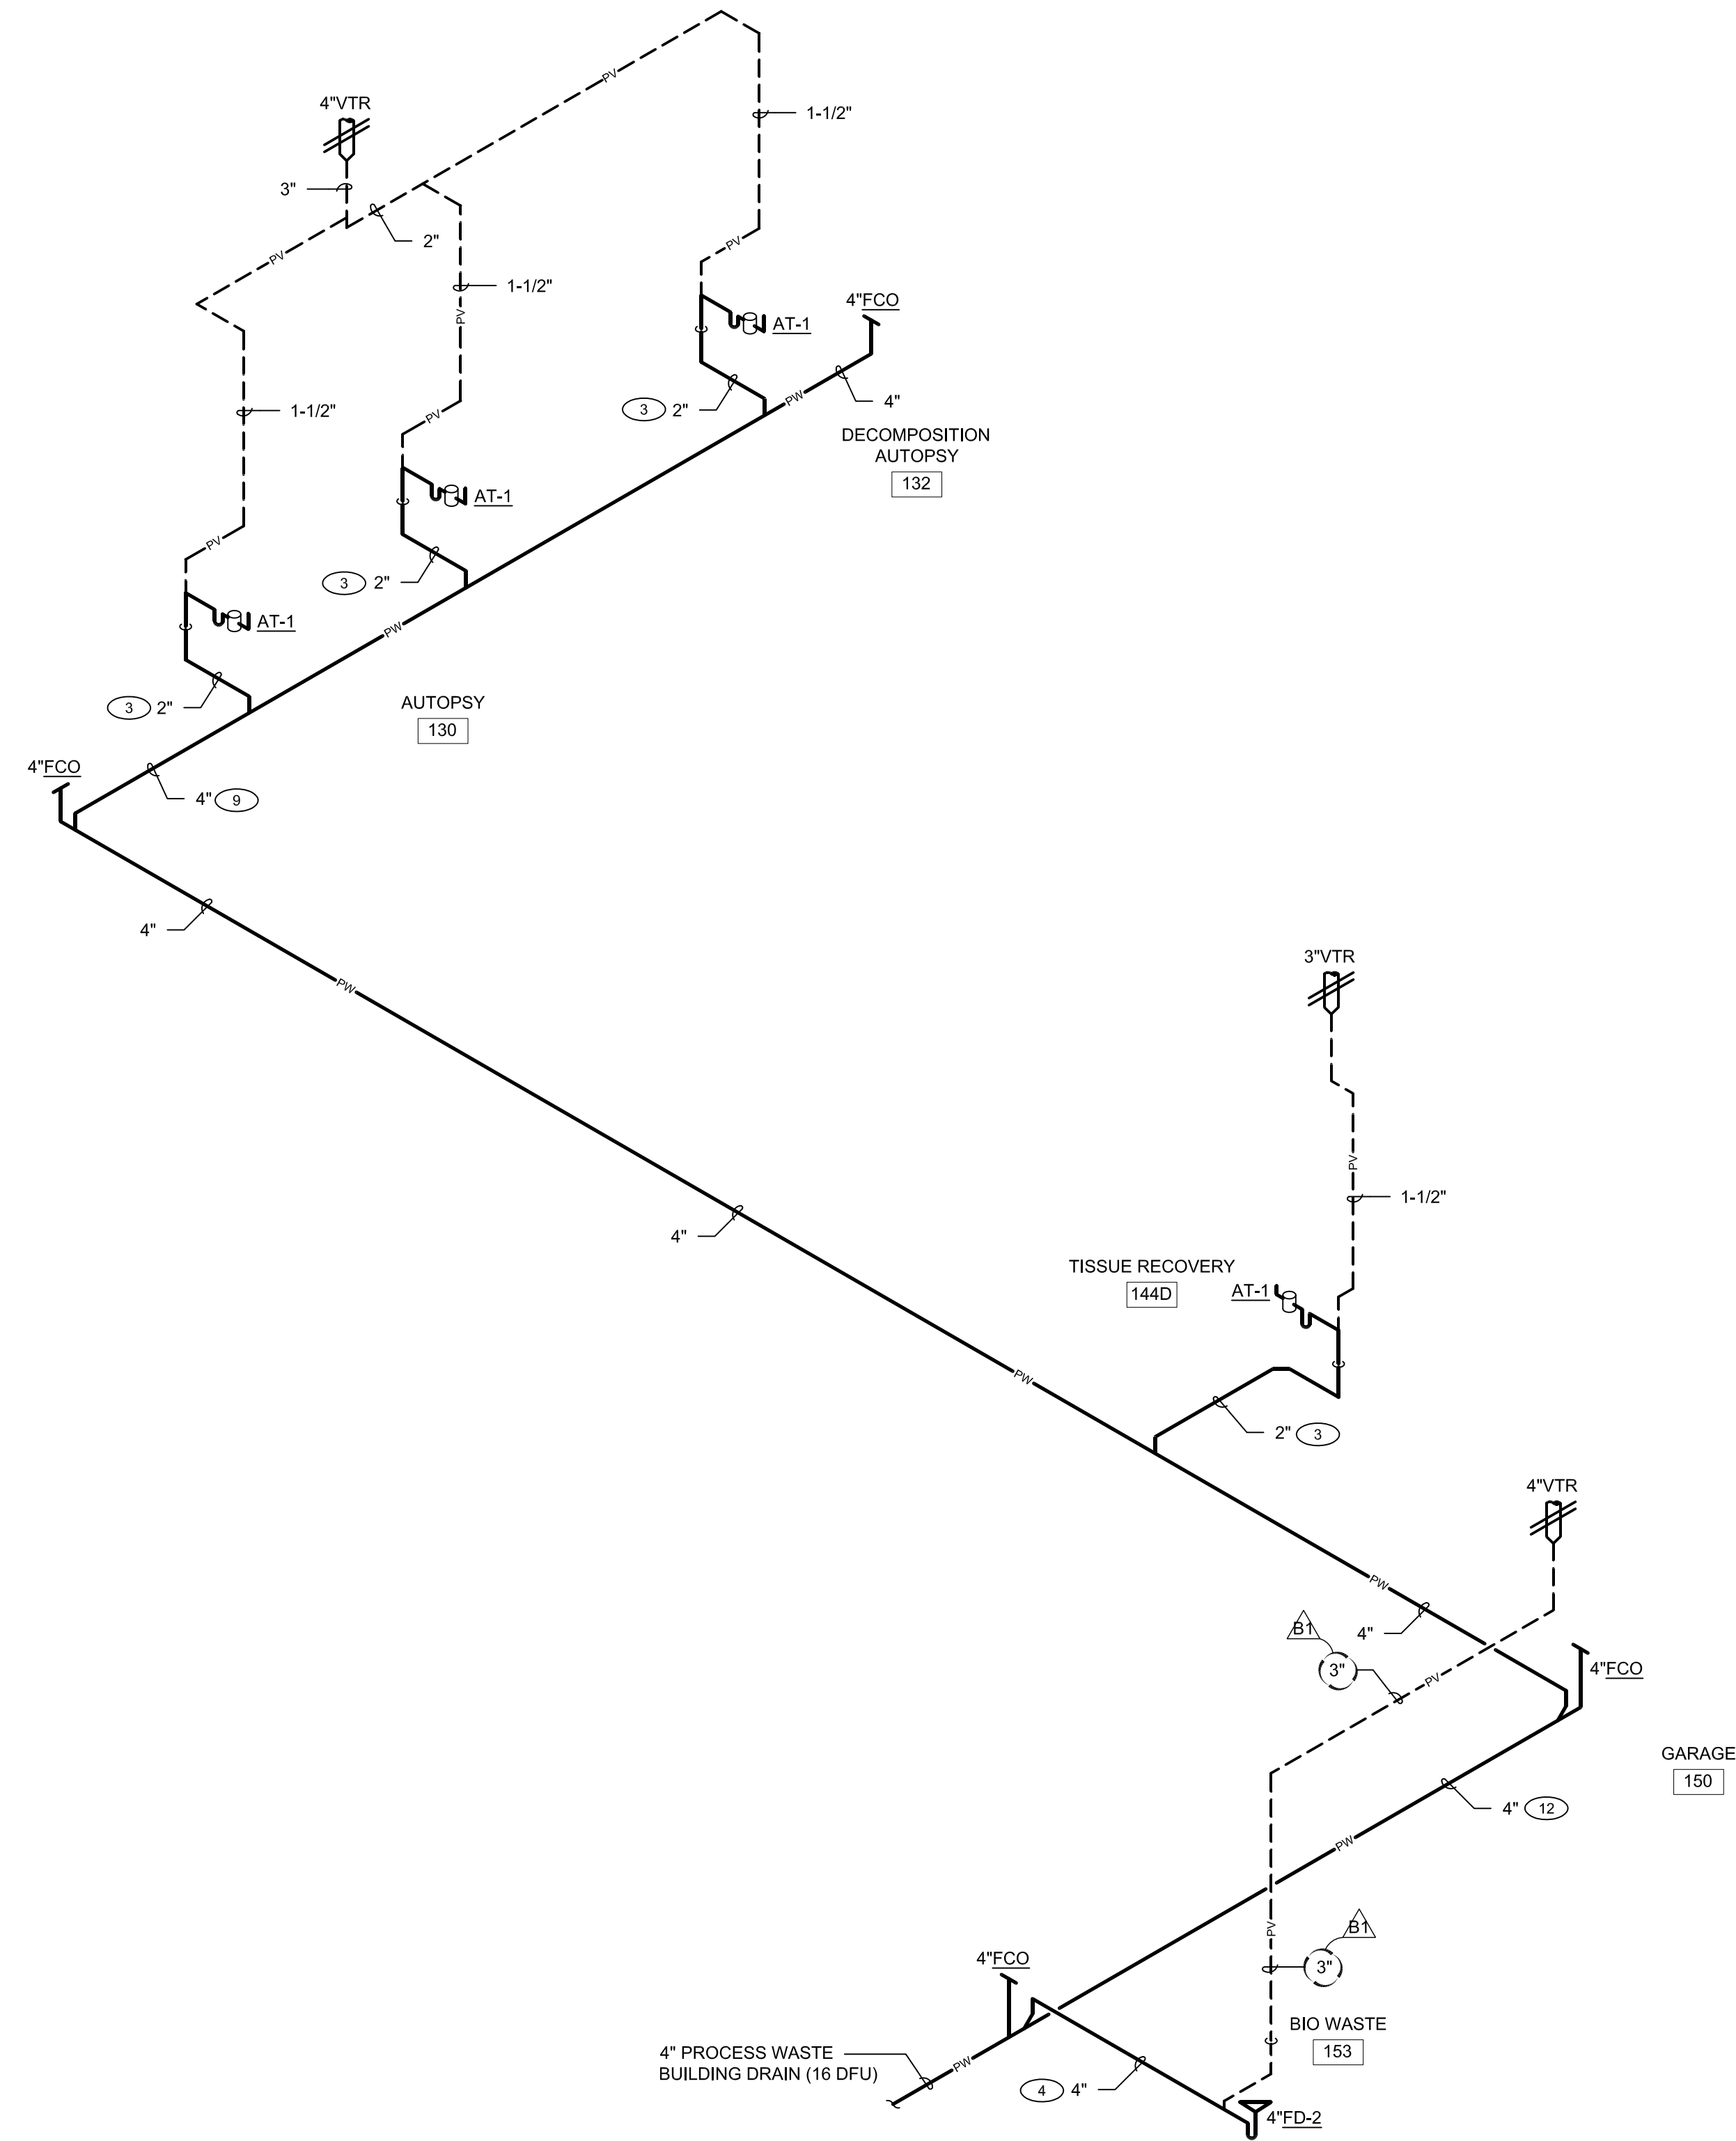

1 PLUMBING PROCESS WASTE ISOMETRICS  
P701 SCALE: NONE


**PROJECT**  
MEDICAL EXAMINER OFFICE  
BUILDING (BID PACKAGE B)  
3562 COUNTY HIGHWAY AB  
MC FARLAND, WI 53558

**BID NO.**  
313083

**DRAWING**  
PLUMBING PROCESS  
WASTE AND VENT  
ISOMETRICS

**DATE**  
01.12.15



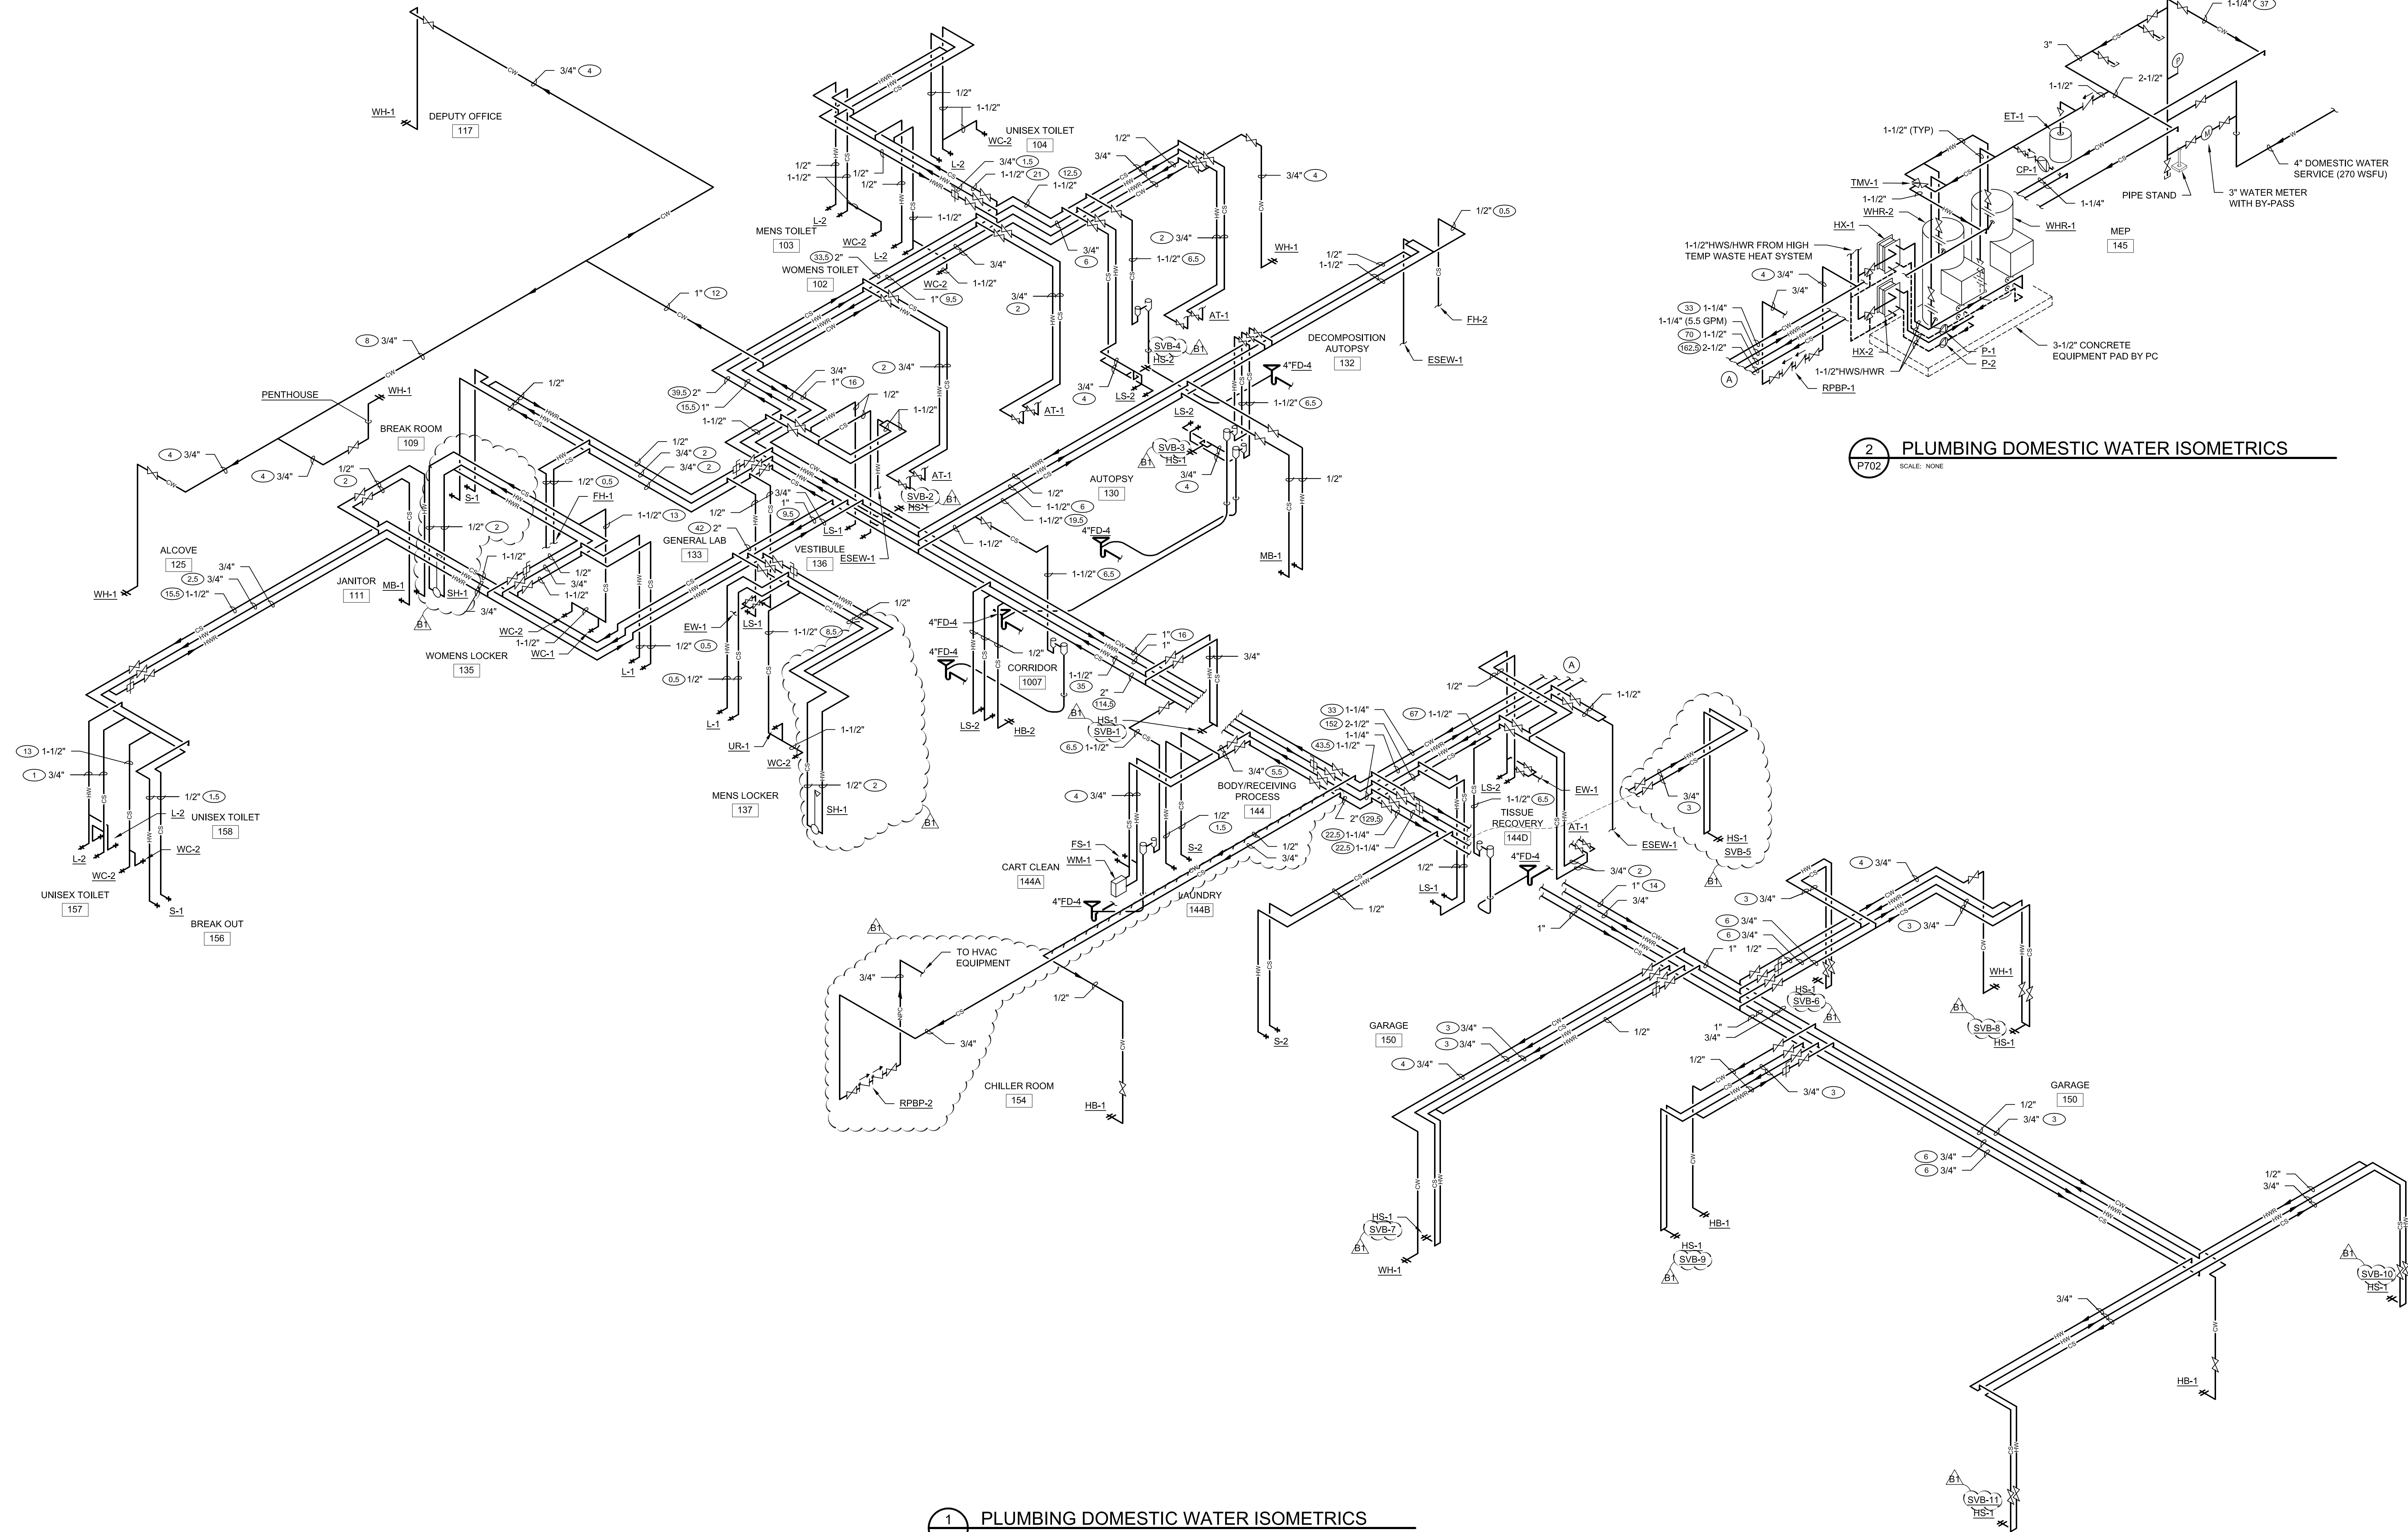

2 PLUMBING DOMESTIC WATER ISOMETRICS  
P702 SCALE: NONE

1 PLUMBING DOMESTIC WATER ISOMETRICS  
P702 SCALE: NONE

**PROJECT**  
MEDICAL EXAMINER OFFICE  
BUILDING (BID PACKAGE B)  
3562 COUNTY HIGHWAY AB  
MC FARLAND, WI 53558

**BID NO.**  
313083

**DRAWING**  
PLUMBING DOMESTIC  
WATER ISOMETRICS

**DATE**  
01.12.15

**JDR**  
ENGINEERING, INC.  
5525 NOBEL DRIVE  
SUITE 110  
MADISON, WI 53711  
ph:608.277.1728 fax:608.271.7046  
JDR Project No. 130099

## GAS WATER HEATERS SCHEDULE

ID	MANUFACTURER MODEL #	GAS PH	GAS PRESS IN WC	RECOVERY		TANK CAP GAL	DETAIL/ SHEET	DESCRIPTION/REMARKS
				GPH	RISE °F			
WHR-1 & WHR-2	PHOENIX PH199-119SNHX	40-199	12	294	80	119	5/P400	TANK TYPE NATURAL GAS FIRED WATER HEATER, 96% EFFICIENT, SEALED COMBUSTION, MODULATING 5:1 TURN-DOWN, 3" INTAKE AND VENT, 316L STAINLESS STEEL TANK, LCD DISPLAY, AUXILIARY INLET AND OUTLET FOR CONNECTIONS FROM HEAT EXCHANGER, LESS INTERNAL HEAT EXCHANGER COIL. INCLUDE 3" PVC CONCENTRIC VENT TERMINATION KIT.

## HEAT EXCHANGER SCHEDULE

ID	MANUFACTURER MODEL #	MBH	HOT SIDE				COLD SIDE				FOULING FACTOR	DETAIL/ SHEET	DESCRIPTION/REMARKS		
			IN TEMP	OUT TEMP	GPM IN	GPM OUT	IN TEMP	OUT TEMP	GPM IN	GPM OUT					
HX-1 & HX-2	AIC LC110DW-20	300	200°F	170°F	22.99	22.71	3.67	72.0	97.0	23.98	24.05	3.91	0.0065	5/P400	DOUBLE WALL PLATE AND FRAME HEAT EXCHANGER, BRAISED BRONZE CONNECTIONS.

## EXPANSION TANK SCHEDULE

ID	MANUFACTURER MODEL #	SIZE		SYSTEM	VOLUME GALLON	PRESSURE RATING PSI	DETAIL/ SHEET	DESCRIPTION/REMARKS
		DIA	HEIGHT					
ET-1	AMTROL ST-20VC	12"	19"	DOMESTIC	8	150	5/P400	STEEL THERMAL EXPANSION TANK, RATED FOR DOMESTIC WATER, HEAVY DUTY BUTYL NSF/ANSI 61 DIAPHRAGM, POLYPROPYLENE LINER, PRECHARGED, STAINLESS STEEL CONNECTION, WITH AIR VALVE.

## PUMPS SCHEDULE

ID	MANUFACTURER MODEL #	ELECTRICAL				VFD	DISCHARGE		DETAIL/ SHEET	DESCRIPTION/REMARKS
		HP	AMPS	VOLTS	PHASE		GPM	HD FT		
CP-1	GRUNDFOS UPS15-55FC	0.12	0.75	115	1	NO	5.5	13	5/P400	BRONZE BODY, CERAMIC SHAFT, STAINLESS STEEL ROTOR CAN AND BEARING PLATE, BRONZE BODY, THREE SPEEDS.
P-1	GRUNDFOS UPS26-99FC	1/6	1.8	115	1	NO	24	9	5/P400	BRONZE BODY, CERAMIC SHAFT, STAINLESS STEEL ROTOR CAN AND BEARING PLATE, BRONZE BODY, THREE SPEEDS.
P-2	GRUNDFOS UPS26-99FC	1/6	1.8	115	1	NO	24	9	5/P400	BRONZE BODY, CERAMIC SHAFT, STAINLESS STEEL ROTOR CAN AND BEARING PLATE, BRONZE BODY, THREE SPEEDS.

## REDUCED PRESSURE BACKFLOW PREVENTER SCHEDULE

ID	MANUFACTURER MODEL #	SIZE	GPM	PRESS DROP	SYSTEM	DETAIL/SHEET	DESCRIPTION/REMARKS
RPBP-1	WATTS 9190T-S	3/4"	12	13	HVAC MAKE-UP	6/P400	BRONZE BODY, SILICONE RUBBER DISC IN BOTH CHECK SEATS, STAINLESS STEEL RELIEF VALVE SEATS, INCLUDE AIR GAP FITTING.
RPBP-2	WATTS 9190T-S	3/4"	12	13	HVAC MAKE-UP	6/P400	BRONZE BODY, SILICONE RUBBER DISC IN BOTH CHECK SEATS, STAINLESS STEEL RELIEF VALVE SEATS, INCLUDE AIR GAP FITTING.

## PLUMBING DRAIN & CLEANOUT SCHEDULE

ID	FIXTURE	WASTE			WATER		DETAIL/ SHEET	DESCRIPTION/REMARKS
		DFU	TRAP	VENT	WFU	SIZE		
CB-1	CATCH BASIN	4	---	2	---	---	9/P400	FIXTURE: PRECAST CATCH BASIN WITH FRAME AND GRATE, MONOLITHICALLY FACTORY FORMED BASIN, 6" CONCRETE WALLS, GASKETED PIPE PENETRATIONS. REFER TO DETAIL.
FD-1	FLOOR DRAIN	2	3"	1-1/2"	---	---	---	FIXTURE: ZURN ZN4158, CAST IRON BODY, 6" DIAMETER NICKEL BRONZE "TYPE B" STRAINER, COMBINATION INVERTIBLE MEMBRANE CLAMP, AND ADJUSTABLE COLLAR.
FD-2	FLOOR DRAIN	4	4"	2"	---	---	---	FIXTURE: ZURN ZN508, CAST IRON BODY, 9" DIAMETER NICKEL BRONZE TOP, SEEPAGE PAN, COMBINATION MEMBRANE FLASHING CLAMP & FRAME, AND HEAVY DUTY DEEP FLANGE SLOTTED GRATE.
FD-3	FLOOR DRAIN (AUTOPSY AND LAB)	4	4"	2"	---	---	---	FIXTURE: ZURN ZN4158-AR, ACID RESISTING COATED CAST IRON BODY, 6" DIAMETER NICKEL BRONZE "TYPE B" STRAINER, COMBINATION INVERTIBLE MEMBRANE CLAMP, AND ADJUSTABLE COLLAR.
FD-4	FLUSHING FLOOR DRAIN (AUTOPSY AND LAB)	6	4"	2"	6.5	1-1/2"	8/P400	FIXTURE: JR SMITH Z505T, ACID RESISTING COATED CAST IRON BODY, 11-1/2" DIAMETER NICKEL BRONZE STRAINER, FLASHING CLAMP, HINGED PERFORATED GRATE, INTEGRAL P-TRAP, FLUSHING CONNECTIONS ON DRAIN BODY AND P-TRAP.
9". INTEGRAL GALVANIZED FRAME, NO CROSS BARS, CONTINUOUS SLOPE SYSTEM AT 0.5%. INCLUDE END CAPS AT BEGINNING AND END OF TRENCH RUN, IRON SLOTTED LOCKING GRATE, PROVIDE INSTALLATION DEVICES FOR CHANNELS. REFER TO FLOOR PLANS FOR HIGH POINTS AND LENGTHS OF TRENCH RUN.
TD-2	TRENCH DRAIN	4	4"	2"	---	---	4/P400	FIXTURE: ACO POWERDRAIN S100K TRENCH DRAIN SYSTEM, 4" INTERNAL WIDTH, ONE (1) IN-LINE CATCH BASIN 90'D AND SEVEN (7) ONE METER LENGTH SECTIONS STARTING AT SK1-4 THRU SK1-10, NO NEUTRAL SECTIONS, 4" ROUND SIDE OUTLET, LOWEST BOTTOM INVERT 5.9". INTEGRAL GALVANIZED FRAME, NO CROSS BARS, CONTINUOUS SLOPE SYSTEM AT 0.5%. INCLUDE END CAPS AT BEGINNING AND END OF TRENCH RUN, IRON SLOTTED LOCKING GRATE, PROVIDE INSTALLATION DEVICES FOR CHANNELS. REFER TO FLOOR PLANS FOR HIGH POINTS AND LENGTHS OF TRENCH RUN.
HD-1	HUB DRAIN - AT GRADE	6	4"	2"	---	---	---	EXTEND HUB 2" AFF (MIN), INSTALL PIPE INCREASER ONE PIPE SIZE LARGER.
DSN-1	DOWNSPOUT NOZZLE	---	---	---	---	---	---	FIXTURE: ZURN ZANB-199 DOWNPOUT NOZZLE, ALL NICKEL BRONZE BODY, THREADED INLET, DECORATIVE FACE OF WALL FLANGE AND OUTLET NOZZLE.
ORD-1	OVERFLOW ROOF DRAIN	---	---	---	---	---	---	FIXTURE: ZURN ZC100-C-EA-R-WZ OVERFLOW ROOF DRAIN, CAST IRON BODY, 15" DIA, COMBINATION MEMBRANE FLASHING CLAMP/GRAVEL GUARD, UNDERDECK CLAMP, ADJUSTABLE EXTENSION, ROOF SUMP RECEIVER, CAST IRON STRAINER, AND 2" INTERNAL WATER DAM.
RD-1	ROOF DRAIN	---	---	---	---	---	---	FIXTURE: ZURN ZC100-C-EA-R ROOF DRAIN, CAST IRON BODY, 15" DIA, COMBINATION MEMBRANE FLASHING CLAMP/GRAVEL GUARD, UNDERDECK CLAMP, ADJUSTABLE EXTENSION, ROOF SUMP RECEIVER, AND CAST IRON STRAINER.
RD-2	ROOF DRAIN	---	---	---	---	---	---	FIXTURE: ZURN ZC100-C-R ROOF DRAIN, CAST IRON BODY, 8-3/8" DIA, COMBINATION MEMBRANE FLASHING CLAMP/GRAVEL GUARD, UNDERDECK CLAMP, ROOF SUMP RECEIVER, AND CAST IRON STRAINER.
RD-3	ROOF DRAIN (CANOPY DRAIN)	---	---	---	---	---	---	FIXTURE: ZURN Z197 SCUPPER ROOF DRAIN, CAST IRON BODY, 7-1/2" x 8-3/8", COMBINATION MEMBRANE FLASHING CLAMP/GRAVEL GUARD, AND CAST IRON STRAINER.
FCO	FLOOR CLEANOUT	---	---	---	---	---	---	FINISHED AREAS WITH HARD FLOORS: ZURN ZN1400-BP, CAST IRON, ADJUSTABLE FLOOR CLEANOUT WITH NICKEL BRONZE TOP & BRONZE PLUG.
WCO	WALL CLEANOUT	---	---	---	---	---	---	FINISHED AREAS WITH CARPETED FLOORS: ZURN ZN1400-BP-CM, CAST IRON, ADJUSTABLE FLOOR CLEANOUT WITH NICKEL BRONZE TOP & BRONZE PLUG, WITH CARPET MARKER.
YCO	YARD CLEANOUT	---	---	---	---	---	3/P400	UNFINISHED AREAS: ZURN ZN1400-BP, HEAVY DUTY, ADJUSTABLE FLOOR CLEANOUT WITH NICKEL TOP AND BRONZE PLUG. FINISHED AREAS: ZURN ZN1400-BP-CM, HEAVY DUTY, ADJUSTABLE FLOOR CLEANOUT WITH NICKEL TOP AND BRONZE PLUG.

## AIR COMPRESSOR SCHEDULE

ID	MANUFACTURER MODEL #	ELECTRICAL				TOTAL (SCFM)	PRESS PSI	COOLING G TYPE	RECEIVER TANK SIZE	DETAIL/ SHEET	DESCRIPTION/REMARKS
		HP	AMPS	VOLTS	PHASE						
AC-1	QUINCY QT-5 253D90VCB46M	5	7.6	480	3	17.2	175	AIR	80 GALLON	---	RECIPROCATING PISTON AIR COMPRESSOR, TWO-STAGE, SPLASH LUBRICATED, TANK MOUNTED ON VERTICAL TANK, PROVIDE ISOLATION MOUNTING PADS, INCLUDE NANO 20 CFM CYCLING REFRIGERATED AIR DRYER, AND NANO F1 DRYER PRE-FILTER.

## SPILL-RESISTANT BACKFLOW PREVENTER SCHEDULE

ID	MANUFACTURER MODEL #	SIZE	GPM	PRESS DROP	SYSTEM	DETAIL/SHEET	DESCRIPTION/REMARKS
SVB-1 SVB-2 SVB-3 SVB-4 SVB-5 SVB-6 SVB-7 SVB-8 SVB-9 SVB-10 SVB-11	WATTS LF008PCQT	3/4"	7	3	HOSE STATION WATER	---	ANTI-SIPHON, SPILL-RESISTANT ELEVATED BACKFLOW PREVENTER, ONE-PIECE MODULAR CHECK AND FLOAT ASSEMBLY, LEAD-FREE, CAST COPPER SILICON ALLOY BODY, STAINLESS STEEL SPRINGS, INTEGRAL BALL VALVES ON INLET AND OUTLET, TEST PORT, 180°F MAX TEMPERATURE, ASSE 1056. INSTALL EXPOSED ON WALL IN ACCESSIBLE LOCATION ON TEMPERED WATER OUTLET FROM HOSE STATION, MOUNT 60" AFF (MIN).


## PLUMBING FIXTURE SCHEDULE

REFER TO SPECIFICATION SECTION 22 40 00 FOR ACCEPTABLE EQUAL MANUFACTURERS

ID	FIXTURE	DFU	TRAP	VENT (MIN)	WATER				DETAIL/ SHEET	DESCRIPTION/REMARKS
					COLD		HOT			
					WFU	SIZE	WFU	SIZE		
AO-1	AIR OUTLET	---	---	---	---	---	---	---	---	FIXTURE: MILTON S-775 STYLE 'A' QUICK DISCONNECT AIR OUTLET, MOUNT 48" AFF, PROVIDE BALL VALVE WITH DIRT LEG.
AT-1	AUTOPSY TABLE WITH SINK (PROVIDED BY DIV 11)	3	2"	1-1/2"	2	3/4"	2	3/4"	---	FIXTURE: SINK, DRAIN STRAINER, AND TAILPIECE PROVIDED BY DIV 11, INSTALLED BY PC. FAUCET: FAUCET PROVIDED BY DIV 11, INSTALLED BY PC. TRAP & DRAIN: 17 GAUGE CAST BRASS P-TRAP, GRID STRAINER DRAIN. STOPS & SUPPLIES: MCGUIRE H2167LK, LOOSE KEY QUARTER TURN ANGLE STOPS WITH CHROME PLATED ESCUTCHEONS & CHROME PLATED COPPER RISER SUPPLIES.
EW-1	EMERGENCY EYEWASH (PROVIDED BY DIV 11)	---	---	---	---	1/2"	---	1/2"	---	FIXTURE: DRENCH TYPE EYEWASH PROVIDED BY DIV 11, INSTALLED BY PC. MIXING VALVE: BRADLEY S19-2000 THERMOSTATIC MIXING VALVE, MEETS ANSI Z358.1, CHECKSTOPS ON INLETS, ADJUSTABLE TEMPERATURE RANGE, COLD WATER BYPASS, POSITIVE SHUTOFF ON HOT SUPPLY WHEN COLD SUPPLY IS LOST, DIAL THERMOMETER, PROVIDED AND INSTALLED BY PC, INSTALL ABOVE CEILING AT ESEW-1 LOCATION WITH BALL VALVES.
ESEW-1	EMERGENCY SHOWER / EYEWASH (PROVIDED BY DIV 11)	---	1-1/2"	1-1/2"	---	1-1/4"	---	1-1/4"	---	FIXTURE: SHOWER AND EYEWASH UNIT PROVIDED BY DIV 11, INSTALLED BY PC. MIXING VALVE: BRADLEY S19-2000 THERMOSTATIC MIXING VALVE, MEETS ANSI Z358.1, INTEGRAL STRAINER, CHECKSTOPS ON INLETS, ADJUSTABLE TEMPERATURE RANGE, COLD WATER BYPASS, POSITIVE SHUTOFF ON HOT SUPPLY WHEN COLD SUPPLY IS LOST, DIAL THERMOMETER, PROVIDED AND INSTALLED BY PC, INSTALL ABOVE CEILING AT ESEW-1 LOCATION WITH BALL VALVES.
FH-1	FUME HOOD (PROVIDED BY DIV 11)	0.5	1-1/4"	1-1/2"	0.5	1/2"	0.5	1/2"	---	FIXTURE: FUME HOOD WITH CUP SINK PROVIDED BY DIV 11, CUP SINK INSTALLATION AND ALL CONNECTIONS BY PC. TRAP & DRAIN: PRE-WRAPPED OFFSET DRAIN & P-TRAP, WITH GRID STRAINER DRAIN. STOPS & SUPPLIES: MCGUIRE H2167LK, LOOSE KEY QUARTER TURN ANGLE STOPS WITH CHROME PLATED ESCUTCHEONS & CHROME PLATED COPPER RISER SUPPLIES.
FH-2	FUME HOOD (PROVIDED BY DIV 11)	0.5	1-1/4"	1-1/2"	0.5	1/2"	---	---	---	FIXTURE: FUME HOOD WITH CUP SINK PROVIDED BY DIV 11, CUP SINK INSTALLATION AND ALL CONNECTIONS BY PC. TRAP & DRAIN: PRE-WRAPPED OFFSET DRAIN & P-TRAP, WITH GRID STRAINER DRAIN. STOPS & SUPPLIES: MCGUIRE H2167LK, LOOSE KEY QUARTER TURN ANGLE STOPS WITH CHROME PLATED ESCUTCHEONS & CHROME PLATED COPPER RISER SUPPLIES.
FS-1	FAUCET STATION	---	---	---	2	1/2"	2	1/2"	---	FIXTURE: CHICAGO FAUCETS 610-GCLVBBCP FAUCET WITH HOSE SPRAY, WALL MOUNTED FAUCET ON 8" CENTERS, LEVER HANDLES, 29" RISER PIPE FITTING, 29" FLEXIBLE HOSE, 1.0 GPM SPRAY VALVE, IN-LINE BACKFLOW PREVENTER, PIPE STRAP AND HOOK ASSEMBLY.
HB-1	HOSE BIBB	---	---	---	3	1/2"	---	---	---	FIXTURE: WOODFORD MODEL 24 ANTI-SIPHON HOSE BIBB, EXPOSED COLD WATER, INTEGRAL VACUUM BREAKER, 3/4" HOSE CONNECTION.
HB-2	HOSE BIBB	---	---	---	3	1/2"	---	---	---	FIXTURE: WOODFORD MODEL 24 ANTI-SIPHON HOSE BIBB, EXPOSED COLD WATER, INTEGRAL VACUUM BREAKER, INCLUDE DIVERTER FOR TWO (2) 3/4" HOSE CONNECTIONS.
HS-1	HOSE STATION AND HOSE	---	---	---	3	3/4"	3	3/4"	---	HOSE: STRAHMAN 5/8" ID / 1-1/8" OD HOSE, YELLOW, STAINLESS STEEL FITTINGS, FDA APPROVED INTERNAL TUBE, 50 FOOT LENGTH. NOZZLE: STRAHMAN HYDRO-PRO 150 SPRAY NOZZLE, STAINLESS STEEL HOUSING, LOCKING TRIGGER, BLACK WATERPROOF NYLON COVER, 7 GPM AT 80 PSIG, WITH SWIVEL ADAPTER.
HS-2	HOSE STATION AND HOSE	---	---	---	3	3/4"	3	3/4"	---	HOSE: STRAHMAN 5/8" ID / 1-1/8" OD HOSE, YELLOW, STAINLESS STEEL FITTINGS, FDA APPROVED INTERNAL TUBE, 25 FOOT LENGTH. NOZZLE: STRAHMAN HYDRO-PRO 150 SPRAY NOZZLE, STAINLESS STEEL HOUSING, LOCKING TRIGGER, BLACK WATERPROOF NYLON COVER, 7 GPM AT 80 PSIG, WITH SWIVEL ADAPTER.
L-1	LAVATORY (ADA COMPLIANT)	1	1-1/4"	1-1/2"	0.5	1/2"	0.5	1/2"	2/P400	FIXTURE: KOHLER PENNINGTON K-2196-4 SELF-RIMMING LAVATORY SINK, VITREOUS CHINA, THREE FAUCET HOLES ON 2" CENTERS, 20.25" x 17.5", OVERFLOW, ADA COMPLIANT. FAUCET: CHICAGO FAUCETS 2200-4-2300-4KCP MANUAL FAUCET, SINGLE LEVER, SOLID BRASS CONSTRUCTION, CHROME FINISH, CERAMIC CARTRIDGE, 1.5 GPM AERATOR, MOUNTED ON 4" CENTERS, ADA COMPLIANT. TRAP & DRAIN: PRE-WRAPPED OFFSET DRAIN & P-TRAP, WITH GRID STRAINER DRAIN. STOPS & SUPPLIES: MCGUIRE H2167LK, LOOSE KEY QUARTER TURN ANGLE STOPS WITH CHROME PLATED ESCUTCHEONS & CHROME PLATED COPPER RISER SUPPLIES.
L-2	LAVATORY (ADA COMPLIANT)	1	1-1/4"	1-1/2"	0.5	1/2"	0.5	1/2"	2/P400	FIXTURE: KOHLER KINGSTON K-2006 WALL HUNG LAVATORY SINK, WHITE VITREOUS CHINA, THREE FAUCET HOLES ON 2" CENTERS, 21.25" x 18.125", WITH OVERFLOW, ADA COMPLIANT. FAUCET: CHICAGO FAUCETS 2200-4-2300-4KCP MANUAL FAUCET, SINGLE LEVER, SOLID BRASS CONSTRUCTION, CHROME FINISH, CERAMIC CARTRIDGE, 1.5 GPM AERATOR, MOUNTED ON 4" CENTERS, ADA COMPLIANT. TRAP & DRAIN: PRE-WRAPPED OFFSET DRAIN & P-TRAP, WITH GRID STRAINER DRAIN. STOPS & SUPPLIES: MCGUIRE H2167LK, LOOSE KEY QUARTER TURN ANGLE STOPS WITH CHROME PLATED ESCUTCHEONS & CHROME PLATED COPPER RISER SUPPLIES.
LS-1	LAB SINK (PROVIDED BY DIV 11) (ADA COMPLIANT)	2	1-1/2"	1-1/2"	1	1/2"	1	1/2"	2/P400	FIXTURE: SINK, DRAIN STRAINER, AND TAILPIECE PROVIDED BY DIV 11, INSTALLED BY PC. FAUCET: FAUCET PROVIDED BY DIV 11, INSTALLED BY PC. TRAP & DRAIN: PRE-WRAPPED OFFSET DRAIN & P-TRAP, WITH GRID STRAINER DRAIN. STOPS & SUPPLIES: MCGUIRE H2167LK, LOOSE KEY QUARTER TURN ANGLE STOPS WITH CHROME PLATED ESCUTCHEONS & CHROME PLATED COPPER RISER SUPPLIES.
LS-2	LAB SINK (PROVIDED BY DIV 11)	2	1-1/2"	1-1/2"	1	1/2"	1	1/2"	---	FIXTURE: SINK, DRAIN STRAINER, AND TAILPIECE PROVIDED BY DIV 11, INSTALLED BY PC. FAUCET: FAUCET PROVIDED BY DIV 11, INSTALLED BY PC. TRAP & DRAIN: PRE-WRAPPED OFFSET DRAIN & P-TRAP, WITH GRID STRAINER DRAIN. STOPS & SUPPLIES: MCGUIRE H2167LK, LOOSE KEY QUARTER TURN ANGLE STOPS WITH CHROME PLATED ESCUTCHEONS & CHROME PLATED COPPER RISER SUPPLIES.
Mb-1	MOP BASIN	3	3"	1-1/2"	2	1/2"	2	1/2"	---	FIXTURE: MUSTEE 63M 24"x24"x10" HIGH BASIN, ONE PIECE MOLDED DURASTONE, INTEGRAL MOLDED-IN DRAIN, 3" DRAIN CONNECTION. FAUCET: CHICAGO FAUCETS SERVICE SINK FAUCET 305-RFC WITH ROUGH CHROME FINISH, 3/4" MALE HOSE THREADED OUTLET, PAIL HOOK, ADJUSTABLE SUPPLY ARMS WITH INTEGRAL SERVICE STOPS AND LEVER HANDLES, PROVIDE WATTS MODEL 8AC NON-REMOVABLE CHROME FINISH HOSE REEL, 1/2" HOSE, 100 FT, WITH OVERFLOW, ADA COMPLIANT. ACCESSORIES: PROVIDED BY DIV 11, COORDINATE LOCATIONS.
S-1	SINK (BREAK ROOM SINK) (ADA COMPLIANT)	2	1-1/2"	1-1/2"	1.5	1/2"	1.5	1/2"	---	FIXTURE: ELKAY IAD2521-A-5, 18 GAUGE TYPE 304 STAINLESS STEEL SINK, SELF-RIMMING, 25"x21.25"x8.5" DEEP, THREE FAUCET HOLES ON 4" CENTERS, CUSTOM DRILL FOURTH HOLE FOR SIDE SPRAY 6" TO RIGHT OF FAUCET HOLE, ADA COMPLIANT. FAUCET: CHICAGO FAUCETS 1102-317CP, MANUAL FAUCET WITH SIDE SPRAY, BRASS CONSTRUCTION, 2.2 GPM AERATOR, POLISHED CHROME FINISH, 8" CAST BRASS SWING SPOUT, TWO 4" WRISTBLADE HANDLES, TWO HOLE MOUNTING ON 8" CENTERS, DECK MOUNTED. TRAP & DRAIN: CHROME PLATED CAST BRASS P-TRAP, WITH BASKET STRAINER DRAIN. STOPS & SUPPLIES: MCGUIRE H2167LK, LOOSE KEY QUARTER TURN ANGLE STOPS WITH CHROME PLATED ESCUTCHEONS & CHROME PLATED COPPER RISER SUPPLIES.
S-2	SINK	2	1-1/2"	1-1/2"	1.5	1/2"	1.5	1/2"	---	FIXTURE: ELKAY IAD2521-A-5, 18 GAUGE TYPE 304 STAINLESS STEEL SINK, SELF-RIMMING, 25"x21.25"x8.5" DEEP, THREE FAUCET HOLES ON 4" CENTERS, CUSTOM DRILL FOURTH HOLE FOR SIDE SPRAY 6" TO RIGHT OF FAUCET HOLE, ADA COMPLIANT. FAUCET: CHICAGO FAUCETS 1102-317CP, MANUAL FAUCET WITH SIDE SPRAY, BRASS CONSTRUCTION, 2.2 GPM AERATOR, POLISHED CHROME FINISH, 8" CAST BRASS SWING SPOUT, TWO 4" WRISTBLADE HANDLES, TWO HOLE MOUNTING ON 8" CENTERS, BACKSPASH MOUNTED. TRAP & DRAIN: CHROME PLATED CAST BRASS P-TRAP, WITH BASKET STRAINER DRAIN. STOPS & SUPPLIES: MCGUIRE H2167LK, LOOSE KEY QUARTER TURN ANGLE STOPS WITH CHROME PLATED ESCUTCHEONS & CHROME PLATED COPPER RISER SUPPLIES.
SH-1	SHOWER (ADA COMPLIANT)	2	32"	1-1/2"	2	1/2"	2	1/2"	---	ENCLOSURE: FIELD BUILT BY OTHERS. FIXTURE: SYMMONS 3505-H321-V-CYL-X-2.0 SHOWER SYSTEM, ON/OFF MIXING VALVE, DIVERTER VALVE, FIXED SHOWER HEAD, HAND HELD SHOWER HEAD WITH 60" HOSE & IN-LINE VACUUM BREAKER WALL CONNECTION, 30" SLIDE BAR WITH CRADLE FROM HAND SHOWER, ALL CHROME FINISH, 2.0 GPM FLOW RATE, ADA COMPLIANT. DRAIN: FLOOR DRAIN FD-1 IN SHOWER FLOOR.
TMV-1	THERMOSTATIC MIXING VALVE	---	---	---	---	---	---	---	5/P400	FIXTURE: ETV-SS 1" ELECTRONIC THERMOSTATIC MIXING VALVE, HOT WATER SHUT-OFF FAILURE, FULLY PROGRAMMABLE, 120 VAC 1 PHASE STAINLESS STEEL VALVE CONSTRUCTION, INCLUDE ADJUSTAT ON HOT WATER INLET, PROVIDE SOLENOID ON HOT WATER INLET TO VALVE.
UR-1	URINAL (ADA HEIGHT)	2	2	1-1/2"	2	3/4"	---	---	---	FIXTURE: KOHLER BARDON K-4904-ET VITREOUS CHINA URINAL, WALL MOUNTED, WASHOUT, 3/4" TOP SPUD, 0.5 GPF, ADA HEIGHT. FLUSH VALVE: SLOAN ROYAL 188-05 MANUAL FLUSH VALVE, EXPOSED VALVE, CHROME FINISH, 0.5 GPF, FOR 3/4" TOP SPUD, 3/4" SCREWDRIIVER ANGLE STOP, RUBBER DIAPHRAGM, ADA COMPLIANT. SUPPORT: COMMERCIAL GRADE, WALL HUNG URINAL SUPPORT, STEEL STANCHIONS, IRON WELDED FEET, STEEL SLEEVES, FASTEN TO FLOOR. FIXTURE: KOHLER KINGSTON K-4325, WALL HUNG, FLUSH VALVE TOILET, WHITE VITREOUS CHINA, ELONGATED BOWL, 1.6 GPF MAX, 2.25" TRAFWAY, 1-1/2" TOP SPUD.
WC-1	WATER CLOSET	6	4"	2"	6.5	1-1/2"	---	---	---	FLUSH VALVE: SLOAN ROYAL 111-1.6 MANUAL FLUSH VALVE, EXPOSED VALVE, CHROME FINISH, 1.6 GPF, FOR 1-1/2" TOP SPUD, 1" SCREWDRIIVER ANGLE STOP, RUBBER DIAPHRAGM, ADA COMPLIANT. SEAT: KOHLER LUSTRA K-4670-CA, OPEN FRONT TOILET SEAT, ELONGATED BOWL, INJECTION MOLDED, WITH ANTI-MICROBIAL AGENT. SUPPORT: COMMERCIAL GRADE, WALL HUNG WATER CLOSET SUPPORT, STEEL STANCHIONS, IRON WELDED FEET, STEEL SLEEVES, FASTEN TO FLOOR.
WC-2	WATER CLOSET (ADA HEIGHT)	6	4"	2"	6.5	1-1/2"	---	---	---	FLUSH VALVE: SAME AS WC-1, MOUNTED AT ADA HEIGHT. SEAT: KOHLER LUSTRA K-4670-CA, OPEN FRONT TOILET SEAT, ELONGATED BOWL, INJECTION MOLDED, WITH ANTI-MICROBIAL AGENT. SUPPORT: COMMERCIAL GRADE, WALL HUNG WATER CLOSET SUPPORT, STEEL STANCHIONS, IRON WELDED FEET, STEEL SLEEVES, FASTEN TO FLOOR.
WH-1	WALL HYDRANT	---	---	---	4	3/4"	---	---	---	FIXTURE: WOODFORD MODEL 67, EXTERNAL FREEZELESS WALL HYDRANT, AUTOMATIC DRAINING, INTEGRAL VACUUM BREAKER, 3/4" HOSE CONNECTION, LOCATED PER PLAN.
WM-1	WASHING MACHINE WALL BOX	4	2"	1-1/2"	2	3/4"	2	3/4"	7/P400	FIXTURE: GUY GRAY T207PCPCWA WASHING MACHINE RECESSED WALL BOX, WHITE POWDER COATED FINISH, 1/2" QUARTER TURN HOT & COLD VALVES, INTEGRAL WATER HAMMER ARRESTORS, 2" DRAIN OUTLET.

Architecture  
Planning

DorschnerAssociates, Inc.  
849 E. Washington Ave., Ste

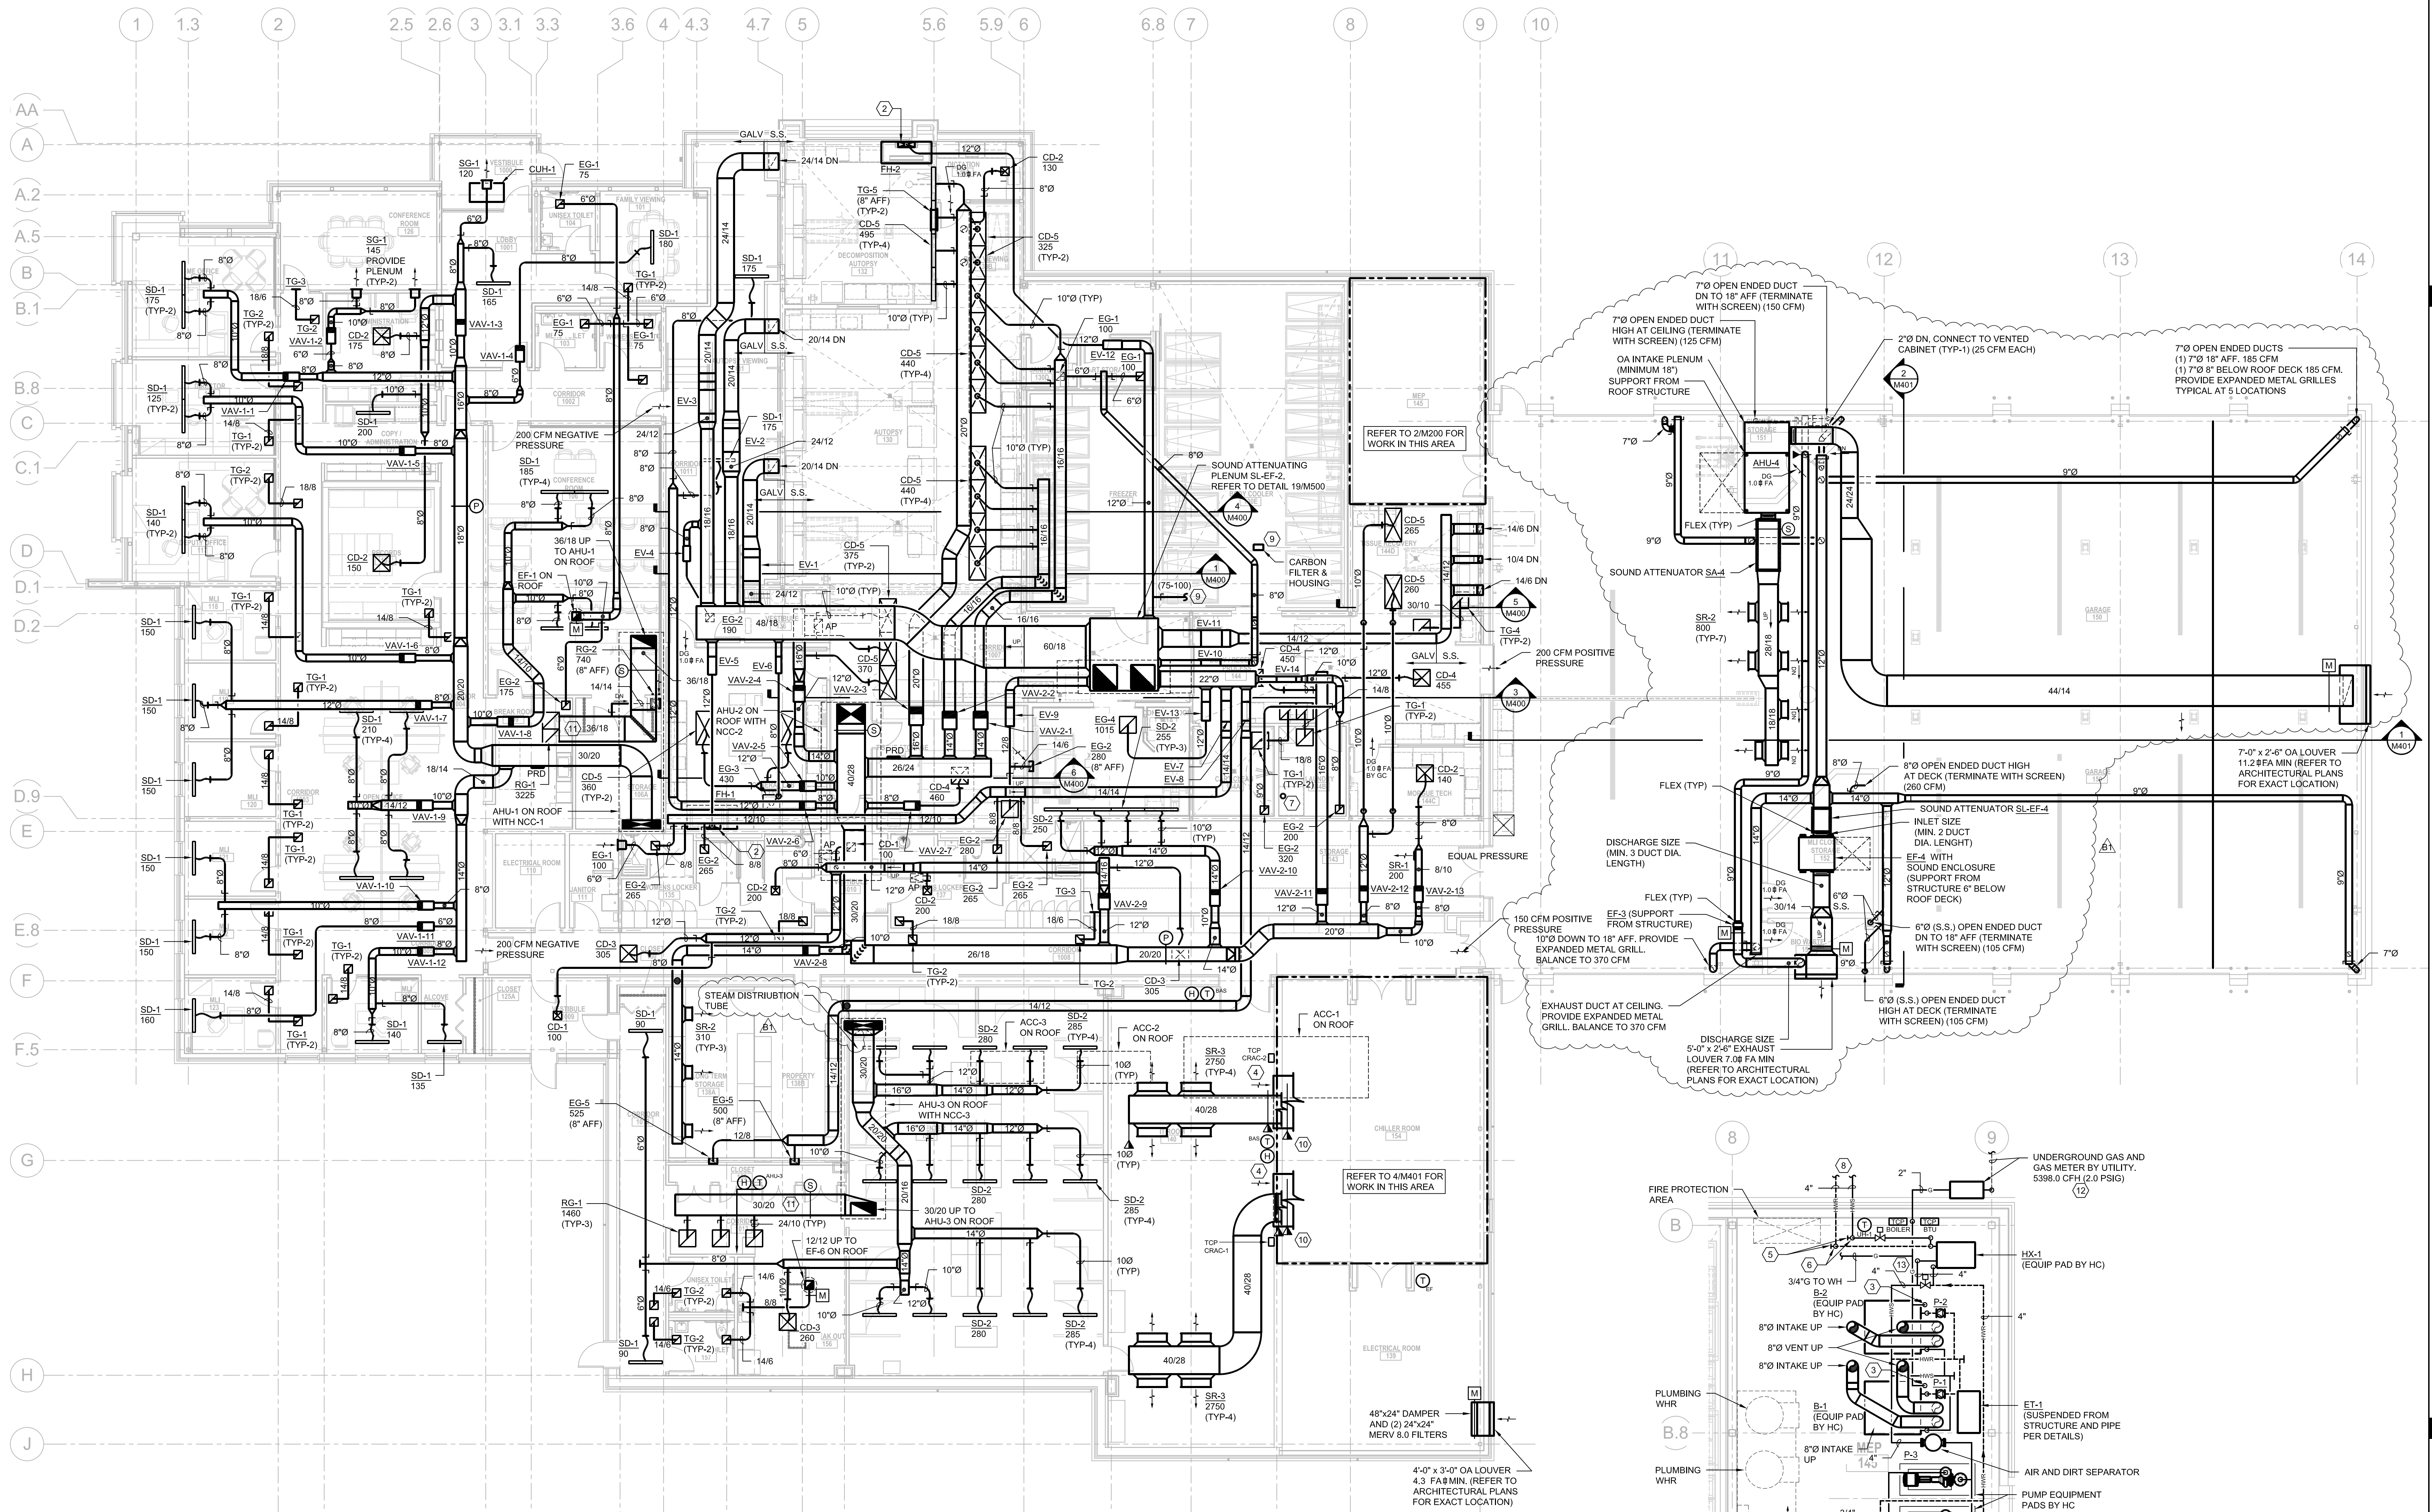


1 HVAC FIRST FLOOR PLAN  
SCALE: 1/8"=1'-0"



SHEET KEYED NOTES:

- 1 8" VENT AND OA UP THRU ROOF. TERMINATE PER MANUFACTURERS REQUIREMENTS.
- 2 TRANSITION TO 24x8 CONNECTION ON FUME HOOD.
- 3 1 1/4" (2.0 PSIG) DN TO BOILER.
- 4 PROVIDE EXPANDED METAL SCREEN OVER RETURN AIR OPENINGS.
- 5 PROVIDE 4" X 1 1/2" TEE IN HWS AND HWR PIPES FOR PLUMBING CONNECTIONS. COORDINATE WITH PC.
- 6 PROVIDE WATER FLOW AND BTU MEASUREMENT STATION ON INCOMING HEATING HOT WATER FROM SITE GENERATOR HEAT RECOVERY LOOP. INSTALL IN VERTICAL PIPE RISE.
- 7 EXTEND AN ALL ALUMINUM DRYER VENT UP THRU ROOF AND TERMINATE MINIMUM 18" ABOVE FINISHED ROOF WITH GOOSENECK.
- 8 EXTEND AND CONNECT 4" HWS AND HWR TO 4" HWS AND HWR PIPING LEFT BY PHASE 1 PROJECT.
- 9 PROVIDE 5" (INSULATED 3" RIGID INSULATION) SUPPLY AND RETURN AIR DUCTS FROM AND TO COLD ROOM GRILLES (GRILLES BY COLD ROOM SUPPLIER) TO THE DEHUMIDIFICATION UNIT. PROVIDE A FILTER RACK WITH 12" CARBON FILTER IN THE RETURN AIR DUCT (COORDINATE WITH THE COLD ROOM SUPPLIER FOR DEHUMIDIFICATION AND FILTER RACK LOCATIONS). CONNECT 3" DUCT FROM THE DEHUMIDIFICATION UNIT (BALANCE TO CFM LISTED) TO EXHAUST SYSTEM AS INDICATED.

2 ENLARGED MECHANICAL ROOM - HVAC  
SCALE: 1/4"=1'-0"


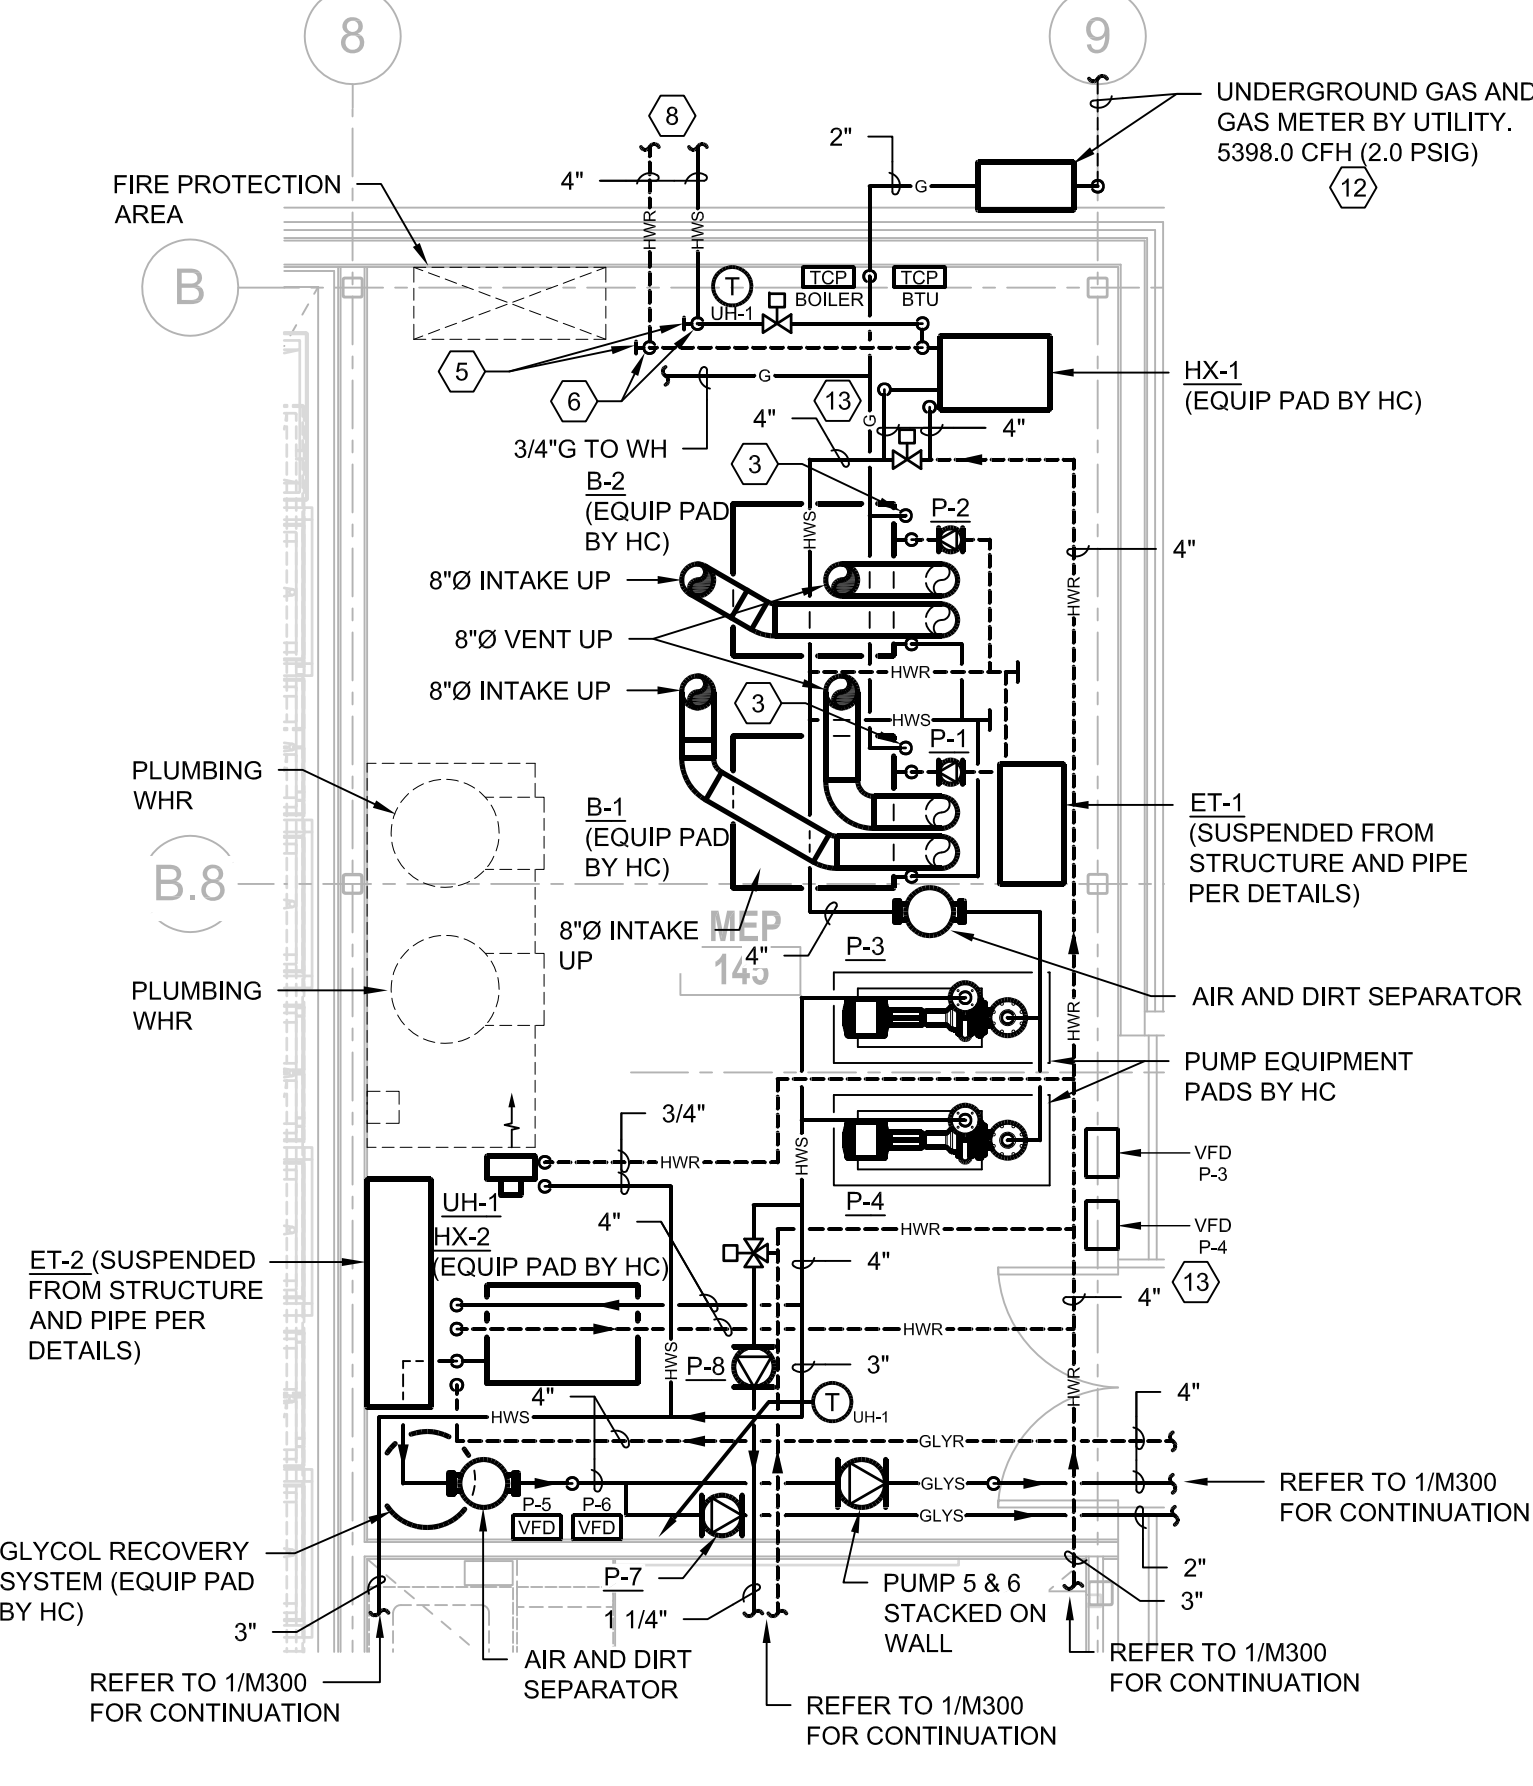


PROJECT  
MEDICAL EXAMINER OFFICE  
BUILDING (BID PACKAGE B)  
3562 COUNTY HIGHWAY AB  
MC FARLAND, WI 53558

BID NO.  
313083

DRAWING  
HVAC FIRST FLOOR  
PLAN


DATE  
01.12.15

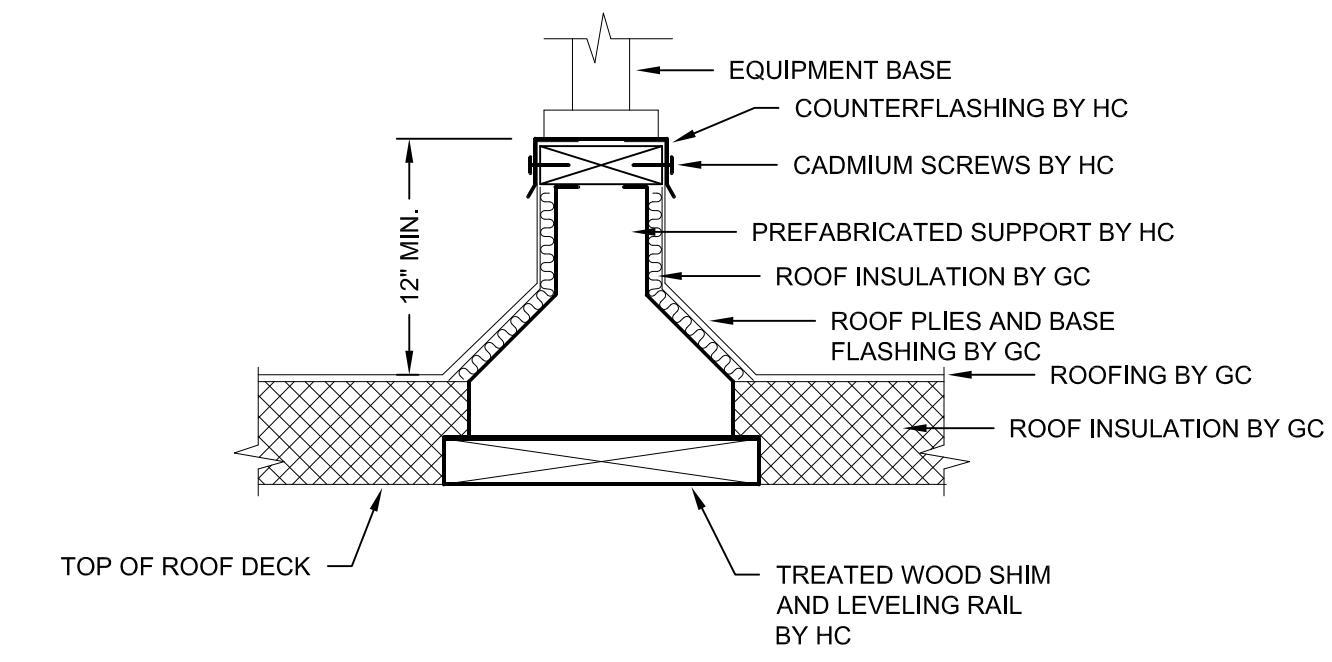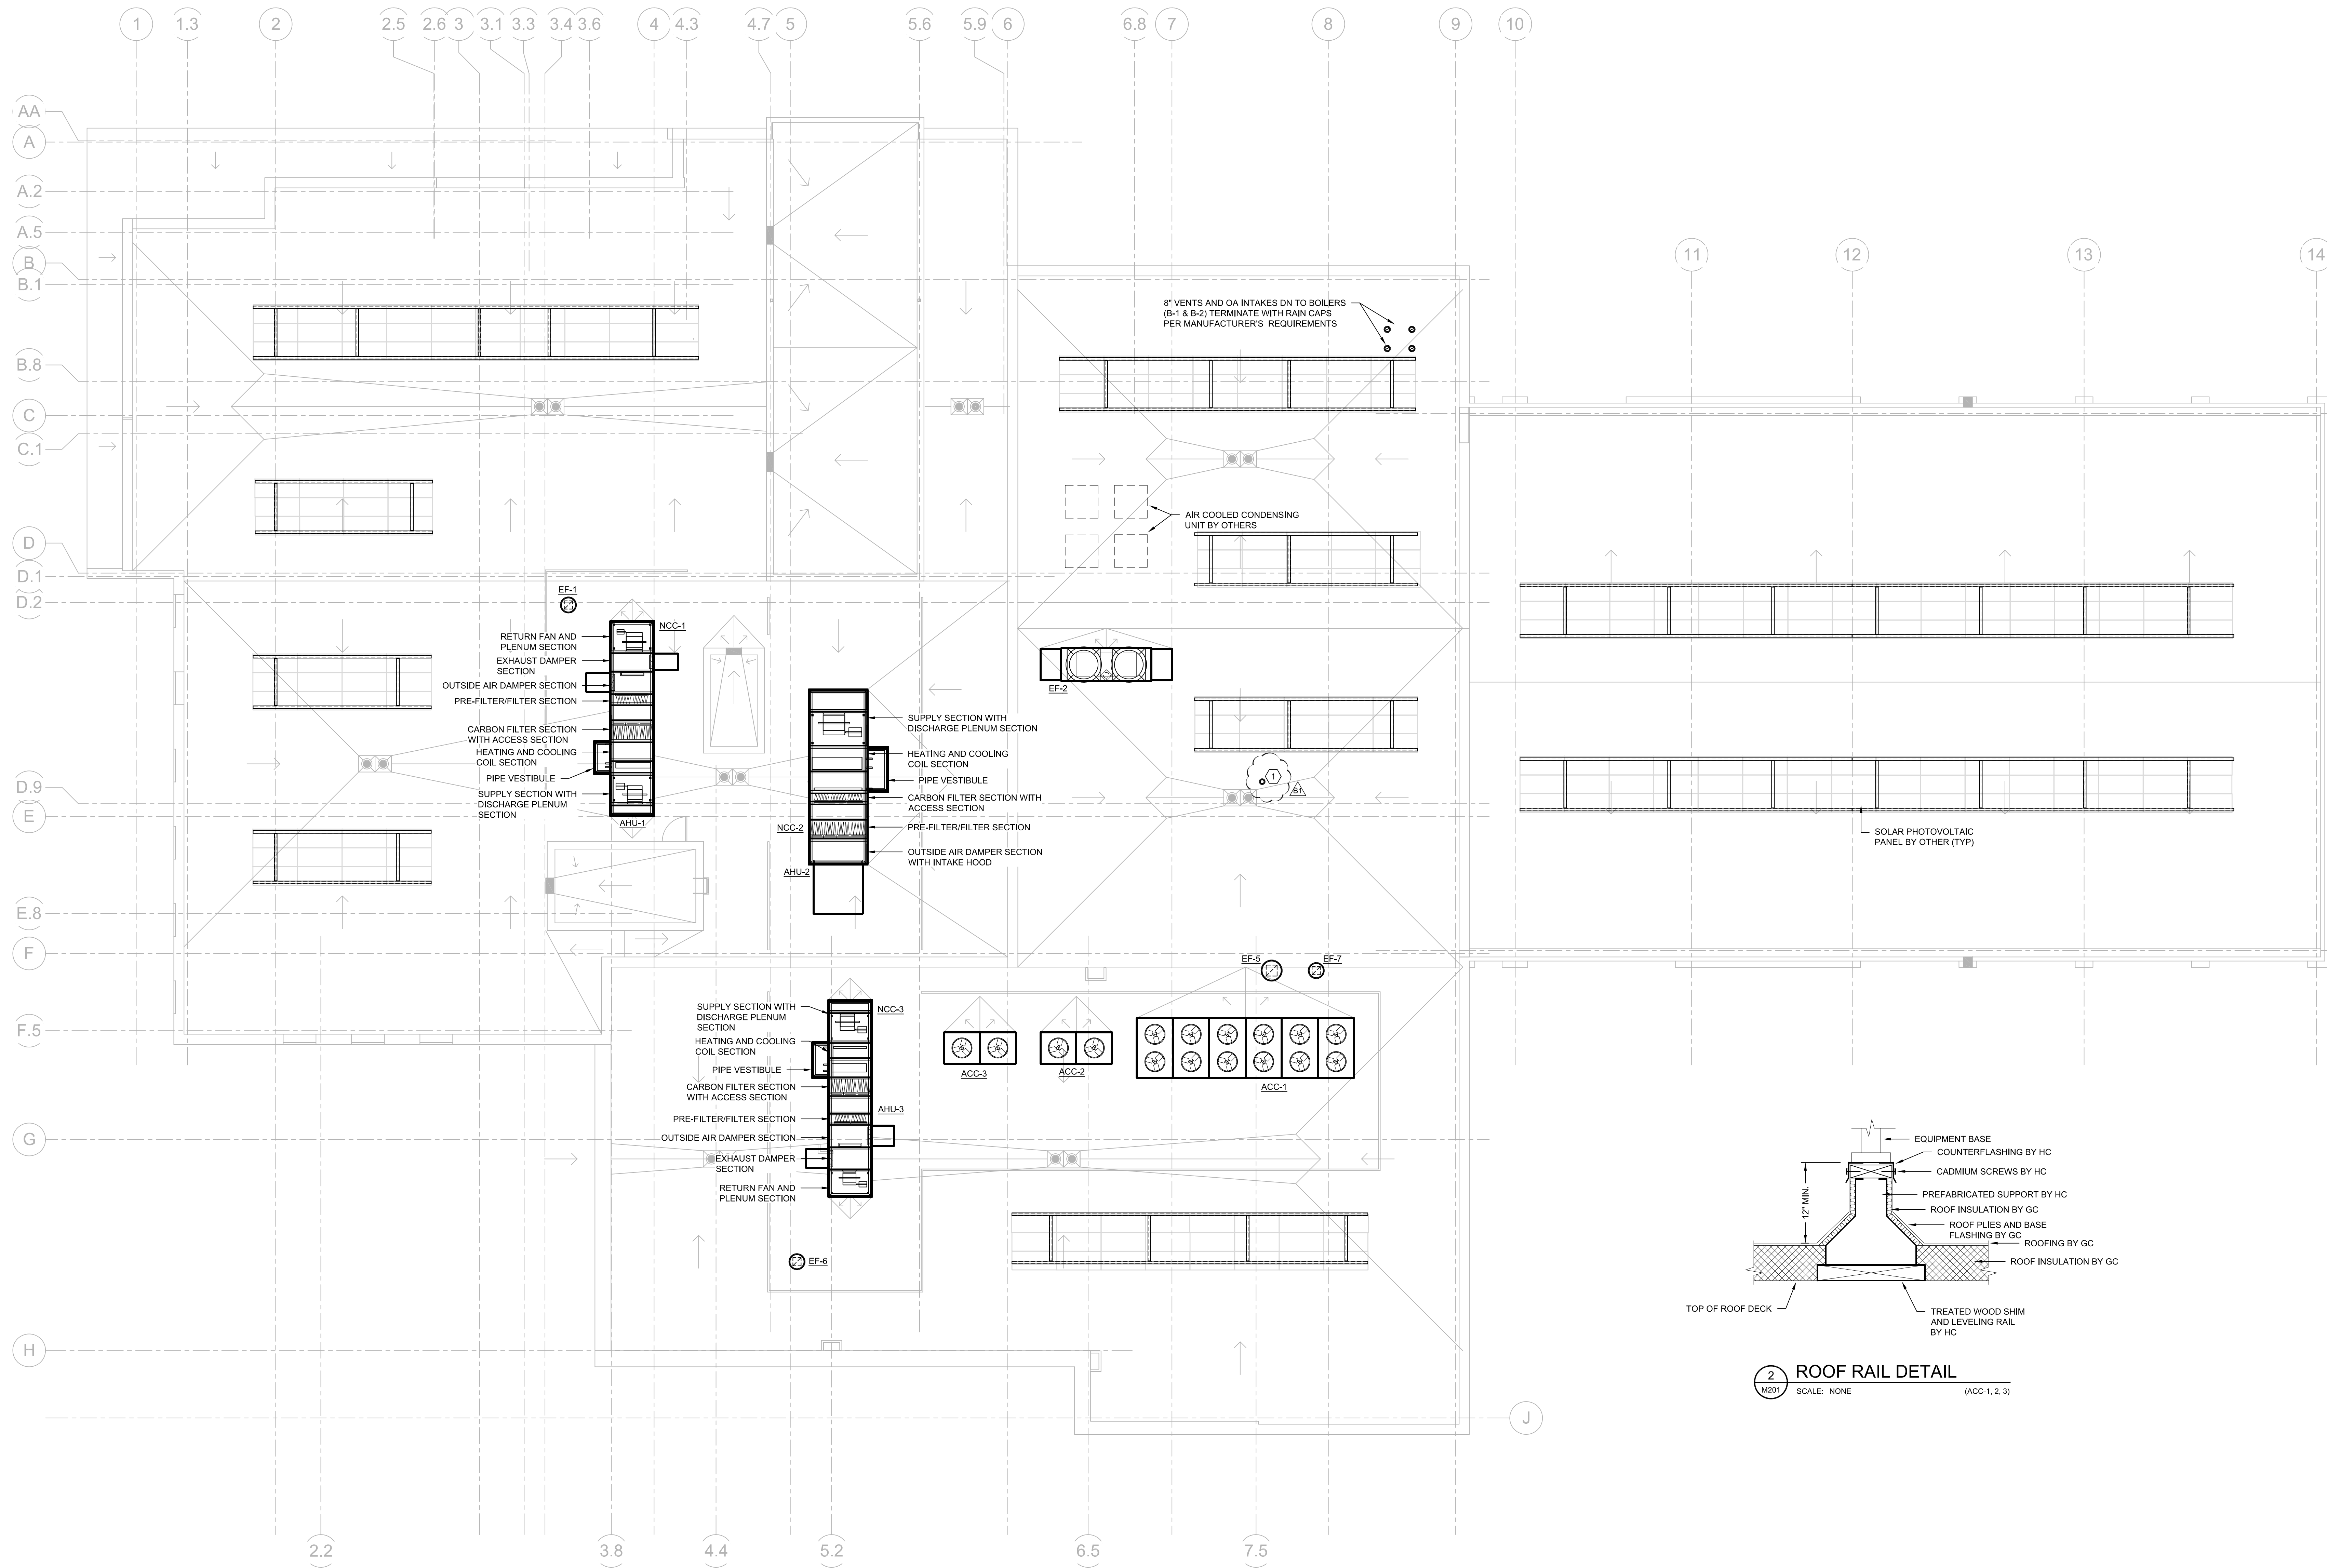

2 ROOF RAIL DETAIL  
SCALE: NONE (ACC-1, 2, 3)

1 HVAC ROOF PLAN  
SCALE: 1/8"=1'-0"  
NORTH

KEYED NOTES:  
1 EXTEND AN ALL ALUMINUM DRYER VENT UP THRU ROOF AND TERMINATE MINIMUM 18" ABOVE FINISHED ROOF WITH GOOSENECK. REFER TO DETAIL 15/M500.

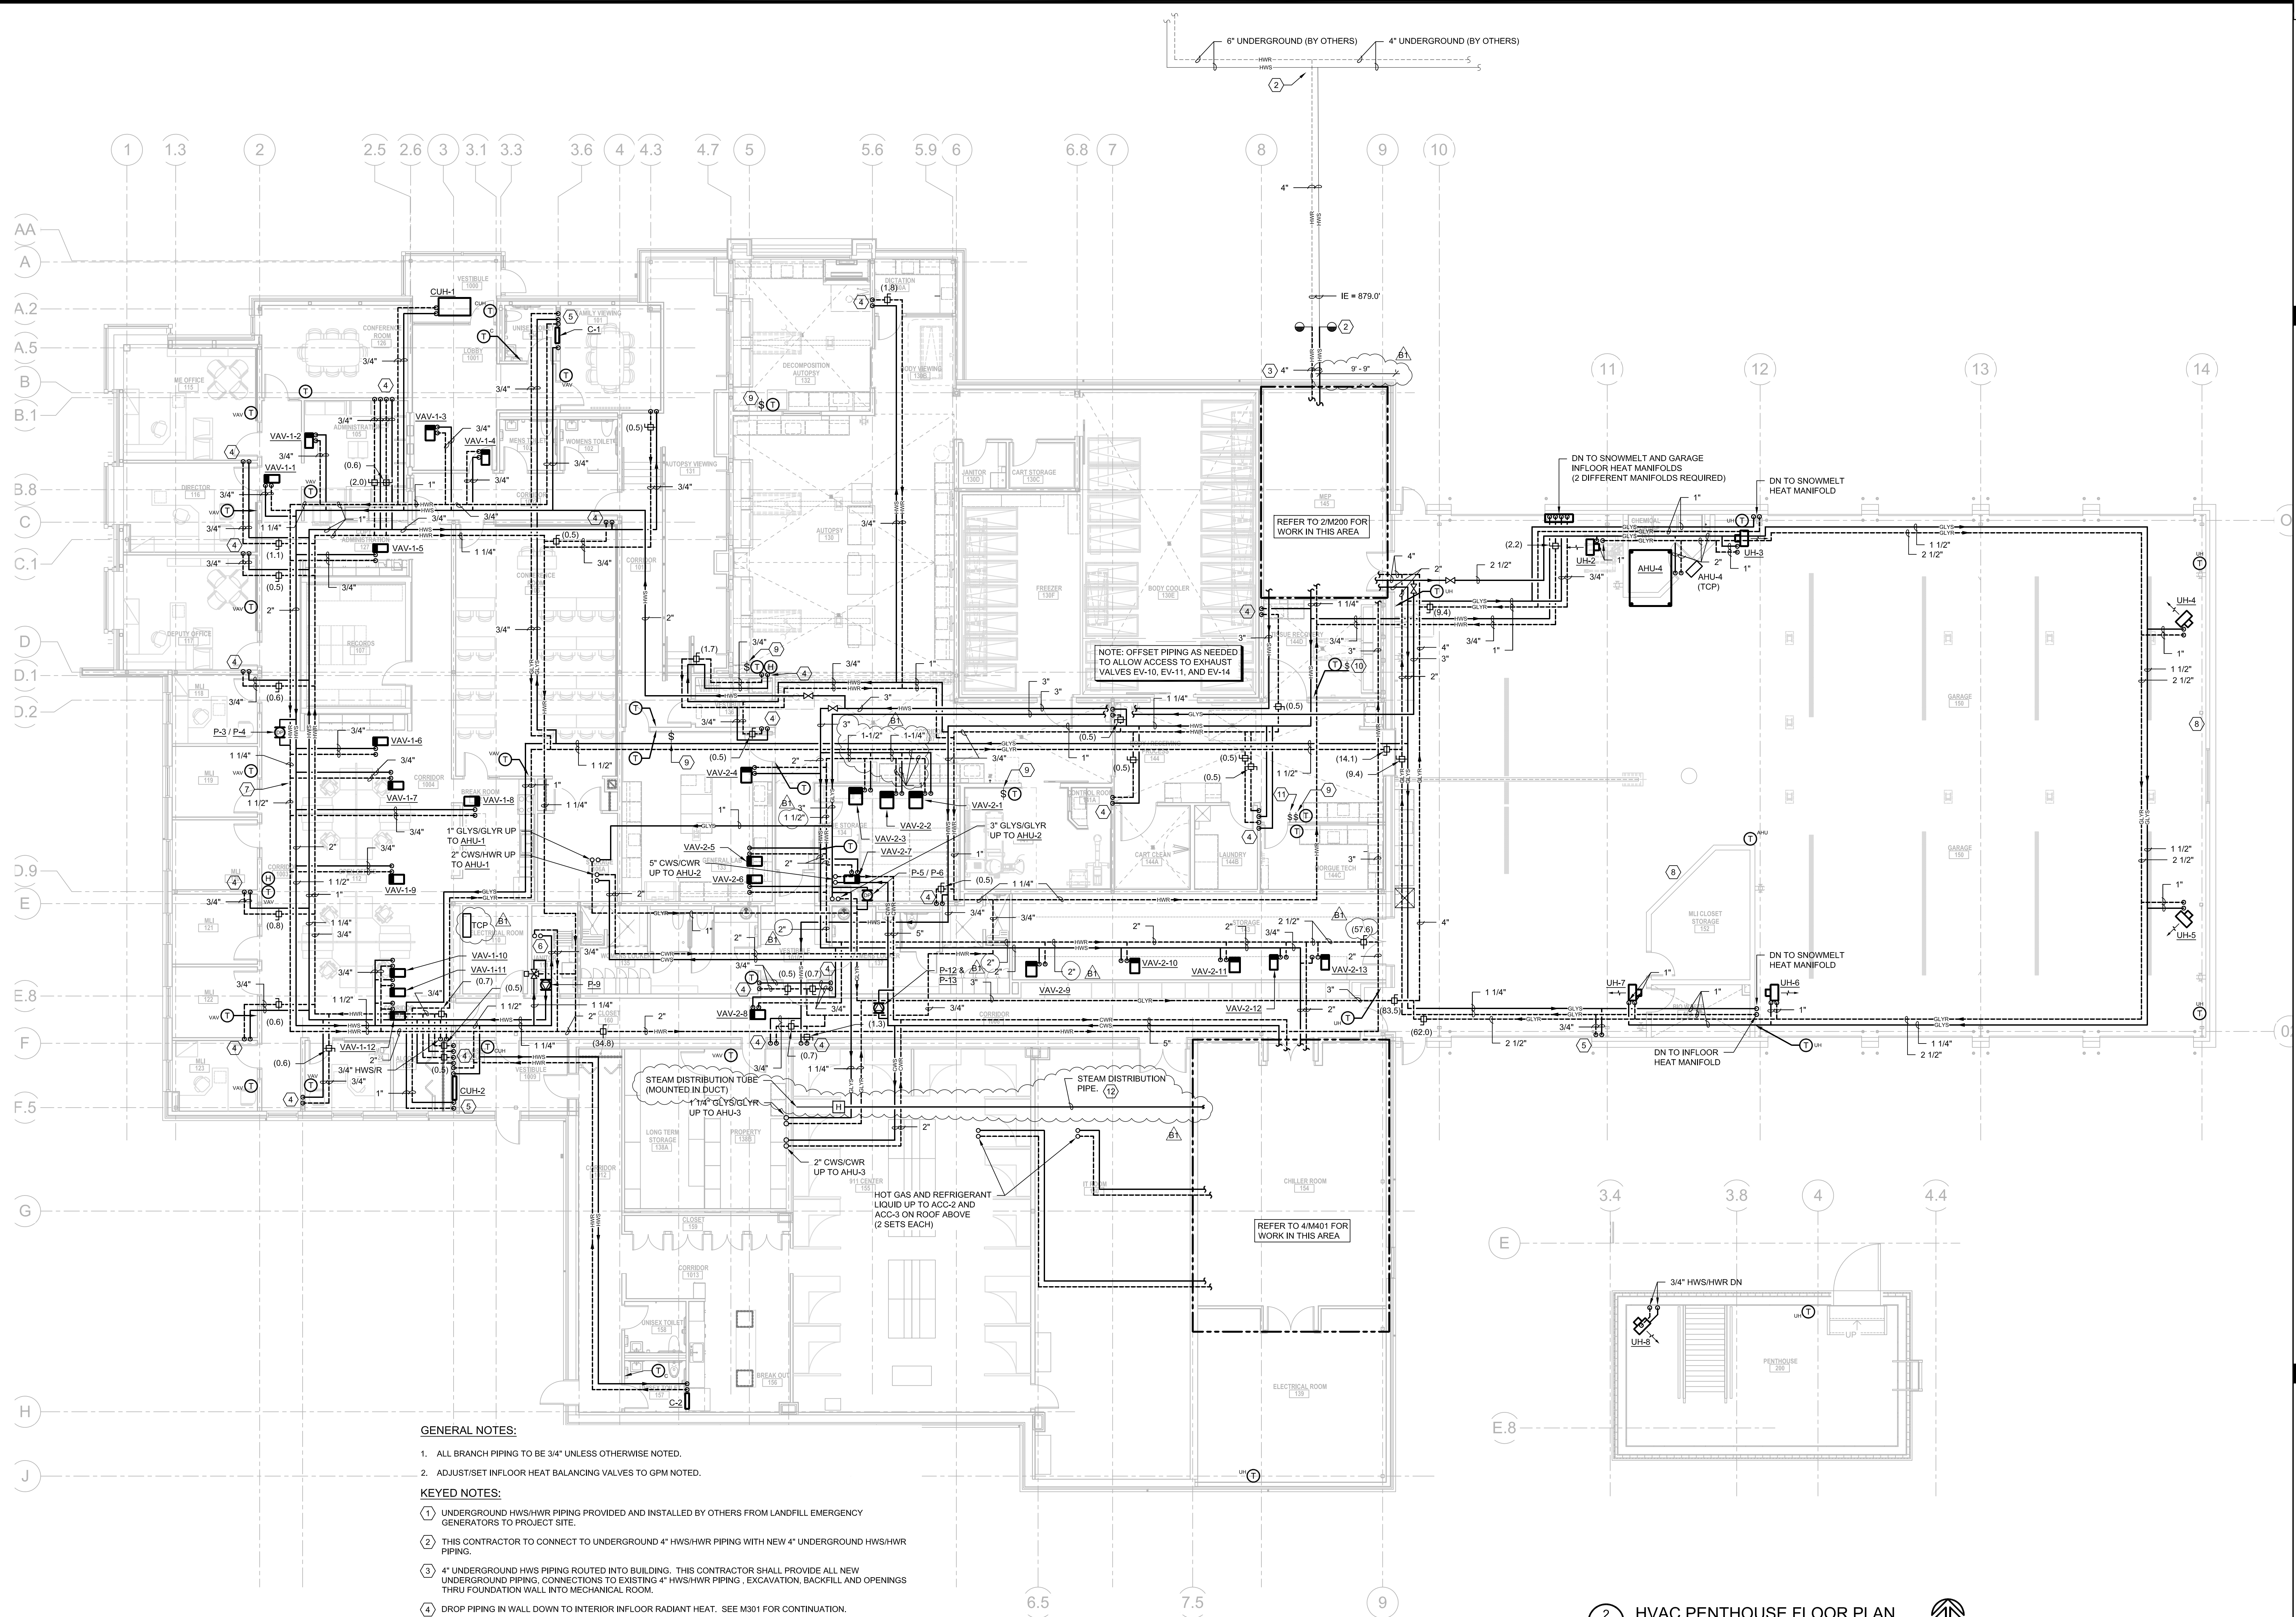

- GENERAL NOTES:**
1. ALL BRANCH PIPING TO BE 3/4" UNLESS OTHERWISE NOTED.
  2. ADJUST/SET INFLOOR HEAT BALANCING VALVES TO GPM NOTED.
- KEYED NOTES:**
- 1 UNDERGROUND HWS/HWR PIPING PROVIDED AND INSTALLED BY OTHERS FROM LANDFILL EMERGENCY GENERATORS TO PROJECT SITE.
  - 2 THIS CONTRACTOR TO CONNECT TO UNDERGROUND 4" HWS/HWR PIPING WITH NEW 4" UNDERGROUND HWS/HWR PIPING.
  - 3 4" UNDERGROUND HWS PIPING ROUTED INTO BUILDING. THIS CONTRACTOR SHALL PROVIDE ALL NEW UNDERGROUND PIPING, CONNECTIONS TO EXISTING 4" HWS/HWR PIPING, EXCAVATION, BACKFILL AND OPENINGS THRU FOUNDATION WALL INTO MECHANICAL ROOM.
  - 4 DROP PIPING IN WALL DOWN TO INTERIOR INFLOOR RADIANT HEAT. SEE M301 FOR CONTINUATION.
  - 5 DROP PIPING IN WALL DOWN TO EXTERIOR SNOWMELT HEAT. SEE M301 FOR CONTINUATION.
  - 6 3/4" HWS/HWR PIPING UP TO PENTHOUSE. SEE 2/M300 FOR CONTINUATION.
  - 7 LOCATION OF HW SYSTEM BY-PASS VALVE.
  - 8 LOCATION OF GAS DETECTION SENSOR. PROVIDE QUANTITY OF SENSORS REQUIRED FOR COMPLETE COVERAGE OF FLOOR AREA.
  - 9 LOW/HIGH VENTILATION AIR SWITCH.
  - 10 POSITIVE/NEGATIVE AIR SWITCH.
  - 11 AHU-2 OVERRIDE SWITCH LOCATION.
  - 12 STEAM DISTRIBUTION TUBE. SIZE PER MANUFACTURERS RECOMMENDATIONS. PITCH TUBING BACK TO HUMIDIFIER. RUN TUBING IN PVC CONDUIT ACROSS IT ROOM. INSULATE DISTRIBUTION TUBE.

1 M300 HVAC PIPING FIRST FLOOR PLAN SCALE: 1/8"=1'-0"



2 M300 HVAC PENTHOUSE FLOOR PLAN SCALE: 1/4"=1'-0"



**PROJECT**  
MEDICAL EXAMINER OFFICE  
BUILDING (BID PACKAGE B)  
3562 COUNTY HIGHWAY AB  
MC FARLAND, WI 53558


**BID NO.**  
313083

**DRAWING**  
HVAC PIPING FIRST  
FLOOR AND  
PENTHOUSE PLANS

**DATE**  
01.12.15

**JDR**  
ENGINEERING, INC.  
5525 NOBEL DRIVE  
SUITE 110  
MADISON, WI 53711  
ph:608.277.1728 fax:608.271.7046  
JDR Project No. 130099


M300

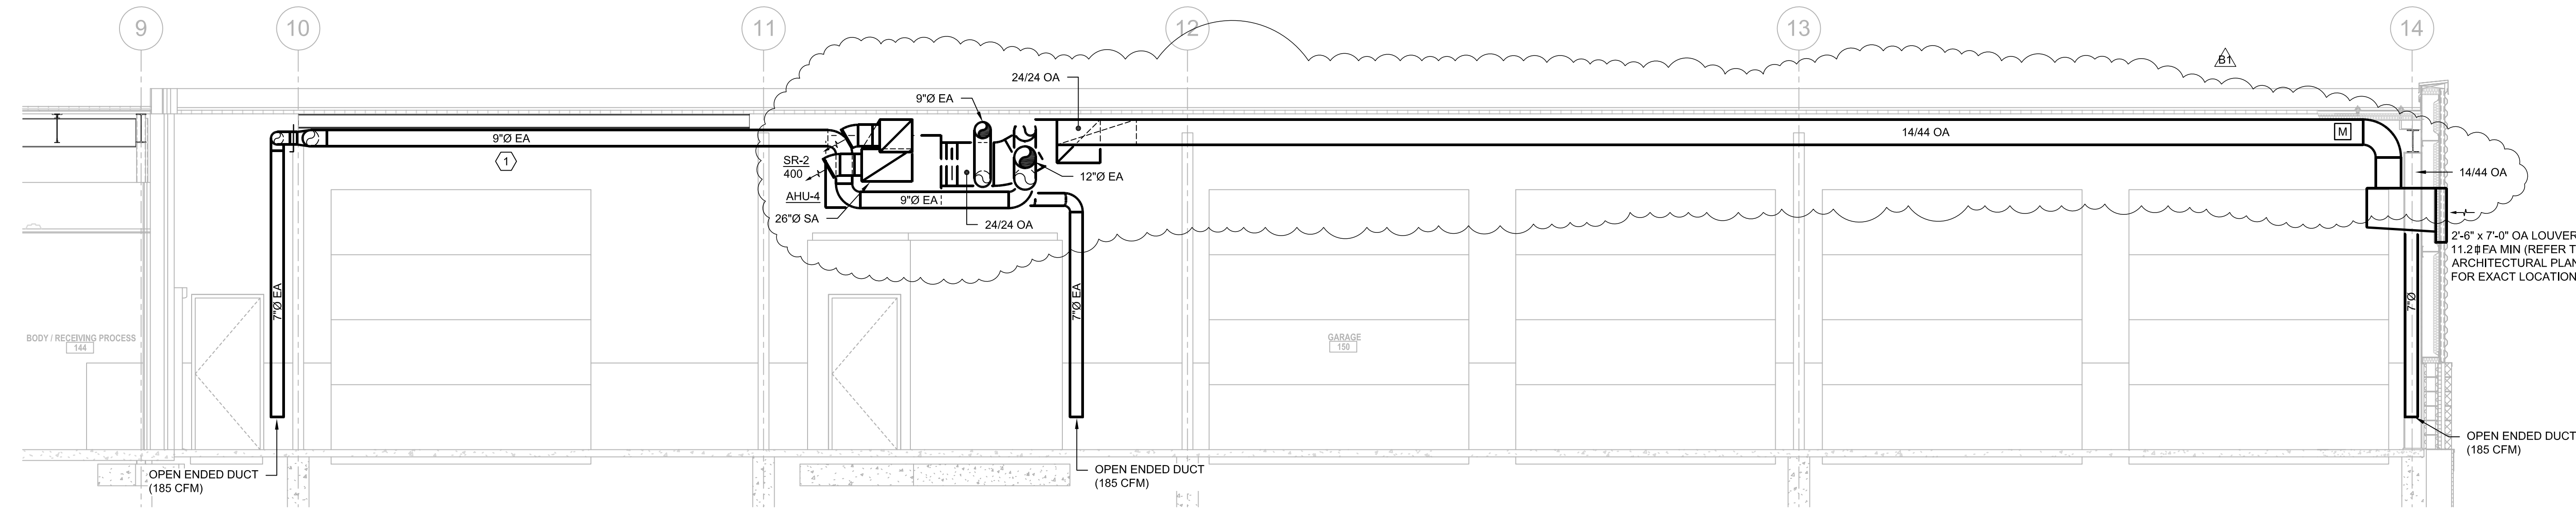


1 HVAC SECTION  
M401 SCALE: 1/4\"/>

KEYED NOTES:

- 1 DUCTWORK TO BE TIGHT TO STRUCTURE (± 13\"/>

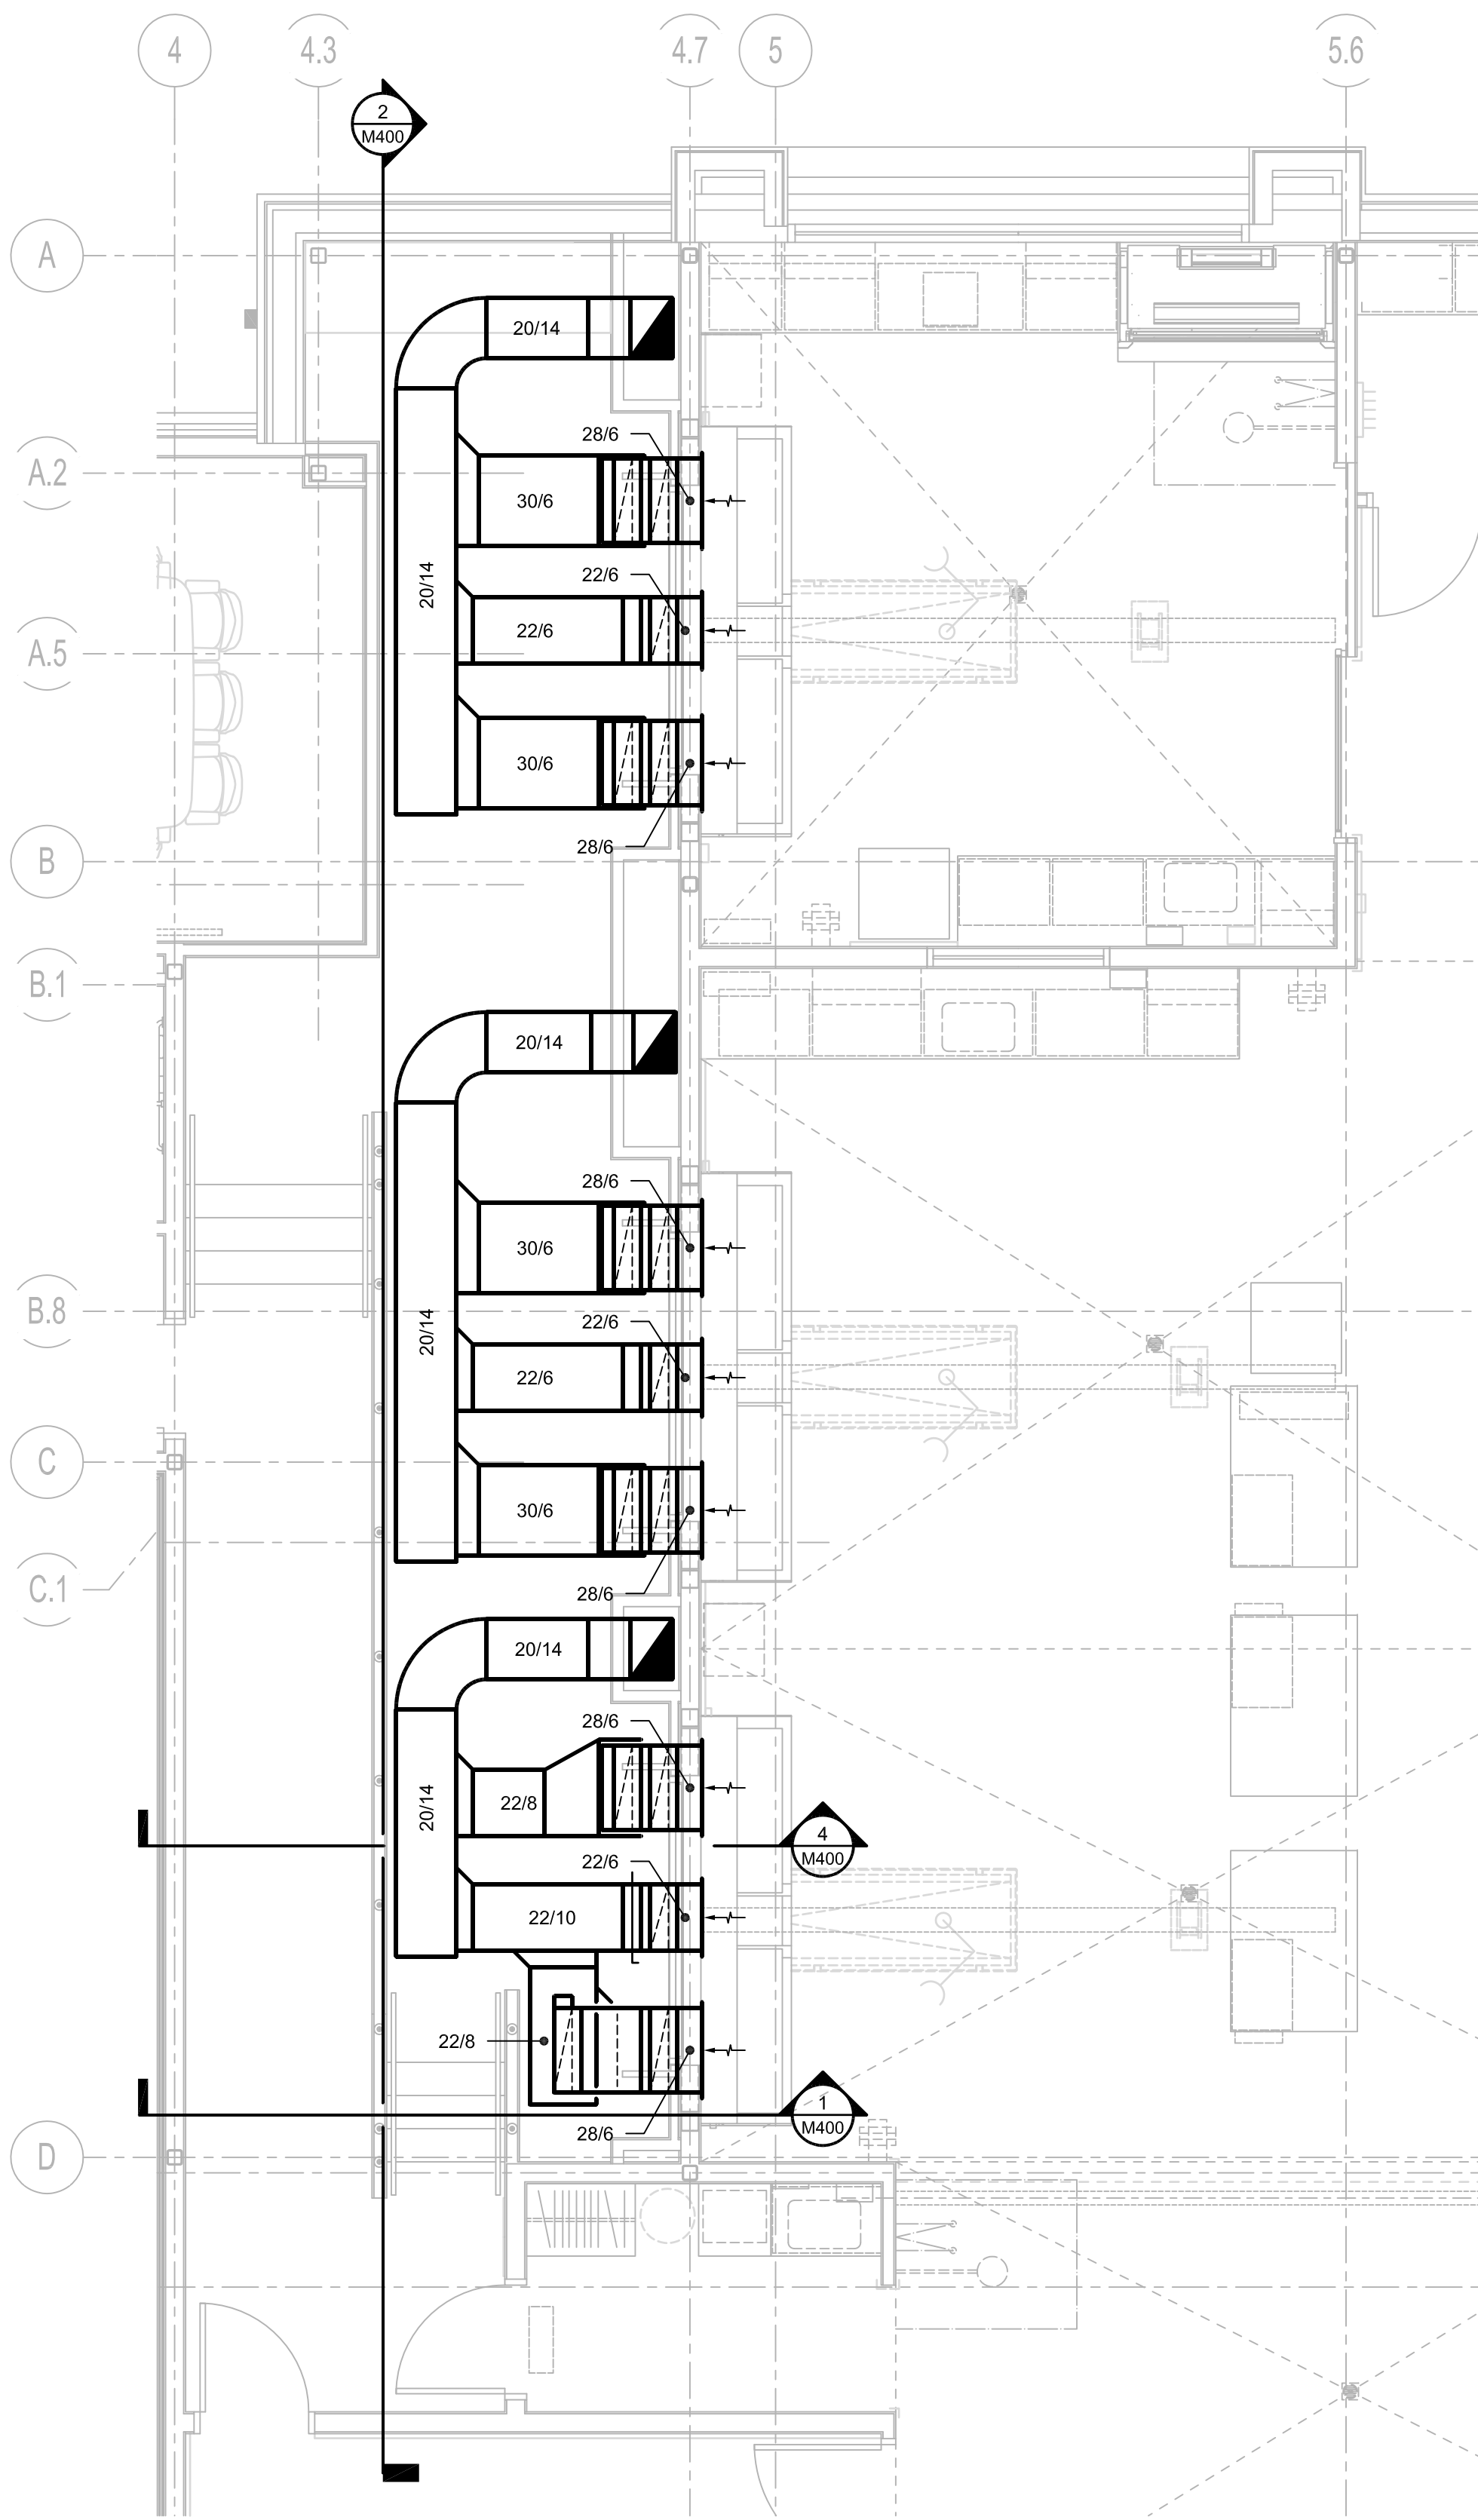


3 ENLARGED FLOOR PLAN - HVAC  
M401 SCALE: 1/4\"/>

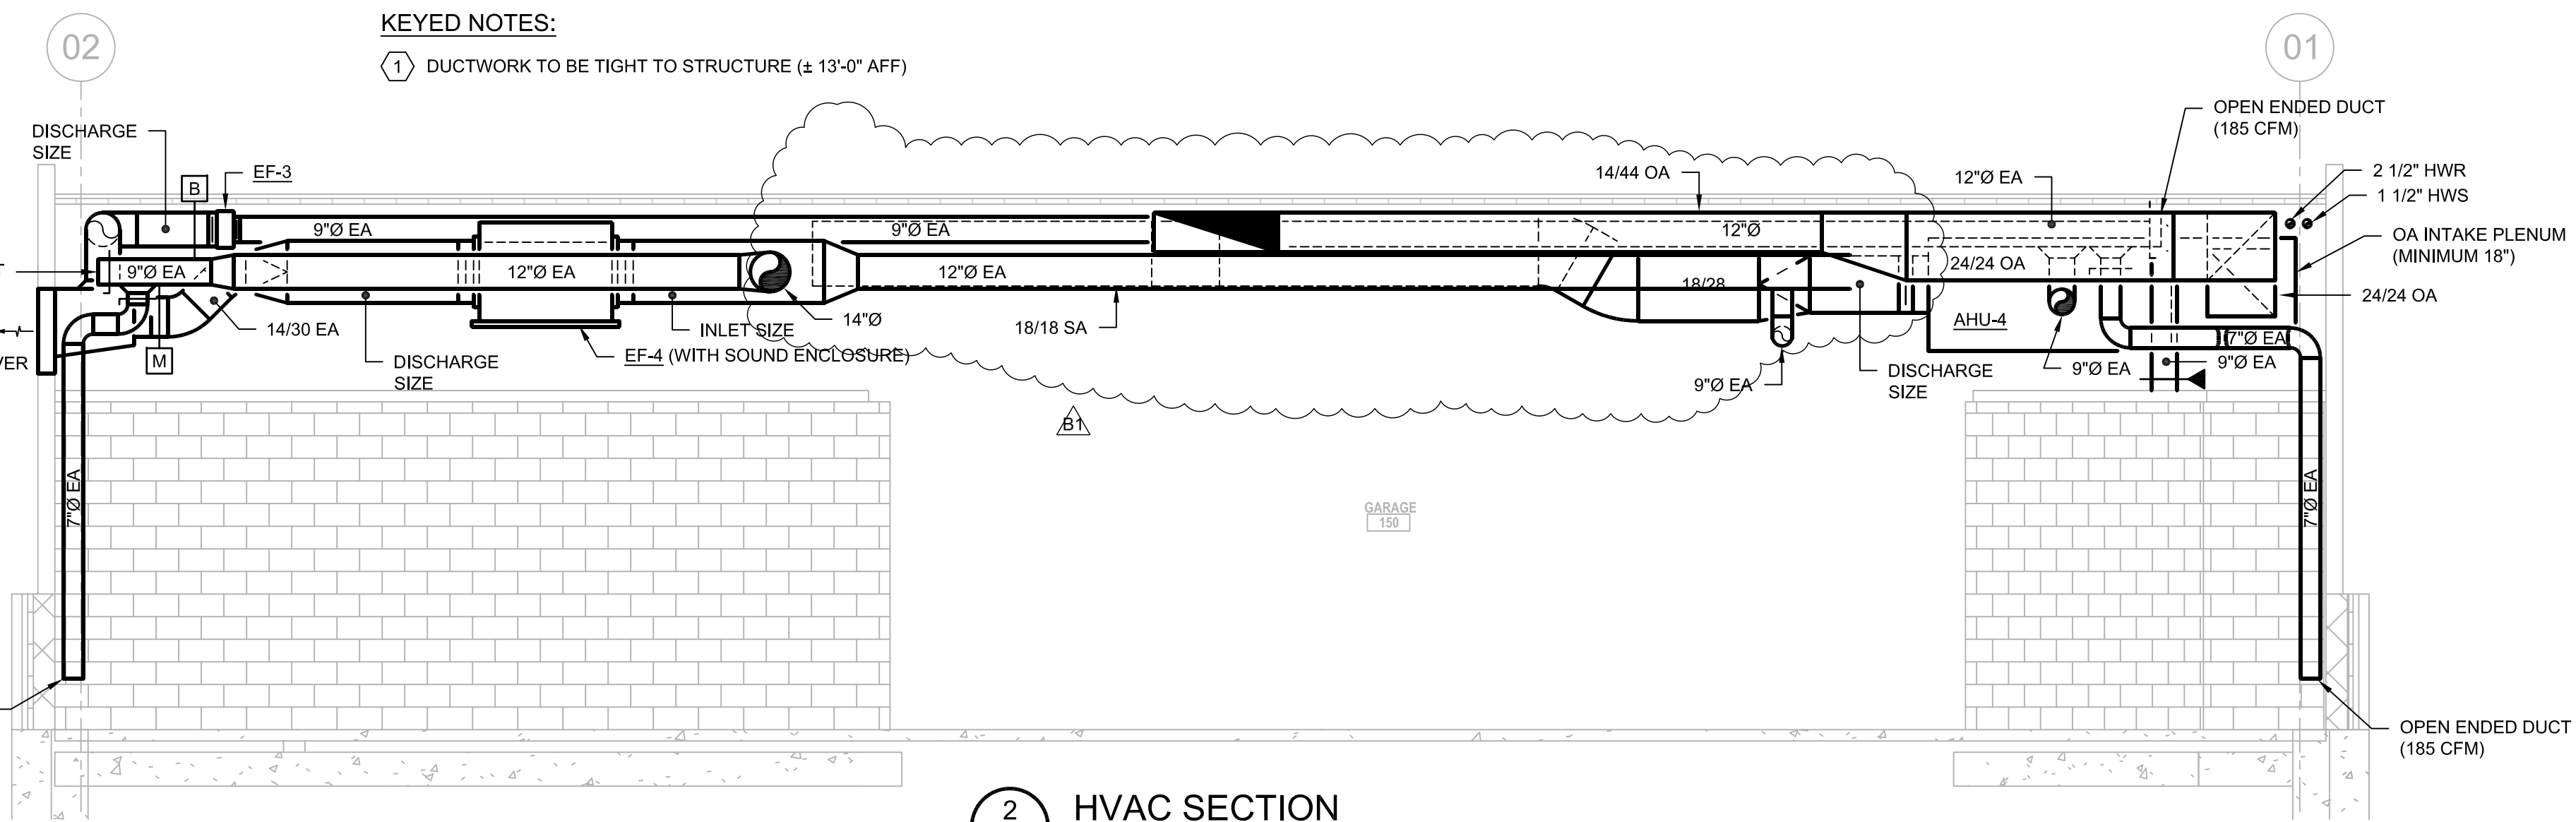

2 HVAC SECTION  
M401 SCALE: 1/4\"/>

KEYED NOTES:


- 1 DUCTWORK TO BE TIGHT TO STRUCTURE (± 13\"/>

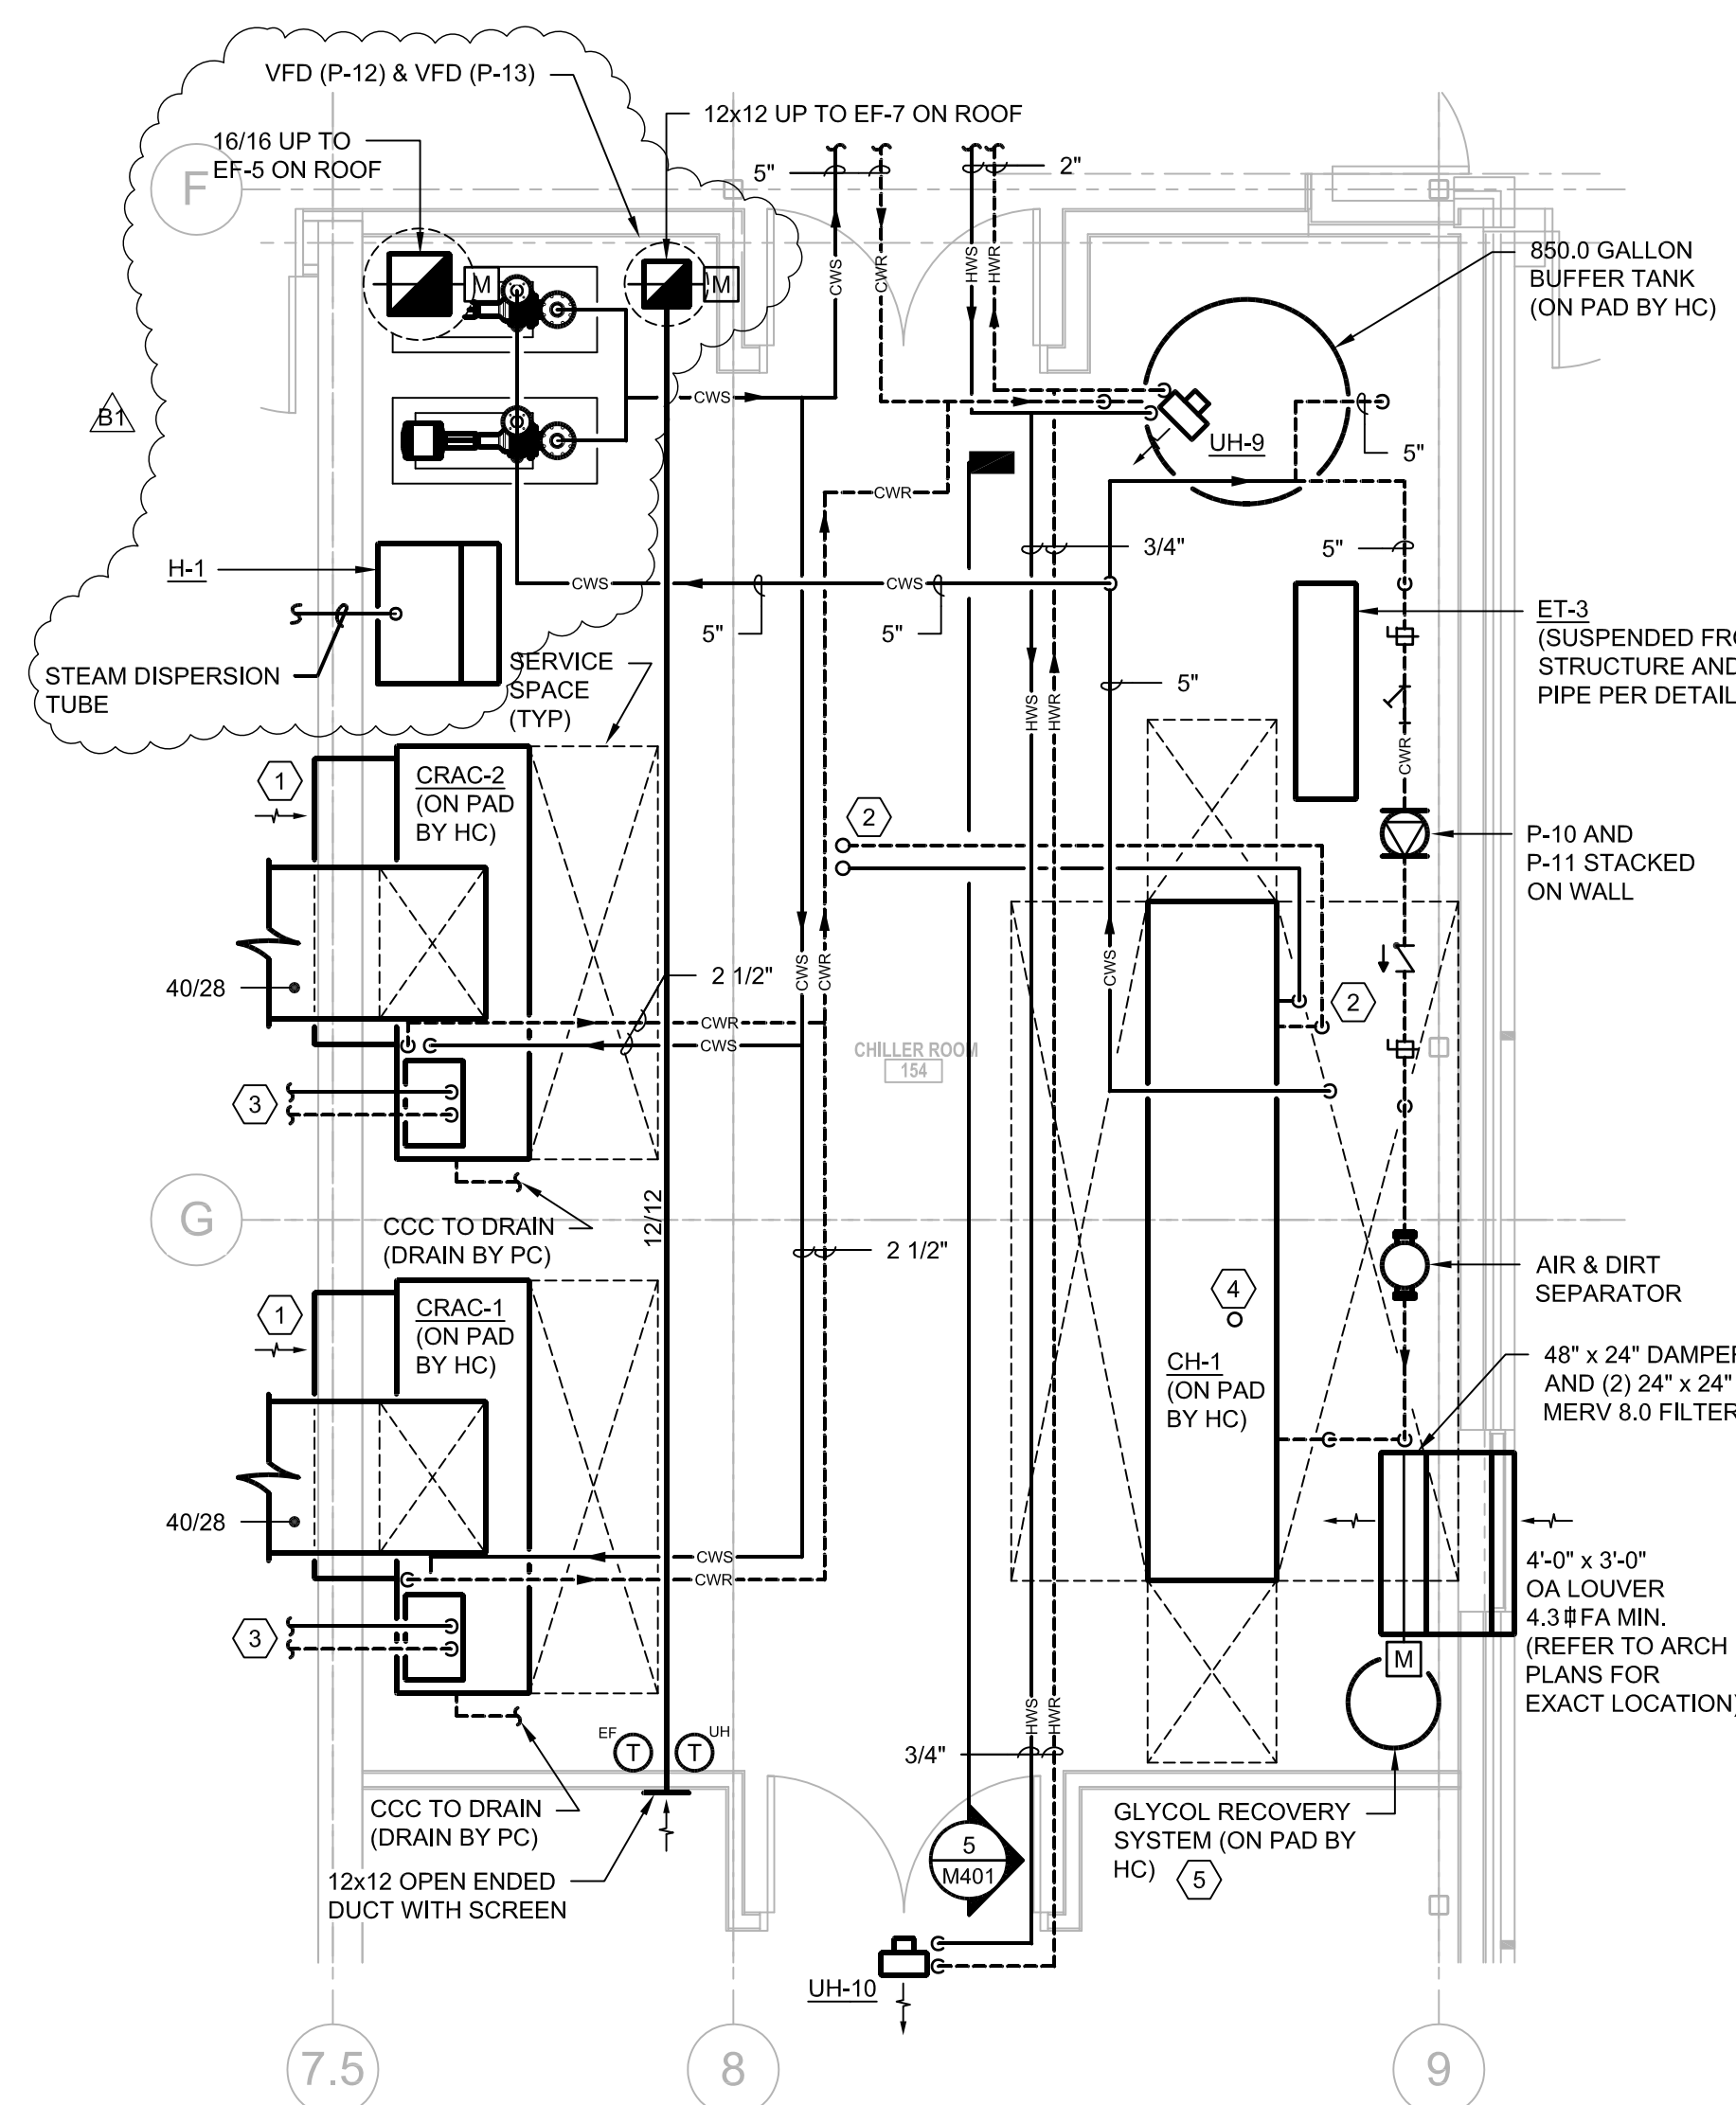

4 ENLARGED CHILLER ROOM - HVAC  
M401 SCALE: 1/4\"/>

KEYED NOTES:

- 1 PROVIDE EXPANDED METAL SCREEN OVER RETURN AIR OPENINGS.
- 2 REFRIGERANT LIQUID AND HOT GAS (2 SETS) BETWEEN CH-1 AND ACC-1 ON ROOF.
- 3 REFRIGERANT LIQUID AND HOT GAS (2 SETS) BETWEEN CRAC AND ACC ON ROOF.
- 4 RELIEF VALVE PIPING UP THRU ROOF (SIZE PER CODE AND MANUFACTURERS REQUIREMENTS).
- 5 PIPE GLYCOL PRESSURE RELIEF DISCHARGE PIPING TO GLYCOL RECOVERY TANK.

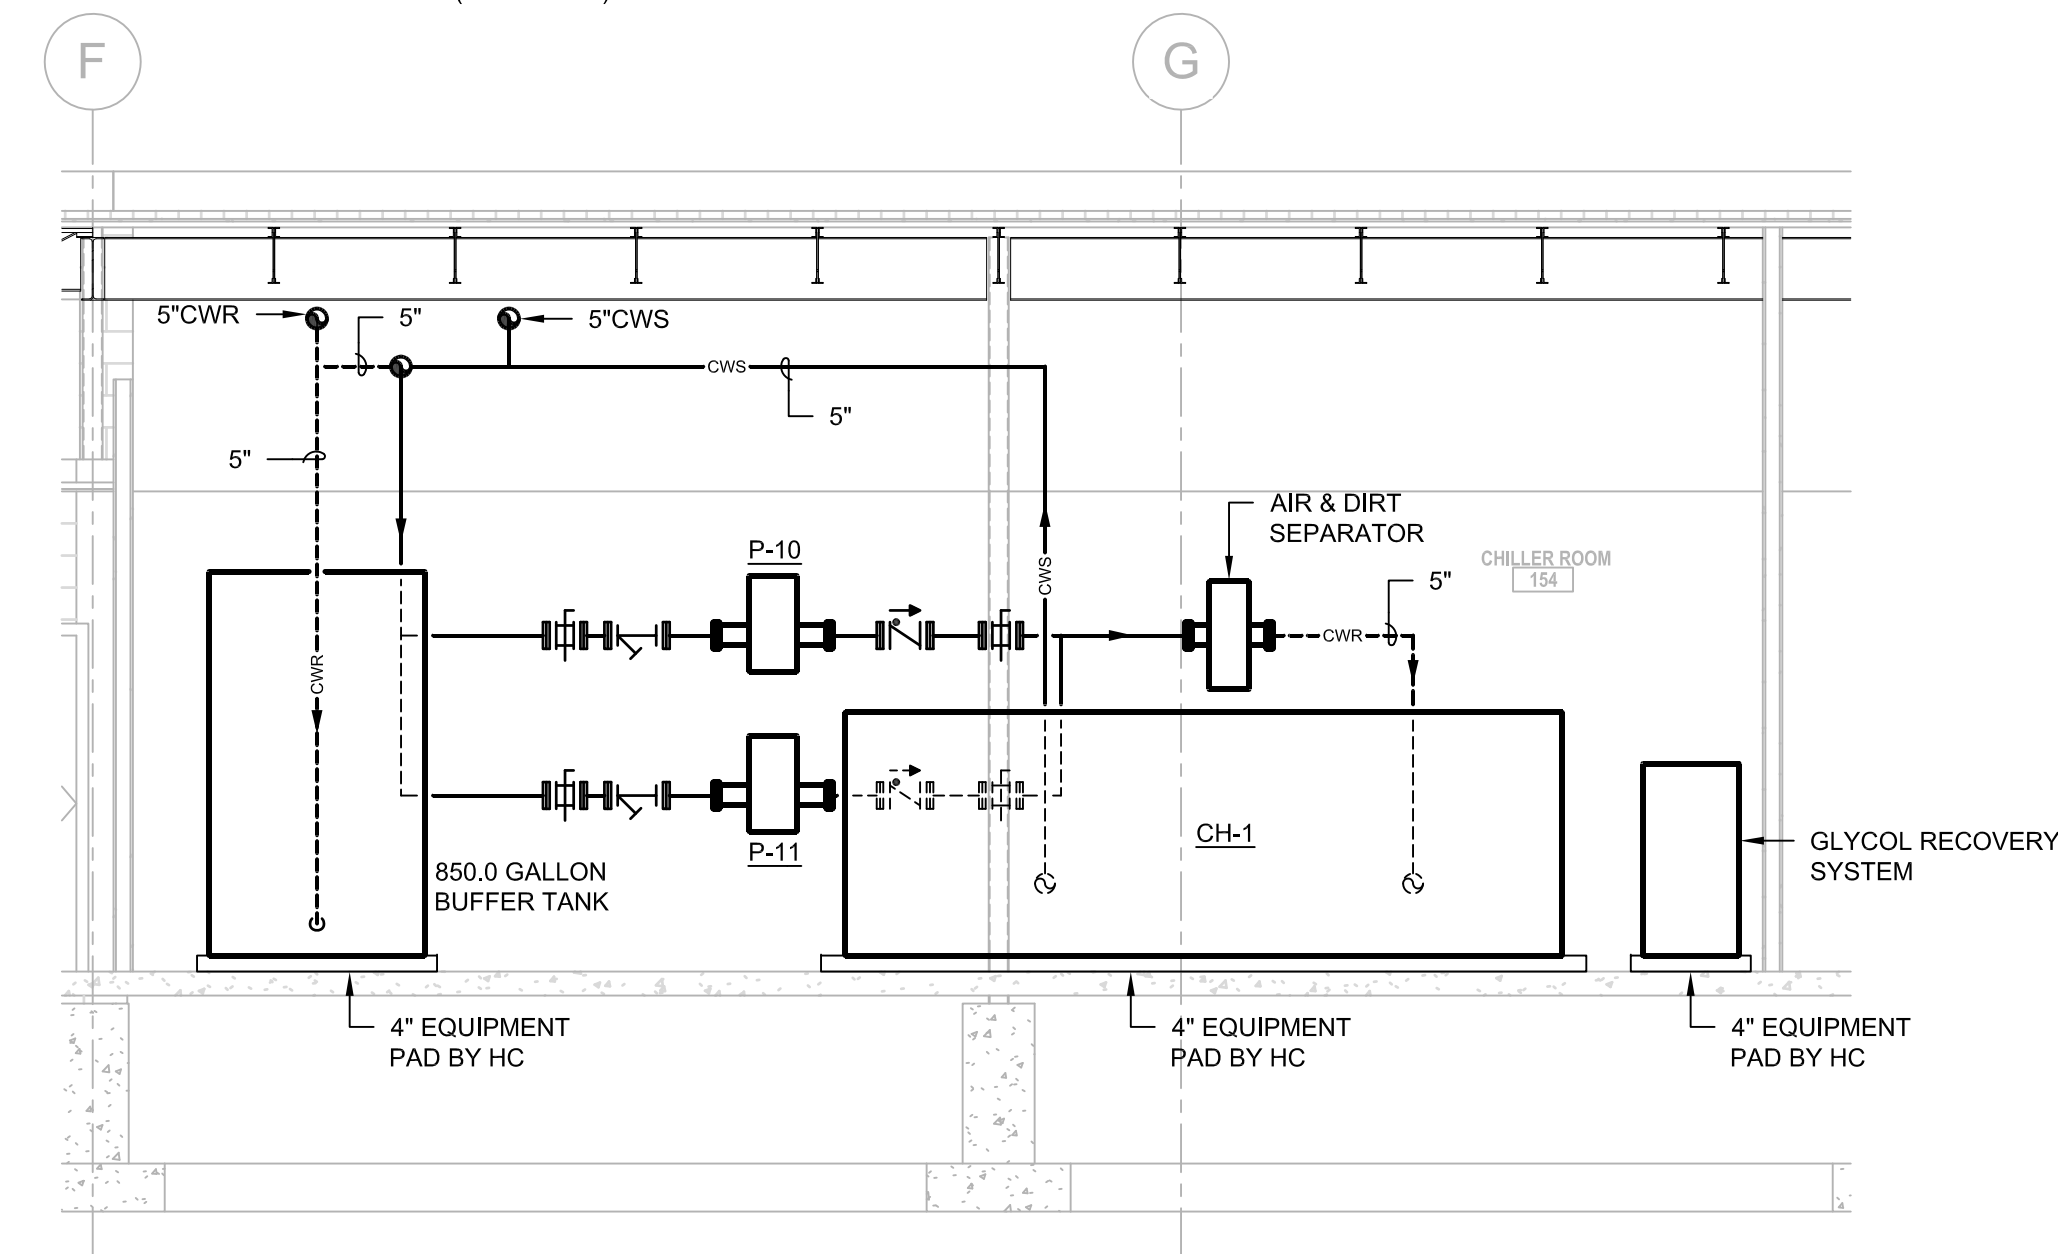

5 HVAC SECTION  
M401 SCALE: 1/4\"/>



ADDENDUM B1 BID QUESTIONS AND ANSWERS

1. QUESTION/COMMENT
  - a. Section 27 60 00 is missing from Bid Package B.AE RESPONSE
  - a. Refer to Addendum for addition of Specification Section 27 60 00.
  
2. QUESTION/COMMENT
  - a. Can Mortech Manufacturing Company be an approved equal for the Tissue Grossing Station in Section 11 78 10 Part 2.13?AE RESPONSE
  - a. Refer to Addendum for modification of Specification Section 11 78 10.
  
2. QUESTION/COMMENT
  - a. Metal Building @ Medical Examiner Office Building - The wall section details 1,2, and 3/A503 and 2/A604 appear to be missing some of the framing required to construct the parapet and the internal gutter. The Z girt at elevation 116'-8" is not attached to the metal building frame. There also does not appear to be anything supporting the internal gutter on the bottom or the sides. Please provide a detail that shows the light gage framing required to construct the parapet and the bottom and sides of the internal gutter. The way this is detailed it is not something that is provided by the metal building manufacturer. The wall girt at the top of the parapet has nothing to attach to. The internal gutter needs to be supported.AE RESPONSE
  - a. Refer to Addendum for modification of drawings and Specification Section 13 34 19 for revisions and clarification of scope.
  
2. QUESTION/COMMENT/REQUEST
  - a. Preferred Lightening Protection provided information for Engineer's review as an approved equal for lightening protection.AE RESPONSE
  - a. Refer to Addendum for modification of Specification Section 26 41 00.
  
3. QUESTION/COMMENT/REQUEST
  - a. ABT, Inc. provided information for Engineer's review as an approved equal for plumbing drains.AE RESPONSE
  - a. Refer to Addendum for modification of Specification Section 22 13 00.
  
4. QUESTION/COMMENT
  - a. This project is missing some information and also may have some conflicting asphalt specifications that need to be clarified.AE RESPONSE
  - a. Refer to Addendum for modification of Specification Section 32 12 16.
  
5. QUESTION/COMMENT
  - a. Detail 11/S410: Please reference roof framing plan key note #49 on sheet S200. This note refers us to detail 11/S410. There is no detail 11/S410, please provide or revise reference.AE RESPONSE
  - a. Refer to Addendum for clarification in drawings.
  
6. QUESTION/COMMENT
  - a. Spec 05 12 00: In paragraph 1.04 subparagraph A, there is a requirement that the steel fabricator's plant is AISC Certified. This has reduced competition significantly in the past even though most fabricators meet the AISC requirements but simply don't apply for the certification. Subs have noted that Pkg A doesn't have that requirement. Is it needed for the Medical Examiner's building?AE RESPONSE



- a. Bid as per Contract Documents.
7. QUESTION/COMMENT
- a. Drawing Q210: SS Wall Guard in Rooms 130E and 130F- Please clarify the extent of SS Wall Guard (Key Note 14 on Sheet Q210) in rooms 130E and 130F. The specific note 14 in these rooms appears to indicate that SS Wall Guard should go around the entire, interior perimeter of the rooms. However, at all other locations with note 14, there is a “hatching” that indicates SS Wall Guard. Please clarify.
- AE RESPONSE
- a. Refer to Addendum for clarification in drawings.
8. QUESTION/COMMENTS
- a. Drawing Q210: Please clarify where or if these items or conditions apply on this or other sheets. Items 25, 36, 39, 50, 62, 64, 73, and 75.
- AE RESPONSE
- a. Refer to Addendum for clarification in drawings.
11. QUESTION/COMMENT
- a. Creative Sign Company requested to be approved equal for the signs found in Information Specialties, 10 14 00.
- AE RESPONSE
- a. Architect requested information/documentation to review that they met the specified material. None was received. No, bid as per Contract Documents.
12. QUESTION/COMMENT
- a. Wisconsin Automatic Door, Inc. to be approved equal for the sliding doors found in Sliding Automatic Entrances, 18 42 29.23.
- AE RESPONSE
- a. Architect requested information/documentation to review that they met the specified material. Incomplete information was received. Upon a call with the Wisconsin Automatic Door, Inc., it was found they could not meet the specified criteria. No, bid as per Contract Documents.
13. QUESTION/COMMENT
- a. Mopec D.A.I. Scientific would like to substitute the recessed body scale found in Specification Section 11 78 10, Autopsy & Morgue Equipment with an alternate scale.
- AE RESPONSE
- a. No, bid as per Contract Documents.
14. QUESTION/COMMENT
- a. TAB Products Co. would like TAB TRAC to be considered as an approved equal to the product specified in Specification Section 10 56 26, Mobile Storage Shelving.
- AE RESPONSE
- a. No, bid as per Contract Documents. The submitted product information did not meet all the specification requirements.
15. QUESTION/COMMENT
- a. Montel Inc. would like one of their products to be considered as an approved equal to the product specified in Specification Section 10 56 26, Mobile Storage Shelving.
- AE RESPONSE
- a. No, bid as per Contract Documents. The submitted product information did not meet all the specification requirements.
16. QUESTION/COMMENT
- a. Spec 10 56 26: At the mobile storage shelving units, are the uprights on the ends all closed, or closed ends with intermediate supports? There are 7 shelves specified. Is this 7 total

shelves per section, or 7 openings, making 8 shelves? Is the shelving to be single face or double face?

AE RESPONSE

- a. See addendum for clarification of upright style and end face panel locations. Section 10 56 26 specifies 7 levels per shelving unit. Section 10 56 26 specifies back stop and acrylic bin front and shelving configuration is per floor plan A200.

17. QUESTION/COMMENT

- a. For Specification Section 09 51 00, Acoustic Ceilings, USG would like to be considered as an provide equal for the following: Armstrong Optima 3251 (specified) , USG Halcyon 98225 (equivalent), Armstrong Clean Room 868 (specified), USG Clean Room 56099 and CE Grid w/gaskets (equivalent), Certainteed VinylRock (specified), and USG Sheetrock Gypsum Lay-in Panels (equivalent).

AE RESPONSE

- a. Refer to Addendum for addition of USG as approved equal for the above.

18. QUESTION/COMMENT/REQUEST

- a. There is no drain shown on the mechanical drawings for the canopy.

AE RESPONSE

- a. Refer to Addendum for modification of plumbing drawing.

14. QUESTION/COMMENT/REQUEST

- a. Can Loren Cook be an approved equal for Mixed-Flow Induced Dilution Fans?

AE RESPONSE

- a. Refer to Addendum for modification of Section 23 34 00.

14. QUESTION/COMMENT/REQUEST

- a. Can Lochinvar Crest be an approved equal for Heating Boilers?

AE RESPONSE

- a. No, bid as per Contract Documents. The submitted product information did not meet all the specification requirements.

14. QUESTION/COMMENT/REQUEST

- a. Can Armstrong be an approved equal for Hydronic Pumps?

AE RESPONSE

- a. Refer to Addendum for modification of Specification Section 23 21 21.

14. QUESTION/COMMENT/REQUEST

- a. Can Johnson Controls be an approved equal for Building Controls?

AE RESPONSE

- a. No, bid as per Contract Documents.

14. QUESTION/COMMENT/REQUEST

- a. Can Trane Controls be an approved equal for Building Controls?

AE RESPONSE

- a. No, bid as per Contract Documents.

14. QUESTION/COMMENT/REQUEST

- a. Is there any dual wall duct as indicated on Detail 5/M500

AE RESPONSE

- a. See Addendum B1.

END OF ATTACHMENT